## **FAX TRANSMITTAL**

ADDENDUM TO THE CONTRACT DOCUMENTS	Page Number	No. of Pages		
Addendum No. One	Date Addendum Issued: April 16, 2021			
Issuing Office Alaska State Parks, Design & Construction Section 550 West 7 <sup>th</sup> Ave., Suite 1340; Anchorage, Alaska 99501 Phone: 269-8731 Fax: 269-8917	Previous Addenda Issu None	ed		
Project: DSP: Visitor Center Complex Interpretive Trails Project No.: 79225-1	Date and Hour of Quot Tuesday; April 27, 2021	es Due at 2:00 P.M. (Local Time)		

## **NOTICE TO BIDDERS**

Bidder must acknowledge receipt of this addendum prior to the hour and date set for the quotes being due by one of the following methods:

(a) By acknowledging receipt of this addendum on the quote submitted.

(b) By telegram or telefacsimile which includes a reference to the project and addendum number.

## The Plans are modified as follows:

Replace Sheet 2 of the Plans with modified Sheet 2 (Attachment A). (Reference Addendum No. 1 – Attachment A)

is addendum on the proposal form quotes being due.
One received.
Date
(

Firm

-			7		DDENDUM	
		ESTIMATE OF QUANTITIES		<u>S</u>	HEET 1 OU	
ITEM		UNIT	QTY			
201(3A)	CLEARING AND GRUBBING	RUBBING			0.70	
201(6)	SELECTIVE TREE REMOVAL	EACH	10			
203(3)	UNCLASSIFIED EXCAVATION			C.Y.	600	
203(5A)	BORROW, TYPE A			C.Y.	675	
301(1)	AGGREGATE BASE COURSE, GRA	ADING D-1		TON	370	
615(1)	STANDARD SIGN	<del></del>		S.F.	2.44	
618(2)	SEEDING			POUND	16	
620(1)	TOPSOIL, CLASS B			S.Y.	1700	
640(1)	MOBILIZATION AND DEMOBILIZAT	TION	·	L.S.	ALL REQ'D	
641(1)	EROSION, SEDIMENT AND POLLU	TION CONTROL ADMINISTRATION		L.S.	ALL REQ'D	
641(2)	TEMPORARY EROSION, SEDIMEN	T, AND POLLUTION CONTROL		C.S.	ALL REQ'D	
641(6)	WITHHOLDING			C.S.	ALL REQ'D	
642(1)	CONSTRUCTION SURVEYING	L.S.	ALL REQ'D			
642(3)	THREE PERSON SURVEY PARTY	HOUR	5			
643(2)	TRAFFIC MAINTENANCE	L.S.	ALL REQ'D			
647(6)	HYDRAULIC EXCAVATOR, 1 CY. 1	HOUR	5			
650(3B)	PARK BENCH, TYPE B	EACH	1			
650(11)	SPOTTING SCOPE	EACH	2			
650(20)	REMOVABLE BARRIER POST	EACH	1			
650(40D)	INTERPRETIVE SIGN, TYPE D	EACH				
650(46)	TIMBER STAIRWAY	<del></del>		L.S.	5 ALL REQ'D	
EXISTING	LEGEND PROPOSED		φ	ABBREVIATIONS DIAMETER		
to explanation of the	20 March 20 20 May 20 1943	EDGE OF PAVEMENT	AC APPRIX.	CENTERLINE ASPHALT CONCRETE APPROXIMATE		
************		EDGE OF VEGETATION	BLDG C.F. C.S.	.		
		EDGE OF WATER	CSP C.Y.	CONTINGENT SUM CORRUGATED STE CUBIC YARD		
(60)	(3)	MAJOR CONTOUR LINE	ELEV	ELEVATION		
		MINOR CONTOUR LINE	EST. HMA IN.	ESTIMATE HOT MIX ASPHALT INCH		
		EDGE OF ROAD/TRAIL	INV. LB/LBS	INVERT POUND/POUNDS		
***************************************	Company of the Compan	LIMIT OF FILL SLOPE	L.F. L.S.	LINEAR FEET LUMP SUM		
>=====		LIMIT OF CUT SLOPE  CULVERT	MIN M.E. MP NO.	MINIMUM MATCH EXISTING MILEPOST NUMBER		
lacktriangle		SURVEY CONTROL MONUMENT	OE OHW PCC PVC	OVERHEAD ELECTI ORDINARY HIGH W PORTLAND CEMEN POLYVINYL CHLOR	ATER TOONCRETE	
			QTY.	QUANTITY		

INTERPRETIVE SIGN, TYPE D

ERRATIC

PARK BENCH

SIGN

SPOTTING SCOPE

REMOVABLE BARRIER POST

TABLE OF ESTIMATING FACTORS			
ITEM	DESCRIPTION	ESTIMATING FACTOR	
203(5A)	BORROW, TYPE A	145 LBS/C.F.	
301(1)	AGGREGATE BASE COURSE. GRADING D-1	148 LBS/C.F.	

			ITEM	615(1) STAN	DARD SIGN				
SIGN NO.	FACING TYPE	IO TYPE	LEGEND	SIZE	4054 (0.5)	THICKNESS	SIGN POST DATA		
		LEGEND	(IN X IN)	AREA (S.F.)	(IN.)	TYPE	SIZE (IN.)	NO.	
	ŞE	TPS 1	<b>#</b> #	11X16	1.22	0.125			
S1		STA 0+10	•				WOOD	12 X 12	1
Ī		RIGHT							
	SW	TPS 1	20.27	11X16	1.22	0.125			
S2	_	STA 202+22	↑				WOOD	12 X 12	1
		LEFT						1 1	
			PROJECT TOTALS	1	2.44				2

ORIGINAL


ADDENDUM

GROUND '

TRAIL POST

DATE

04/15/2021

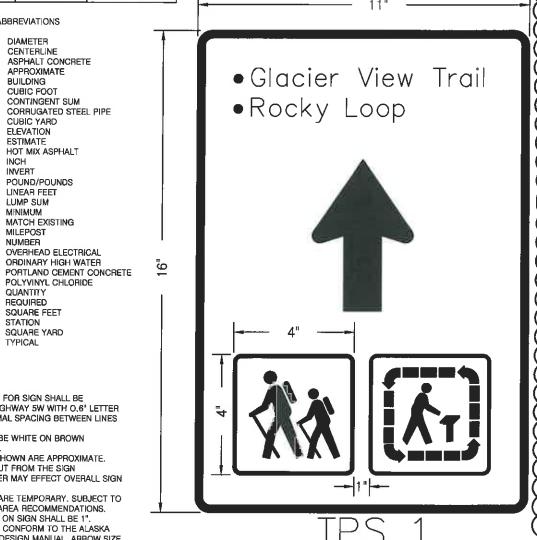

- ATTACHMENT A

DEPARTMENT OF NATURAL RESOURCES

: DIVISION OF PARKS AND OUTDOOR RECREATION
ITE 1340, ANCHORAGE, AK 99501 - 907.269.8731

COMPLEX

ESTIMATE OF QUANTITIES, SUMMARY
ILS

TABLE, LEGEND, SIGN SUMMARY, SIGN
DETAILS, AND ABBREVIATIONS SY: DIVISION (SUITE 1340, AP CUT TOP ON ALL FOUR SIDES @45 DEGREES -SIX INCHES BELOW TOP OF TIMBER TREATED 12X12 OF ALA ATTACH SIGN WITH 1-1/2' LONG TAMPERPROOF STATE

COMMENT

ADDITIONAL DETAIL



PREPARED: ROM DRAWN: ROM REVIEWED: LGN DATE: 4/15/2021

SHEET

OF 13 SHEETS

REQ'D S.F. STA S.Y. TYP.

1. TYPICAL FONT FOR SIGN SHALL BE CLEARVIEW HIGHWAY 5W WITH O.6" LETTER HEIGHT. NORMAL SPACING BETWEEN LINES

REQUIRED SQUARE FEET STATION SQUARE YARD TYPICAL

- OF TEXT.
  2. SIGNS SHALL BE WHITE ON BROWN BACKGROUND.
- DIMENSIONS SHOWN ARE APPROXIMATE. ACTUAL LAYOUT FROM THE SIGN MANUFACTURER MAY EFFECT OVERALL SIGN
- DIMENSIONS.
  TRAIL NAMES ARE TEMPORARY. SUBJECT TO CHANGE PER AREA RECOMMENDATIONS.
  CORNER RADII ON SIGN SHALL BE 1".
- ARROW SHALL CONFORM TO THE ALASKA DOT&PF SIGN DESIGN MANUAL. ARROW SIZE
- BORDER SHALL BE 0.25".
  DETAILS ARE D7-RL LAND RECREATION PLATES: RL-100 & RL-130.