
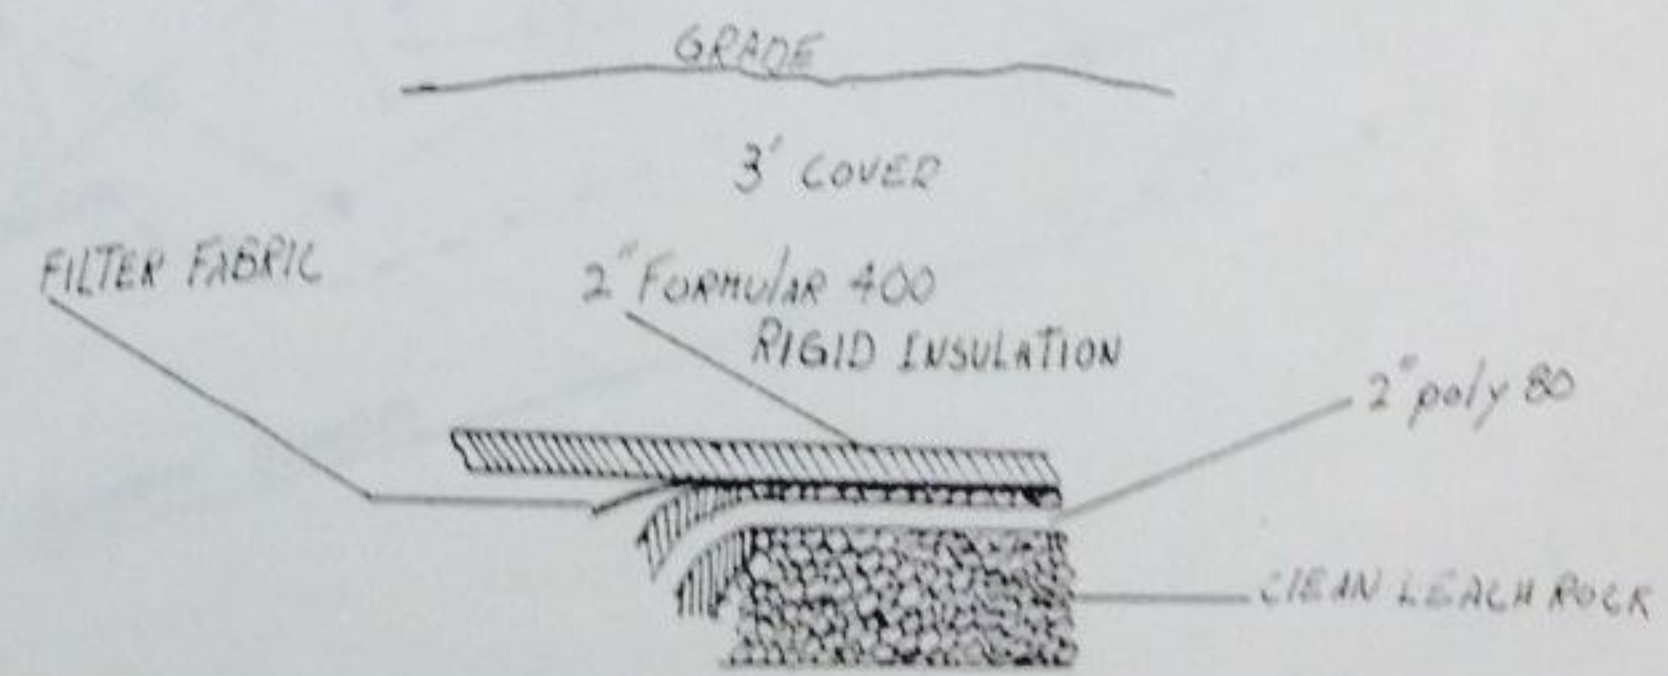


Keep in
Kings File
11/8/87
Sand and gravel together

AS-BUILT

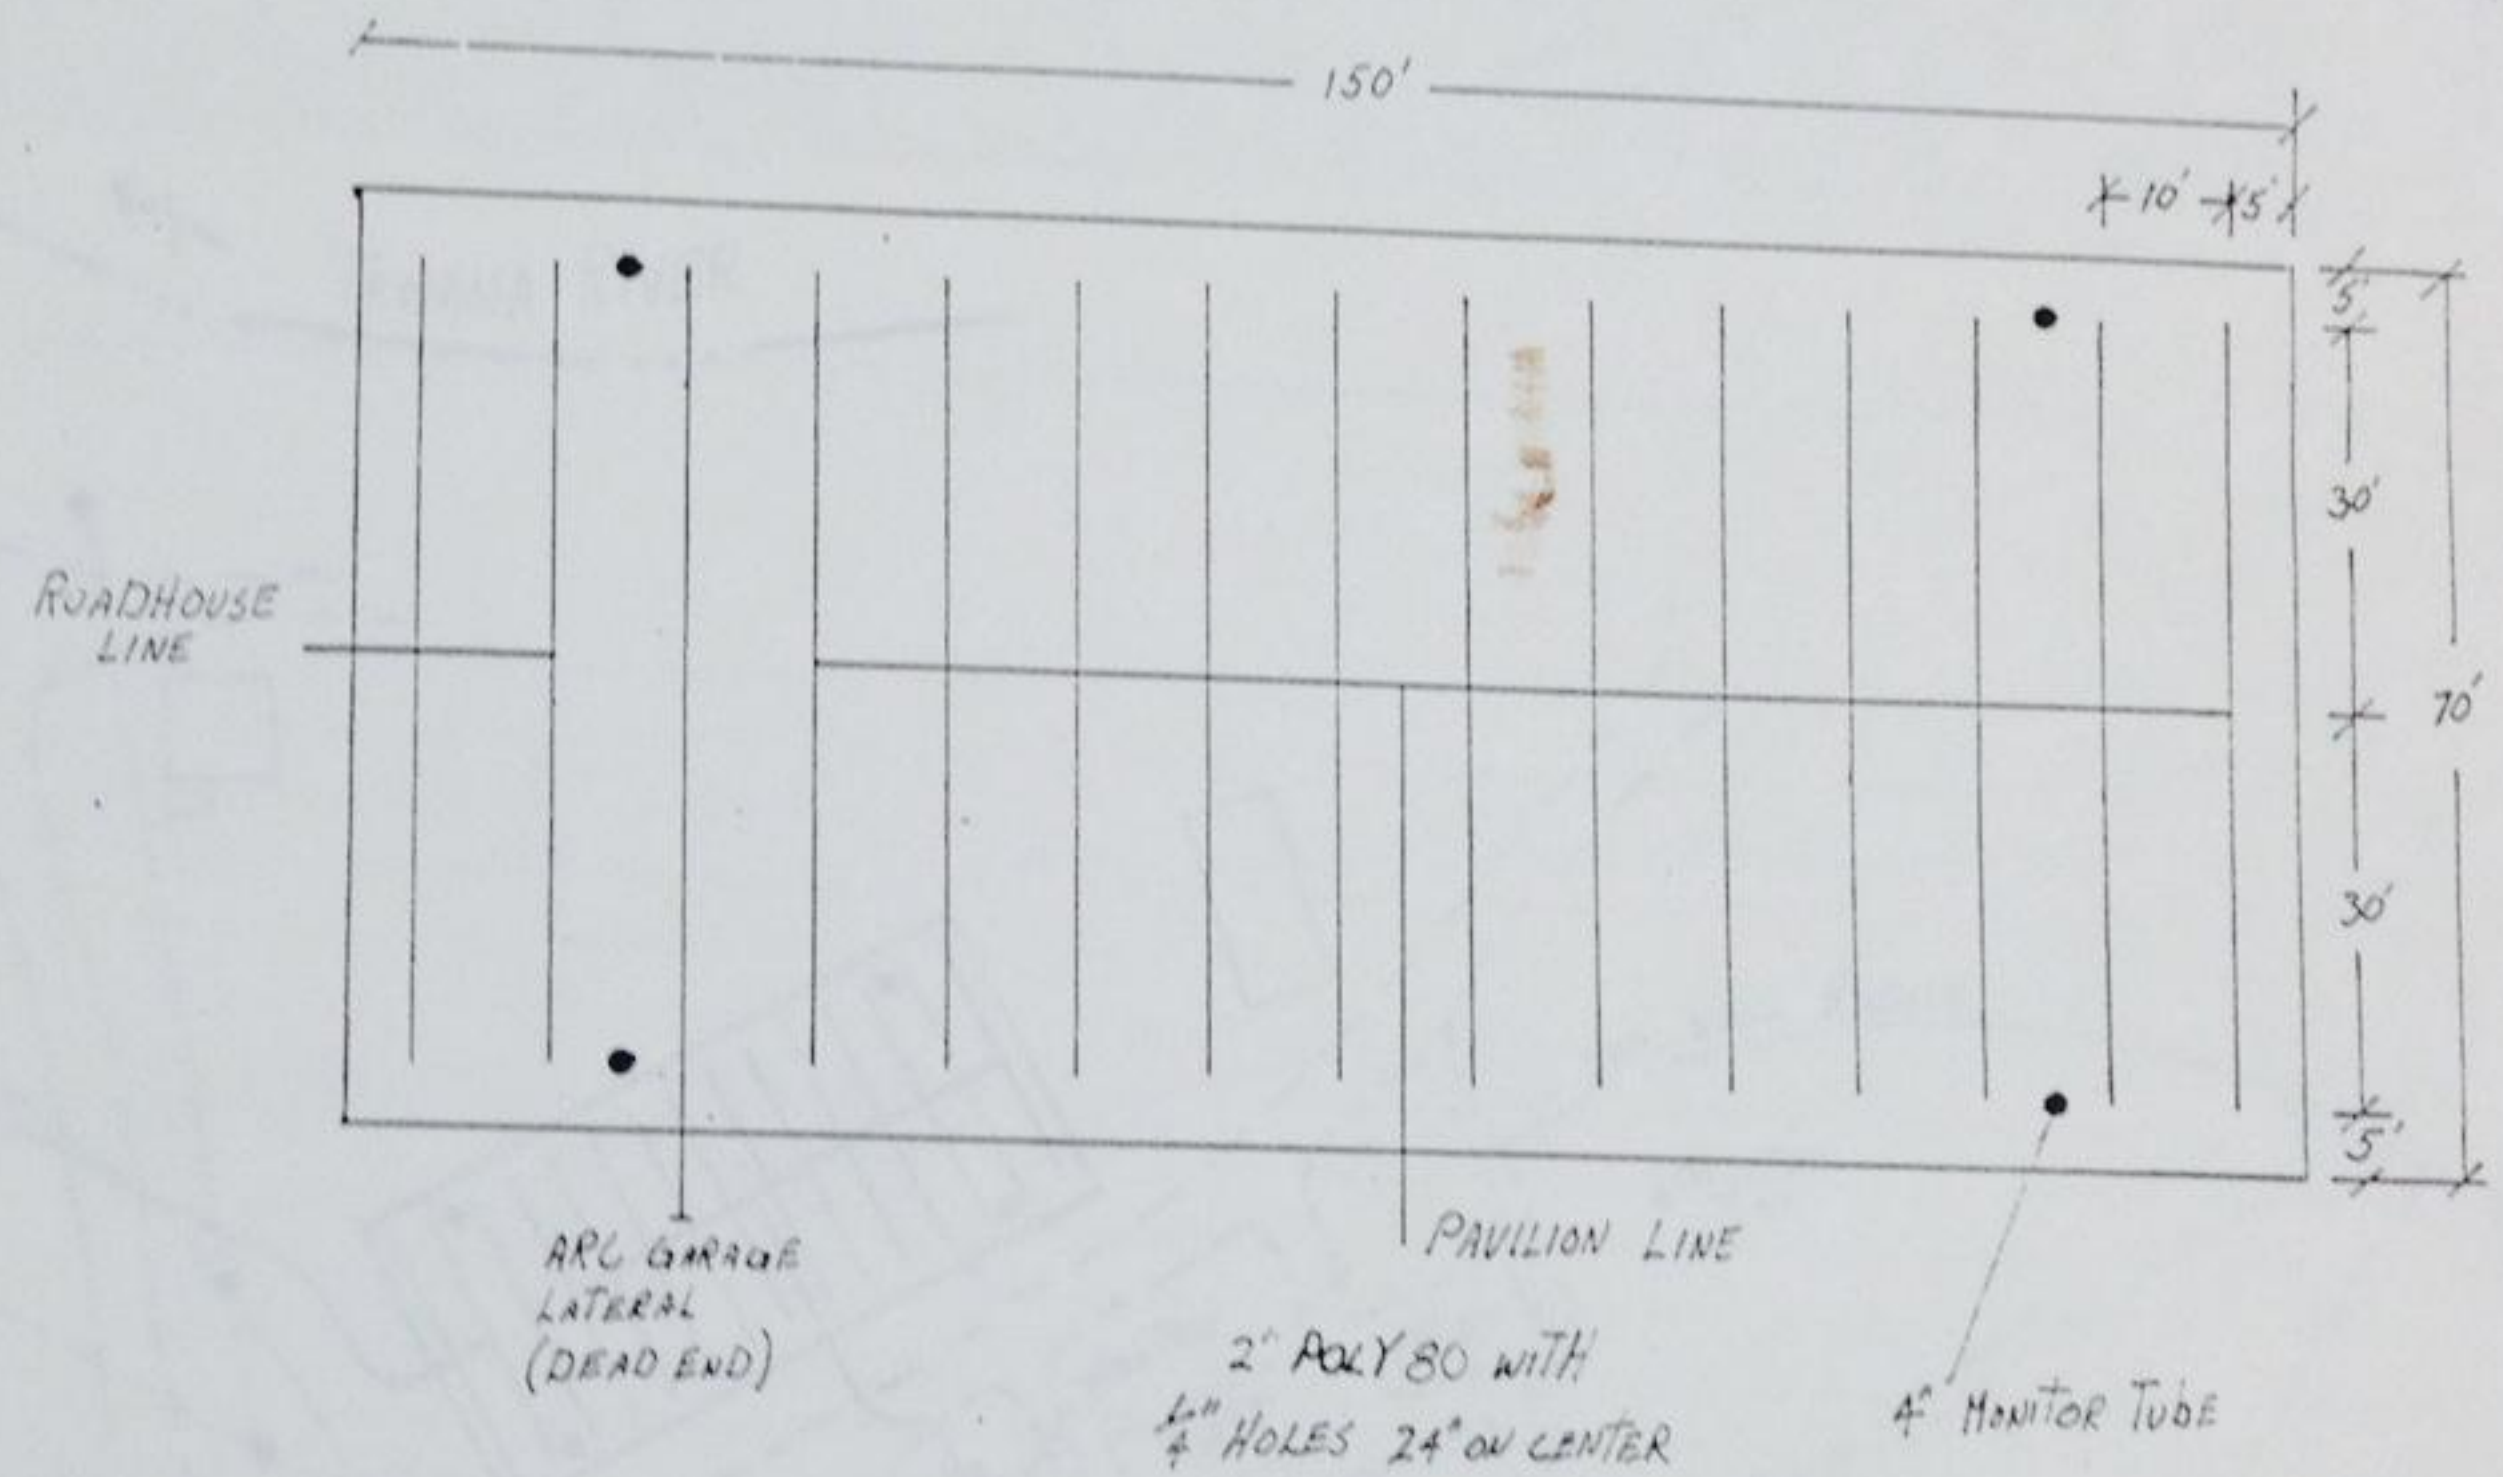

Wastewater Disposal System

DISPOSAL

SCALE
1" = 60'

BIG DELTA
STATE HISTORICAL PARK

DRAWN RG
REVIEWED
DATE NOV 87

SHEET
1
OF