



UPPER HUFFMAN

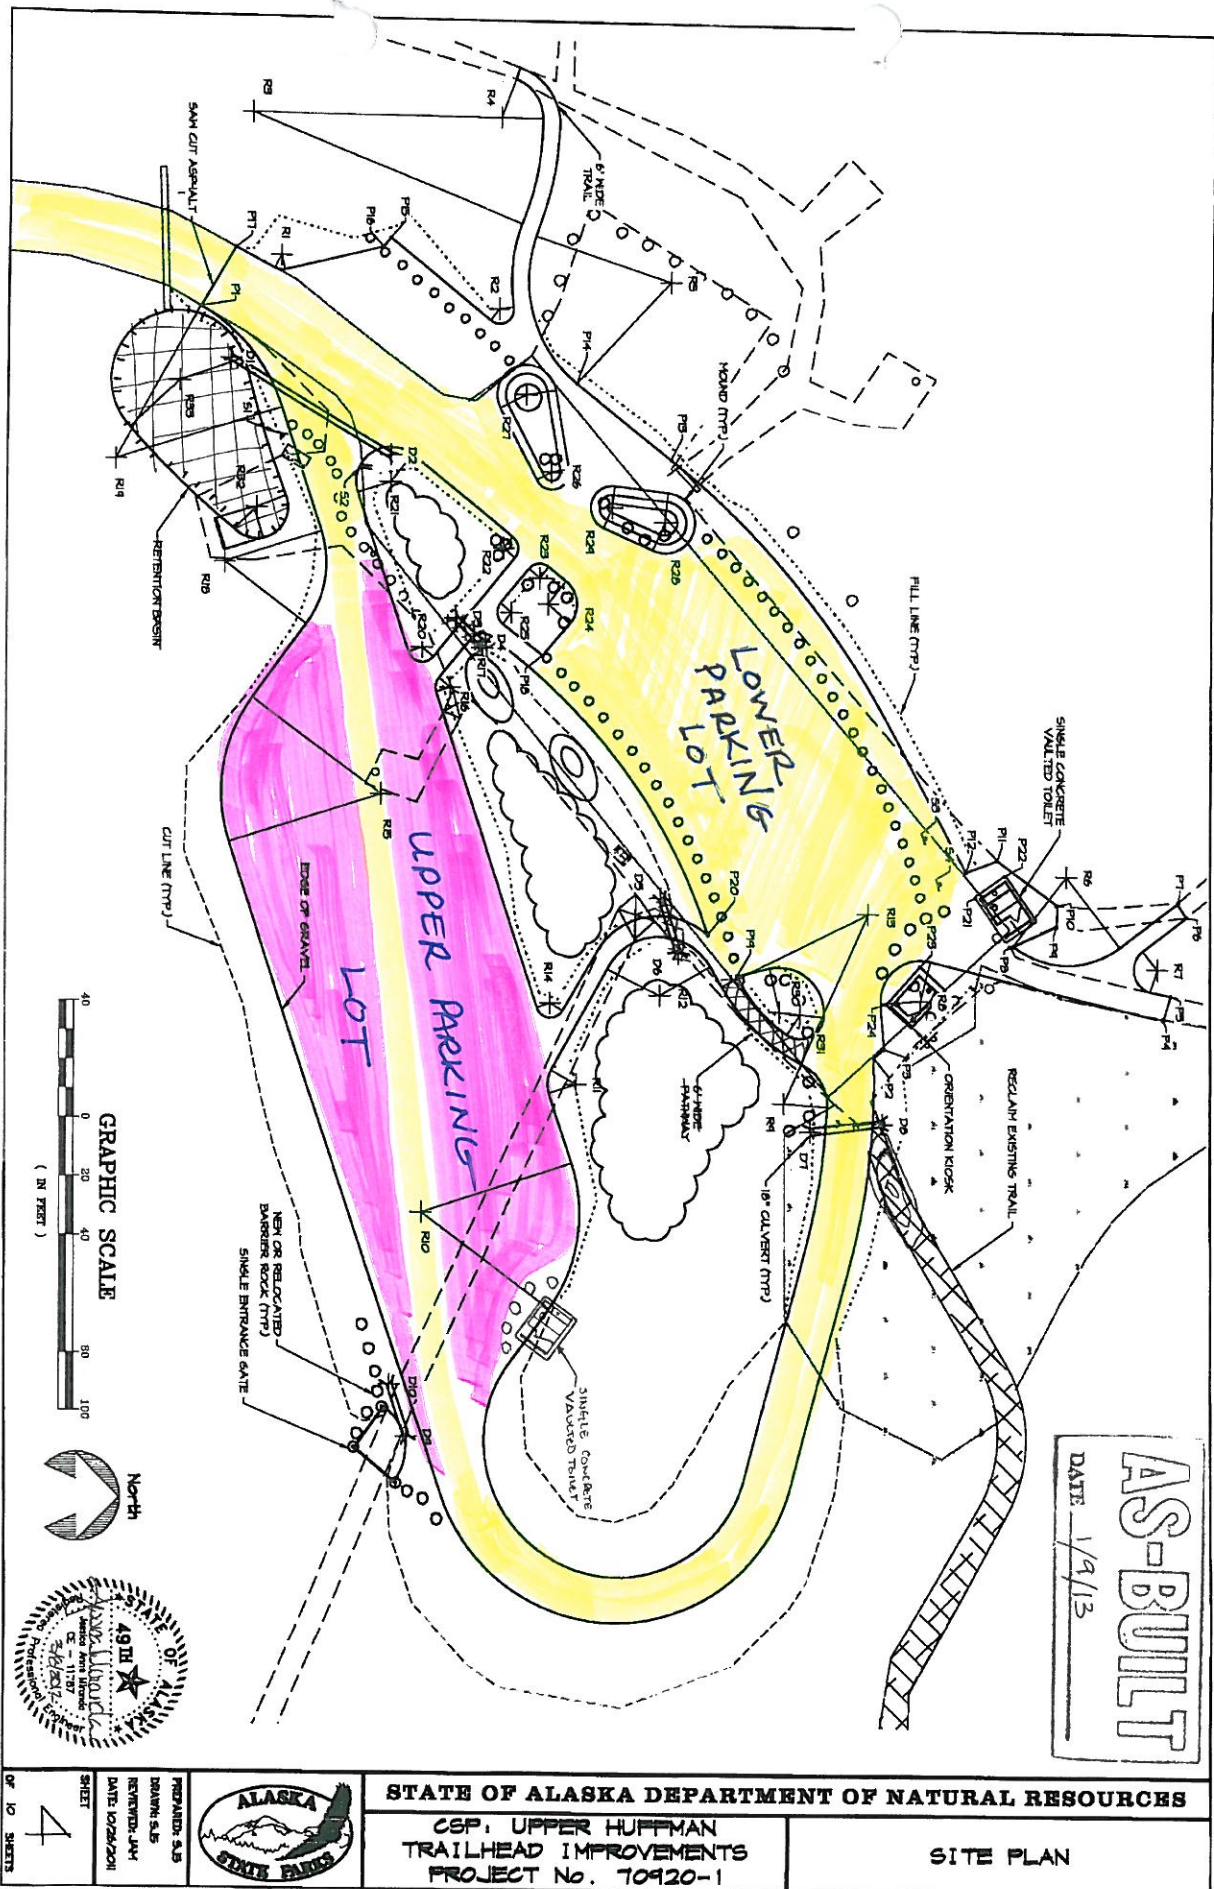

AS-BUILT
DATE 1/9/13

PROSPECT HEIGHTS

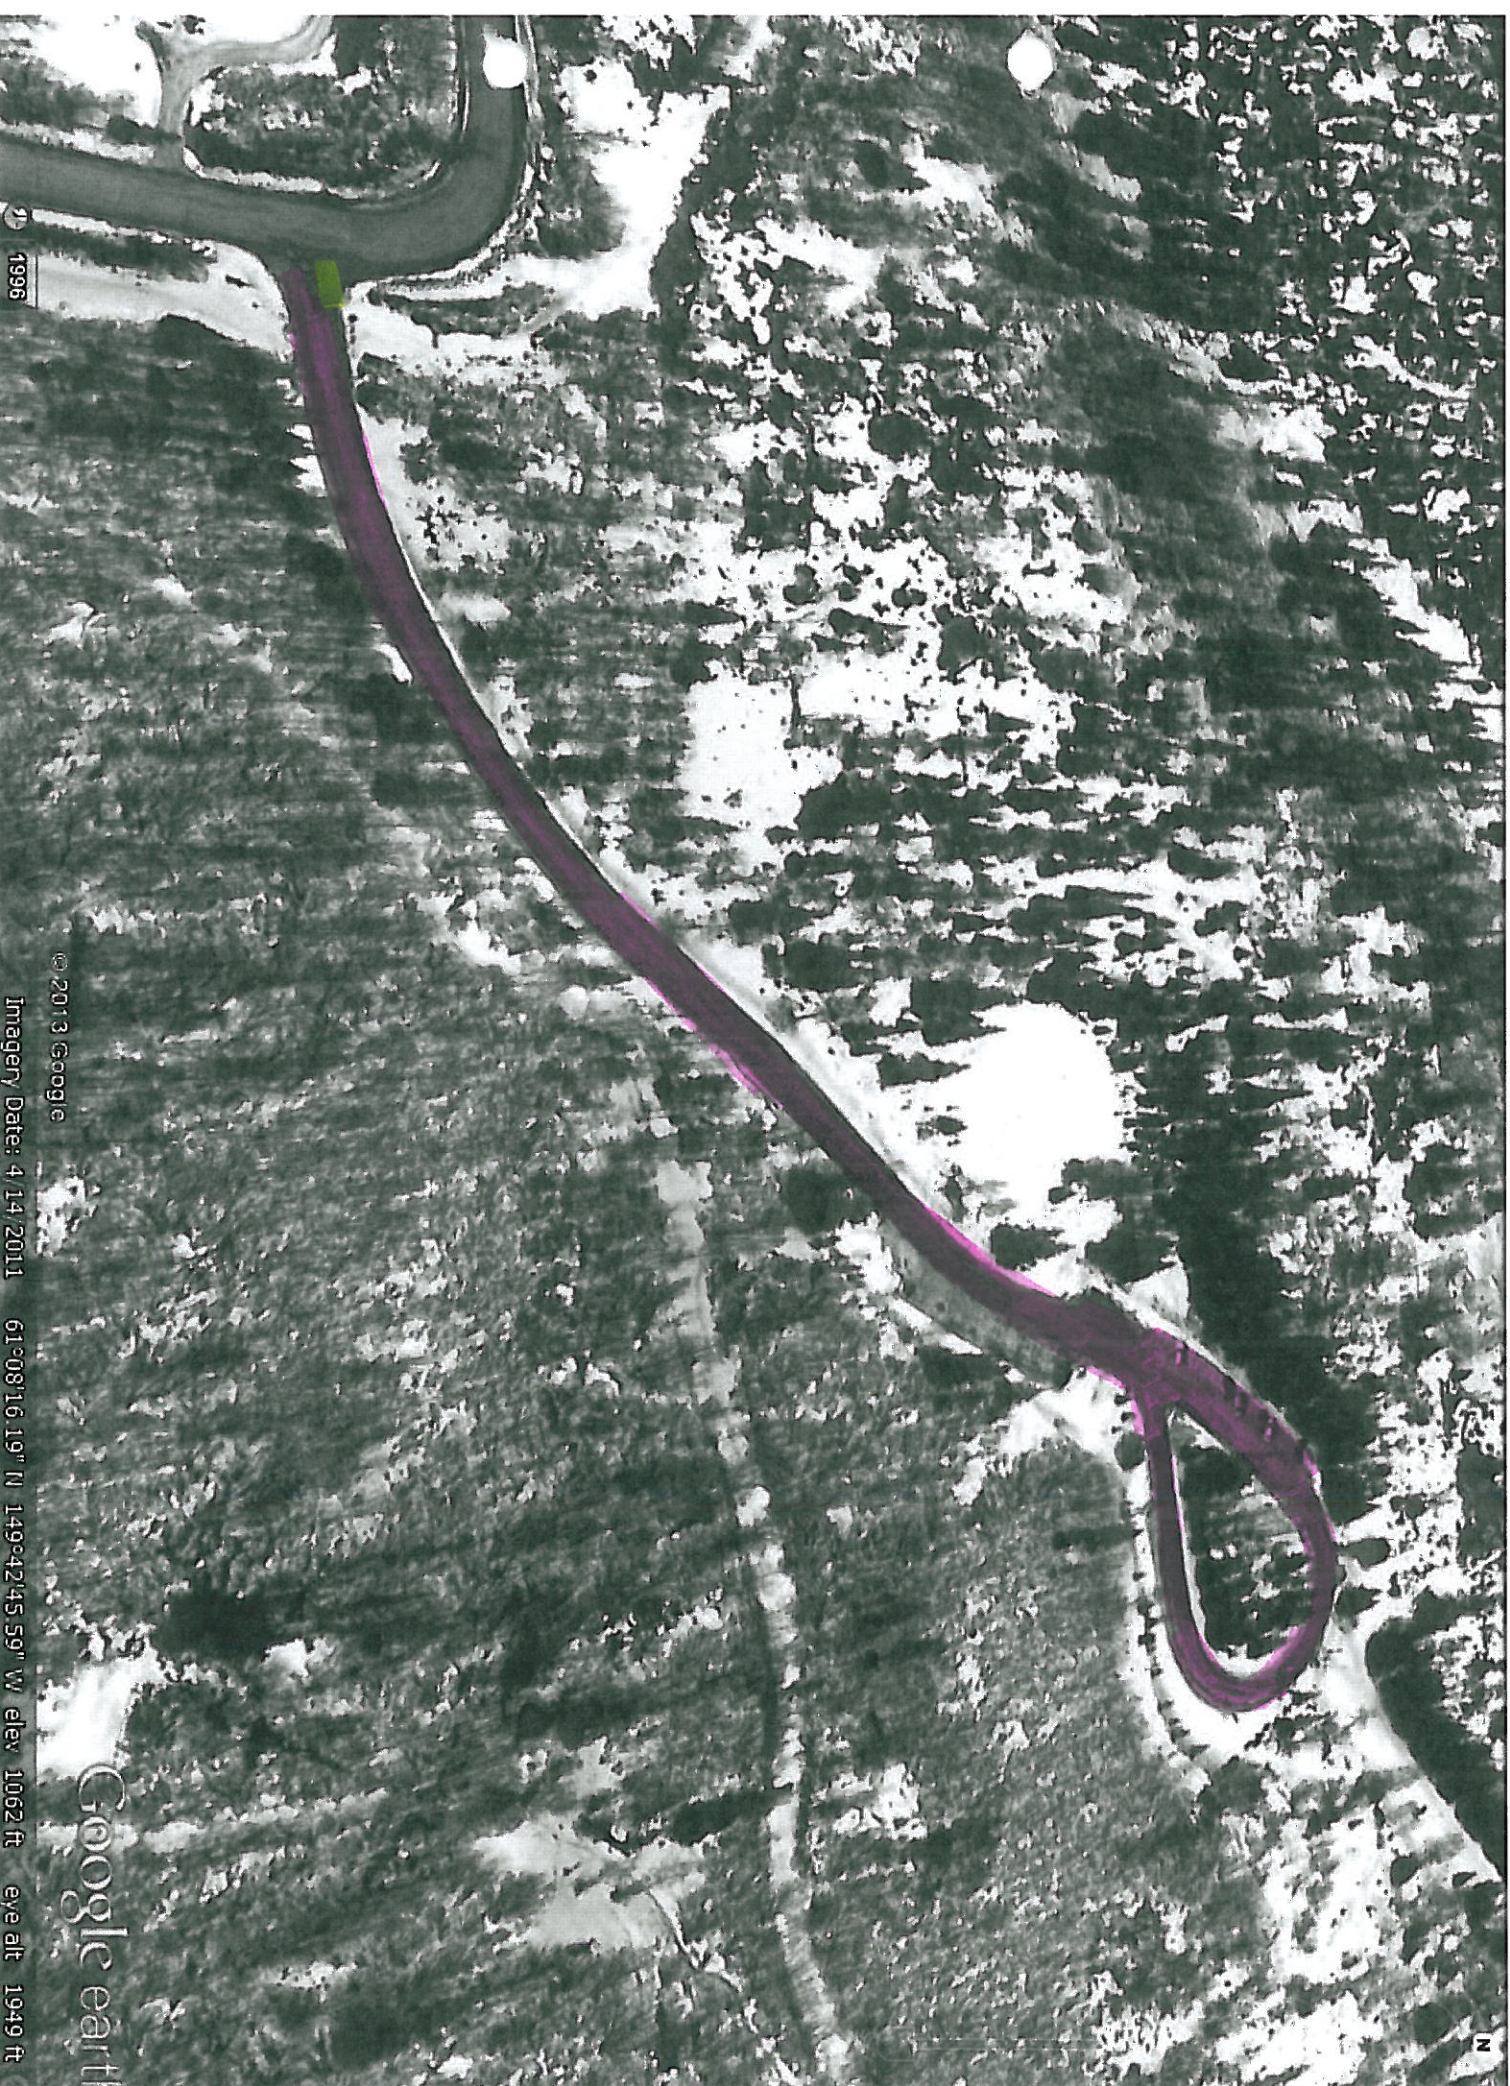

© 2013 Google

Imagery Date: 4/14/2011 61°08'16.19" N 149°42'45.59" W elev 1062 ft eye alt 1949 ft

Google earth

GLEN Alps



1998

©2013 Google

Imagery Date: 4/14/2011 61°06'10.76" N 149°41'03.29" W elev 2194 ft eye alt 2583 ft

Google earth

