



ELEVATION

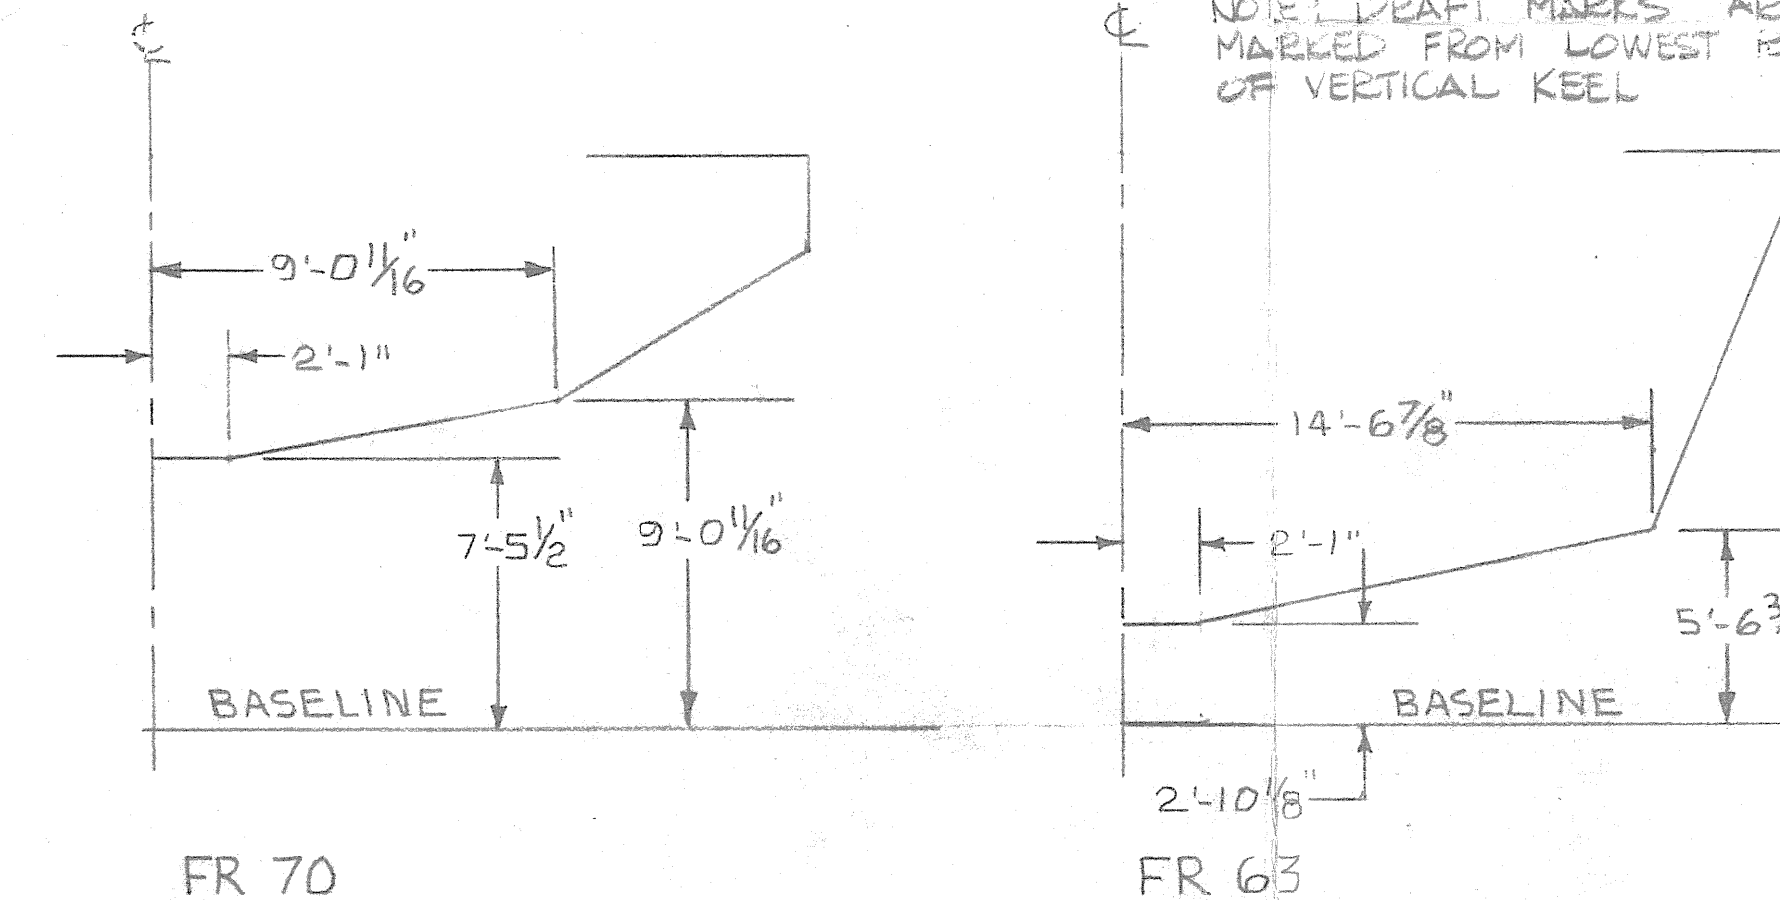


FR 70


FR 63

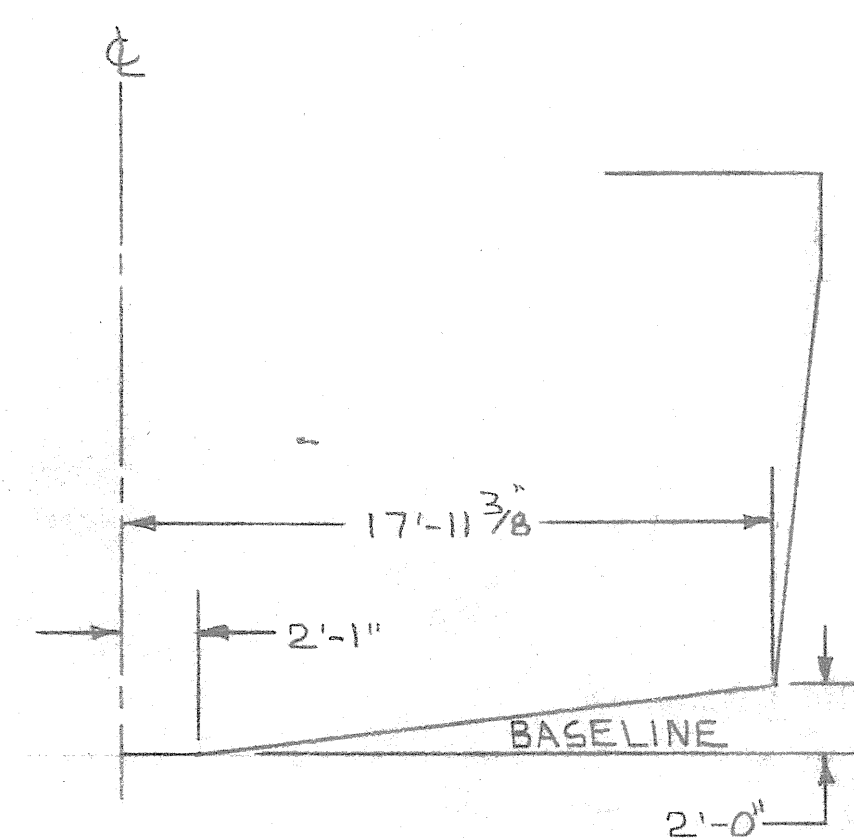


FR 47

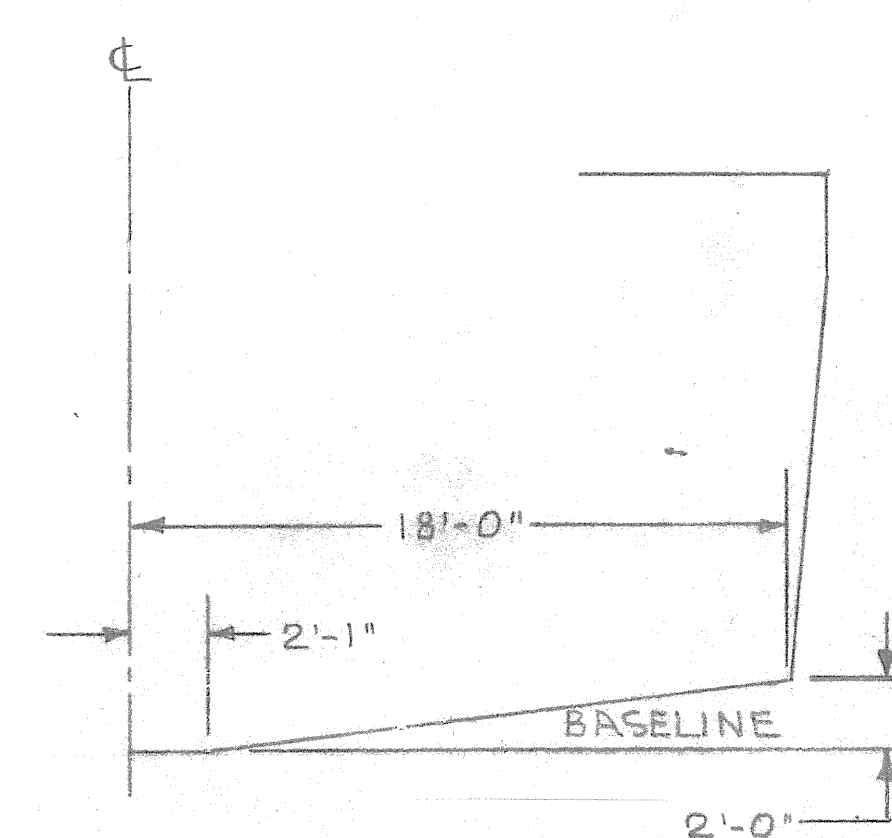


FR 38

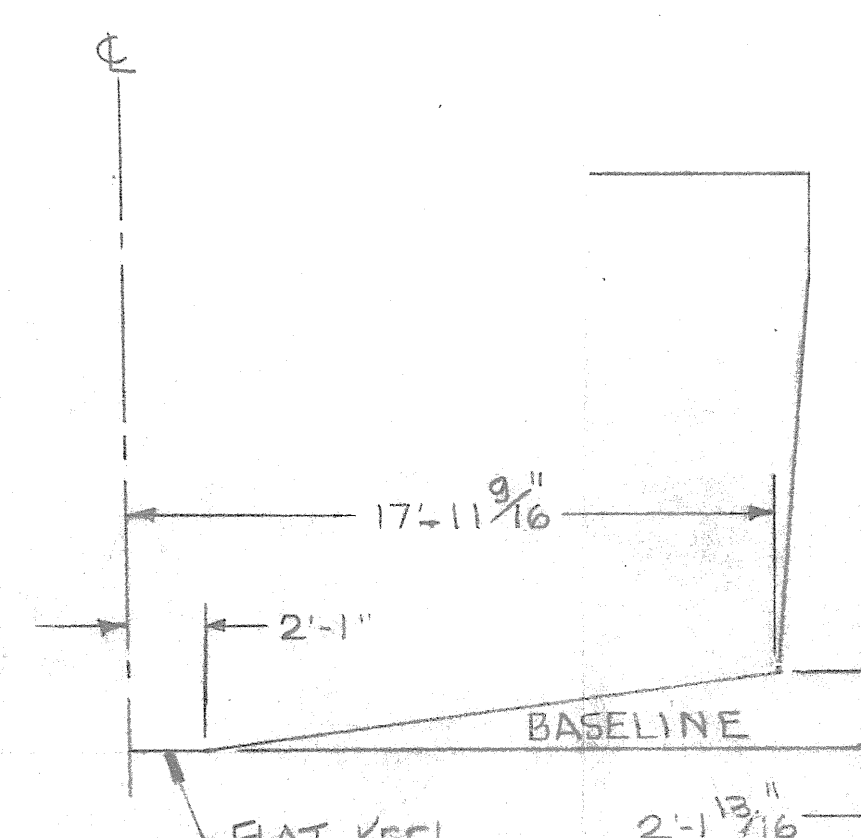

FR 28

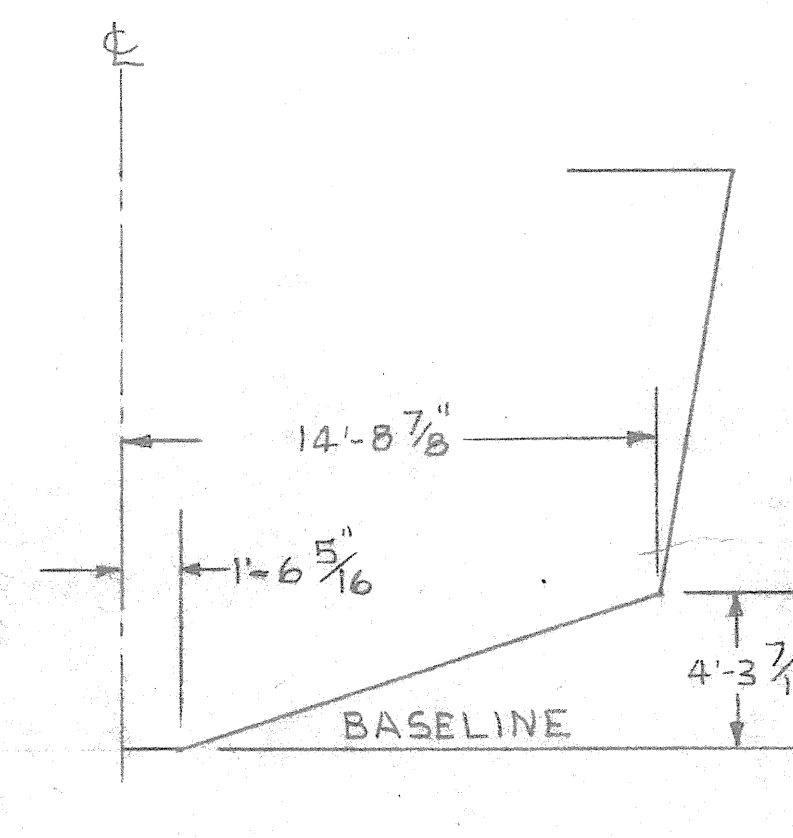

FR 19

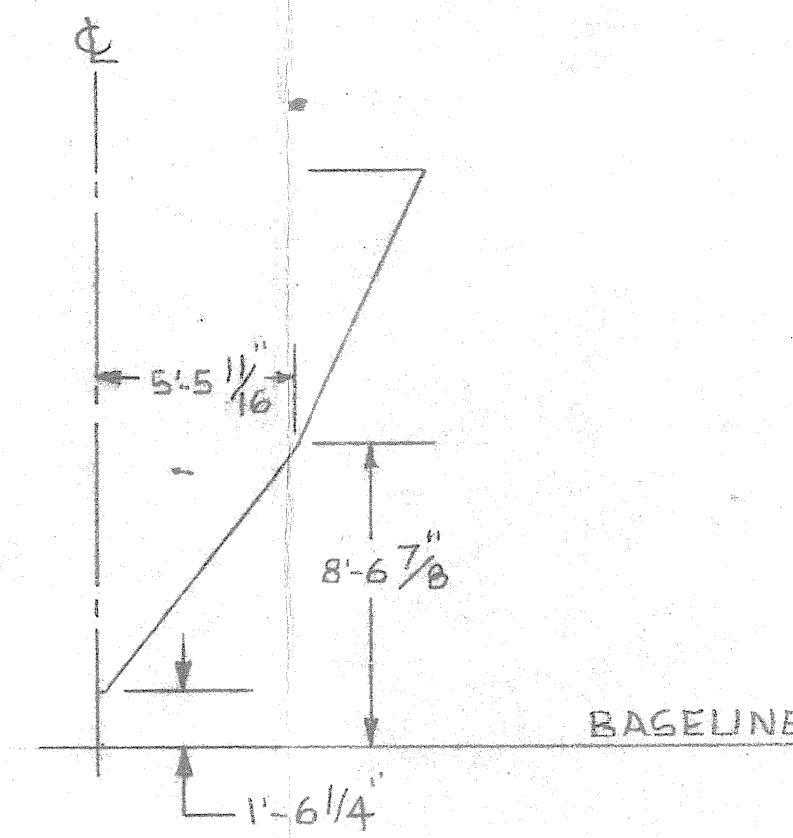

FR 9

A RELOCATED TRANSDUCERS TO SUIT AS-BUILT CONDITION. LEADING EDGE WAS @ FR 33. ENILSON 9-17-91

REVISIONS

This drawing is the exclusive property of Homeport Marine Services, Inc., and is furnished on a confidential basis. No portion of this drawing may be copied, traced, photographed, or in any other way reproduced; nor may any item hereon depicted be manufactured as shown without the written consent of Homeport Marine Services, Inc.. The recipient of the information contained hereon may not disclose the same to any other person or business firm; nor may he use such information except for the specific purpose intended.

156' X 38' X 16" CRAB BOAT

DOCKING PLAN & ANODE LOCATIONS

Homeport Marine Services, Inc.

5807 ELDER FERRY ROAD • POST OFFICE BOX 745
MOSS POINT, MISSISSIPPI 39563 601-475-5633

SCALE 3/16" = 1'-0"

DATE 4-19-91

DRAWN E.R. O'BRIEN

APP'D.

HULL NO. 1119

DWG. NO. D-1