

DEMOLITION PLAN NOTES:

- 1 DEMOLISH LOW SLOPED ROOF ASSEMBLY (IRMA) PER DETAIL 1/A600.
- 2 DEMOLISH DOUBLE LEAF ROOF HATCH.
- 3 DEMOLISH ABANDON FLUE STACK AND CURB AND PATCH METAL ROOF DECKING.
- 4 DEMOLISH UNUSED ANTENNA AND MOUNTING PIPE.
- 5 DEMOLISH ABANDON STEEL STAND.
- 6 DEMOLISH MECHANICAL CURB, MAINTAIN BOILER FLUE STACK DURING ROOF REPLACEMENT.

GENERAL DEMOLITION LEGEND:

- ITEMS OR PORTIONS THERE OF TO BE DEMOLISHED
- _____ ITEMS TO REMAIN
- (E) ROOF DRAINS TO BE DEMOLISHED AND REPLACED WITH NEW JR SMITH MODEL #2005 OF SIMILAR SIZE WITH CAST IRON DOME STRAINER.
- [Pattern] CONCRETE PAVERS AND ROOF ASSEMBLY TO BE DEMOLISHED

RENOVATION PLAN NOTES:


- 1 NEW ROOF HATCH SAFETY RAIL SYSTEM
- 2 NEW 9'-0" x 9'-0" DOUBLE LEAF ROOF HATCH
- 3 PROVIDE NEW ROOF ACCESS LADDER WITH CAGE, SEE DETAIL 11/A600.

GENERAL CONSTRUCTION LEGEND:

- [Pattern] AREAS OF FLAT BOARD INSULATION, AS METAL ROOF DECKING IS SLOPED.
- [Pattern] TAPERED INSULATION FOR SLOPE TO DRAIN

GENERAL CONSTRUCTION NOTES:



- 1. CONTRACTOR TO VERIFY ALL EXISTING CONDITIONS.
- 2. CONTRACTOR TO NOTIFY THE OWNER & ARCHITECT OF ANY DISCREPANCIES TO AS-BUILT CONDITIONS.
- 3. CONSTRUCTION IS TO BE IN COMPLIANCE WITH ALL LOCAL AND FEDERAL BUILDING REQUIREMENTS.

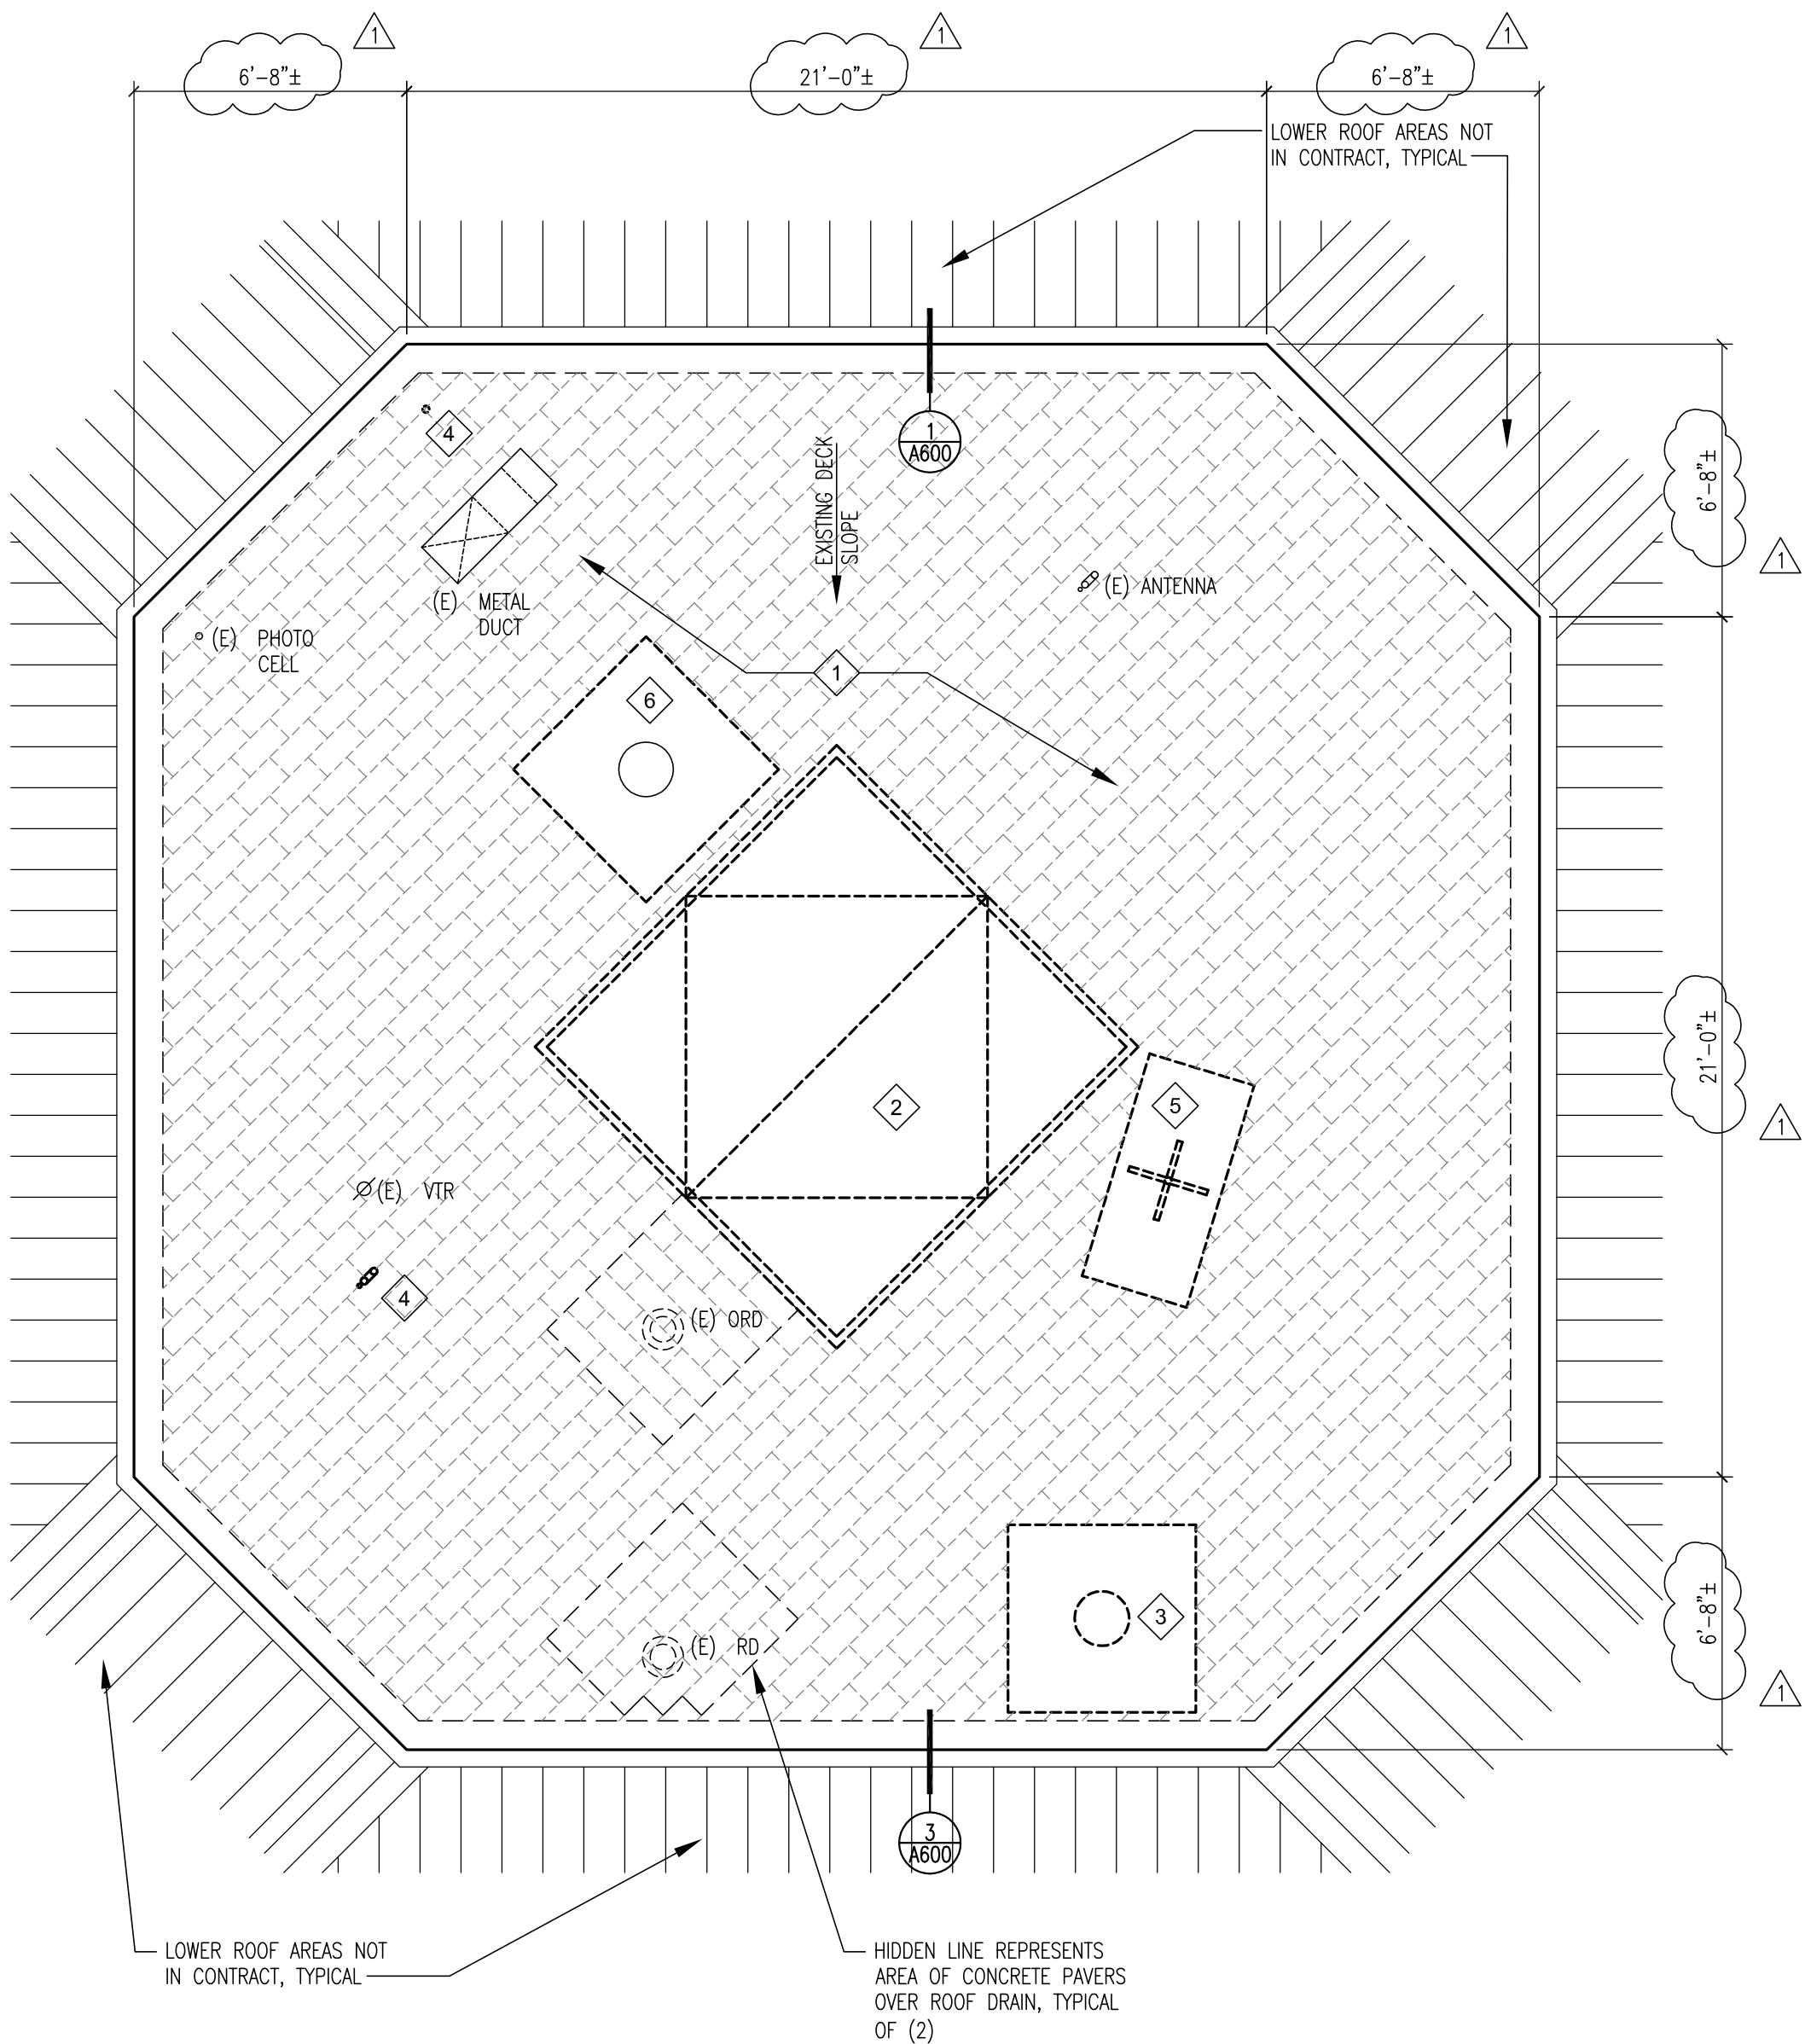

1
A100

DEMOLITION ROOF PLAN


SCALE: 1/4" = 1'-0"

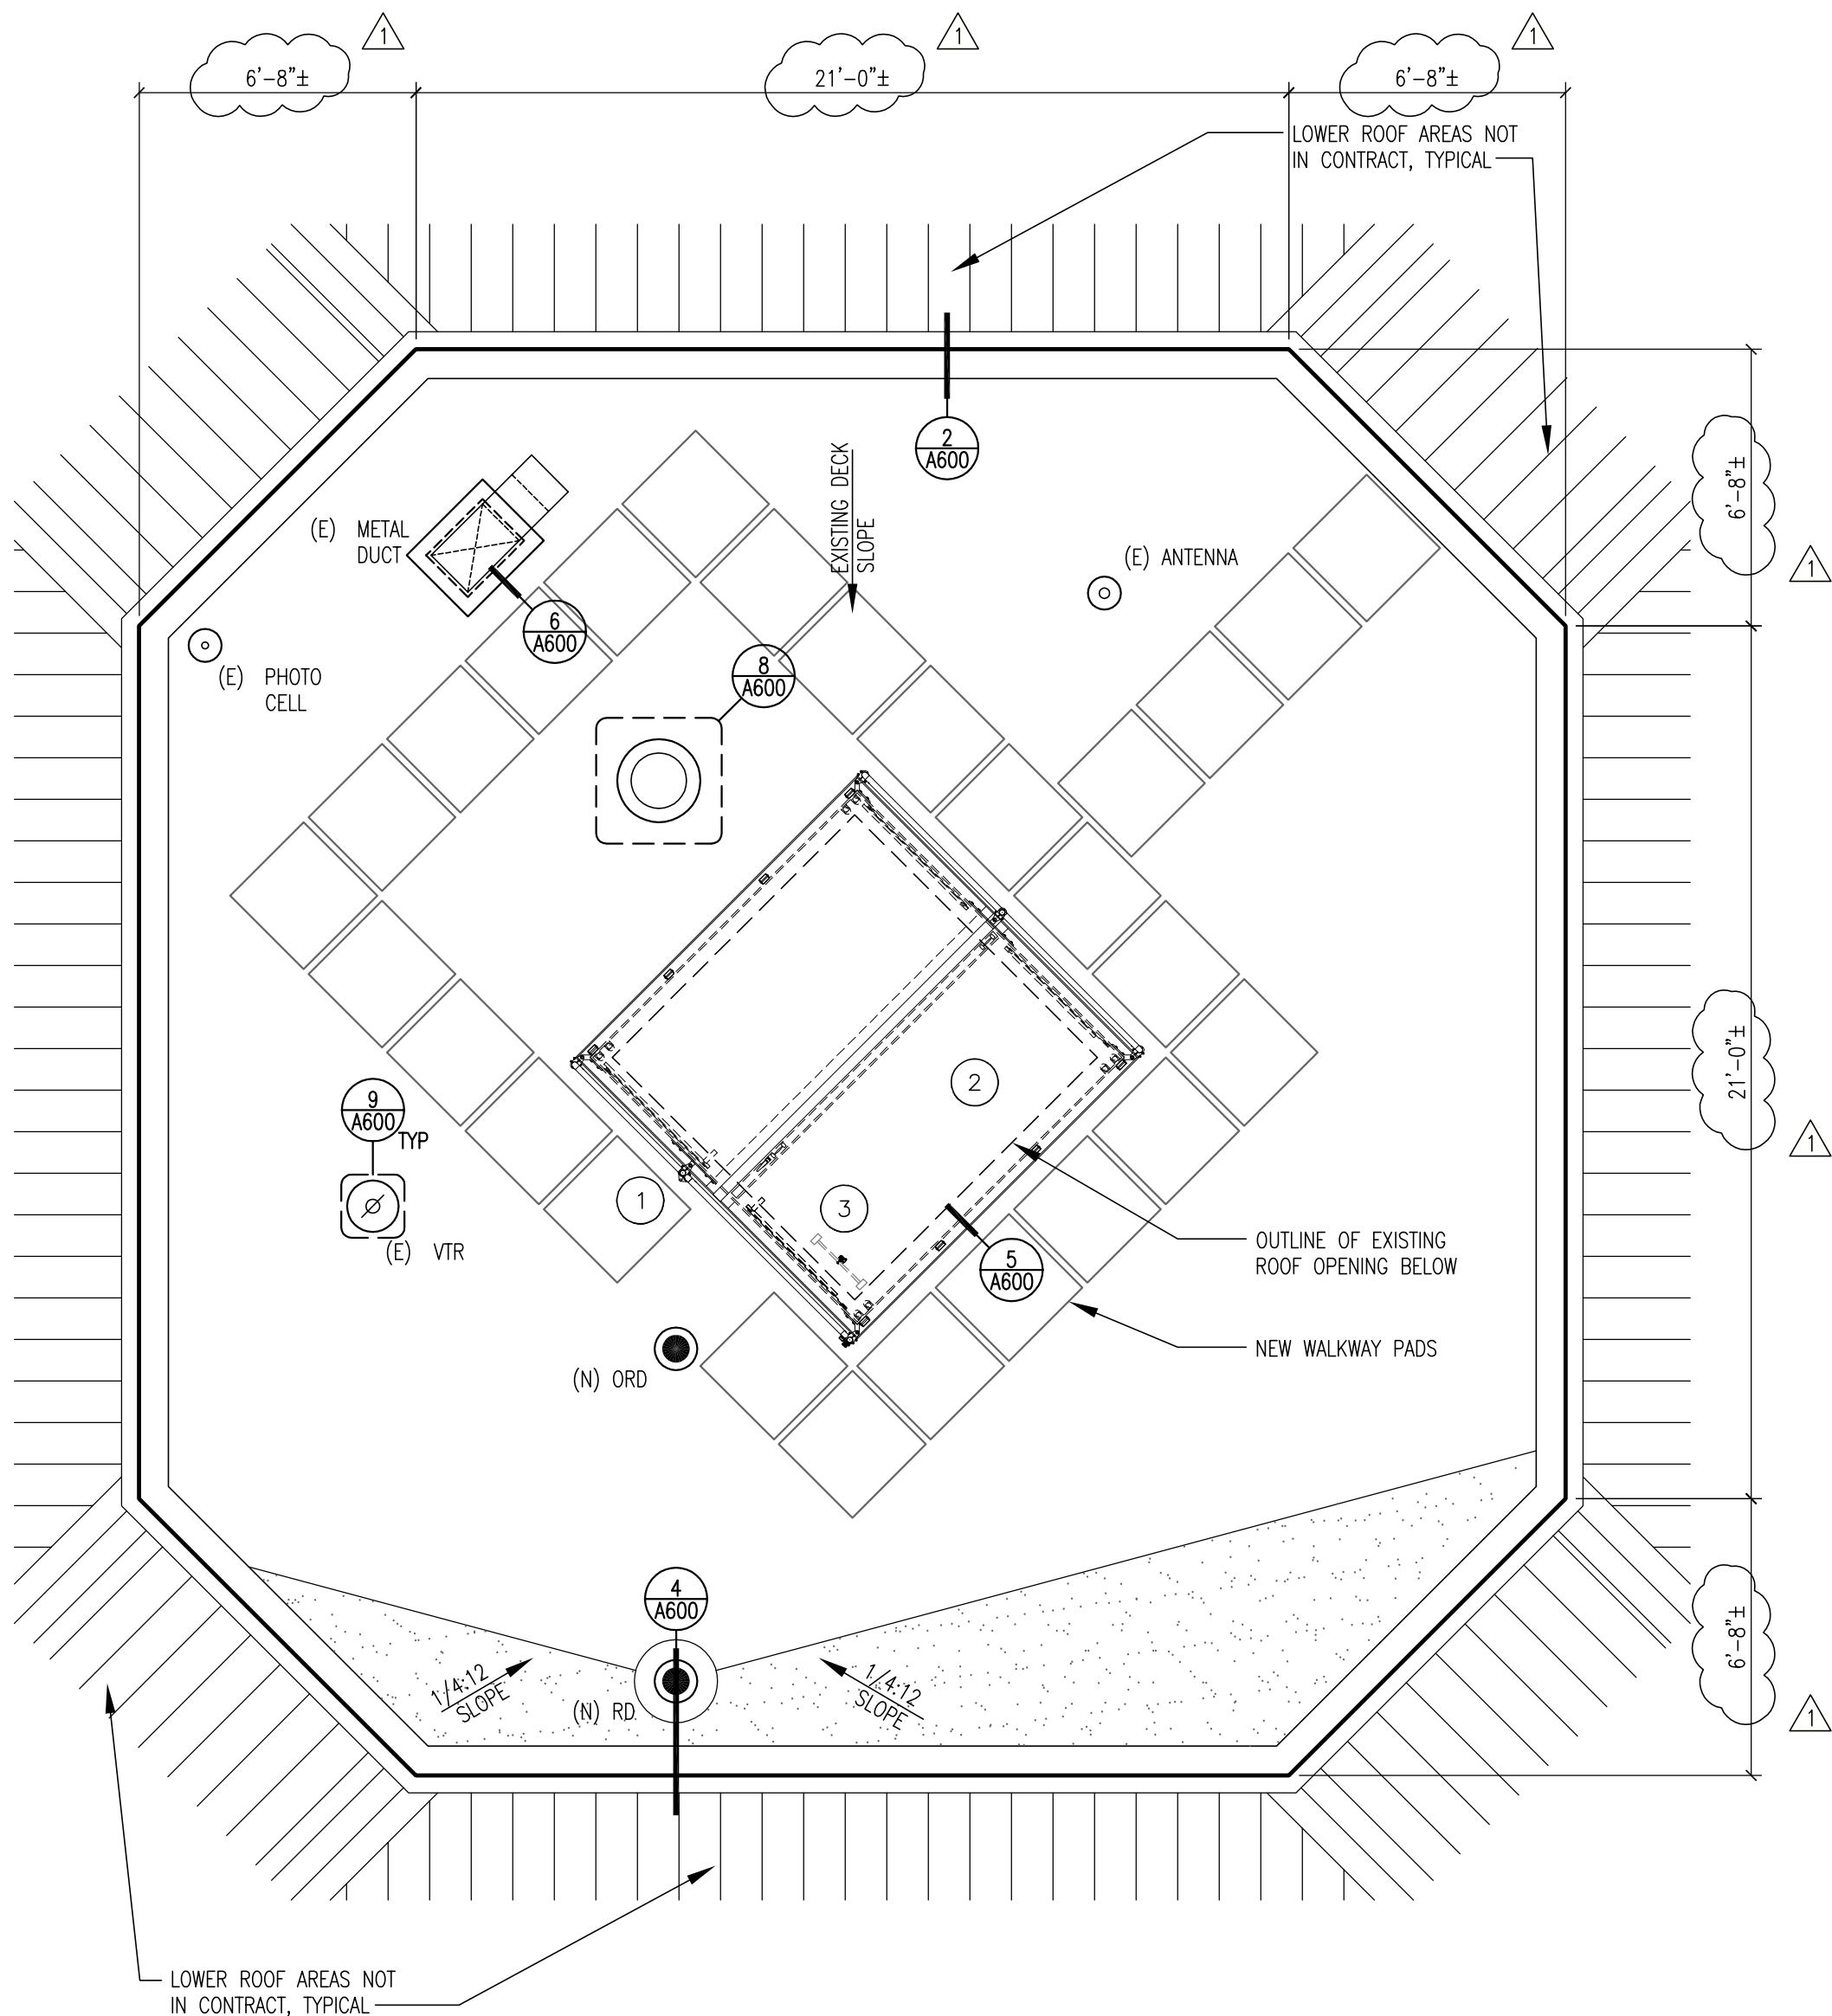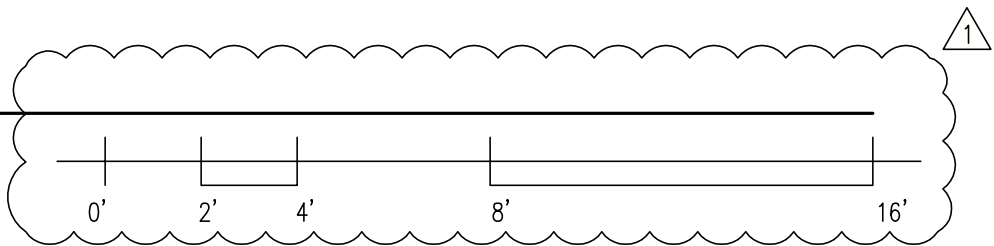

2
A100

RENOVATED ROOF PLAN

SCALE: 1/4" = 1'-0"

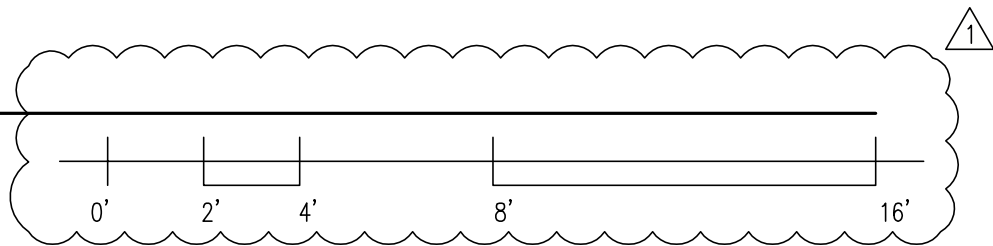

MAT-SU PRE-TRIAL FACILITY -
ROOF REPLACEMENT

(DOC PROJ NO. 180004374)

DEPARTMENT OF TRANSPORTATION AND PUBLIC FACILITIES
339 EAST DOGWOOD AVENUE, PALMER, ALASKA 99645-

100% CONSTRUCTION DOCUMENTS

CONSULTANT:

INSTRUCTION

PROJECT NO: 18-154

DATE: 07/3/2018


DRAWN BY: JLL

CHECKED BY: RR

Symbol	Description	Date
△	ADDENDUM #1	07/06/2018

ROOF PLANS

A100

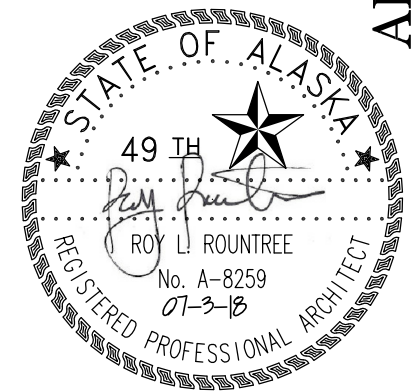

ARCHITECT: BETTISWORTH NORTH
2600 DENALI STREET SUITE 710 ANCHORAGE ALASKA 99503 (907) 561-5780
212 FRONT STREET FAIRBANKS, ALASKA 99701 (907) 456-5780
CORPORATE NO. AECC219 WWW.BETTISWORTHNORTH.COM