

FILE g:\Marine\Angoon\Ang - apron lift beam replacement\Drawings\PLANSET\01_Title Sheet.dwg DATE 11/21/2019 8:20 LAYOUT 1 DESIGNED STAFF CHECKED STAFF DRAFTED STAFF


STATE OF ALASKA

DEPARTMENT OF TRANSPORTATION & PUBLIC FACILITIES

ANGOON FERRY TERMINAL

APRON REPAIRS

PROJECT NO. Z73221000

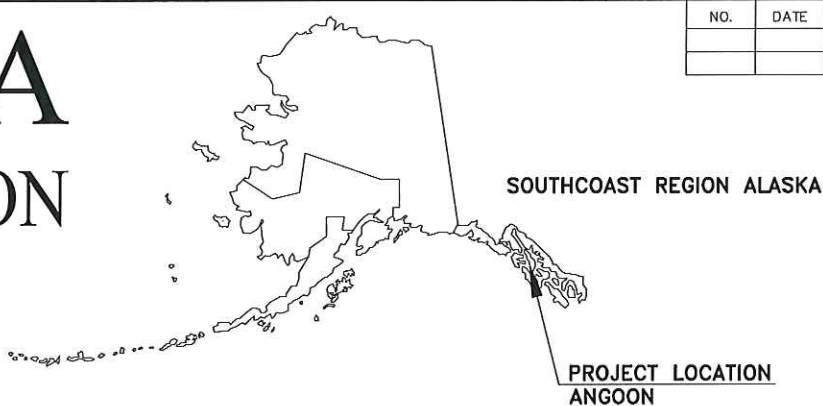


NO.	DATE	REVISIONS	STATE	PROJECT DESIGNATION	YEAR	SHEET NO.	TOTAL SHEETS
			ALASKA	Z73221000	2019	1	7

SHEET INDEX	
SHEET NO.	DESCRIPTION
GENERAL	
1	TITLE SHEET
2	EXISTING SITE PLAN
3	FLOAT AND PLATFORM LAYOUT
4	RAMP PLAN & ELEVATIONS
5	RAMP & APRON LIFT FRAMING
6	APRON LIFT DETAILS
7	EXISTING CONDITIONS PHOTOS

NOTES:

1. THIS PLANSET WAS DEVELOPED USING THE EXISTING AS-BUILT DRAWINGS AND ALL NOTES, SHEET OR DETAIL REFERENCES, ETC. DO NOT APPLY. NEW WORK OR MODIFICATIONS FOR THIS PROJECT ARE SHOWN IN RED.
2. REFERENCE AS-BUILT AND SHOP FABRICATION DRAWINGS & SPECIFICATIONS FOR ADDITIONAL DETAILS & WORK REQUIREMENTS NOT INDICATED.

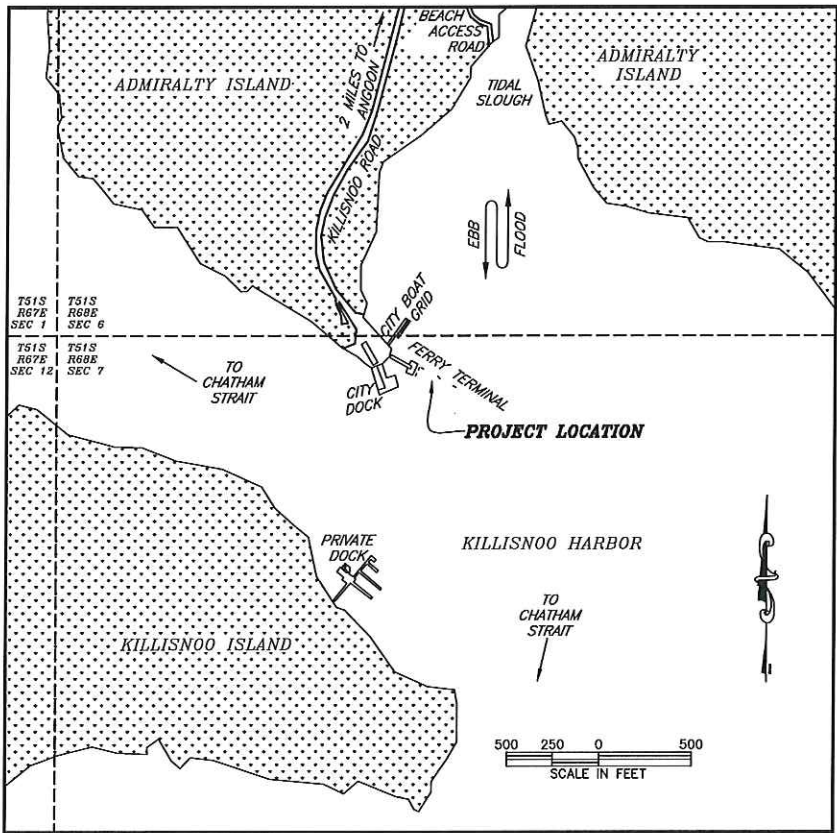

VICINITY MAP



EXISTING TERMINAL SITE

TIDAL DATA (ft)	
EHW	+19.0
MHHW	+14.1
MHW	+13.2
MTL	+7.4
MLW	+1.6
MLLW	0.0
ELW	-5.5

USE THESE PLANS IN CONJUNCTION WITH THE STATE OF ALASKA STANDARD SPECIFICATIONS FOR HIGHWAY CONSTRUCTION, 2017 EDITION AND THE PROJECT SPECIAL PROVISIONS.

STATE OF ALASKA
DEPARTMENT OF TRANSPORTATION & PUBLIC FACILITIES
6860 GLACIER HIGHWAY, JUNEAU, AK 99801
(907) 465-1763

APPROVED:

KIRK MILLER, P.E.
DESIGN GROUP CHIEF

11/21/19
DATE


CONCUR:

D. LANCE MEARIG, P.E.
DIRECTOR, SOUTHCOAST REGION

21 Nov 2019
DATE

FILE Q:\Marine\Angoon\Ang - apron lift beam replacement\Drawings\PLANSET\02 Site Plan.dwg DATE 11/21/2019 11:11 LAYOUT 2 DESIGNED STAFF CHECKED STAFF DRAFTED STAFF

NO.	DATE	REVISION	STATE	PROJECT DESIGNATION	YEAR	SHEET NO.	TOTAL SHEETS
			ALASKA	Z73221000	2019	2	7

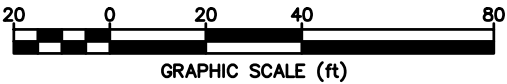

Field-Located STA 5+00

Center of shoreward bearing beam swivel pin = STA 5+00
℄ bearing = S 61°46'35" E
= ℄ new bridge, ramp, apron, & float

A.T.S. 1017
TRACT B
LESSEE:
CITY OF ANGOON

New bridge head gate, see sheet 8
Additional riprap to be placed, see sheet 8

New intermediate ramp, see sheet 28
New float access platform, see sheet 24
New skiff fenders, see sheet 43

N1

Center King Pile
STA 6+15.28 LT 24.95

N2

Center King Pile
STA 6+64.21 LT 33.88

N3

Center of Dolphin
STA 6+91.50 LT 35.75

A.T.S. 1026
TRACT B
STATE OF ALASKA

LOCATION OF WORK

New structure N5 intentionally set 6" off line from other dolphins to accommodate sponsons of LeConte, Lituya, and IFA.

N4

Center King Pile
STA 7+46.00 LT 34.40

N5

Center King Pile
STA 7+93.00 LT 34.90

N6

Center King Pile
STA 8+30.00 LT 34.40

N7

Center of Dolphin, see Sheet 49
STA 8+88.00 LT 35.75

S1

Center King Pile
STA 6+15.28 RT 25.00

New float restraint collars, see sheets 41 & 42, typ.

New transfer bridge, see sheet 10

Existing abutment to remain

S2

Center King Pile
STA 6+64.21 RT 33.88

New bridge float assembly, see sheet 22

S3

Center King Pile
STA 6+92.50 RT 38.90

New stern fenders, see sheets 44-46, typ.

New fender dolphins, see sheet 54

New floating fender dolphin, see sheet 48

A.T.S. 1017
TRACT A
LESSEE:
CITY OF ANGOON

℄ Project
℄ Structure S3

A.T.S. 1026
TRACT A
STATE OF ALASKA
FERRY TERMINAL

New floating lead-in dolphin, see sheet 49

Existing city dock outside of project limits

NOTE:

AMHS IS SCHEDULING FERRY SERVICE TO ANGOON UTILIZING THE MV TAZLINA ON DECEMBER 13 AND 15. AMHS WILL BE UTILIZING TEMPORARY MEANS TO RAISE AND LOWER THE APRON. CONTRACTOR WILL NOT BE PERMITTED TO HINDER THESE SCHEDULED FERRY ARRIVALS, LOADING AND DEPARTURE OPERATIONS.

PROJECT SCOPE:

- RAISE & SECURE APRON IN "UP" POSITION.
- REMOVE APRON LIFT ASSEMBLY.
- FURNISH & INSTALL NEW APRON LIFT ASSEMBLY.
- INSTALL STATE-FURNISHED APRON LIFT CYLINDERS.
- RECOMMISSION ELECTRICAL CONTROL SYSTEM & RESTORE APRON OPERATION.

LEGEND:

NEW FIELD WORK ITEMS





STATE OF ALASKA DEPARTMENT OF TRANSPORTATION AND PUBLIC FACILITIES
6860 GLACIER HIGHWAY, JUNEAU, AK 99801
(907) 465-1763

ANGOON FERRY TERMINAL
APRON REPAIRS

EXISTING
SITE PLAN

DRAWING SCALES ARE FOR FULL-SIZE SHEETS. USE DIMENSIONS WHEN SCALE NOT SHOWN.

NO.	DATE	REVISION	STATE	PROJECT DESIGNATION	YEAR	SHEET NO.	TOTAL SHEETS
				273221000	2019	3	7

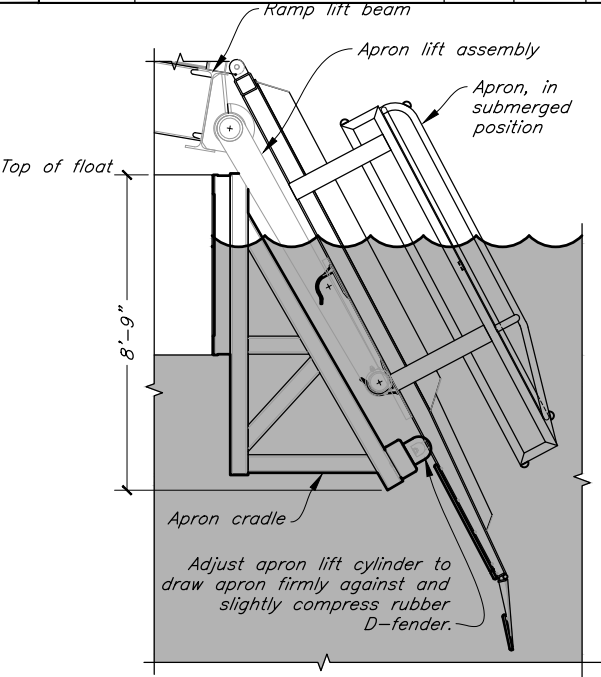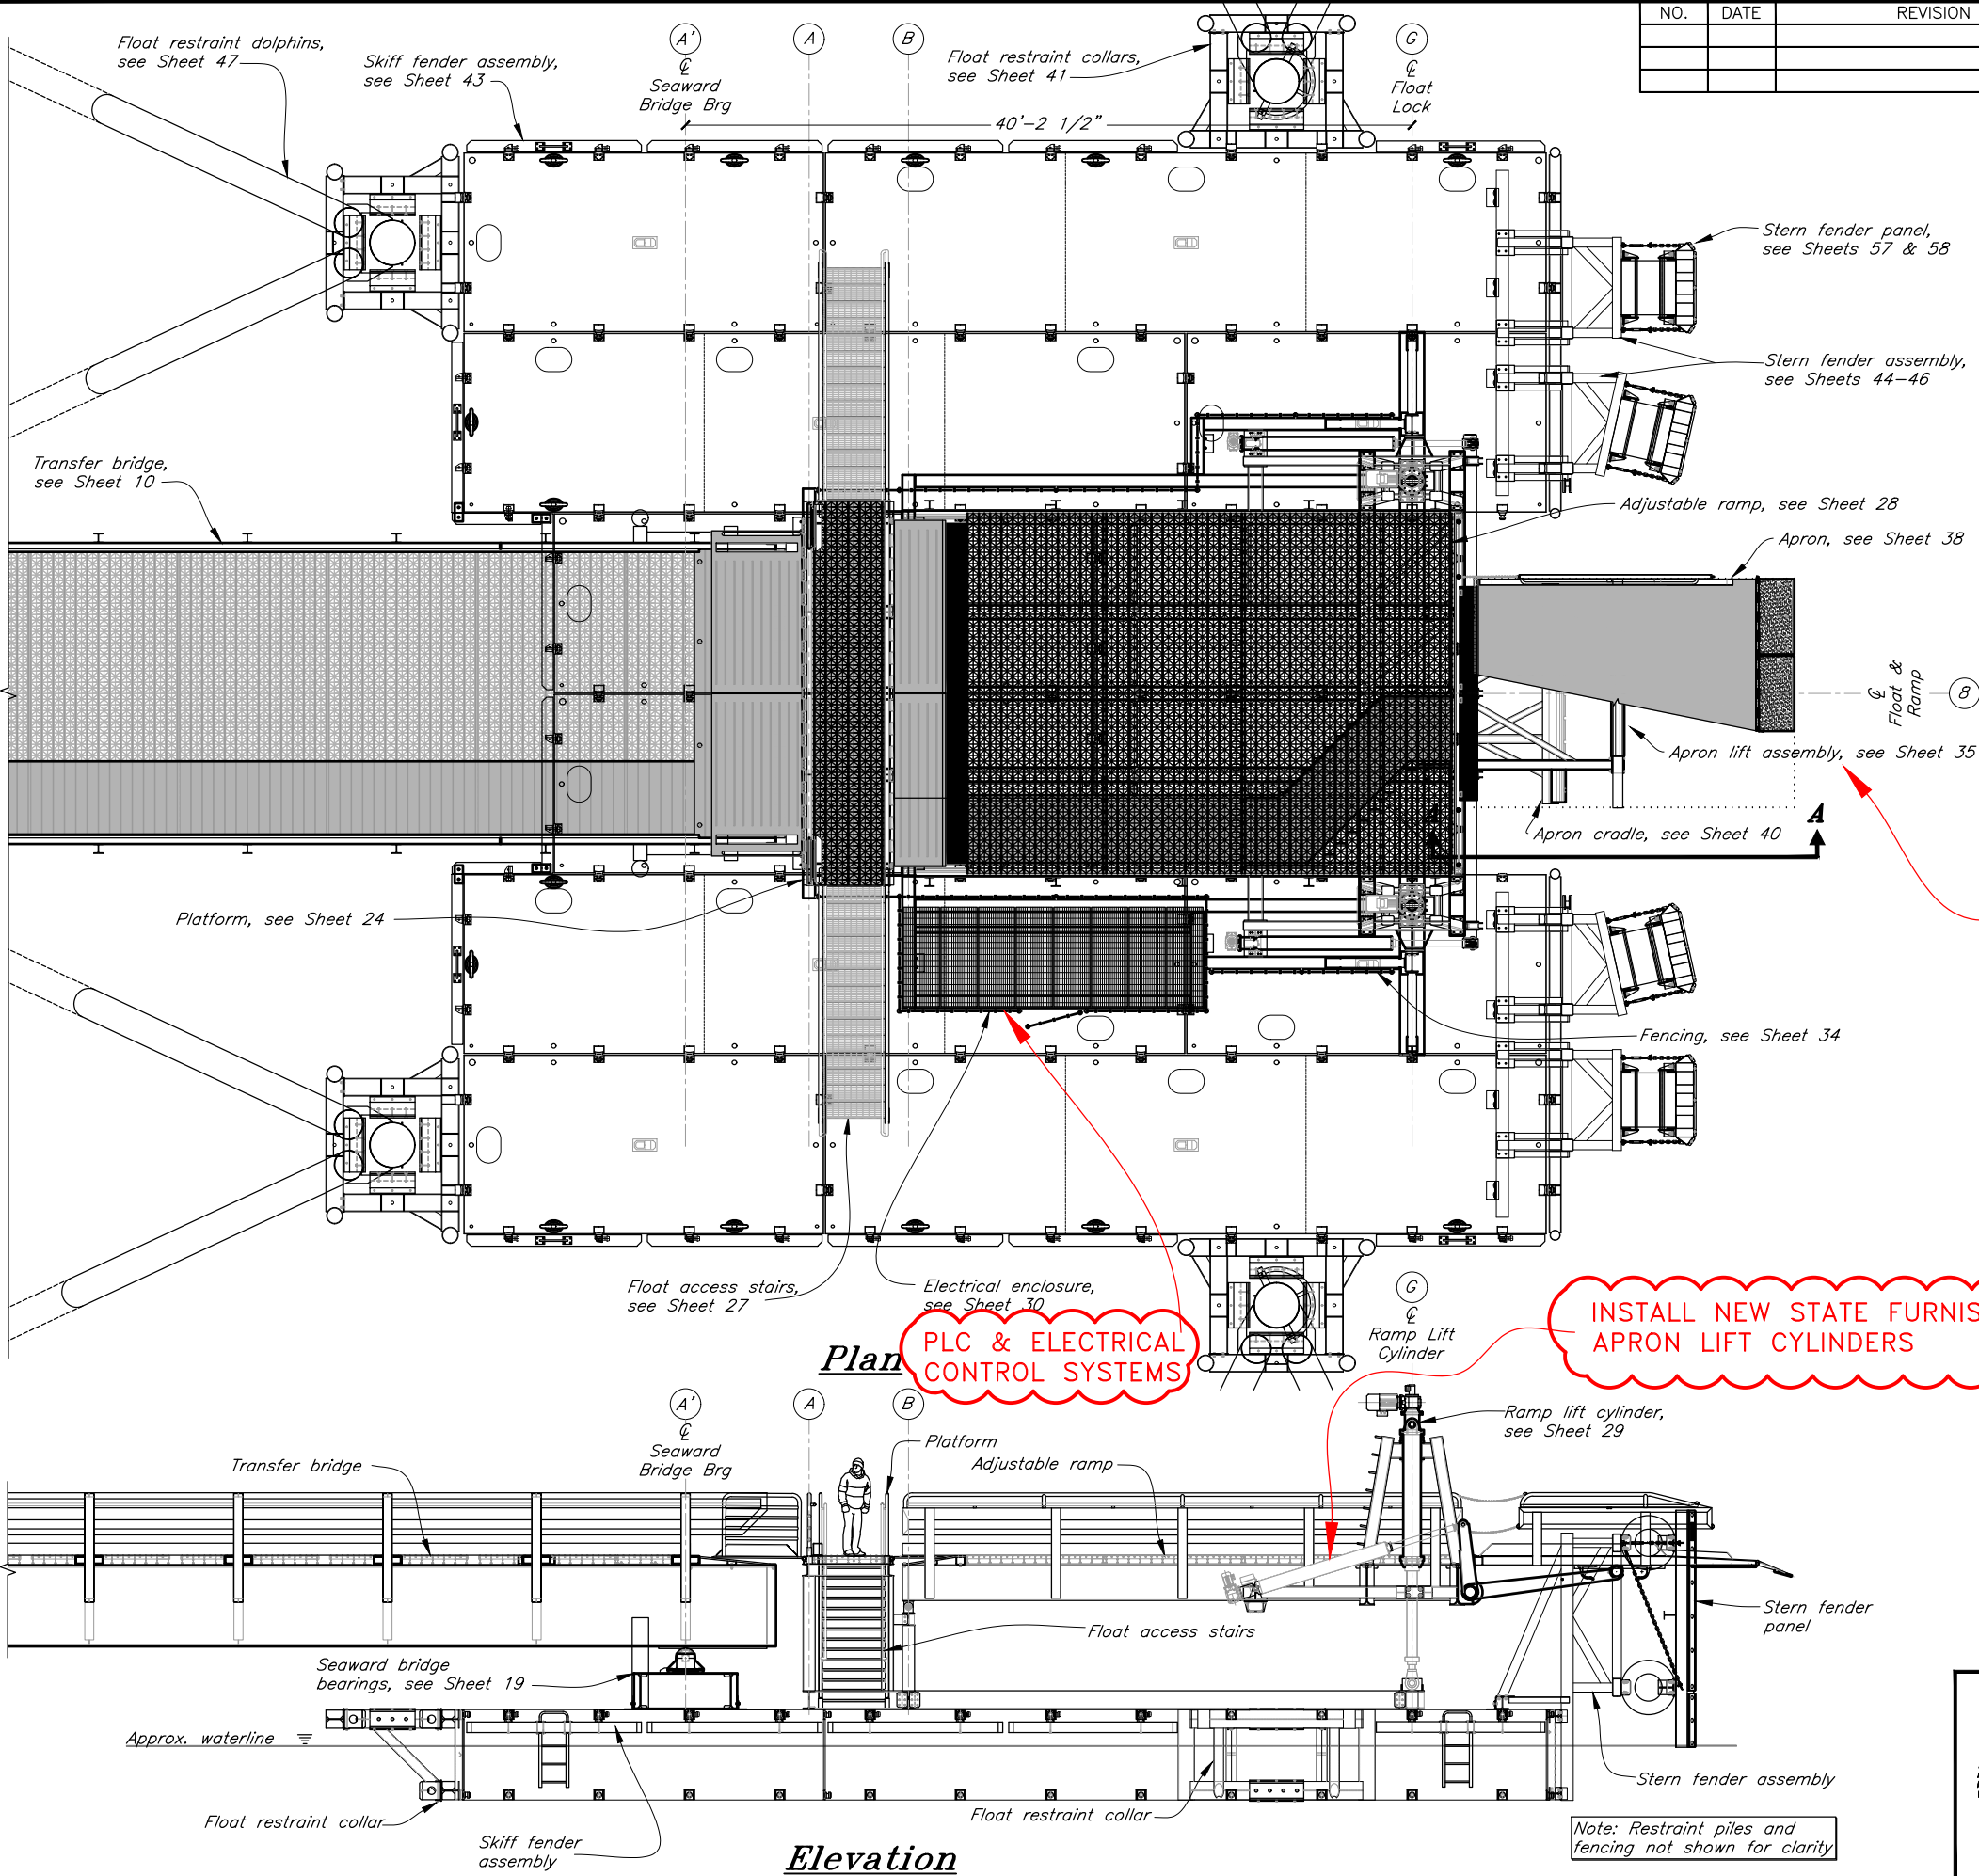

Section A-A


REMOVE & REPLACE

INSTALL NEW STATE FURNISHED APRON LIFT CYLINDERS

PLC & ELECTRICAL CONTROL SYSTEMS

- HORIZONTAL CONTROL OF BRIDGE, PLATFORM, AND RAMP:
1. Centerline of bridge, platform, and ramp (Grid B) coincides with centerline of float assembly.
 2. Centerline of ramp lift cylinder (Grid G) coincides with second lock from seaward face of float assembly.


LEGEND:
NEW FIELD WORK ITEMS

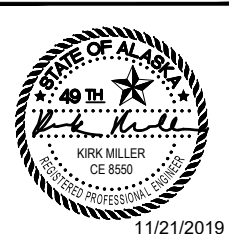

STATE OF ALASKA DEPARTMENT OF TRANSPORTATION AND PUBLIC FACILITIES
6860 GLACIER HIGHWAY, JUNEAU, AK 99801
(907) 465-1763
ANGOON FERRY TERMINAL
APRON REPAIRS
FLOAT AND PLATFORM LAYOUT

Note: Restraint piles and fencing not shown for clarity

NO.	DATE	REVISION	STATE	PROJECT DESIGNATION	YEAR	SHEET NO.	TOTAL SHEETS
				Z73221000	2019	4	7

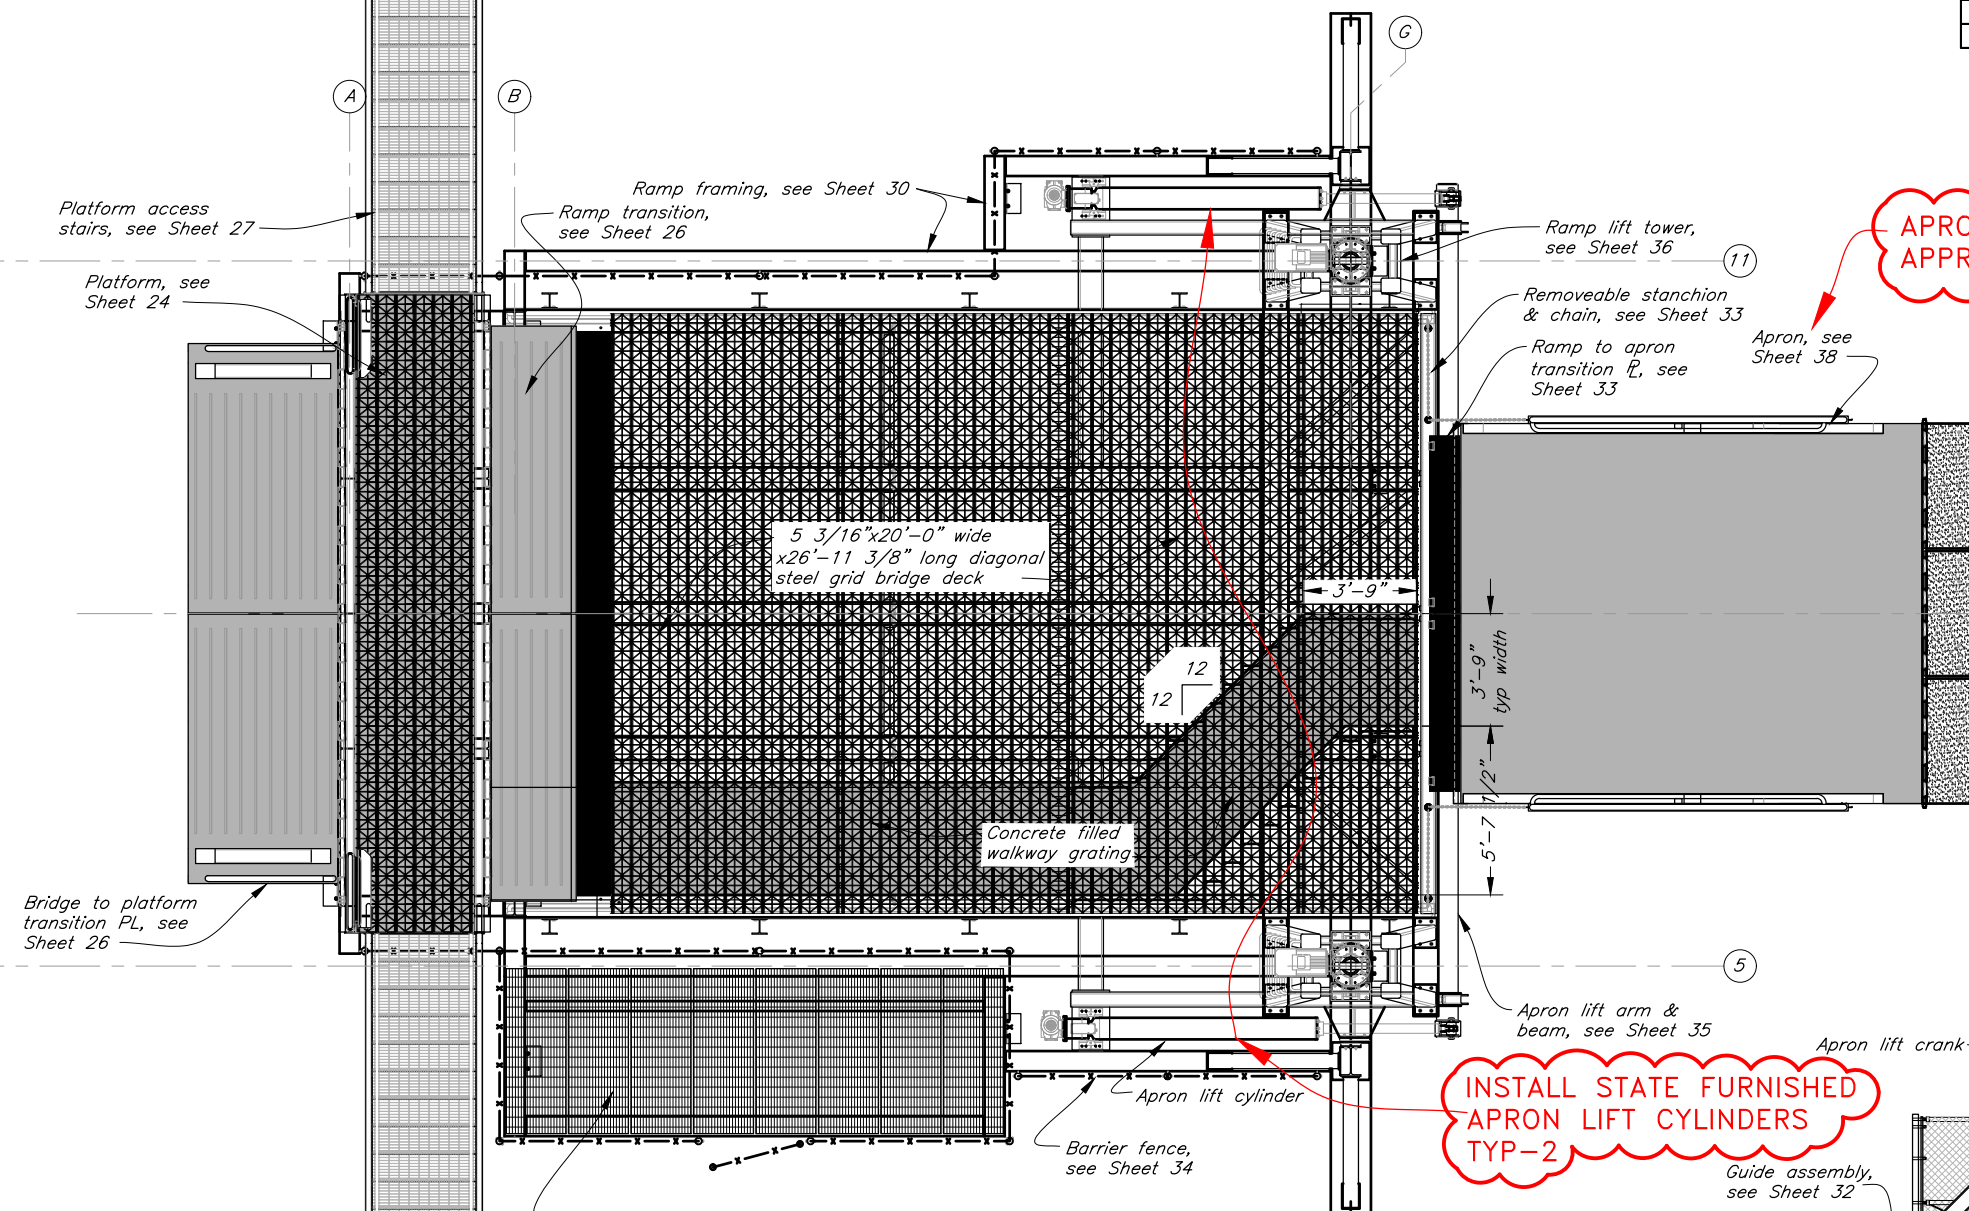

{ APRON WEIGHT IS
APPROX 12,500 lbs


~~SHOP TESTING:~~

~~Ramp and apron components shall be substantially assembled and tested in the shop prior to installation in the field.~~

~~Testing shall verify the operation and full range of motion of the ramp and apron lift systems, and will require installation of the electric cylinders, electrical power, control and synchronization electronics, and local/remote control systems.~~

~~Deficiencies shall be corrected prior to being shipped to the field.~~

3. PRESSURE WASH & CLEAN ALL MARINE GROWTH ON ALL SURFACES OF EXISTING APRON

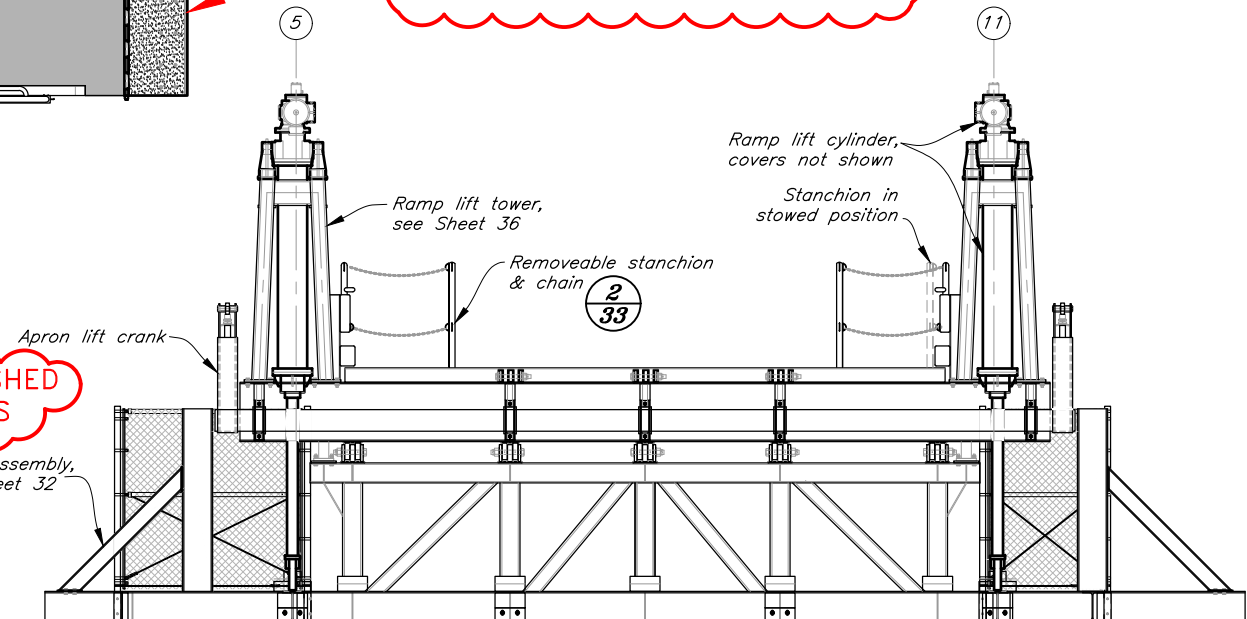


Note: Apron not shown


Front Elevation

LEGEND:

NEW FIELD WORK ITEMS

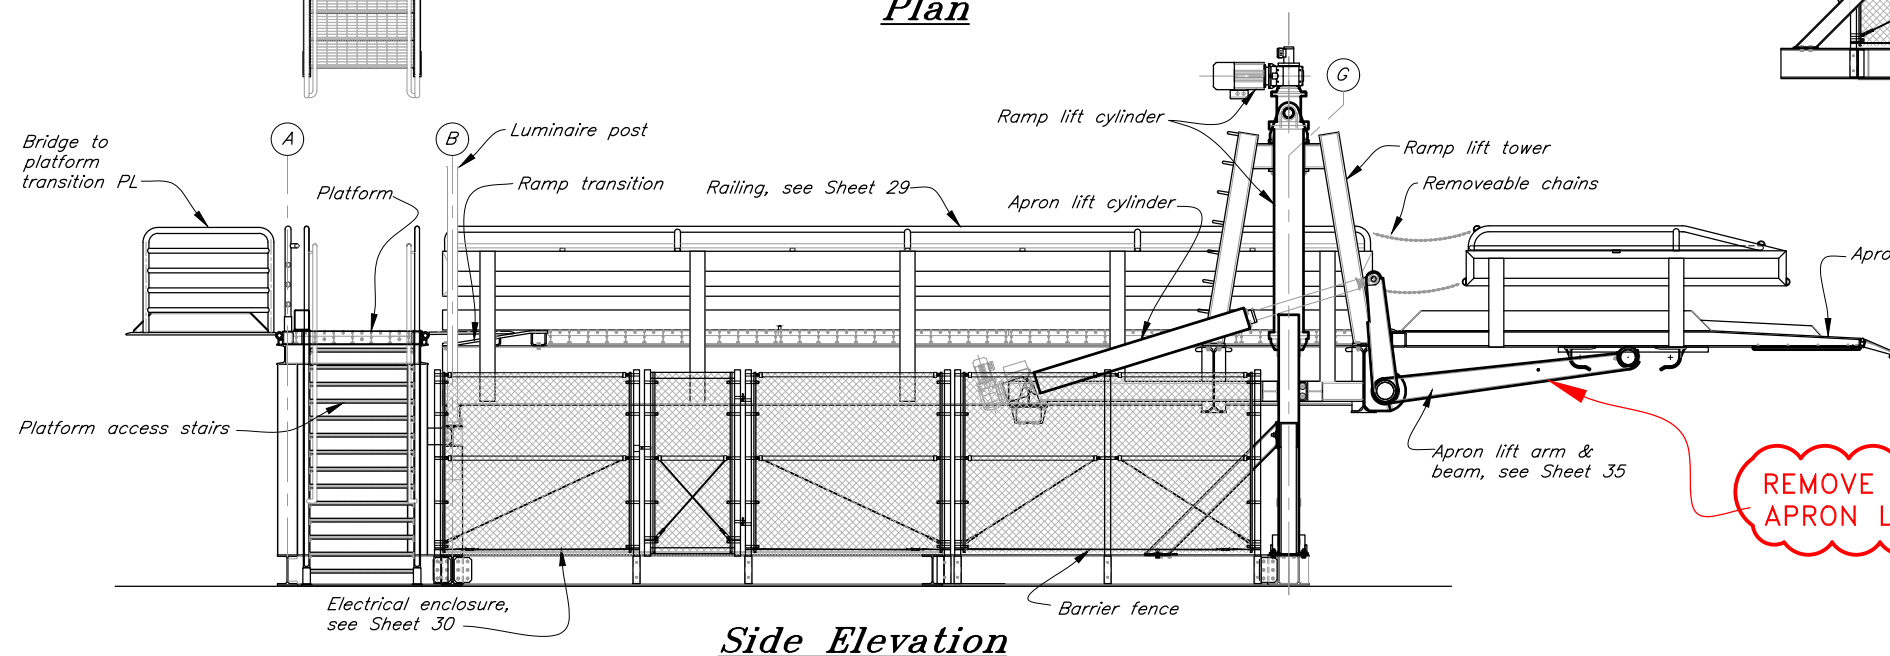

REMOVE & REPLACE APRON LIFT ASSEMBLY

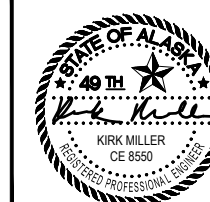


STATE OF ALASKA DEPARTMENT OF TRANSPORTATION
AND PUBLIC FACILITIES
6860 GLACIER HIGHWAY, JUNEAU, AK 99801
(907) 465-1763

ANGOON FERRY TERMINAL
APRON REPAIRS


RAMP PLAN & ELEVATIONS

11/21/2019


NO.	DATE	REVISION	STATE	PROJECT DESIGNATION	YEAR	SHEET NO.	TOTAL SHEETS
			ALASKA	Z73221000	2019	5	7

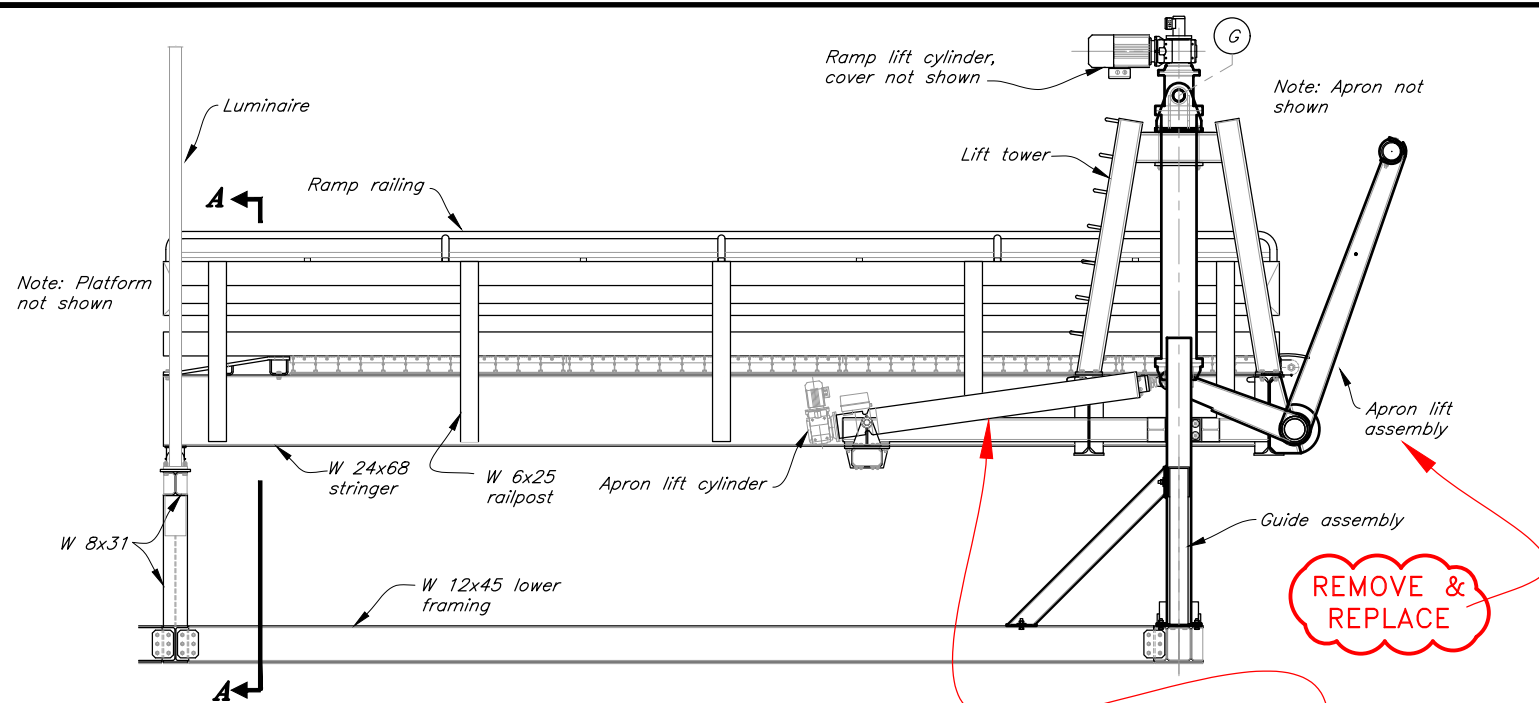

Elevation

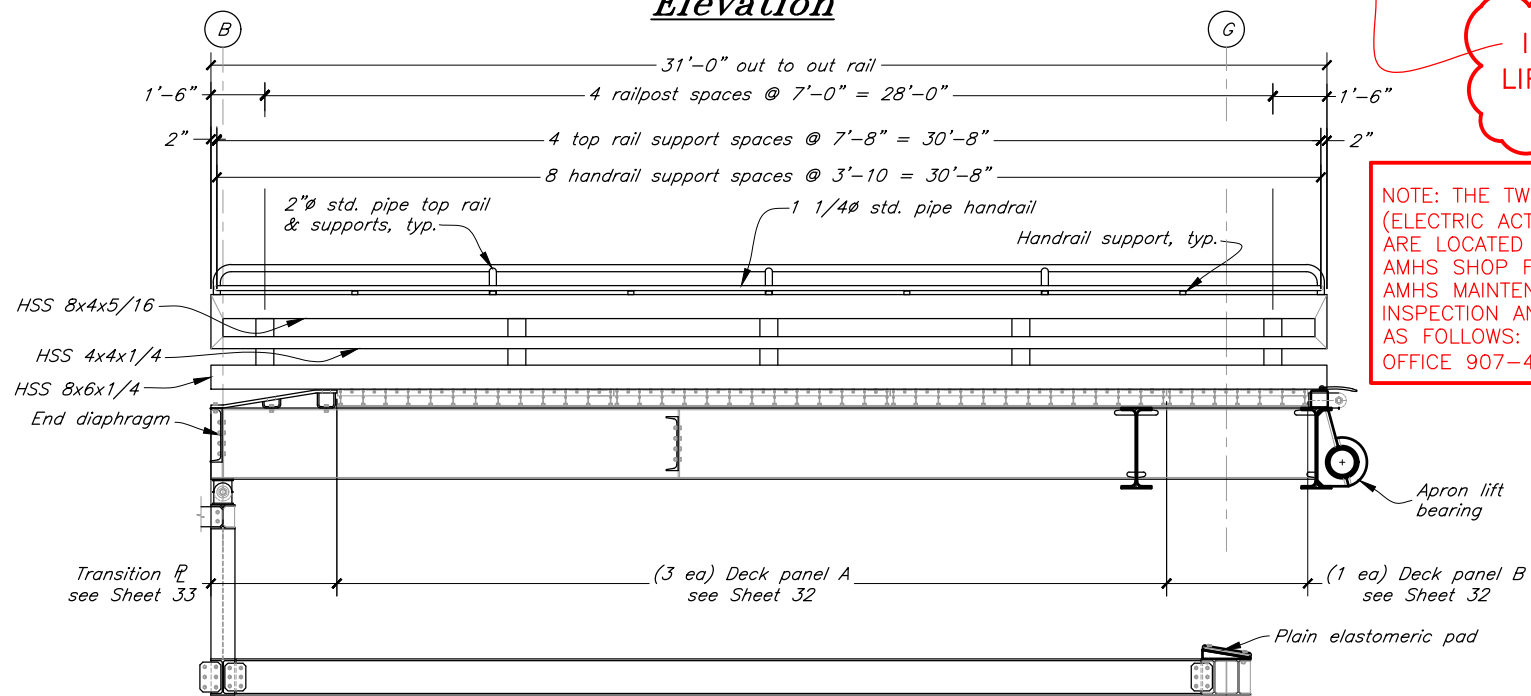

Typical Section

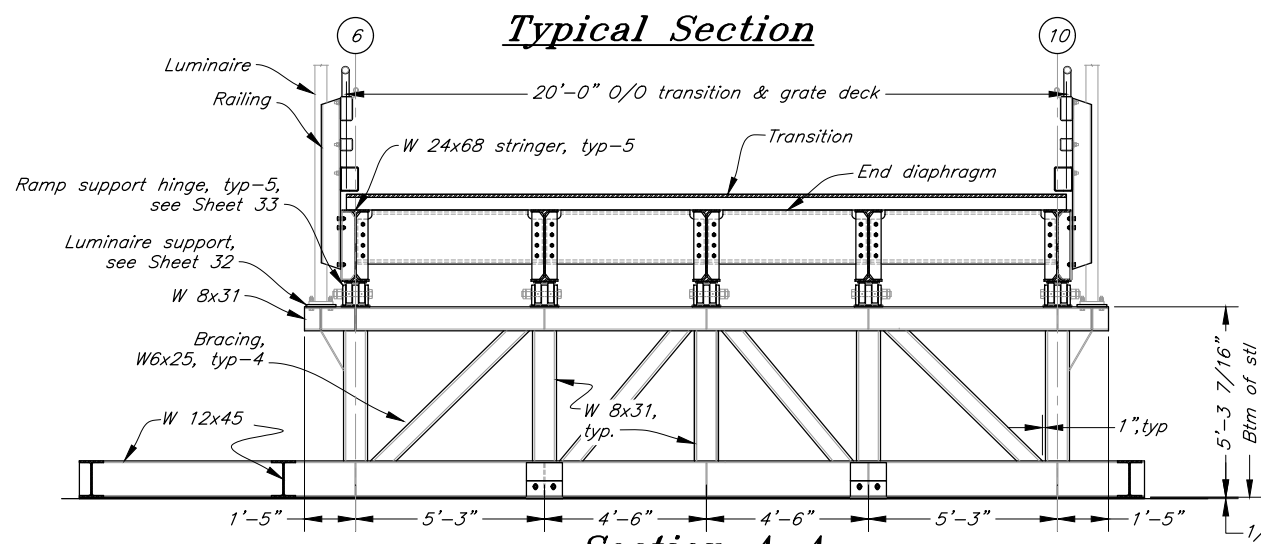

Section A-A

ELECTRIC LINEAR CYLINDER SPECIFICATIONS:

Ramp and apron lift systems are operated by electromechanical linear cylinders with the following capacities, speed, control systems, and dimensions. Cylinders shall be manufactured by RACO International, or an approved equal.

Provide certification and supporting calculations, sealed by a U.S. licensed civil engineer, that cylinders are designed to support the following loads in accordance with AASHTO LRFD Bridge Design Specifications, 2007 with interim updates.

Configuration of ramp and apron lift systems are based on RACO cylinders. Substitution from a different manufacturer may require redesign of ramp and apron framing. Redesign will be at no additional expense to the State.

Ramp Lift Cylinder: RACO Unit 10

Apron Lift Cylinder: RACO Unit 8

Thrust: 65,500 lbs. dynamic
 90,000 lbs. static
 Stroke: 78.7 inches maximum
 Rod speed: 0.7 in./sec (min)
 Lead: ACME screw with catch nut
 Thrust tube: Chrome plate
 Gear: Helical—worm

Thrust: 18,000 lbs. dynamic
Stroke: 78.7 inches maximum
Rod speed: 0.7 in./sec (min)
Lead: ACME screw
Thrust tube: Stainless steel (316)
Gear: Helical

Motor: 460 V / 3 phase / 60 HZ, 1800 base speed, IP65 enclosure, class F insul, inverter duty, right angle gear

Brake: Electromagnetic single disk brake with function monitoring microswitch, braking force applied when power is off


Electronics: Absolute position encoder, brake rectifier, vector drives with software, and associated electronics required for synchronization of cylinder pairs, as shown on Function Control Diagram, Sheet E8.

Misc: Thrust tube accordion type cover, sperical bearing rod end, and trunnion pins & bracket.


High corrosion protection package including: double front cap sealing with dirt/ice wiper, epoxy exterior coating, varnish base interior coating, sealing cable glands, anti-condensation heaters on motors and brakes.

— INSTALL NEW APRON -
LIFT CYLINDERS (2 EA)
STATE FURNISHED

NOTE: THE TWO NEW APRON LIFT CYLINDERS (ELECTRIC ACTUATORS) AND TRUNNION MOUNTS ARE LOCATED AT THE AUKE BAY FERRY TERMINAL, AMHS SHOP FACILITY. CONTRACTOR SHALL CONTACT AMHS MAINTENANCE STAFF TO ARRANGE FOR INSPECTION AND PICKUP. CONTACT INFORMATION IS AS FOLLOWS: JONATHON GUNDSTROM, OFFICE 907-465-4002 / CELL 907-209-1630.

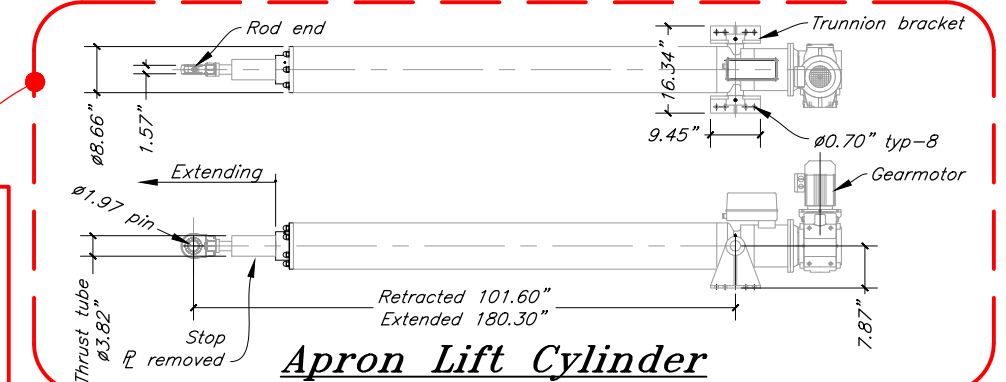

Apron Lift Cylinder

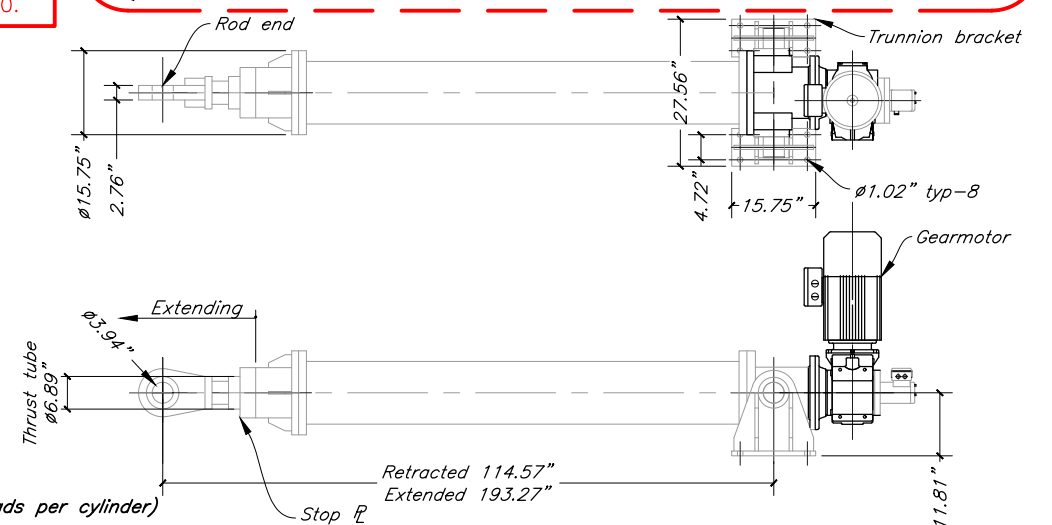

Ramp Lift Cylinder

LEGEND:

NEW FIELD WORK ITEMS



STATE OF ALASKA DEPARTMENT OF TRANSPORTATION
AND PUBLIC FACILITIES
6860 GLACIER HIGHWAY, JUNEAU, AK 99801
(907) 465-1763

ANGOON FERRY TERMINAL
APRON REPAIRS

RAMP & APRON LIFT FRAMING

11/21/2019

RAMP LIFT CYLINDER DESIGN LOADS: (service loads per cylinder)

Load Combinations	D	S	L	(LxIM)xMPF	(LL)xMPF	DESIGN THRUST (kips)
Dynamic Loading:						
D	32.90					32.9
D + L	32.90		32.11			65.0
D + S	32.90	11.30				44.2
D + 0.75L + 0.75S	32.90	8.47	24.08			65.5
Static Loading:						
D	32.90					32.9
D + L	32.90			46.12	9.72	88.7
D + S	32.90	11.30				44.2
D + 0.75L + 0.75S	32.90	8.47		34.59	7.29	83.3

D = Dead Load (self-weight)
L = Truck HS20, wheel centered over Grid ⑨
LL = Lane Load 640 plf, 10 ft. wide lane
S = Snow 70 psf
IM = Dynamic Allowance 1.33
MPF = Multiple Presence Factor 1.08

DRAWING SCALES ARE FOR FULL-SIZE SHEETS. USE DIMENSIONS WHEN SCALE NOT SHOWN

FILE Q:\Marine\Angoon\Ang - apron lift beam replacement\Drawings\PLANSET\07 Extg Conditions Photos.dwg DATE 11/21/2019 9:21 LAYOUT 7 DESIGNED STAFF CHECKED STAFF DRAFTED STAFF




FERRY TERMINAL OVERVIEW



EXISTING APRON SIDE VIEW



APRON & LIFT ASSEMBLY

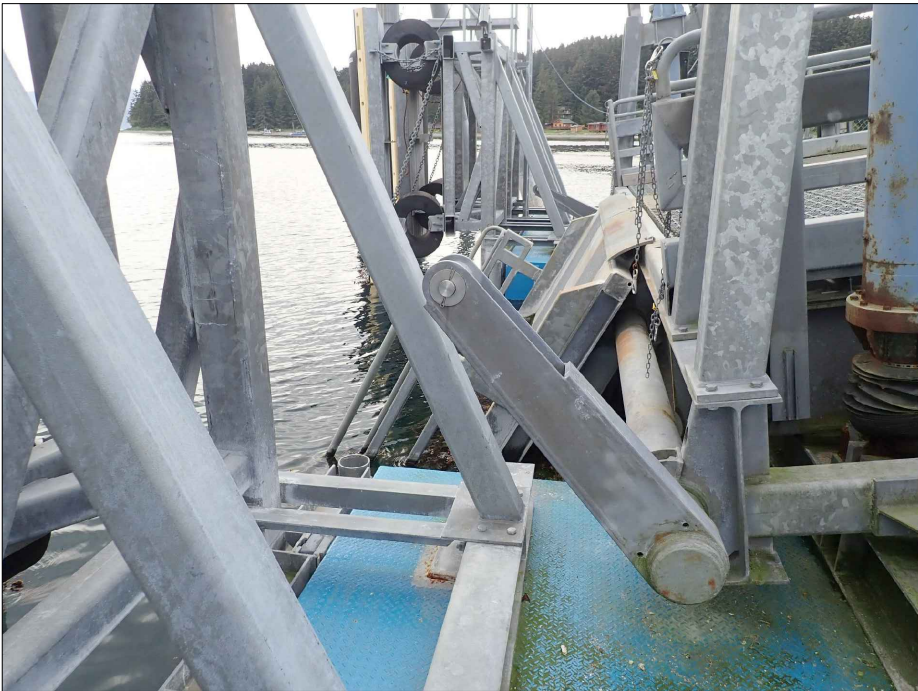

LIFT ASSEMBLY SIDE VIEW

NO.	DATE	REVISION	STATE	PROJECT DESIGNATION	YEAR	SHEET NO.	TOTAL SHEETS
			ALASKA	Z73221000	2019	7	7

STATE OF ALASKA DEPARTMENT OF TRANSPORTATION
AND PUBLIC FACILITIES
6860 GLACIER HIGHWAY, JUNEAU, AK 99801
(907) 465-1763

ANGOON FERRY TERMINAL
APRON REPAIRS

EXISTING
CONDITIONS PHOTOS

DRAWING SCALES ARE FOR FULL-SIZE SHEETS. USE DIMENSIONS WHEN SCALE NOT SHOWN.