

STATE	ROUTE	SECTION	YEAR	SHEET NO.	TOTAL SHEETS
ALASKA	FH2	4	1970	16	24

GENERAL NOTES:

SPECIFICATIONS: Construction, Bureau of Public Roads, F.P. 69; Design, A.A.S.H.O. Standard Specifications for Highway Bridges, 1969.

DEAD LOAD: Concrete, 150 Lbs. per cu. ft.; paving allowance, 25 Lbs. per sq. ft. of roadway surface. Earth pressure equivalent to a fluid weighing 36 Lbs. per cu. ft.

LIVE LOAD: HS 20-44 Loading. Impact = $I = \frac{50}{L+125}$ (L = Span Length), Max. I = 30%.

UNIT STRESSES: Concrete: $f_c = 3,300$ psi.; $f_t = 1,320$ psi. except for slab design where $f_t = 1,200$ psi.; Reinforcing steel: $f_s = 24,000$ psi. except for slab design where $f_s = 20,000$ psi., $n = 10$.

CONCRETE: All concrete shall be Class "A" with 1/2" max. size of coarse aggregate. All concrete shall be mixed with an air entraining admixture and shall be vibrated.

Chamfer all exposed corners $\frac{3}{4}$ unless otherwise shown. Elastomeric bearing pads shall conform to Sec. 25 of the 1969 A.A.S.H.O. Std. Specs. for Highway Bridges. Payment for bearing pads shall be included in contract item for Structural Concrete, Class "A."

FINISHING CONCRETE: Roadway surface shall be finished according to specifications. The following surfaces shall be given a rubbed finish: outside faces of the slab, outside faces of exterior girders, and exposed surfaces of abutment wings down to one foot below finished ground line. All other surfaces shall be given an "Ordinary Finish."

REINFORCING STEEL: All bars shall conform to ASTM Spec. A615. Unless otherwise shown bars shall be Grade 60. The minimum covering to the face of any bar shall be 2" unless otherwise shown. Grade 60 bars shall be lapped 36 bar diameters and Grade 40 bars shall be lapped 24 bar diameters at all splices unless otherwise shown. Bar splice other than those shown on the plans will not be paid for.

CONCRETE PILES CAST IN STEEL PIPE OR SHELLS: The casing for cast in place concrete piles shall be either steel pipe or steel shells at the contractor's option. However, only one type shall be used for the entire project. Steel pipe shall have a min. O.D. of 16" with a min. wall thickness of 4". Pipe shall be either spiral welded or seamless steel pipe conforming to requirements of ASTM, Spec. A252, Grade 2. Steel pipe shall be fitted with pile tip as detailed on the plans. All pipe splices shall be made by butt welds. Steel shell piles shall consist of a 20 ft. length lower section with a min. tip diameter of 24" and a top diameter of 16" and a constant 16" diameter pile extension of the required length welded to the lower tapered section. Wall thickness of both upper and lower sections shall be min. 3 ga. steel. Steel for the shells shall have a min. tensile strength of 50,000 psi. Piles may be ordered in stock lengths and spliced to obtain required lengths except that the min. length of any piece shall be 10 ft. All piles shall be water tight. All piling shall be driven to a min. bearing value of 50 tons and min. tip elevation of El. +15.0. (Estimated tip El. - 150). The contract item for "Concrete Piles Cast in Steel Pipes or Shells" shall include payment for furnishing the pipe or shells and filling with concrete, complete in place. Order lengths of steel pipe or shell shall be based on test pile data. Only those splices required for pile extensions to secure adequate pile bearing after the pile order length has been driven will be paid for. Payment for concrete columns above El. 29.5 in Bents #2 and #3 shall be included in the items for Structural Concrete, Class A and Reinforcing Steel.

TEST PILES: Two test piles shall be driven at locations selected by the Engineer and shall be of the same type as the remainder of the piles in the substructure units and shall become permanent piles. Pile #4 & 18.

PREFORMED ELASTOMERIC COMPRESSION JOINT SEALS: The seals shall be as manufactured by D.S. Brown Company, Acme Highway Products Co. or equal. The cost of the seals and their installation is to be included in the contract item for Structural Concrete, Class "A".

STEEL BRIDGE RAILING: All items of rail construction are included in the contract item for "Steel Bridge Railing" and include the tubular rails, steel posts, and all rail and post securing bolts, nuts, washers and shims. All elements of bridge railing shall be galvanized after fabrication and shall conform to A.S.T.M. Spec. A123. Tubular rails shall conform to A.S.T.M. Spec's. A500 or A501. Posts, plates and $\frac{3}{8}$ " bolts shall conform to A.S.T.M. Spec. A307, $\frac{3}{8}$ ", $\frac{1}{2}$ " and $\frac{3}{4}$ " H.S. bolts shall conform to A.S.T.M. Spec. A325. Provide metal shims for alignment. The cost of furnishing and installing Guard Rail Brackets and End Shoes at all four corners of bridge shall be included in contract item for "Steel Bridge Railing". Contractor will be furnished standard state of Alaska bridge number plates. He shall install these plates on the bridge railing as directed by the engineer. The cost of installing bridge number plates is to be included in the price for "Steel Bridge Railing."

ESTIMATE:

** * Structural Concrete, Class "A"	-----	All Reg'd.
* Reinforcing Steel	-----	113,730 Lbs. (b)
Concrete Piles Cast in Steel Pipes or Shells	-----	1,280 Lin. Ft.
Test Piles (Conc. Piles Cast in Steel Pipes or Shells)	-----	2 Each
Pile Splices	-----	4 Each
Steel Bridge Railing	-----	378 Lin. Ft.
Loose Riprap (Includes Excavation)	-----	1,200 Cu. Yds.
Steel Pile Pipes or Shells, Driven	-----	22 Each

* Includes weight of guard angles Bents #2 & #3 = 9.7 cu. yds.

(a) Abut. #1 = 21.8 cu. yds, Abut. #4 = 21.8 cu. yds, Superstructure = 300.3 cu. yds.
(b) Abut. #1 = 1,690 Lbs.*, Abut. #4 = 1,690 lbs.*, Superstructure = 110,410 Lbs.*

**Includes Bents #28 & 3 & pile reinforcing.

*** Estimated quantity Class A Concrete = 354.1 Cu. Yds.

U. S. DEPARTMENT OF TRANSPORTATION
FEDERAL HIGHWAY ADMINISTRATION
PROGRAMS OFFICE REGION 7 SAN FRANCISCO, CALIFORNIA


COWEE CREEK BRIDGE
BRIDGE NO. 1220
ALASKA FOREST HIGHWAY PROJECT FH2-4(3)
GLACIER HIGHWAY

SCALE: 1" = 20'-0"


BRIDGE DRWG. 1 OF 4 DRWGS.

APRIL 1970


RG 1918-A

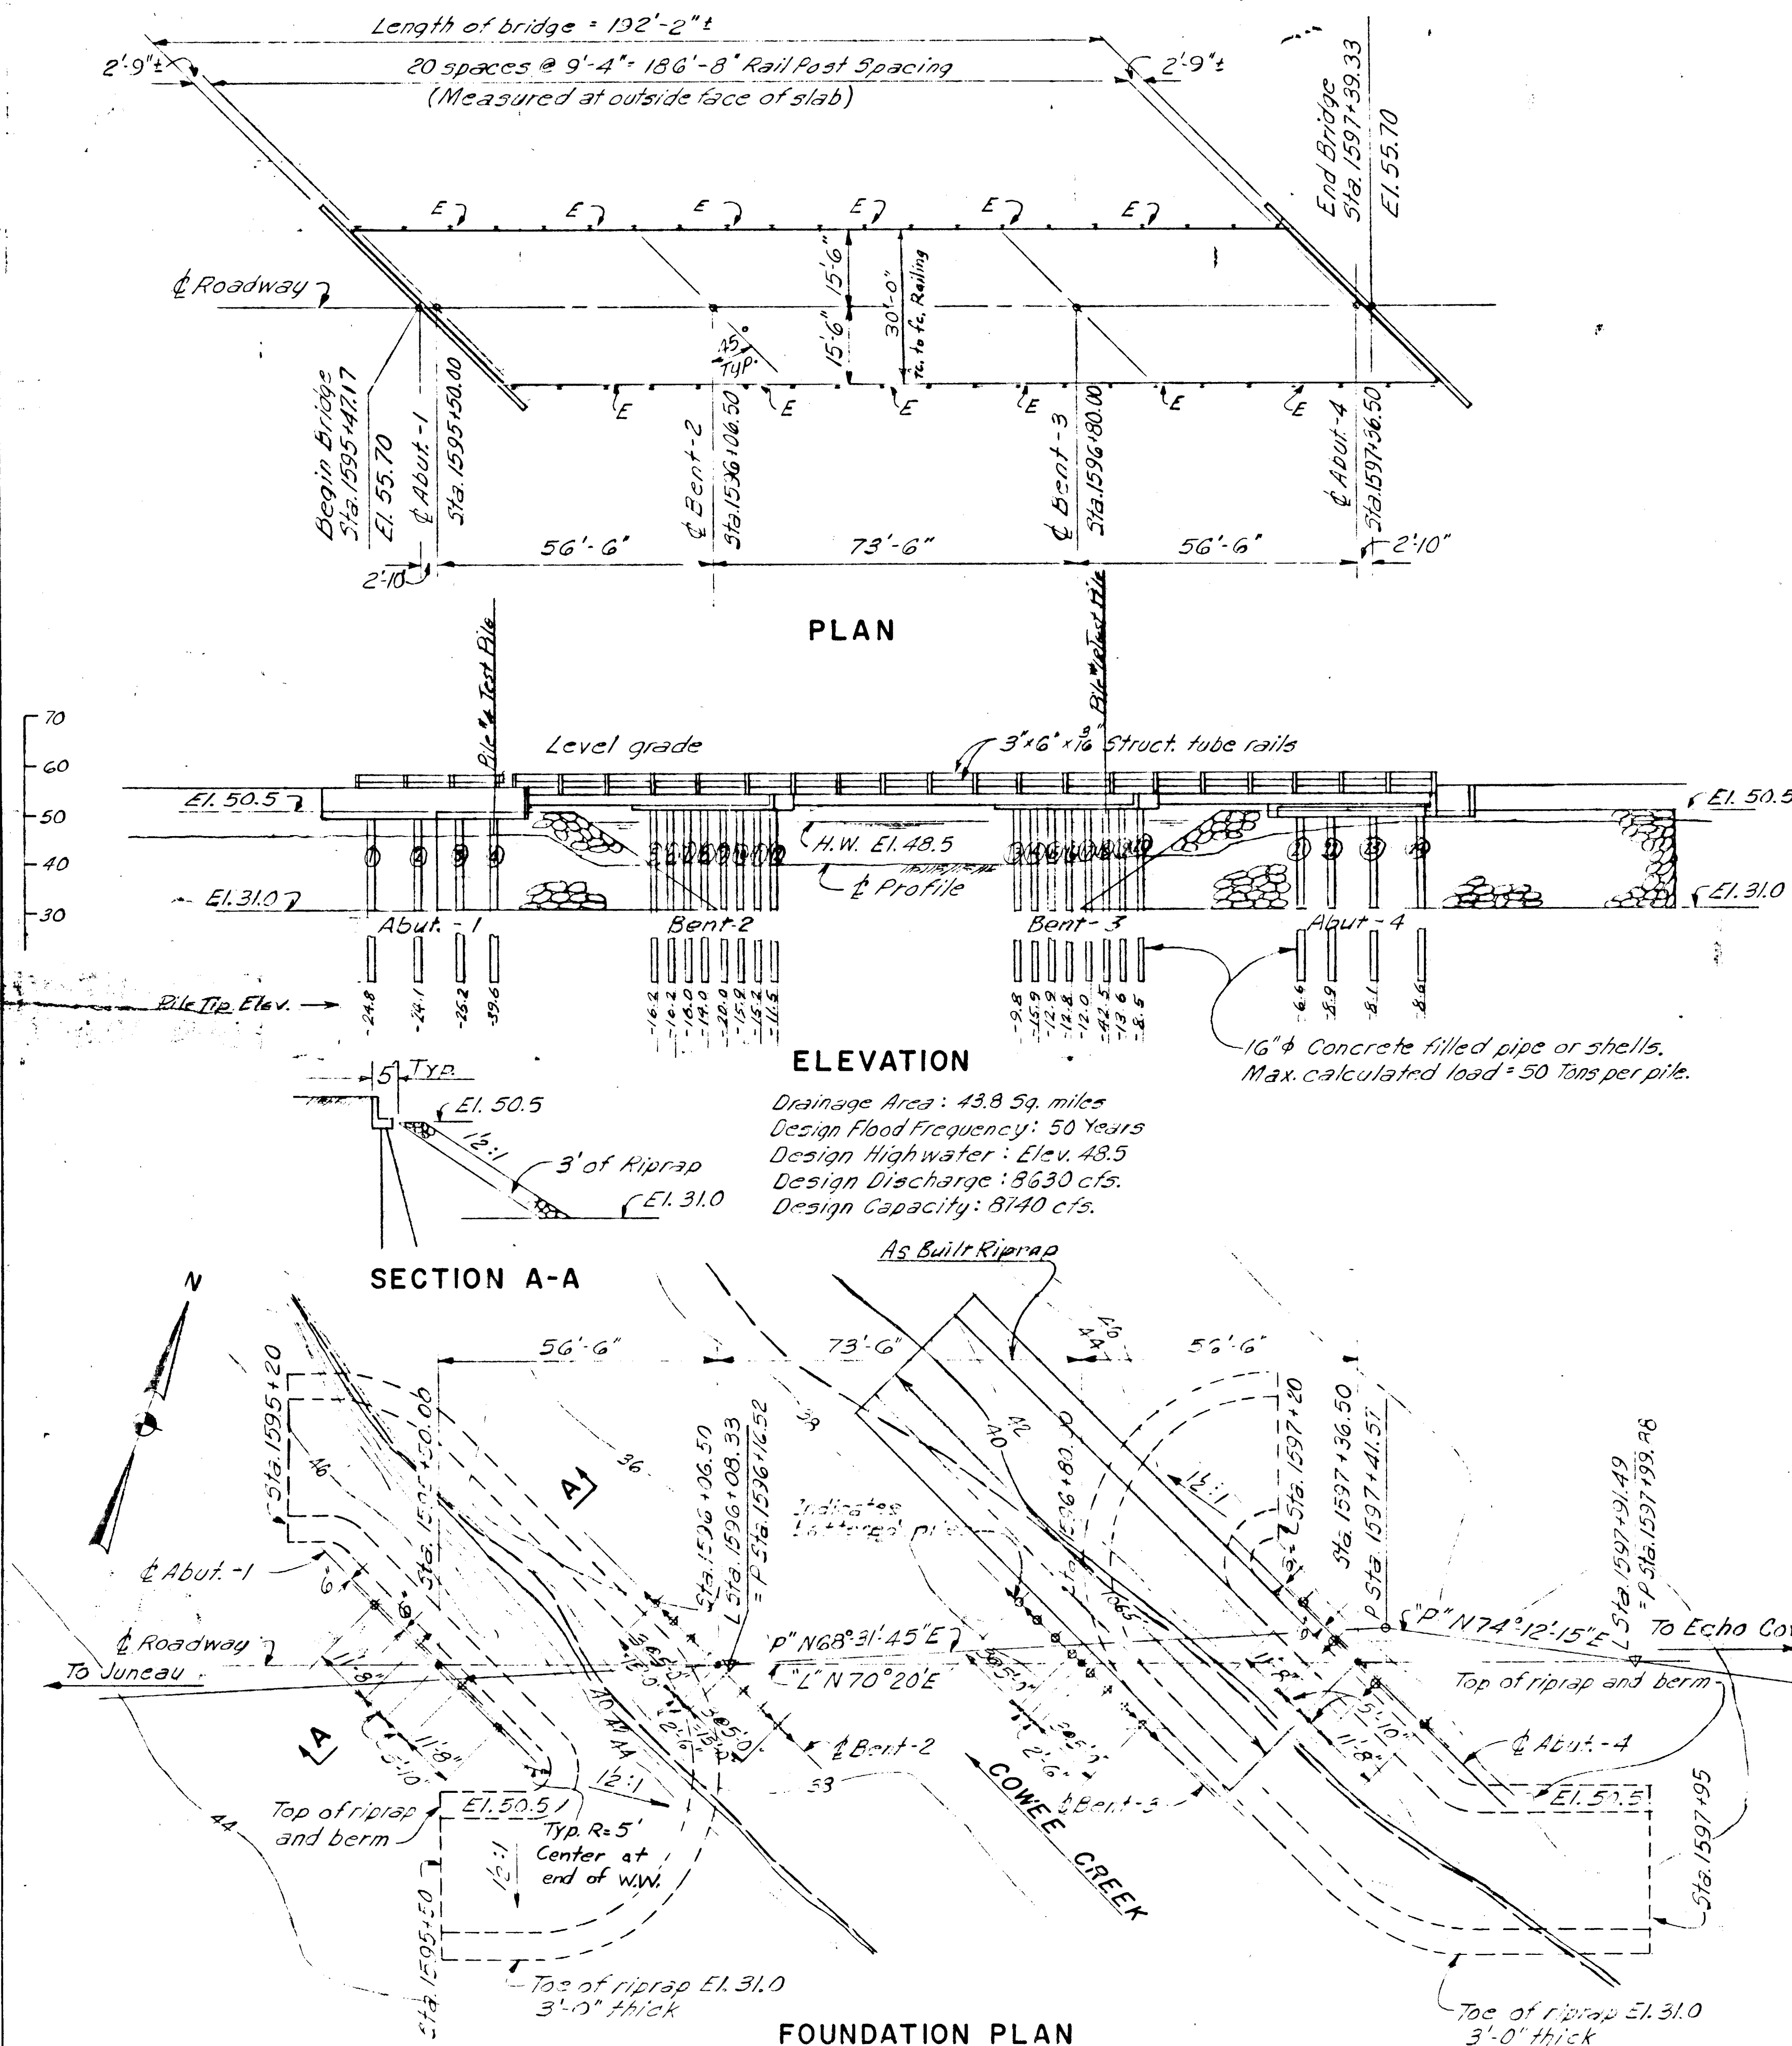


STATE	ROUTE	SECTION	YEAR	SHEET NO.	TOTAL SHEETS
ALASKA	FH2	4	1970	17	24

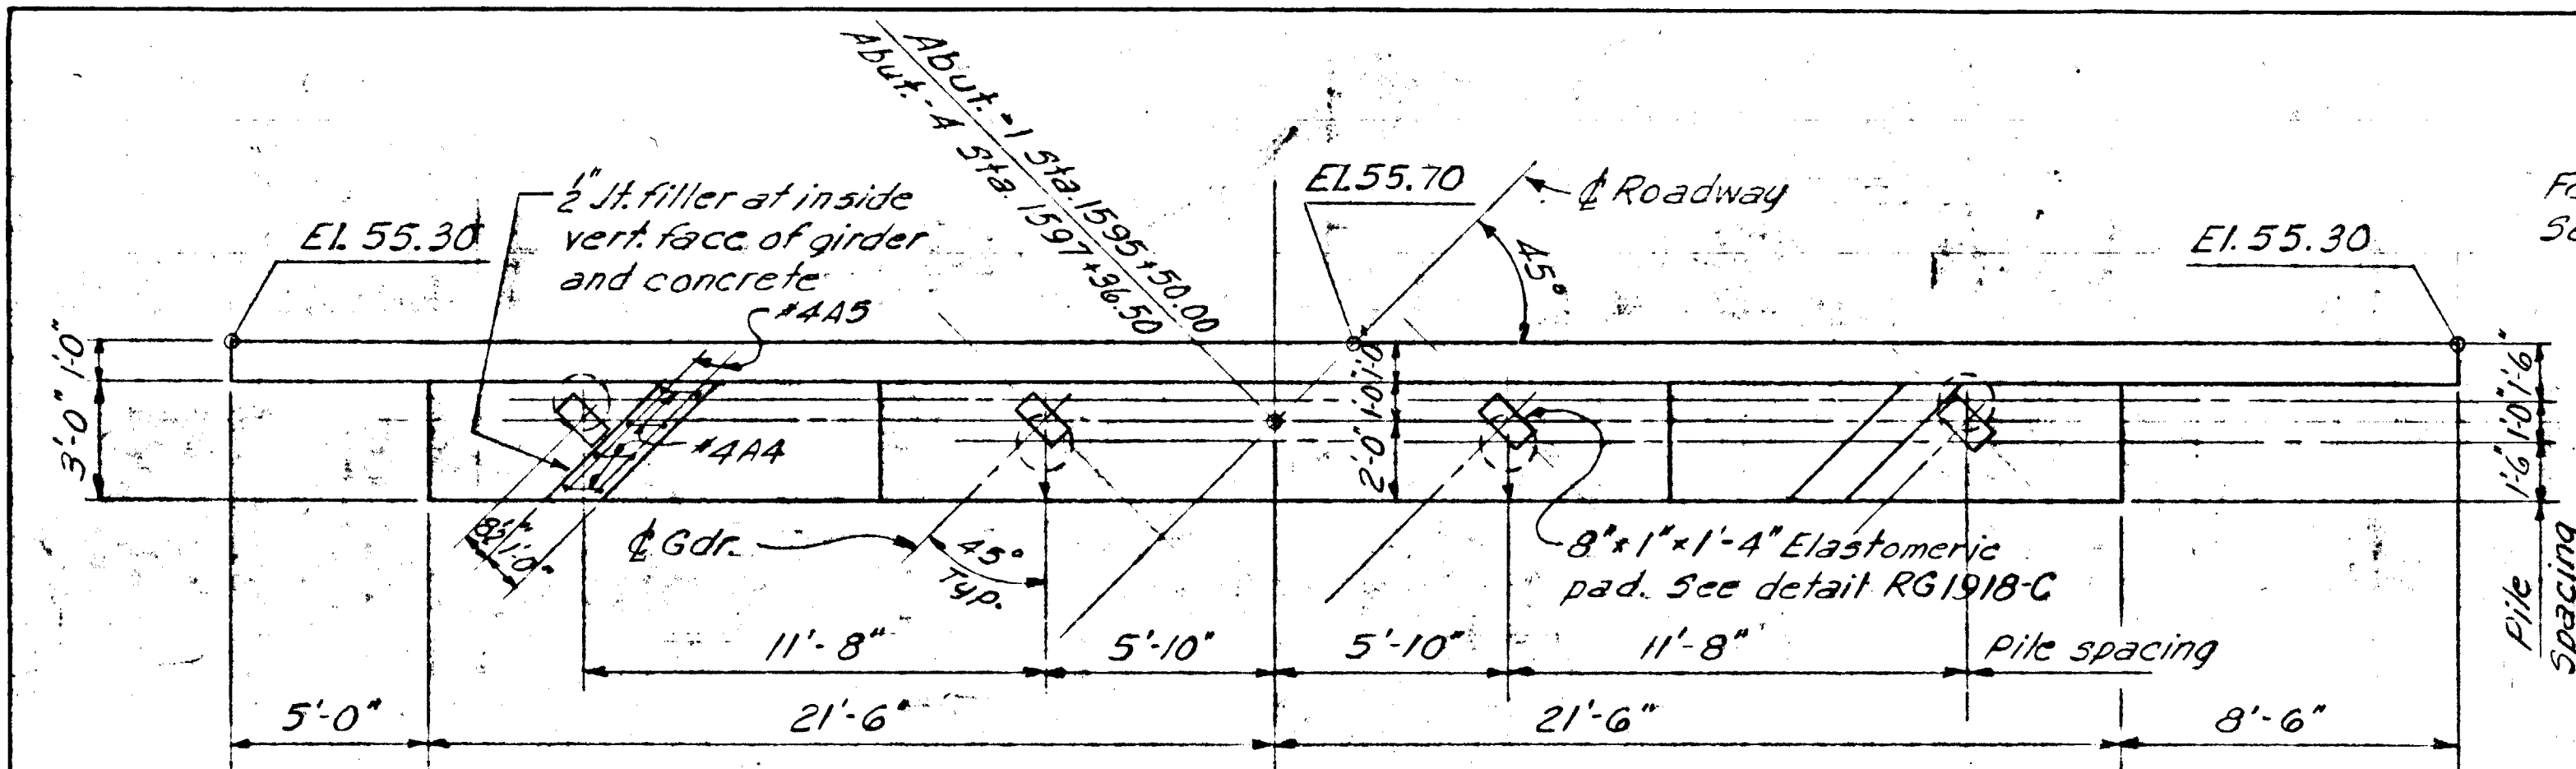


ABUTMENT PLAN

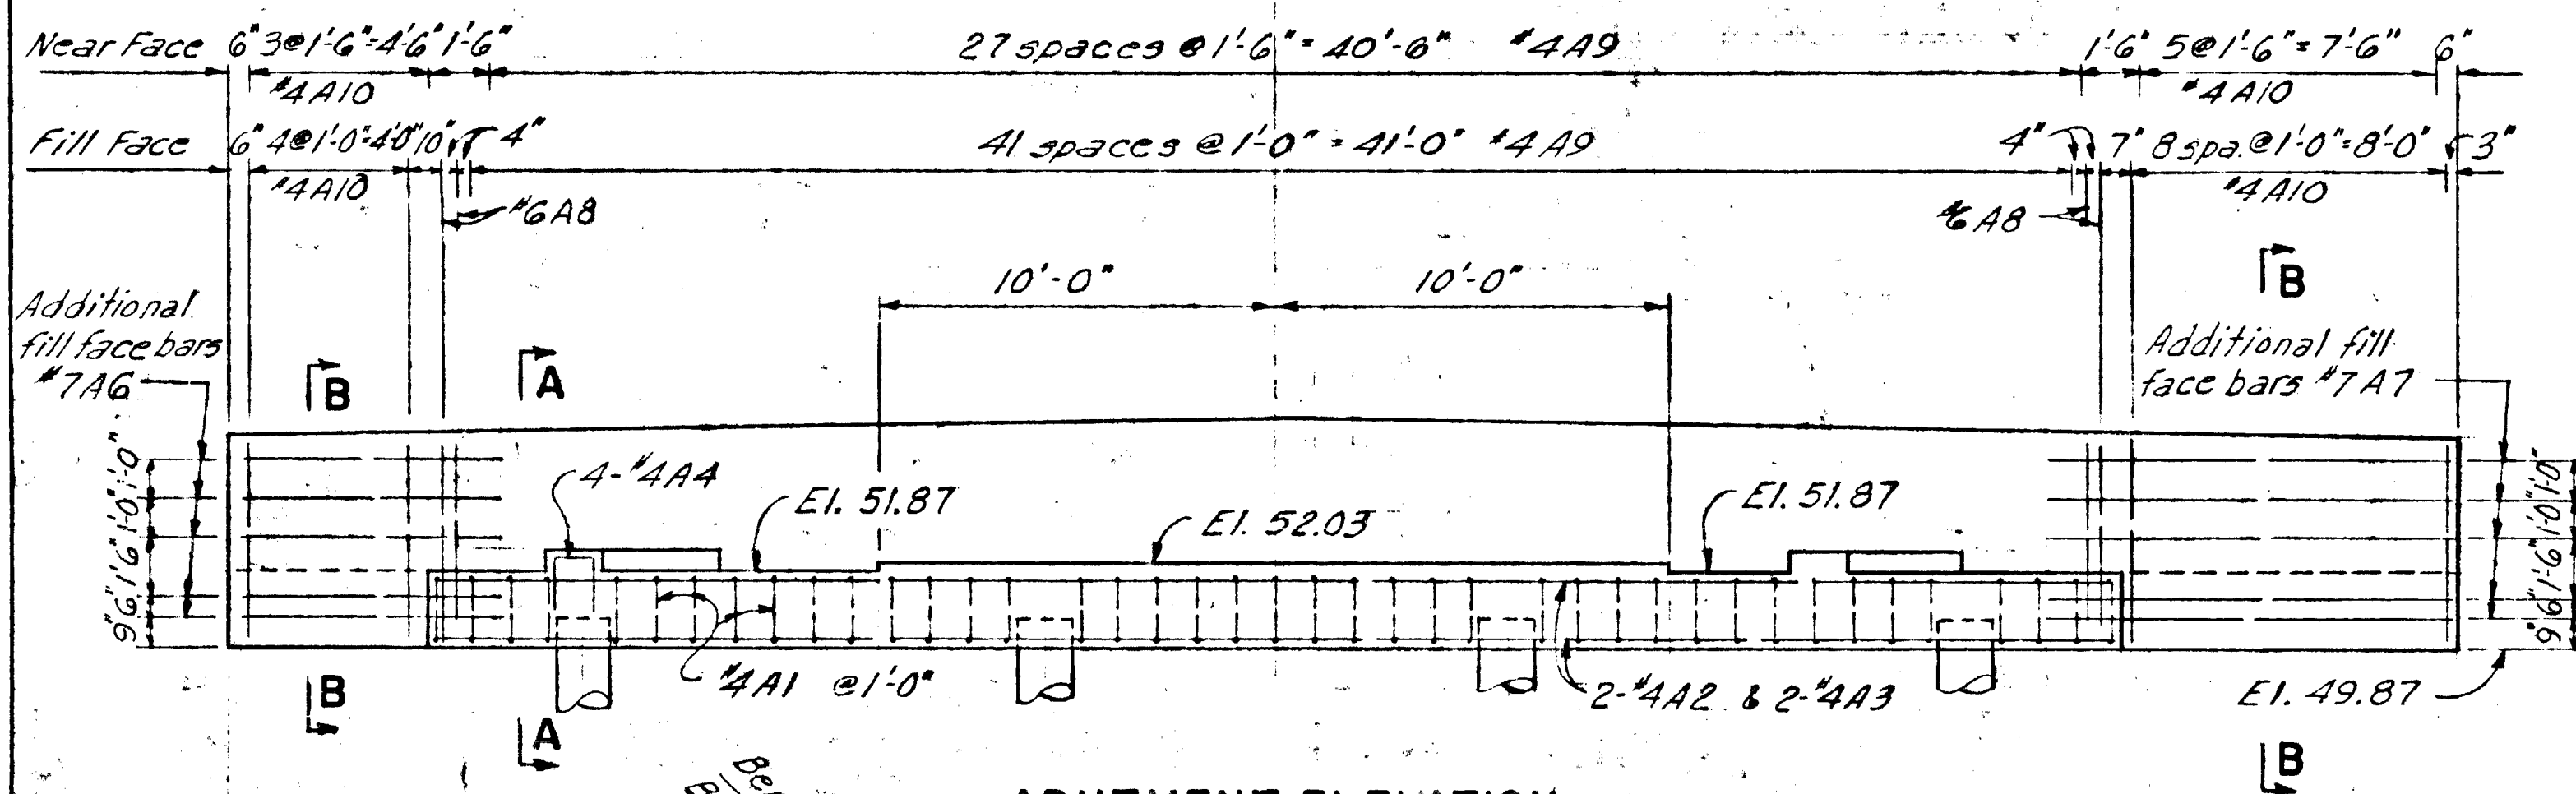


ABUTMENT ELEVATION

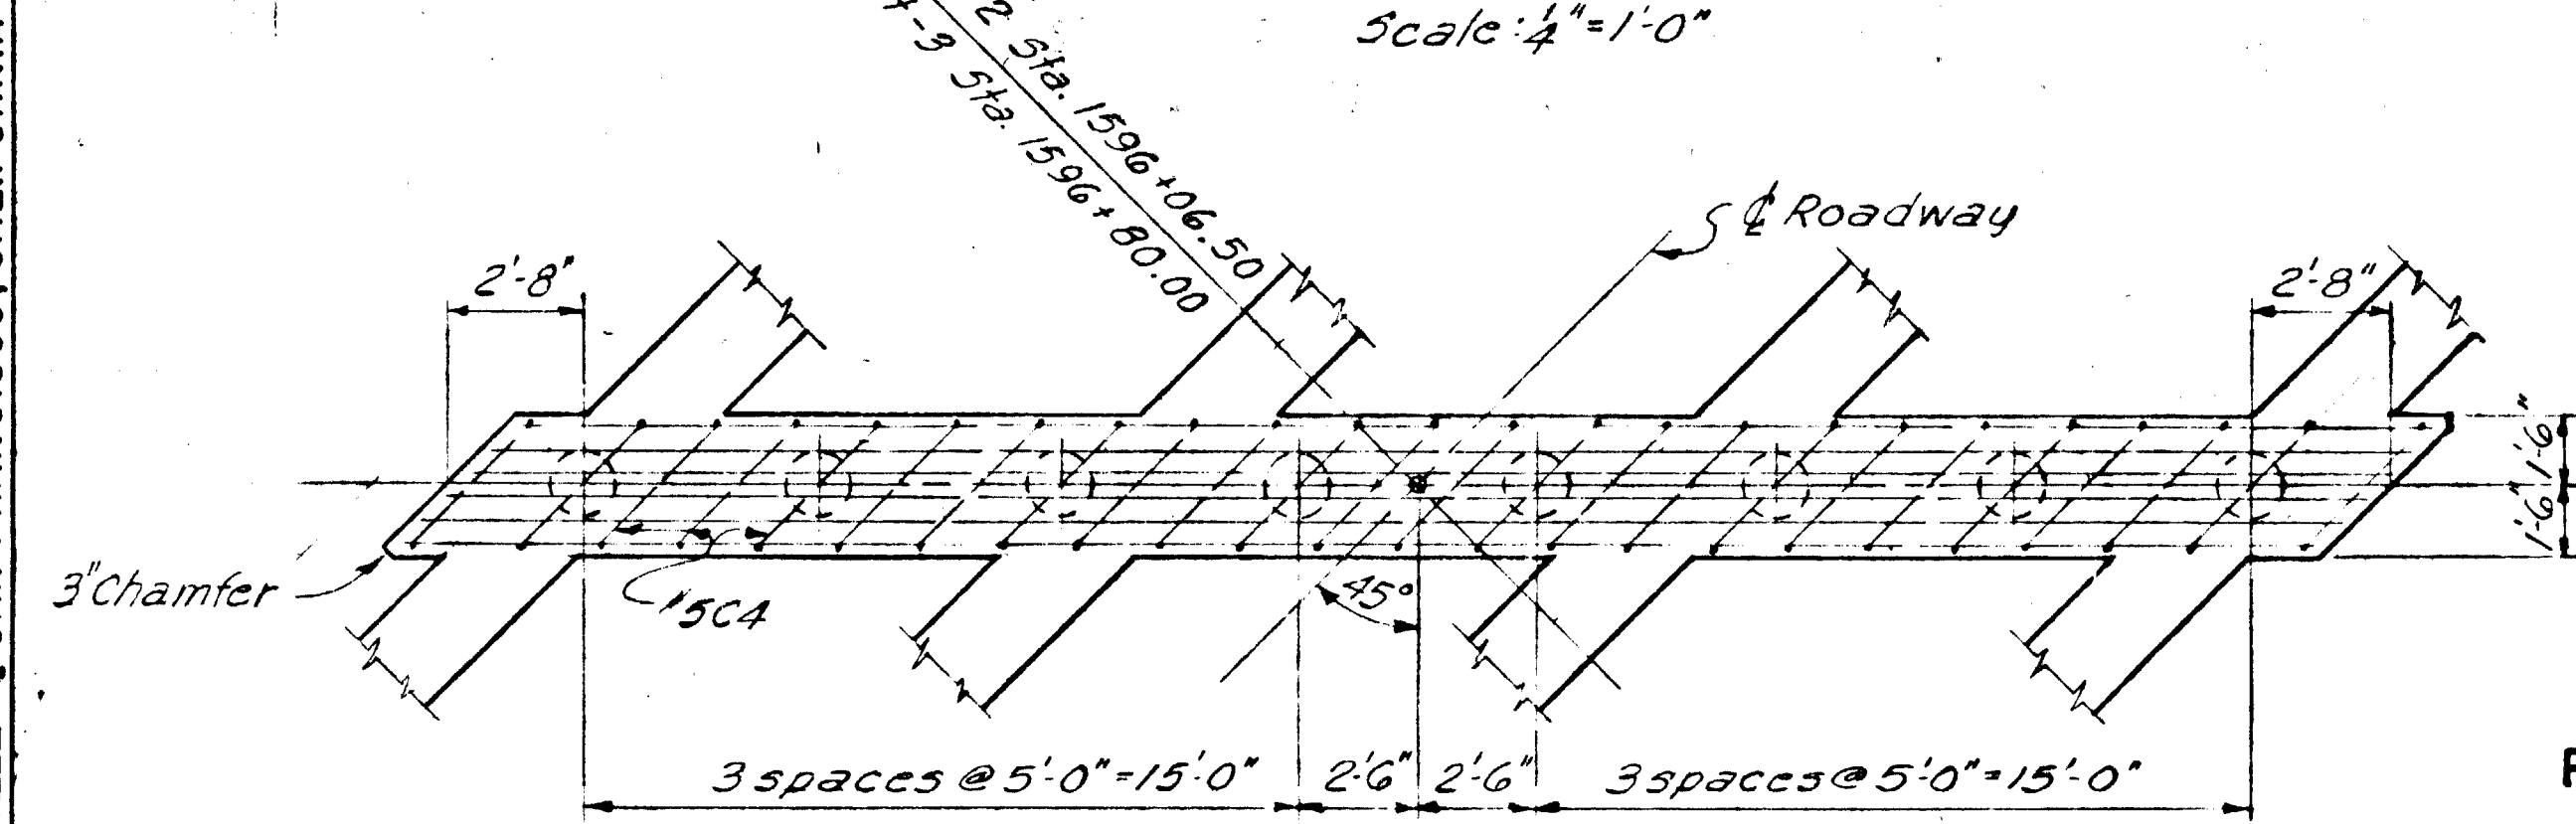


BENT PLAN

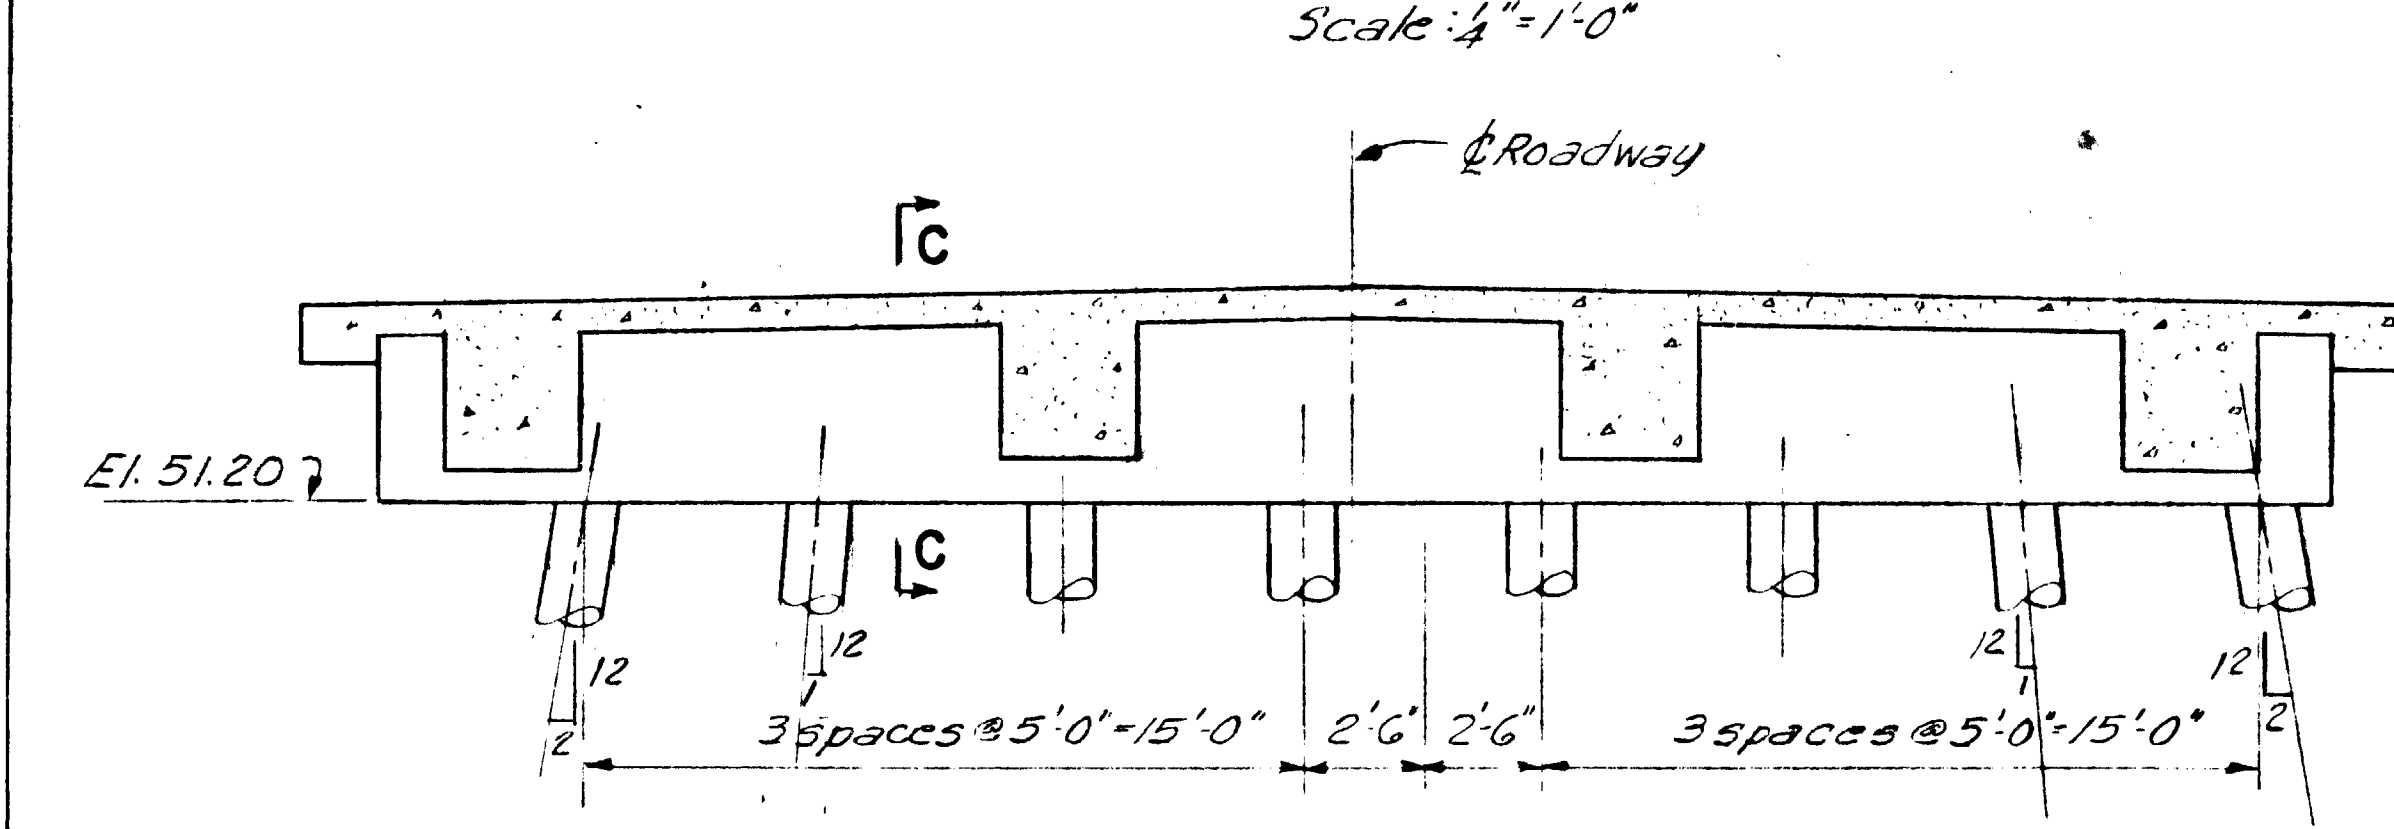


BENT ELEVATION.

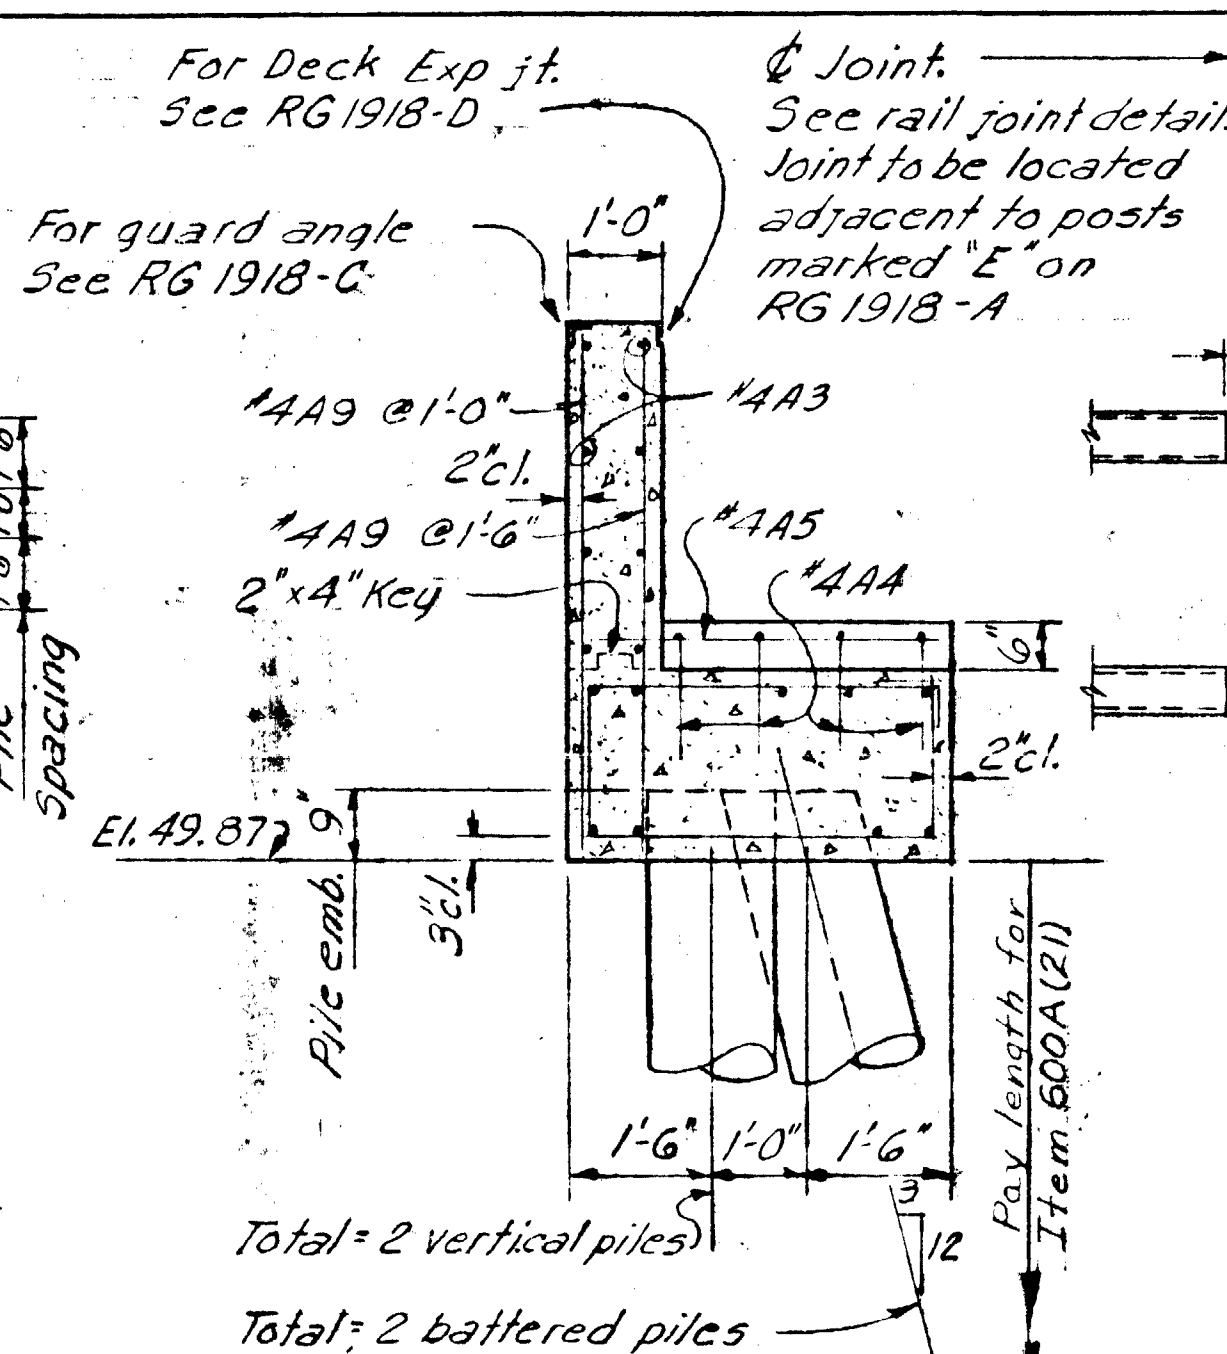


SECTION A-A

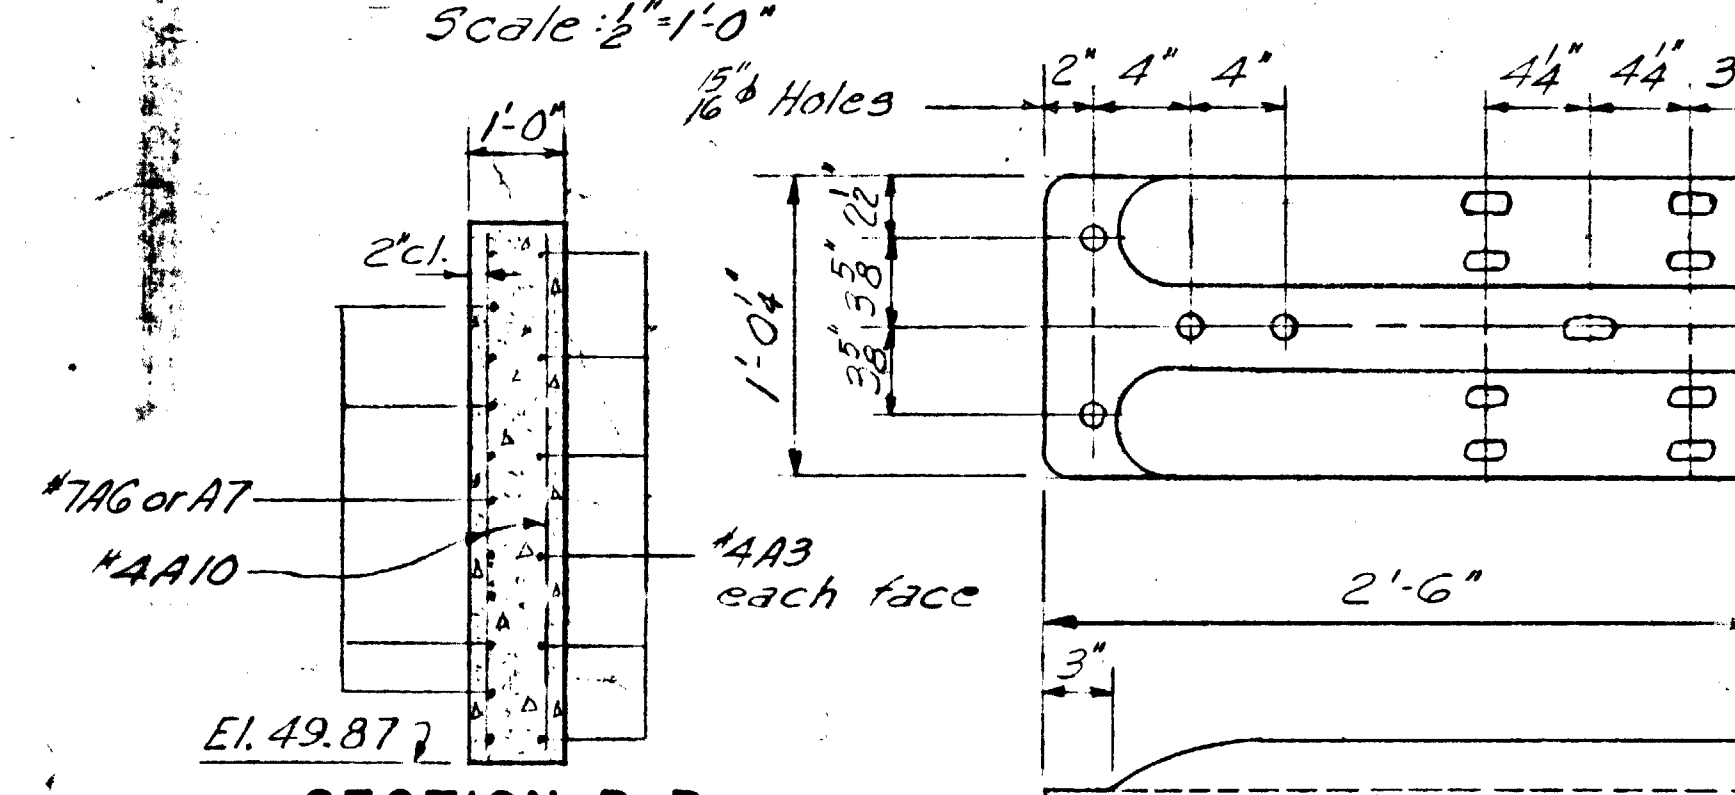


SECTION B-B

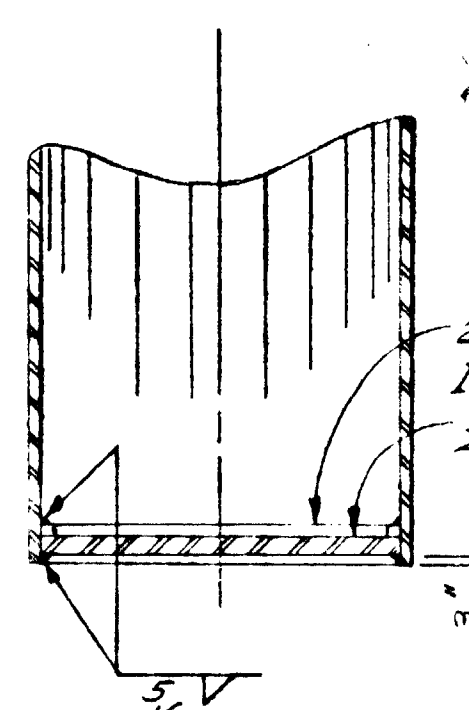


PIPE PILE TIP DETAIL

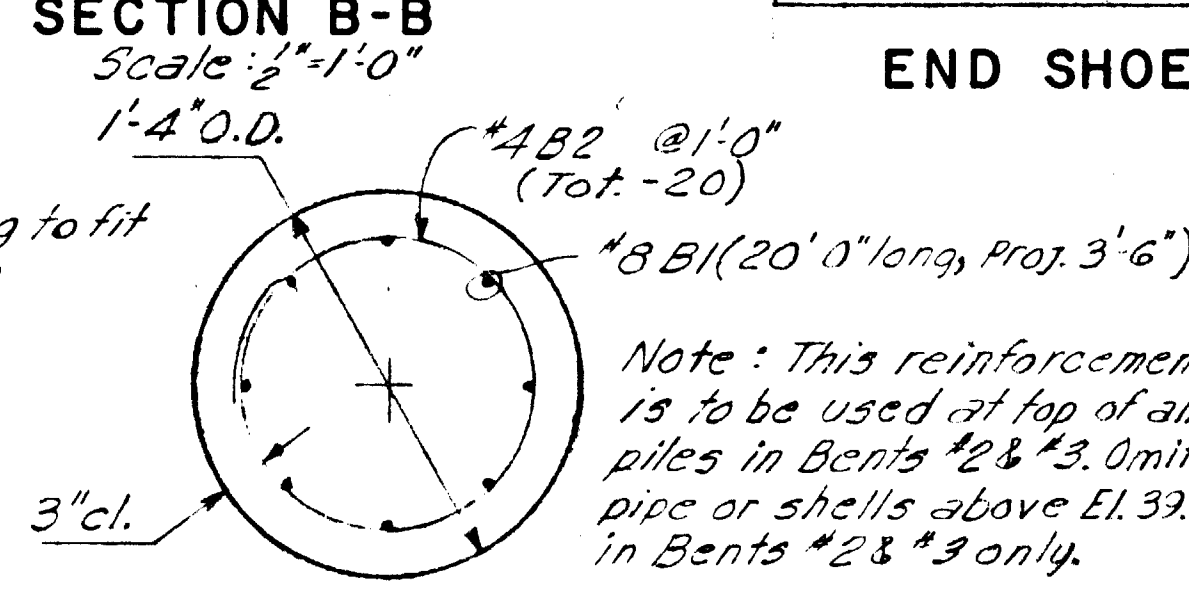


TYPICAL PILE SECTION

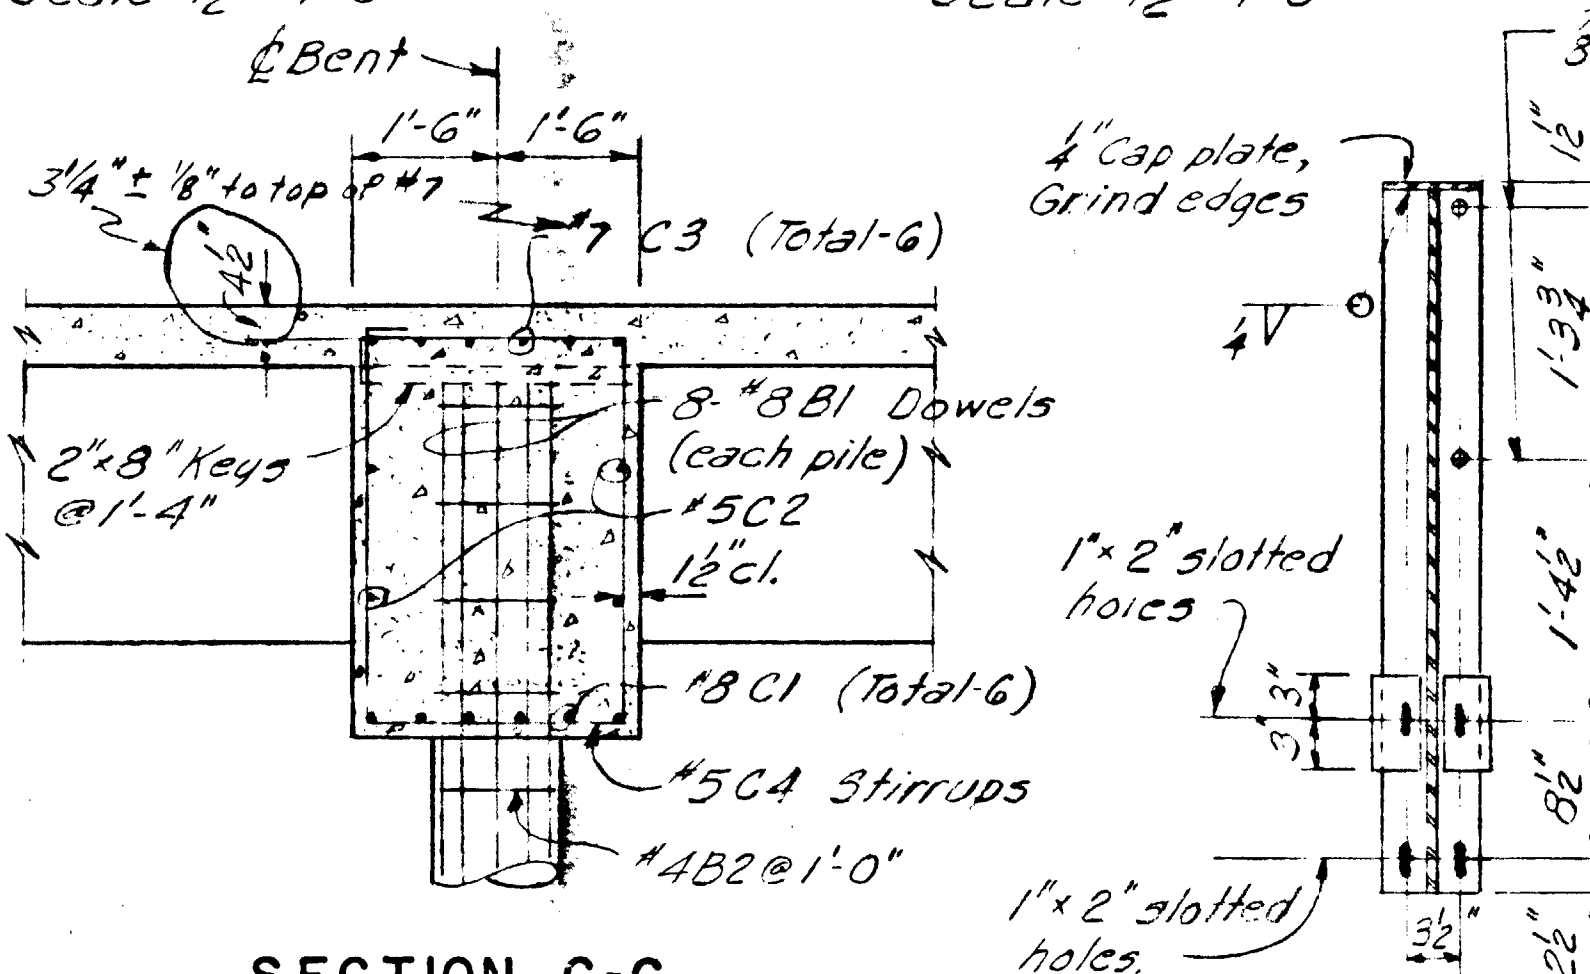


SECTION C-C

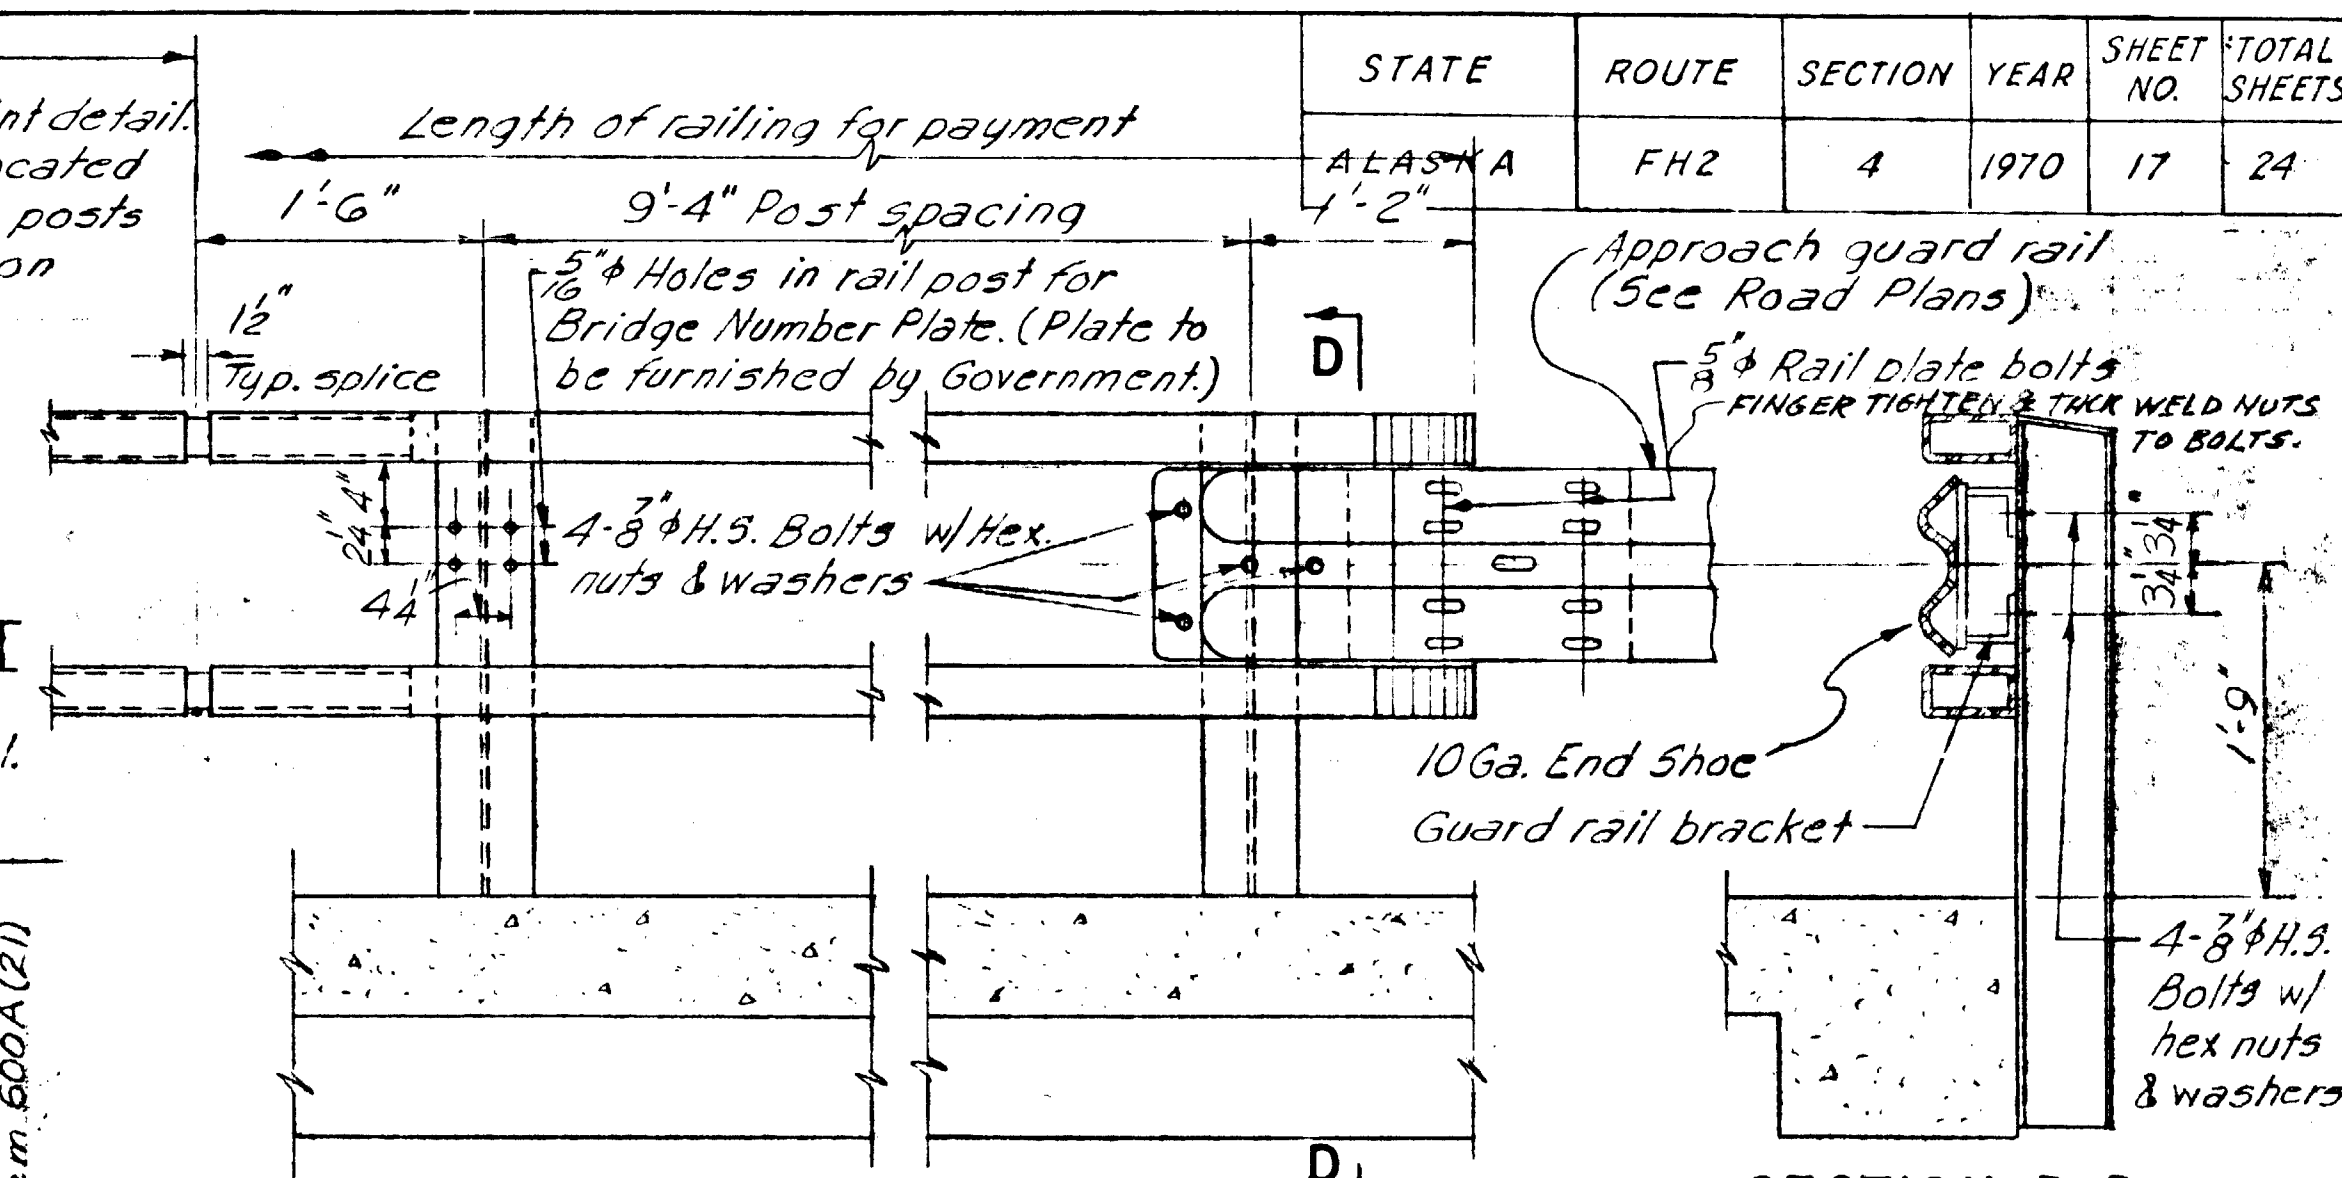


RAIL ELEVATION

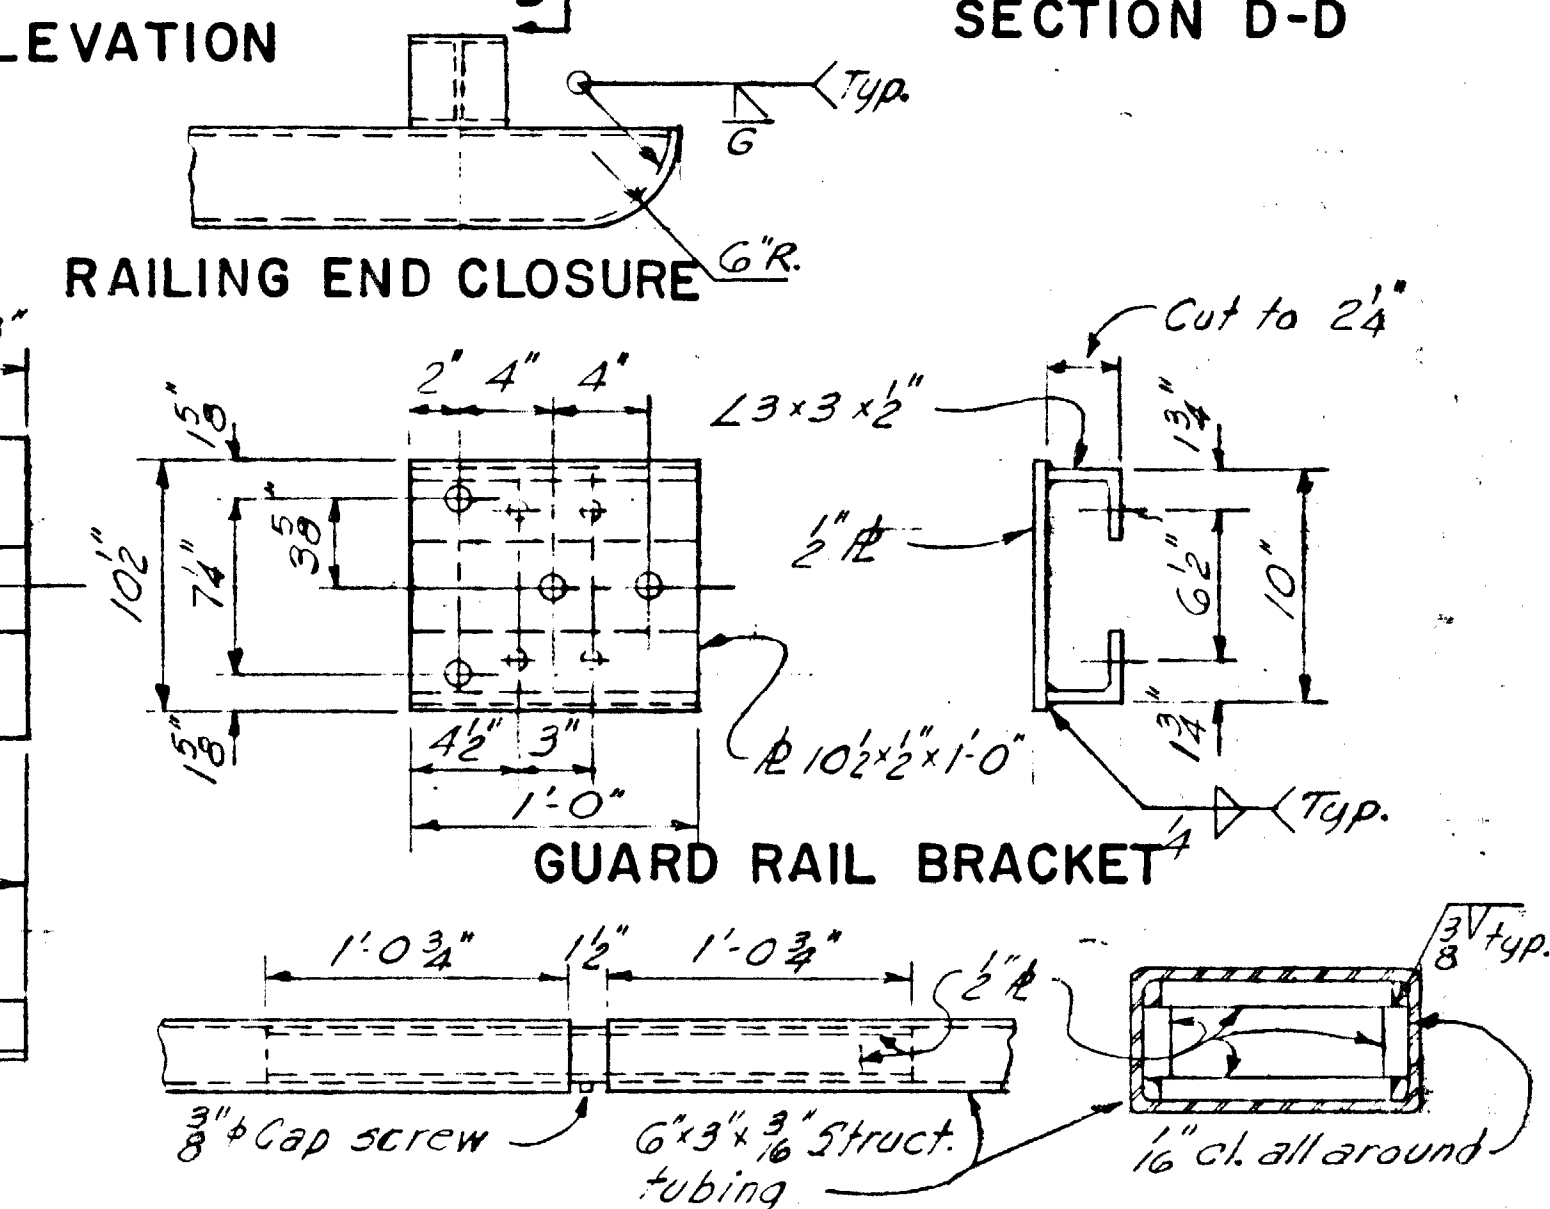

GUARD RAIL BRACKET⁴

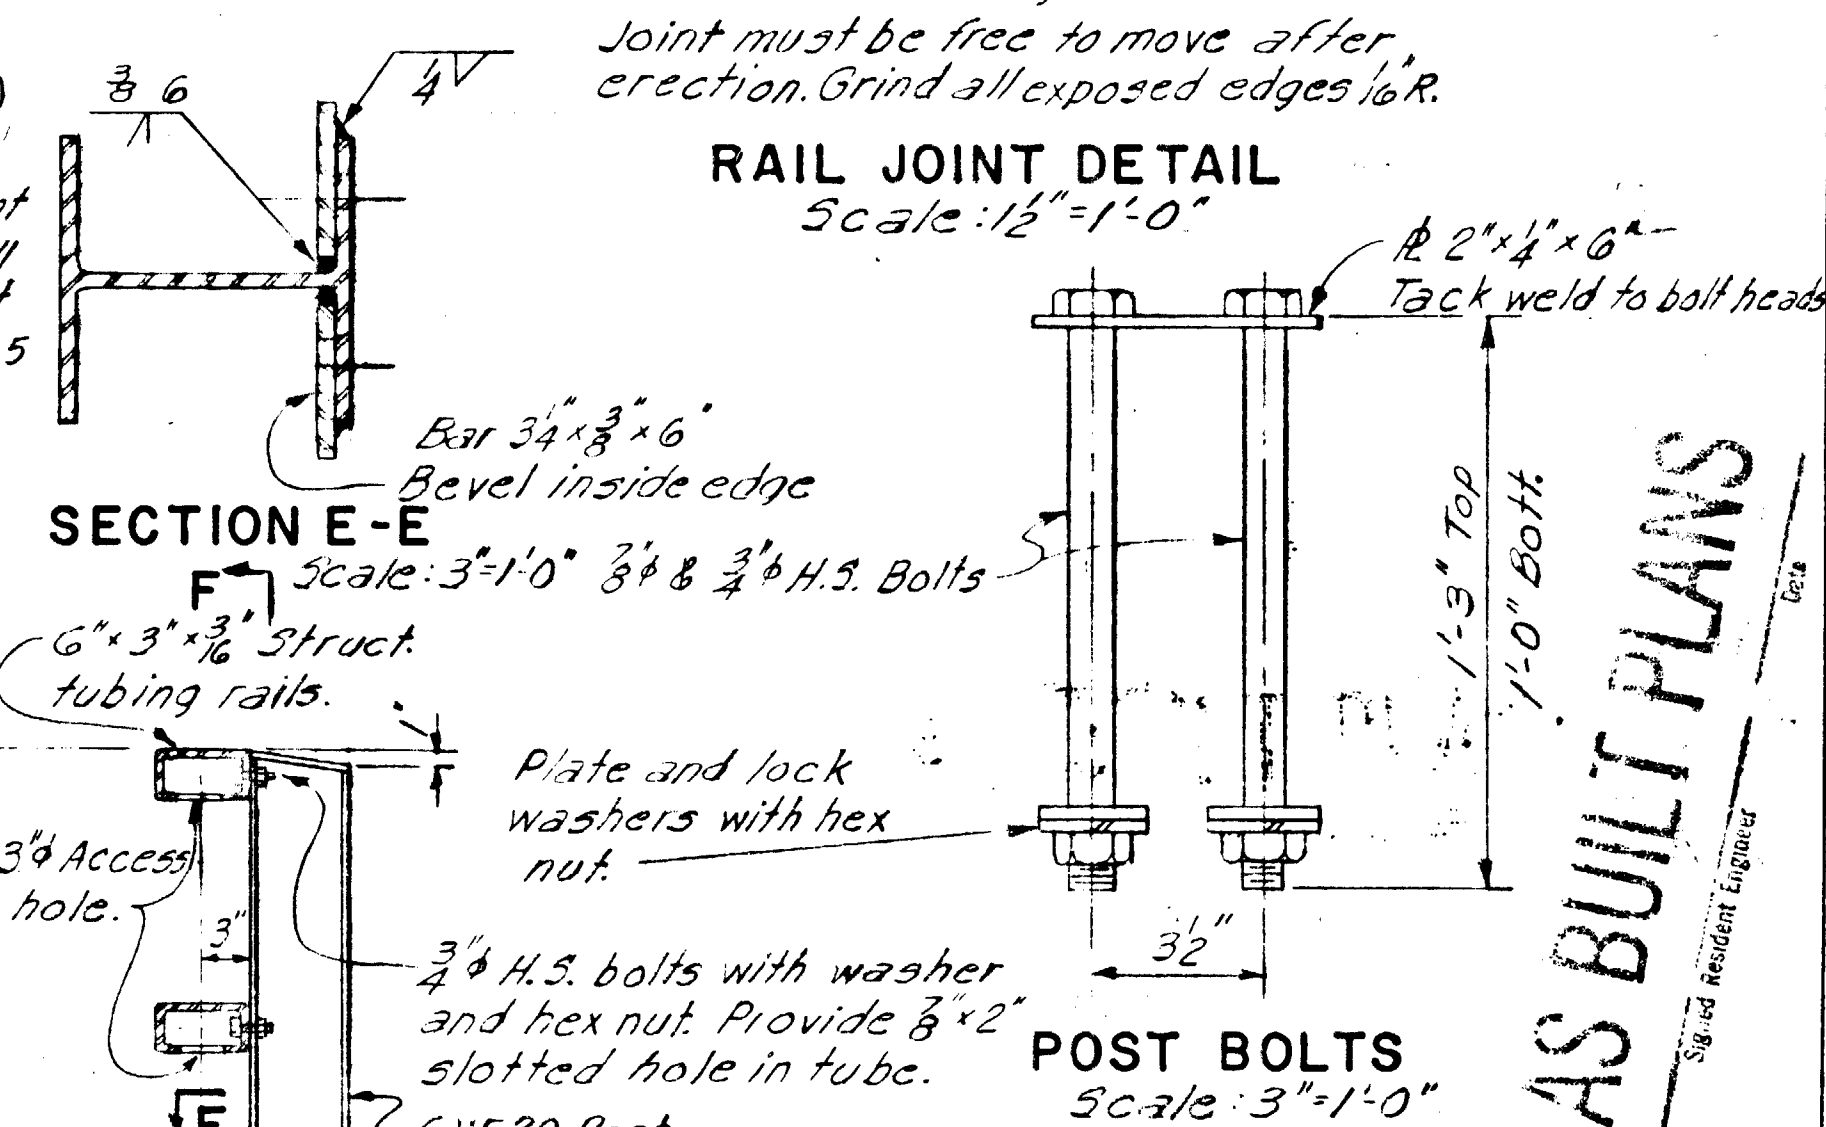

RAIL JOINT DETAIL

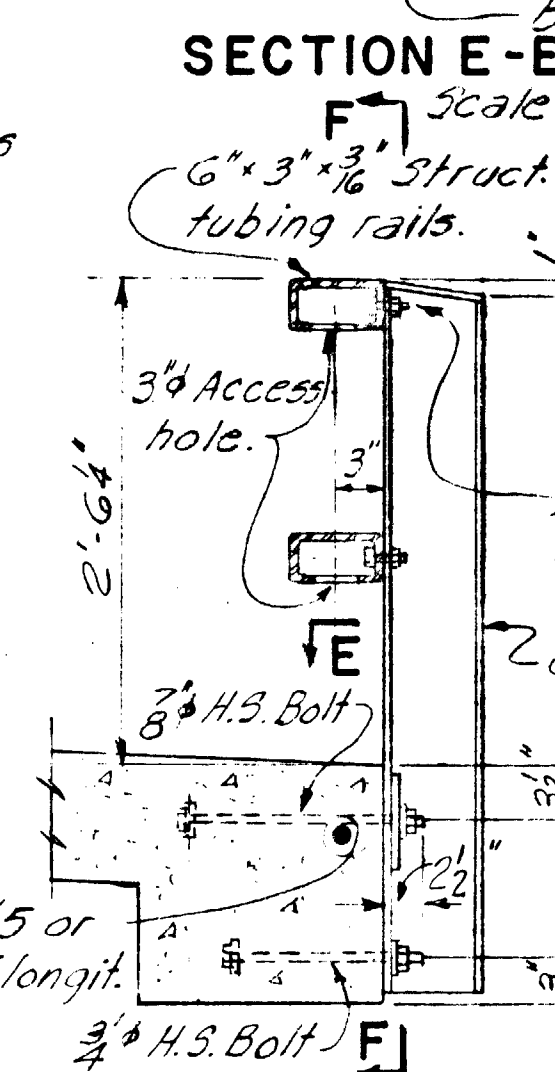

STEEL RAIL & POST

1'-0" Bott.

AS BUILT PLANS

Sig. Resident Engineer

U.S. DEPARTMENT OF TRANSPORTATION
FEDERAL HIGHWAY ADMINISTRATION
HIGHWAY PROGRAMS OFFICE REGION 7 SAN FRANCISCO, CALIFORNIA

COWEE CREEK BRIDGE #1220
BRIDGE NO. 1220




ALASKA FOREST HIGHWAY PROJECT FH2-4(3)
GLACIER HIGHWAY

SCALE: 1"=1'-0" UNLESS NOTED
BRIDGE DRWG. 2 OF 4 DRWGS.

Rev. 7-1-70

RG 1918-B

	STATE	ROUTE	SECTION	YEAR	SHEET NO.	TOTAL SHEETS
9	ALASKA	FH 2	4	1970	18	24

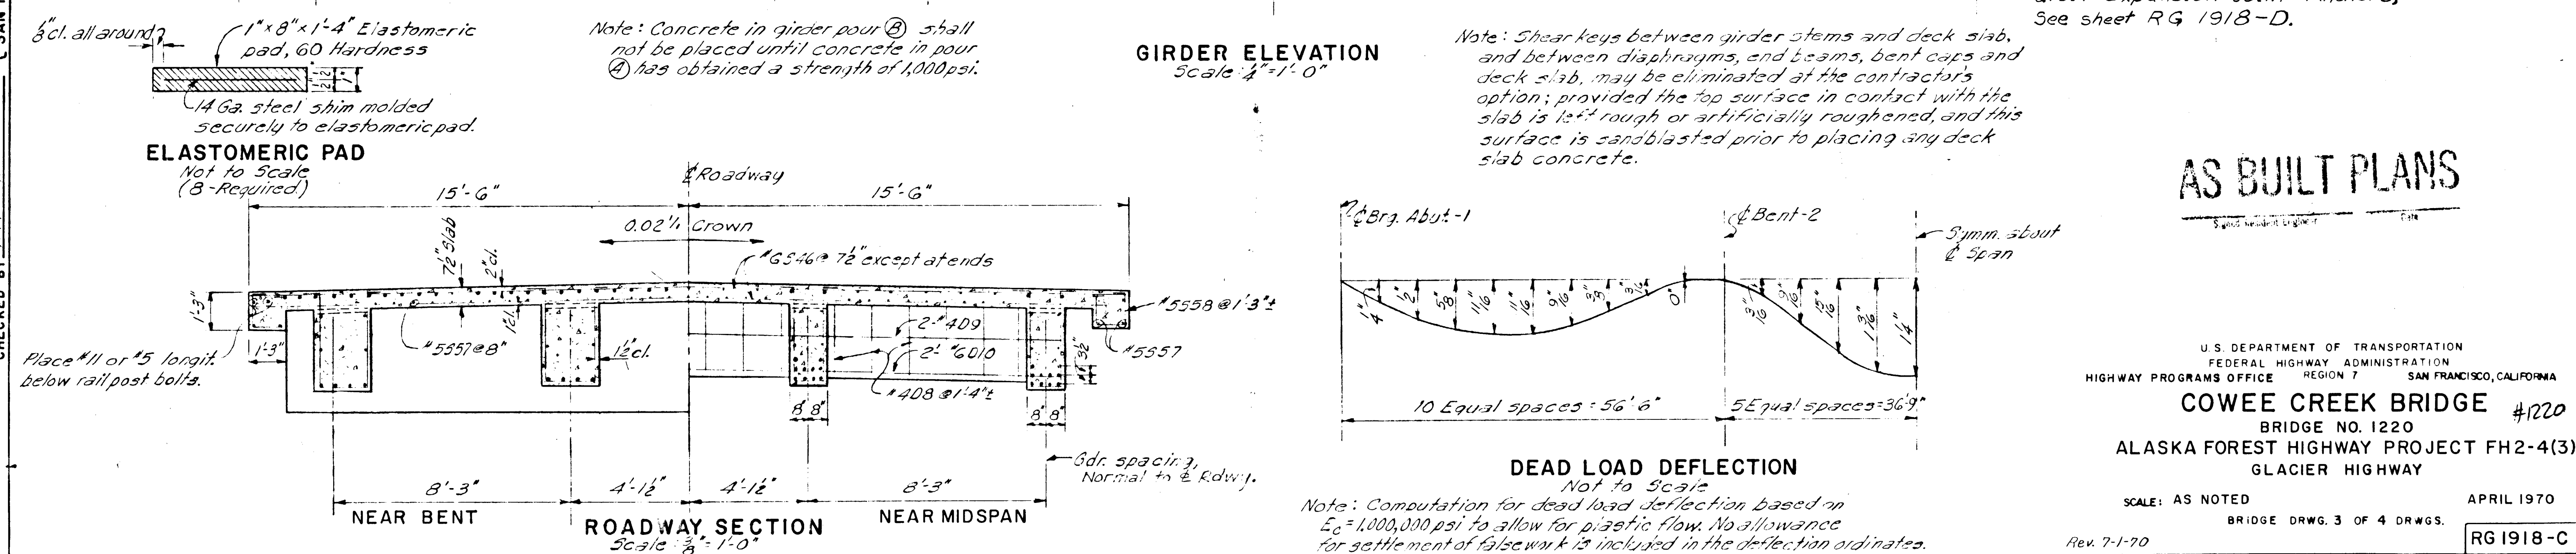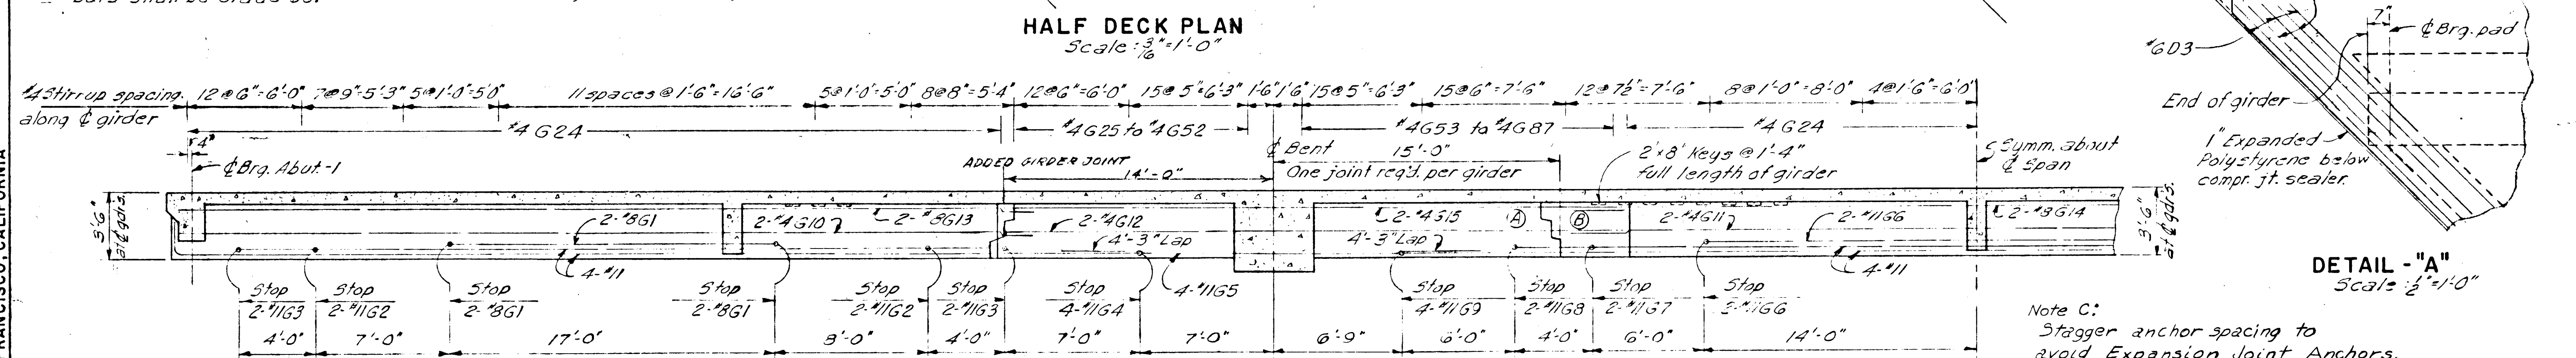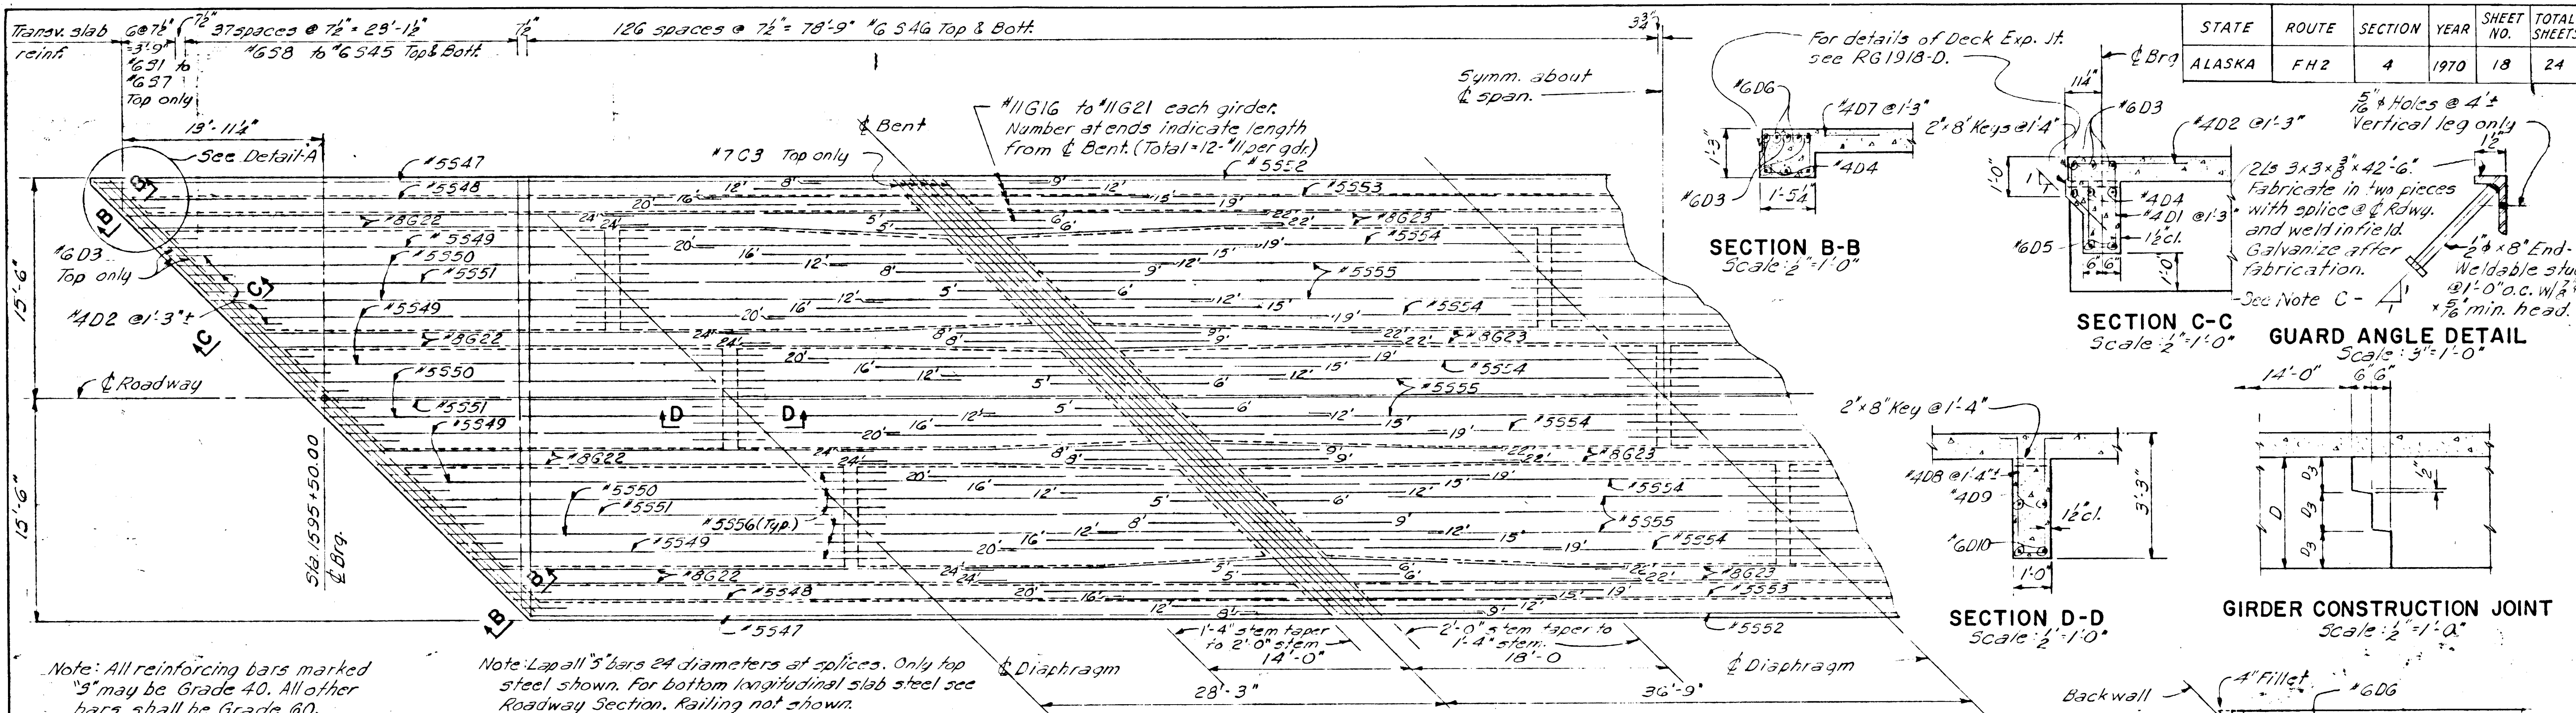

AS BUILT PLANS

U. S. DEPARTMENT OF TRANSPORTATION
FEDERAL HIGHWAY ADMINISTRATION
HIGHWAY PROGRAMS OFFICE REGION 7 SAN FRANCISCO, CALIFORNIA

COWEE CREEK BRIDGE #1220
BRIDGE NO. 1220
ALASKA FOREST HIGHWAY PROJECT FH2-4(3)
GLACIER HIGHWAY

SCALE: AS NOTED
BRIDGE DRWG. 3 OF 4 DRWGS.

RG 1918-C

[illegible]

ELEVATION

Diagram illustrating the elevation view of a concrete wall section. The wall has a total height of 5'-8" and a total length of 42'-8". Reinforcement includes:


- Top longitudinal bars: 6 #10 @ 2'-0" ± - 19'-9" L.O.
- Bottom longitudinal bars: 2 #2 x 8' Headed anchors
- Vertical spacing between top bars: 10'-0" ± 2'-0" ± - 10'-9"
- Horizontal spacing between bottom bars: 2'-0" ± 2'-0" ± - 19'-9" L.O.
- End dimensions: 4' at each end.

Fabricate in two pieces with splice at 1/2 Roadway. Butt weld in field and file seal face flush.

Assemble the two 42'-8" angles with temporary angles and install as a unit. Install compression joint sealer after concrete in both backwall and deck slab has set or is partially cured.

4" Compression joint sealer

42'-8" long. 2-Required.

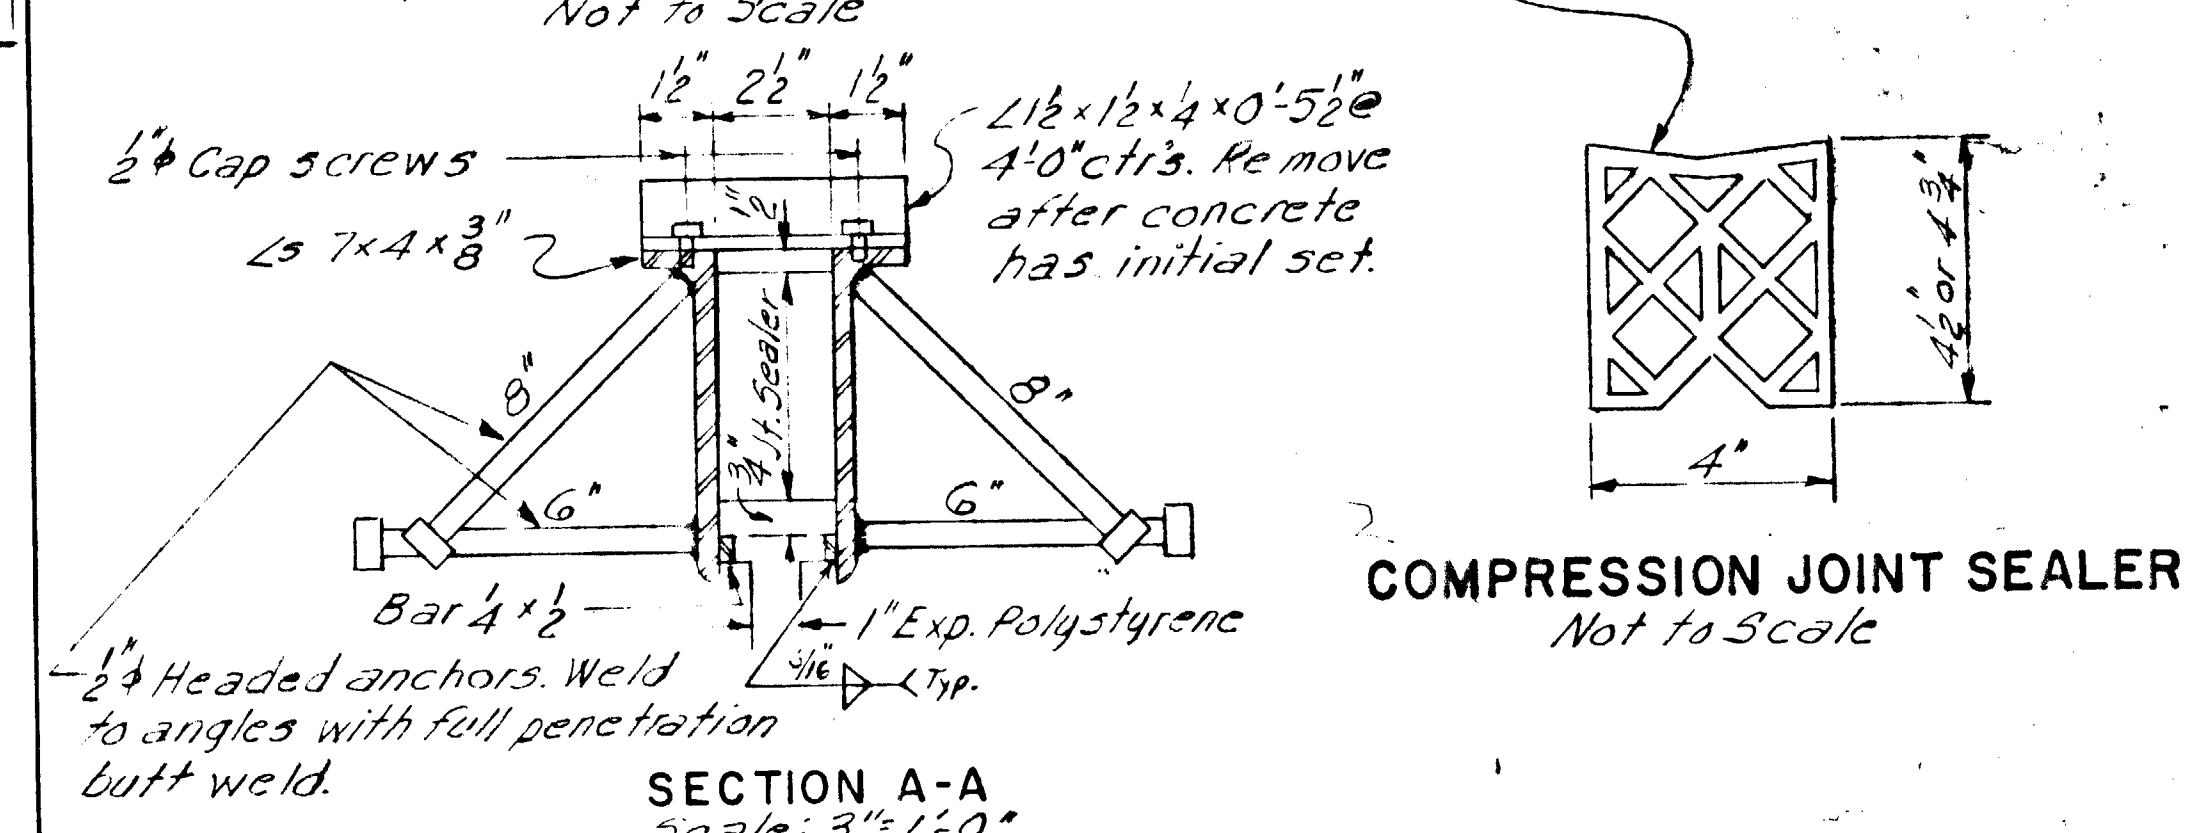

DECK EXPANSION JOINT
Galvanize after fabrication.
2- Required

Note:
The distance set between angles
is to be varied from 2½" by
an amount of ¼" for each
10° variation in temperature
from 40° F.

U.S. DEPARTMENT OF TRANSPORTATION
 FEDERAL HIGHWAY ADMINISTRATION
 HIGHWAY PROGRAMS OFFICE REGION - 7 SAN FRANCISCO, CALIF.





COWEE CREEK BRIDGE
 BRIDGE NO. 1220 #1220
 ALASKA FOREST HIGHWAY PROJECT FH2-4
 GLACIER HIGHWAY

SCALE: NONE UNLESS NOTED
 SHEET 4 OF 4 SHEETS

APRIL 1970
 RG 1918-

Rev. 7-1-70

LOCATION	STRAIGHT BARS				BENT BARS				BENDING DIAGRAMS		
	MARK	NO.	SIZE	LENGTH	MARK	NO.	SIZE	LENGTH	ALL DIMENSIONS ARE OUT TO OUT		
Girder Stems (Int. Gdrs.)					G15C	3	8	32'-0"			
Girder Slab	G16	16	11	11'-0"							
"	G17	16	11	17'-0"							
"	G18	16	11	24'-0"							
"	G19	16	11	31'-0"							
"	G20	16	11	39'-0"							
Girder Slab (Ext. Gdrs.)					G12B	4	11	46'-0"			
" (Int. Gdrs.)					G12C	8	11	46'-0"			
"	G22	16	8	36'-8"					X		
"	G23	8	8	35'-6"							
Girder Stirrups					G24	540	4	8'-3"	1'-1"		
"					G25	8ea	4	8'-3"	1'-1"		
"					to of 13		to	to	3" Increments		
"					G37	104	4	8'-7 1/2"			1'-5 1/2"
"					G38	8ea	4	8'-7 3/4"	1'-5 3/4"		4" Increments
"					to of 15		to	to			
"					G52	120	4	8'-11 1/4"	1'-9 1/4"		15 Equal Decrements = 4" (-)
"					to of 16		to	to			
"					G68	128	4	8'-8 1/4"	1'-6 1/4"		4" Decrements
"					G69	8ea	4	8'-7 1/2"	1'-5 3/4"		
"					to of 15		to	to	3" Decrements		
"					G83	120	4	8'-4 1/4"		1'-2 1/4"	
"					G84	8ea	4	8'-4 1/8"	1'-2 1/8"	3" Decrements	
"					to of 4		to	to			
"					G87	32	4	8'-3"	1'-1"		
Slab Transv.	51	2ea	6	2'-8"							
"	to of 7		to								
"	57	14	6	6'-5"							
"	58	4ea	6	7'-0 1/2"							
"	to of 38		to								
"	545	152	6	30'-2"							
"	546	508	6	30'-8"							
" Top Longit.	547	4	5	52'-3"				1-splice allowed			
"	548	4	5	43'-0"							
"	549	12	5	39'-0"							
"	550	12	5	48'-3"				1-splice allowed			
"	551	3	5	194'-0"				4-splices allowed			
"	552	2	5	59'-3"				1-splice allowed			
"	553	2	5	46'-0"							
"	554	6	5	38'-0"							
"	555	6	5	53'-3"				1-splice allowed			
" Over Diaphs.	556	54	5	5'-0"							
" Bottom Longit.	557	31	5	194'-0"				4-splices allowed stagger adjacent bar splices.			
Edge Slab Ties					558	302	5	3'-11"			

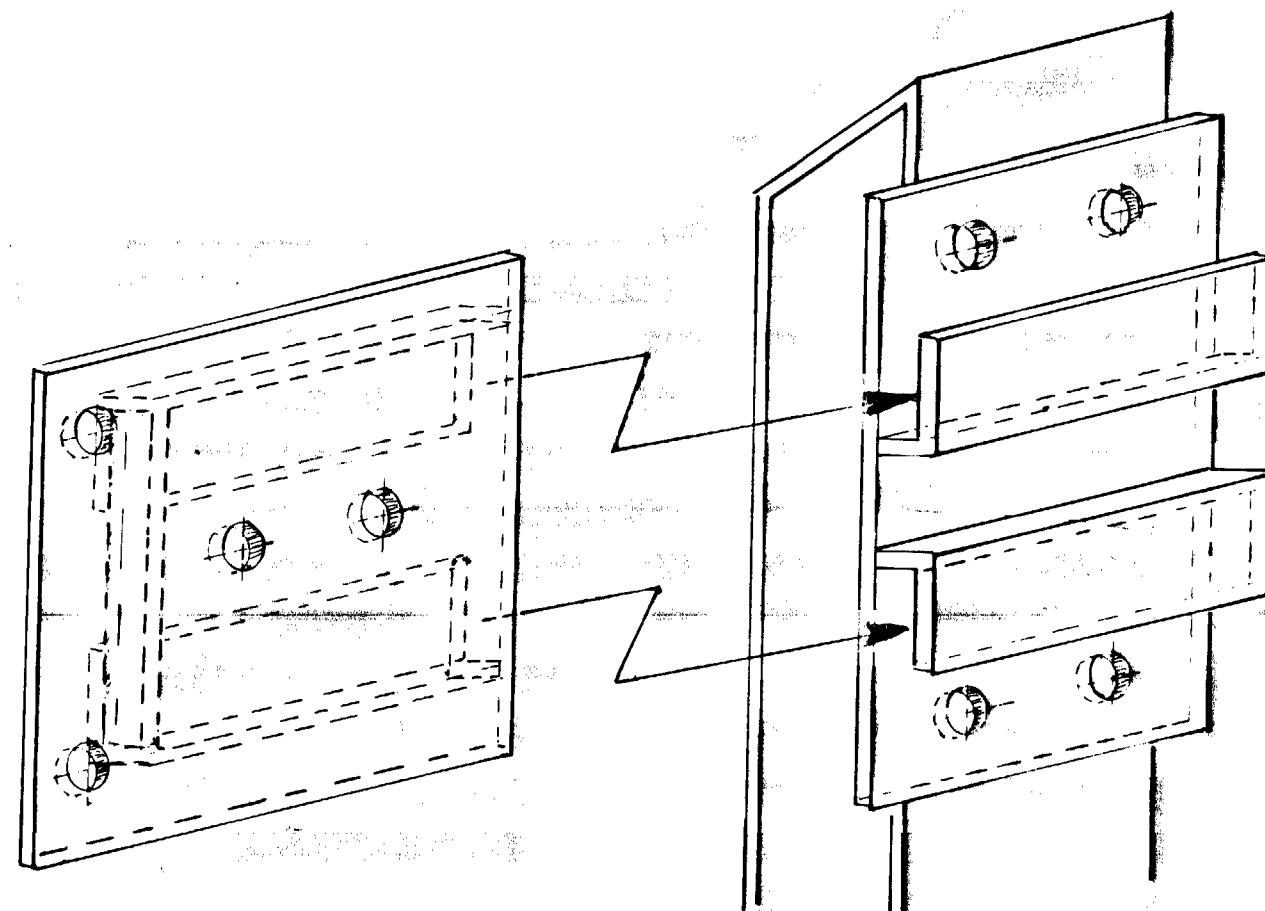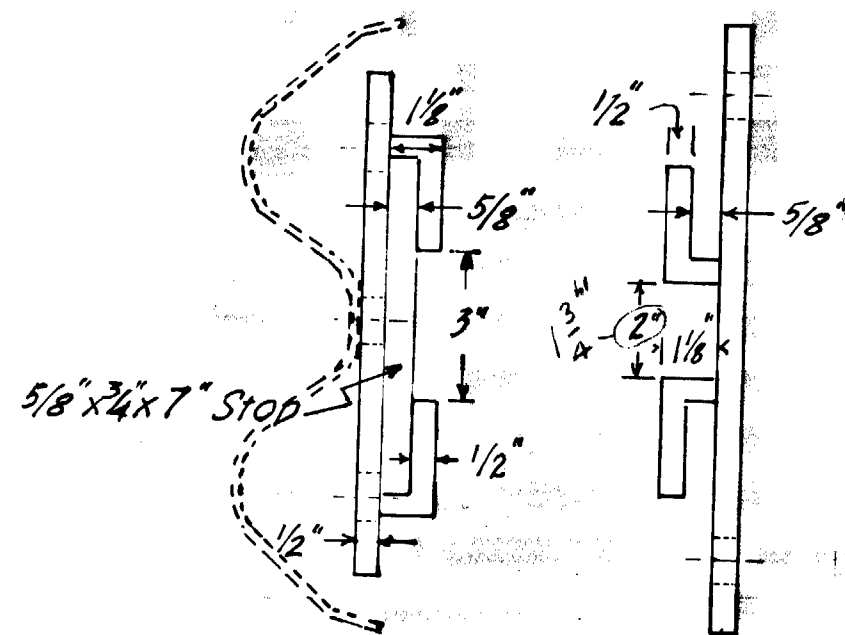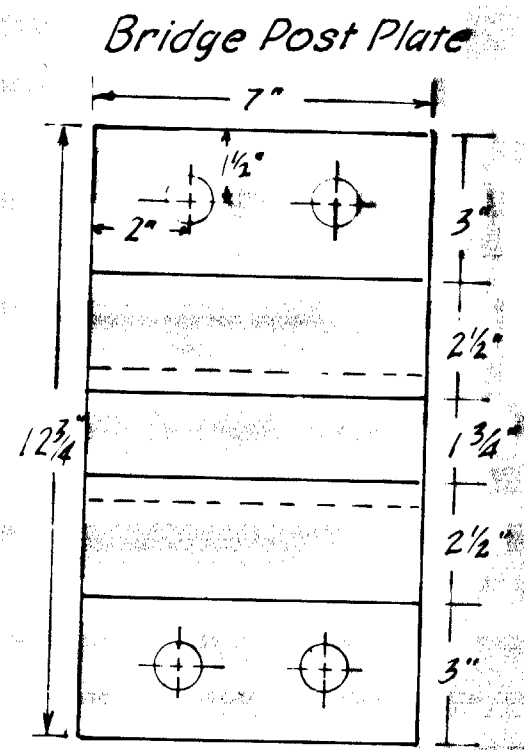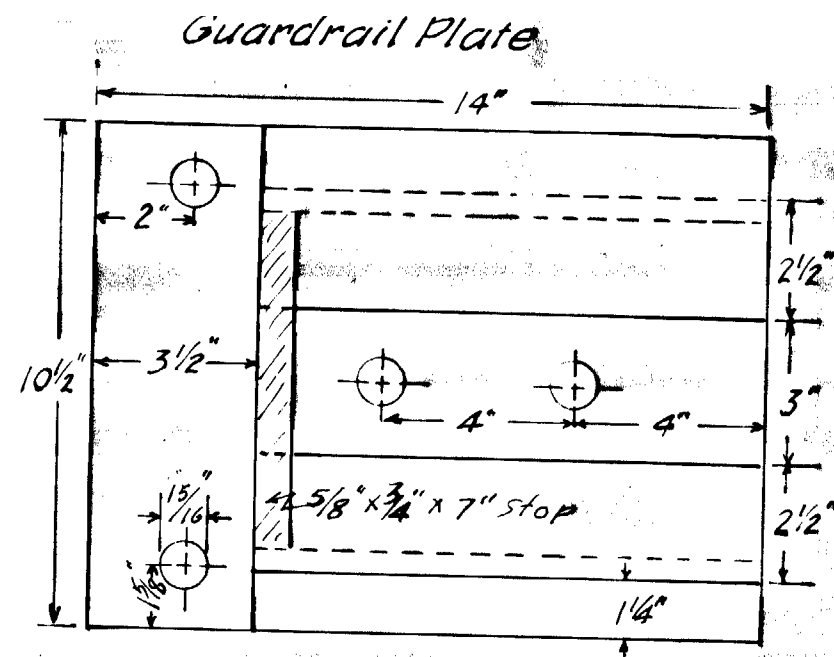

SCALE: 1/4" = 1"