



8/06/2015, 9:41 AM
Date Plotted: 8/06/2015, 9:41 AM
Layout Name: DATA
File Name: W:\Projects\Adak\1-General - non-Project\ALP - 2015\1-Drawings\ALP-Adak-DATA.dwg
Designed By:
Drawn By:
Checked By:

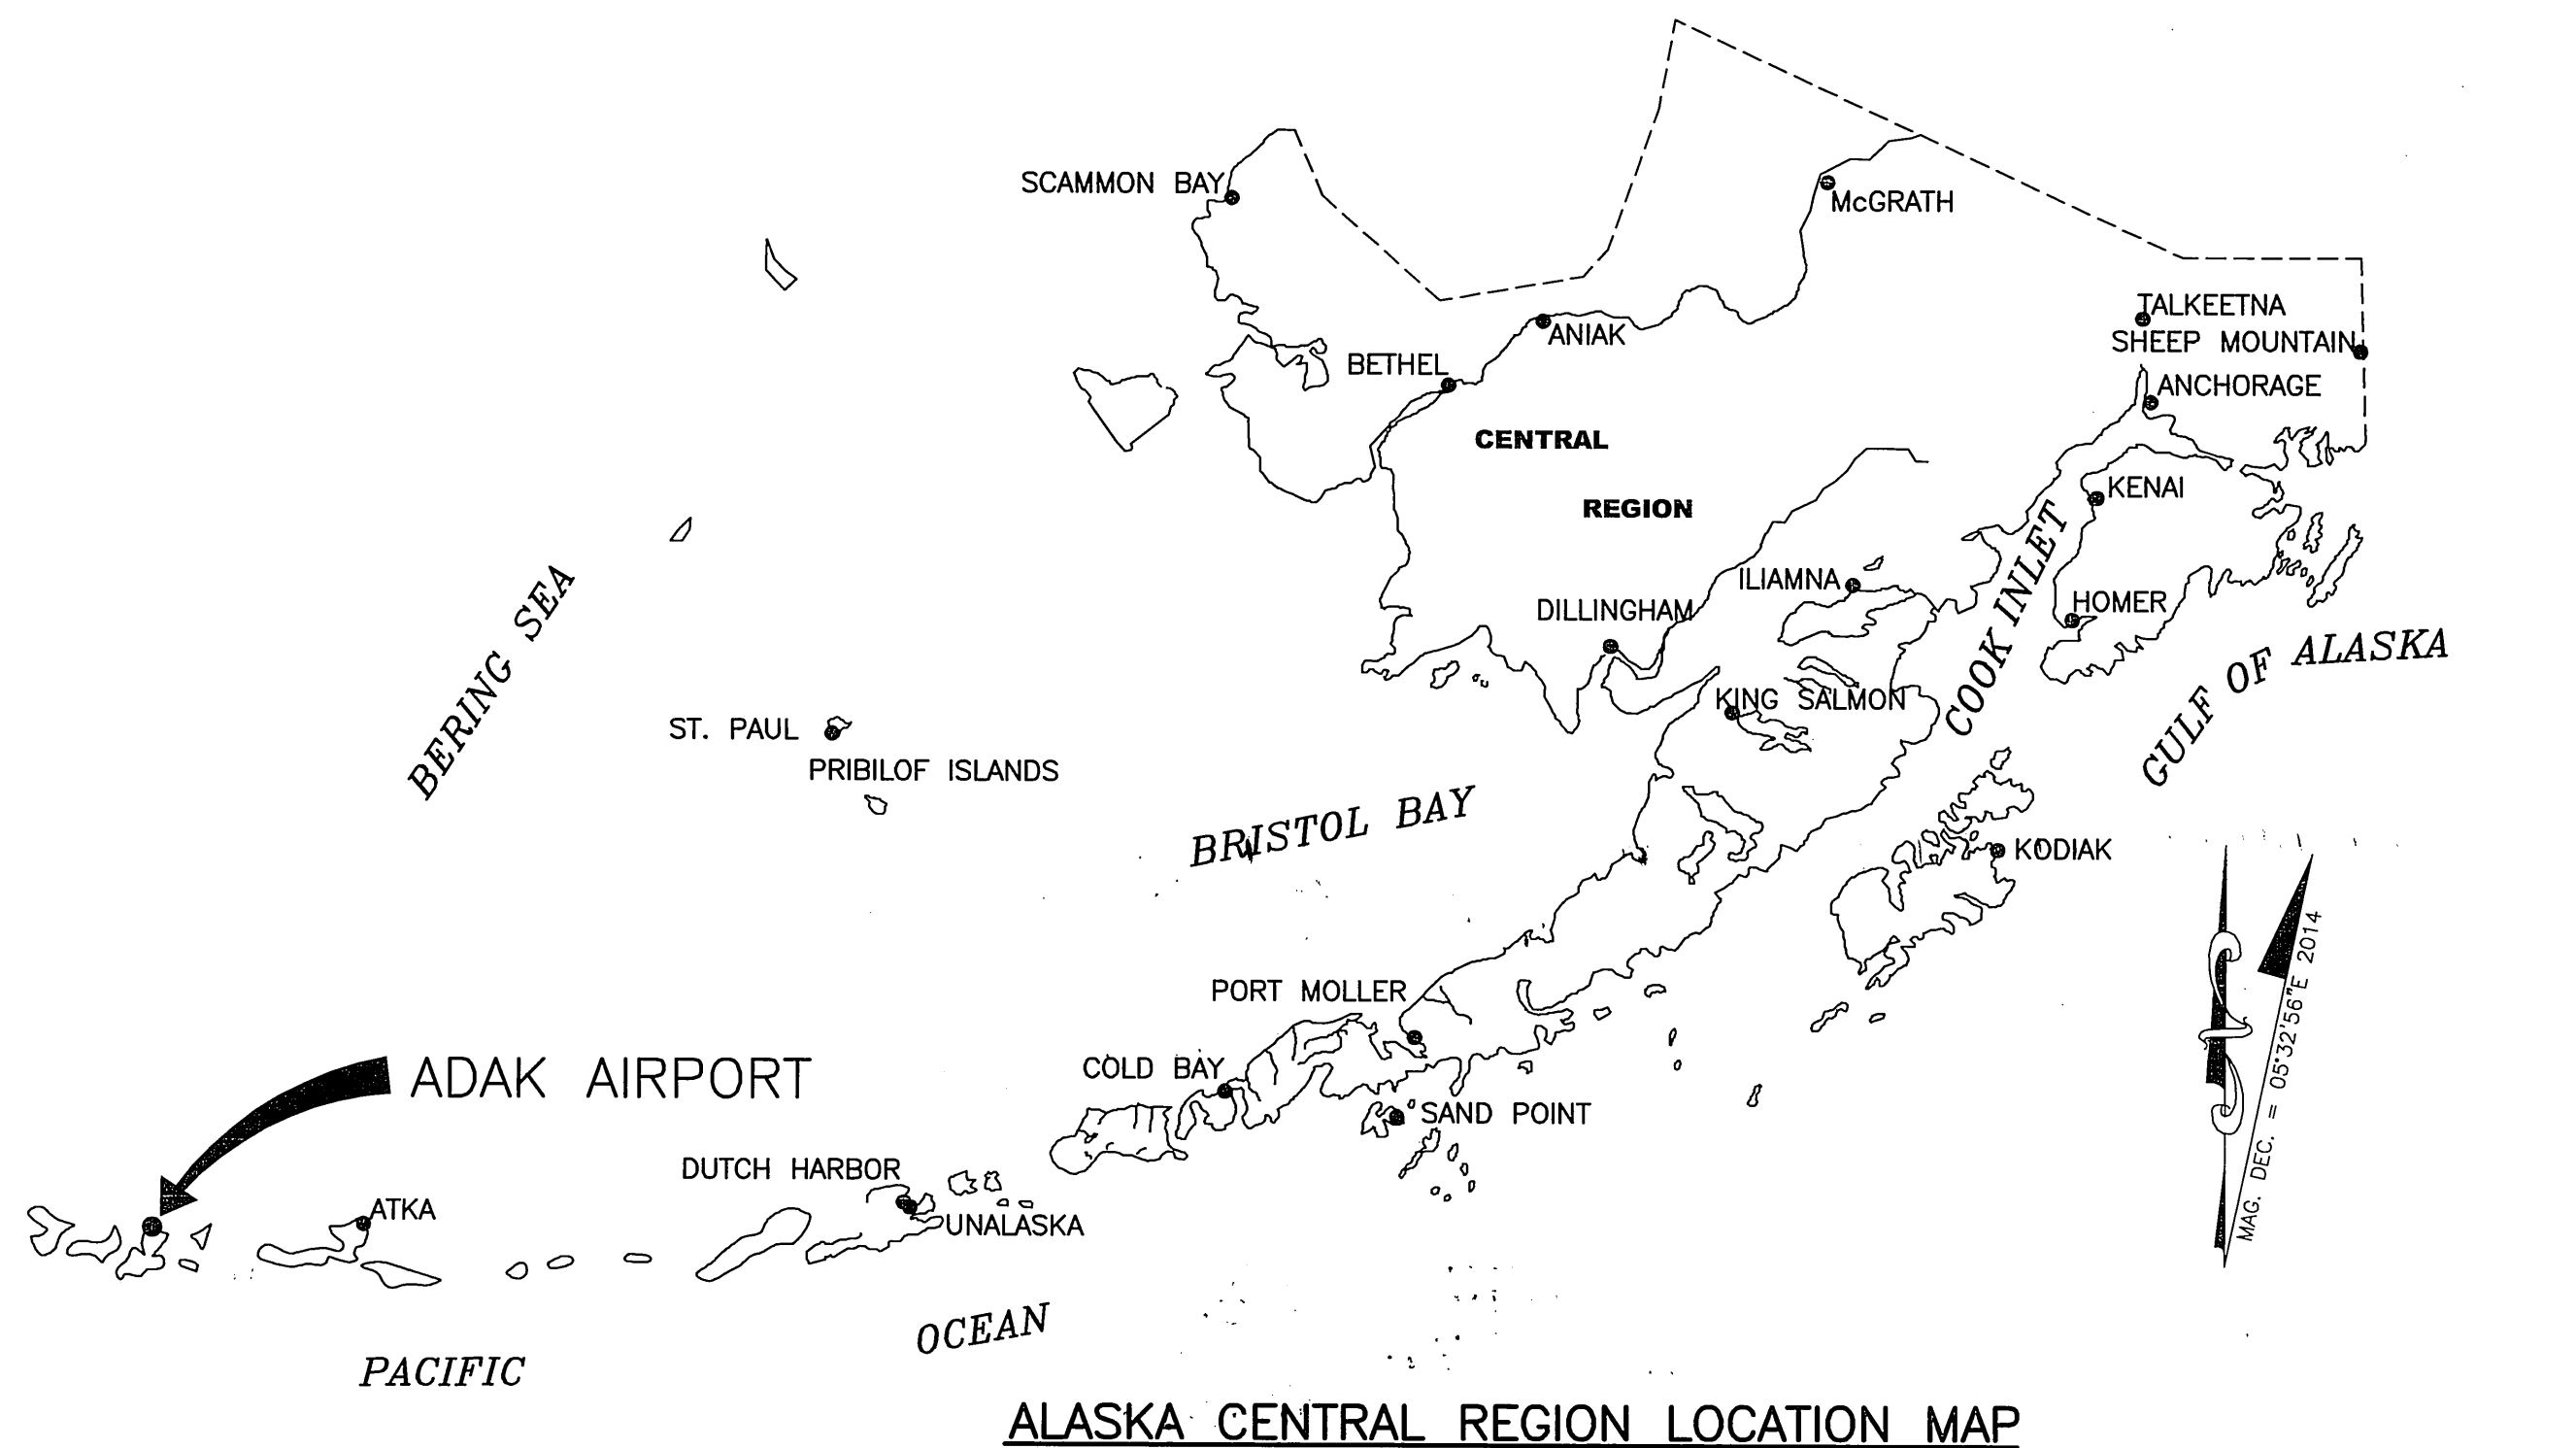

ALASKA CENTRAL REGION LOCATION MAP

ADAK AIRPORT AIRPORT LAYOUT PLAN

ADAK, ALASKA

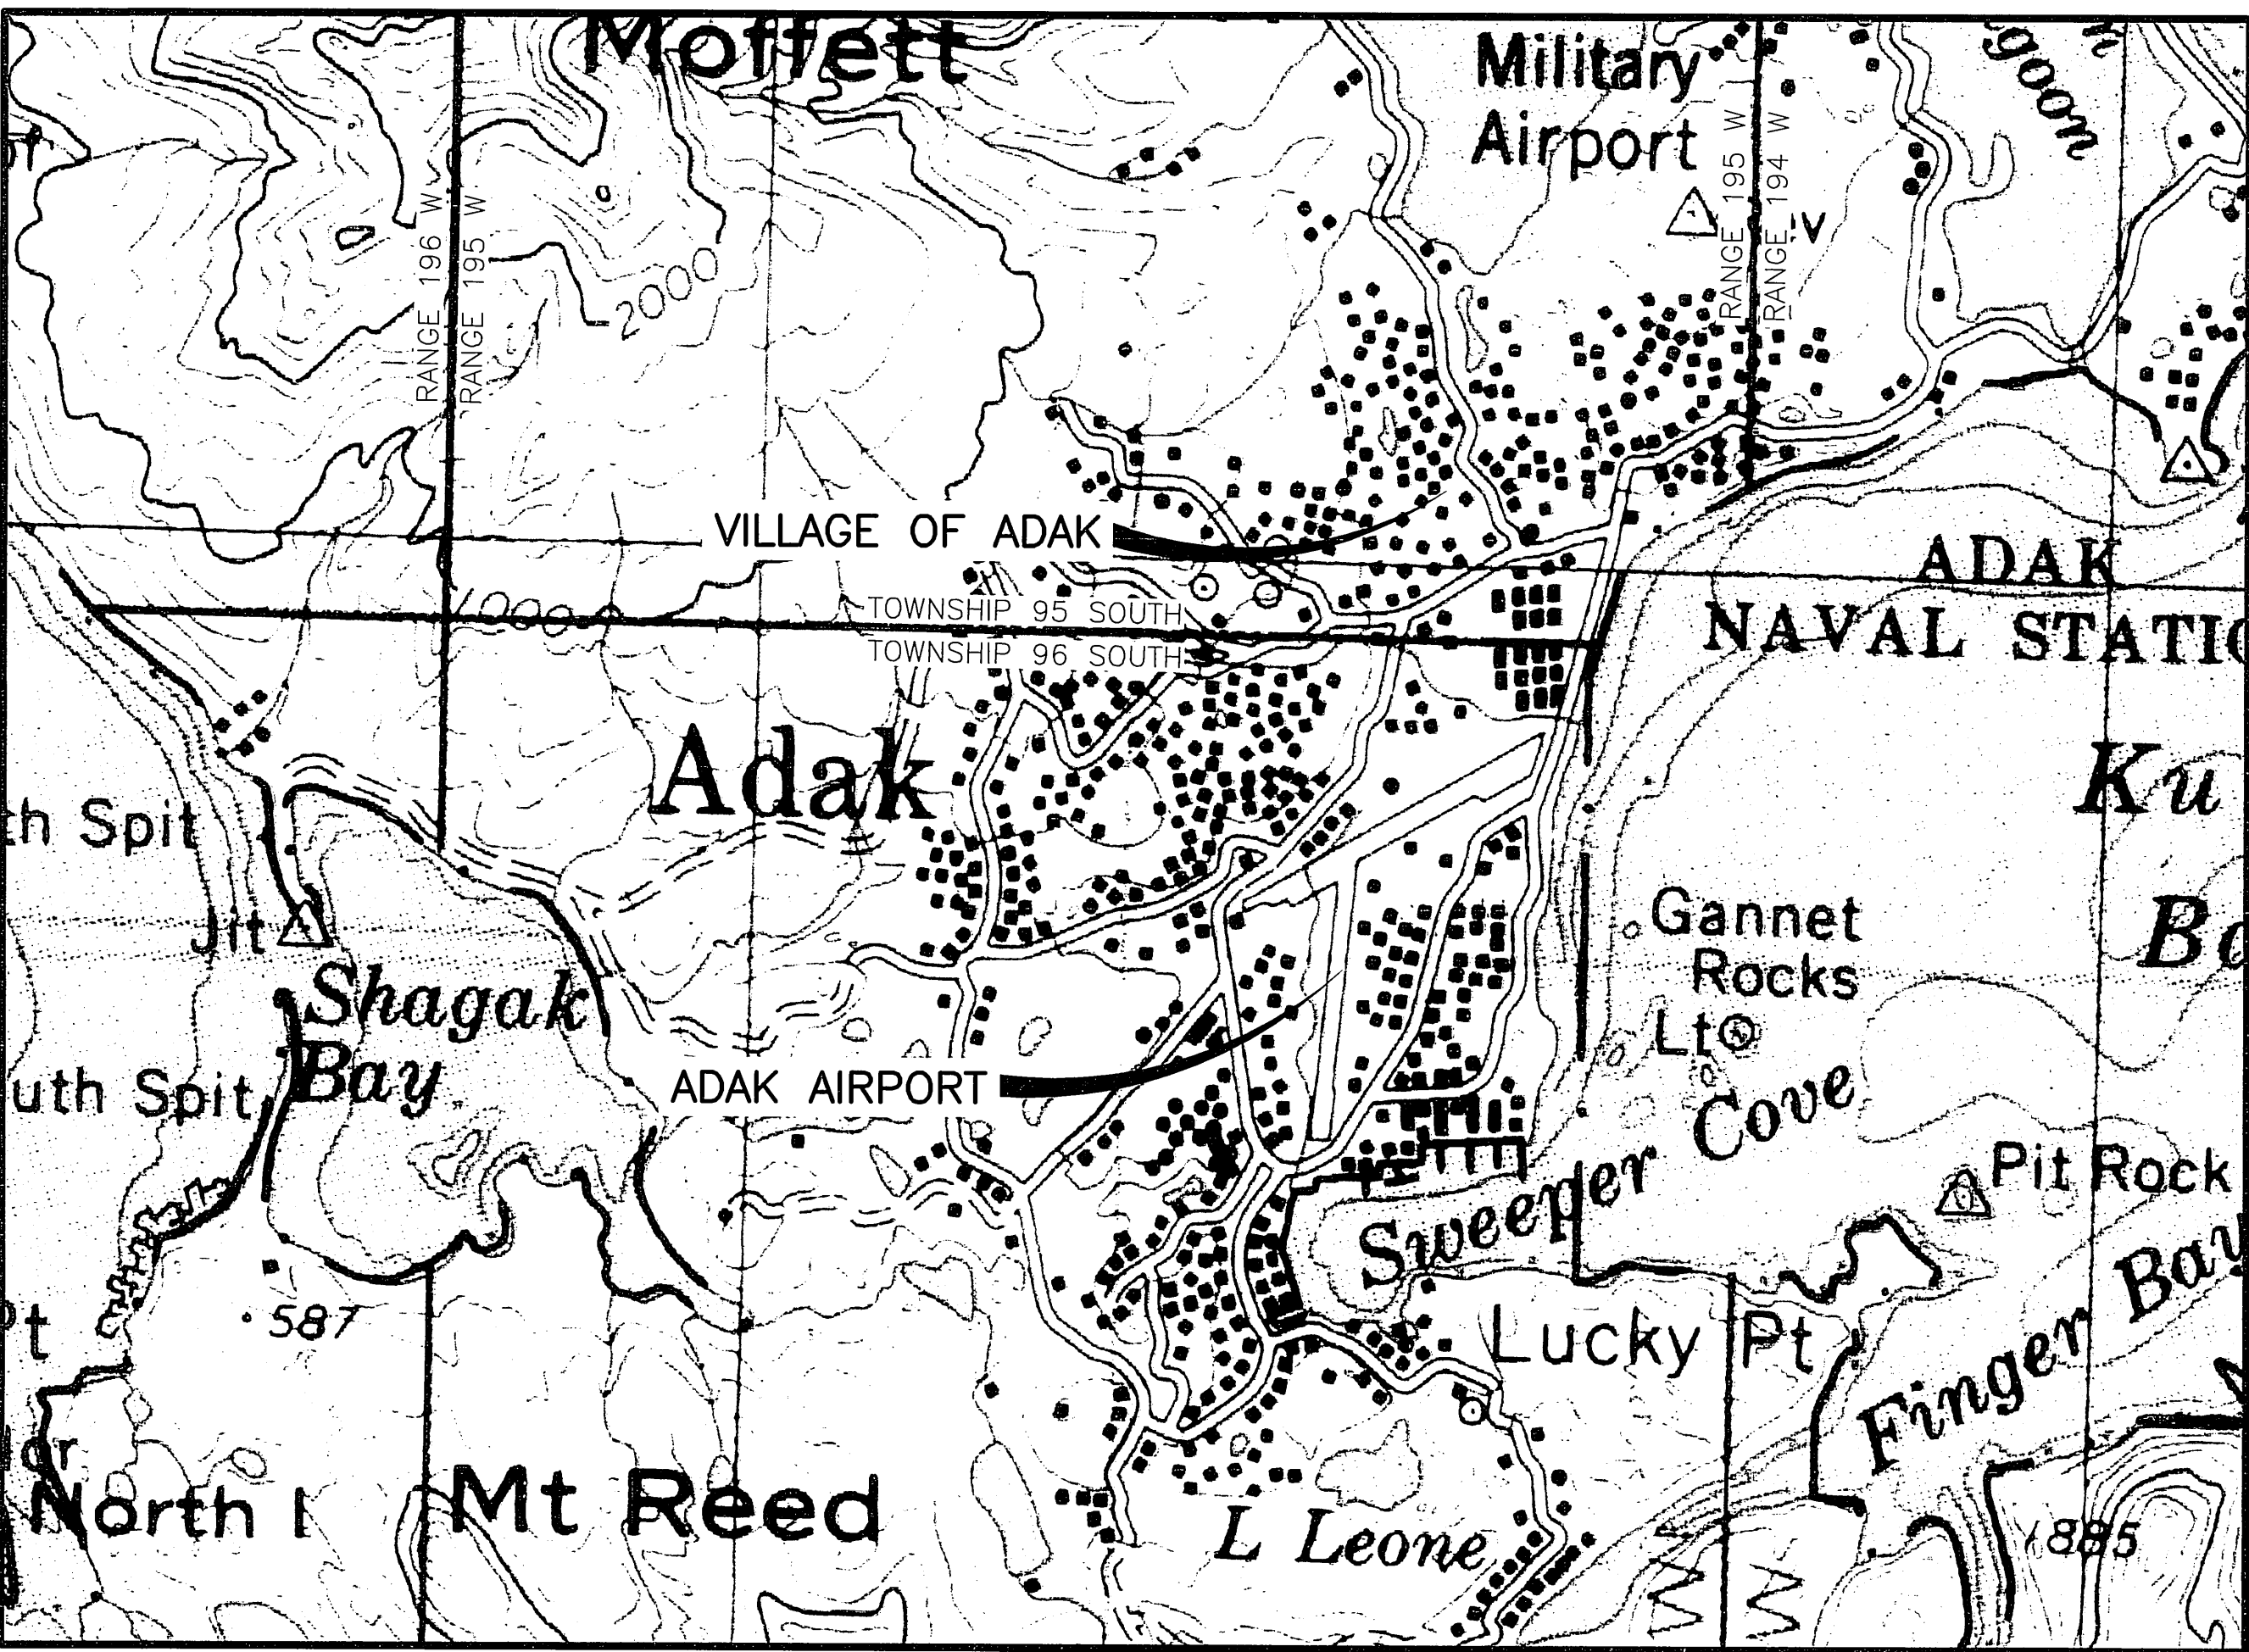

VICINITY MAP

1 SM .5 SM 0 1 SM 2 SM
T 96 S, R 195 W, SEC. 2,3,10,11,14 & 15
SEWARD MERIDIAN
U.S.G.S. TRINITY ISLANDS (D-1) 1957, ALASKA

LEGEND		
ITEM	EXISTING	ULTIMATE
AIRPORT REFERENCE POINT (A.R.P.)		
ANTENNA		
APPROACH		
APPROACH SITING		
AWOS		
BLUFF		
BUILDINGS		
BUILDING RESTRICTION LINE		
CLOSED RUNWAY/TAXIWAY MARKER		
DEPARTURE SITING		
ELECTRIC GATE		
FENCE		
GLIDESLOPE QUALIFICATION		
LIGHT POLE		
NAVAID CRITICAL AREA		
NON-DIRECTIONAL BEACON		
OMNI-DIRECTIONAL APPROACH LIGHTING SYSTEM (ODALS)		
PAPI		
PAPI SITING SURFACE		
PROPERTY LINE		
REIL		
REIL SITING SURFACE		
ROADWAYS		
ROTATING BEACON		
RUNWAY OBSTACLE FREE AREA		
RUNWAY OBSTACLE FREE ZONE		
RUNWAY PROTECTION ZONE		
RUNWAY PROTECTION ZONE - APPROACH		
RUNWAY PROTECTION ZONE - DEPARTURE		
RUNWAY SAFETY AREA		
SEGMENTED CIRCLE		
SHORELINE		
SURVEY MONUMENT		
THRESHOLD MARKERS/LIGHTS		
TOPOGRAPHIC CONTOURS		
TREE (LARGE SINGLE)		
TREELINE		
UTILITY POLE		
VASI		
VISUAL ZONE		
WATER BODY		
WIND CONE		

DRAWING INDEX	
SHT#	TITLE
1	AIRPORT DATA
2	AIRPORT DATA
3	AIRPORT DATA
4	EXISTING LAYOUT
5	EXISTING LAYOUT
6	EXISTING INNER PORTION OF THE APPROACH SURFACE - RUNWAY 5
7	EXISTING INNER PORTION OF THE APPROACH SURFACE - RUNWAY 23
8	EXISTING INNER PORTION OF THE APPROACH SURFACE - RUNWAY 23
9	EXISTING INNER PORTION OF THE APPROACH SURFACE - RUNWAY 10
10	EXISTING INNER PORTION OF THE APPROACH SURFACE - RUNWAY 36
11	EXISTING RUNWAY CENTERLINE PROFILES
12	EXISTING RUNWAY CENTERLINE PROFILE
13	EXISTING INNER PORTION OF THE APPROACH SURFACE - RUNWAY 5
14	EXISTING INNER PORTION OF THE APPROACH SURFACE - RUNWAY 23
15	EXISTING INNER PORTION OF THE APPROACH SURFACE - RUNWAY 10
16	EXISTING INNER PORTION OF THE APPROACH SURFACE - RUNWAY 36
17	EXISTING DEPARTURE & APPROACH SITING SURFACES - RUNWAY 5
18	EXISTING DEPARTURE & APPROACH SITING SURFACES - RUNWAY 23
19	EXISTING DEPARTURE, APPROACH SITING & OFZ - DATA TABLES
20	EXISTING DEPARTURE & APPROACH SITING SURFACES - RUNWAY 5
21	EXISTING DEPARTURE & APPROACH SITING SURFACES - RUNWAY 23
22	EXISTING DEPARTURE, APPROACH SITING & OFZ - DATA TABLES
23	SIGNIFICANT OBJECTS & BUILDING TABLES
24	TERMINAL AREA
25	AIRPORT AIRSPACE, 14 CFR, PART 77
26	AIRPORT AIRSPACE, 14 CFR, PART 77 RUNWAY 23 APPROACH
27	AIRPORT AIRSPACE, 14 CFR, PART 77 DATA TABLES
28	AIRPORT AIRSPACE, 14 CFR, PART 77 DATA TABLES
29	PROPERTY MAP

4/4/2017	AS-BUILT PER PROJECT Z549720000
DATE	REVISION

APPROVED: _____ DATE: _____
KENNETH M. MORTON, P.E. PRECONSTRUCTION ENGINEER
RECOMMENDED: _____ DATE: 8/12/15
WOLFGANG E. JUNGE, P.E. DESIGN SECTION CHIEF
AIRPORT LAYOUT PLAN CONDITIONAL APPROVAL SUBJECT TO
ALP APPROVAL LETTER DATED 8/21/2015
FAA AIRSPACE REVIEW NUMBER: 2015-AAL-124-NKA
AS-BUILT 8/21/15
5-24-17 DATE: 8/21/15
FAA, AIRPORTS DIVISION ALASKA REGION, AAL-6012

STATE OF ALASKA
DEPARTMENT OF TRANSPORTATION
AND PUBLIC FACILITIES
CENTRAL REGION

ADAK AIRPORT
ADAK, ALASKA
AIRPORT LAYOUT PLAN

AIRPORT DATA

DATE:
AUGUST 2015
SHEET:
1 OF
24

NOTE:


1. OFZ INCLUDES SALSF REQUIREMENT
2. DECLARED DISTANCES IMPLEMENTED ON THIS RUNWAY

NOTE:
1. OFZ INCLUDES SALSF REQUIREMENT

MODIFICATIONS TO STANDARDS


STATE OF ALASKA
DEPARTMENT OF TRANSPORTATION

Date Plotted: 15/08/2017 3:13 PM
Layout Name: 4A-NI-LAYOUT
File Name: W:\Projects\Adak\ALP-ADK-LAYOUT PLANS.dwg
Designed By:
Drawn By:
Checked By:

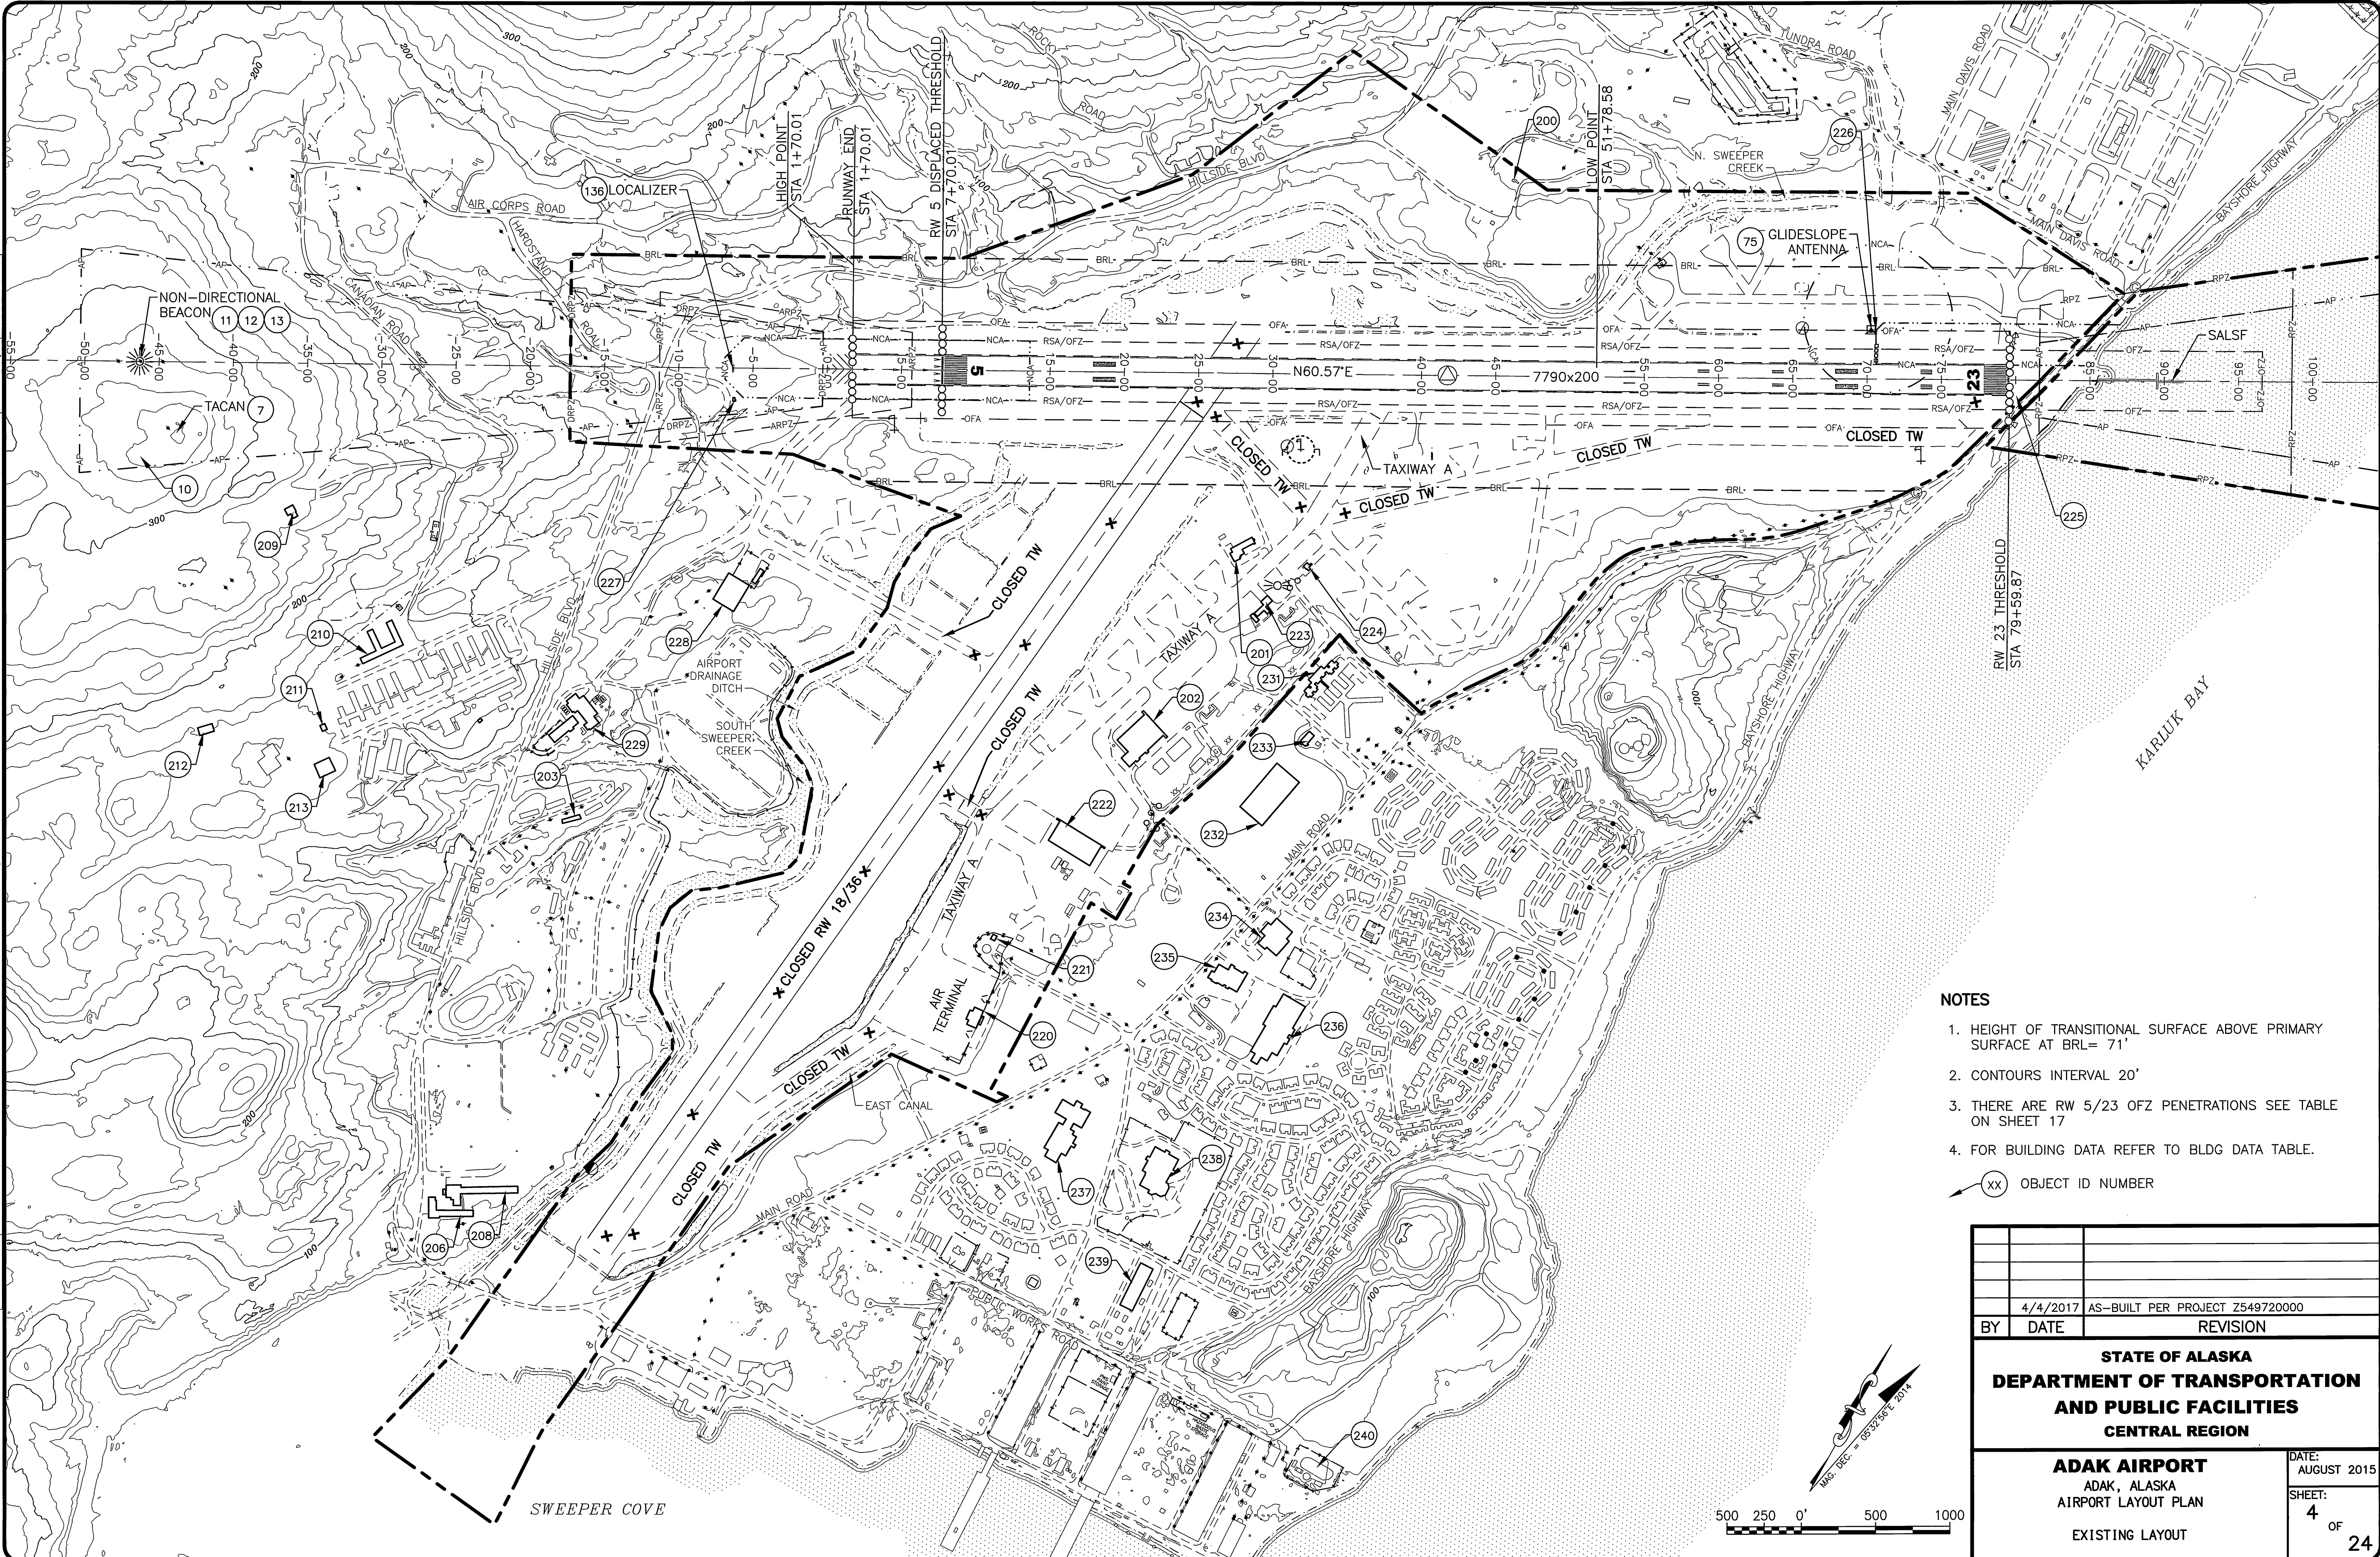

- NOTES**
1. HEIGHT OF TRANSITIONAL SURFACE ABOVE PRIMARY SURFACE AT BRL= 71'
 2. CONTOURS INTERVAL 20'
 3. THERE ARE RW 5/23 OFZ PENETRATIONS SEE TABLE ON SHEET 17
 4. FOR BUILDING DATA REFER TO BLDG DATA TABLE.
- XX OBJECT ID NUMBER

	4/4/2017	AS-BUILT PER PROJECT Z549720000
BY	DATE	REVISION
STATE OF ALASKA DEPARTMENT OF TRANSPORTATION AND PUBLIC FACILITIES CENTRAL REGION		
ADAK AIRPORT ADAK, ALASKA AIRPORT LAYOUT PLAN EXISTING LAYOUT		DATE: AUGUST 2015 SHEET: 4 OF 24


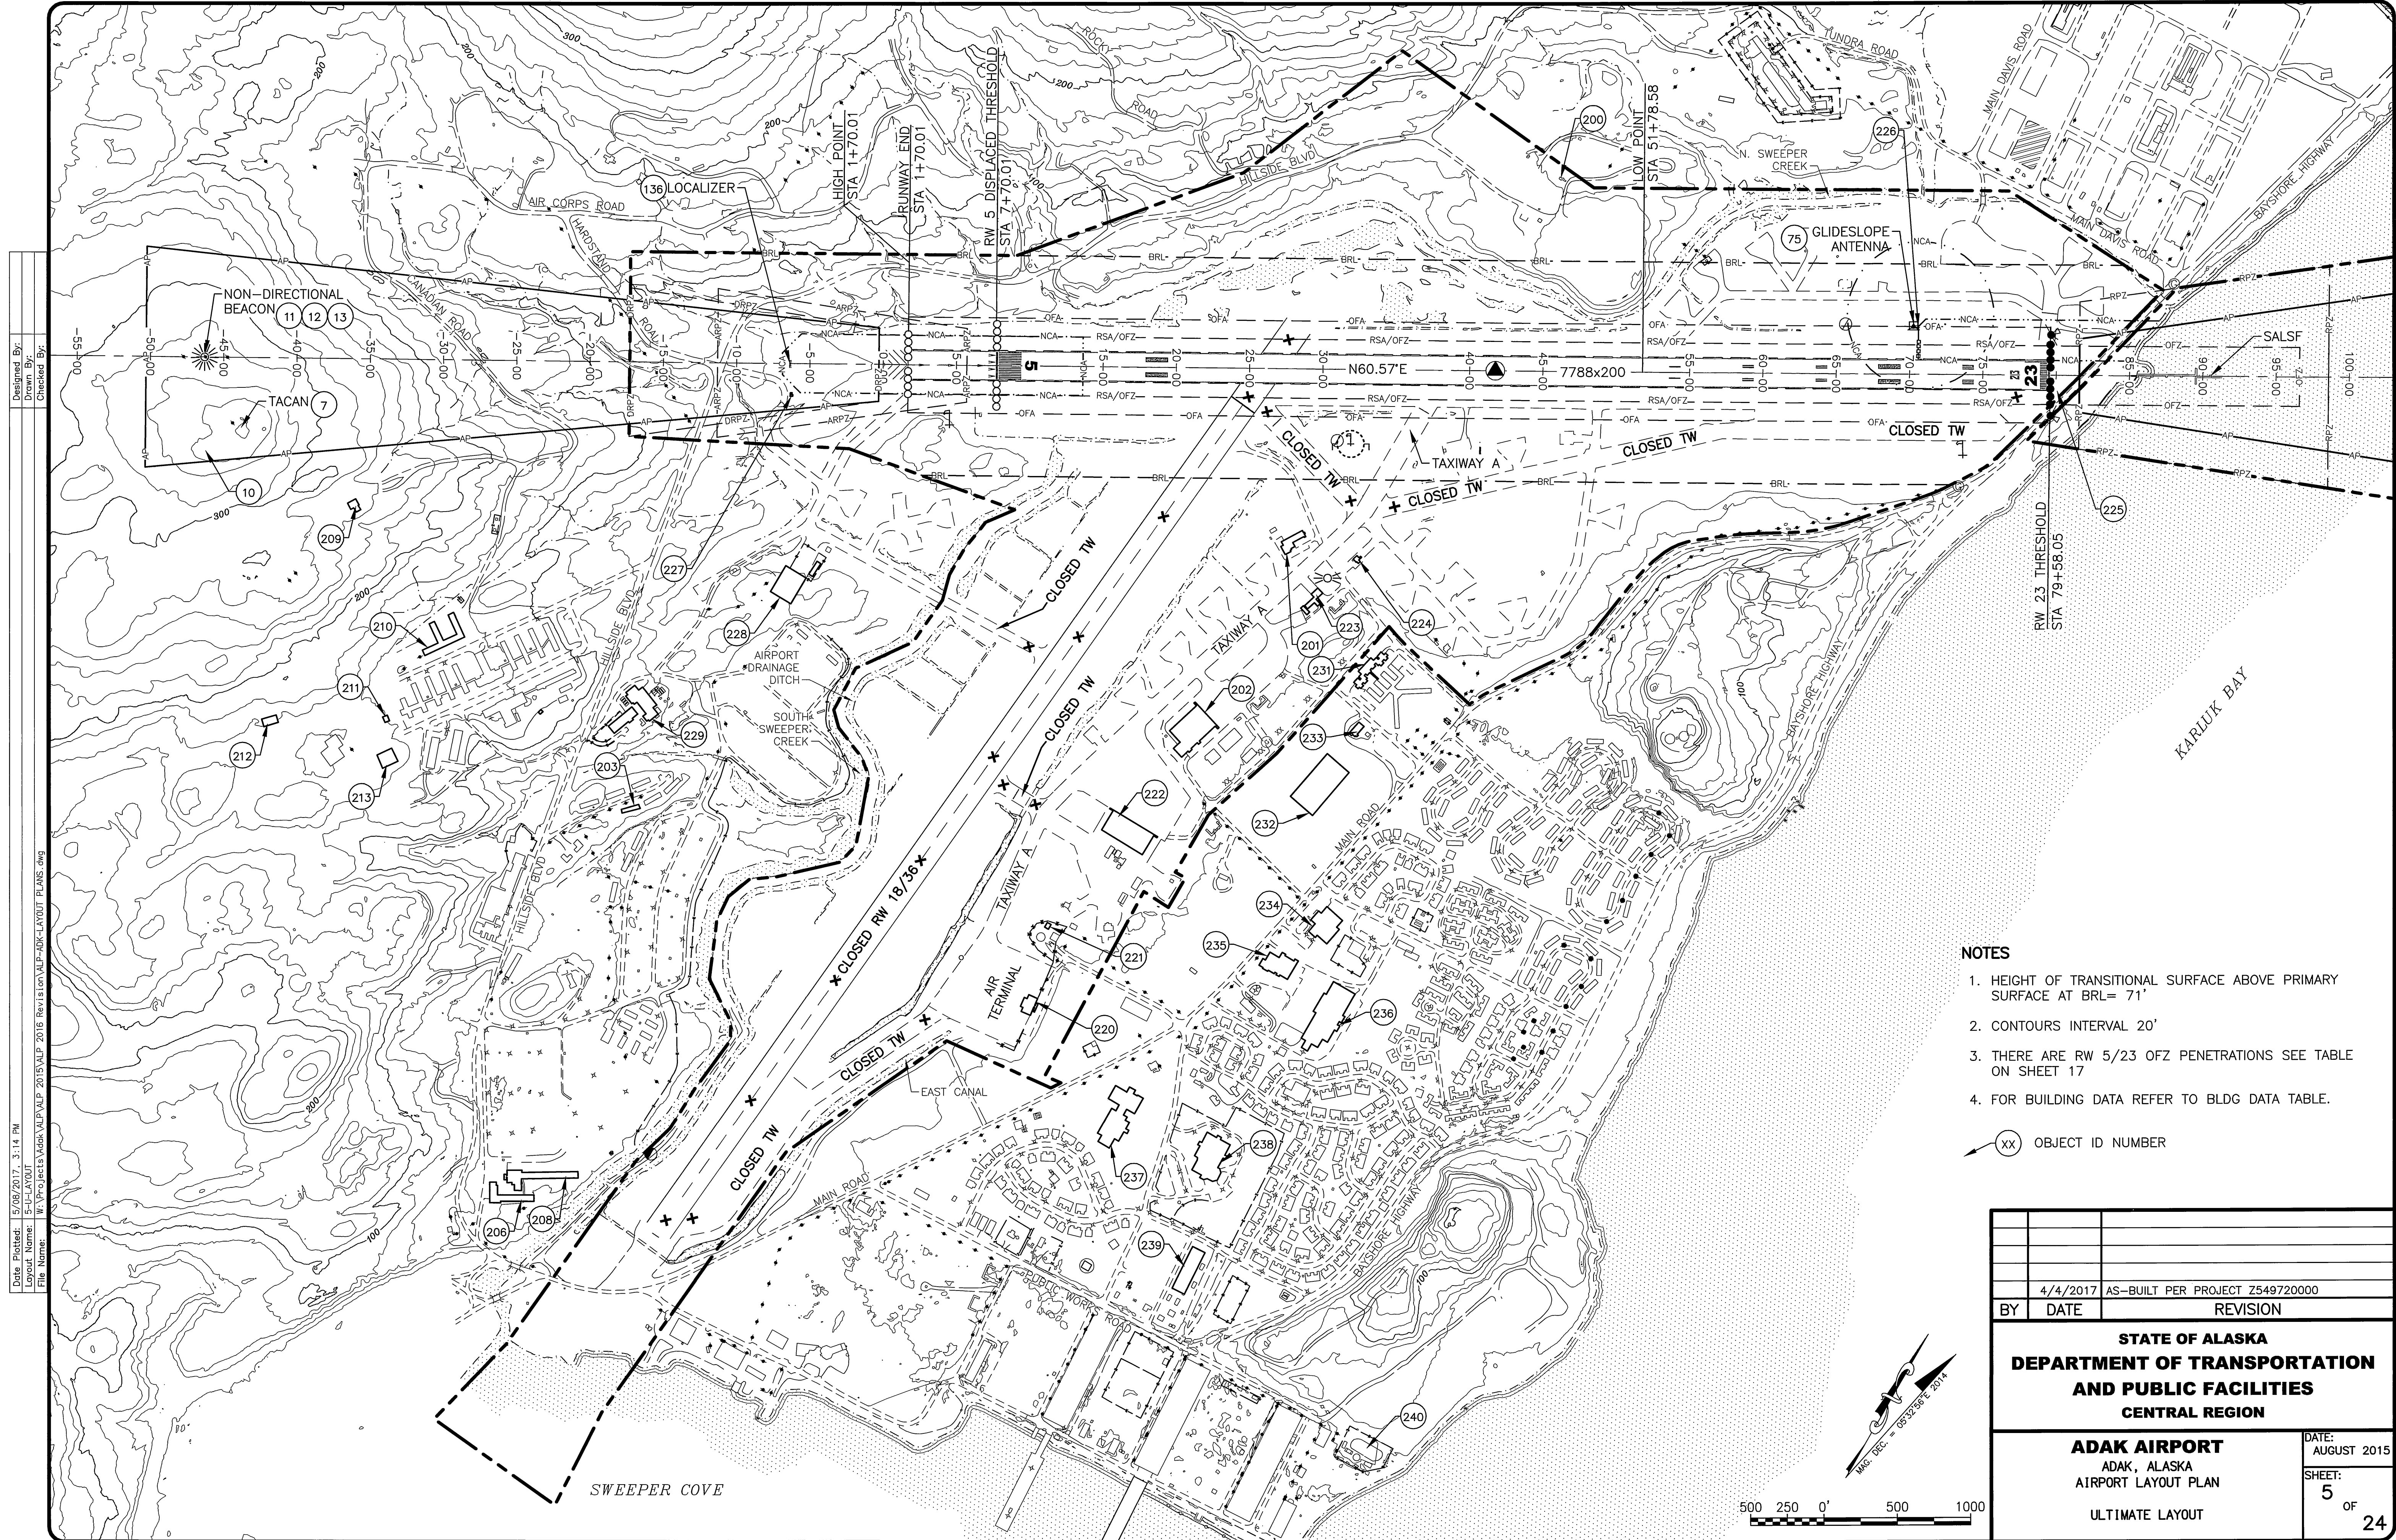


1. HEIGHT OF TRANSITIONAL SURFACE ABOVE PRIMARY SURFACE AT BRL= 71'
2. CONTOURS INTERVAL 20'
3. THERE ARE RW 5/23 OFZ PENETRATIONS SEE TABLE ON SHEET 17
4. FOR BUILDING DATA REFER TO BLDG DATA TABLE.

DATE:
AUGUST 2015

SHEET:
5 OF 24

Date Plotted: 4/03/2017 4:46 PM
Layout Name: 7A-RW23
File Name: W:\Projects\Adak\ALP 2015\ALP 2016 Revision\ALP-ADK-INT-RP2.dwg
Designed By:
Drawn By:
Checked By:

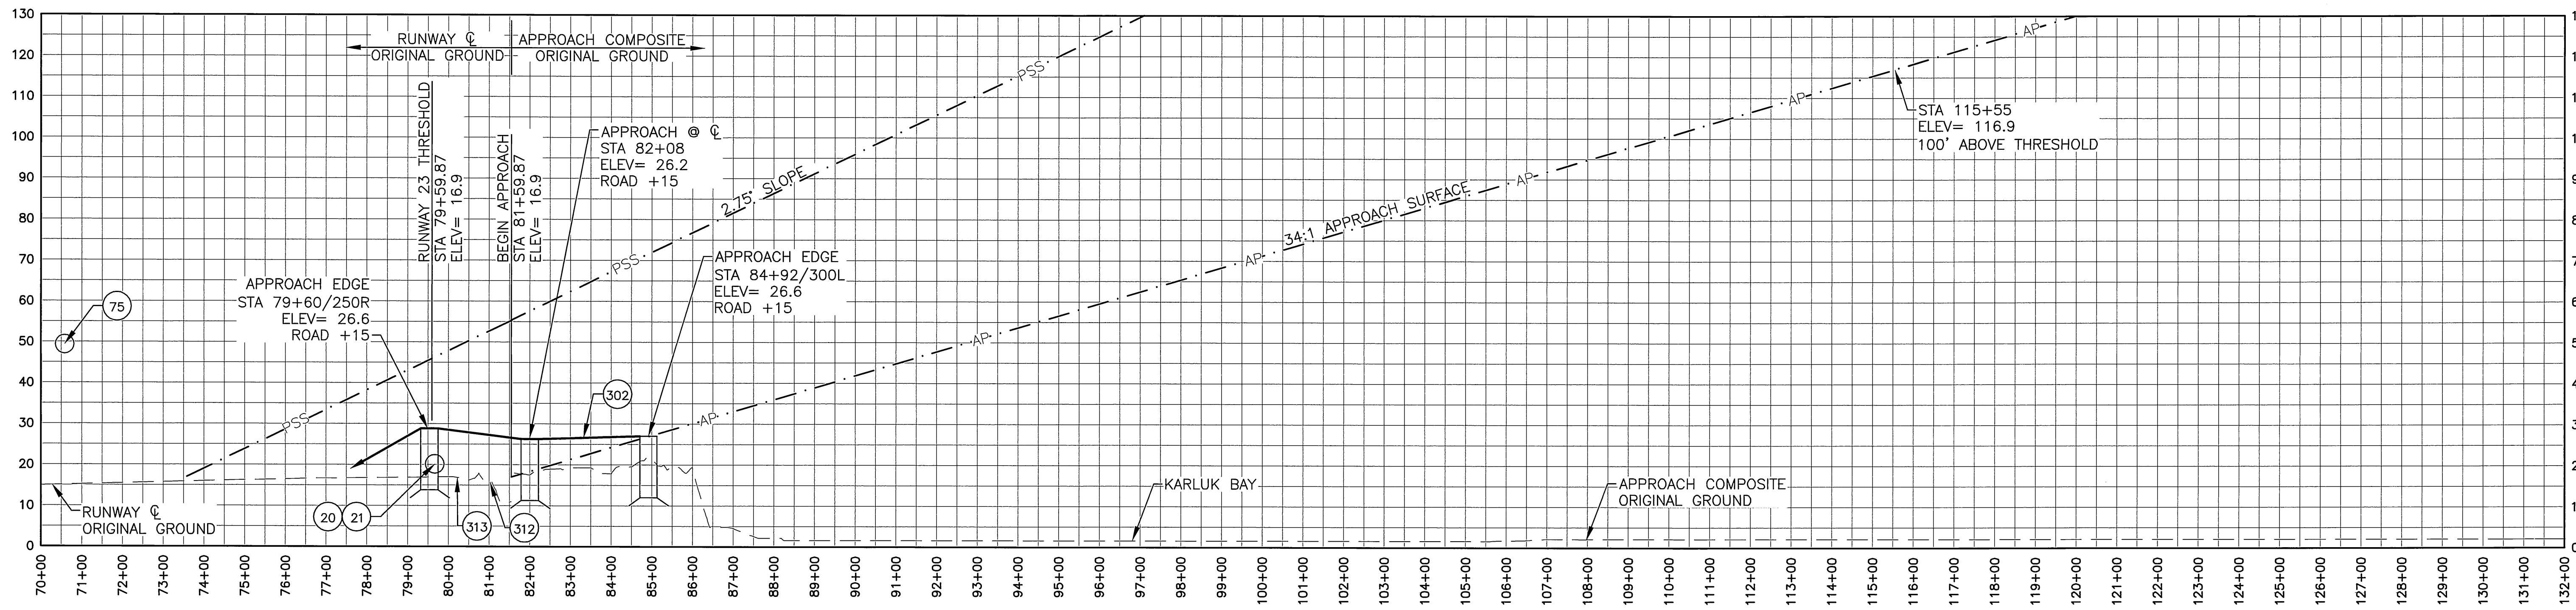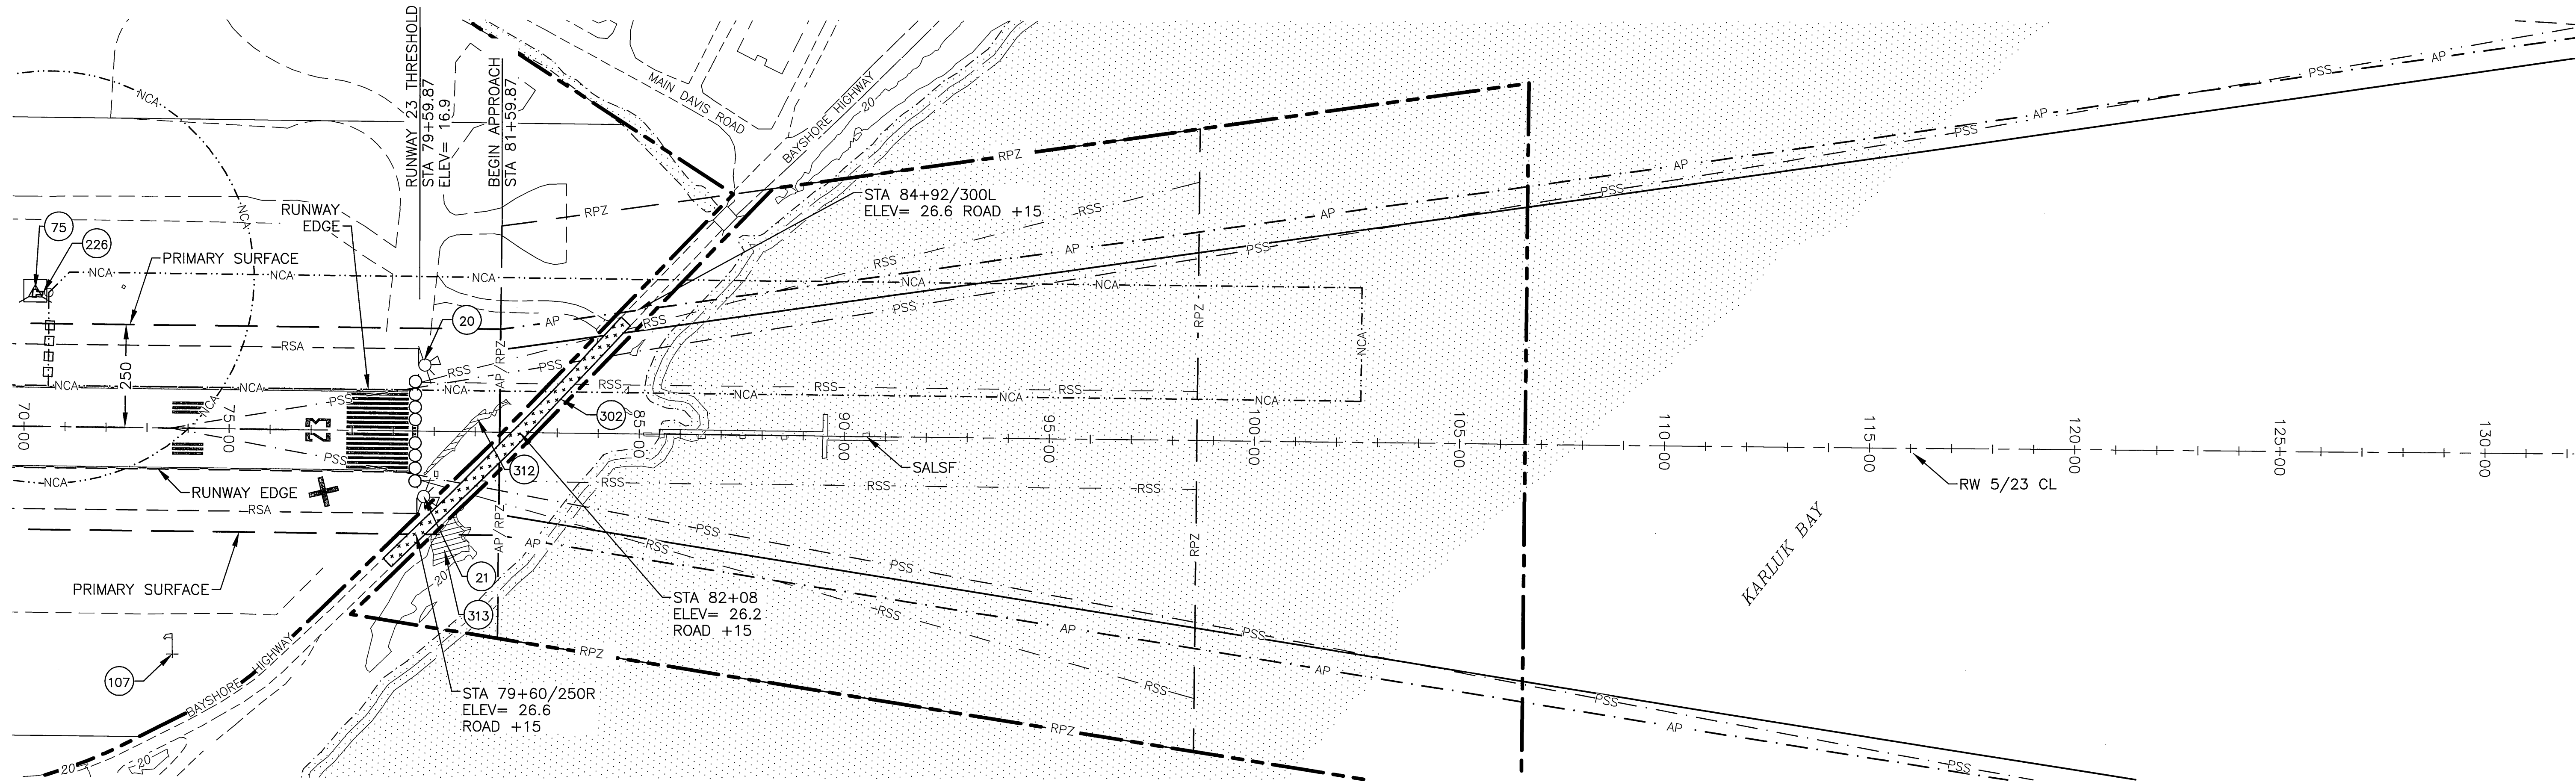


INNER APPROACH LEGEND

- XX OBJECT ID NUMBER
- PART 77 SURFACE TERRAIN PENETRATION AREA
- PART 77 SURFACE ROAD PENETRATION
- ROAD PENETRATION CONTINUES BEYOND APPROACH SURFACE
- RSS— REIL SITING SURFACE

NOTE:

1. CONTOUR INTERVAL 20'
2. REFER TO DEPARTURES & APPROACH SITING SURFACE DRAWING RW 23
3. REFER TO AIRPORT AIRSPACE, 14 CFR, PART 77 DATA TABLES.
4. SEE AIRPORT AIRSPACE, 14 CFR, PART 77 FOR OBSTRUCTIONS BEYOND THIS DRAWING EXTENTS
5. CONTROLLING OBSTRUCTION = ROAD +15 @ STA 81+58/44R ELEV= 26.0 SLOPE 1:1

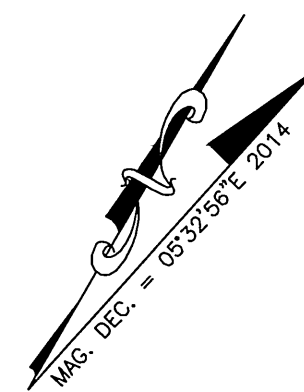

200 100 0' 200 400
HORIZONTAL:VERTICAL SCALE = 1:10


BY	DATE	REVISION
	4/4/2017	AS-BUILT PER PROJECT Z549720000

STATE OF ALASKA
DEPARTMENT OF TRANSPORTATION
AND PUBLIC FACILITIES
CENTRAL REGION

ADAK AIRPORT
ADAK, ALASKA
AIRPORT LAYOUT PLAN

EXISTING INNER PORTION OF THE
APPROACH SURFACE - RUNWAY 23

DATE:
AUGUST 2015
SHEET:
7
OF
24

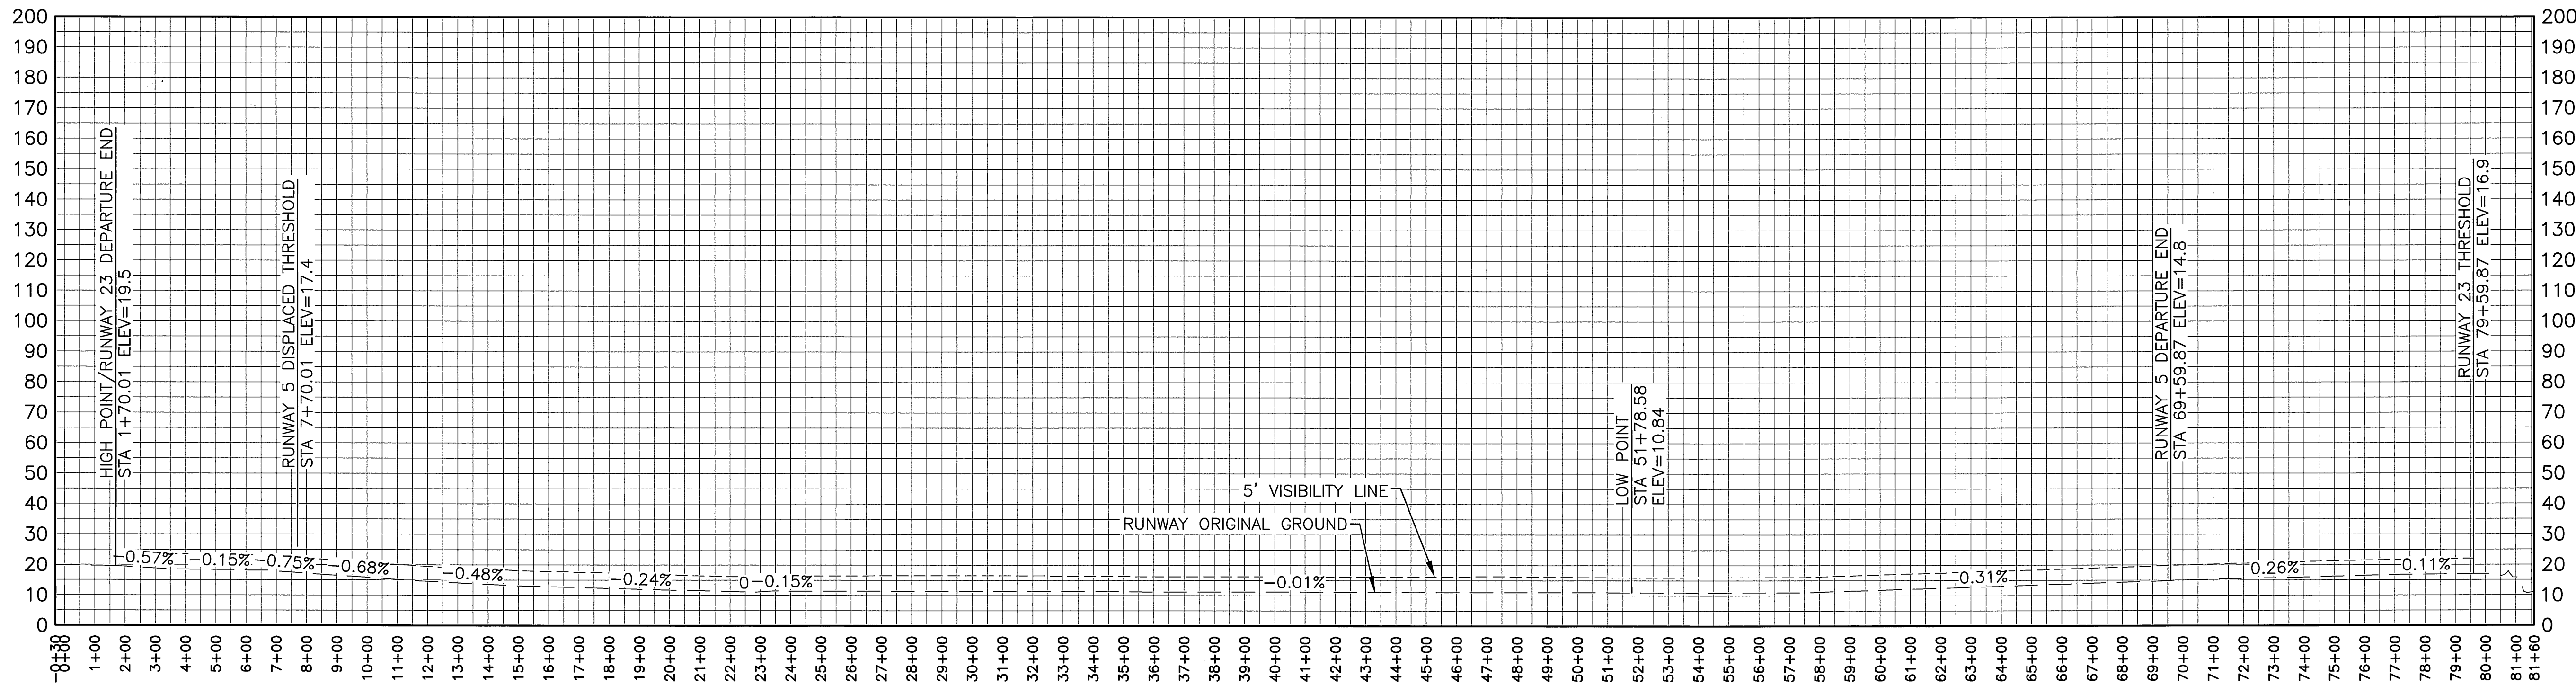

RUNWAY 5-23 CENTERLINE PROFILE

NOTE:

- RUNWAY LAYOUT INFORMATION IS NOT AVAILABLE. RUNWAY $\varnothing$ GRADES WERE DETERMINED BY SAMPLING AS-BUILT SURVEY POINTS.




BY	4/4/2017	AS-BUILT PER PROJECT Z549720000
DATE		REVISION

STATE OF ALASKA
DEPARTMENT OF TRANSPORTATION
AND PUBLIC FACILITIES
CENTRAL REGION

ADAK AIRPORT
ADAK, ALASKA
AIRPORT LAYOUT PLAN
EXISTING RUNWAY
CENTERLINE PROFILE

Date Plotted: 4/03/2017 4:50 PM
Layout Name: 11-RWS
File Name: W:\Projects\Adak\ALP\ALP 2015\ALP 2016 Revision\ALP-ADK-LP-RWS.dwg
Designed By: DGM
Checked By: DGM


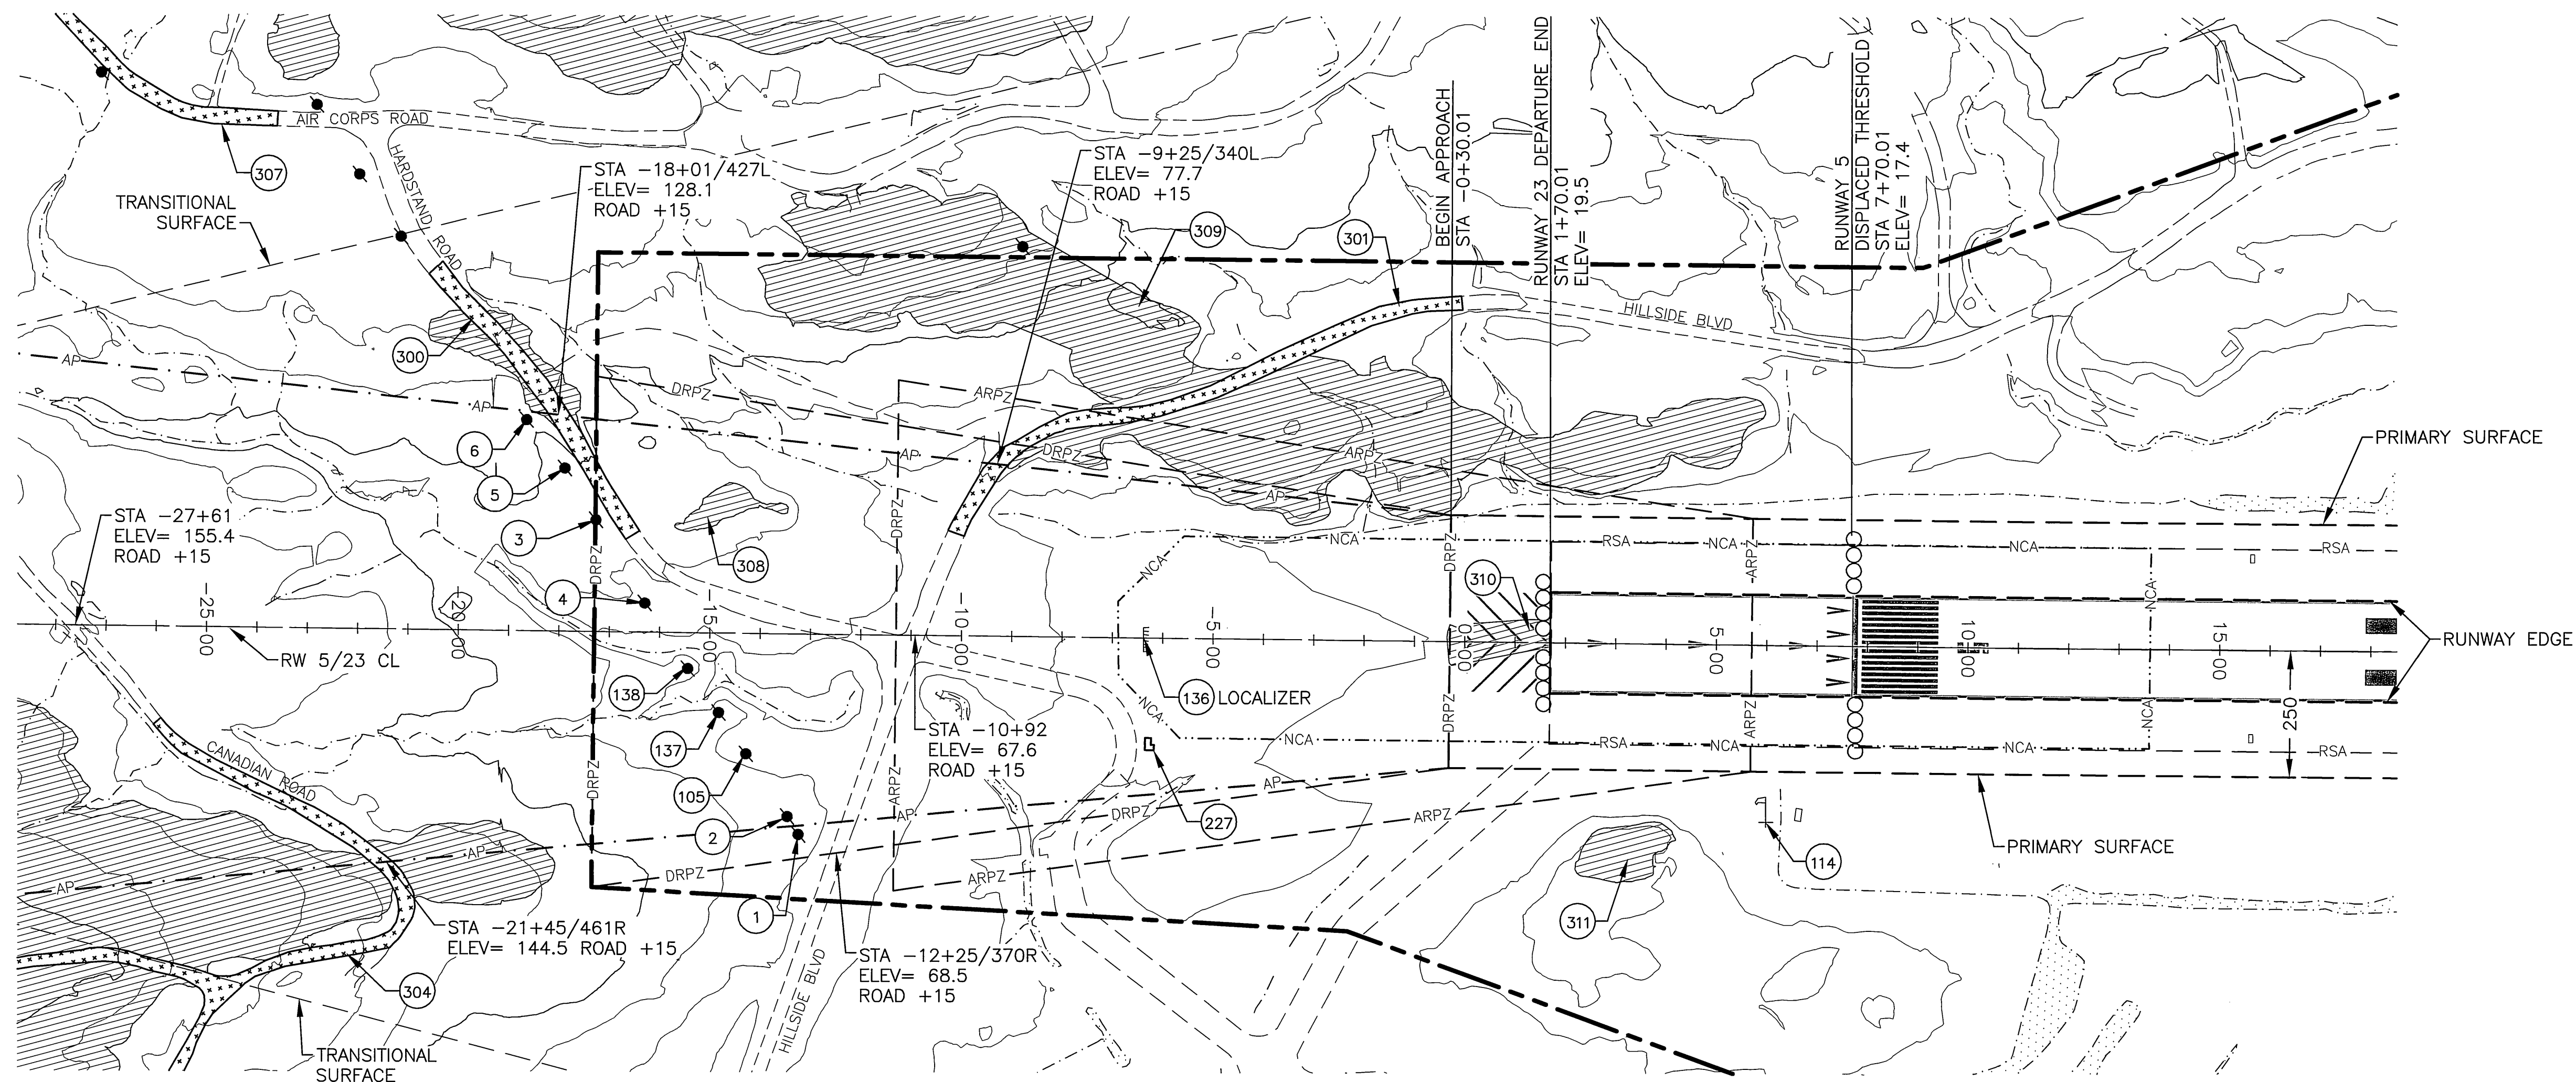


INNER APPROACH LEGEND

- XX OBJECT ID NUMBER
- PART 77 SURFACE TERRAIN PENETRATION AREA
- PART 77 SURFACE ROAD PENETRATION
- ROAD PENETRATION CONTINUES BEYOND APPROACH SURFACE

NOTE:

- CONTOUR INTERVAL 20'
- REFER TO DEPARTURE, APPROACH SITING SURFACE DRAWING RW 5
- REFER TO PART 77 OBSTRUCTION DATA TABLES ON SHEETS 22-23
- SEE AIRPORT AIRSPACE DRAWING FOR PART 77 OBSTRUCTIONS BEYOND THIS DRAWING EXTENTS
- CONTROLLING OBSTRUCTION = TOWER @ STA -13+61/396R, ELEV = 413, SLOPE = 11:1

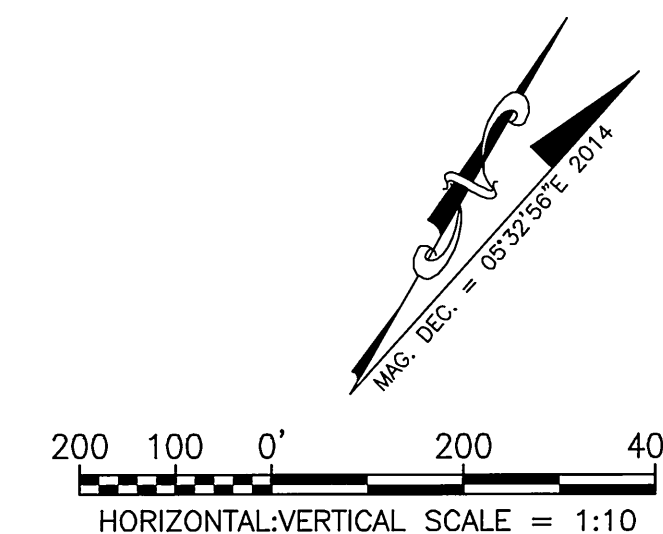
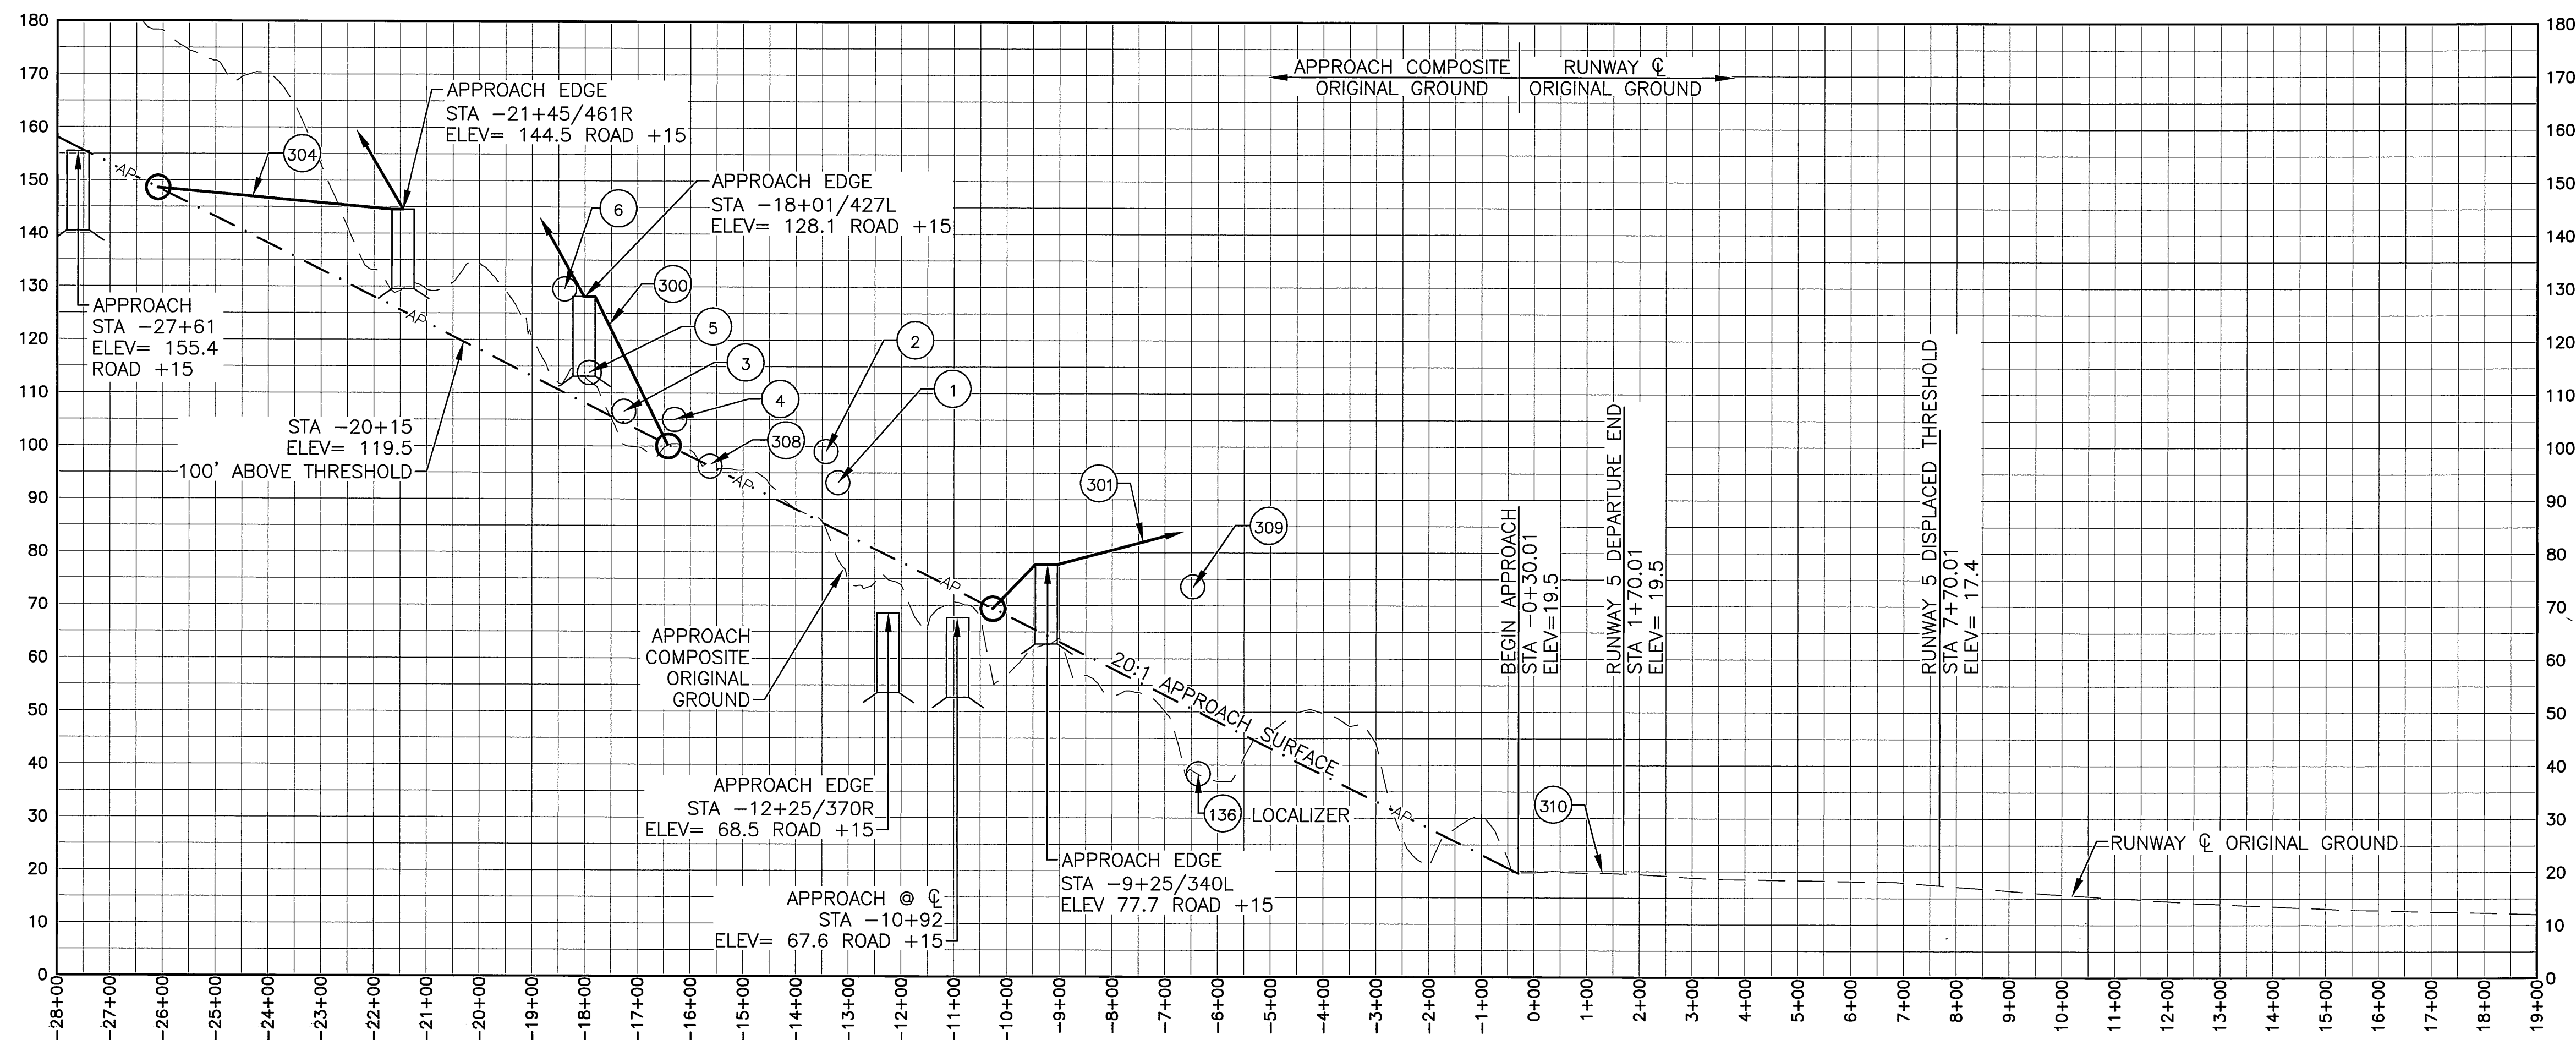


	4/4/2017.3	AS-BUILT PER PROJECT Z549720000
BY	DATE	REVISION

STATE OF ALASKA	
DEPARTMENT OF TRANSPORTATION	
AND PUBLIC FACILITIES	
CENTRAL REGION	

ADAK AIRPORT ADAK, ALASKA AIRPORT LAYOUT PLAN ULTIMATE INNER PORTION OF THE APPROACH SURFACE - RUNWAY 5	DATE: AUGUST 2015
	SHEET: 9 OF 24

Designed By: [Blank]
Drawn By: [Blank]
Checked By: [Blank]
Date Plotted: 1/03/2017, 4:51 PM
Layout Name: 22-23
File Name: W:\Projects\Adak\ALP\2015\ALP 2015\ALP-Adak-CL-RP.dwg

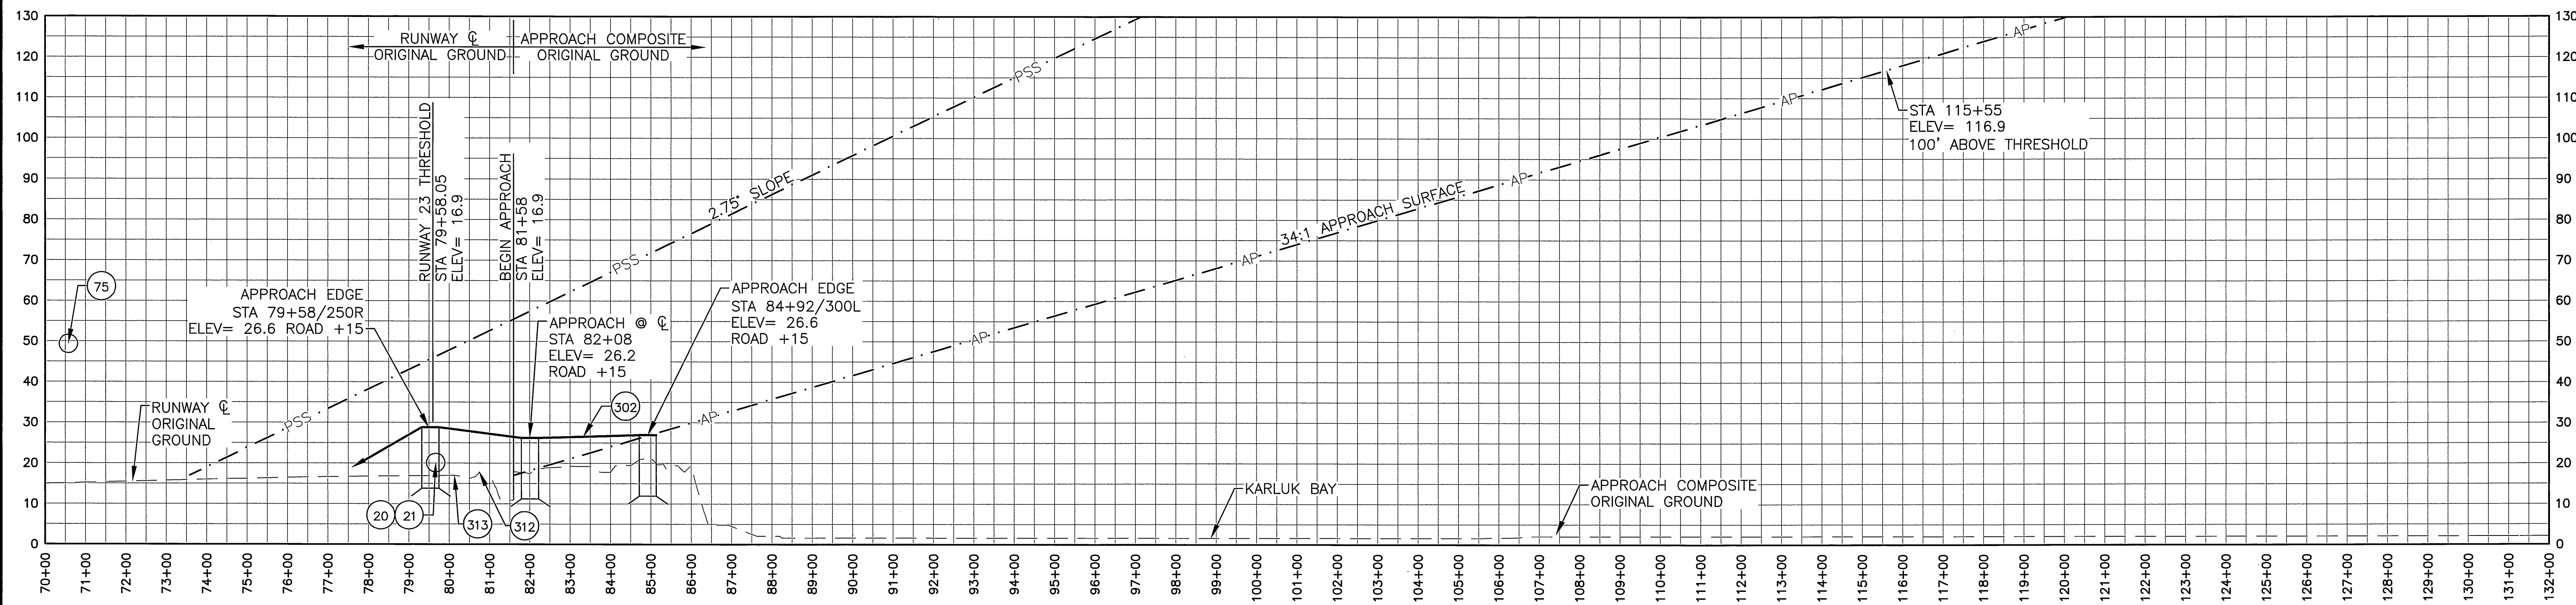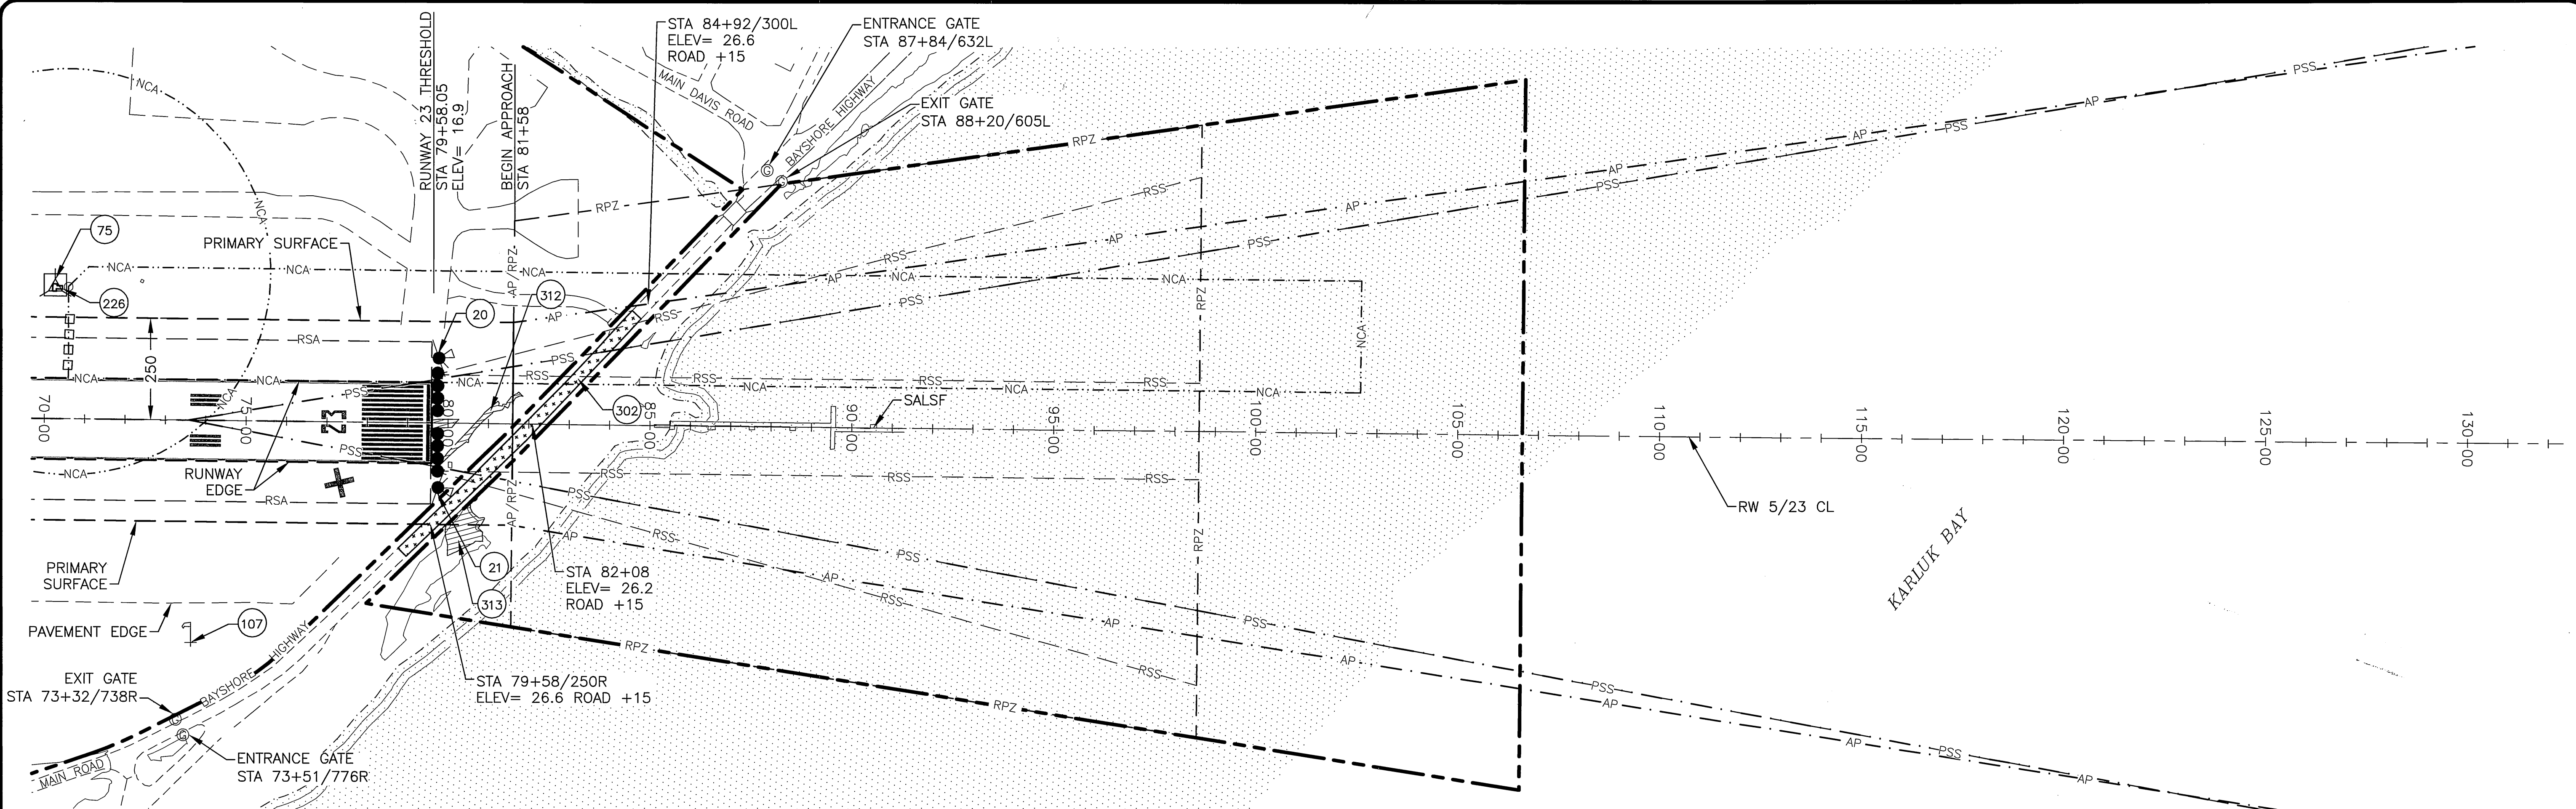


INNER APPROACH LEGEND

- XX OBJECT ID NUMBER
- PART 77 SURFACE TERRAIN PENETRATION AREA
- PART 77 SURFACE ROAD PENETRATION
- ROAD PENETRATION CONTINUES BEYOND APPROACH SURFACE
- RSS — REIL SITING SURFACE

NOTES:

- CONTOUR INTERVAL 20'
- REFER TO DEPARTURE, APPROACH SITING SURFACE DRAWING
- REFER TO PART 77 OBSTRUCTION DATA TABLES ON SHEETS 22-23
- SEE AIRPORT AIRSPACE DRAWING FOR PART 77 OBSTRUCTIONS BEYOND THIS DRAWING EXTENTS
- CONTROLLING OBSTRUCTION = ROAD+15@ STA 81+58/44R, ELEV= 26.0, SLOPE = 1:1

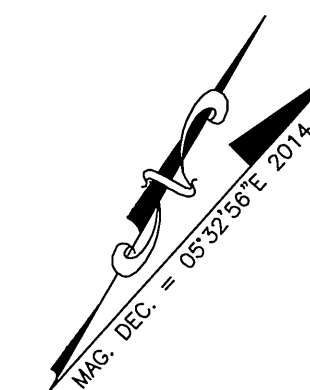

200 100 0' 200 400
HORIZONTAL/VERTICAL SCALE = 1:10


BY	DATE	REVISION
	4/4/2017	AS-BUILT PER PROJECT Z549720000

STATE OF ALASKA
DEPARTMENT OF TRANSPORTATION
AND PUBLIC FACILITIES
CENTRAL REGION

ADAK AIRPORT
ADAK, ALASKA
AIRPORT LAYOUT PLAN

ULTIMATE INNER PORTION OF THE
APPROACH SURFACE - RUNWAY 23

DATE:
AUGUST 2015
SHEET:
10
OF
24

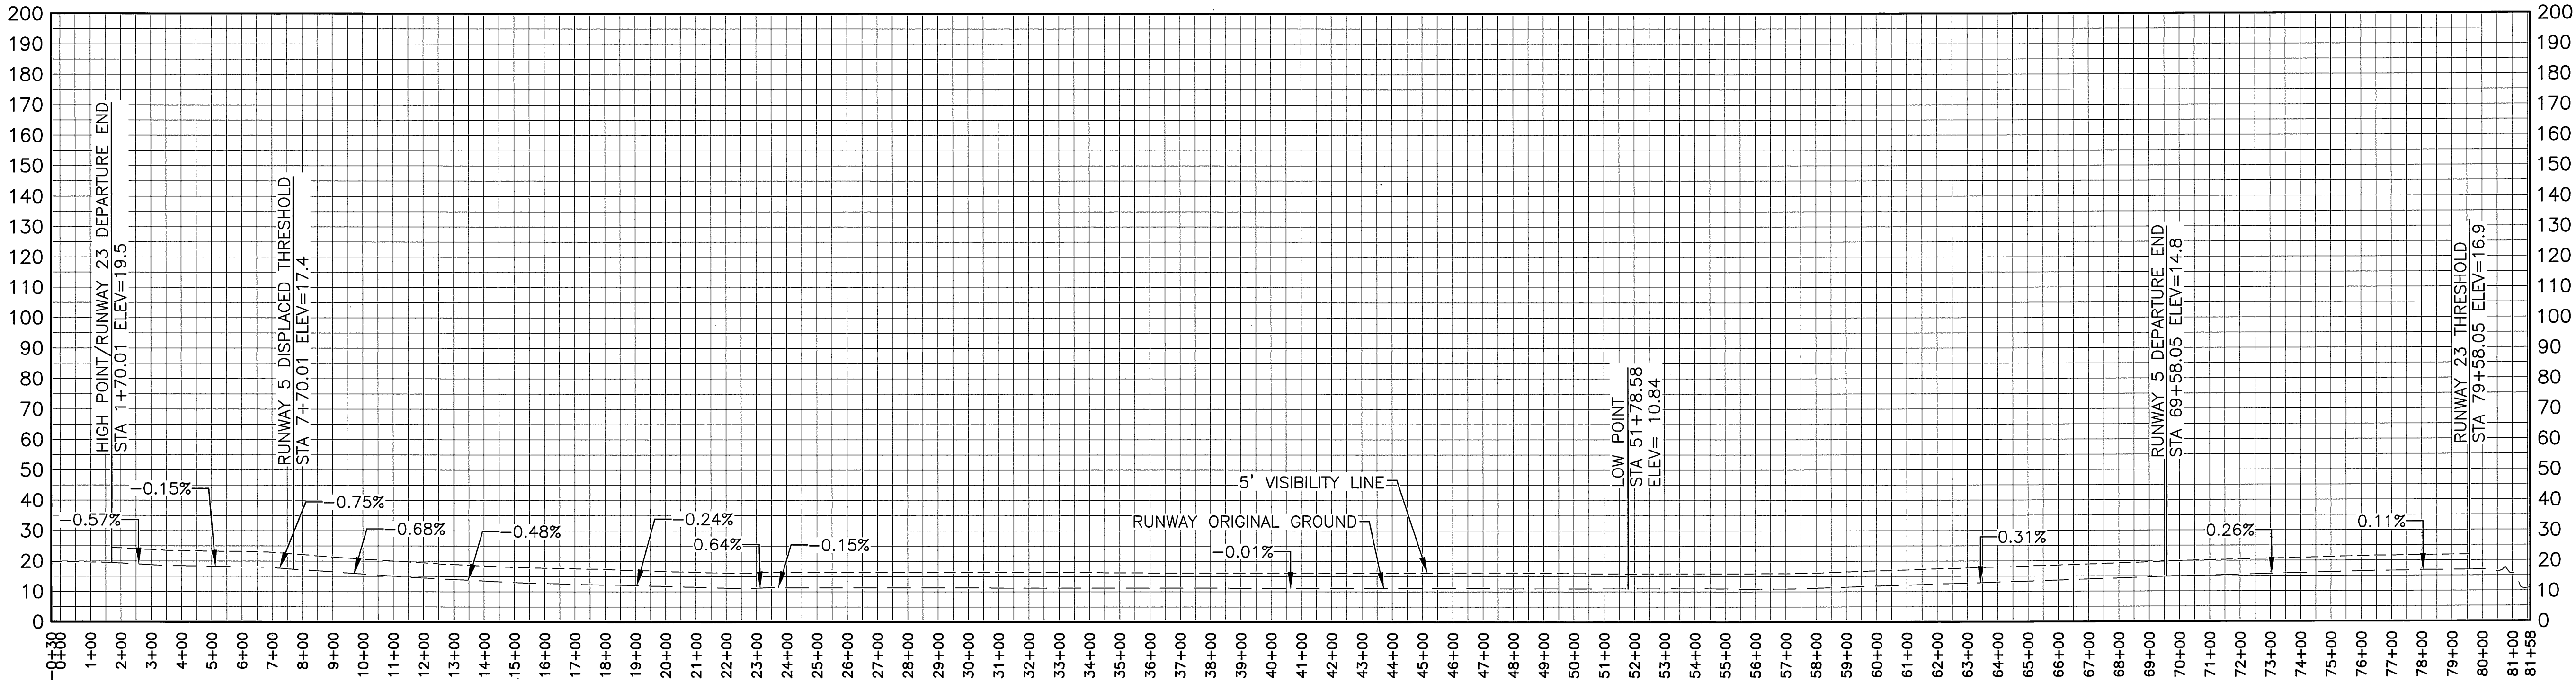

RUNWAY 5-23 CENTERLINE PROFILE

NOTE:

1. RUNWAY LAYOUT INFORMATION IS NOT AVAILABLE. RUNWAY $\odot$ GRADES WERE DETERMINED BY SAMPLING AS-BUILT SURVEY POINTS.





4/4/2017	AS-BUILT PER PROJECT Z549720000	
BY	DATE	REVISION


STATE OF ALASKA
DEPARTMENT OF TRANSPORTATION
AND PUBLIC FACILITIES
CENTRAL REGION

ADAK AIRPORT
ADAK, ALASKA
AIRPORT LAYOUT PLAN
ULTIMATE RUNWAY
CENTERLINE PROFILES

Date Plotted:	4/04/2017 7:47 AM	Designed By:
Layout Name:	16-RW5	Drawn By:
File Name:	W:\Projects\Adsk\ALP\ALP_2015\ALP_2016_Revision\ALP-AUX-NT-BEP-P&G.dwg	Checked By:

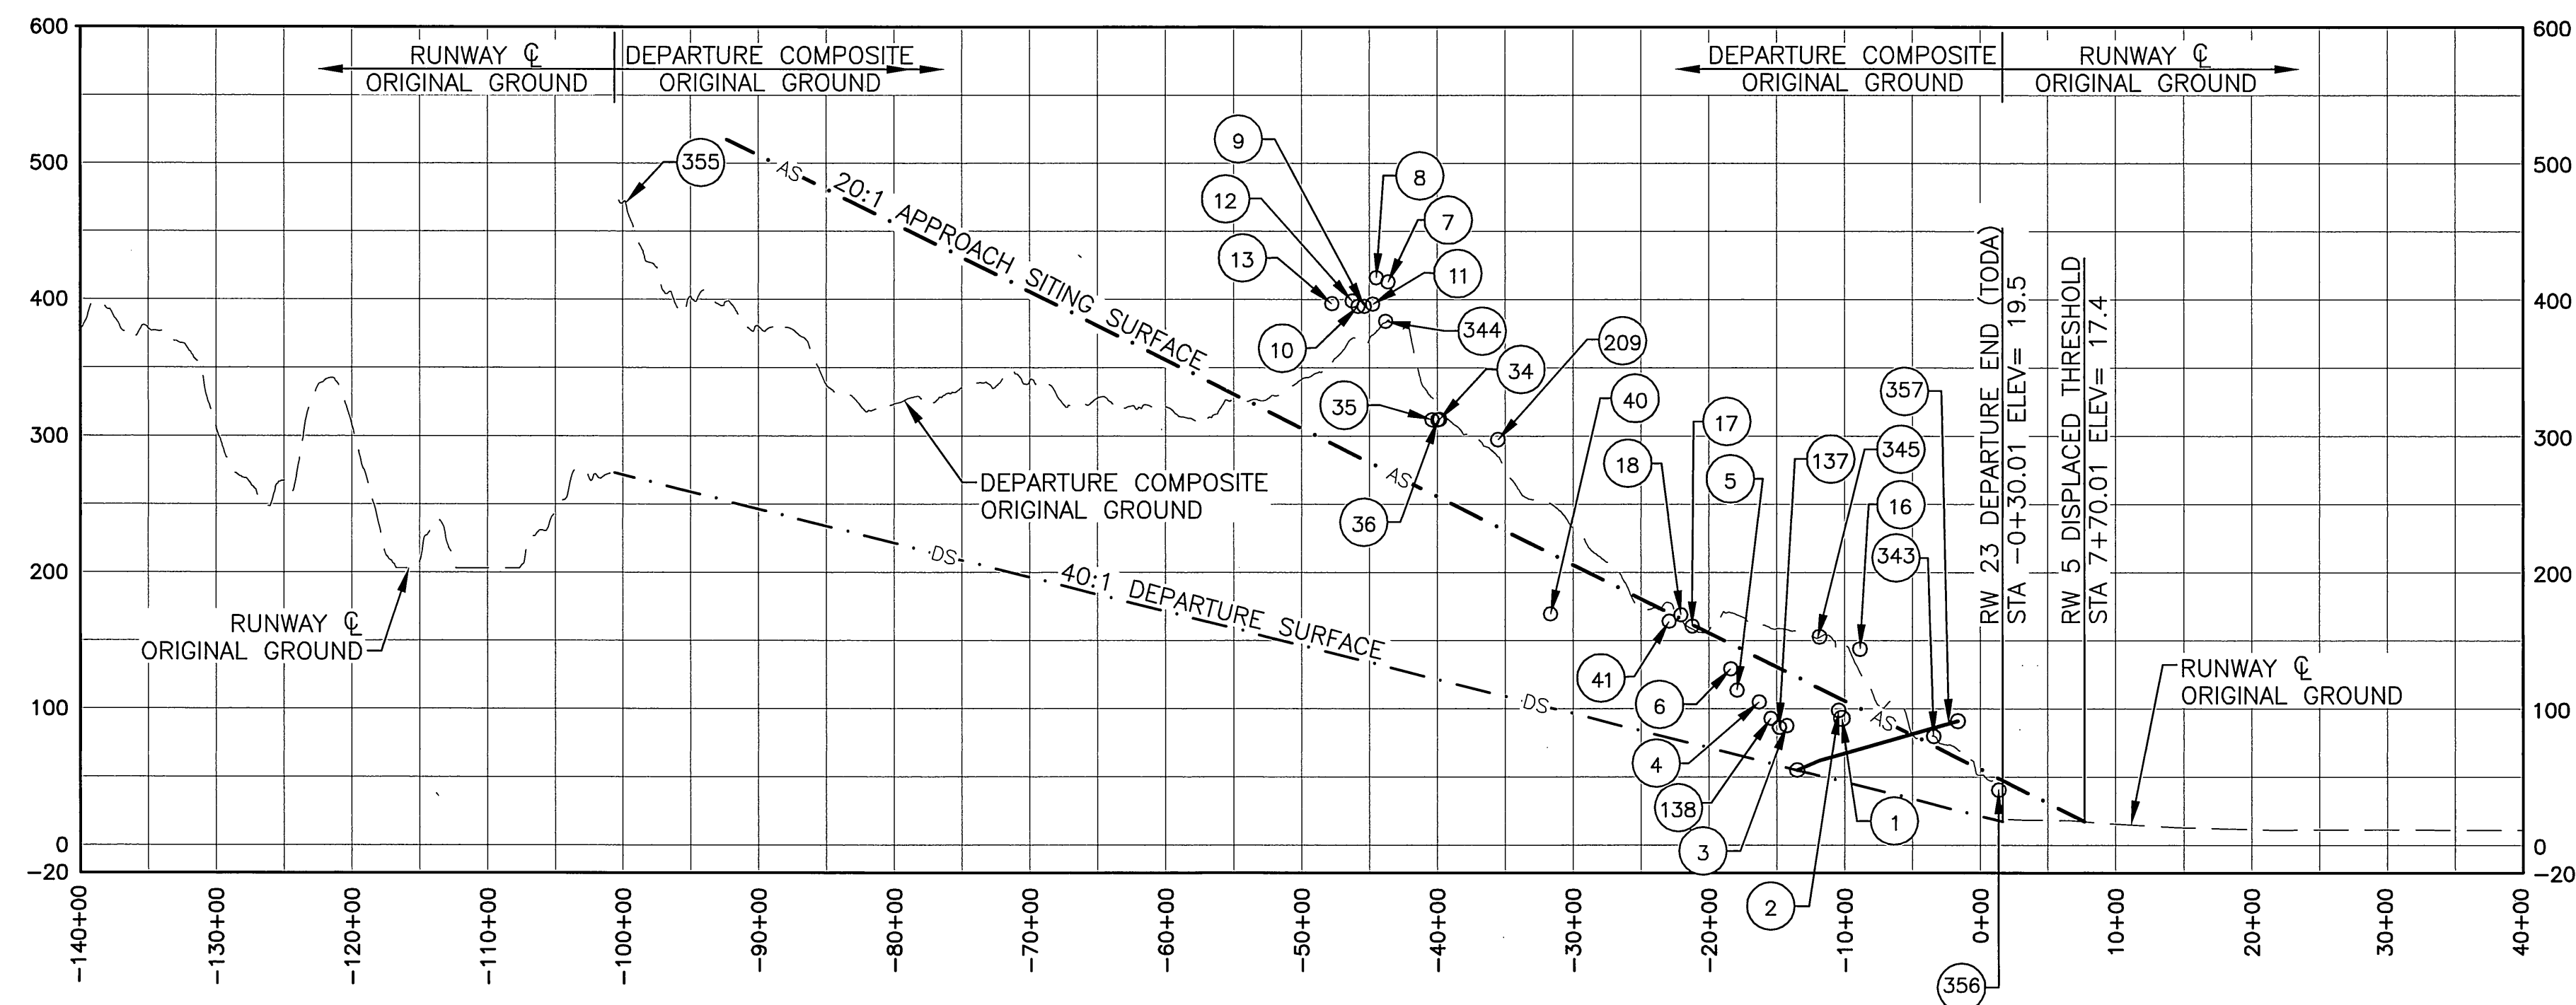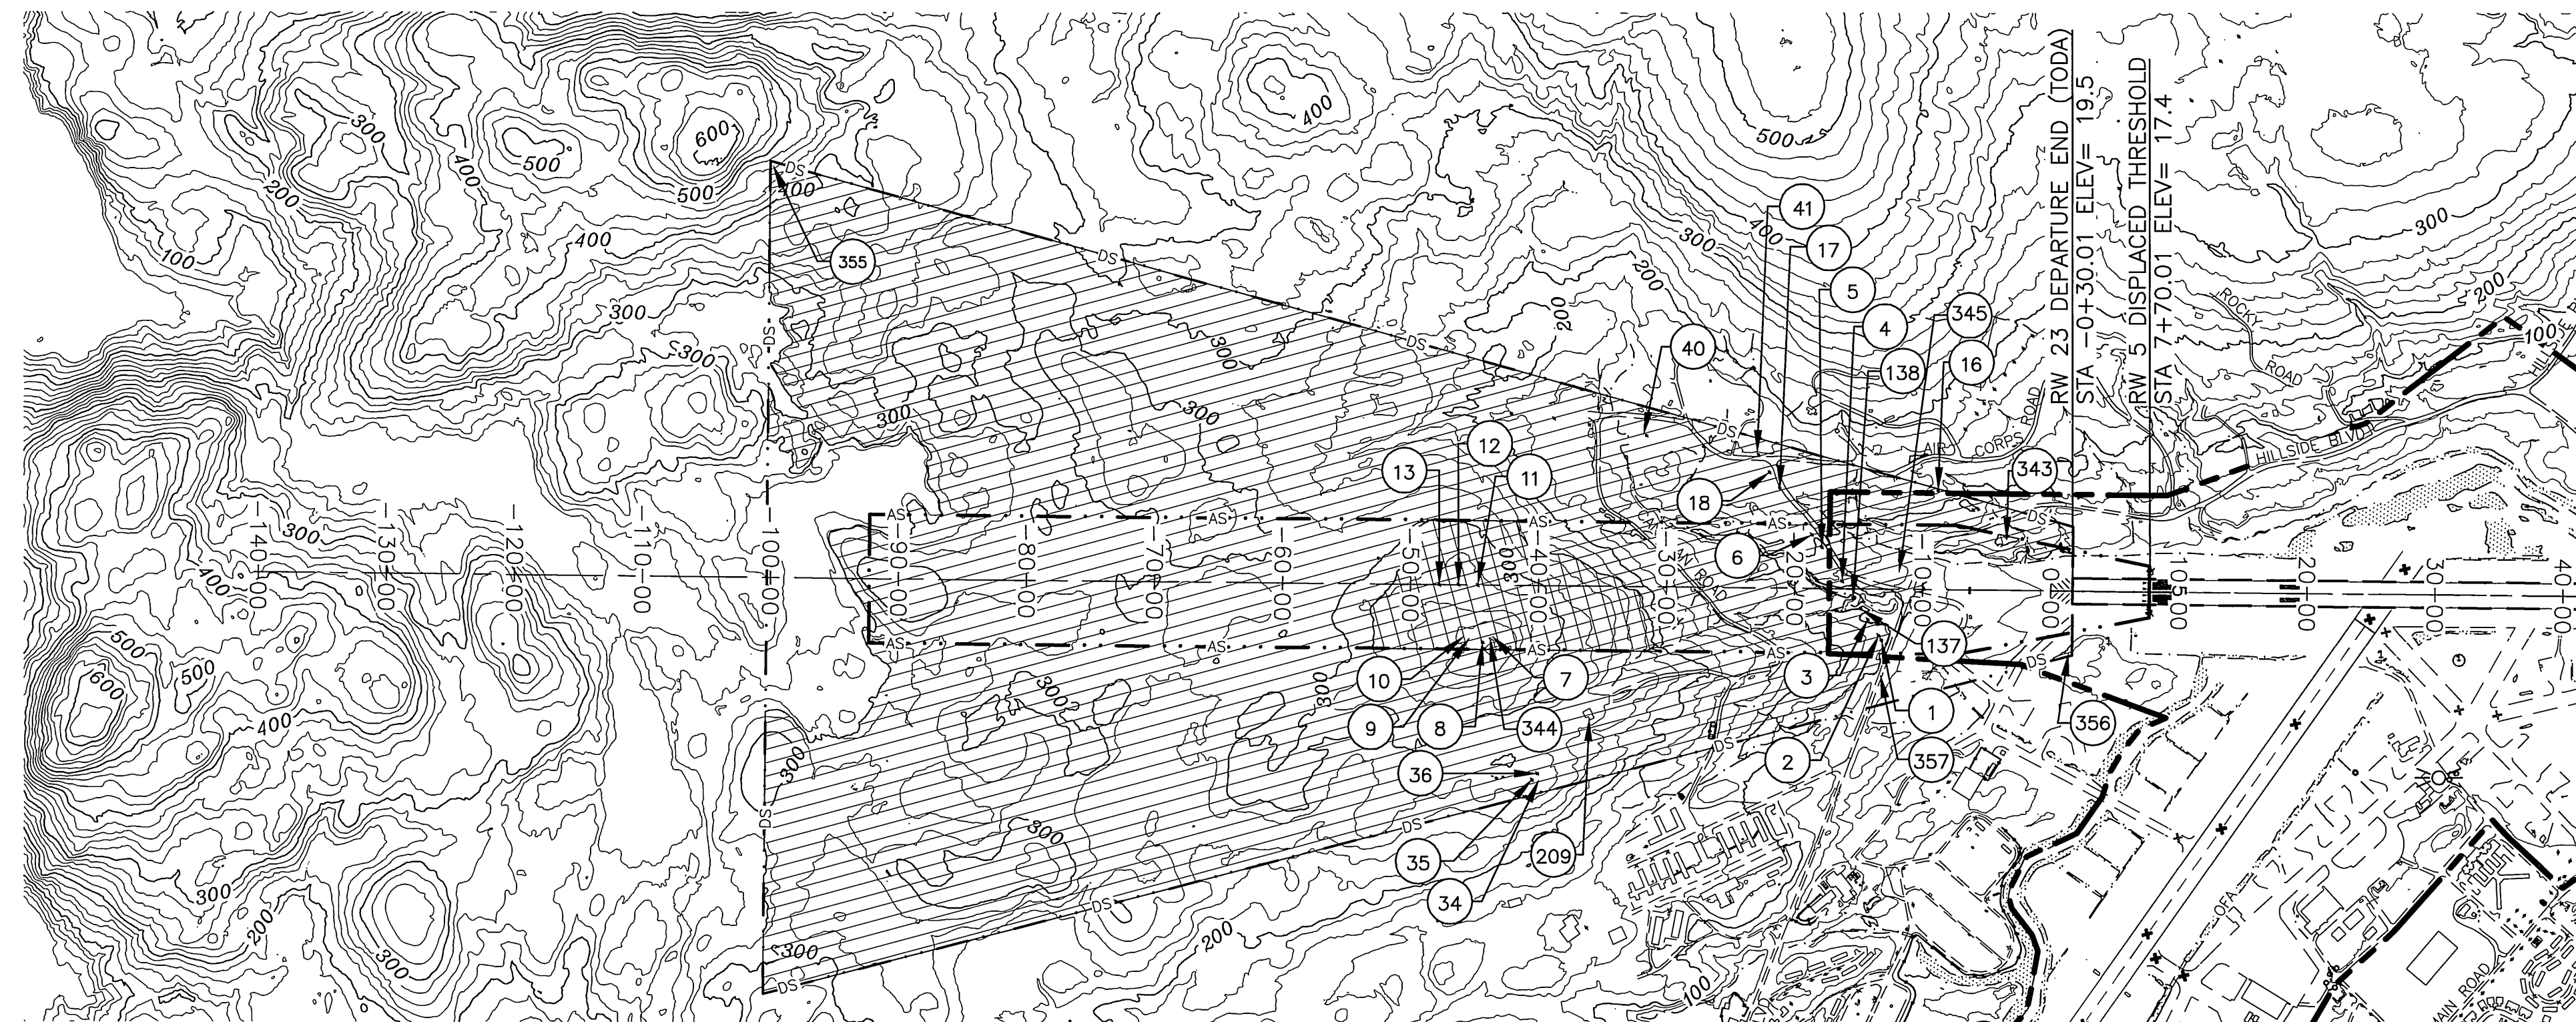


DEPARTURE & SITING SURFACE LEGEND

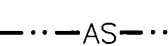- 
 AIRPORT PROPERTY LINE
 ---AS--- APPROACH SITING SURFACE
 APPROACH SITING SURFACE
 TERRAIN PENETRATION
 ---DS--- DEPARTURE SURFACE
 DEPARTURE SURFACE
 TERRAIN PENETRATION
 OBJECT ID NUMBER

NOTE:

1. CONTOUR INTERVAL 20'
2. APPROACH END OF RUNWAY 5 EXPECTED TO SERVE LARGE AIRPLANES (VISUAL DAY/NIGHT) APPROACH SITING SURFACE BEGINS @ DISPLACED THRESHOLD
400 X 1,000 X 1,500 X 8,500 X 20:1
3. DEPARTURE SURFACE FOR RW 23 BEGINS @ RUNWAY END (TODA) 1,000 X 6,466 X 10,200 X 40:1
4. REFER TO APPROACH SITING AND DEPARTURE OBSTACLE TABLES ON SHEET 14

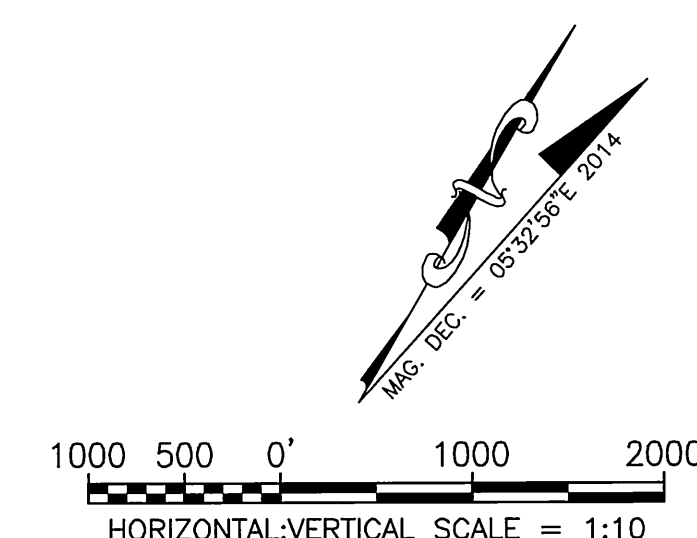

	4/4/2017	AS-BUILT PER PROJECT Z549720000	
BY	DATE	REVISION	

STATE OF ALASKA DEPARTMENT OF TRANSPORTATION AND PUBLIC FACILITIES CENTRAL REGION		DATE: AUGUST 2015 SHEET: 12 OF 24
ADAK AIRPORT ADAK, ALASKA AIRPORT LAYOUT PLAN EXISTING DEPARTURES & APPROACH SITING SURFACES - RUNWAY 5		

Designed By:	
Drawn By:	
Checked By:	

Date Plotted:	5/08/2017, 1:31 PM
Layout Name:	18-DATA
File Name:	W:\Projects\Adak\ALP\ALP 2015\ALP 2016 Revision\ALP-ADK-NT-DEPT-P&P.dwg


Date Plotted:	5/08/2017, 1:31 PM
Layout Name:	18-DATA
File Name:	W:\Projects\Adak\A\

⑥


⑥

(*)

			STATE OF ALASKA DEPARTMENT OF TRANSPORTATION AND PUBLIC FACILITIES CENTRAL REGION	ADAK AIRPORT ADAK, ALASKA AIRPORT LAYOUT PLAN EXISTING DEPARTURE, APPROACH SITING & OFZ - DATA TABLES	DATE: AUGUST 2015
					SHEET: 14 OF 24
	4/4/2017	AS-BUILT PER PROJECT Z549720000			
BY	DATE	REVISION			


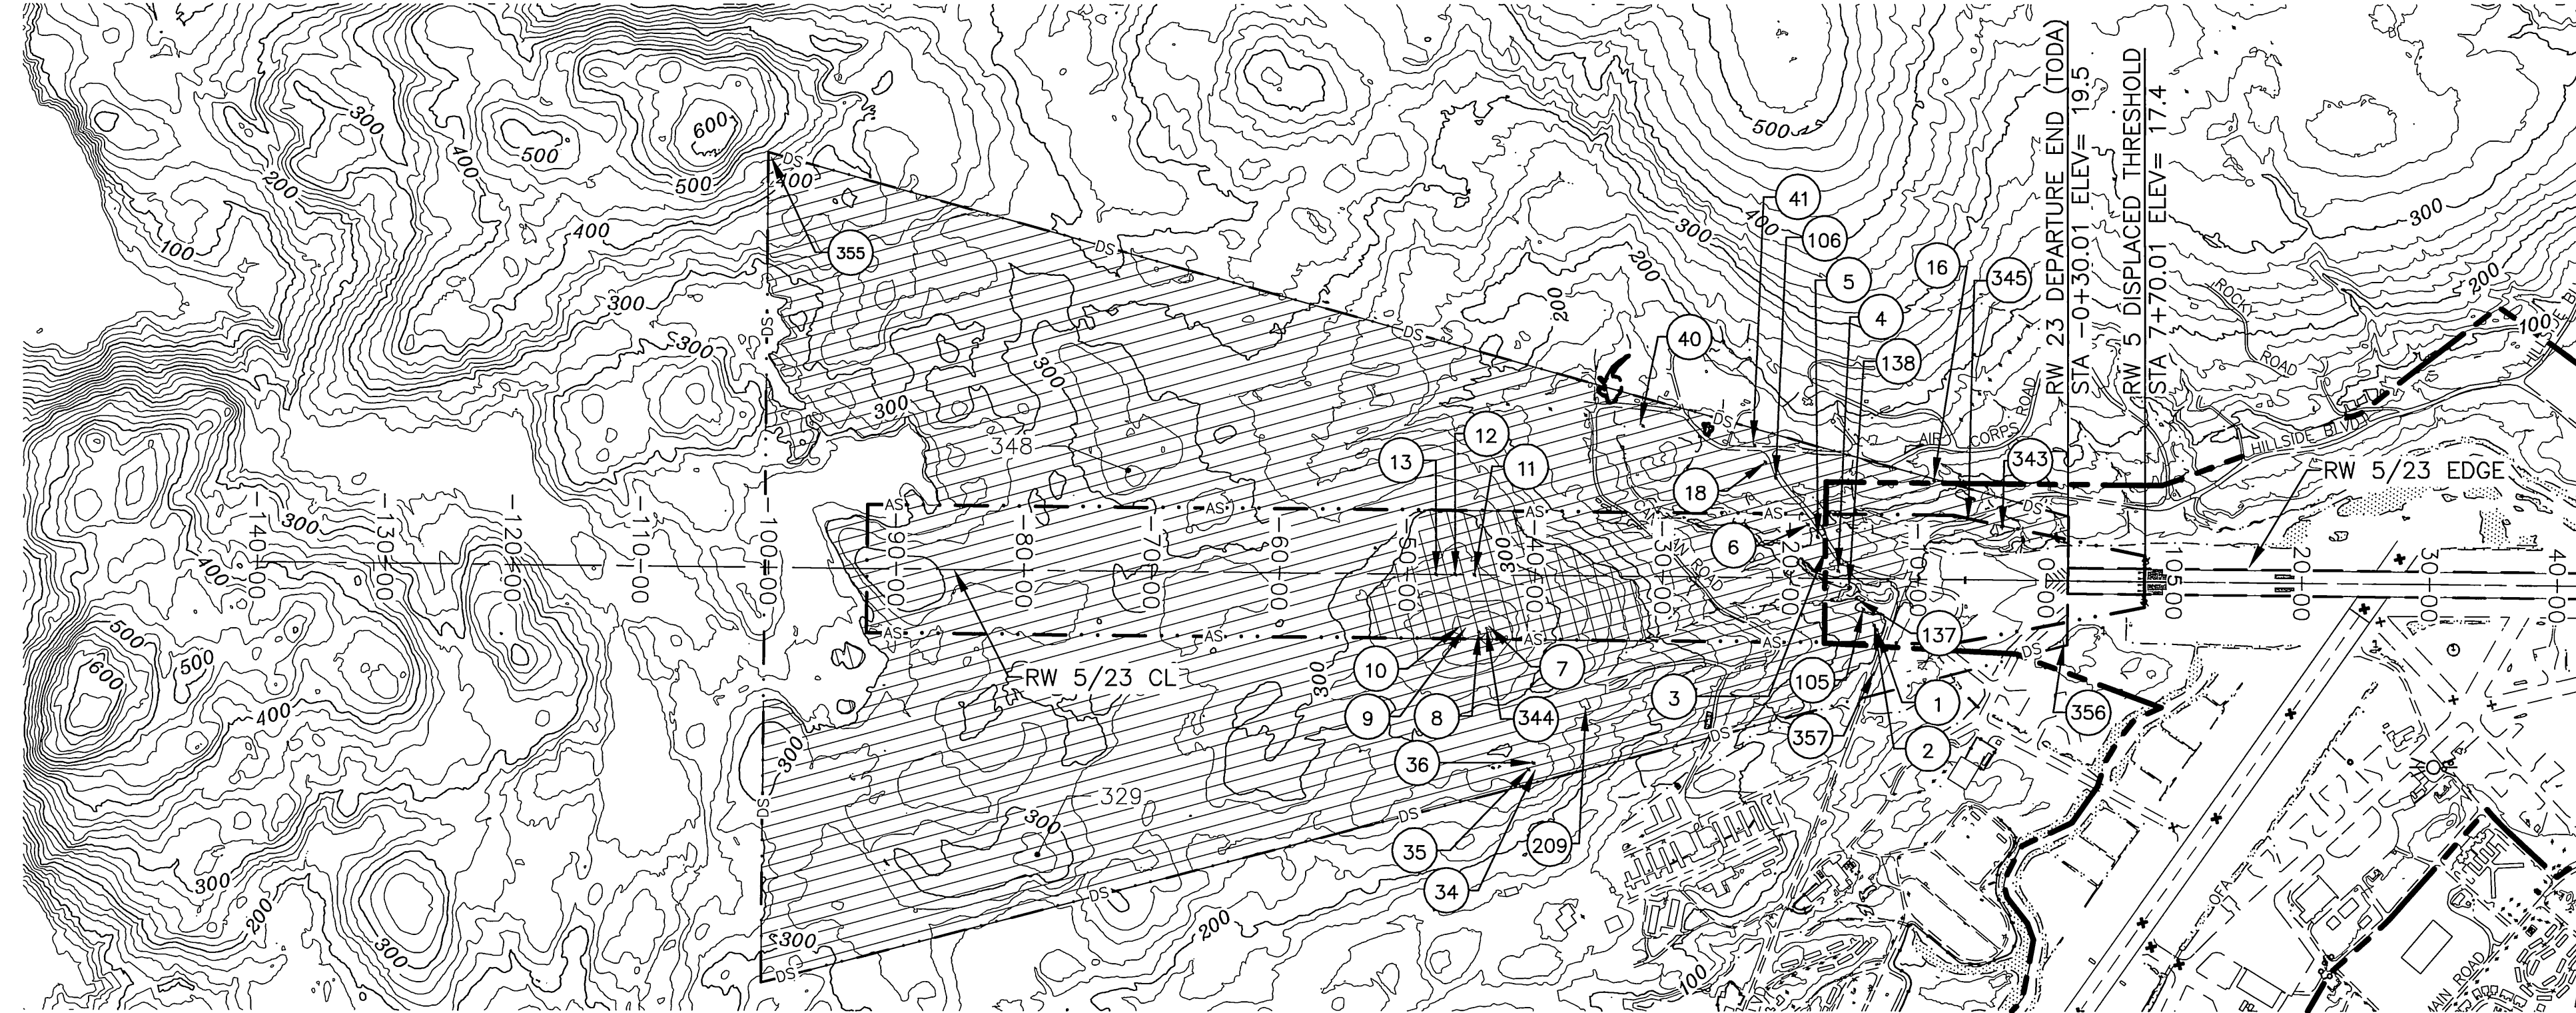


DEPARTURE & SITING SURFACE LEGEND

 -  AIRPORT PROPERTY LINE
 APPROACH SITING SURFACE
 TERRAIN PENETRATION
 DEPARTURE SURFACE
 TERRAIN PENETRATION
 OBJECT ID NUMBER


NOTE:

1. CONTOUR INTERVALS SHOWN AT 20'
2. APPROACH END OF RUNWAY 5 EXPECTED TO SERVE LARGE AIRPLANES (VISUAL DAY/NIGHT) APPROACH SITING SURFACE BEGINS @ DISPLACED THRESHOLD 400 X 1,000 X 1,500 X 8,500 X 20:1
3. DEPARTURE SURFACE FOR RW 23 BEGINS @ DEPARTURE RUNWAY END (TODA) 1,000 X 6,466 X 10,200 X 40:1
4. REFER TO APPROACH SITING AND DEPARTURE OBSTACLE TABLES ON SHEET 17

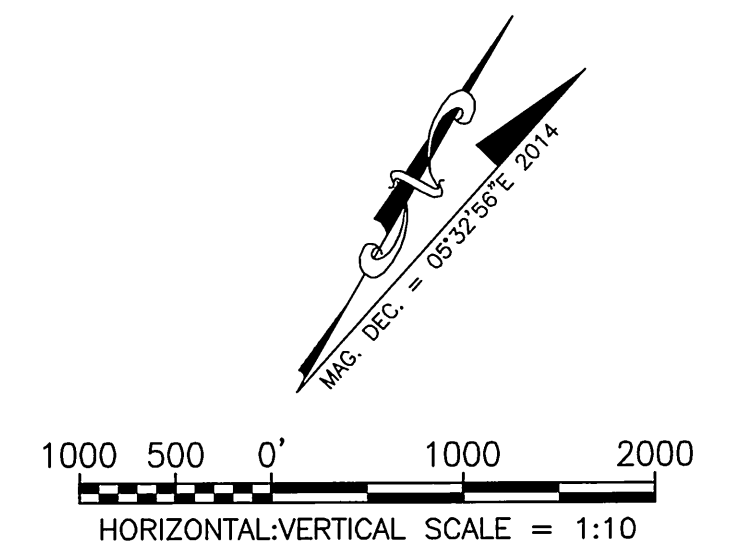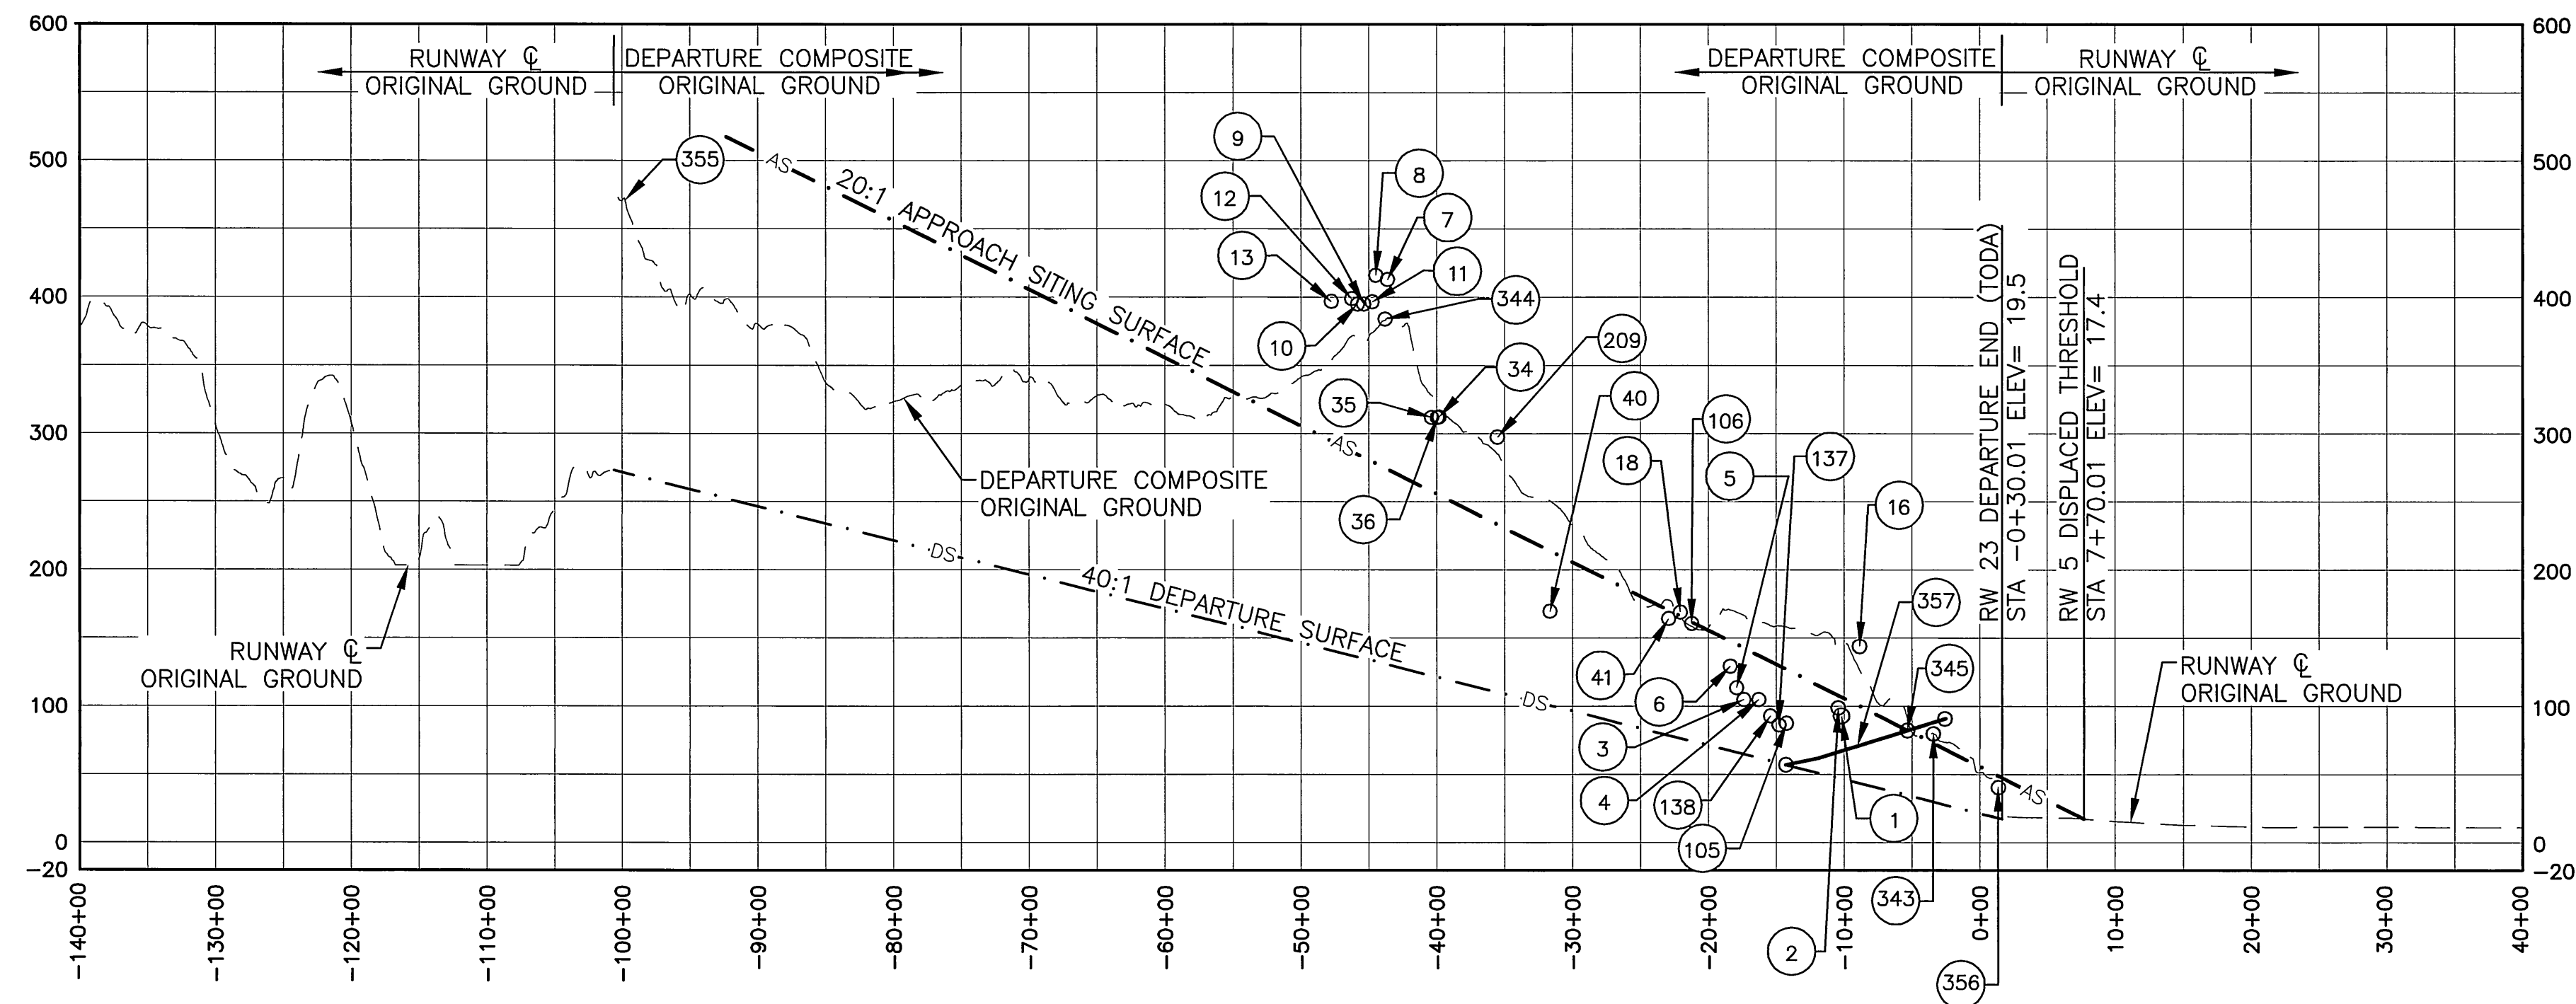



4/4/2017	AS-BUILT PER PROJECT Z549720000	
BY	DATE	REVISION
STATE OF ALASKA DEPARTMENT OF TRANSPORTATION AND PUBLIC FACILITIES CENTRAL REGION		
ADAK AIRPORT ADAK, ALASKA AIRPORT LAYOUT PLAN ULTIMATE DEPARTURES & APPROACH SITING SURFACES - RUNWAY 5		DATE: AUGUST 2015 SHEET: 15 OF 24

Date Plotted:	5/08/2017, 1:35 PM
---------------	--------------------

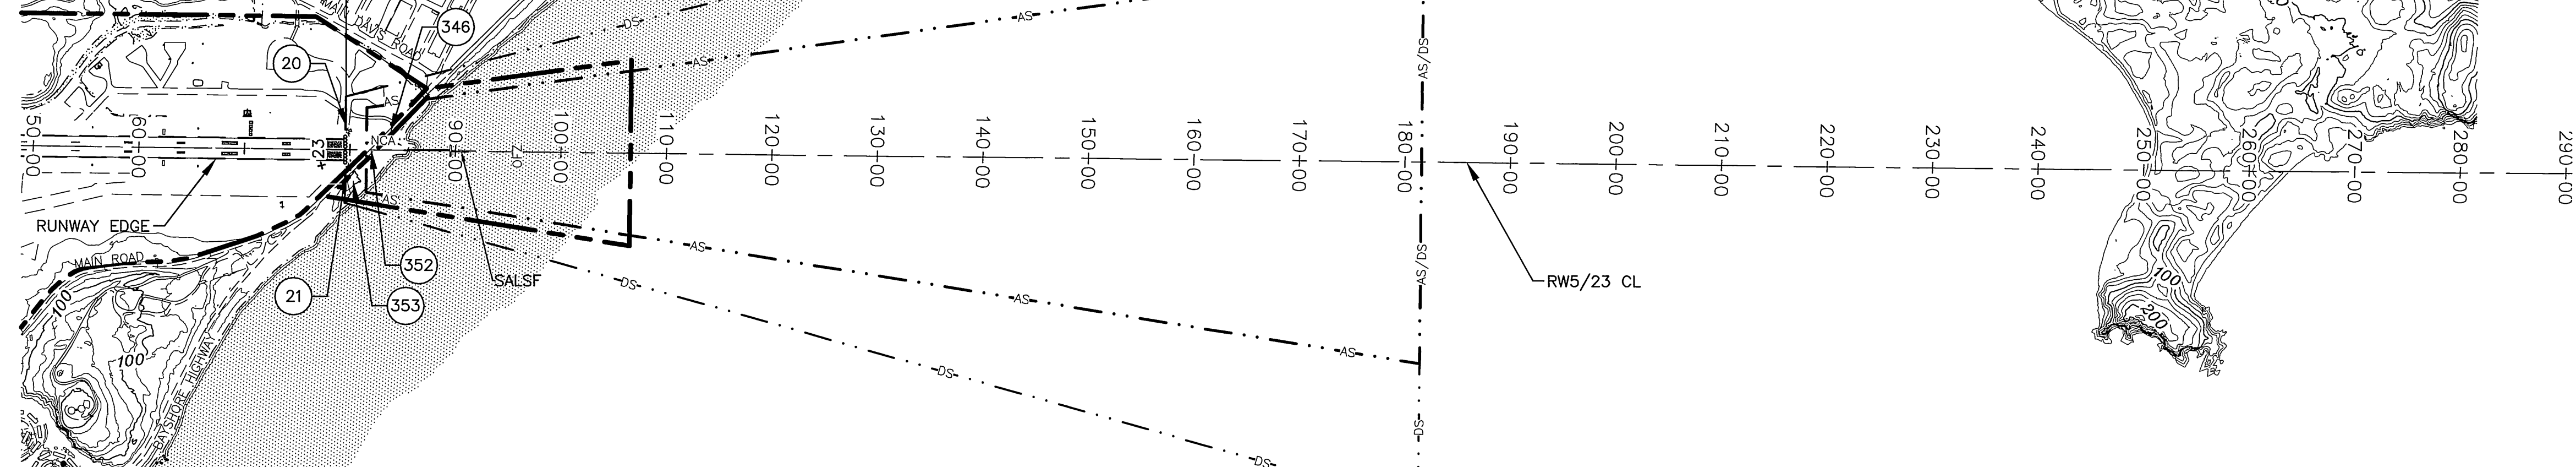

- · — · — AIRPORT PROPERTY LINE
- · — AS — · — APPROACH SITING SURFACE
- · — DS — · — DEPARTURE SURFACE
- XX OBJECT ID NUMBER

1. CONTOUR INTERVAL 20'
2. APPROACH END OF RUNWAY 23 EXPECTED TO ACCOMMODATE INSTRUMENT APPROACHES HAVING VISIBILITY MINIMUMS GREATER THAN OR EQUAL TO 3/4 BUT LESS THAN 1 STATUTE MILE, DAY OR NIGHT. APPROACH SURFACE BEGINS 200' OUTBOARD OF THRESHOLD 800 X 3,800 X 10,000 X 20:1
3. DEPARTURE SURFACE RUNWAY 5 @ RUNWAY END (TODA) 1,000 X 6,466 X 10,200 X 40:1
4. REFER TO APPROACH SITING AND DEPARTURE OBSTACLE TABLES ON SHEET 17

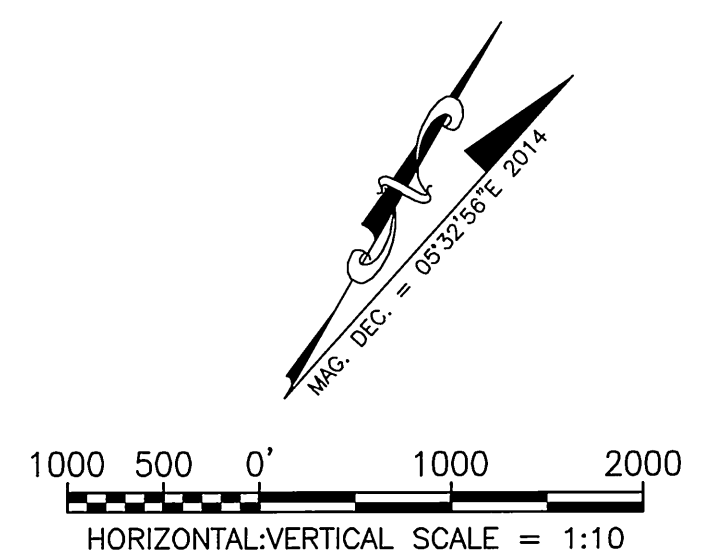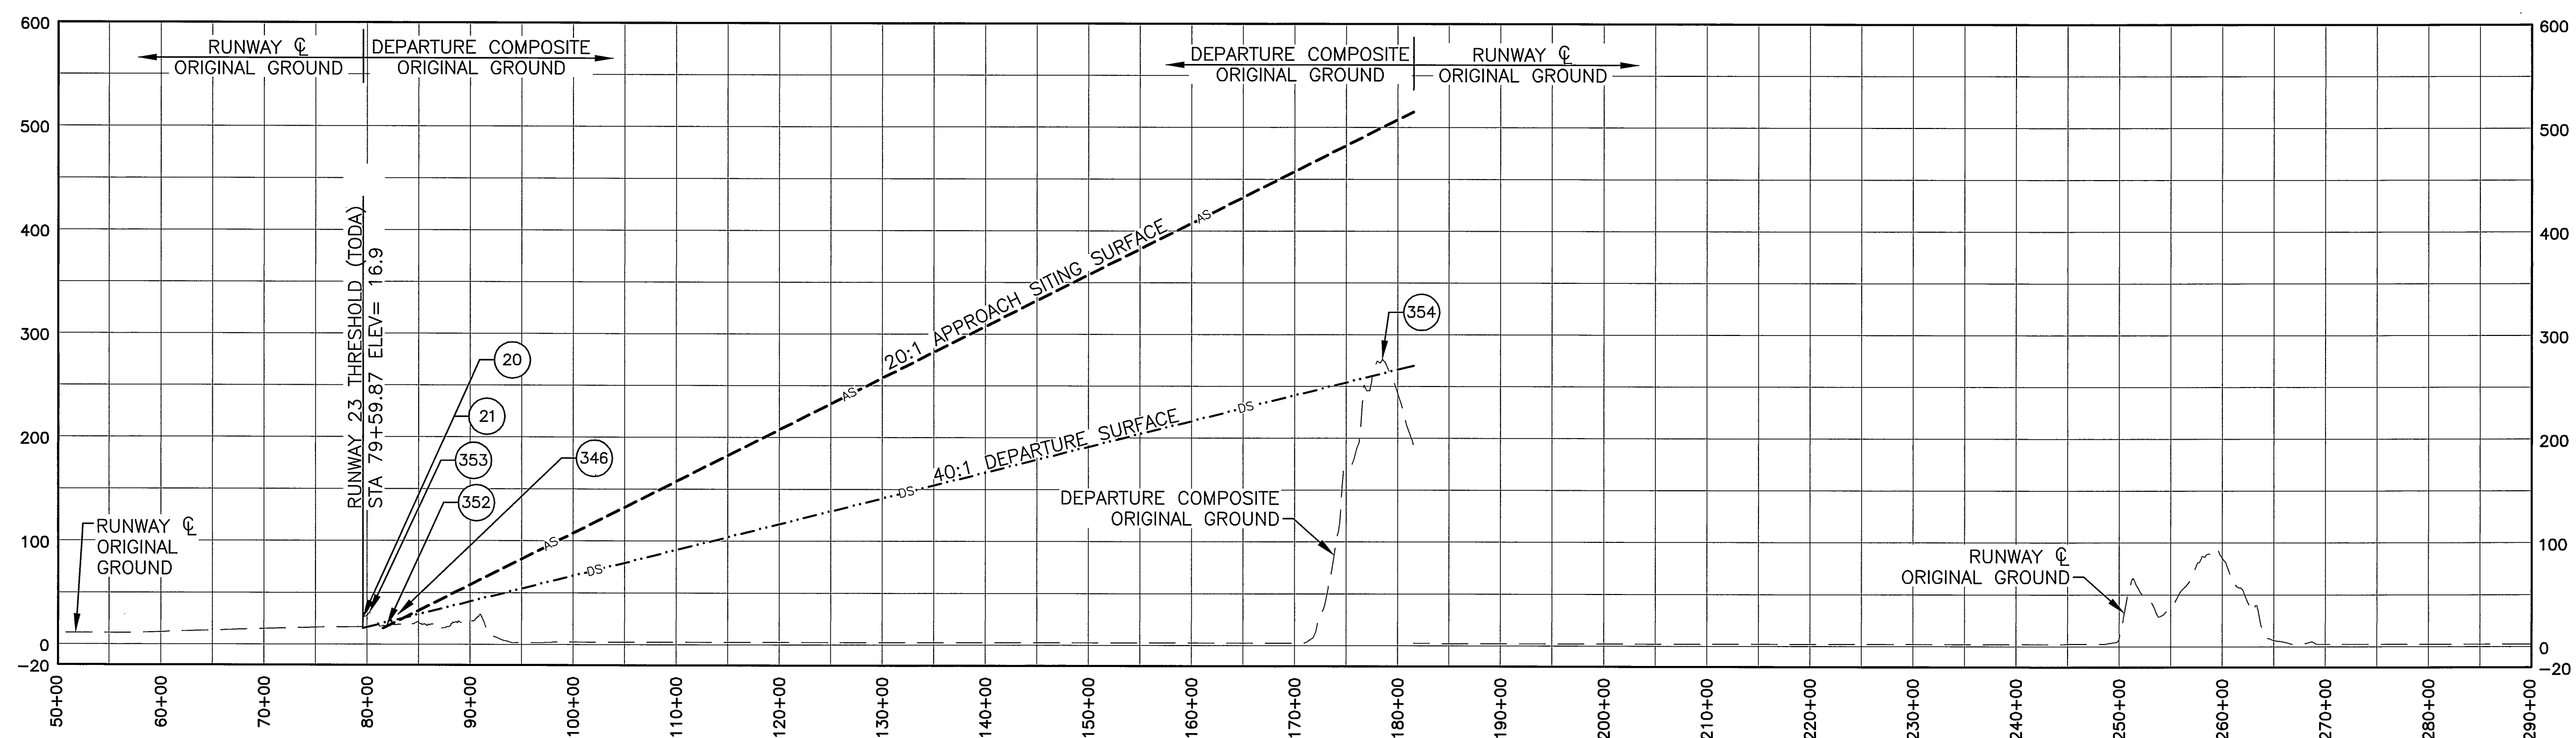

	4/4/2017	AS--BUILT PER PROJECT Z549720000
BY	DATE	REVISION

STATE OF ALASKA DEPARTMENT OF TRANSPORTATION AND PUBLIC FACILITIES CENTRAL REGION	
ADAK AIRPORT ADAK, ALASKA AIRPORT LAYOUT PLAN ULTIMATE DEPARTURE & APPROACH SITING SURFACES - RUNWAY 23	DATE: AUGUST 2015 SHEET: 16 OF 24

Designed By:
Drawn By:
Checked By:

15/08/2017 1:36 PM
19-DATA
W:\Projects\Adak\ALP\ALP 2015\ALP 2016 Revision\ALP-ADK-U-DEPT-P&P.dwg

SIGNIFICANT OBJECTS											
ID #	DESCRIPTION	STATION/ OFFSET	GRD ELEV	AGL	TOP ELEV	SURFACE PENETRATED	SURFACE ELEV	AMOUNT PENETRATION	TRIGGER EVENT	DISPOSITION	STAGE TO CORRECT
100	POLE	86+71/1091L	13.6	55.4	69.0	NONE	N/A	N/A	EXISTING	TO REMAIN	
101	POLE	86+60/1130L	13.7	55.4	69.1				EXISTING	TO REMAIN	
102	POLE	86+49/1170L	13.7	55.5	69.2				EXISTING	TO REMAIN	
103	POLE	82+89/1039L	14.3	36.6	50.9				EXISTING	TO REMAIN	
104	POLE	86+71/1082L	13.5	57.6	71.1				EXISTING	TO REMAIN	
105	POLE	-14+26/239R	57.7	26.0	83.7				EXISTING	TO REMAIN	
106	POLE	-21+22/777L	144.1	16.7	160.8				EXISTING	TO REMAIN	
*107	WIND CONE	73+59/556R	12	8	20				EXISTING	TO REMAIN	
108	NOT USED										
109	POLE	55+85/807L	10.6	12.1	22.7				EXISTING	TO REMAIN	
110	POLE	51+09/1616L	60.8	37.1	97.9				EXISTING	TO REMAIN	
111	POLE	49+81/1391L	69.6	28.1	97.7				EXISTING	TO REMAIN	
112	POLE	48+77/1300L	72.7	4.7	77.4				EXISTING	TO REMAIN	
113	LIGHTED WIND CONE	31+93/506R	14.5	19.3	33.8				EXISTING	LIGHTED	
114	WIND CONE	6+01/350R	14.2	17.8	32.0				EXISTING	TO REMAIN	
*115	ROTATING BEACON	30+45/1425R	15.3	30	45.3						
116	NOT USED										
117	NOT USED										
118	POLE	-27+21/1093L	149.1	15.2	164.3				EXISTING	TO REMAIN	
119	NOT USED										
120	SIGN	9+92/3139R	7.6	4.4	12.0				EXISTING	TO REMAIN	
121	POLE	-21+23/4086R	52.0	24.9	76.9				EXISTING	TO REMAIN	
122	POLE	-17+44/5508R	5.5	17.1	22.6				EXISTING	TO REMAIN	
123	POLE	-23+90/5763R	44.0	23.6	67.6				EXISTING	TO REMAIN	
124	POLE	-18+21/5391R	25.6	21.3	46.9				EXISTING	TO REMAIN	
125	POLE	-7+63/6390R	16.1	48.1	64.2				EXISTING	TO REMAIN	
126	POLE	-7+99/6508R	15.7	38.0	53.7				EXISTING	TO REMAIN	
127	POLE	-8+32/6618R	11.8	38.4	50.2				EXISTING	TO REMAIN	
128	POLE	-8+65/6721R	8.8	39.7	48.5				EXISTING	TO REMAIN	
129	POLE	-9+53/6681R	10.0	39.2	49.2				EXISTING	TO REMAIN	
130	POLE	-83+04/10015R	263.2	28.4	291.6				EXISTING	TO REMAIN	
131	POLE	-81+35/10143R	250.0	25.0	275.0				EXISTING	TO REMAIN	
132	POLE	-79+70/10262R	228.2	24.3	252.5				EXISTING	TO REMAIN	
133	POLE	-77+48/10429R	202.9	26.1	229.0				EXISTING	TO REMAIN	
134	NOT USED										
135	POLE	45+75/1108L	56.7	37.0	93.7				EXISTING	TO REMAIN	
136	LOCALIZER	-6+34/2L	31.8	6.5	38.3				EXISTING	TO REMAIN	
137	POLE	-14+81/157R	62.0	24.6	86.6				EXISTING	TO REMAIN	
138	POLE	-15+43/71R	63.4	29.6	93.0				EXISTING	TO REMAIN	
139	POLE	-84+31/9923R	278.7	28.0	306.7				EXISTING	TO REMAIN	
140	ELECTRICAL EQUIPMENT	39+50/479R	11.4	7.1	18.5	NONE	N/A	N/A	EXISTING	TO REMAIN	

* DATA ESTIMATED

NOTE:

1. STATION AND OFFSET BASED ON RUNWAY 5-23
2. ITEMS IN THIS TABLE WERE IDENTIFIED IN THE AERONAUTICAL SURVEY AS SAFETY CRITICAL OBJECTS BUT DO NOT PENETRATE ANY PART 77, AC 50/5300-13A DESIGN OR SITING SURFACES. ONLY OBJECTS WITHIN THE APPROACH SURFACE FOOTPRINTS ARE LABELED ON THE PLANS

BUILDINGS					
NO.	DESCRIPTION	STA & OFFSET	ELEV	STATUS	OBSTRUCTION LIGHT
200	BUILDING	46+13/1316L	79.0	UNKNOWN	NOT REQUIRED
201	CONTROL TOWER & OPERATIONS	27+47/1163R	75.4	NON-OP	LIGHTED
202	OMD HANGER	20+49/2396R	71.2	IN SERVICE	LIGHTED
203	HOUSING	-13+58/2844R	75.0 (EST)	IN SERVICE	NOT REQUIRED
204	NOT USED				
205	NOT USED				
206	DORMITORY	-23+30/5665R	63.3	UNKNOWN	NOT REQUIRED
207	NOT USED				
208	DORMITORY	-20+31/5545R	54.6	UNKNOWN	NOT REQUIRED
209	BUILDING	-35+54/1024R	297.0	UNKNOWN	
210	BERING BARRACKS COMPLEX	-29+91/1919L	170.2	NON-OP	
211	CHURCH	-33+88/2296R	183.5	UNKNOWN	
212	BUILDING	-41+44/2457R	181.6	UNKNOWN	
213	BUILDING	-37+37/2752R	224.9	UNKNOWN	
214	BUILDING	25+85/7328L	452.9	UNKNOWN	
215	BUILDING	37+82/6985L	410.2	UNKNOWN	
216	BUILDING	39+62/6799L	441.1	UNKNOWN	
217	BUILDING	41+60/7005L	431.2	UNKNOWN	
218	BUILDING	42+52/6864L	424.9	UNKNOWN	
219	BUILDING	42+83/6697L	431.9	UNKNOWN	
220	AIR TERMINAL	9+79/4305R	UNKNOWN	IN SERVICE	LIGHTED
221	FUEL STORAGE	11+87/3765R	UNKNOWN	NON-OP	
222	VP HANGER	17+24/3110R	UNKNOWN	IN SERVICE	LIGHTED
223	ARFF STATION	29+94/1505R	UNKNOWN	IN SERVICE	NOT REQUIRED
224	BALLOON LAUNCH BUILDING	32+42/1265R	UNKNOWN	NON-OP	NOT REQUIRED
*225	APPROACH LIGHTING CONTROL BLDG	80+06/103R	UNKNOWN	IN SERVICE	NOT REQUIRED
*226	GLIDE SLOPE & AWOS SHELTER	70+37/315L	21.0	IN SERVICE	LIGHTED
*227	LOCALIZER SHELTER	-6+14/218R	34.6	IN SERVICE	NOT REQUIRED
228	YAKATAT HANGER	-5+83/1420R	UNKNOWN	UNKNOWN	
229	POWER PLANT #3	-15+64/2295R	UNKNOWN	IN SERVICE	
230	NOT USED				
231	BIRCHWOOD BARRACKS COMPLEX	32+97/2009R	UNKNOWN	NON-OP	
232	HOSPITAL	29+08/2687R	UNKNOWN	NON-OP	
233	STEAM PLANT	32+32/2430R	UNKNOWN	IN SERVICE	
234	MEDICAL CLINIC	29+78/3714R	UNKNOWN	UNKNOWN	
235	RECREATION CENTER	26+72/3970R	UNKNOWN	UNKNOWN	
236	PERSONNEL SUPPORT CENTER	29+97/4357R	UNKNOWN	UNKNOWN	
237	HIGH SCHOOL & CITY ADMIN	16+85/4967R	UNKNOWN	UNKNOWN	
238	ELEMENTARY SCHOOL	22+05/5265R	UNKNOWN	IN SERVICE	
239	PUBLIC WORKS	20+93/6103R	UNKNOWN	INSERVICE	
240	SEWAGE TREATMENT FACILITY	33+58/7333R	UNKNOWN	INSERVICE	

NOTES:

1. SOME BUILDINGS ARE NOT LOCATED WITHIN THE TERMINAL AREA.
2. REFER TO SIGNIFICANT OBJECT TABLE FOR OBJECTS THAT ARE NOT PENETRATIONS.
3. REFER TO SURFACE PENETRATION TABLES FOR BUILDING PENETRATION DATA.
4. STATIONS/OFFSETS IN THIS TABLE ARE BASED ON RUNWAY 5/23.

	4/4/2017	AS-BUILT PER PROJECT Z549720000
BY	DATE	REVISION

STATE OF ALASKA

DEPARTMENT OF TRANSPORTATION

AND PUBLIC FACILITIES

CENTRAL REGION

ADAK AIRPORT


ADAK, ALASKA

AIRPORT LAYOUT PLAN


SIGNIFICANT OBJECTS &
BUILDING TABLES

DATE:
AUGUST 2015

SHEET:
18
OF
24

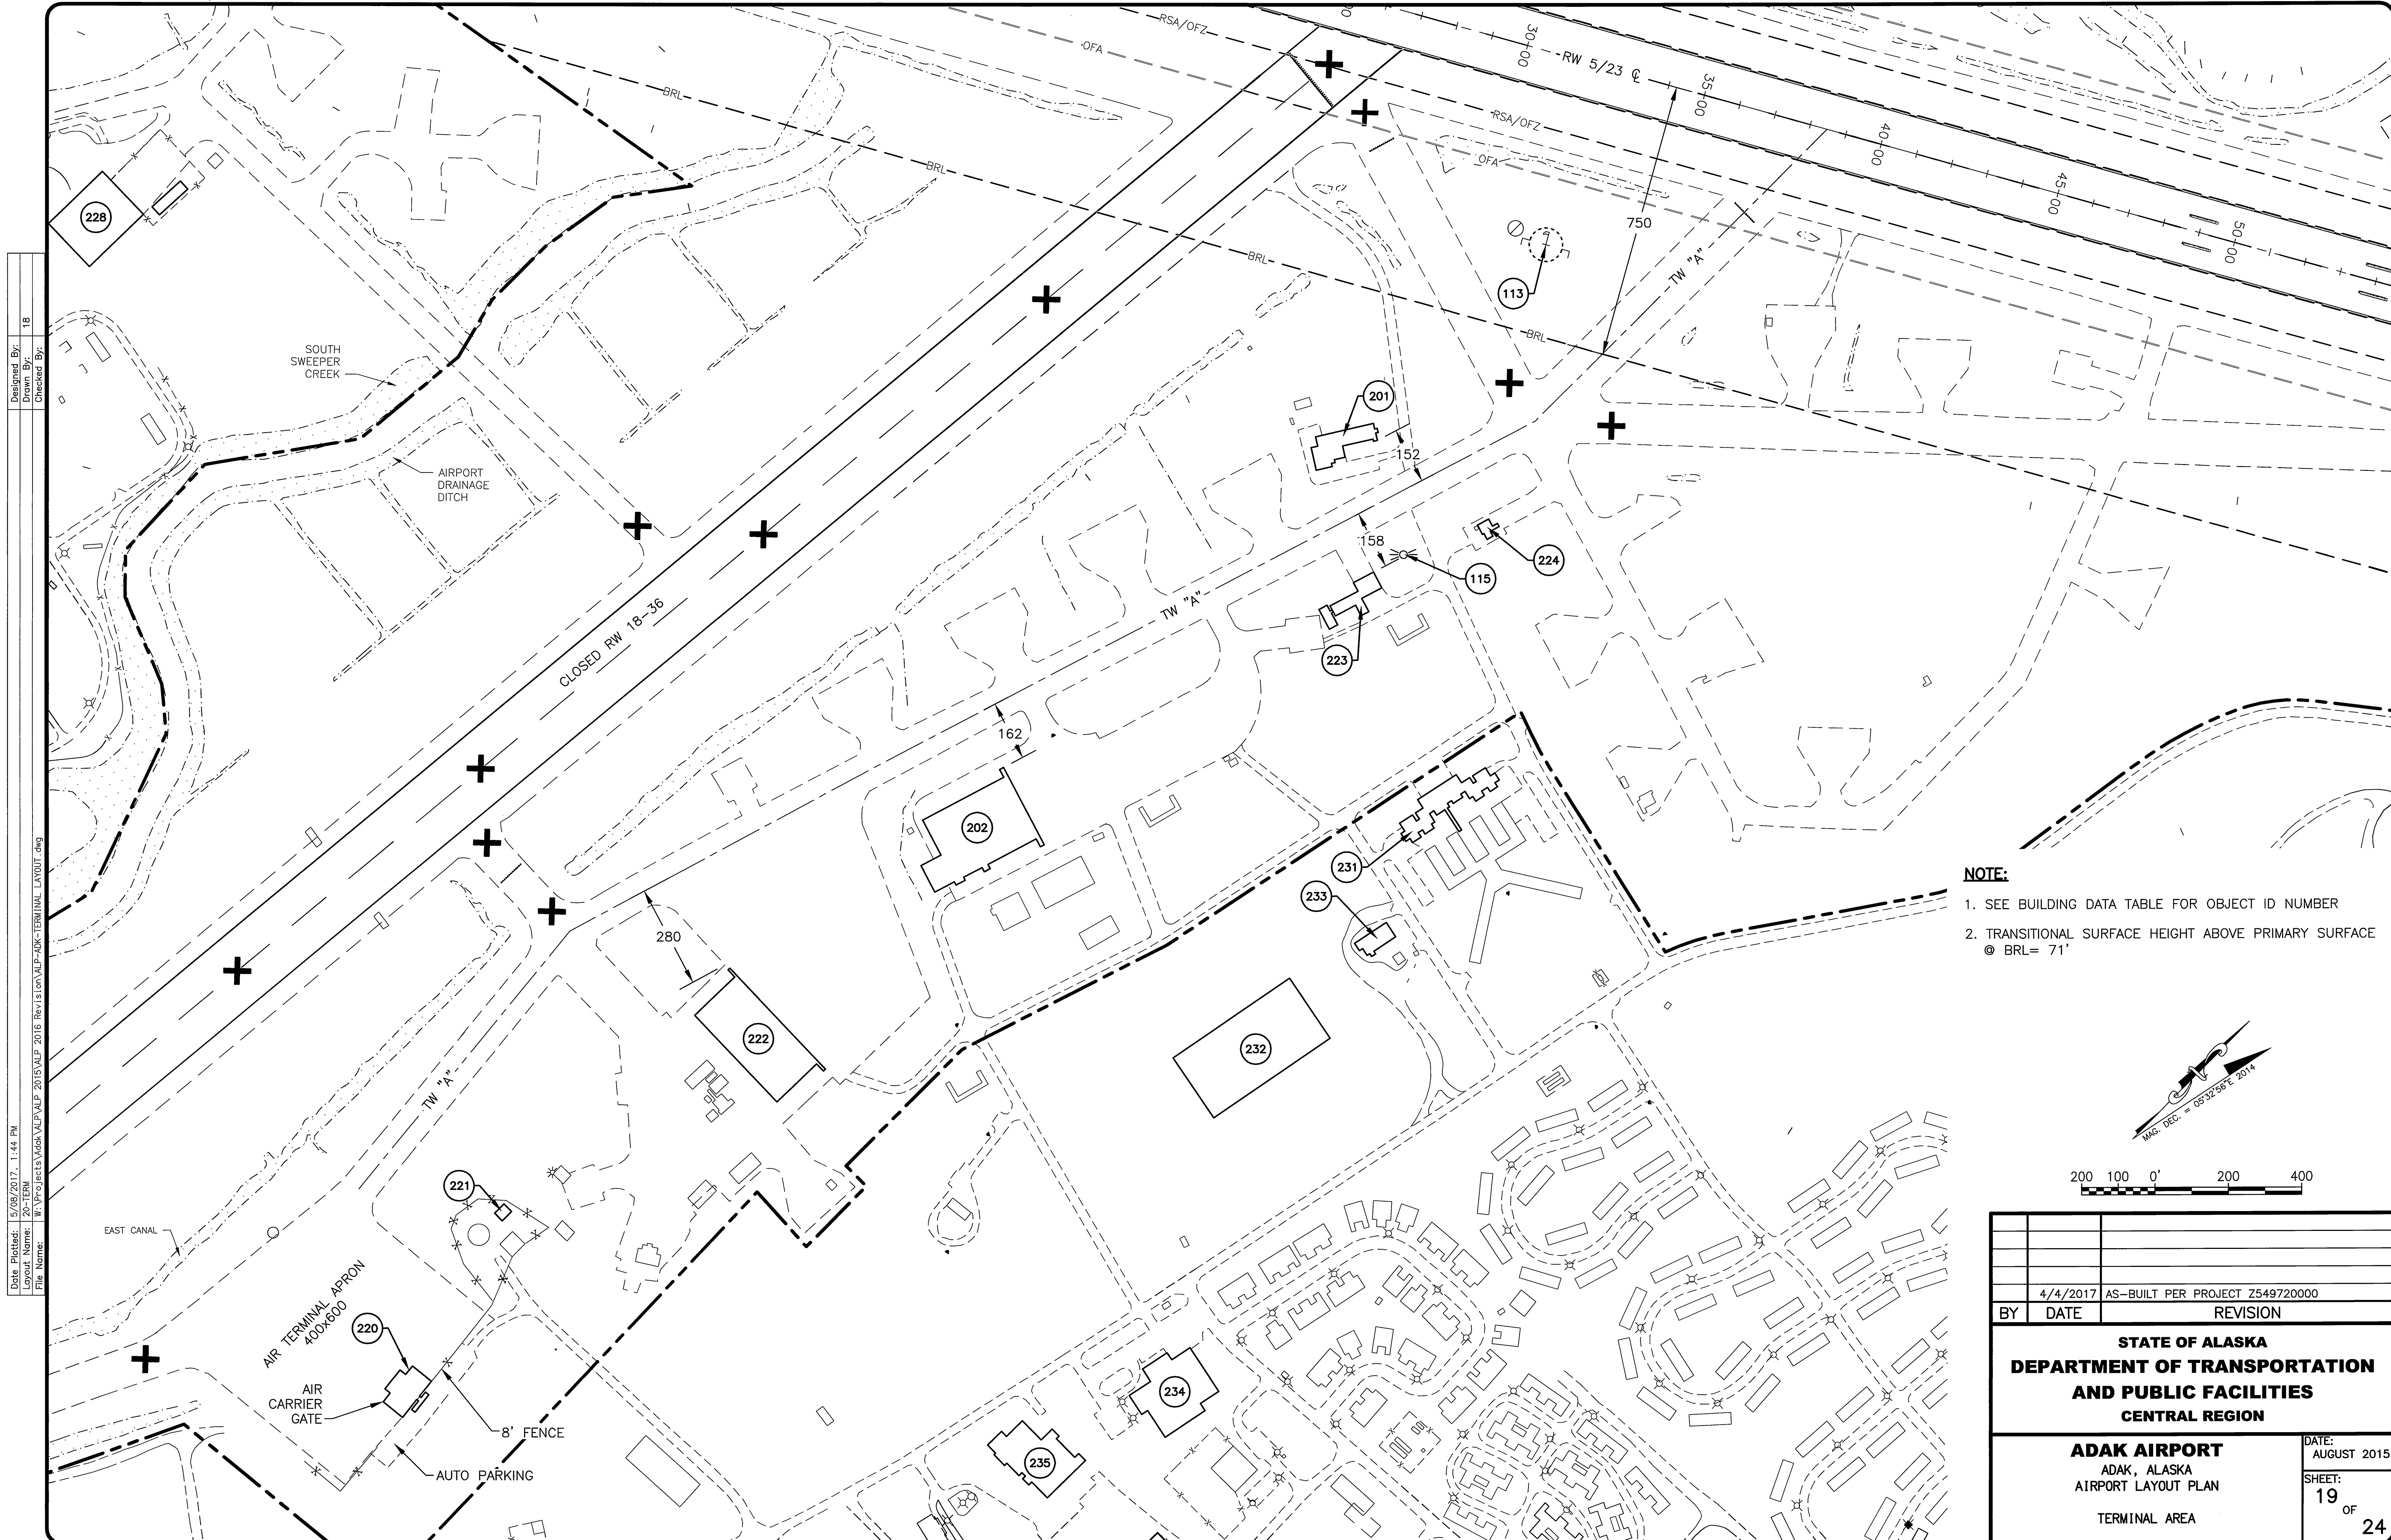

1. SEE BUILDING DATA TABLE FOR OBJECT ID NUMBER
2. TRANSITIONAL SURFACE HEIGHT ABOVE PRIMARY SURFACE
@ BRL= 71'

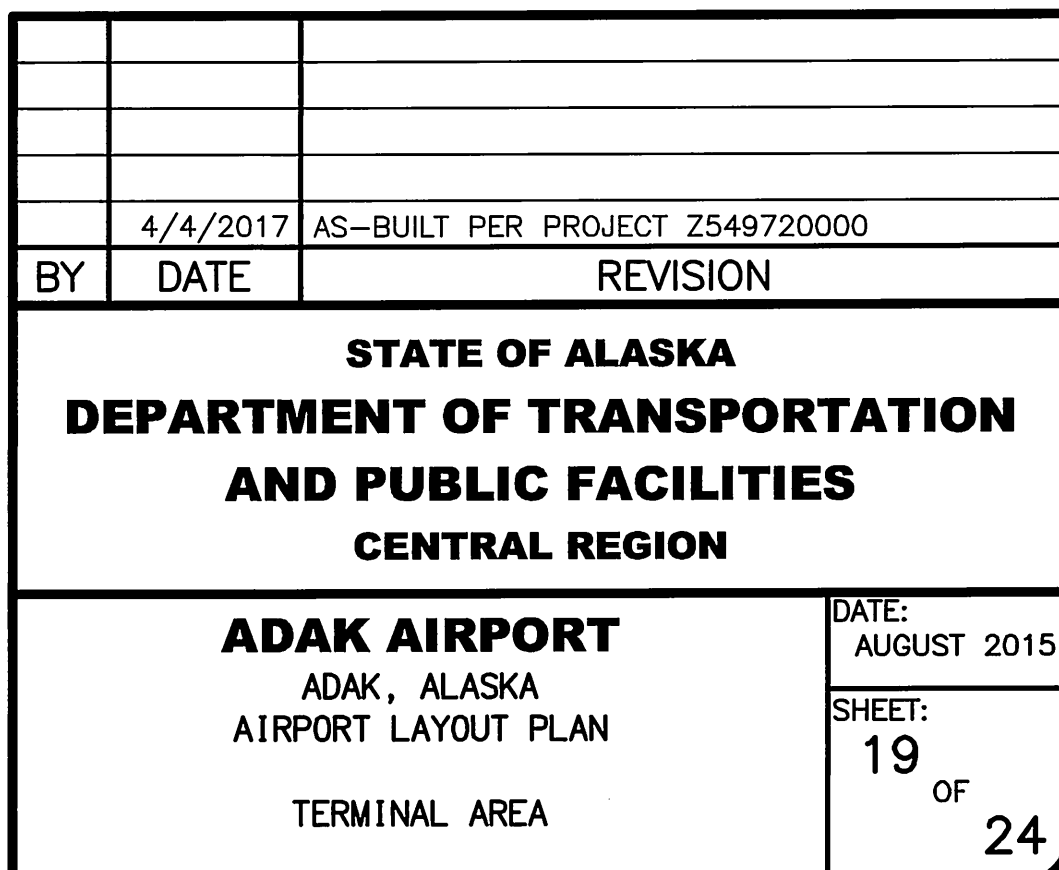


Designed By:
Drawn By:
Checked By:

5/08/2017, 2:06 PM
19-777
W:\Projects\Adak\ALP\2015\ALP 2015\ALP-40X-PART 77.dwg

NOTES:

1. AIRPORT ELEVATION IS 20' (SURVEYED) (NAVD88).
2. MAPPING BASED ON AERONAUTICAL SURVEY DATED 2012.
3. PRIMARY SURFACE WIDTH RUNWAY 5/23 = 500'
4. THERE ARE NO KNOWN HEIGHT RESTRICTIONS
5. CONTOUR INTERVAL 50'
6. REFER TO INNER PORTION OF THE APPROACH DRAWINGS FOR CLOSE IN OBSTRUCTIONS
7. SEE PART 77 SURFACE OBSTRUCTION DATA ON SHTS 22-23

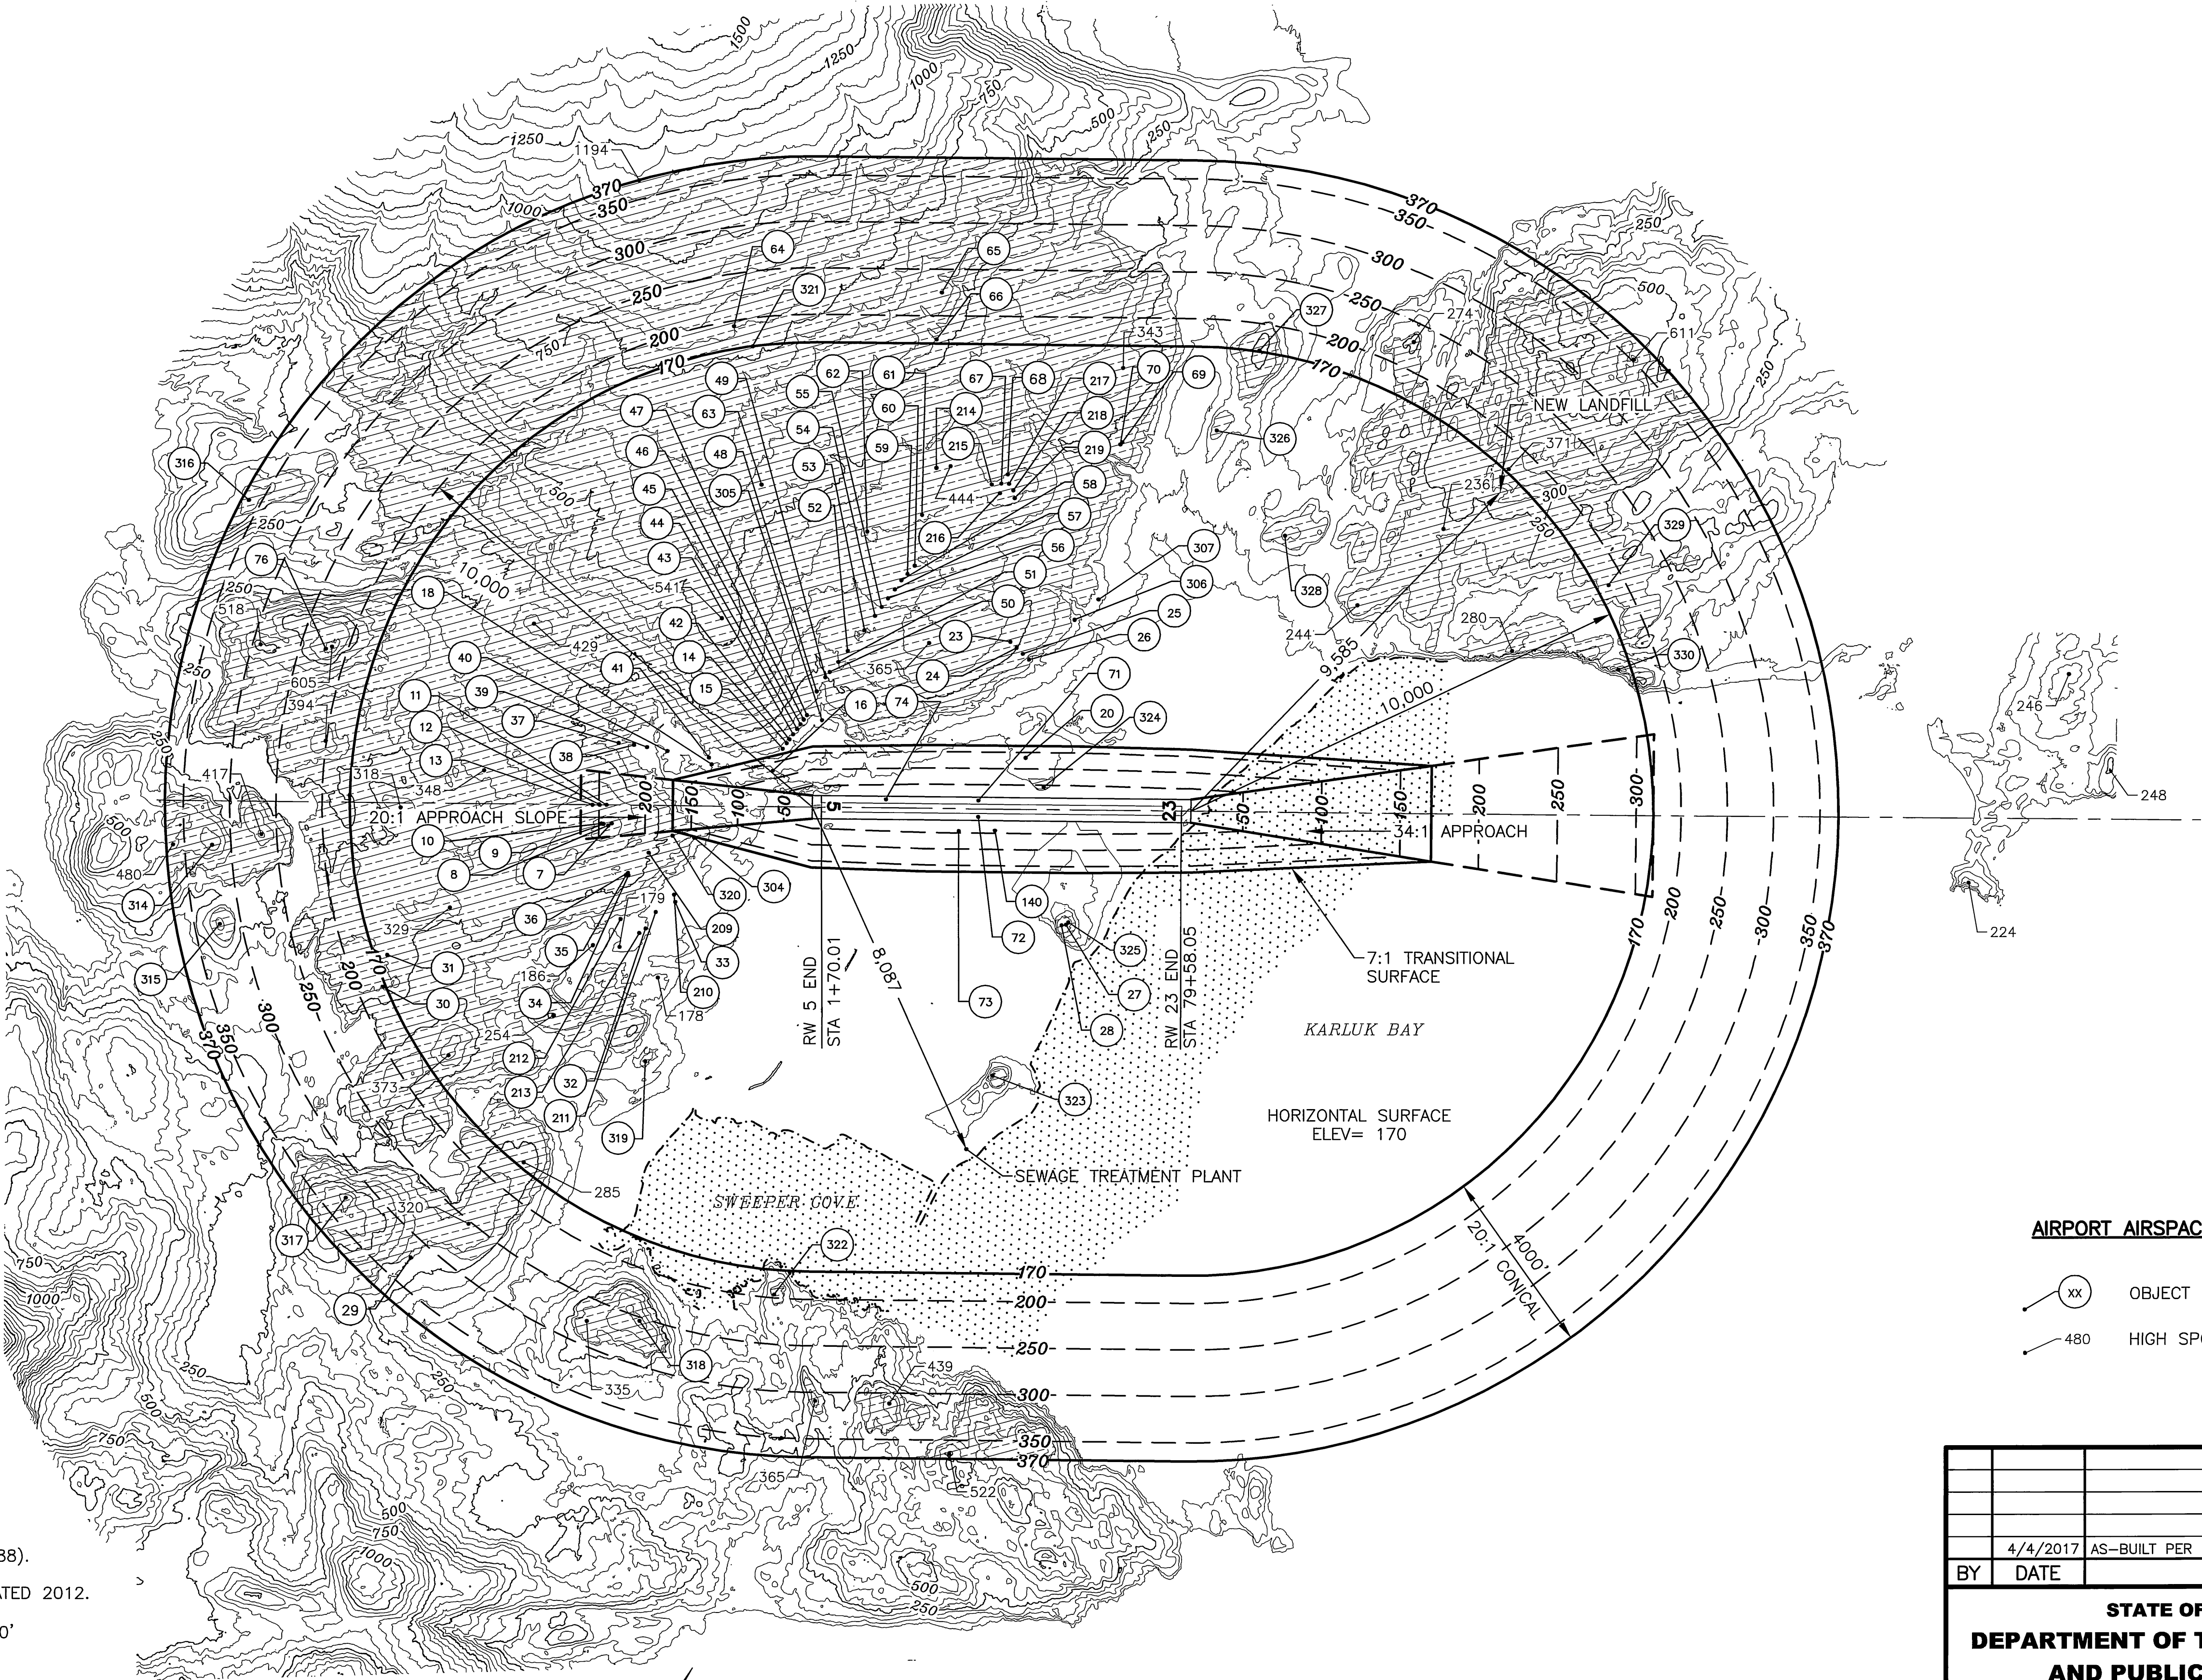

AIRPORT AIRSPACE LEGEND:

- OBJECT ID NUMBER
- HIGH SPOT ELEVATION

	4/4/2017	AS-BUILT PER PROJECT Z549720000
BY	DATE	REVISION
STATE OF ALASKA DEPARTMENT OF TRANSPORTATION AND PUBLIC FACILITIES CENTRAL REGION		
ADAK AIRPORT ADAK, ALASKA AIRPORT LAYOUT PLAN		DATE: AUGUST 2015
AIRPORT AIRSPACE, 14 CFR, PART 77		SHEET: 20 OF 24

ULTIMATE APPROACH SURFACE DIMENSIONS	
RUNWAY 5	500 X 1,500 X 5,000 X 20:1
RUNWAY 23	500 X 3,500 X 10,000 X 34:1

APPROACH SURFACES BEGIN 200' OUTBOARD OF RUNWAY ENDS

Date Plotted: 15/08/2017, 2:06 PM



Layout Name: 22-P77

File Name: W:\Projects\Adak\ALP\ALP 2015\ALP 2016 Revision\ALP-ADK-PART 77.dwg

Designed By:

Drawn By:

Checked By:

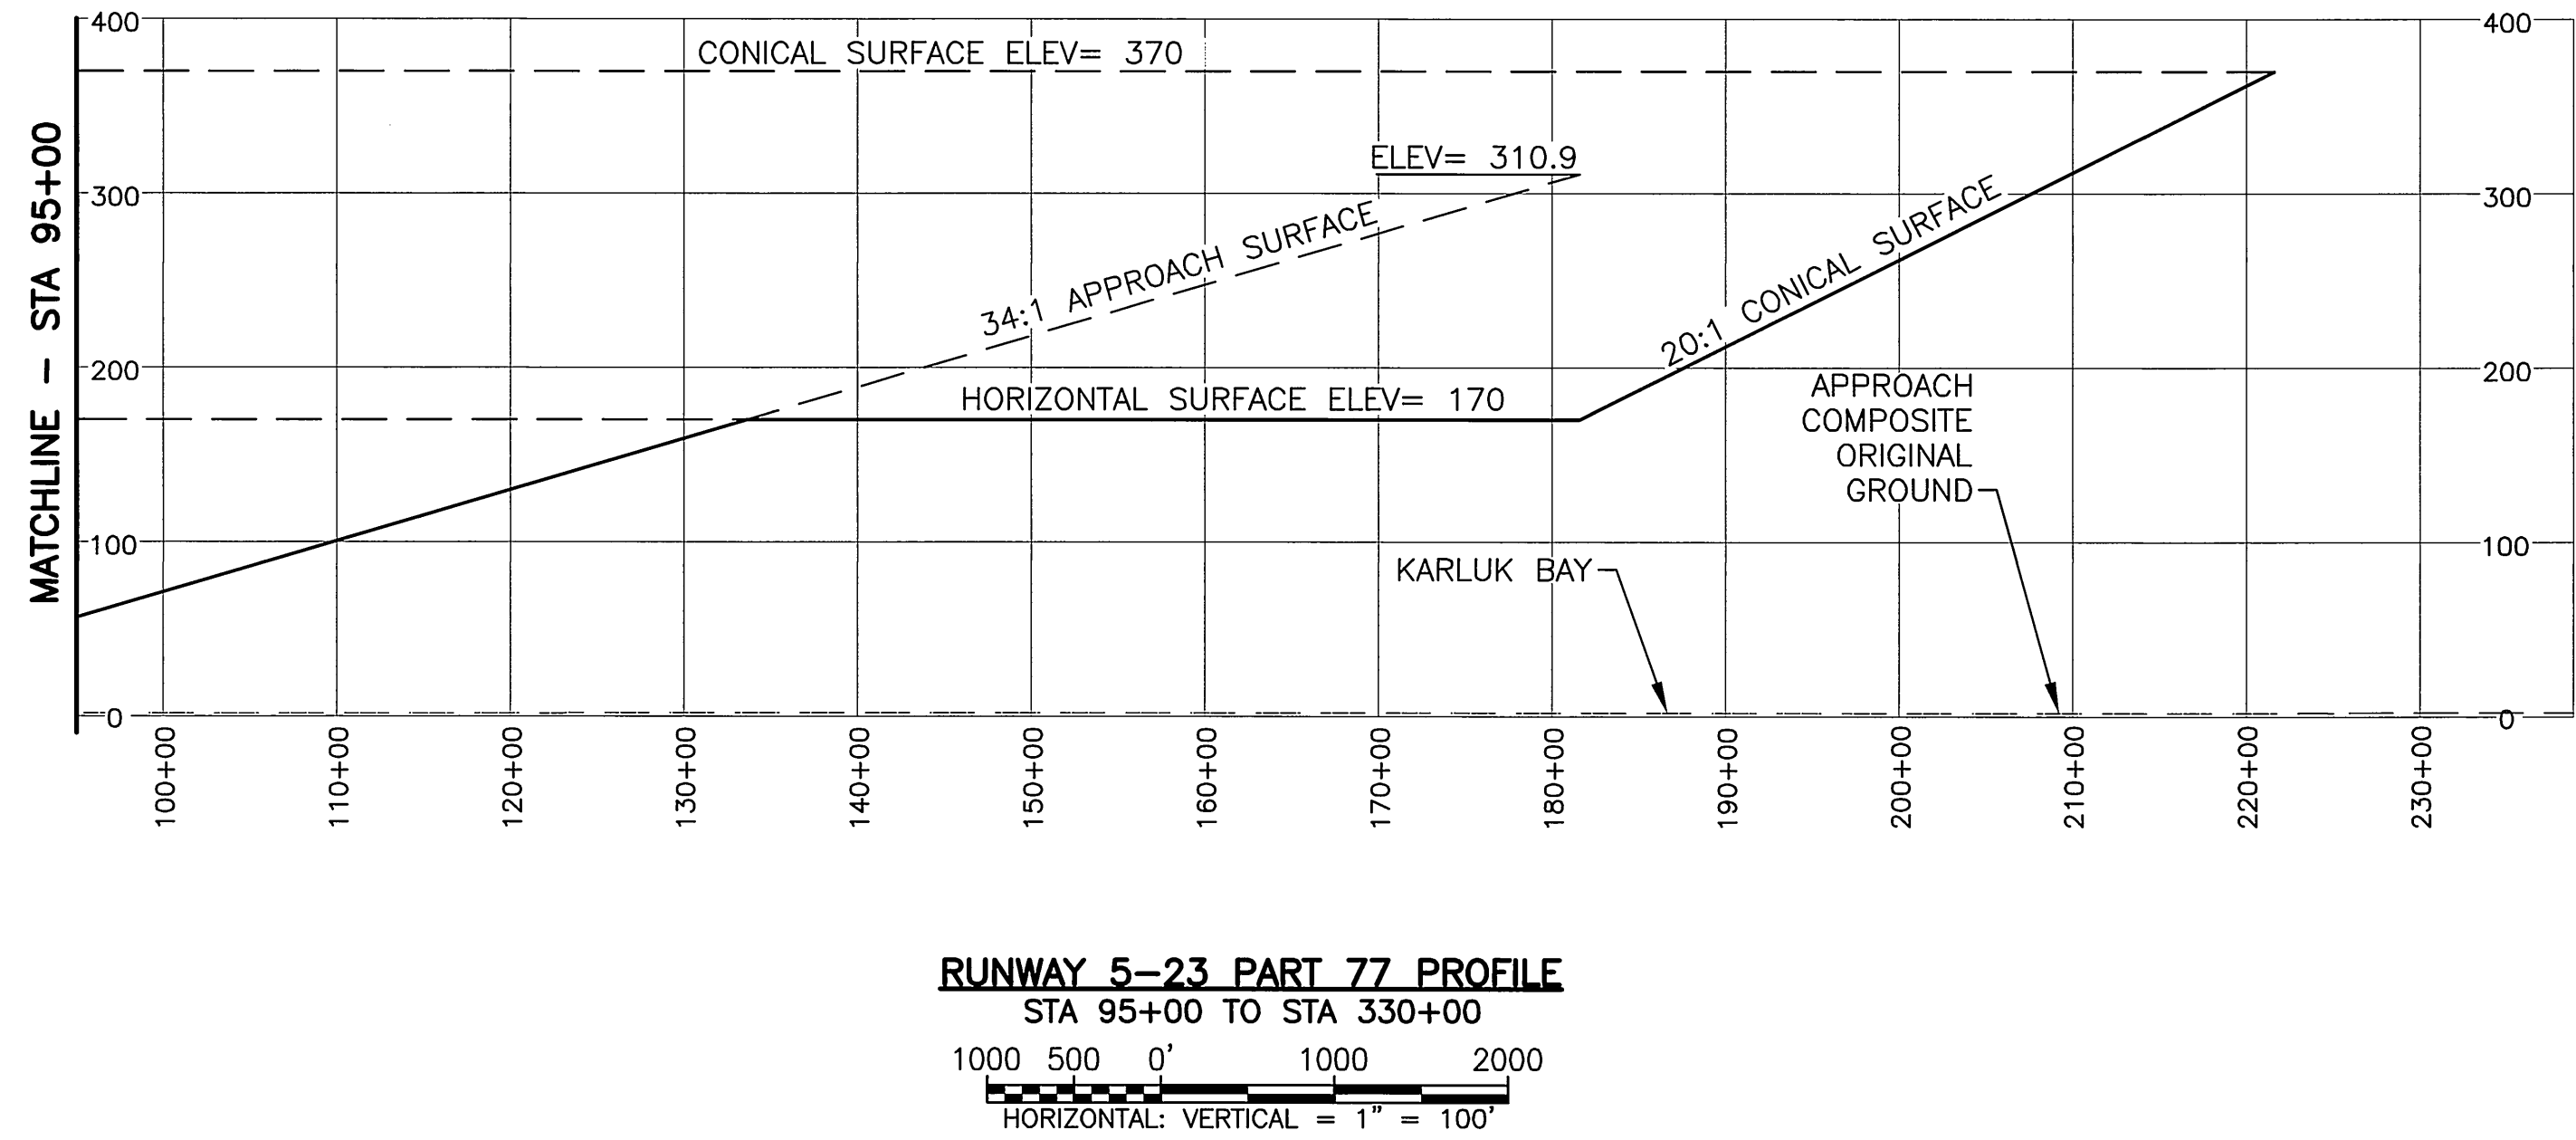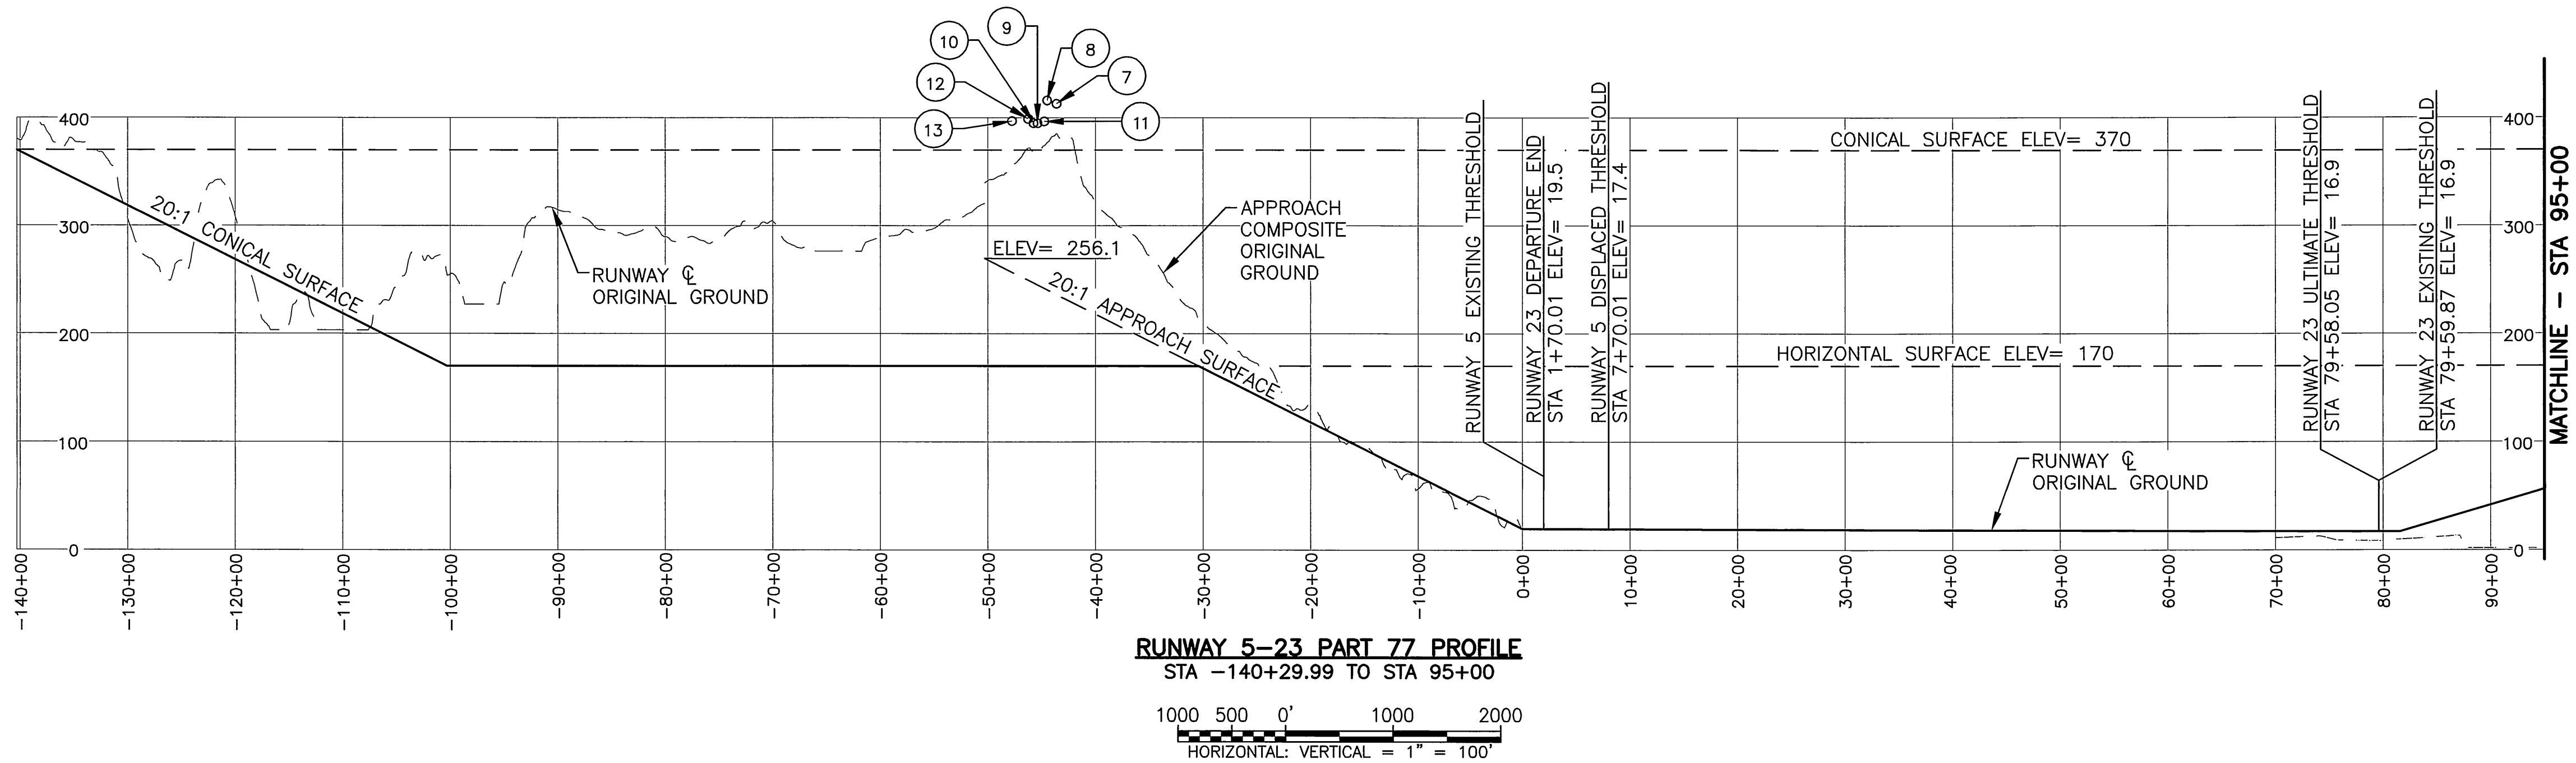

	4/4/2017	AS-BUILT PER PROJECT Z549720000
BY	DATE	REVISION

STATE OF ALASKA
DEPARTMENT OF TRANSPORTATION
AND PUBLIC FACILITIES
CENTRAL REGION

ADAK AIRPORT
ADAK, ALASKA
AIRPORT LAYOUT PLAN
AIRPORT AIRSPACE, 14 CFR, PART 77
RUNWAY 23 APPROACH

DATE:
AUGUST 2015
SHEET:
21
OF
24

Designed By:
Drawn By:
Checked By:


Date Plotted: 5/03/2017 - 2:07 PM
Layout Name: 24-P77-TABLES
File Name: W:\Projects\Adak VLP\2015 VLP 2016 Revision\ALP-ADK-PART 77.dwg

PART 77 SURFACE OBSTRUCTIONS											
ID #	DESCRIPTION	STATION/ OFFSET	GRD ELEV	AGL	TOP ELEV	SURFACE PENETRATED	SURFACE ELEV	AMOUNT PENETRATION	TRIGGER EVENT	DISPOSITION	STAGE TO CORRECT
1	POLE	-13+20/396R	65.2	27.9	93.1	TRANSITIONAL	86.5	6.6	EXISTING	TO REMAIN	
2	POLE	-13+43/361R	69.9	29.1	99.0	RW 5 APPROACH	85.1	13.9	EXISTING	TO REMAIN	
3	POLE	-17+05/187L	81.5	25	106.5	RW 5 APPROACH	103.3	3.2	EXISTING	TO REMAIN	
4	POLE	-16+30/58L	76.7	28.3	105.0	RW 5 APPROACH	99.5	5.5	EXISTING	TO REMAIN	
5	POLE	-17+92/322L	92.4	21.4	113.8	RW 5 APPROACH	107.6	6.2	EXISTING	TO REMAIN	
6	POLE	-18+39/417L	105.4	24.1	129.5	RW 5 APPROACH	111.4	18.1	EXISTING	TO REMAIN	
7	TACAN TOWER	-43+61/396R	378.7	34.2	412.9	HORIZONTAL	170.0	242.9	EXISTING	TO REMAIN	
8	POLE	-44+35/444R	377.5	38.6	416.1	HORIZONTAL	170.0	246.1	EXISTING	TO REMAIN	
9	RADAR DOME	-45+37/413R	366.7	28.4	395.1	HORIZONTAL	170.0	225.1	EXISTING	TO REMAIN	
10	DME ANTENNA	-45+82/402R	366.3	28.8	395.1	HORIZONTAL	170.0	225.1	EXISTING	TO REMAIN	
11	NDB TOWER	-44+75/0	327.0	70.0	397.0	HORIZONTAL	170.0	227.0	EXISTING	TO REMAIN	
12	NDB SHELTER	-46+25/0	327.0	70.0	397.0	HORIZONTAL	170.0	327.0	EXISTING	TO REMAIN	
13	NDB TOWER	-47+75/0	327.0	70.0	397.0	HORIZONTAL	170.0	327.0	EXISTING	TO REMAIN	
14	POLE	-5+93/1369L	163.4	9.4	172.8	HORIZONTAL	170.0	2.8	EXISTING	TO REMAIN	
15	POLE	-6+79/1247L	160.2	16.9	177.1	HORIZONTAL	170.0	7.1	EXISTING	TO REMAIN	
16	POLE	-8+87/771L	125.9	18.2	144.1	TRANSITIONAL	124.5	19.6	EXISTING	TO REMAIN	
17	NOT USED										
18	POLE	-22+06/898L	150.5	18.5	169.0	HORIZONTAL	170.0	1 ^	EXISTING	TO REMAIN	
19	NOT USED										
20	REIL	79+67/119L	15.4	4.7	20.1	PRIMARY	16.9	3.2	EXISTING	FRANGIBLE	
21	REIL	79+66/119R	15.6	4.5	20.1	PRIMARY	16.9	3.2	EXISTING	FRANGIBLE	
22	NOT USED										
23	POLE	42+19/3604L	270.2	24.5	294.7	HORIZONTAL	170.0	124.7	EXISTING	TO REMAIN	
24	POLE	43+56/3476L	250.9	25.0	275.9	HORIZONTAL	170.0	105.9	EXISTING	TO REMAIN	
25	POLE	44+92/3347L	227.9	23.4	251.3	HORIZONTAL	170.0	81.3	EXISTING	TO REMAIN	
26	POLE	46+29/3223L	186.2	27.5	213.7	HORIZONTAL	170.0	43.7	EXISTING	TO REMAIN	
27	TANK	54+85/2472R	213.8	39.0	252.8	HORIZONTAL	170.0	82.8	EXISTING	TO REMAIN	
28	TANK	53+89/2489R	214.4	38.4	252.8	HORIZONTAL	170.0	82.8	EXISTING	TO REMAIN	
29	POLE	-86+11/9793R	309.1	27.4	336.5	CONICAL	321.0	15.5	EXISTING	TO REMAIN	
30	BUNKER	-92+69/3967R	304.8	10.6	315.4	CONICAL	172.8	142.6	EXISTING	TO REMAIN	
31	BUNKER	-91+86/3278R	294.8	15.3	310.1	HORIZONTAL	170.0	140.1	EXISTING	TO REMAIN	
32	POLE	-36+01/2653R	154.6	26.2	180.8	HORIZONTAL	170.0	10.8	EXISTING	TO REMAIN	
33	POLE	-29+67/2073R	128.2	44.4	172.6	HORIZONTAL	170.0	2.6	EXISTING	TO REMAIN	
34	TANK	-39+84/1512R	277.0	35.4	312.4	HORIZONTAL	170.0	142.4	EXISTING	TO REMAIN	
35	TANK	-40+37/1509R	277.0	35.0	312.0	HORIZONTAL	170.0	142.0	EXISTING	TO REMAIN	
36	TANK	-39+96/1460R	277.0	35.0	312.0	HORIZONTAL	170.0	142.0	EXISTING	TO REMAIN	
37	POLE	-42+26/1334L	176.6	27.3	203.9	HORIZONTAL	170.0	33.9	EXISTING	TO REMAIN	
38	POLE	-38+91/1299L	166.5	11.1	177.6	HORIZONTAL	170.0	7.6	EXISTING	TO REMAIN	
39	POLE	-36+13/1253L	161.7	18.2	179.9	HORIZONTAL	170.0	9.9	EXISTING	TO REMAIN	
40	POLE	-31+67/1174L	150.7	18.9	169.6	HORIZONTAL	170.0	1 ^	EXISTING	TO REMAIN	
41	POLE	-22+92/1034L	154.5	15.1	169.6	HORIZONTAL	170.0	1 ^	EXISTING	TO REMAIN	
42	POLE	-5+35/1451L	166.6	21.6	188.2	HORIZONTAL	170.0	18.2	EXISTING	TO REMAIN	
43	POLE	-4+55/1561L	172.4	22.7	195.1	HORIZONTAL	170.0	25.1	EXISTING	TO REMAIN	
44	POLE	-3+74/1676L	176.8	22.2	199.0	HORIZONTAL	170.0	29.0	EXISTING	TO REMAIN	
45	POLE	-3+04/1775L	177.0	19.4	196.4	HORIZONTAL	170.0	26.4	EXISTING	TO REMAIN	
46	POLE	-2+32/1880L	182.9	23.7	206.6	HORIZONTAL	170.0	36.6	EXISTING	TO REMAIN	
47	POLE	-1+61/1978L	180.4	25.9	206.3	HORIZONTAL	170.0	36.3	EXISTING	TO REMAIN	
48	POLE	0+41/2489L	212.9	28.6	241.5	HORIZONTAL	170.0	71.5	EXISTING	TO REMAIN	
49	POLE	2+26/2797L	251.8	16.7	268.5	HORIZONTAL	170.0	98.5	EXISTING	TO REMAIN	
50	POLE	3+21/2911L	267.5	24.7	292.2	HORIZONTAL	170.0	122.2	EXISTING	TO REMAIN	

PART 77 SURFACE OBSTRUCTIONS CONTINUED											
ID #	DESCRIPTION	STATION/ OFFSET	GRD ELEV	AGL	TOP ELEV	SURFACE PENETRATED	SURFACE ELEV	AMOUNT PENETRATION	TRIGGER EVENT	DISPOSITION	STAGE TO CORRECT
51	POLE	5+04/3129L	297.6	22.9	320.5	HORIZONTAL	170.0	150.5	EXISTING	TO REMAIN	
52	POLE	7+05/3366L	323.8	21.9	345.7	HORIZONTAL	170.0	175.7	EXISTING	TO REMAIN	
53	POLE	10+64/3818L	349.4	13.8	363.2	HORIZONTAL	170.0	193.2	EXISTING	TO REMAIN	
54	POLE	12+89/4126L	344.4	29.5	373.9	HORIZONTAL	170.0	203.9	EXISTING	TO REMAIN	
55	POLE	14+29/4319L	379.4	27.0	376.4	HORIZONTAL	170.0	206.4	EXISTING	TO REMAIN	
56	POLE	15+67/4507L	371.4	26.6	398.0	HORIZONTAL	170.0	228.0	EXISTING	TO REMAIN	
57	POLE	17+12/4701L	383.1	27.0	410.1	HORIZONTAL	170.0	240.1	EXISTING	TO REMAIN	
58	POLE	18+54/4900L	380.7	29.4	410.1	HORIZONTAL	170.0	240.1	EXISTING	TO REMAIN	
59	POLE	19+82/5038L	370.4	30.9	401.3	HORIZONTAL	170.0	231.3	EXISTING	TO REMAIN	
60	POLE	21+38/5217L	362.9	26.3	389.2	HORIZONTAL	170.0	219.2	EXISTING	TO REMAIN	
61	POLE	22+83/6314L	419.9	70.5	490.4	HORIZONTAL	170.0	320.4	EXISTING	TO REMAIN	
62	POLE	10+99/5940L	405.3	32.3	437.6	HORIZONTAL	170.0	267.6	EXISTING	TO REMAIN	
63	POLE	-11+94/6930L	580.4	23.1	603.5	HORIZONTAL	170.0	433.5	EXISTING	TO REMAIN	
64	POLE	-18+20/10326L	804.4	24.7	829.1	CONICAL	194.0	635.1	EXISTING	TO REMAIN	
65	TANK	26+67/11100L	626.8	15.1	641.9	CONICAL	225.0	416.9	EXISTING	TO REMAIN	
66	POLE	25+60/10092L	539.4	10.8	550.2	CONICAL	174.6	375.6	EXISTING	TO REMAIN	
67	POLE	39+86/7003L	405.2	60.6	465.8	HORIZONTAL	170.0	295.8	EXISTING	TO REMAIN	
68	POLE	41+29/7206L	401.5	51.9	453.4	HORIZONTAL	170.0	283.4	EXISTING	TO REMAIN	
69	TANK	66+07/7928L	222.0	23.0	245.0	HORIZONTAL	170.0	75.0	EXISTING	TO REMAIN	
70	TANK	65+58/7879L	214.9	23.2	238.1	HORIZONTAL	170.0	68.1	EXISTING	TO REMAIN	
71	SIGN	35+60/180L	8.4	4.5	12.9	PRIMARY	11.1	1.8	EXISTING	FRANGIBLE	
72	SIGN	35+79/133R	9.0	4.0	13.0	PRIMARY	11.1	1.9	EXISTING	FRANGIBLE	
73	SIGN	31+45/487R	14.2	4.5	18.7	PRIMARY	11.1	7.6	EXISTING	FRANGIBLE	
74	SIGN	15+60/178L	10.8	4.7	15.5	PRIMARY	13.2	2.3	EXISTING	FRANGIBLE	
75	ANTENNA, GUIDE SLOPE	70+58/324L	11.1	38.2	49.3	TRANSITIONAL	25.1	24.2	EXISTING	TO REMAIN	
76	CELL TOWER	-105+81/3297L	602.5	66.2	668.7	CONICAL	222.7	446.0	EXISTING	TO REMAIN	


⊕ DATA ESTIMATED
^ ELEVATION DIFFERENCE BELOW DATA CONFIDENCE THRESHOLD
NOTE: STATION AND OFFSET BASED ON RUNWAY 5-23

Date Plotted: 15/08/2017, 2:11 PM
Layout Name: Sheet 1
File Name: W:\Projects\Adak\ALP\2015\ALP 2016 Revision\ALP-ADK-PROPERTY MAP.dwg
Designed By:
Drawn By:
Checked By:

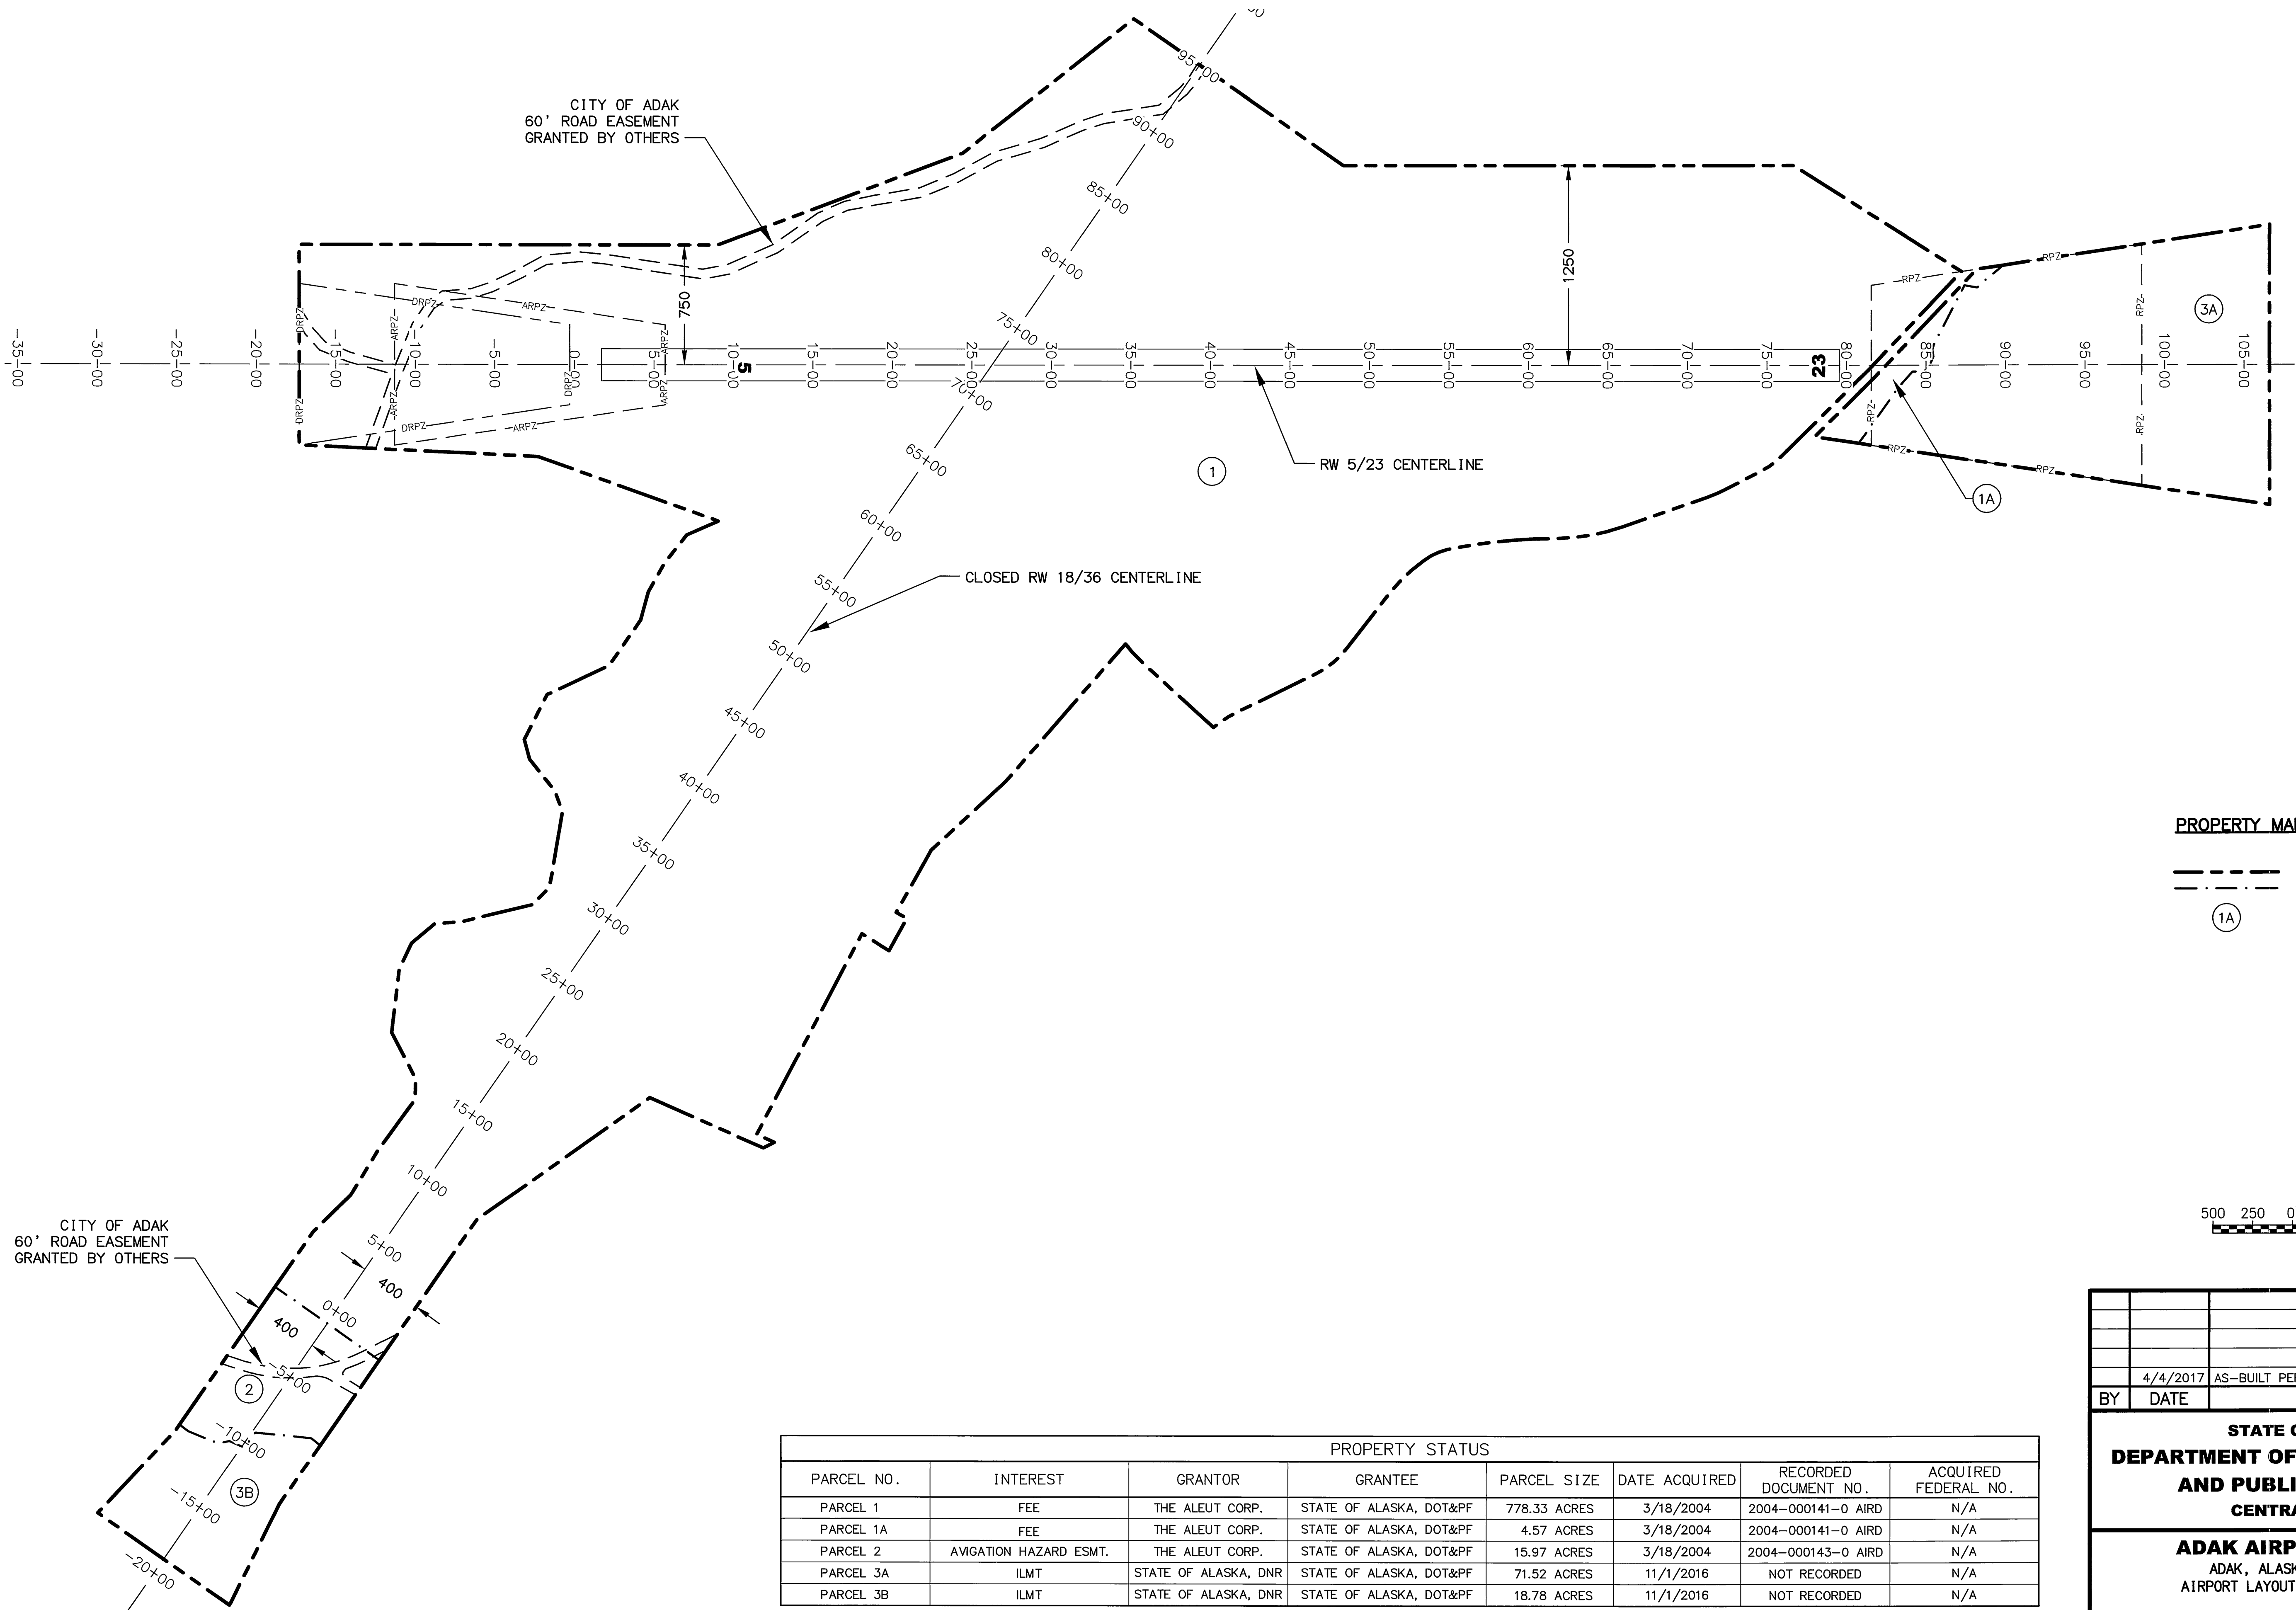

PROPERTY MAP LEGEND

- AIRPORT PROPERTY LINE
- - - PARCEL BOUNDARY
- ①A PARCEL NO.

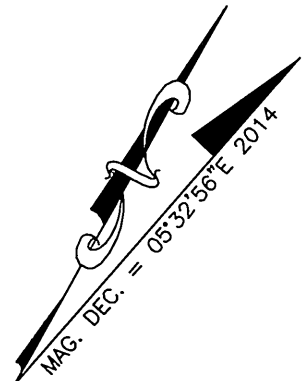

500 250 0' 500 1000

PROPERTY STATUS							
PARCEL NO.	INTEREST	GRANTOR	GRANTEE	PARCEL SIZE	DATE ACQUIRED	RECORDED DOCUMENT NO.	ACQUIRED FEDERAL NO.
PARCEL 1	FEE	THE ALEUT CORP.	STATE OF ALASKA, DOT&PF	778.33 ACRES	3/18/2004	2004-000141-0 AIRD	N/A
PARCEL 1A	FEE	THE ALEUT CORP.	STATE OF ALASKA, DOT&PF	4.57 ACRES	3/18/2004	2004-000141-0 AIRD	N/A
PARCEL 2	AVIGATION HAZARD ESMT.	THE ALEUT CORP.	STATE OF ALASKA, DOT&PF	15.97 ACRES	3/18/2004	2004-000143-0 AIRD	N/A
PARCEL 3A	ILMT	STATE OF ALASKA, DNR	STATE OF ALASKA, DOT&PF	71.52 ACRES	11/1/2016	NOT RECORDED	N/A
PARCEL 3B	ILMT	STATE OF ALASKA, DNR	STATE OF ALASKA, DOT&PF	18.78 ACRES	11/1/2016	NOT RECORDED	N/A

BY	DATE	REVISION
	4/4/2017	AS-BUILT PER PROJECT Z549720000
STATE OF ALASKA		
DEPARTMENT OF TRANSPORTATION		
AND PUBLIC FACILITIES		
CENTRAL REGION		
ADAK AIRPORT		DATE:
ADAK, ALASKA		AUGUST 2015
AIRPORT LAYOUT PLAN		SHEET:
PROPERTY MAP		24
		OF
		24