

EQUIPMENT REQUIREMENTS FOR APPROVED EQUALS (APPLIES TO ALL SCHEDULES):
 SPECIFIC PARTS MANUFACTURER AND MODEL SELECTED NOT ONLY TO MEET PERFORMANCE FUNCTION BUT ALSO TO COORDINATE AND INTERFACE WITH OTHER DEVICES AND SYSTEMS. APPROVED EQUAL SUBSTITUTIONS WILL BE ALLOWED ONLY BY ENGINEER'S APPROVAL. TO OBTAIN APPROVAL, SUBMITTALS MUST CLEARLY DEMONSTRATE HOW SUBSTITUTE ITEM MEETS OR EXCEEDS SPECIFIED ITEM QUALITY AND PERFORMANCE CHARACTERISTICS AND ALSO COMPLIES WITH MECHANICAL AND/OR ELECTRICAL CONNECTIONS AND PHYSICAL LAYOUT REQUIREMENTS.

ELECTRICAL EQUIPMENT SCHEDULE

SYMBOL	SERVICE/FUNCTION	DESCRIPTION	MANUFACTURER/MODEL
1	DAY TANK ALARM HORN/STROBE	MULTI-TONE ALARM WITH STROBE, 115V, NEMA 3R, WEATHER RESISTANT SURFACE MOUNT BELL BOX	WHEELLOCK MT4-115-WH-VNS
2	DIGITAL THERMOSTAT	MULTIPLE OUTPUT MODULATING DIGITAL THERMOSTAT	HONEYWELL TB7980B
3	LINE VOLTAGE THERMOSTAT	HEATING/COOLING THERMOSTAT, 16 FLA @ 120V, SPDT, 50F TO 80F RANGE.	DAYTON 1UHH2
4	EXTERIOR LIGHT	AREA LIGHT, WIDE DISPERSION WALL PACK WITH PHOTO CONTROL. LED, 17.7W, 120-277V DRIVER	HUBBELL NRG-356L-5K-U-PC
5	EMERGENCY LIGHT	WHITE PLASTIC ENCLOSURE, 120-347V INPUT, DUAL 5.3W LED LAMPS, LITHIUM IRON PHOSPHATE BATTERY	LITHONIA EML6L UVOLT LTP SRDT
6	EMERGENCY/EXIT LIGHT COMBO	WHITE PLASTIC ENCLOSURE, RED EXIT SIGN, 277/120V INPUT, DUAL 1.5W 9.6V LED LAMPS. OPTIONAL HIGH OUTPUT NI-CAD BATTERY	LITHONIA LHQM LED R HO
7	EMERGENCY EXIT REMOTE LIGHT	REMOTE LAMP FIXTURE, DUAL HEAD, RATED FOR EXTERIOR INSTALLATION IN DAMP/WET LOCATIONS, 1.5W 9.6V LED LAMPS.	LITHONIA ELA T QWP L0309
8	INTERIOR LIGHT	SURFACE MOUNTED LED STRIPLIGHT FIXTURE, 48" LONG, 34W, 5000K WITH SNAP ON FROSTED DIFFUSER	LITHONIA L1N-L48-5000LM-FST
9	TIMER SWITCH	0-5 MINUTE, 120V, 20A, 1HP RATED, INSTALL IN 4"x4" PRESSED STEEL BOX WITH METAL COVER.	INTERMATIC FF5M
10	LIGHT SWITCH	SINGLE POLE SNAP SWITCH, 120V, 20A, METAL, 1-1/2HP RATED, INSTALL IN 4"x4" STEEL BOX WITH METAL COVER, IVORY.	HUBBELL 1221-I
11	SMALL MOTOR DISCONNECT	SINGLE POLE SNAP SWITCH WITH RED PILOT LIGHT, 120V, 20A, 1HP RATED, INSTALL IN 4"x4" STEEL BOX WITH METAL COVER	HUBBELL 1221-PL
12	NOT USED	NOT USED	
13	STATION SERVICE TRANSFORMER	DRY TYPE, ENERGY STAR, ENCLOSURE TYPE 1 WITH INTEGRAL WALL MOUNT BRACKETS, 15 KVA, HV 480 DELTA, LV 208Y/120	HAMMOND HPS SENTINEL CAT. NO. SG3A0015KB
14	STATION SERVICE PANELBOARD	COPPER BUS, 3 PHASE, 4 WIRE, 120/208V, 125A MAIN BREAKER, 30 CIRCUITS, BOLT-IN BREAKERS, 20" WIDE NEMA 1 ENCLOSURE, SURFACE MOUNT, NO KNOCKOUTS	SIEMENS TYPE P1 OR SQUARE D TYPE NQ
15	STANDARD RECEPTACLE	SURFACE MOUNT 125V NEMA 5-20R RECEPTACLE. INSTALL IN 4"x4" STEEL BOX WITH METAL COVER	PASS & SEYMOUR 5362W
16	EXTERIOR GFCI RECEPTACLE	125V NEMA 5-20R GFCI RECEPTACLE. MOUNT IN CAST FDA BOX WITH WEATHERPROOF COVER	PASS & SEYMOUR 2095-W
17	BATTERY CHARGER	12/24-VOLT SOLID STATE 20-AMP AUTO-EQUALIZING BATTERY CHARGER FOR 120 VAC INPUT, WITH OPTIONAL HIGH/LOW VOLTAGE, AC POWER FAILURE, & REMOTE SUMMARY ALARM RELAYS	SENS NRG22-20-RCLS OR LEMARCHE ECSR-40/20-12/24V-AV1
18	WELDER/COMPR. RECEPTACLE	NEMA 6-30R, BLACK, 250V, 30A, 2 POLE, WITH GROUND. INSTALL IN DEEP 4"x4" STEEL BOX WITH 2.15"Ø HOLE METAL COVER	PASS & SEYMOUR 3801
19	NOT USED	NOT USED	
20	RADIATOR/CAC MOTOR DISCONNECT	NON-FUSED LOCKABLE SAFETY SWITCH, NEMA 3R ENCLOSURE, 3PST, 600V, 30A, MIN 5HP RATED	SIEMENS HNF361R OR SQUARE D HU361R
21	24VAC CONTROL TRANSFORMER	120V PRIMARY, 24V SECONDARY, 20VA OUTPUT, 1/2" THREADED HUB MOUNT	FUNCTIONAL DEVICES TR20VA001
22	ENCLOSED POWER RELAY (RIB)	20A, 1HP RATED CONTACT, SPDT, 24VAC COIL, NEMA 1 ENCLOSURE, RED LED PILOT LIGHT	FUNCTIONAL DEVICES RIB2401B
23	SNAP SWITCH WITH THERMAL UNIT	600VAC, 1HP, 16A MANUAL MOTOR STARTER WITH TYPE S, TYPE A, MELTING ALLOY, CLASS 20 THERMAL UNIT	SQUARE D 2510F01 MOTOR STARTER WITH A14.8 THERMAL UNIT
24	ROUTER - HIGH SPEED INTERNET	4-PORT GIGABIT ROUTER, DUAL 2.4 AND 5 GHz WIFI WITH ADJUSTABLE ANTENNAS, 4 GIGABIT LAN, 1 GIGABIT WAN, USB 2.0 AND USB 4.0, MINIMUM 256 MB RAM	ASUS RT-ACI-900P
25	FOC-1 ENCLOSED CONTACTOR	NEMA 1 ENCLOSURE WITH IEC STYLE CONTACTOR, 5.4-27A ADJUSTABLE RANGE SOLID STATE OVERLOAD, HAND-OFF-AUTO CONTROL, 16A, 208V 3-PHASE.	ALLEN-BRADLEY 109-C16AD-OLR ENCLOSED CONTACTOR, 193-EEEB OVERLOAD, 198-3SS HOA, & 193-ERA OVERLOAD RESET
26	FOC-1 TEMP CONTROLLER	NEMA 1 120/240 VAC PROGRAMMABLE TEMPERATURE CONTROLLER WITH PTC TEMPERATURE SENSOR AND 2m LONG JACKETED CABLE	PENN A421ABC-02C

ELECTRICAL CONDUCTOR SCHEDULE

SERVICE/FUNCTION	DESCRIPTION	MANUFACTURER/MODEL	NOTES:
GENERATOR LEADS (ENGINE STARTER CABLES SIMILAR)	HIGH TEMPERATURE, EXTRA FLEXIBLE CABLE, TIN COATED COPPER CONDUCTOR. THERMOSET EPDM INSULATION, UL 3340/3374, MINIMUM 600V, LISTED 150°C FOR NON-FLEXING	COBRA CABLE, BELDEN, OR OMNI	TERMINATE WITH COPPER COMPRESSION LUGS RATED FOR THE FULL AMPACITY OF THE CABLE AT 150°C.
GENERAL USE CONDUCTORS	CLASS B CONCENTRIC STRANDED, SOFT DRAWN COPPER. TYPE XHHW2 INSULATION, 600V AND 90C RATED.		
SHIELDED/TWISTED INSTRUMENT & CONTROL & CANBUS CONDUCTORS	#18 AWG STRANDED TINNED COPPER CONDUCTORS, 600V POLYETHYLENE INSULATION, 100% COVERAGE ALUMINUM FOIL-POLYESTER TAPE SHIELD WITH STRANDED TINNED COPPER DRAIN WIRE & PVC OUTER JACKET	BELDEN PART #'S SINGLE PAIR: #1120A FOUR PAIR: #1049A SINGLE TRIAD: #1121A	GROUND SHIELD DRAIN WIRE AT PANEL END ONLY.
EHTERNET (CAT5e) COMMUNICATION CONDUCTORS	SOLID BARE COPPER CONDUCTORS, 300V FEP INSULATION & JACKET, 100% COVERAGE ALUMINUM FOIL-POLYESTER TAPE SHIELD WITH STRANDED TINNED COPPER DRAIN WIRE	FOUR PAIR #24 BELDEN 1585LC	GROUND SHIELD DRAIN WIRE AT PANEL END ONLY. ROUTE ALL DEVICENET & CAT5e CABLES IN SEPARATE DEDICATED RACEWAY.

UNLESS INDICATED OTHERWISE ALL CONDUCTORS SHALL USE THE FOLLOWING COLOR CODE:

480-VOLT POWER (PHASE) CONDUCTORS
 PHASE A: BROWN
 PHASE B: ORANGE
 PHASE C: YELLOW

120/208-VOLT POWER (PHASE) CONDUCTORS
 PHASE A: BLACK
 PHASE B: RED
 PHASE C: BLUE

NEUTRAL: WHITE, NO EXCEPTIONS
 GROUND: GREEN OR BARE, NO EXCEPTIONS

24 VOLT DC CONDUCTORS
 +24VDC: RED or RED W/GRAY STRIPE
 -24VDC: BLACK or BLACK W/GRAY STRIPE

CONTROL AND INSTRUMENT CONDUCTORS MAY BE COLOR CODED PER MANUFACTURER'S STANDARD

NOTES:
 1) COLOR CODING FOR NO. 6 AWG AND SMALLER CONDUCTORS SHALL BE BY USING CONDUCTORS WITH CONTINUOUS COLOR EMBEDDED IN THE INSULATION.
 2) COLOR CODING FOR CONDUCTORS LARGER THAN NO. 6, SHALL BE BY:
 A) CONTINUOUS COLOR EMBEDDED IN THE INSULATION, OR
 B) BLACK CABLE WITH SCOTCH 35 OR APPROVED EQUAL MARKING (PHASE) TAPE. AT EVERY ACCESSIBLE LOCATION A MINIMUM 3" LONG SECTION OF CONDUCTOR SHALL BE SPIRAL WRAPPED. NOTE THAT PHASE TAPE MAY NOT BE USED ON COLORED CABLE, BLACK CABLE ONLY.
 3) GROUNDING - PROVIDE A SEPARATE GREEN INSULATED EQUIPMENT GROUNDING CONDUCTOR IN EACH RACEWAY. DO NOT USE THE CONDUIT AS AN EQUIPMENT GROUNDING CONDUCTOR. EQUIPMENT GROUNDING CONDUCTORS SHALL BE OF THE SAME TYPE AS THE PHASE CONDUCTORS AND SHALL BE SIZED AS INDICATED ON THE DRAWINGS. CONDUCTORS NOT INDICATED SHALL BE SIZED IN ACCORDANCE WITH THE NATIONAL ELECTRICAL CODE.

WIRING & DEVICE SYMBOL LEGEND

SYMBOL	DESCRIPTION	SYMBOL	DESCRIPTION
SS-##	HOME RUN TO PANEL & BREAKER(S) INDICATED. SHORT DASH INDICATES HOT CONDUCTOR, LONG DASH INDICATES NEUTRAL CONDUCTOR, CURVED DASH INDICATES GROUND CONDUCTOR. IF NOT SPECIFICALLY INDICATED, PROVIDE 2#12 AWG & 1#12 AWG GROUND.	⊖	125V, 20A, DUPLEX RECEPTACLE
⊖		⊖	LINE VOLTAGE THERMOSTAT
⊖		⊖	DIGITAL THERMOSTAT, MODULATING
⊖		⊖	ELECTRICAL ITEM - SEE EQUIPMENT SCHEDULE
⊖		⊖	SNAP SWITCH / SMALL MOTOR DISCONNECT
⊖		⊖	MOTOR (HORESPOWER INDICATED)
⊖		⊖	TIMER SWITCH
⊖		⊖	MOTORIZED DAMPER - SEE MECHANICAL
⊖		⊖	GROUND

INSTRUMENTATION & ENERGY MEASUREMENT LEGEND


NOTE: SEE SCHEDULES SHEET M1.1 FOR EQUIPMENT SPECIFICATIONS.


SYMBOL	SERVICE/FUNCTION	SYMBOL	SERVICE/FUNCTION
⊖	TEMPERATURE TRANSMITTER	⊖	DAY TANK/HOPPER FLOAT SWITCH
⊖	PRESSURE TRANSMITTER	⊖	GLYCOL TANK LEVEL SENSOR PROBE
⊖	HEAT RECOVERY FLOW METER	⊖	TANK LEVEL MONITOR PANEL
⊖	GLYCOL TANK LOW COOLANT ALARM	⊖	TANK LEVEL SENSOR PROBE

ALL MATERIALS AND EQUIPMENT ON SCHEDULES THIS SHEET WERE FURNISHED AS PART OF THE PRIOR MODULE ASSEMBLY PROJECT EXCEPT FOR THOSE ITEMS SPECIFICALLY INDICATED IN RED CLOUDS WHICH ARE TO BE FURNISHED AND INSTALLED AS PART OF THE ON SITE SCOPE.

REV #1 ISSUED FOR ON SITE CONSTRUCTION DECEMBER 2022



1	REVISED TO COORDINATE WITH FINAL ON-SITE DESIGN	12/15/22	BCG
REV.	DESCRIPTION	DATE	BY
 ALASKA ENERGY AUTHORITY			
PROJECT: NAPASKIAK POWER SYSTEM UPGRADE			
TITLE: ELECTRICAL LEGENDS & SCHEDULES			
DRAWN BY: JTD		SCALE: AS NOTED	
DESIGNED BY: CWV/BCG		DATE: 7/29/22	
FILE NAME: NAPS E1		SHEET: E1.1	
PROJECT NUMBER:			
P.O. 111405, Anchorage, AK 99511 (907)349-0100			

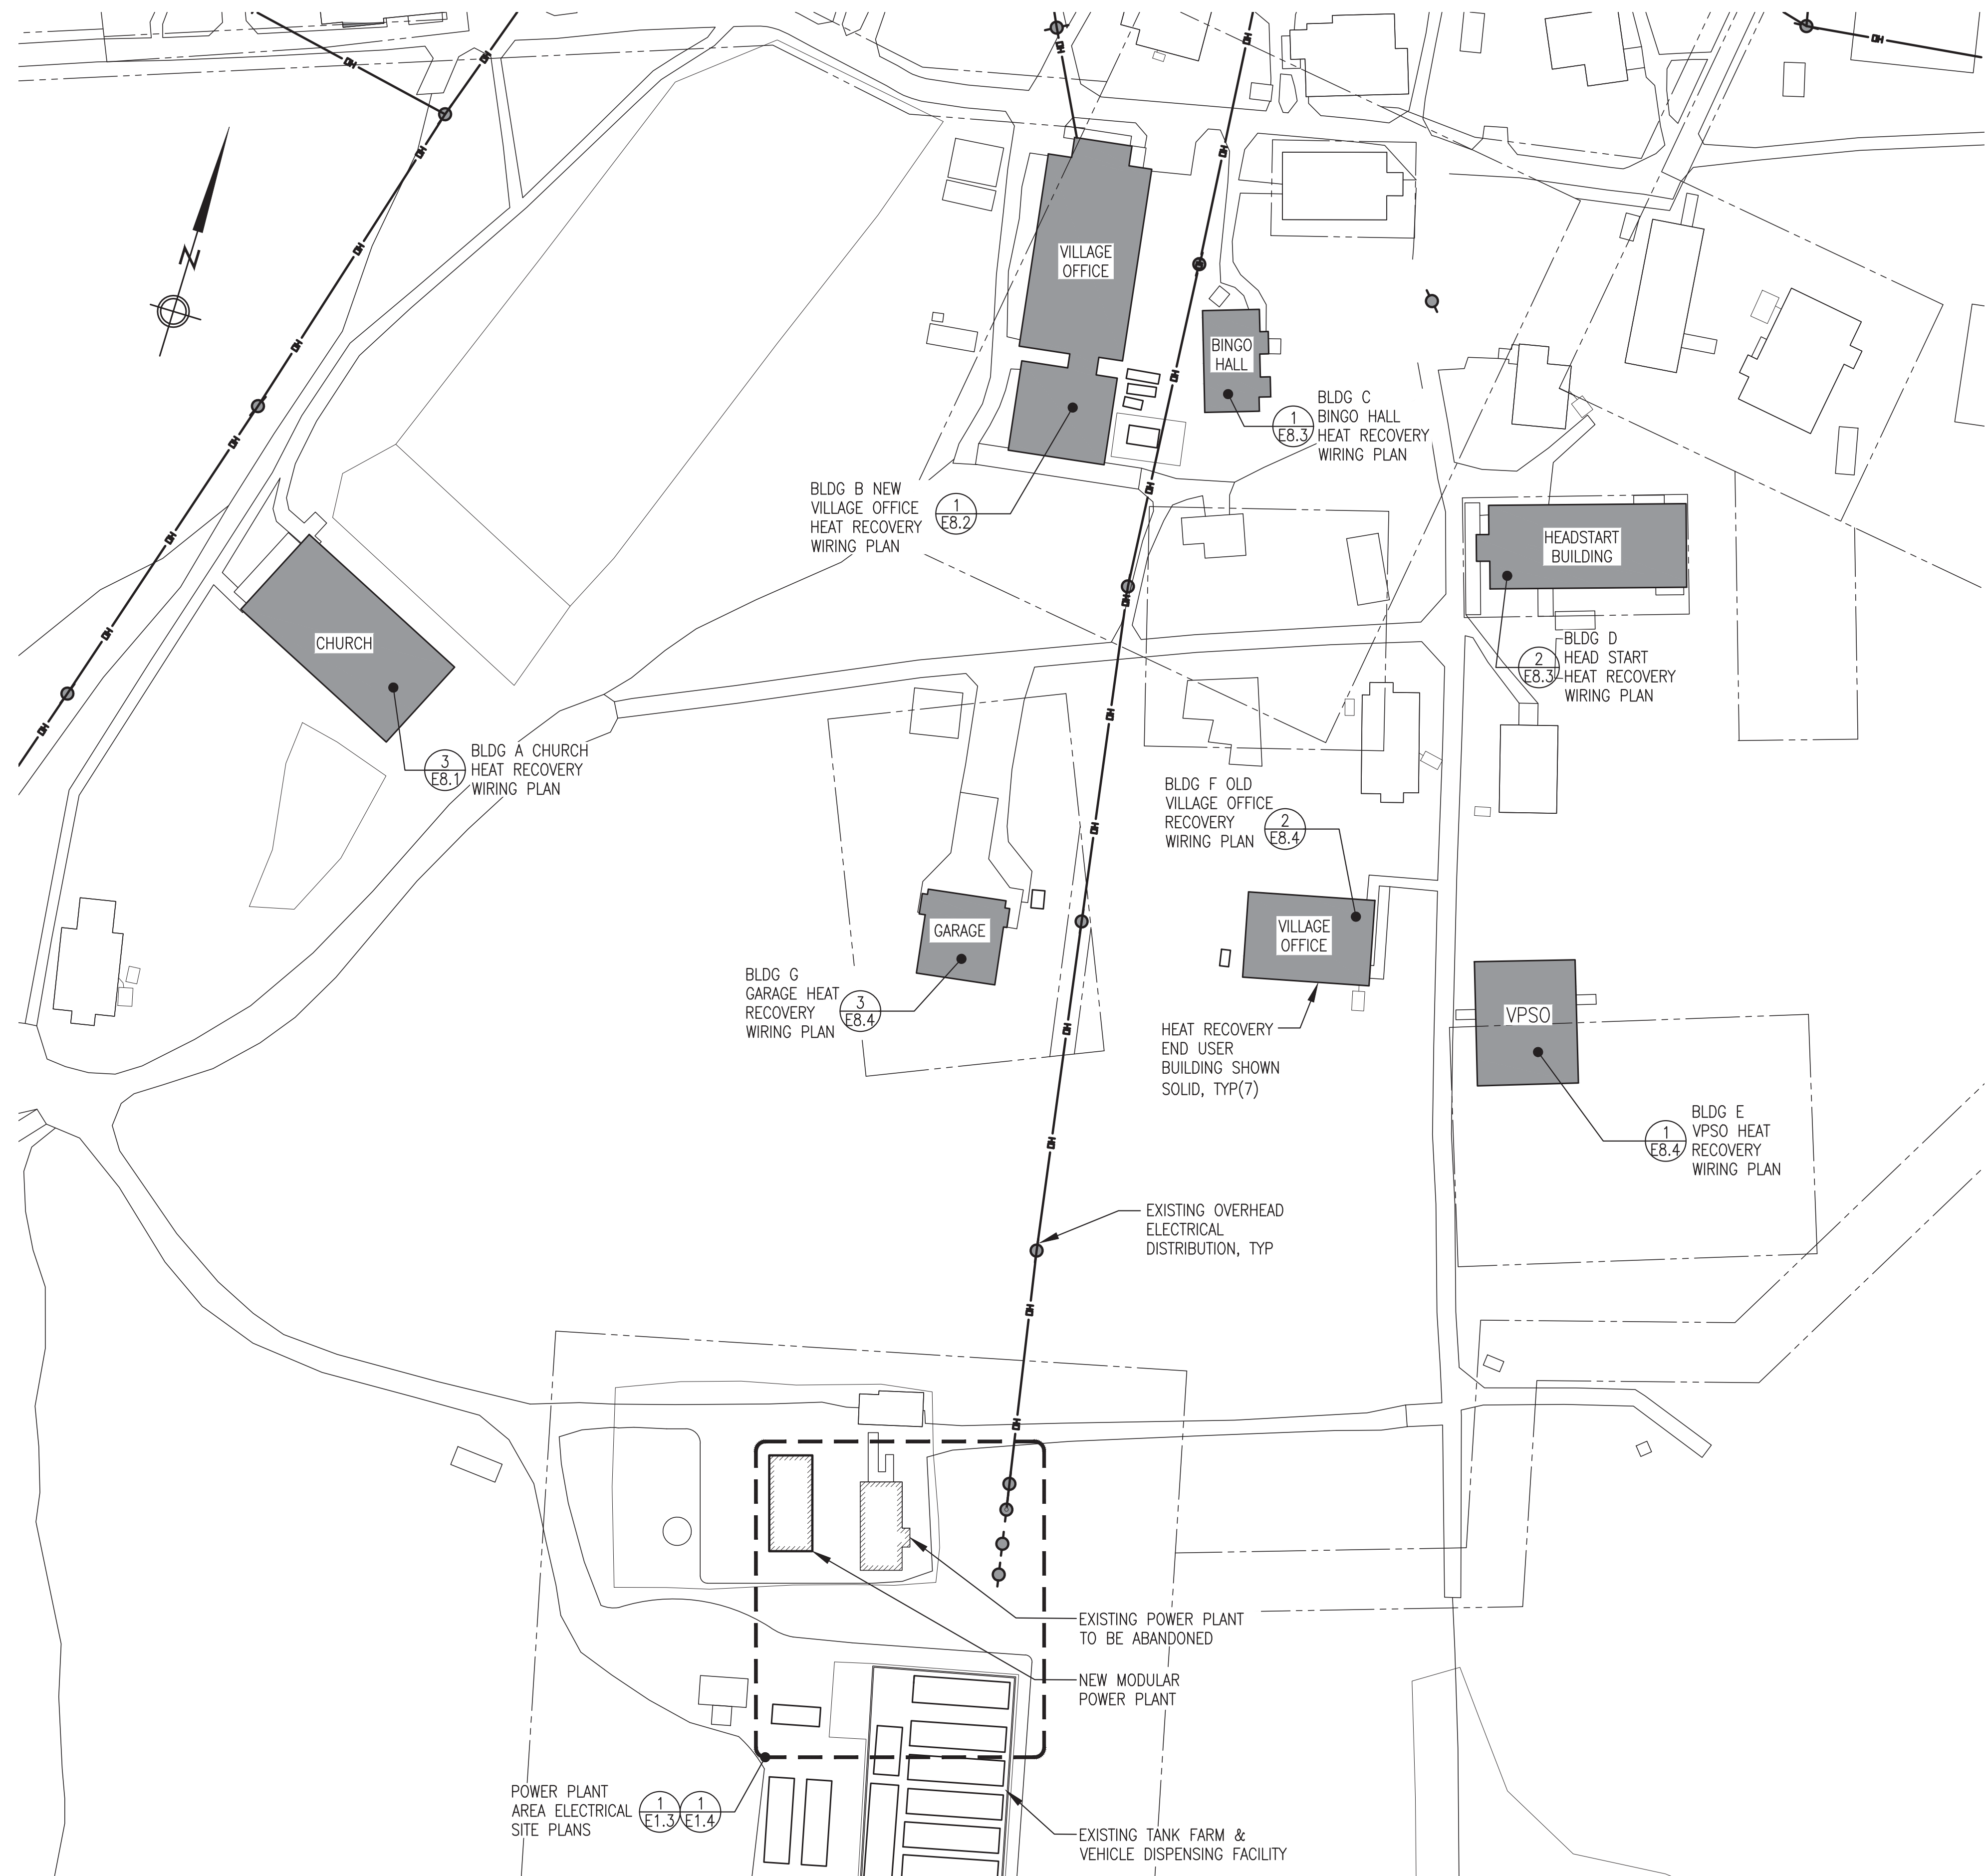




ALL WORK ON THIS SHEET IS INCLUDED IN THE ON SITE CONTRACT

1 OVERALL POWER PLANT & HEAT RECOVERY VICINITY PLAN
E1.2 1"=40'

ISSUED FOR CONSTRUCTION
DECEMBER 2022




 ALASKA ENERGY AUTHORITY		
PROJECT: NAPASKIAK POWER SYSTEM UPGRADE		
TITLE: OVERALL POWER PLANT & HEAT RECOVERY VICINITY PLAN		
 Gray Stassel Engineering, Inc. P.O. 111405, Anchorage, AK 99511 (907)349-0100	DRAWN BY: JTD DESIGNED BY: CWV/BCG FILE NAME: NAPS PP E1 PROJECT NUMBER:	SCALE: AS NOTED DATE: 12/15/22 SHEET: E1.2

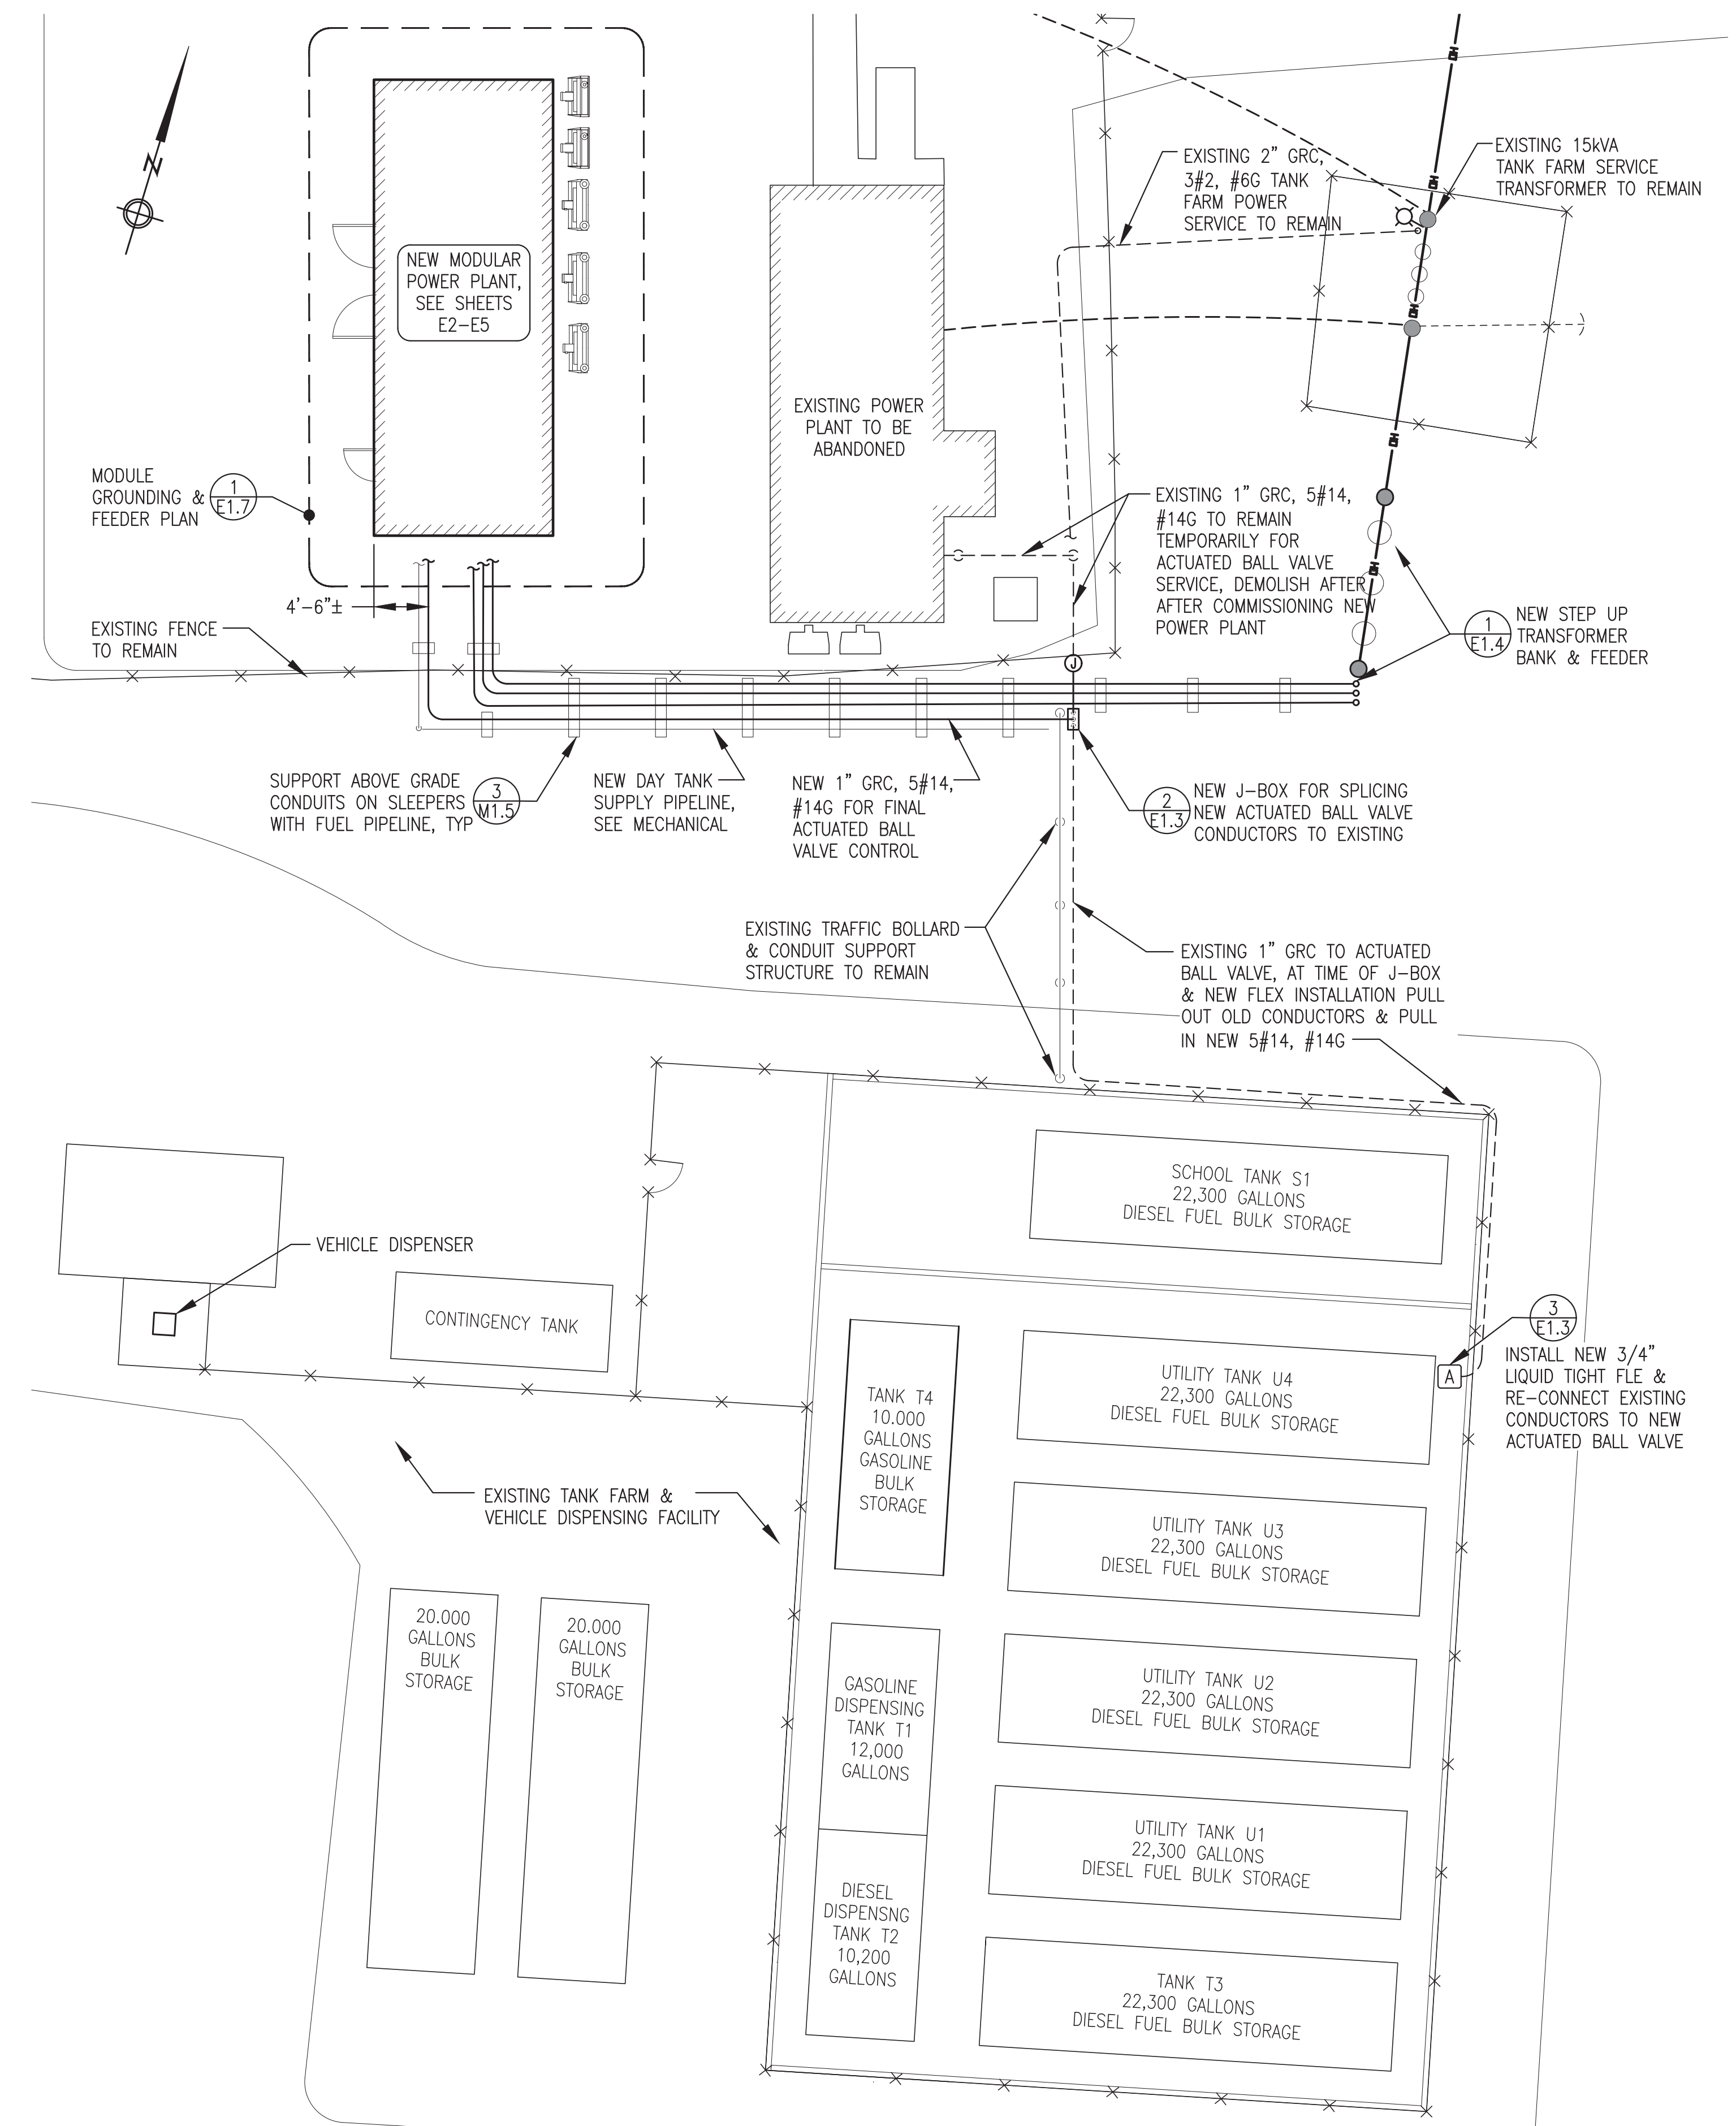

NOTES:


1. NEW CONDUIT & DEVICES SHOWN WITH DARK, SOLID LINES. EXISTING CONDUIT & DEVICES SHOWN WITH LIGHT, DASHED LINES.
2. CUT 1 - CUT EXISTING 1" CONDUIT & CONDUCTORS NEAR A JOINT AT A LOCATION THAT ALLOWS CONDUCTORS FROM OLD POWER PLANT TO REACH INTO J-BOX. INSTALL NEW THREADED COUPLING FOR NEW CONDUIT TO J-BOX.
3. CUT 2 - TEMPORARILY PULL CONDUCTORS BACK TOWARD OLD POWER PLANT PRIOR TO CUTTING CONDUIT. INSTALL NEW COMPRESSION COUPLING FOR NEW CONDUIT TO J-BOX. PULL EXISTING CONDUCTORS FROM OLD POWER PLANT INTO J-BOX.
4. REMOVE FLEX AT ACTUATED VALVE (SEE DETAIL 3) & PULL NEW 5/14, #14G FROM J-BOX TO ACTUATED VALVE. PERMANENTLY CONNECT TO TO ACTUATED VALVE. TEMPORARILY CONNECT NEW CONDUCTORS TO EXISTING CONDUCTORS FROM OLD POWER PLANT WITH WIRE NUTS TO ALLOW ACTUATOR VALVE OPERATION FROM OLD POWER PLANT.
5. PULL NEW 5#14, #14G FROM NEW POWER PLANT & TEMPORARILY COIL IN J-BOX FOR FUTURE PERMANENT CONNECTION.
6. WHEN NEW PLANT IS COMMISSIONED, DISCONNECT CONDUCTORS FROM OLD POWER PLANT. SOLDER SPLICE & HEAT SHRINK CONDUCTORS FROM NEW POWER PLANT TO CONDUCTORS FROM ACTUATED VALVE TO ALLOW ACTUATOR VALVE OPERATION FROM NEW POWER PLANT DAY TANK CONTROL PANEL.
7. REMOVE CONDUIT & CONDUCTORS FROM OLD POWER PLANT AND SEAL UNUSED CONDUIT ENTRANCE IN J-BOX.

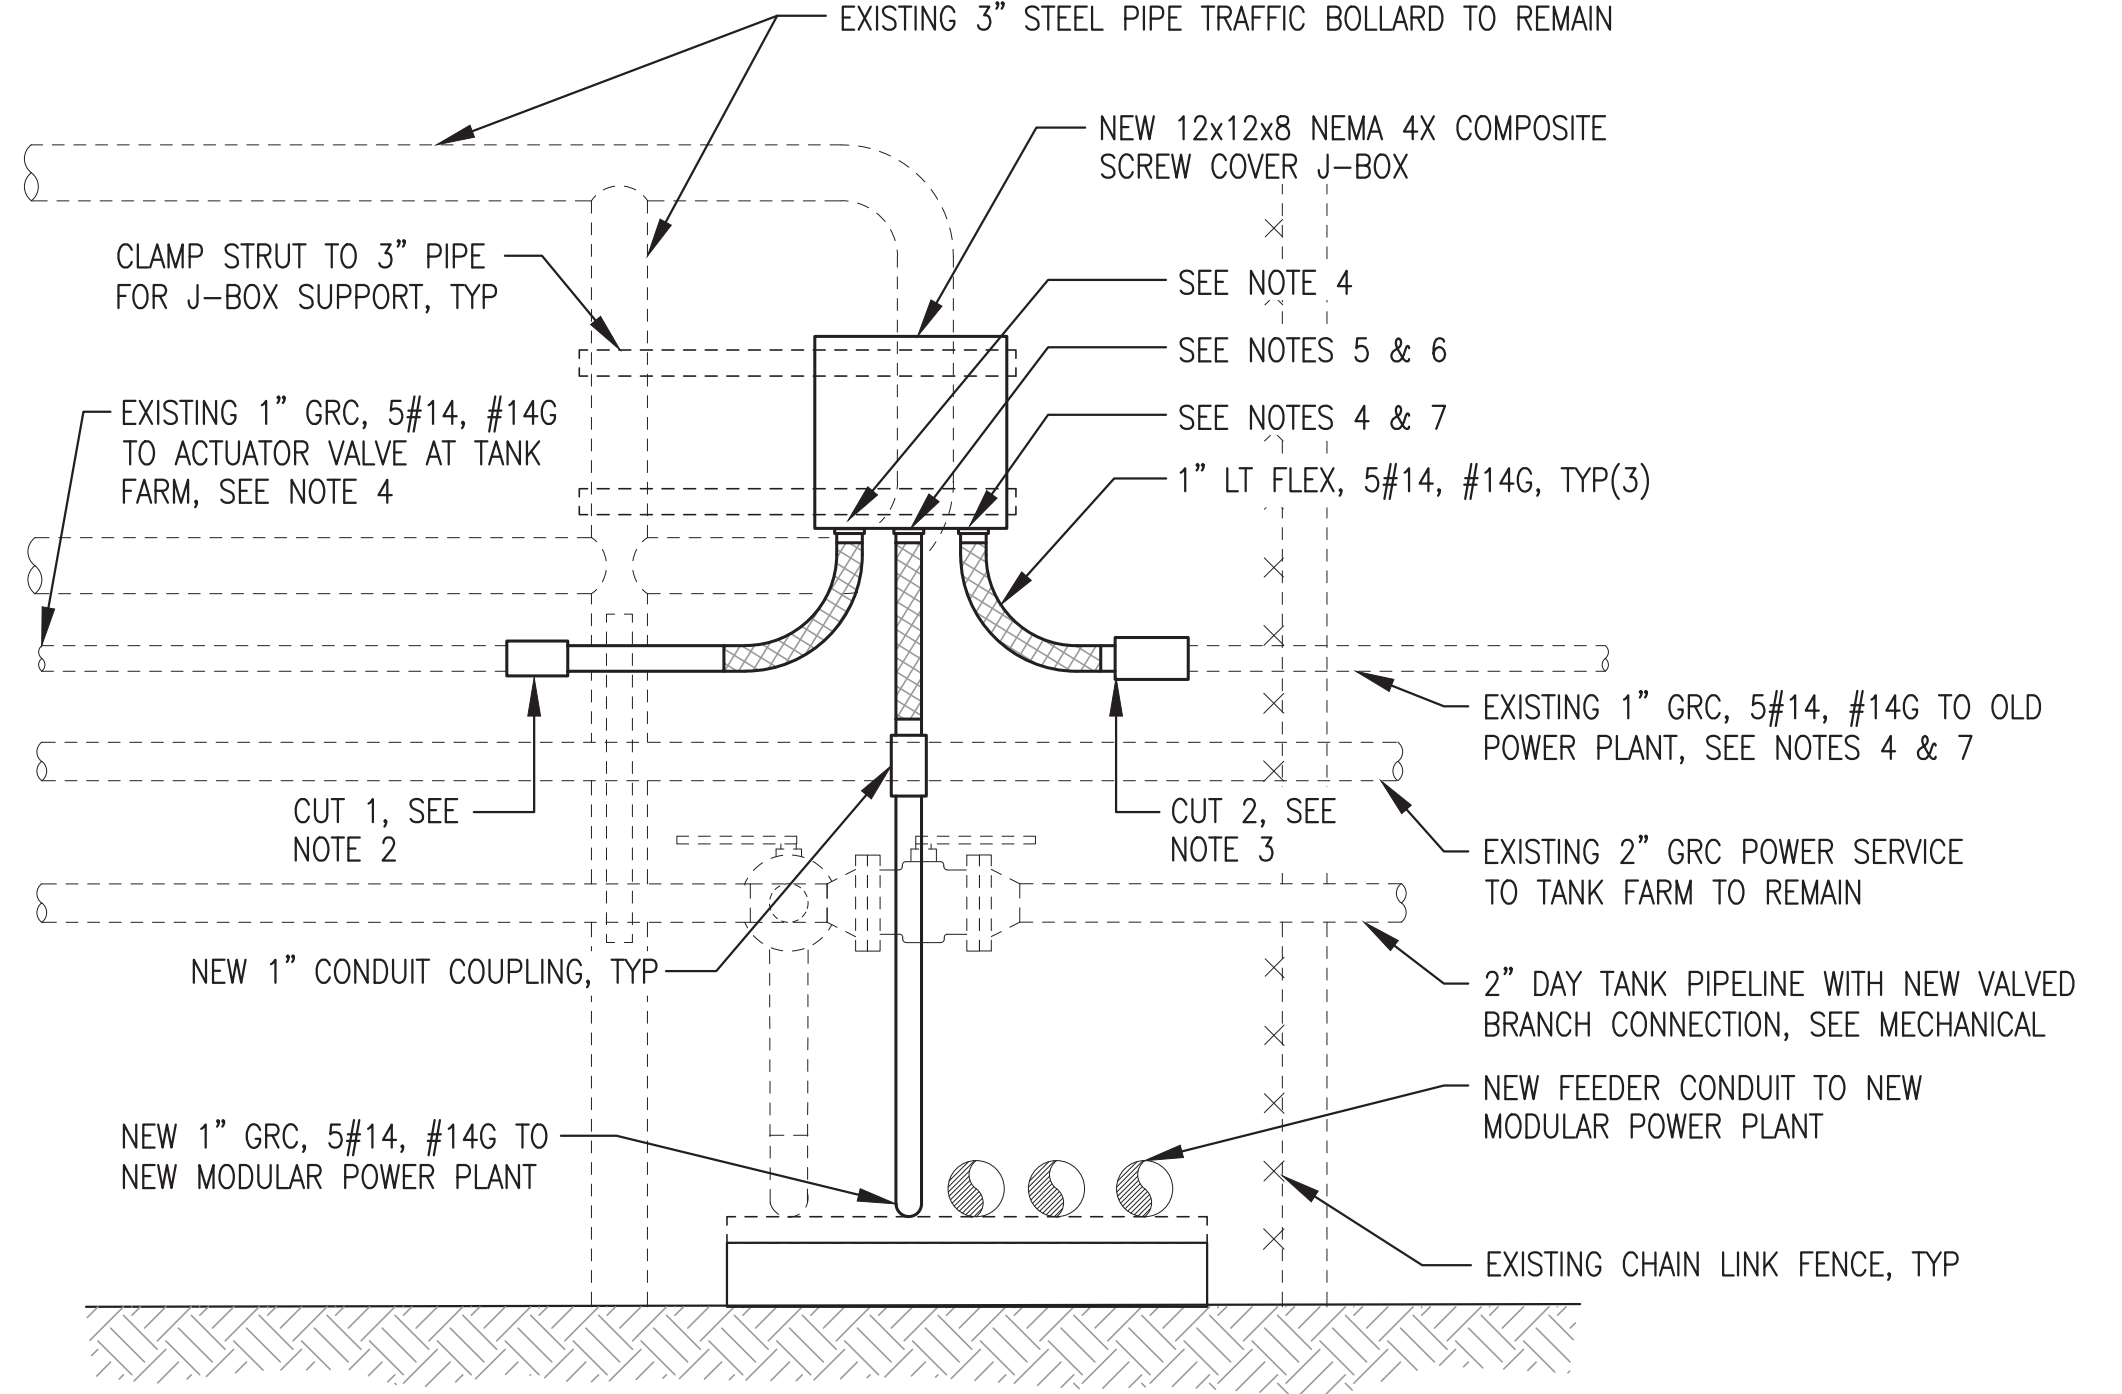

2 ACTUATED BALL VALVE CONDUCTOR SPLICE BOX INSTALLATION - ELEVATION VIEW
E1.3 NO SCALE

NOTES:

- 1) DURING CONSTRUCTION THE EXISTING CONDUCTORS FROM THE OLD POWER PLANT IN THE SPLICE BOX WILL ALLOW THE NEW ACTUATED BALL VALVE TO BE CONTROLLED FROM THE OLD POWER PLANT DAY TANK CONTROL PANEL.
- 2) WHEN THE NEW MODULAR POWER PLANT IS COMMISSIONED, THE NEW CONDUCTORS FROM THE NEW POWER PLANT WILL ALLOW THE NEW ACTUATED BALL VALVE TO BE CONTROLLED FROM THE NEW POWER PLANT DAY TANK CONTROL PANEL. SEE DETAIL 2/E1.3.

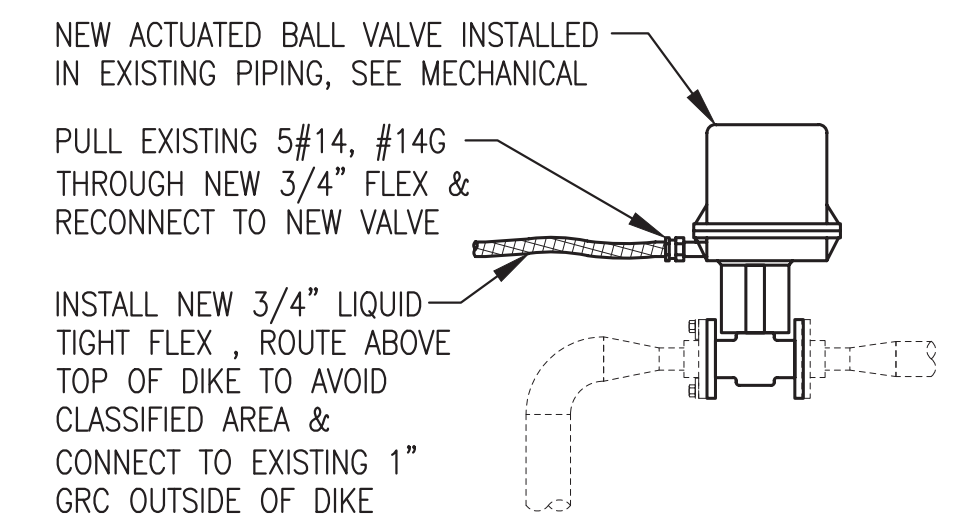

3 ACTUATOR VALVE CONNECTION
E1.3 NO SCALE


ALL WORK ON THIS SHEET IS INCLUDED IN THE ON SITE CONTRACT

1 POWER PLANT ELECTRICAL SITE PLAN & DETAILS
E1.3 1"=10'

ISSUED FOR CONSTRUCTION
DECEMBER 2022




<p>ALASKA ENERGY AUTHORITY</p>		
PROJECT: NAPASKIAK POWER SYSTEM UPGRADE		
TITLE: POWER PLANT ELECTRICAL SITE PLAN & DETAILS		
<p>Gray Stassel Engineering, Inc.</p>	DRAWN BY: JTD DESIGNED BY: CWV/BCG FILE NAME: NAPS PP E1 PROJECT NUMBER:	SCALE: AS NOTED DATE: 12/15/22 SHEET: E1.3
P.O. 111405, Anchorage, AK 99511 (907)349-0100		

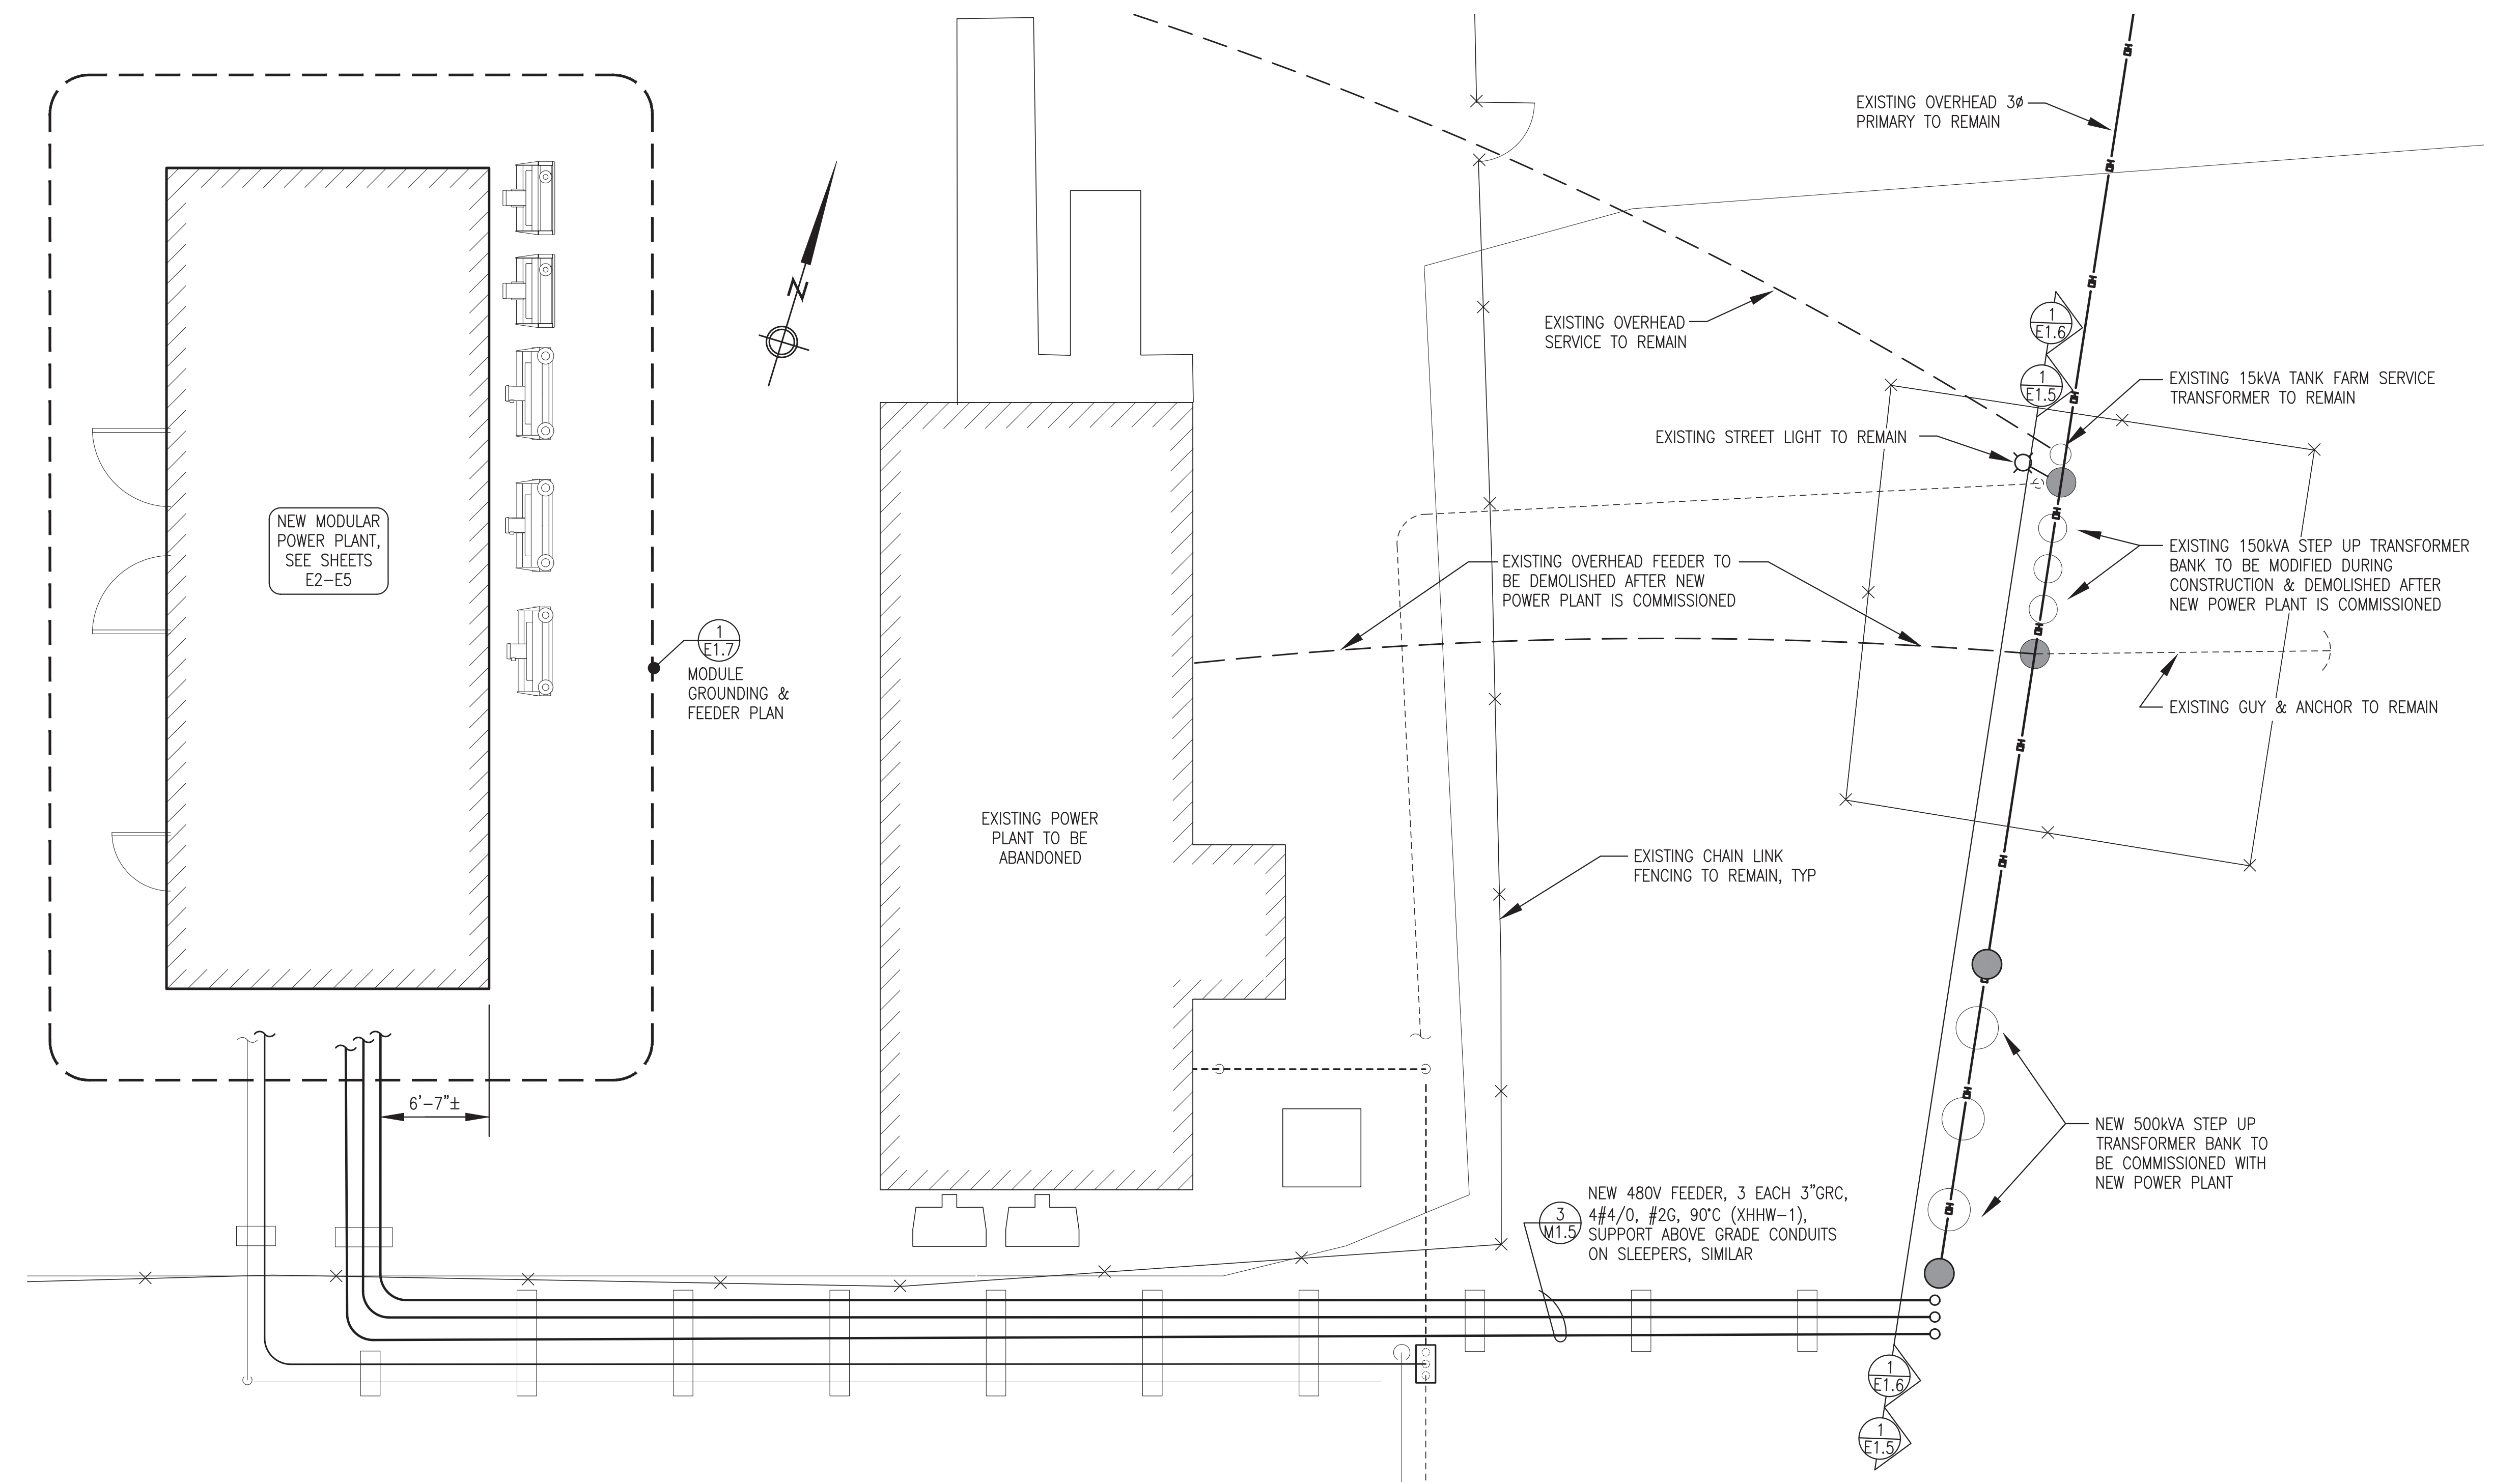




1 POWER PLANT FEEDER & STEP UP TRANSFORMER PLAN
E1.4 1"=6'

ALL WORK ON THIS SHEET IS INCLUDED IN THE ON SITE CONTRACT

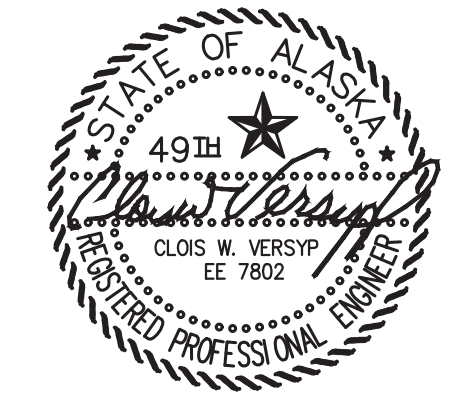ISSUED FOR
CONSTRUCTION
DECEMBER 2022



 ALASKA ENERGY AUTHORITY		
PROJECT: NAPASKIAK POWER SYSTEM UPGRADE		
TITLE: POWER PLANT FEEDER & STEP UP TRANSFORMER PLAN		
 Gray Stassel Engineering, Inc. P.O. 111405, Anchorage, AK 99511 (907)349-0100	DRAWN BY: JTD DESIGNED BY: CWV/BCG FILE NAME: NAPS PP E1 PROJECT NUMBER:	SCALE: AS NOTED DATE: 12/15/22 SHEET: E1.4

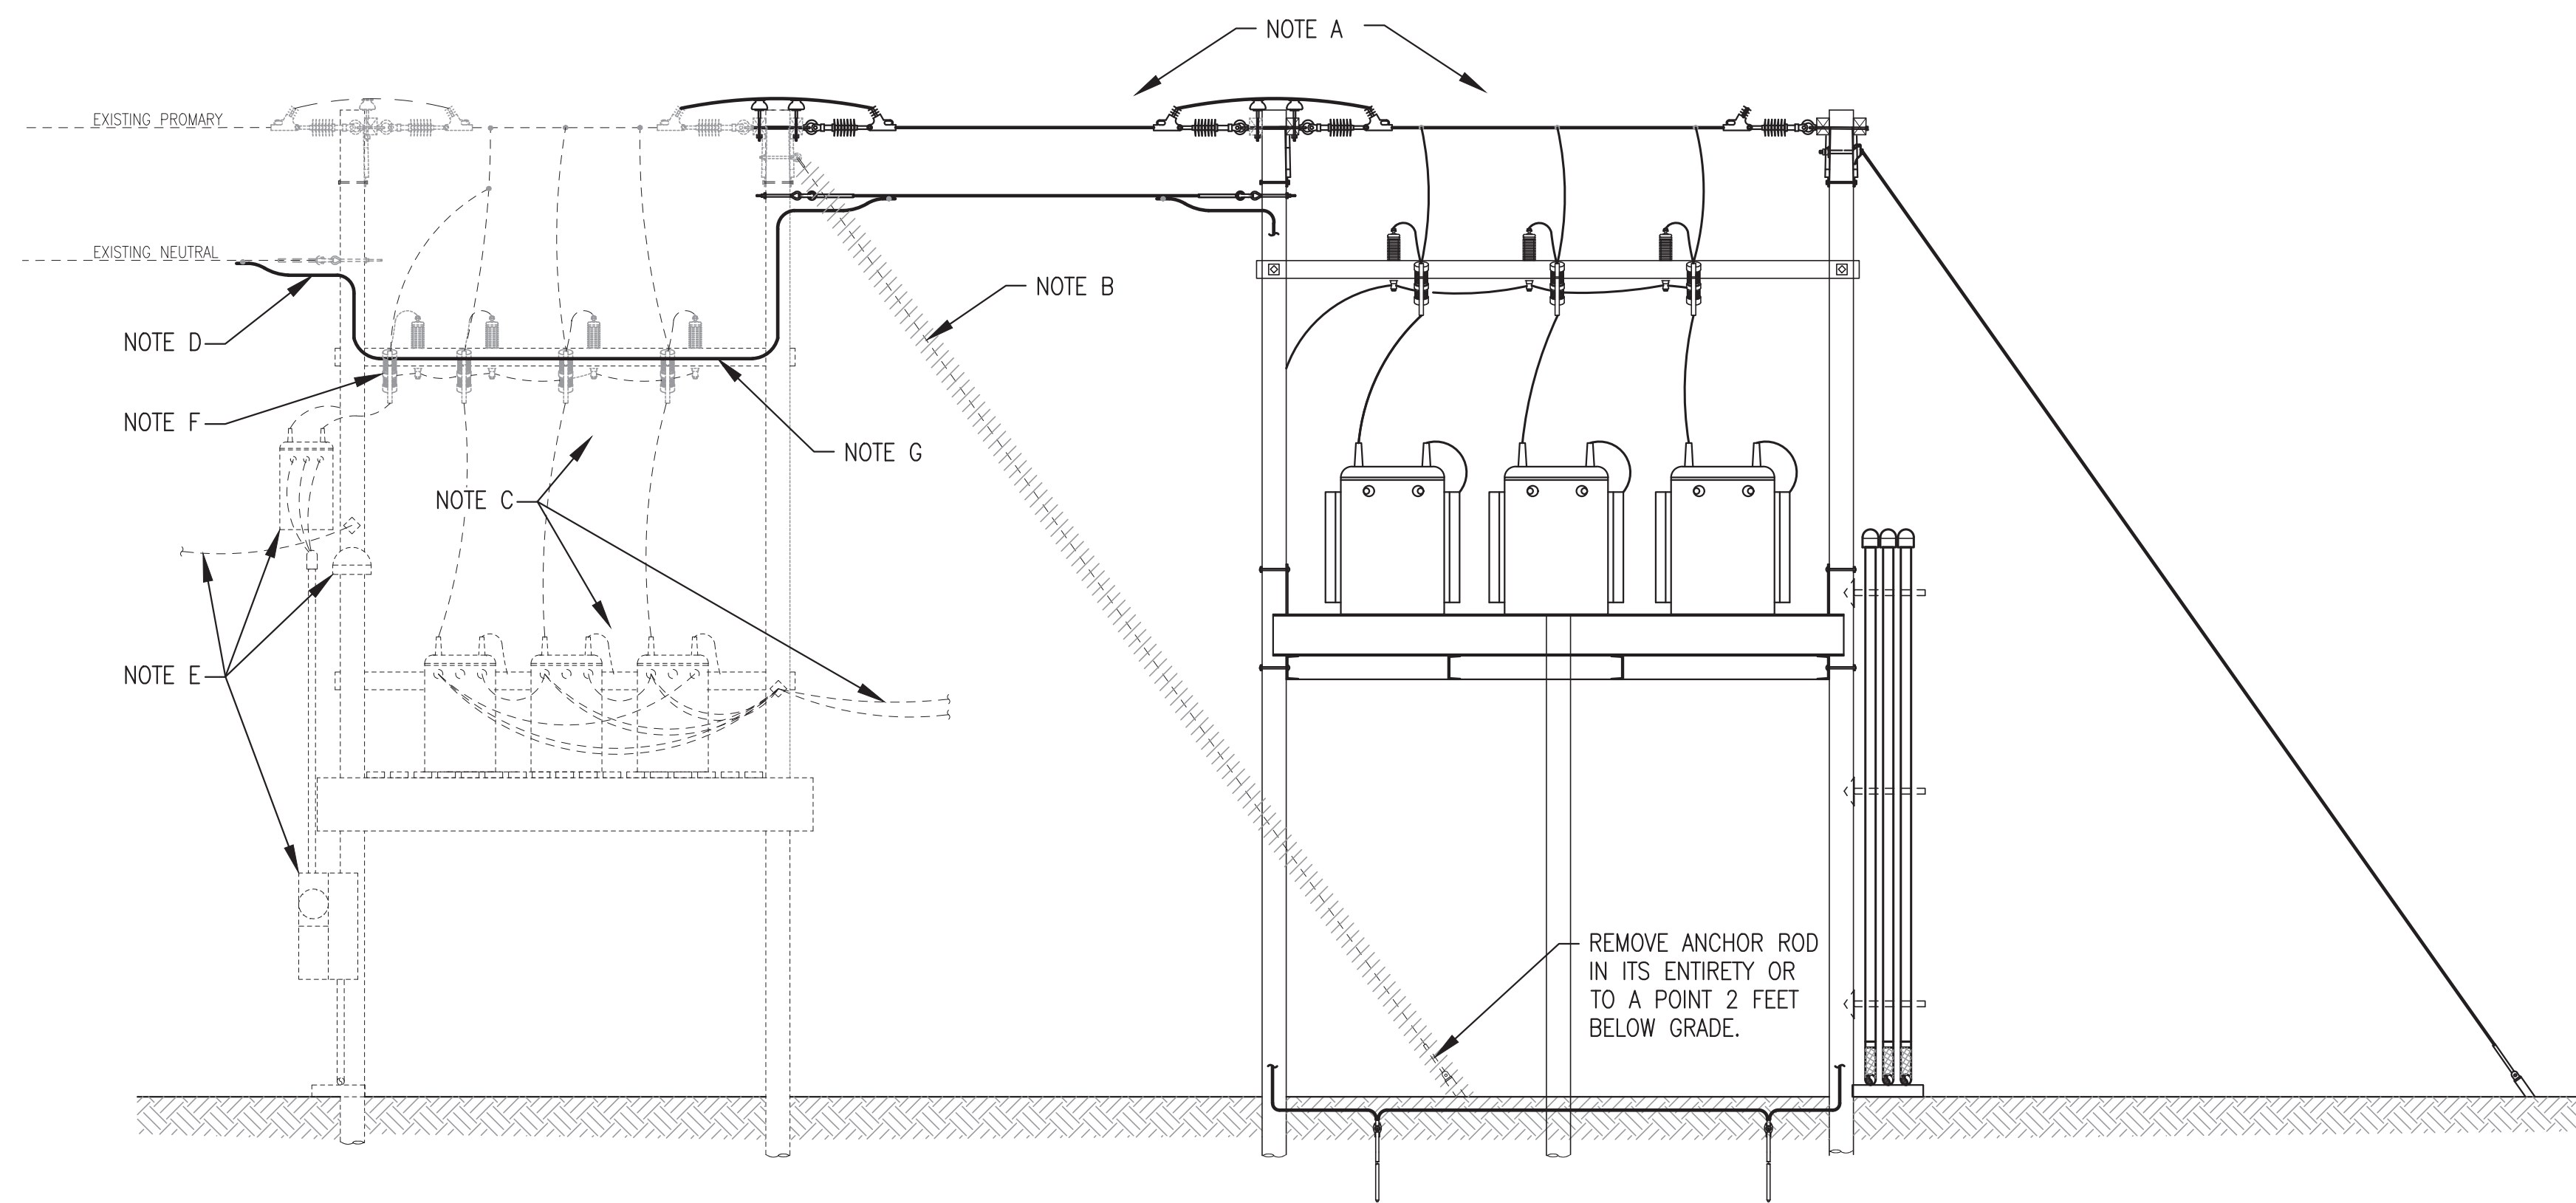

WORK SEQUENCE FOR INTERIM OPERATION OF OLD AND NEW POWER PLANTS AND TRANSFORMER BANKS

- A. SEE FINAL CONFIGURATION FOR SPECIFIC INSTALLATION DETAILS OF ALL NEW UNITS SHOWN WITH DARK, SOLID LINES.
- B. THE EXISTING OVERHEAD ANCHOR WILL INTERFERE WITH INSTALLATION OF THE NEW 500KVA STEP UP TRANSFORMER BANK. TEMPORARILY SUPPORT OR BRACE THE EXISTING OVERHEAD DISTRIBUTION AS REQUIRED TO REMOVE THE EXISTING ANCHOR AND TO INSTALL THE TWO NEW POLES AND NEW ANCHOR.
- C. THE NAPASKIAK POWER PLANT PROVIDES PRIMARY POWER TO THE ENTIRE COMMUNITY; THEREFORE, THE EXISTING 150KVA STEP UP TRANSFORMER BANK AND 480V OVERHEAD FEEDER FROM EXISTING POWER PLANT MUST REMAIN IN SERVICE UNTIL THE NEW INSTALLATION IS COMPLETE AND THE NEW POWER PLANT AND NEW STEP UP TRANSFORMER BANK HAVE BEEN COMMISSIONED. AFTER COMMISSIONING OF NEW PLANT AND TRANSFORMER BANK IS COMPLETE, DEMOLISH THE OLD TRANSFORMER BANK AND 480V FEEDER FROM OLD POWER PLANT AS SHOWN ON FINAL CONFIGURATION
- D. TEMPORARILY INSTALL #1/0 BARE COPPER NEUTRAL EXTENSION TO AVOID PROXIMITY TO THE EXISTING PRIMARY TRANSFORMER JUMPERS DURING INTERIM OPERATIONS. STAPLE THE NEUTRAL CONDUCTOR TO EXISTING WOODEN POLES AND STRUCTURE AS REQUIRED TO ROUTE TO NEW OVERHEAD EXTENSION. UPON COMMISSIONING OF NEW POWER PLANT AND NEW STEP UP TRANSFORMER BANK, INSTALL NEW NEUTRAL AND DEMOLISH TEMPORARY. SEE FINAL CONFIGURATION.
- E. THE EXISTING 15KVA TRANSFORMER, TANK FARM SERVICE, METER, STREET LIGHT, AND OVERHEAD SERVICE TO STORAGE BUILDING WILL REMAIN PERMANENTLY. RECONNECT PRIMARY JUMPER TO TRANSFORMER AS REQUIRED AFTER DEMOLITION OF OLD STEP UP TRANSFORMER BANK, SEE FINAL CONFIGURATION.
- F. REMOVE EXISTING FUSED CUTOUT AND ARRESTER AND RELOCATE TO SIDE OF POLE WITH NEW SINGLE PHASE CUTOUT/ARRESTER EXTENSION BRACKET.
- G. AFTER FINAL CONFIGURATION IS COMPLETE, REMOVE TIMBER.

1 STEP UP TRANSFORMER BANK DEMOLITION & INTERIM CONFIGURATION
E1.5 1/4"=1'


ALL WORK ON THIS SHEET IS INCLUDED IN THE ON SITE CONTRACT

ISSUED FOR
 CONSTRUCTION
 DECEMBER 2022



PROJECT: NAPASKIAK POWER SYSTEM UPGRADE	
TITLE: STEP UP TRANSFORMER BANK DEMOLITION & INTERIM CONFIGURATION	
DESIGNED BY: CWV/BCG	SCALE: AS NOTED
DATE: 12/15/22	SHEET:
FILE NAME: NAPS PP E1	E1.5
PROJECT NUMBER:	

Gray Stassel Engineering, Inc.
 P.O. 111405, Anchorage, AK 99511 (907)349-0100

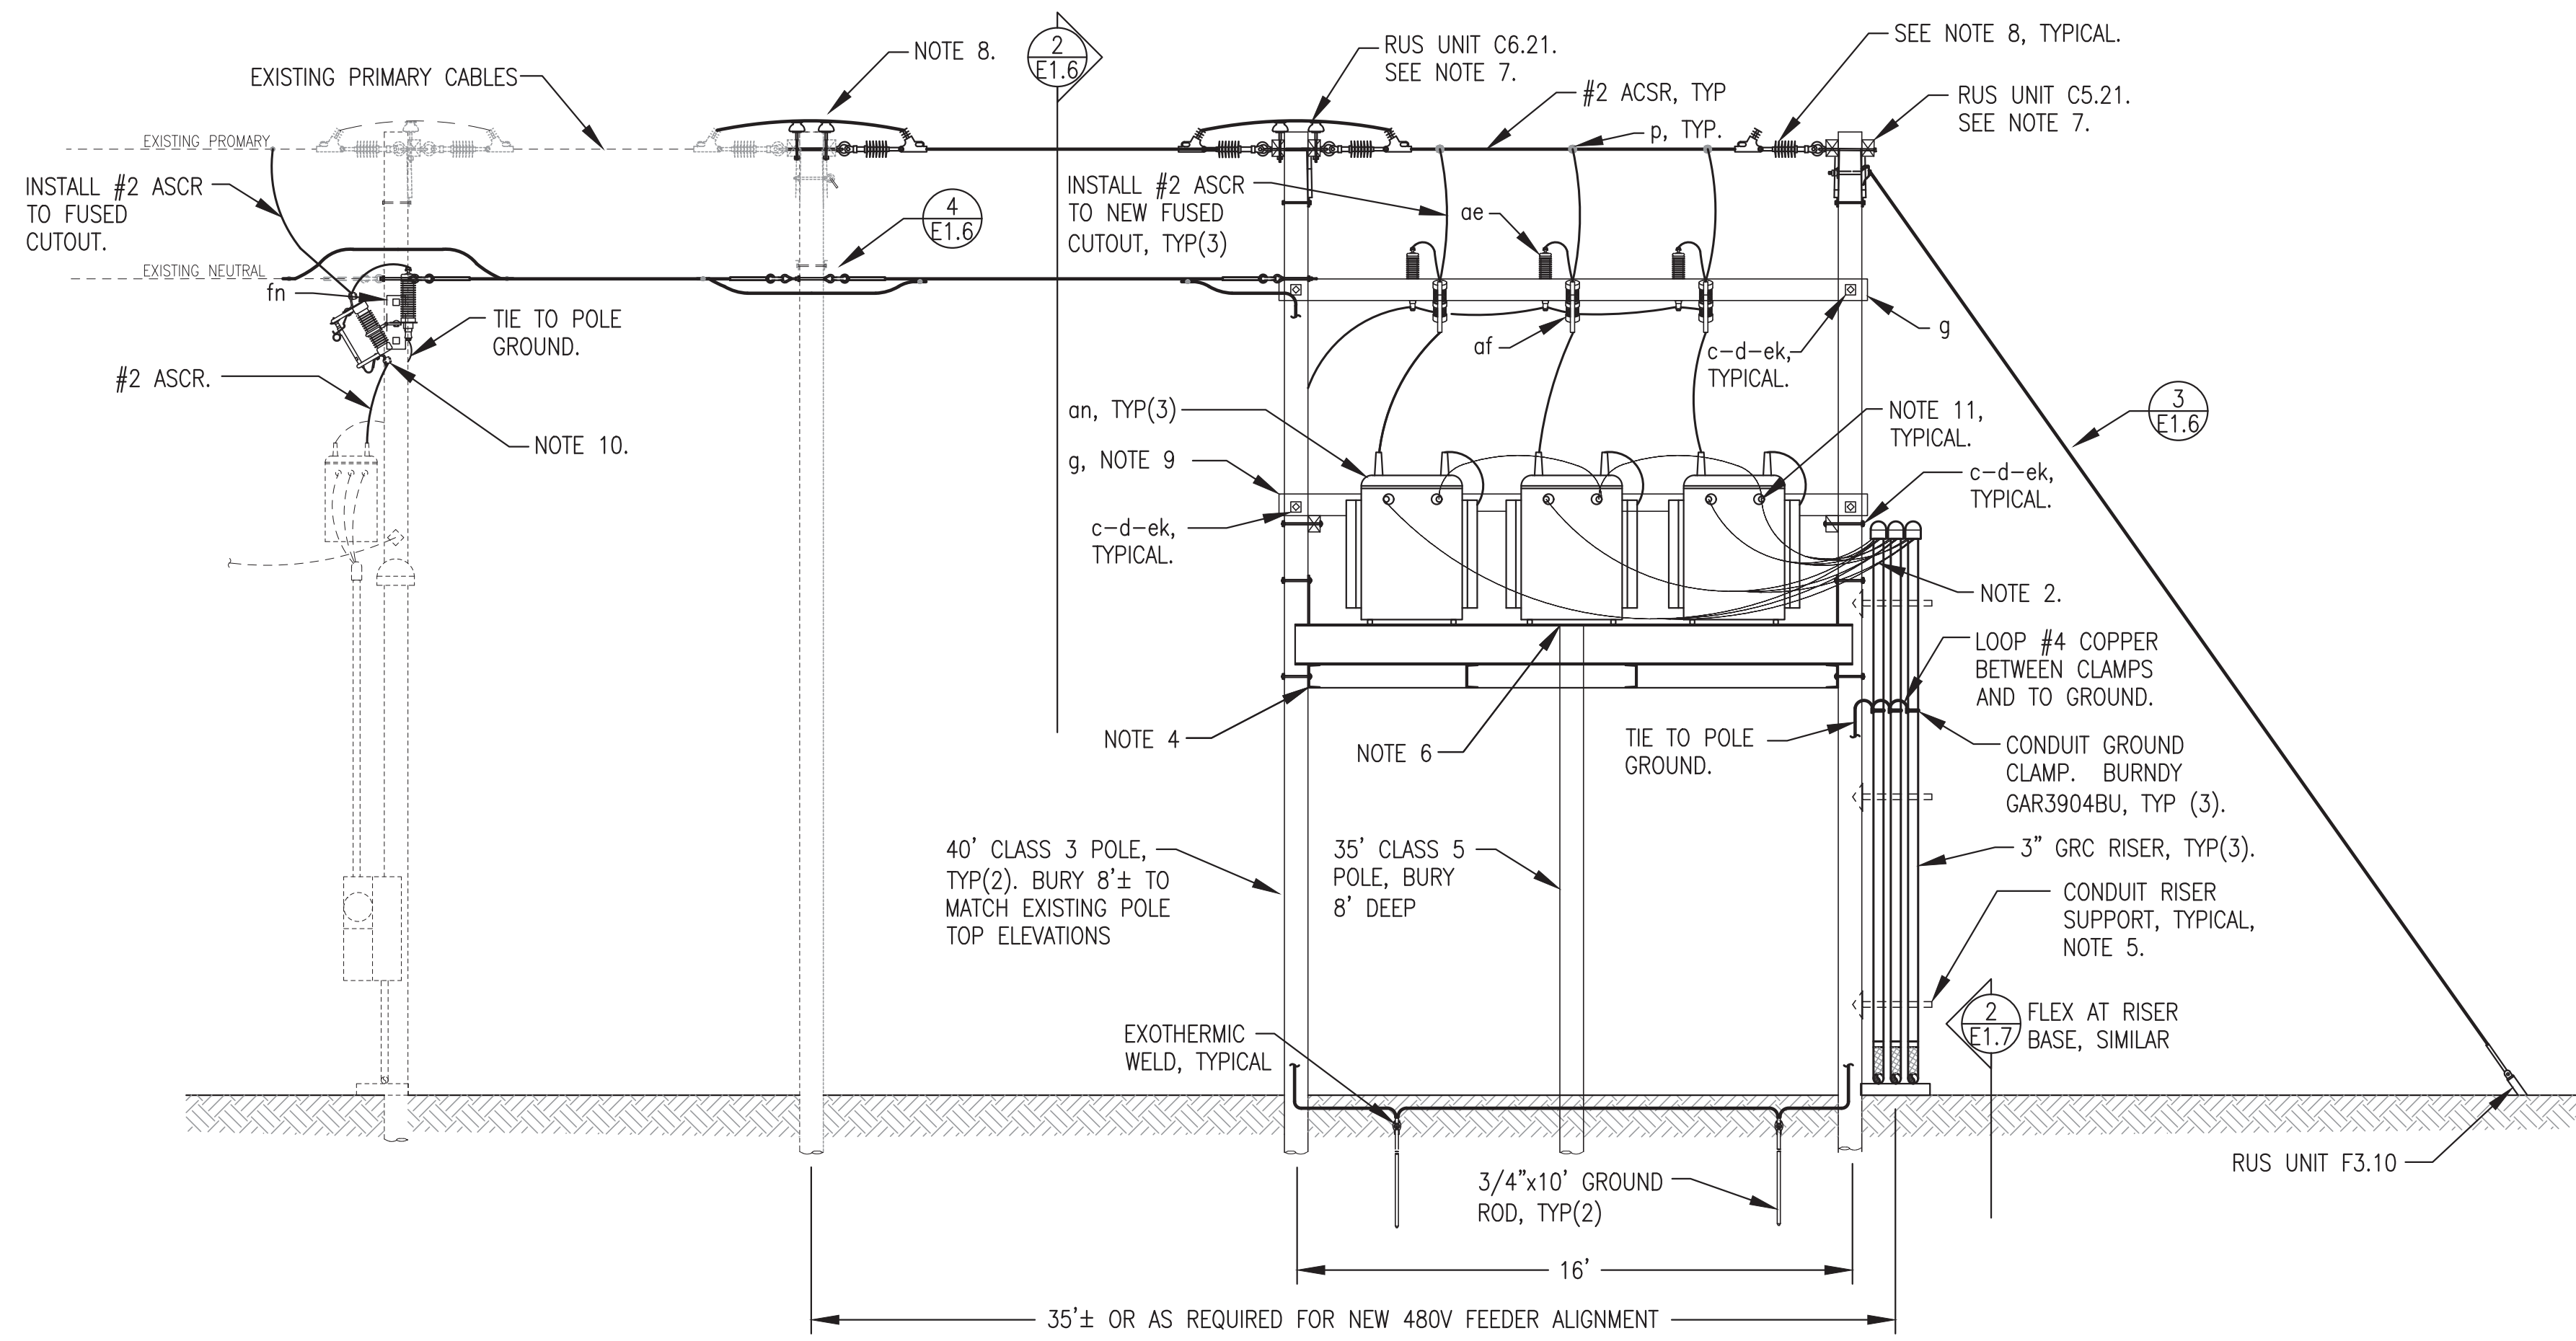

ITEM	QTY	MATERIAL LIST
c	AS REQUIRED	BOLT, MACHINE 5/8" X REQUIRED LENGTH.
c-1	AS REQUIRED	BOLT, MACHINE 1/2" X REQUIRED LENGTH.
d	AS REQUIRED	WASHER, SQUARE 2-1/4".
d-1	AS REQUIRED	WASHER, ROUND, 1-3/8".
g	2	3-5/8"x7-1/2"x17'-0" TREATED HUGHES BROS. CROSSARM.
i	AS REQUIRED	BOLT, CARRIAGE, 3/8" X REQUIRED LENGTH.
p	AS REQUIRED	COMPRESSION CONNECTORS.
ae	3	ARRESTER, SURGE, 7.65 kV MCOV, WITH MOUNTING HARDWARE.
af	3	CUTOUT, DISTRIBUTION, OPEN (15 KV). PROVIDE 21 AMP SloFast FUSE LINKS WITH MOUNTING HARDWARE.
an	3	TRANSFORMER, 277V-7.2 kV, 167 kVA.
ek	AS REQUIRED	LOCKNUTS.
fn	1	BRACKET, EXTENSION, 18".


GENERAL NOTES:

- ADDITIONAL CONSTRUCTION UNITS AND MATERIAL REQUIRED FOR THE CONSTRUCTION OF THE PLATFORM SHALL BE PROVIDED AS REQUIRED FOR THE RUS UNITS REFERENCED.
- ALL CONSTRUCTION SHALL CONFORM TO RUS SPECIFICATIONS.
- VERIFY EXISTING SYSTEM PHASE ROTATION AND MATCH NEW SYSTEM TO THE EXISTING.

NOTES:

- EXISTING CONDUCTORS, POLES, AND HARDWARE TO REMAIN SHOWN WITH LIGHT, DASHED LINES. NEW CONDUCTORS, POLES AND EQUIPMENT SHOWN WITH DARK, SOLID LINES. ALL UNITS TO BE DEMOLISHED SPECIFICALLY INDICATED WITH NOTES.
- CONDUCTORS AS INDICATED. SEE SWITCHGEAR ONE-LINE DIAGRAM. ROUTE NEW CABLE ON NEW SUPPORTS OVER TO NEW TRANSFORMERS. MAKE CONNECTIONS AT TRANSFORMERS AS REQUIRED FOR WYE CONNECTION.
- TIE H2 BUSHING TO GROUND. GROUND TRANSFORMER TANKS, MINIMUM #4 COPPER. CONNECT ALL ARRESTERS TO GROUND AND GROUND ALL METALLIC PARTS.
- ALUMAFORM 3PAL-16 TRANSFORMER PLATFORM, OR ENGINEER APPROVED EQUAL. INSTALL PLATFORM IN ACCORDANCE WITH THE MANUFACTURERS INSTRUCTIONS USING MATERIAL PROVIDED OR IDENTIFIED BY THE MANUFACTURER.
- CONDUIT SUPPORT SHALL BE B-LINE BB12-18, HOT DIP GALVANIZED. ATTACH WITH FOUR 1/4" HOT DIP GALVANIZED LAG BOLTS.
- PROVIDE EXTRA POLE KIT. CUT POLE AS REQUIRED TO MATCH ELEVATION OF PLATFORM.
- ADJUST DIMENSIONS AS NECESSARY TO MATCH EXISTING PLATFORM.
- INSTALL INSULATORS IN ACCORDANCE WITH RUS UNIT A2.021, TWO EACH CROSSARM, AND A2.01 ON POLE.
- INSTALL CROSSARM TIMBER TO PROVIDE SUPPORTS FOR TRANSFORMERS. CUT STANDARD CROSSARM AND ATTACH TO POLES FOR TIMBER SUPPORT. LOCATION OF TIMBER AND LENGTH OF CUT CROSSARMS TO BE FIELD ADJUSTED AS REQUIRED FOR TRANSFORMERS PROVIDED. ALL INSTALLATION SHALL BE LEVEL AND PLUMB. CUTS SHALL BE SQUARE.
- REINSTALL FUSED CUTOUT AND ARRESTER ON NEW EXTENSION BRACKET. POSITION BRACKET AS REQUIRED TO COORDINATE WITH NEUTRAL.
- PROVIDE DUAL RATED COMPRESSION LUGS ON CABLE ENDS FOR CONNECTION TO TRANSFORMER SECONDARY LOAD PADS. PROVIDE COLD SHRINK OR HEAT SHRINK MOISTURE SEAL AT END OF CABLE. MOISTURE SEAL SHALL EXTEND OVER THE INSULATION AND THE LUG TO PROVIDE A WATER TIGHT CONNECTION.

1 STEP UP TRANSFORMER BANK FINAL CONFIGURATION
E1.6 1/4"=1'

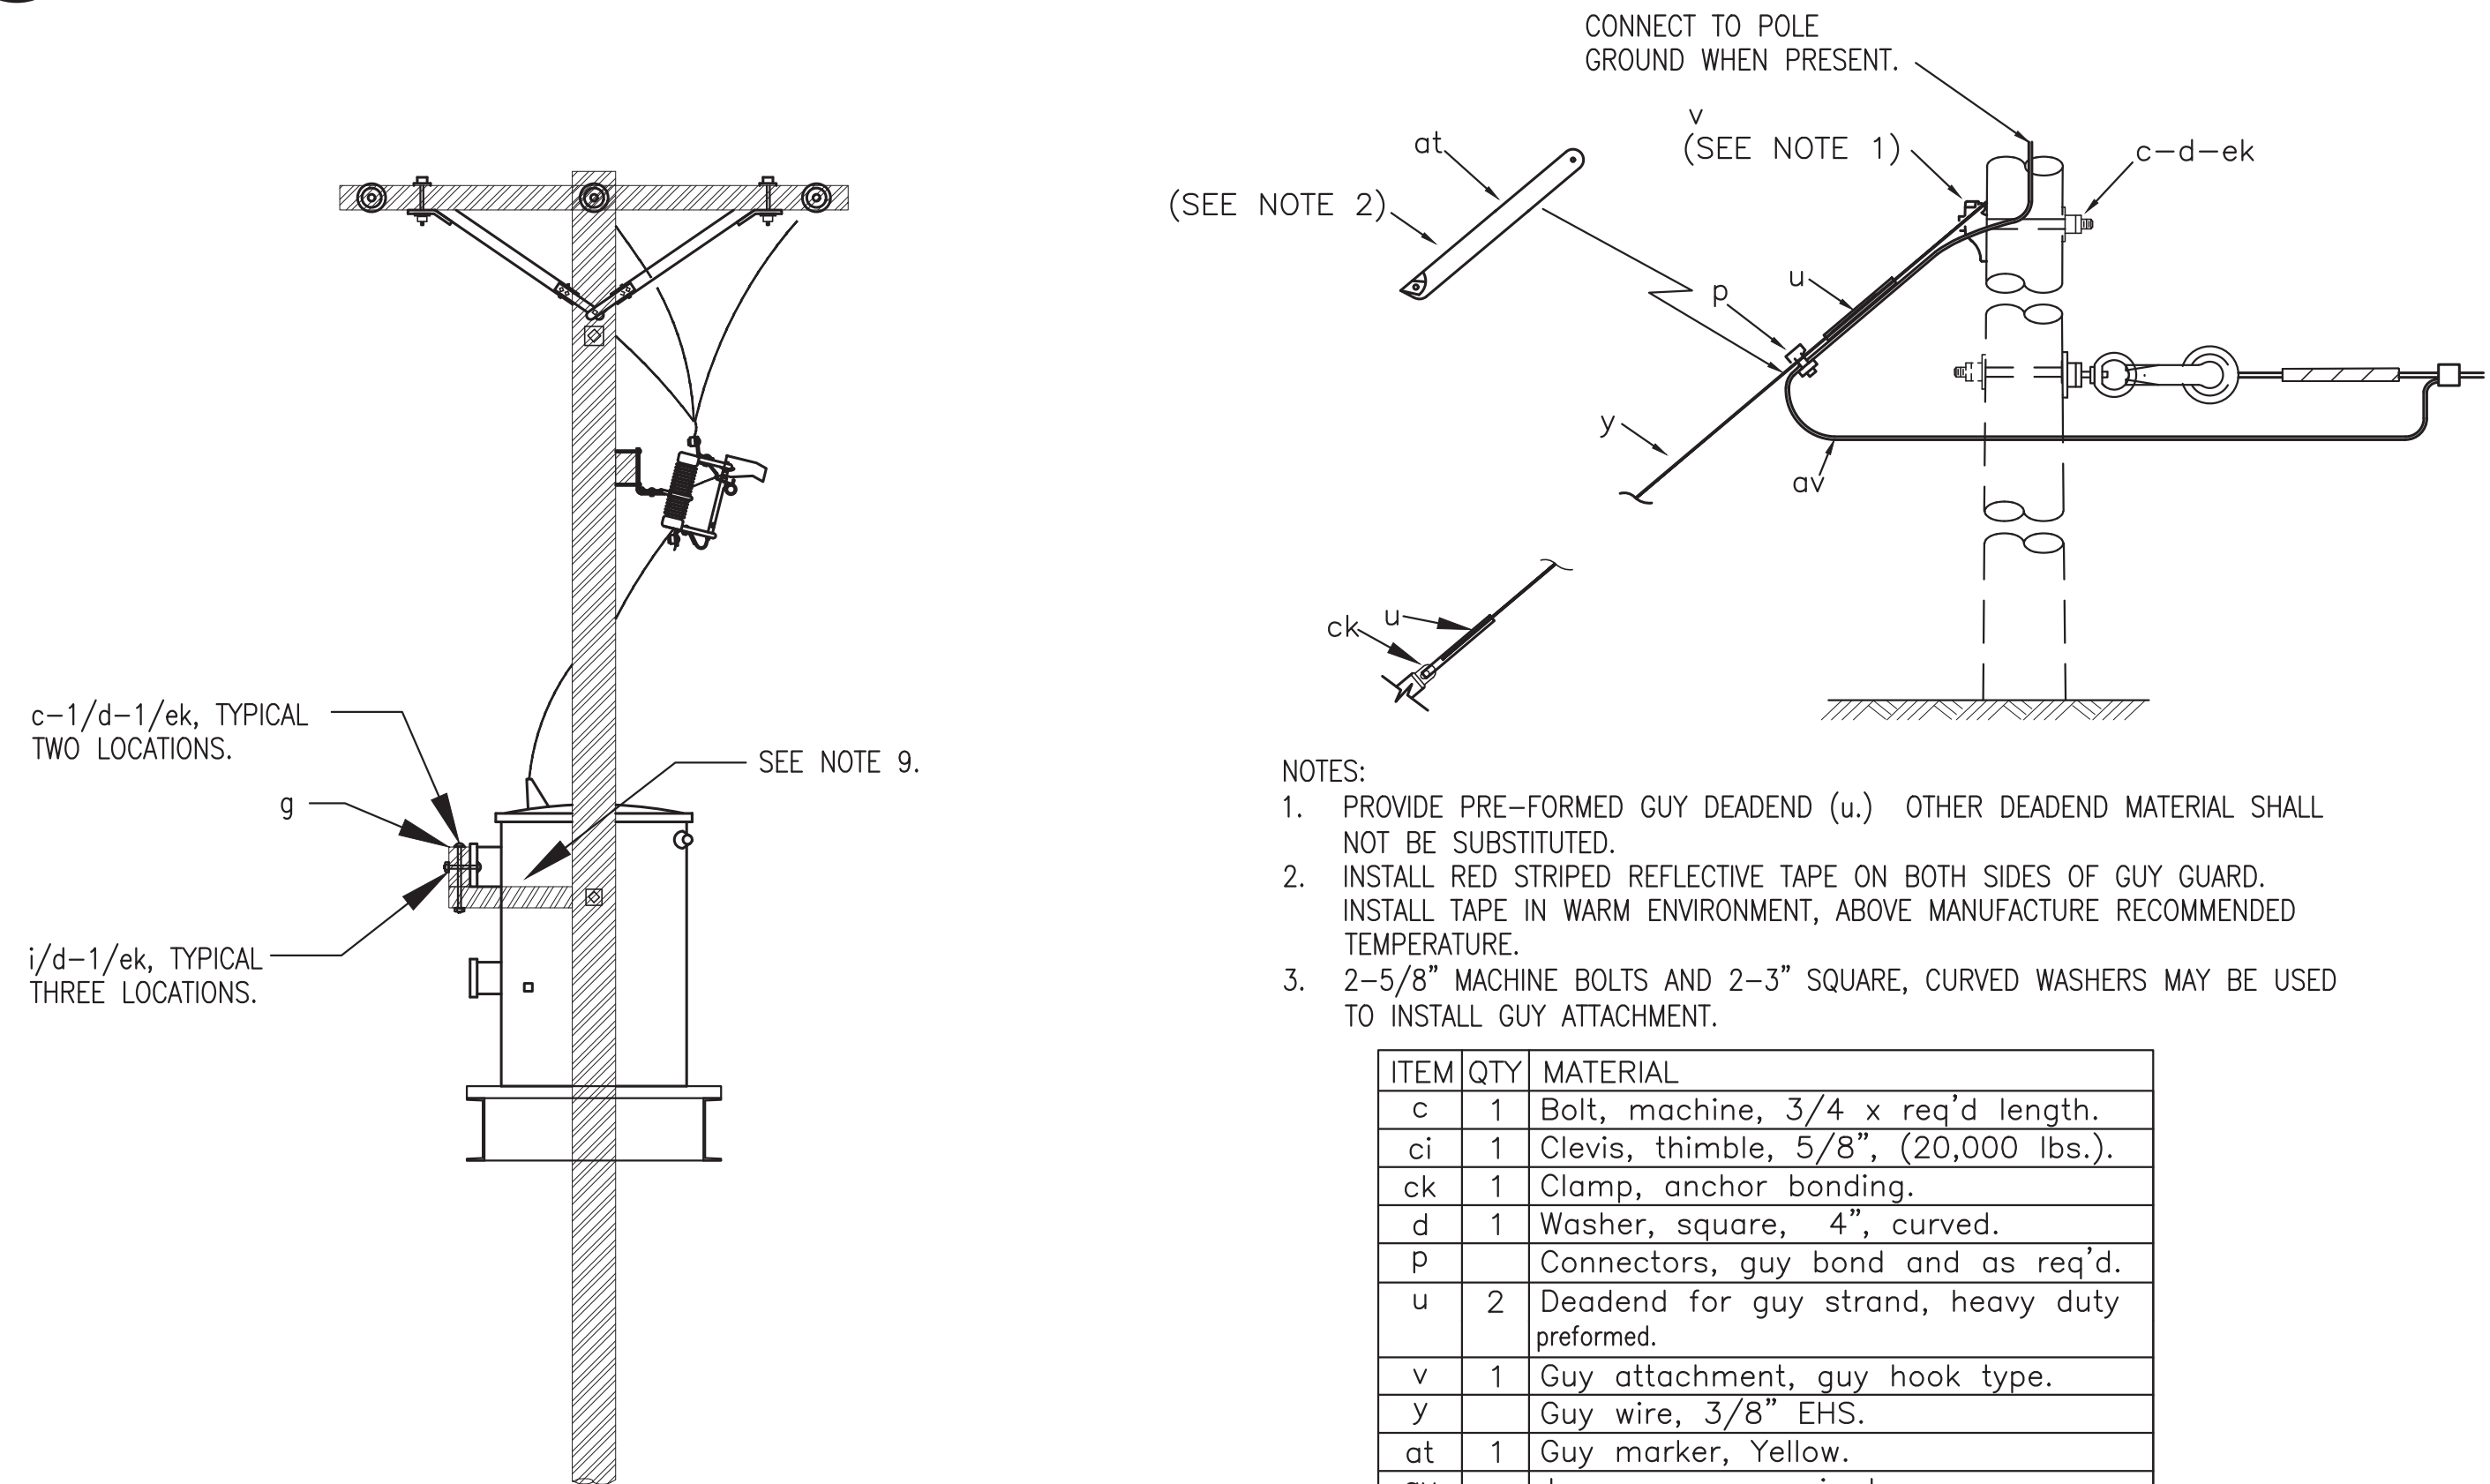

2 TRANSFORMER BANK NEW WORK SECTION
E1.6 3/8"=1'

3 E1.1La SINGLE DOWN GUY
E1.6 NO SCALE

4 N6.1a NEUTRAL ASSEMBLY - DOUBLE DEADEND
E1.6 NO SCALE

ALL WORK ON THIS SHEET IS INCLUDED IN THE ON SITE CONTRACT

ISSUED FOR CONSTRUCTION
DECEMBER 2022




ALASKA ENERGY AUTHORITY

PROJECT: **NAPASKIAK POWER SYSTEM UPGRADE**


TITLE: **STEP UP TRANSFORMER BANK FINAL CONFIGURATION & DETAILS**

DESIGNED BY: JTD	SCALE: AS NOTED
DESIGNED BY: CWV/BCG	DATE: 12/15/22
FILE NAME: NAPS PP E1	SHEET: E1.6
PROJECT NUMBER:	

Gray Stassel Engineering, Inc.
P.O. 111405, Anchorage, AK 99511 (907)349-0100

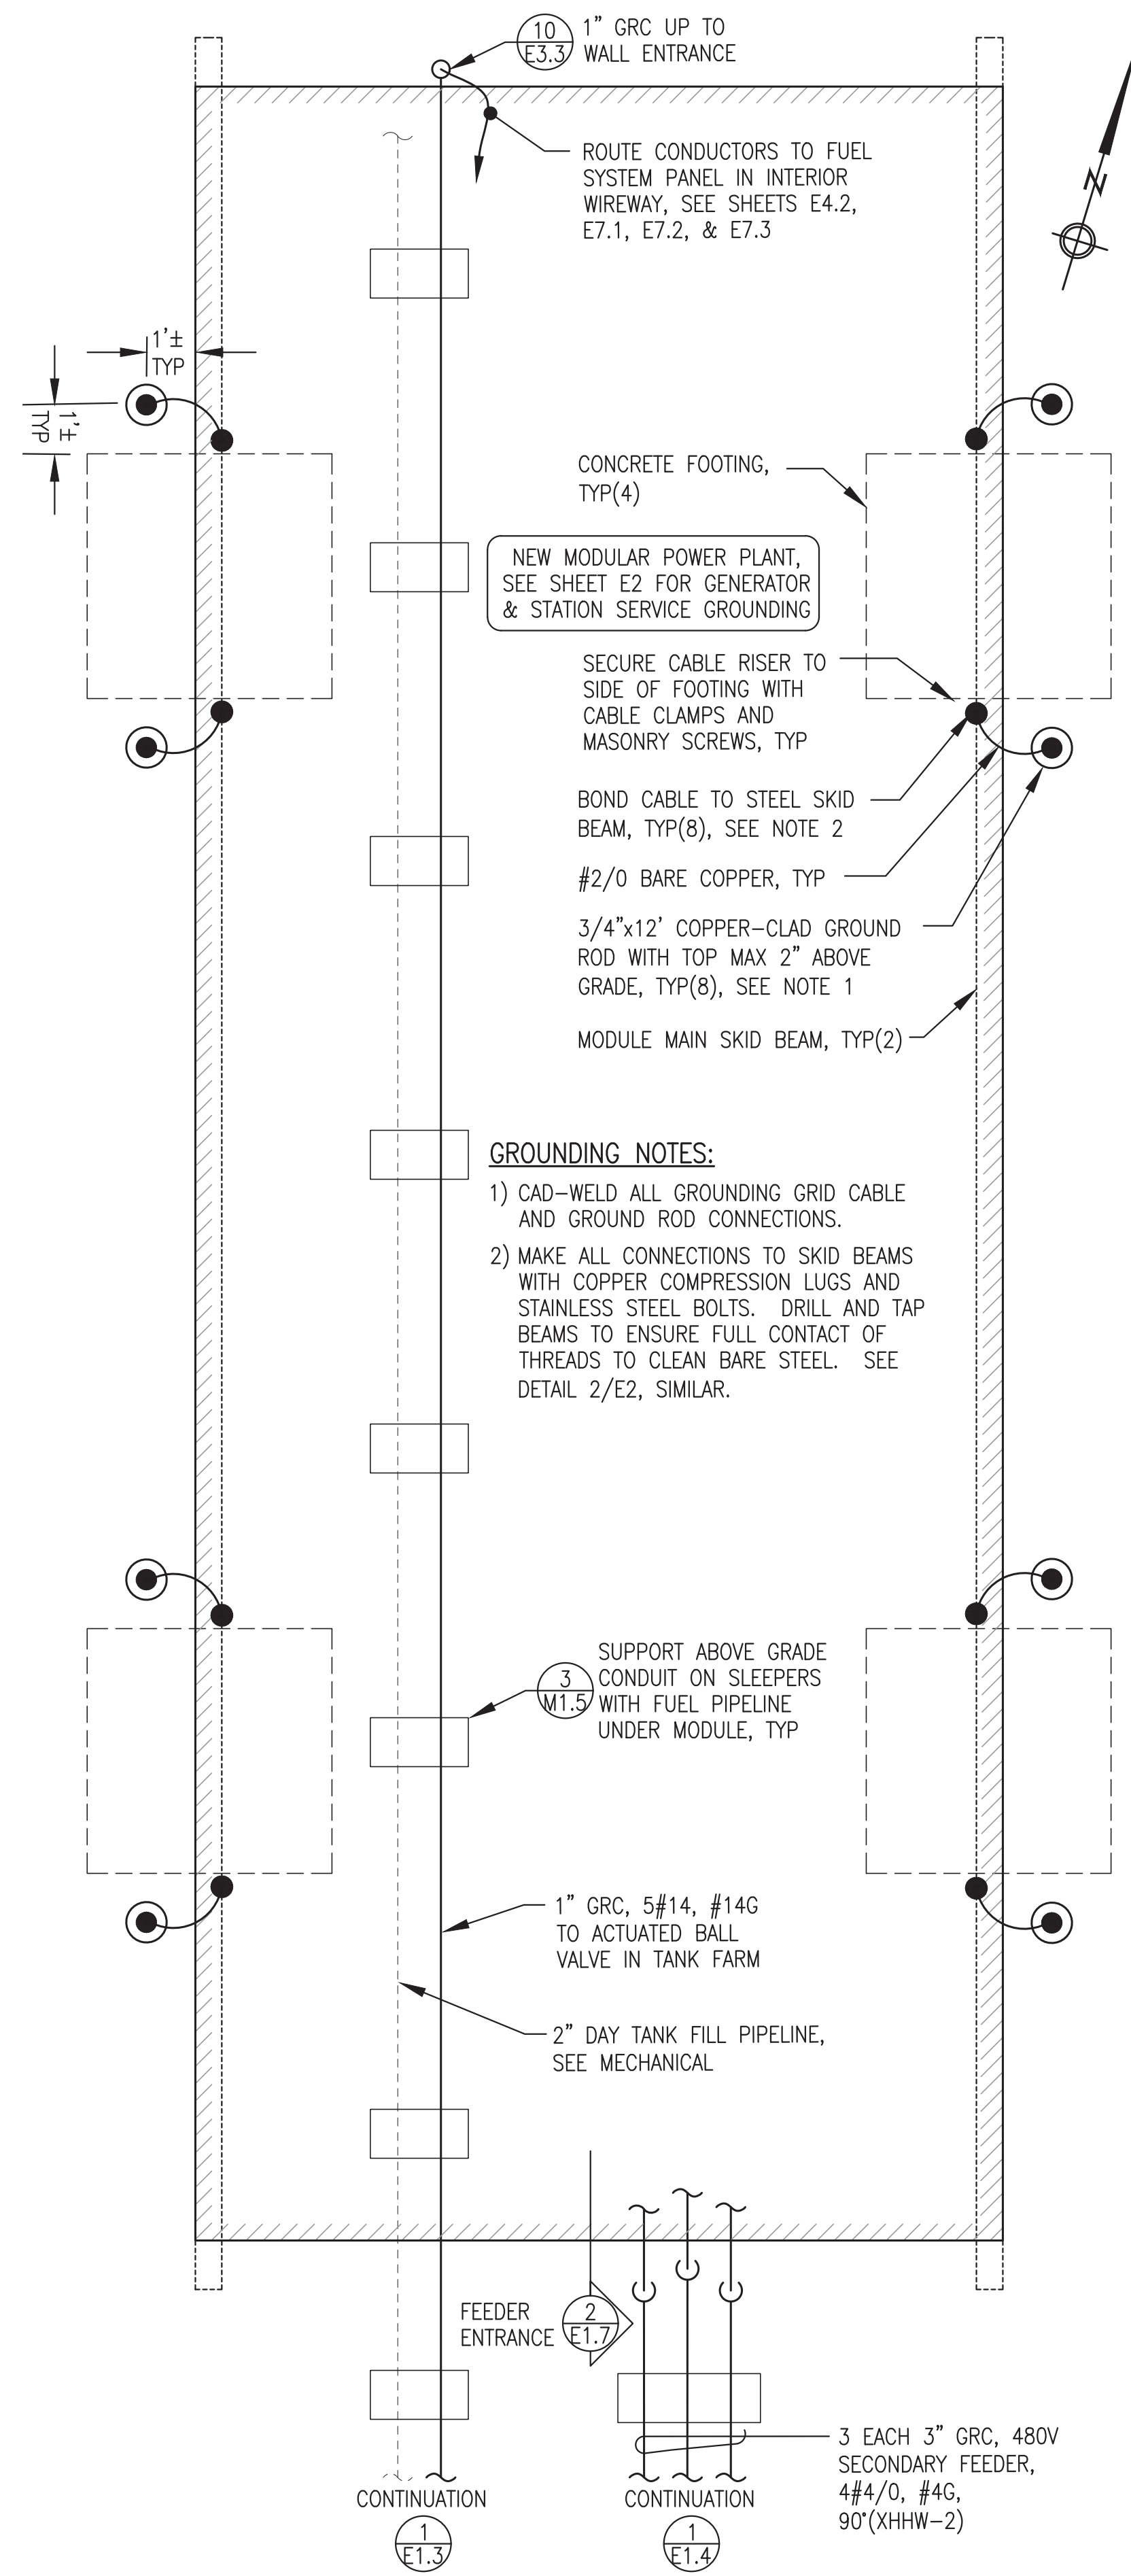

1 POWER PLANT GROUNDING & FEEDER PLAN
 E1.7 3/8"=1'-0"

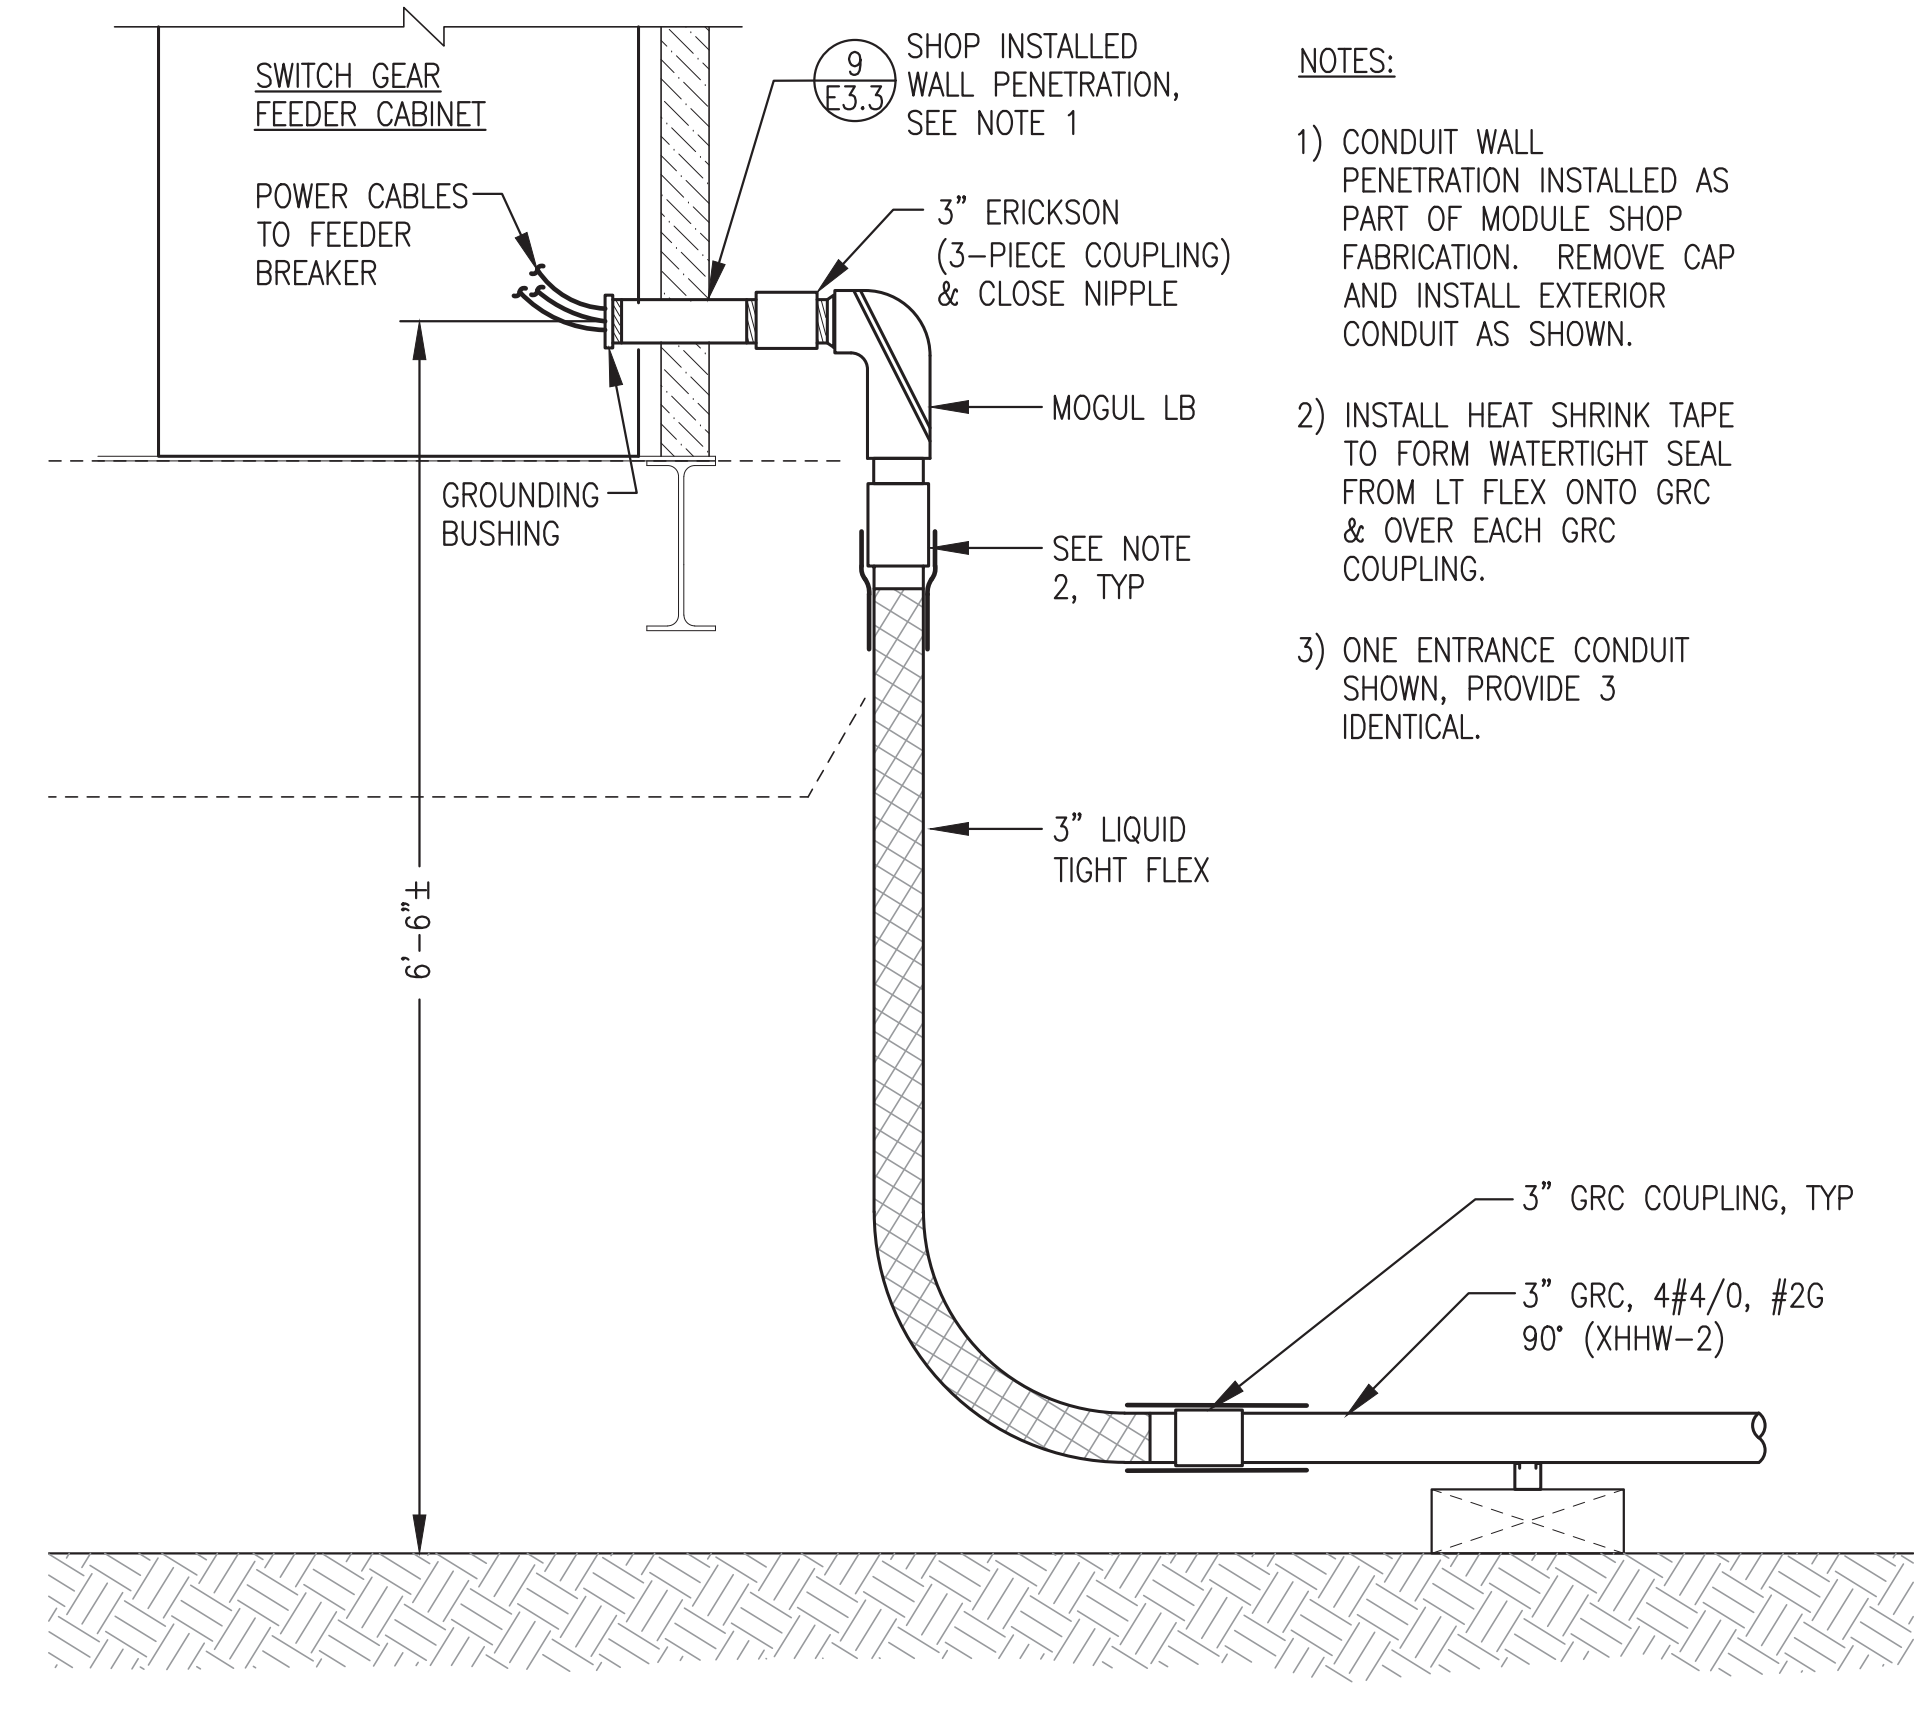


2 FEEDER ENTRANCE
 E1.7 NO SCALE


- NOTES:
- 1) CONDUIT WALL PENETRATION INSTALLED AS PART OF MODULE SHOP FABRICATION. REMOVE CAP AND INSTALL EXTERIOR CONDUIT AS SHOWN.
 - 2) INSTALL HEAT SHRINK TAPE TO FORM WATERTIGHT SEAL FROM LT FLEX ONTO GRC & OVER EACH GRC COUPLING.
 - 3) ONE ENTRANCE CONDUIT SHOWN, PROVIDE 3 IDENTICAL.

ALL WORK ON THIS SHEET IS INCLUDED IN THE ON SITE CONTRACT


ISSUED FOR CONSTRUCTION
 DECEMBER 2022

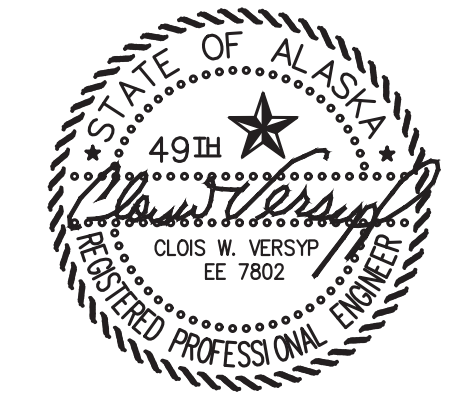

ALASKA ENERGY AUTHORITY		
PROJECT: NAPASKIAK POWER SYSTEM UPGRADE		
TITLE: POWER PLANT GROUNDING PLAN & FEEDER DETAILS		
 Gray Stassel Engineering, Inc. P.O. 111405, Anchorage, AK 99511 (907)349-0100	DRAWN BY: JTD DESIGNED BY: CWV/BCG FILE NAME: NAPS PP E1 PROJECT NUMBER:	SCALE: AS NOTED DATE: 12/15/22 SHEET: E1.7

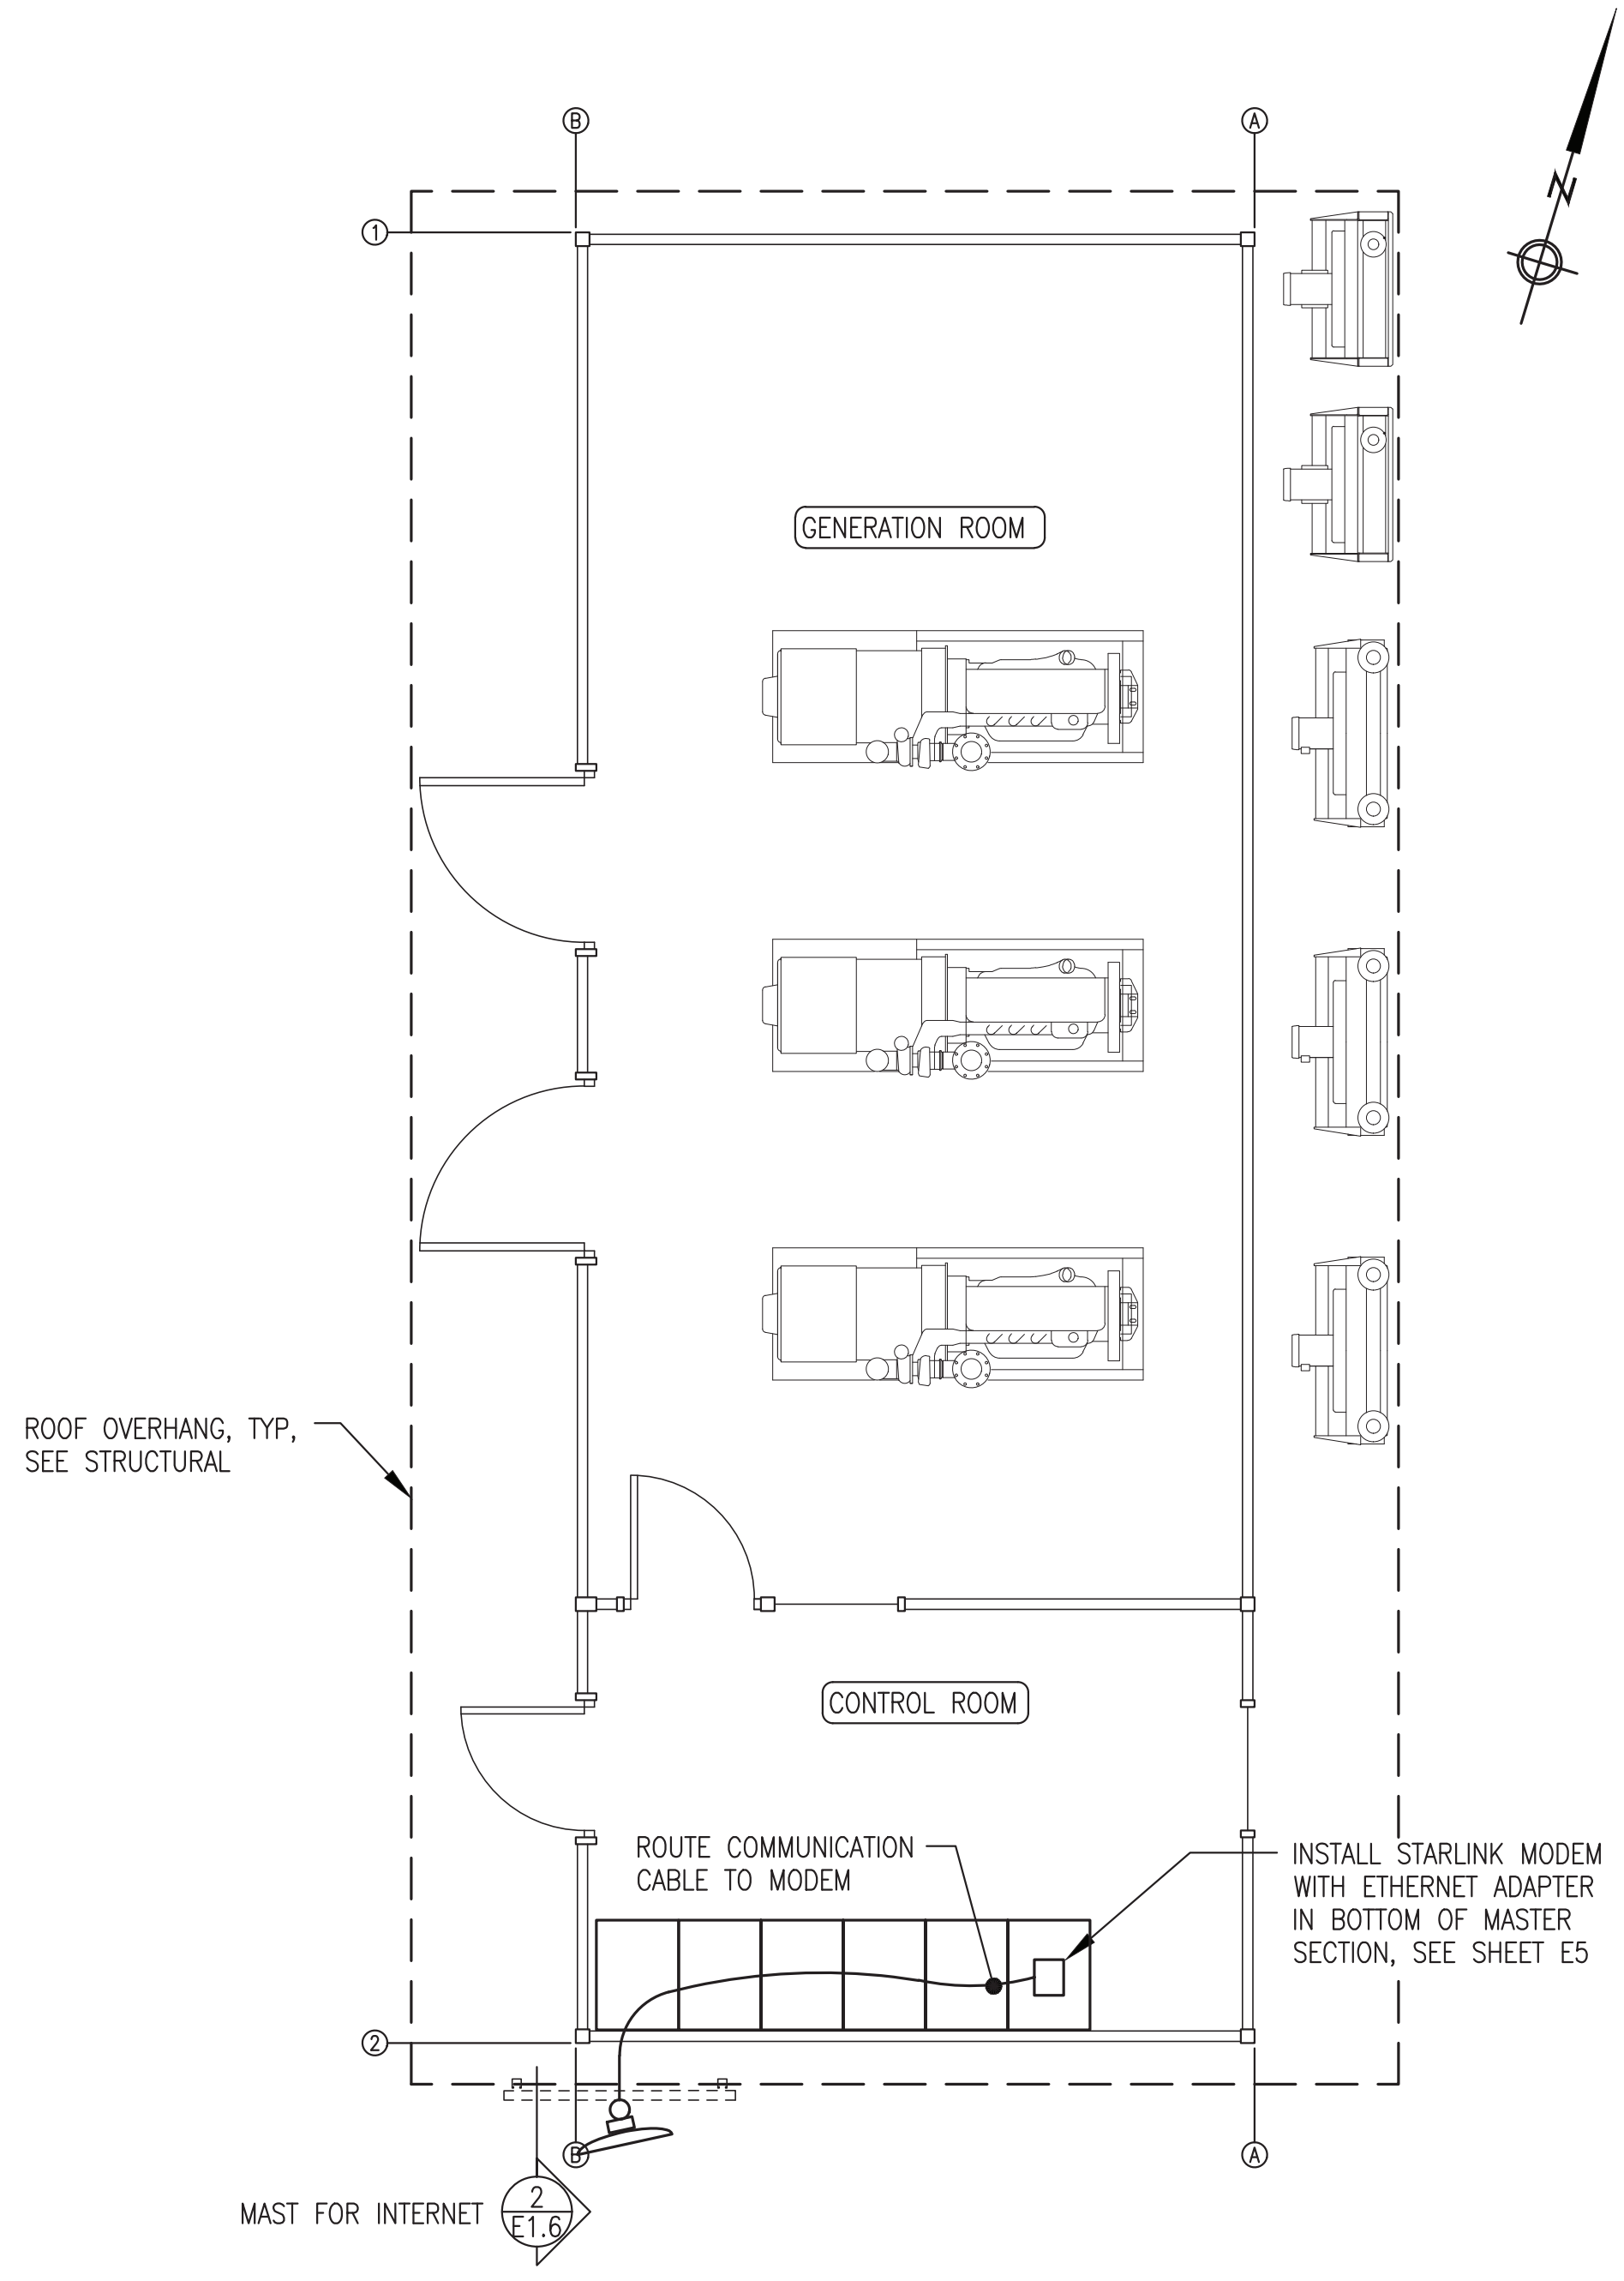

- INTERNET SERVICE GENERAL NOTES:**
- 1) THE INTERNET SERVICE SHALL HAVE THE FOLLOWING MINIMUM PERFORMANCE CHARACTERISTICS:
 20 MBPS DOWNLOAD
 5 MBPS UPLOAD
 NO MONTHLY DATA LIMIT
 STARLINK STANDARD OR APPROVED EQUAL.
 - 2) FURNISH AND INSTALL COMPLETE SYSTEM WITH ANTENNA, PIPE MOUNT ADAPTER, MODEM, CABLE, CONNECTORS, ETHERNET ADAPTER, AND ACCESSORIES REQUIRED TO PROVIDE INTERNET SERVICE TO THE NEW POWER PLANT.
 - 3) UPON COMPLETION OF INSTALLATION THE INTERNET SYSTEM SHALL BE COMMISSIONED IN ACCORDANCE WITH THE SERVICE PROVIDER'S REQUIREMENTS.
 - 4) IN ADDITION TO FURNISHING AND INSTALLING SYSTEMS, THE CONTRACTOR SHALL PRE-PAY FOR A 1 YEAR INTERNET SERVICE CONTRACT.

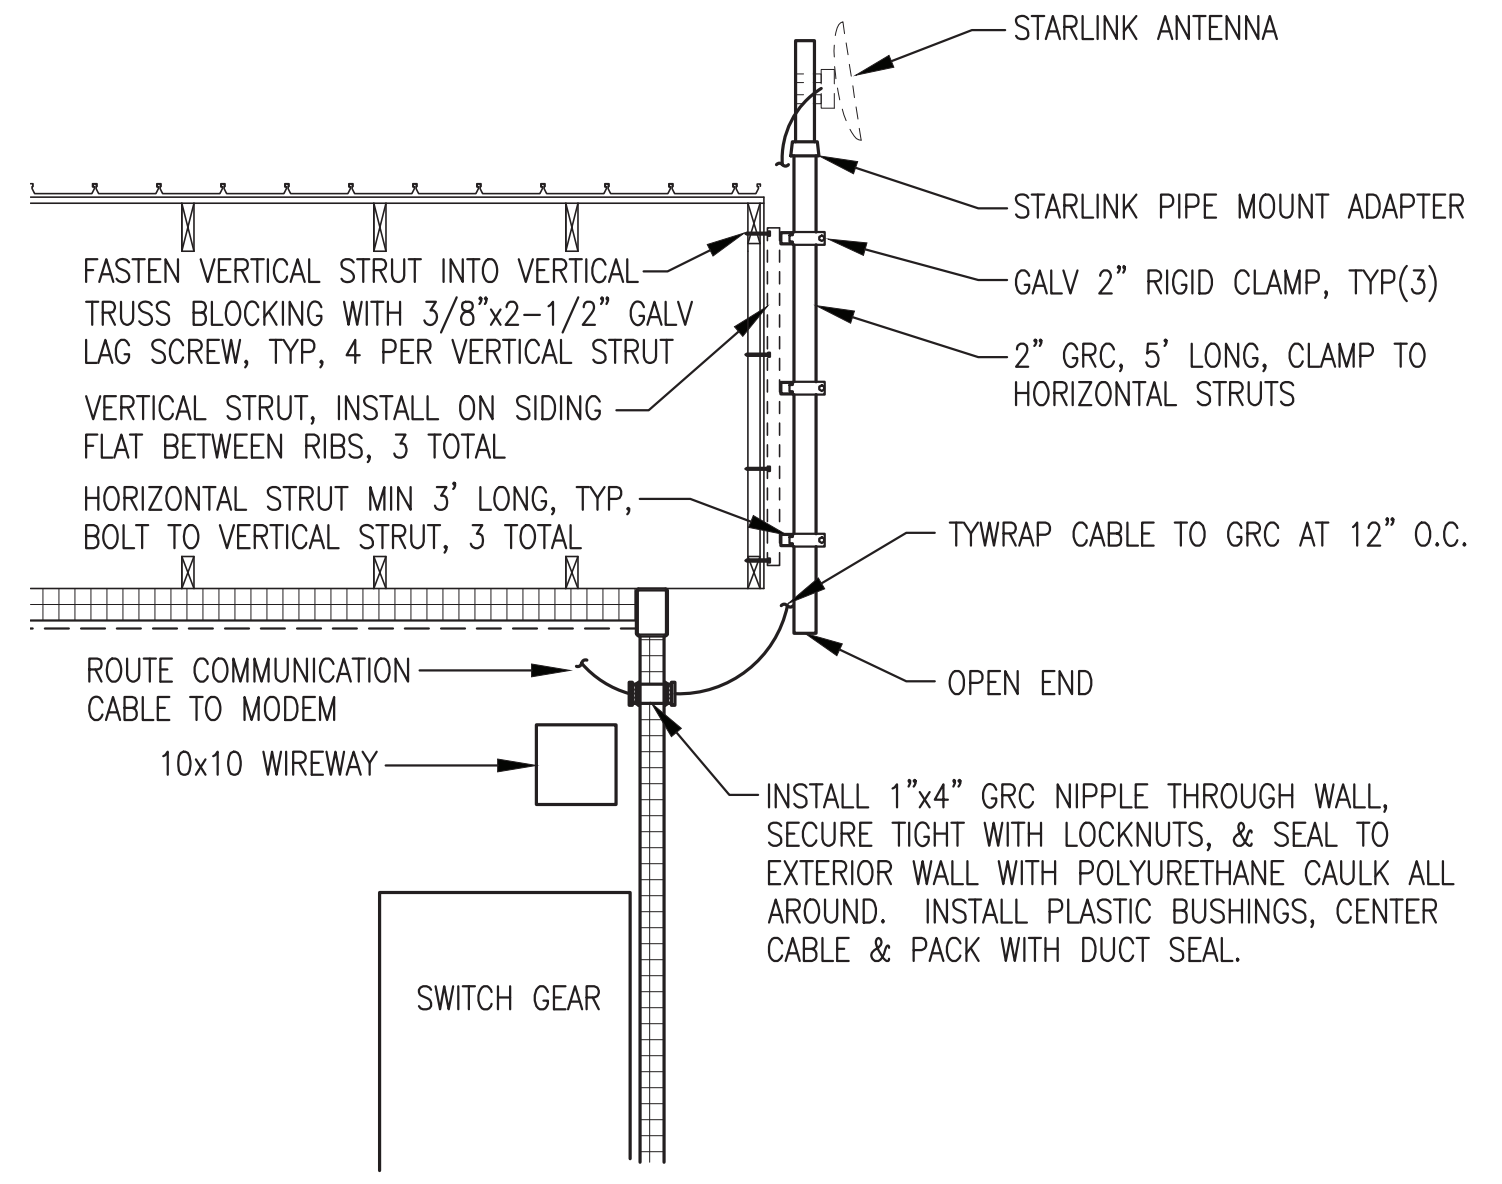


1 POWER PLANT COMMUNICATION PLAN
 E1.8 1/4"=1'-0"


2 COMMUNICATIONS ANTENNA & MAST INSTALLATION DETAILS
 E1.8 1/2"=1'-0"

ALL WORK ON THIS SHEET IS INCLUDED IN THE ON SITE CONTRACT

REV#1
 ISSUED FOR
 CONSTRUCTION
 NOV 2023

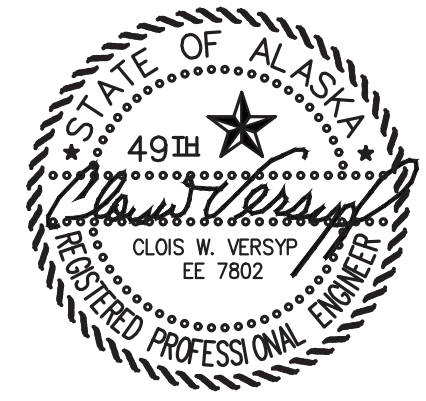

1	CHANGED INTERNET SERVICE TO STARLINK	11/10/23	BCG
REV.	DESCRIPTION	DATE	BY
 ALASKA ENERGY AUTHORITY			
PROJECT: NAPASKIAK POWER SYSTEM UPGRADE			
TITLE: POWER PLANT COMMUNICATION PLAN & DETAILS			
DRAWN BY: JTD		SCALE: AS NOTED	
DESIGNED BY: CWV/BCG		DATE: 12/15/22	
FILE NAME: NAPS PP E1		SHEET:	
PROJECT NUMBER:		E1.8	
P.O. 111405, Anchorage, AK 99511 (907)349-0100			

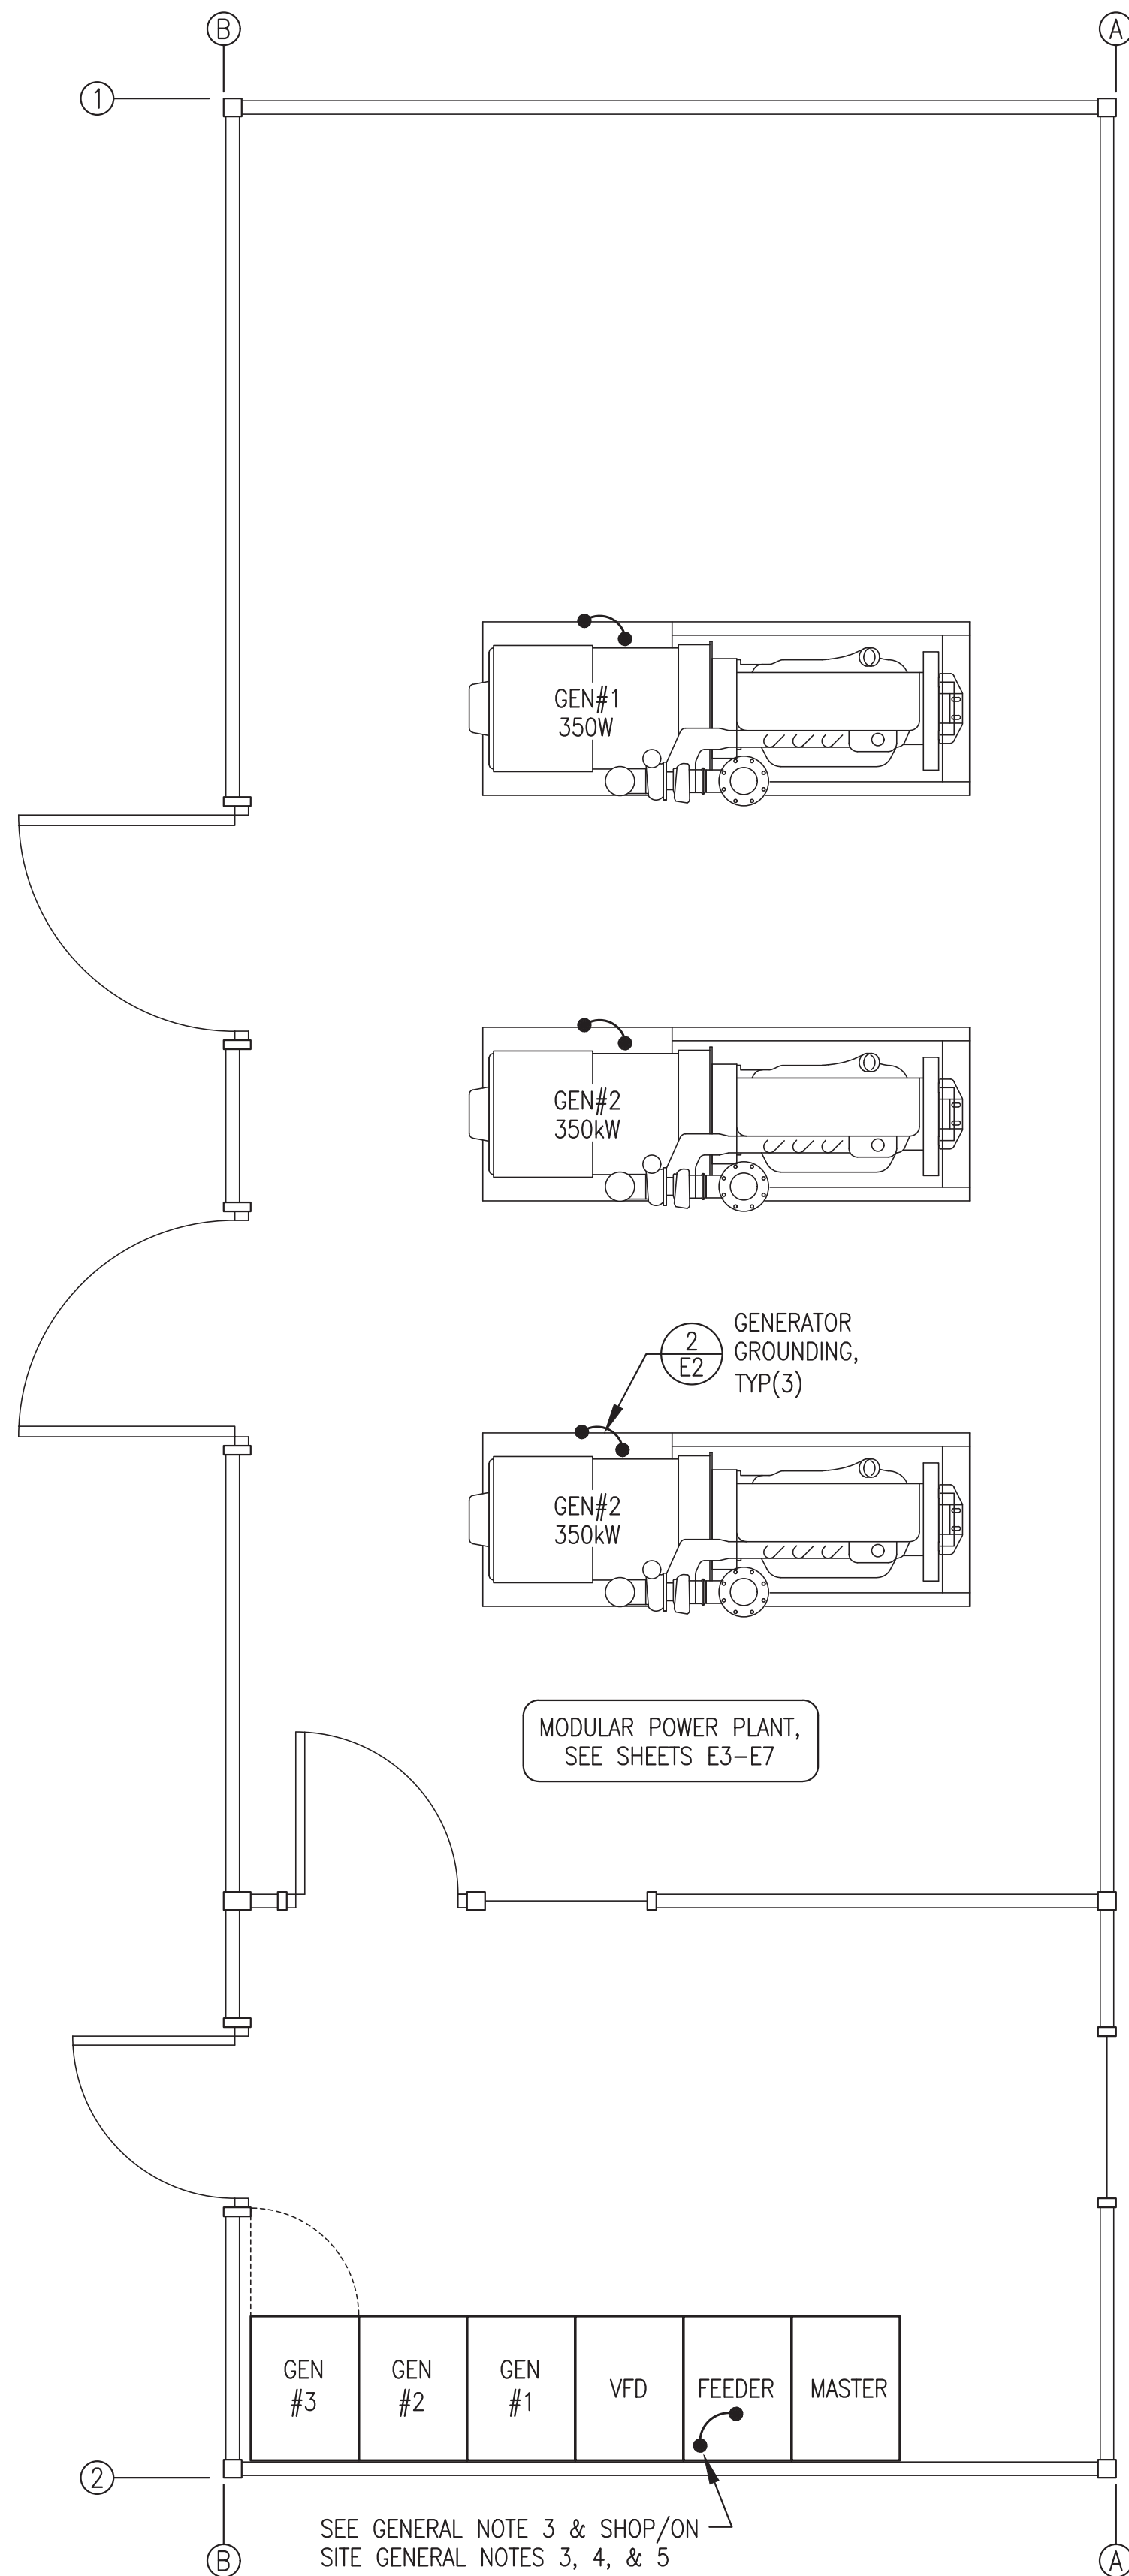


GROUNDING GENERAL NOTES:

- 1) POWER PLANT STRUCTURE IS A CONTINUOUSLY WELDED STEEL MODULE WHICH WILL BE FIELD BONDED TO THE GROUNDING GRID.
- 2) MAKE ALL CABLE CONNECTIONS TO STRUCTURE, SKIDS, OR SUPPORT PEDESTALS WITH COPPER COMPRESSION LUGS AND STAINLESS STEEL BOLTS. DRILL AND TAP STRUCTURAL MEMBERS TO ENSURE FULL CONTACT OF THREADS TO CLEAN BARE STEEL. SEE DETAIL 2/E2, SIMILAR.
- 3) IN FEEDER SECTION PROVIDE #2/0 BARE COPPER JUMPER FROM GROUND BUS TO STEEL FLOOR. SEE DETAIL 2/E2, SIMILAR.

GROUNDING SHOP/ON-SITE NOTES:

- 1) ALL WORK SHOWN THIS SHEET TO BE PERFORMED AS PART OF THE SHOP FABRICATION.
- 2) FIELD INSTALLATION OF GROUND GRID AND BONDING TO MODULE TO BE PERFORMED AS PART OF THE ON-SITE WORK. SEE ENLARGED SITE PLAN.
- 3) AS PART OF SHOP FABRICATION WORK, TEMPORARILY BOND SWITCHGEAR NEUTRAL BUS TO GROUND BUS FOR LOAD BANK TESTING AND LEAVE IN PLACE.
- 4) AS PART OF ON-SITE WORK LEAVE NEUTRAL TO GROUND BUS BONDING JUMPER IN PLACE AS REQUIRED FOR LOAD BANK TESTING.
- 5) REMOVE JUMPER AFTER LOAD BANK TESTING AND PRIOR TO CONNECTING TO THE GRID FOR COMMISSIONING.

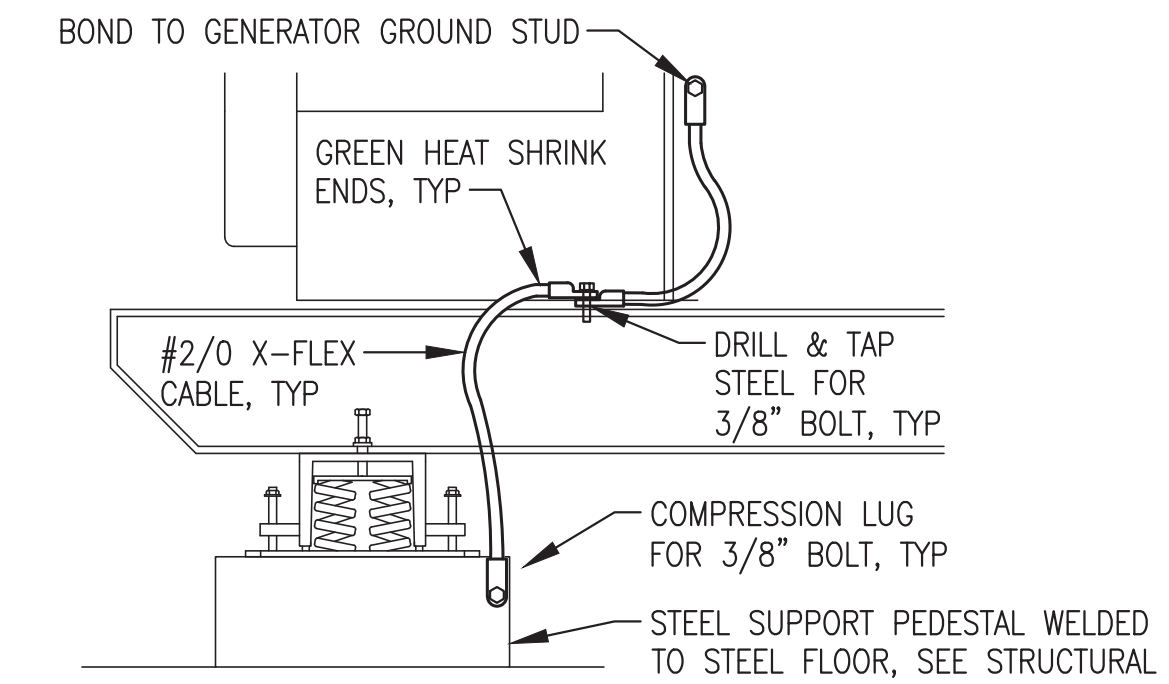


2
E2 GENERATOR GROUNDING
NO SCALE


ALL WORK ON THIS SHEET WAS PERFORMED AS PART OF THE PRIOR MODULE ASSEMBLY CONTRACT EXCEPT AS SPECIFICALLY INDICATED IN THE SHOP/ON SITE NOTES.


1
E2 MODULE GROUNDING PLAN
3/8"=1'-0"

ISSUED FOR
CONSTRUCTION
JULY 2022

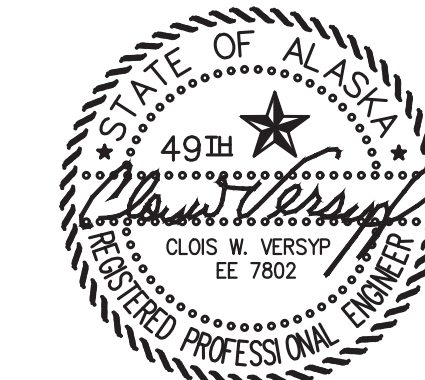


PROJECT: NAPASKIAK POWER SYSTEM UPGRADE		
TITLE: MODULE GROUNDING PLAN & DETAILS		
DRAWN BY: JTD	SCALE: AS NOTED	
DESIGNED BY: CWV/BCG	DATE: 7/29/22	
FILE NAME: NAPS PP E2-5	SHEET:	E2
PROJECT NUMBER:		
P.O. 111405, Anchorage, AK 99511 (907)349-0100		

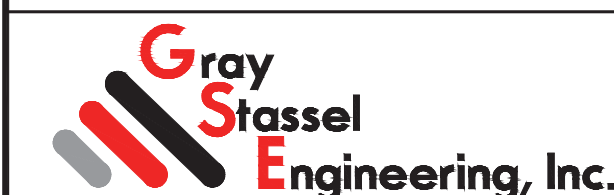


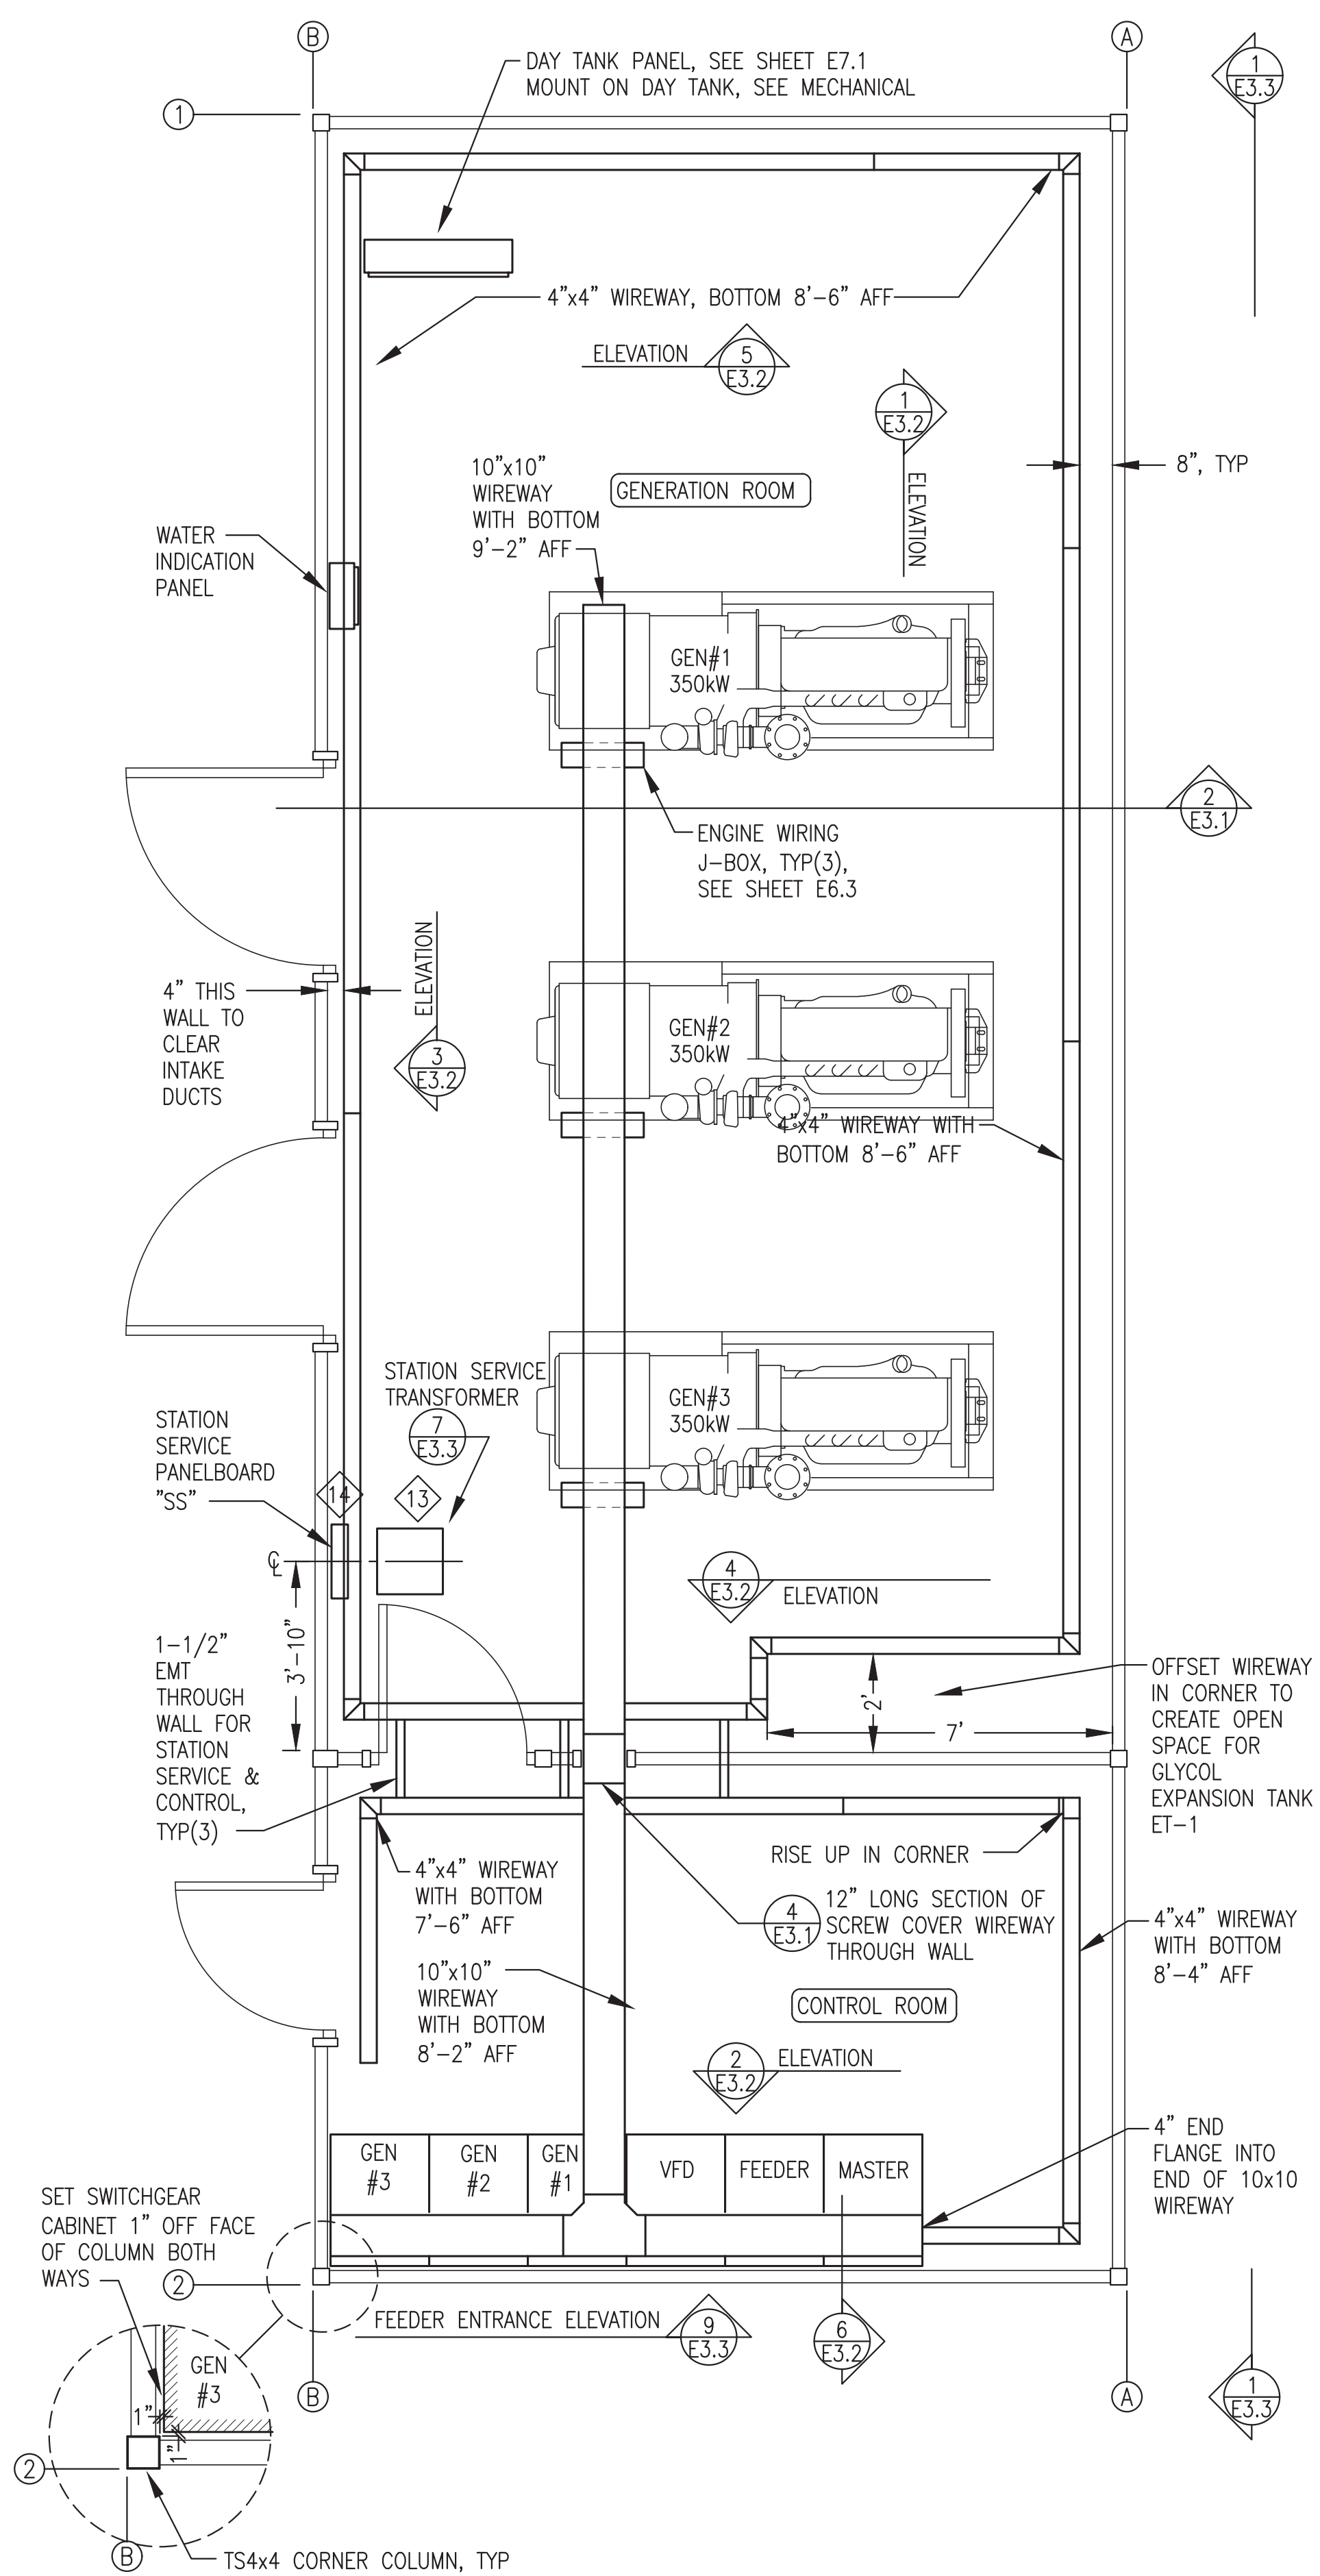

1 EQUIPMENT LAYOUT & WIREWAY PLAN
E3.1 3/8"=1'-0"

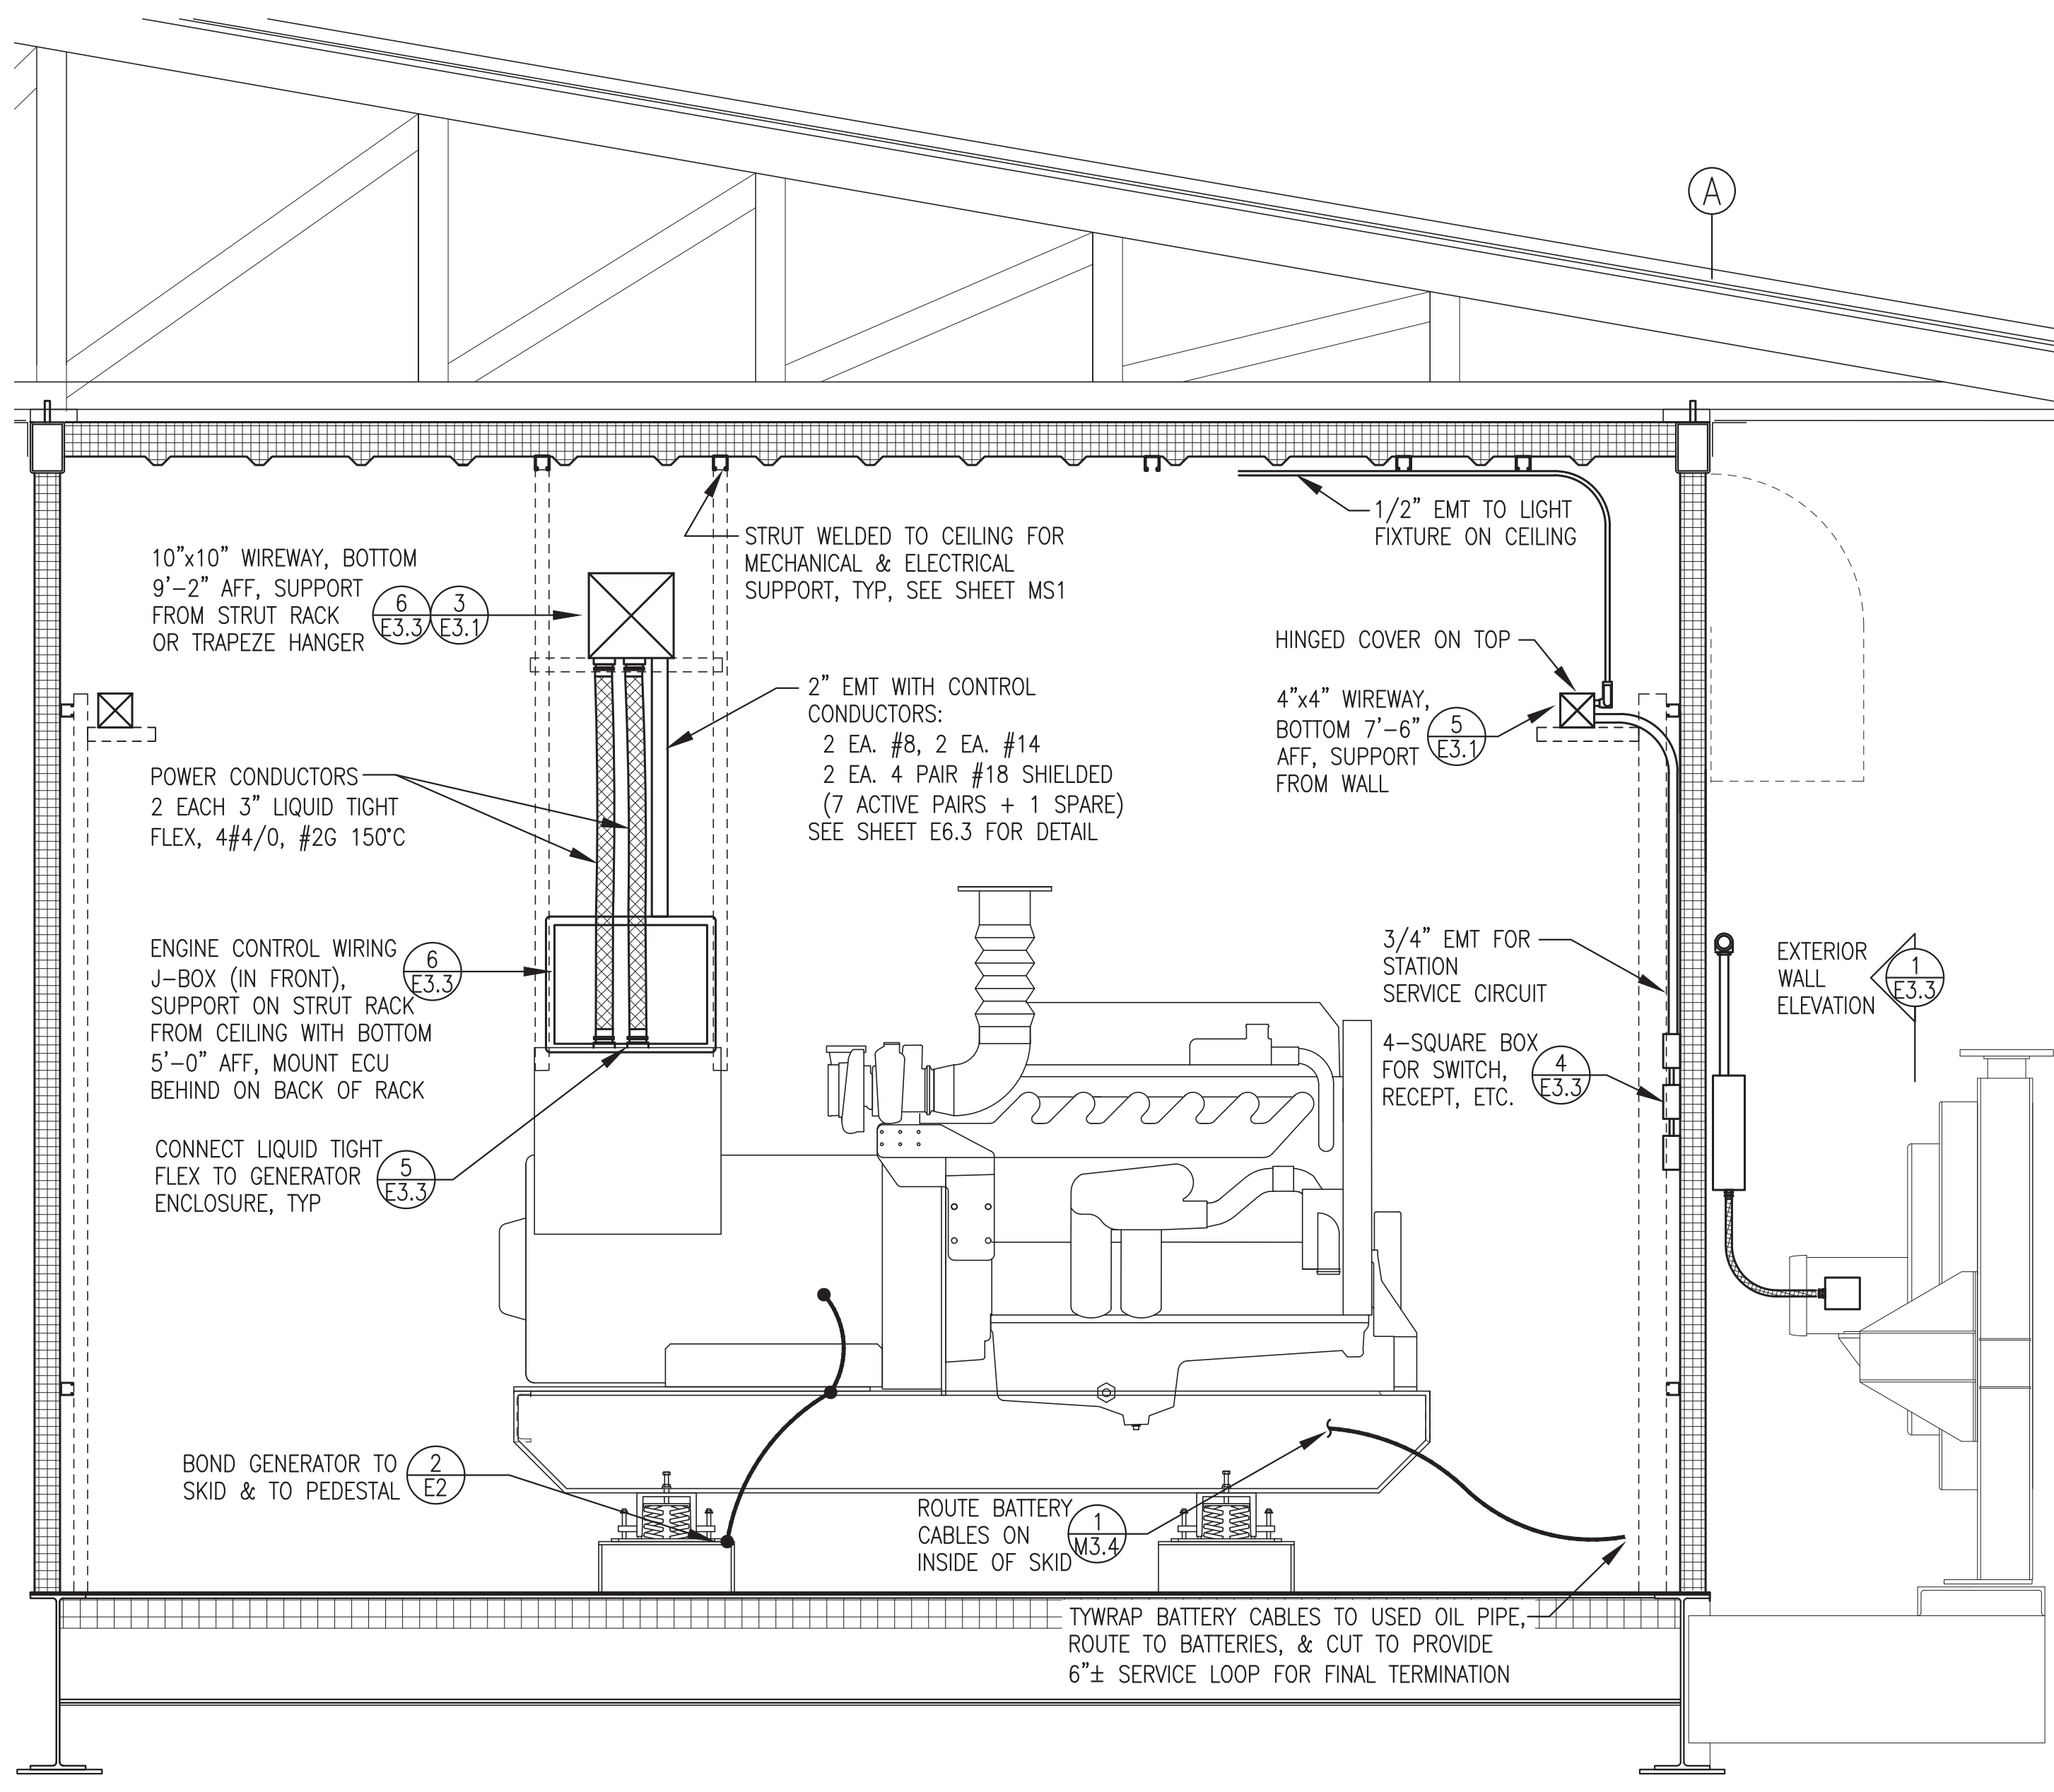


2 TYPICAL MODULE SECTION
E3.1 3/4"=1'-0"

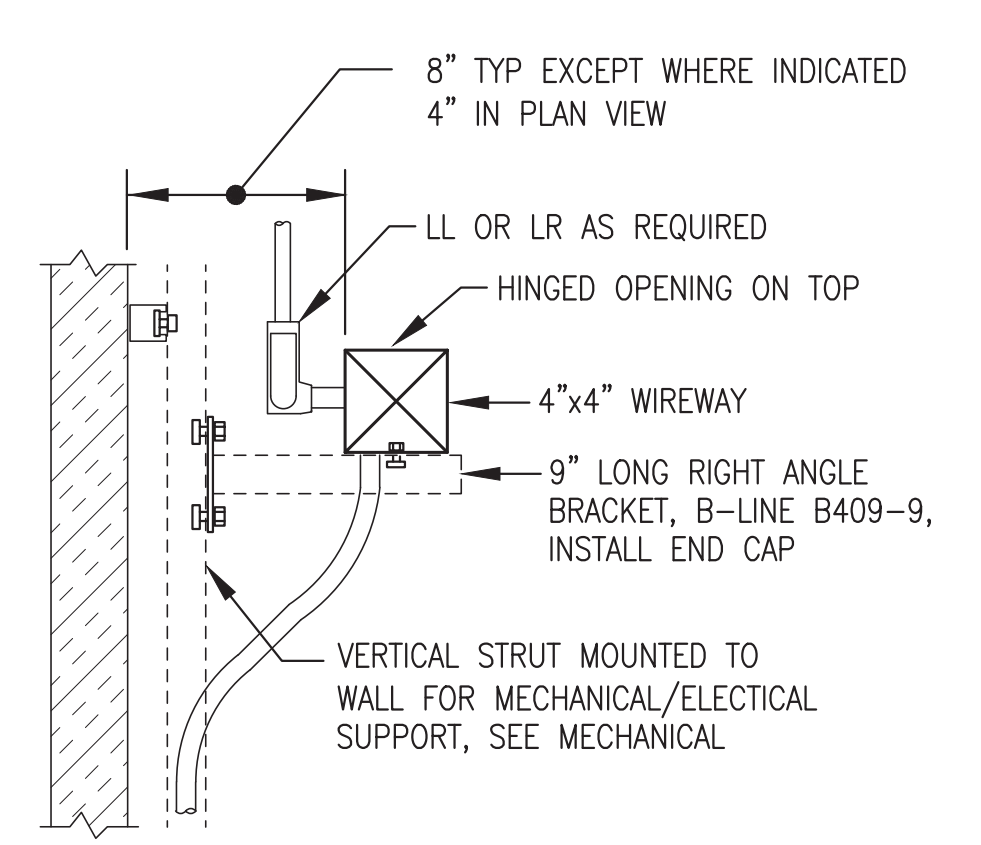

5 4" WIREWAY SUPPORT FROM WALL
E3.1 NO SCALE


ENGINE-GENERATOR SCHEDULE	
GENSET	DESCRIPTION
GEN #1, GEN #2, & GEN #3	ENGINE - 500 HP, 350 kW PRIME, MTU-DETROIT 6063TK35. 24 VDC STARTING & CONTROL. GENERATOR - MINIMUM 450 KW CONTINUOUS AT 105°C RISE, NEWAGE/STAMFORD HCI534D.

ISSUED FOR CONSTRUCTION
JULY 2022

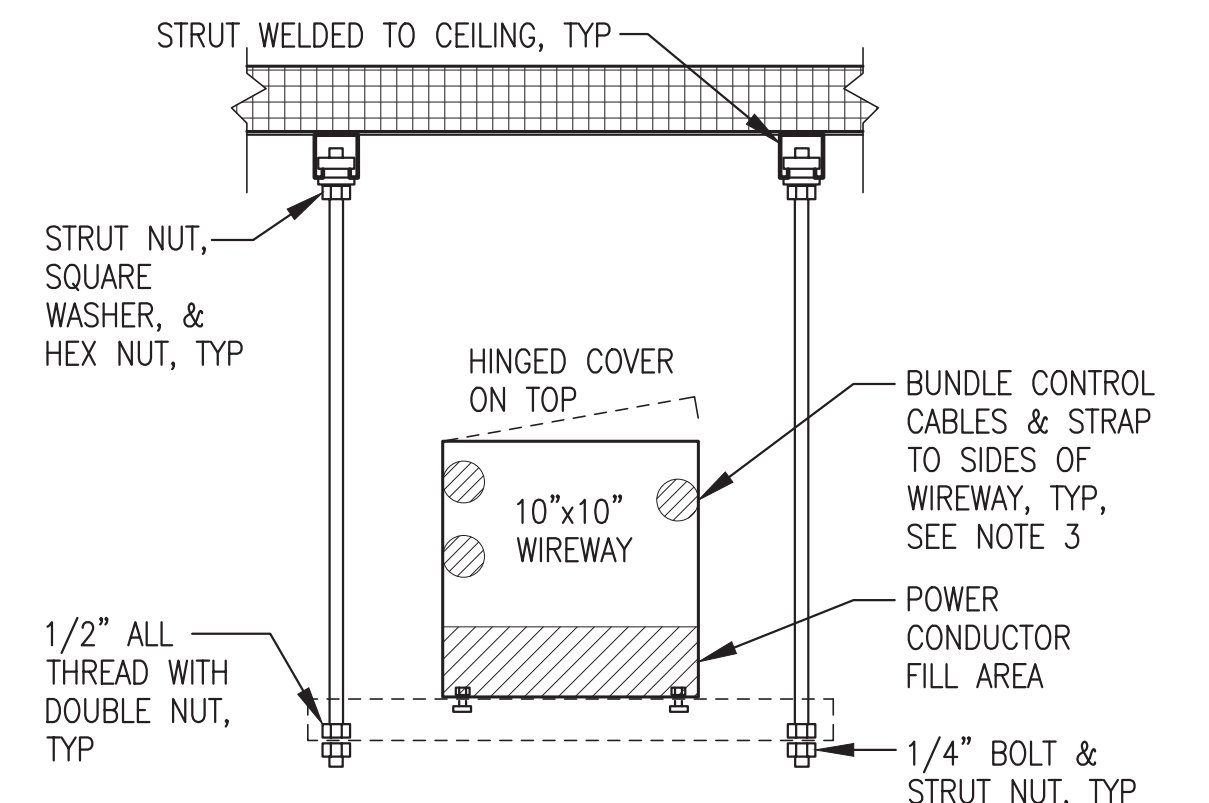

- NOTES:
1) INSTALL HANGER AT EACH JOINT & AT END.
2) HANGER NOT REQUIRED AT ENGINE J-BOX SUPPORT, SEE DETAIL 4/E4.3.
3) STRAP CABLES AT 5' O.C. MIN USING 3M 06292 OR EQUAL STICKY BACK BASES. FASTEN BASES TO WIREWAY SIDE WITH MACHINE BOLTS.

3 10" WIREWAY TRAPEZE HANGER
E3.1 NO SCALE

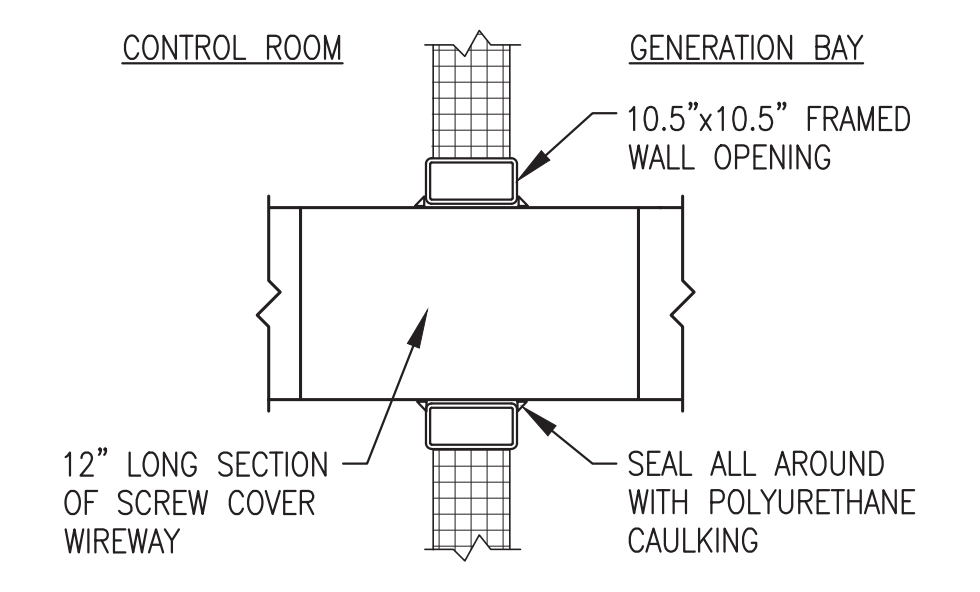

4 WIREWAY WALL PENETRATION
E3.1 NO SCALE

ALL WORK ON THIS SHEET WAS PERFORMED AS PART OF THE PRIOR MODULE FABRICATION CONTRACT AND IS SHOWN HERE FOR REFERENCE ONLY.


ALASKA ENERGY AUTHORITY

PROJECT: **NAPASKIAK POWER SYSTEM UPGRADE**


TITLE: **WIREWAY PLAN, BUILDING SECTION, & DETAILS**

DRAWN BY: JTD	SCALE: AS NOTED
DESIGNED BY: CWV/BCG	DATE: 7/29/22
FILE NAME: NAPS PP E2-5	SHEET: E3.1
PROJECT NUMBER:	

Gray Stassel Engineering, Inc.
P.O. 111405, Anchorage, AK 99511 (907)349-0100

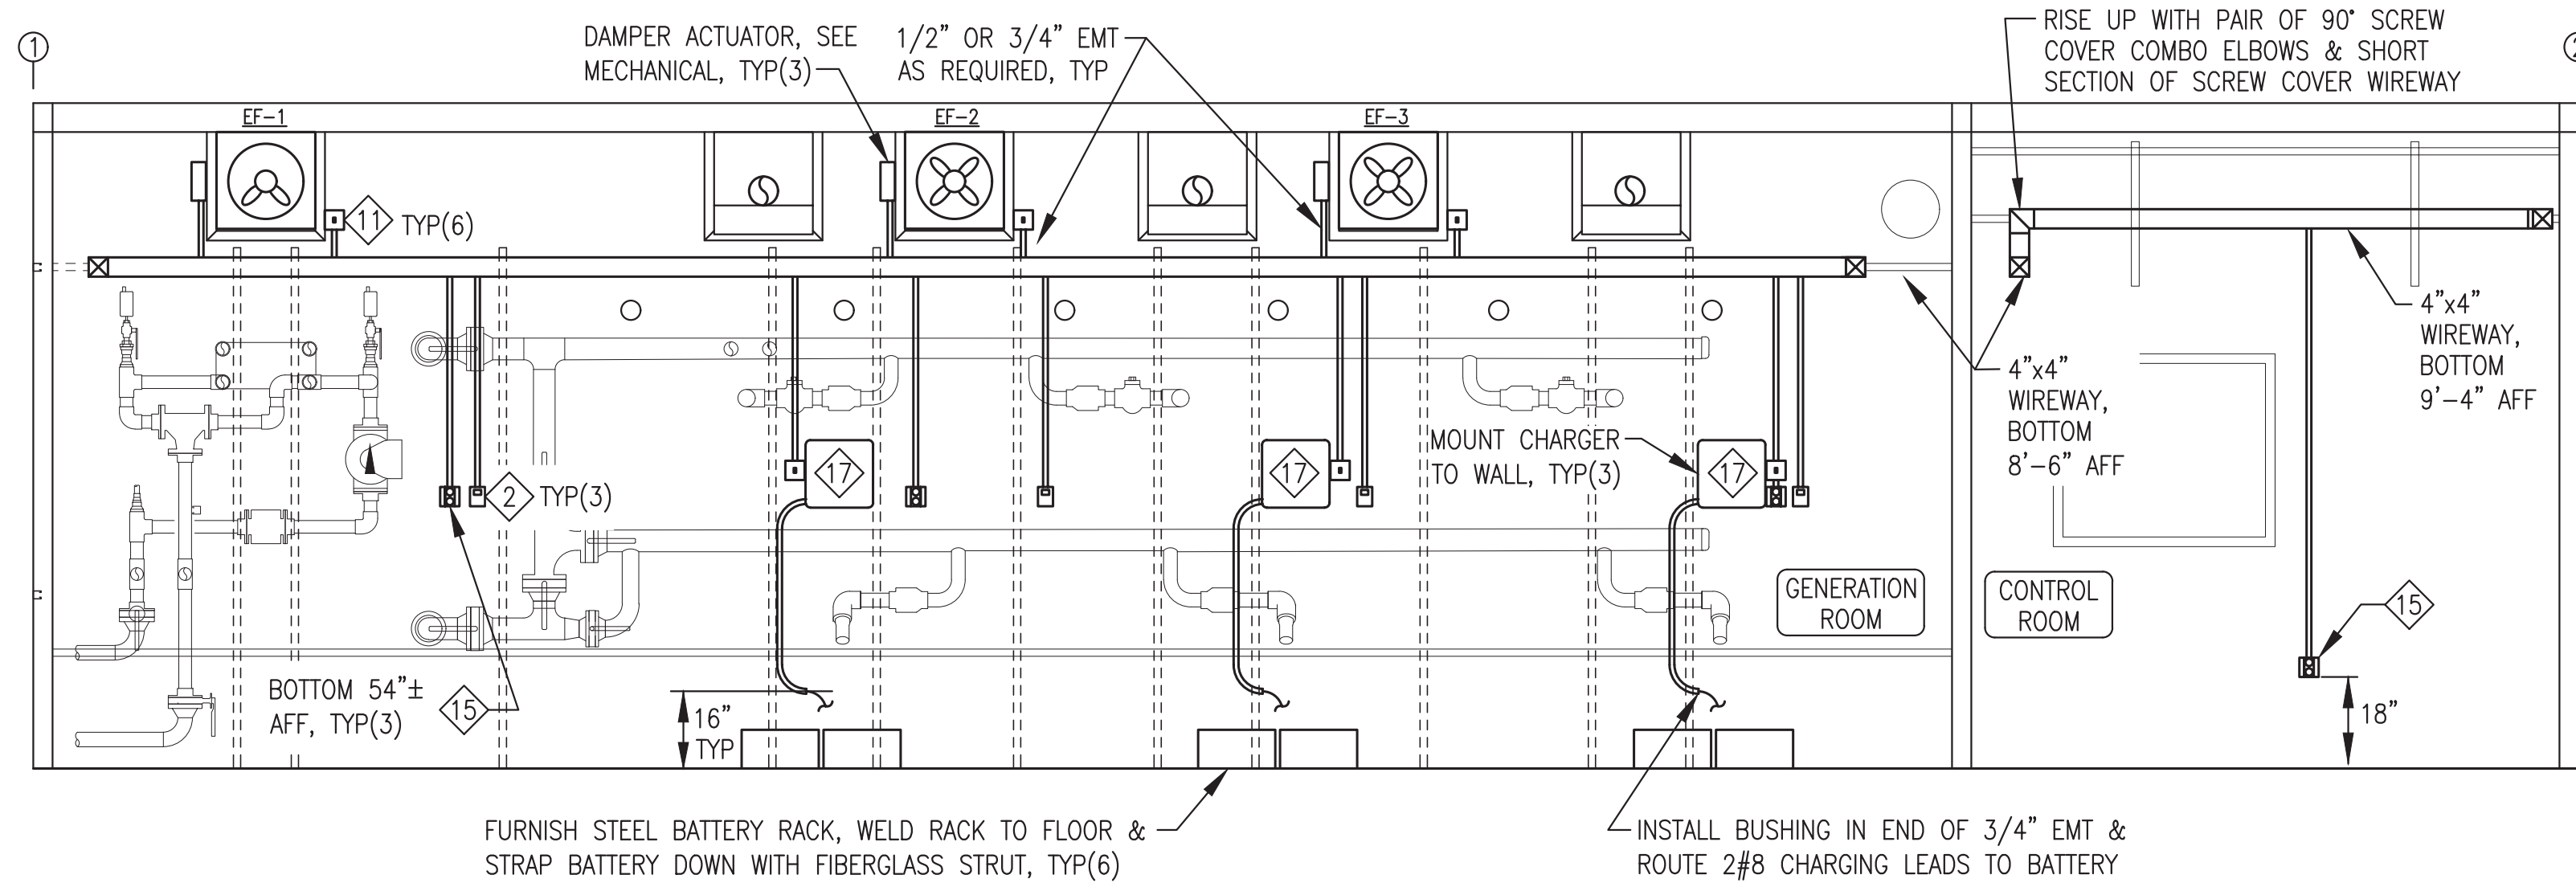


1 WALL ELEVATION AT GRID A
E3.2 3/8"=1'-0"

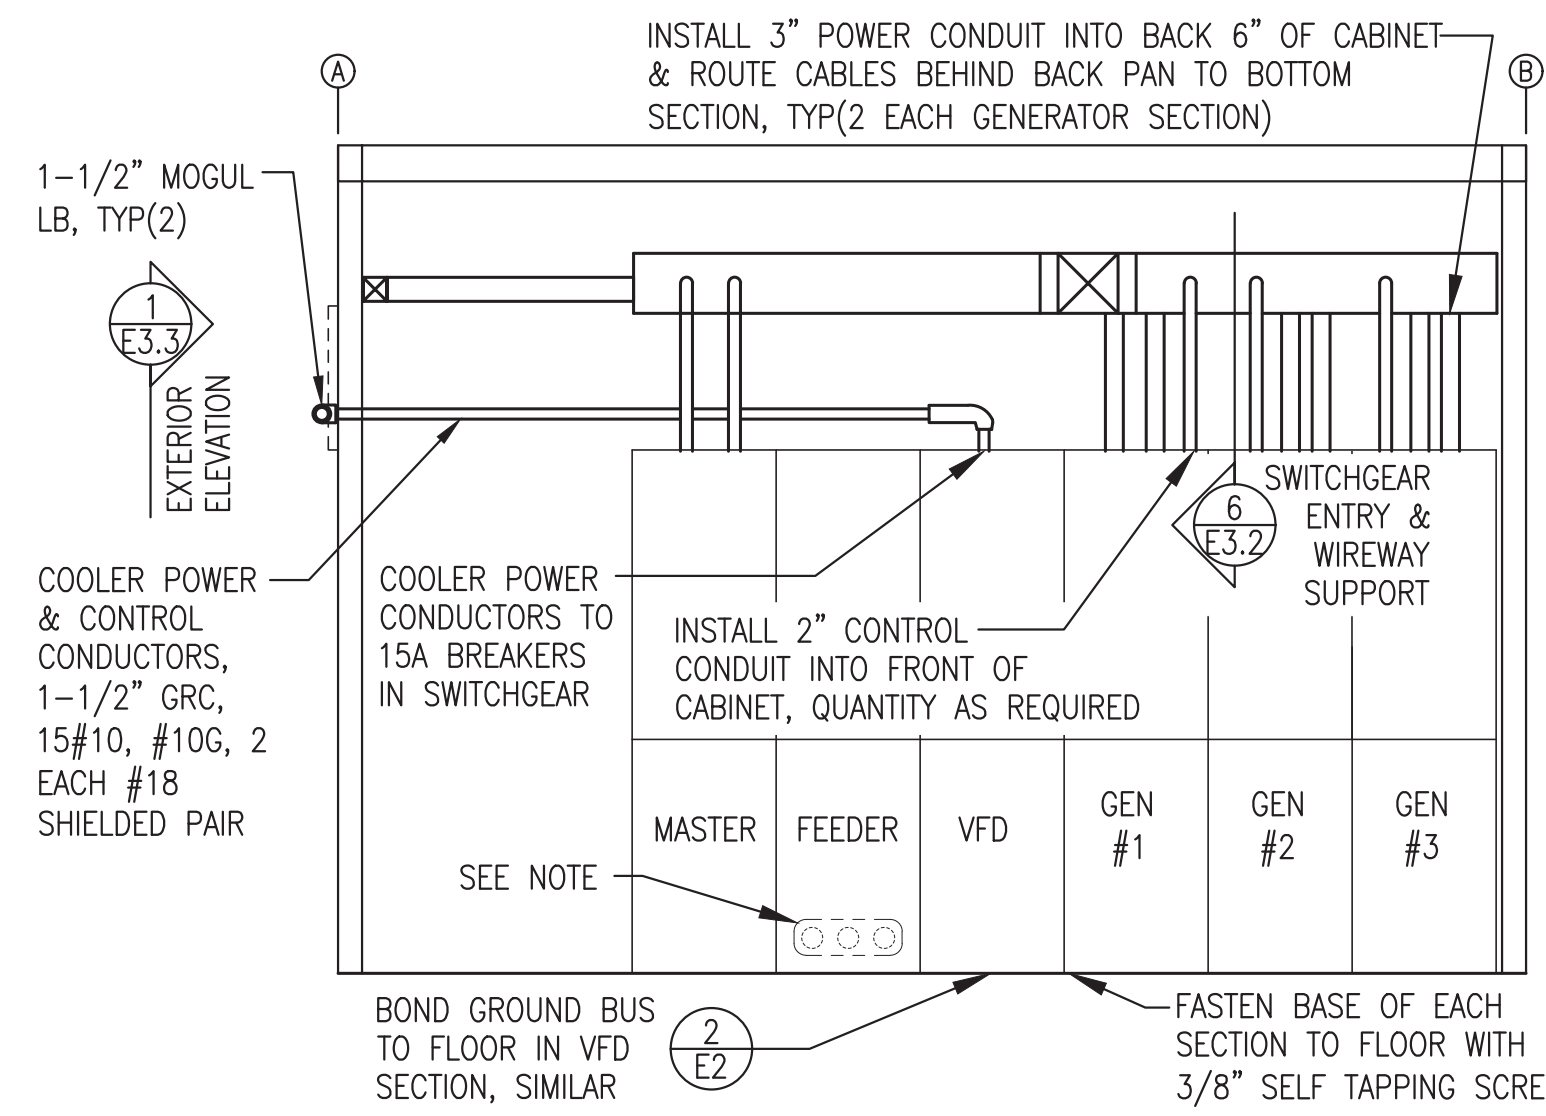


NOTE:
CENTER OPENING IN BACK OF FEEDER SECTION OVER THREE STEEL NIPPLES SHOP WELDED IN WALL FOR FEEDER CABLE ENTRANCE. SEE DETAIL 9/E3.3.

2 WALL ELEVATION AT GRID 2
E3.2 3/8"=1'-0"

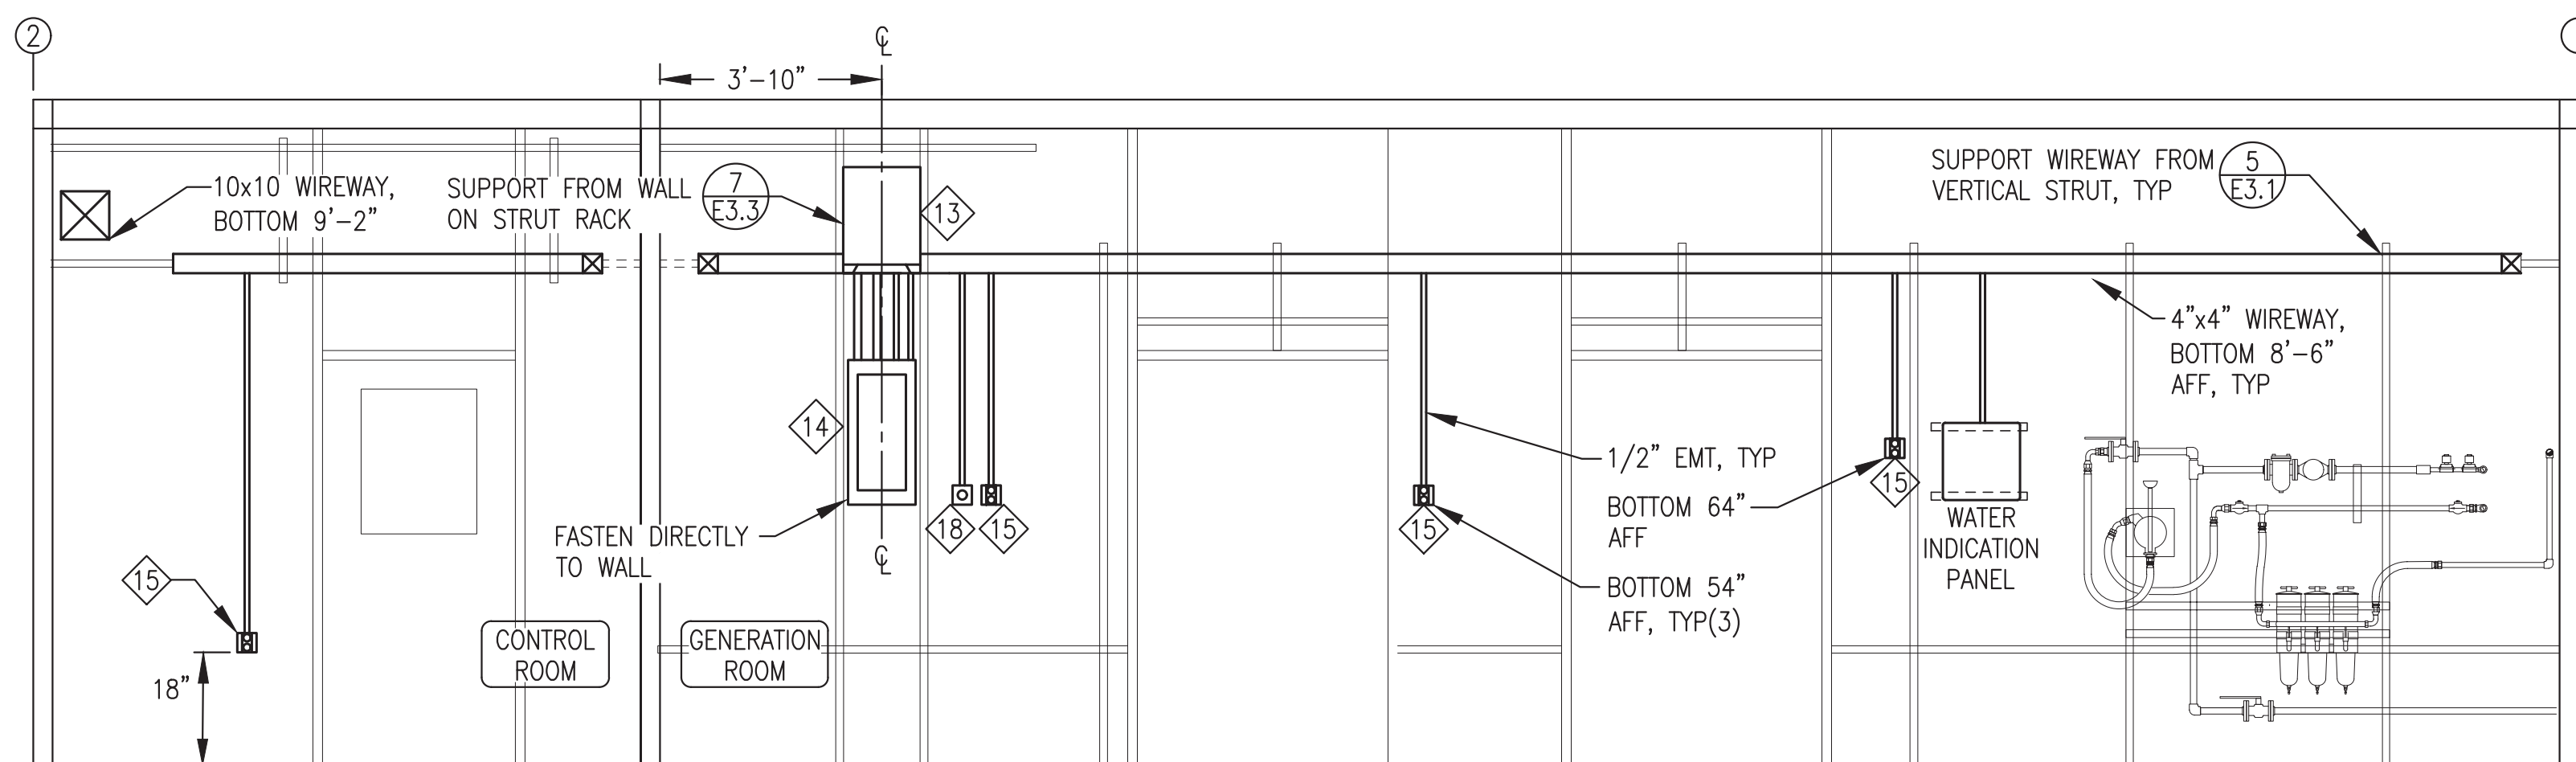


3 WALL ELEVATION AT GRID B
E3.2 3/8"=1'-0"

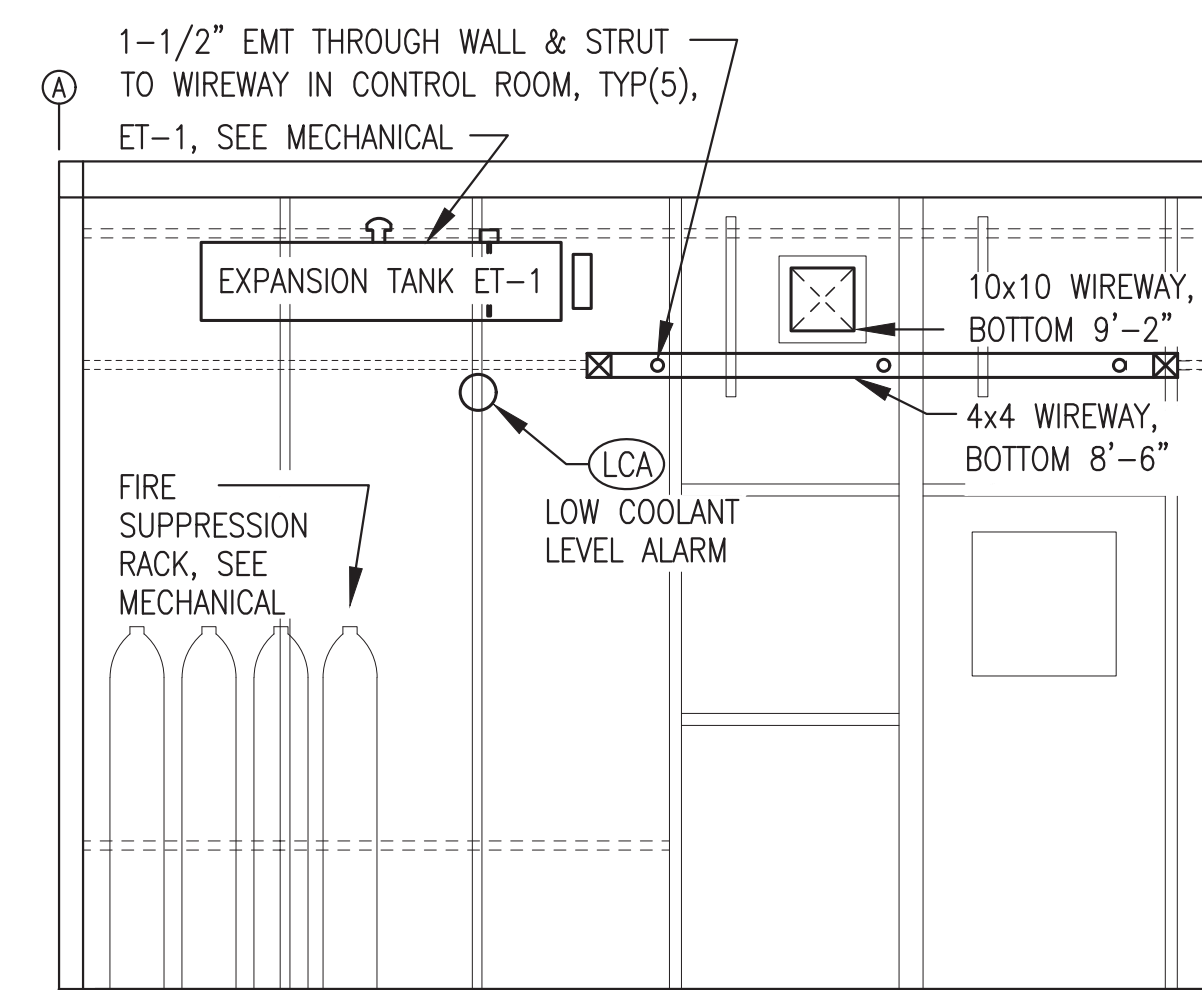


GENERAL NOTE:
WALL ELEVATIONS SHOWN PRIMARILY FOR GENERAL LAYOUT OF MAJOR RACEWAY, EQUIPMENT, AND DEVICES REQUIRING REGULAR ACCESS FOR NORMAL DAILY PLANT OPERATIONS. ALL EQUIPMENT, DEVICES & INSTRUMENTATION CIRCUITS NOT SHOWN FOR CLARITY. SEE PLANS & DETAILS FOR COMPLETE ELECTRICAL INSTALLATIONS.

4 INTERIOR WALL ELEVATION
E3.2 3/8"=1'-0"

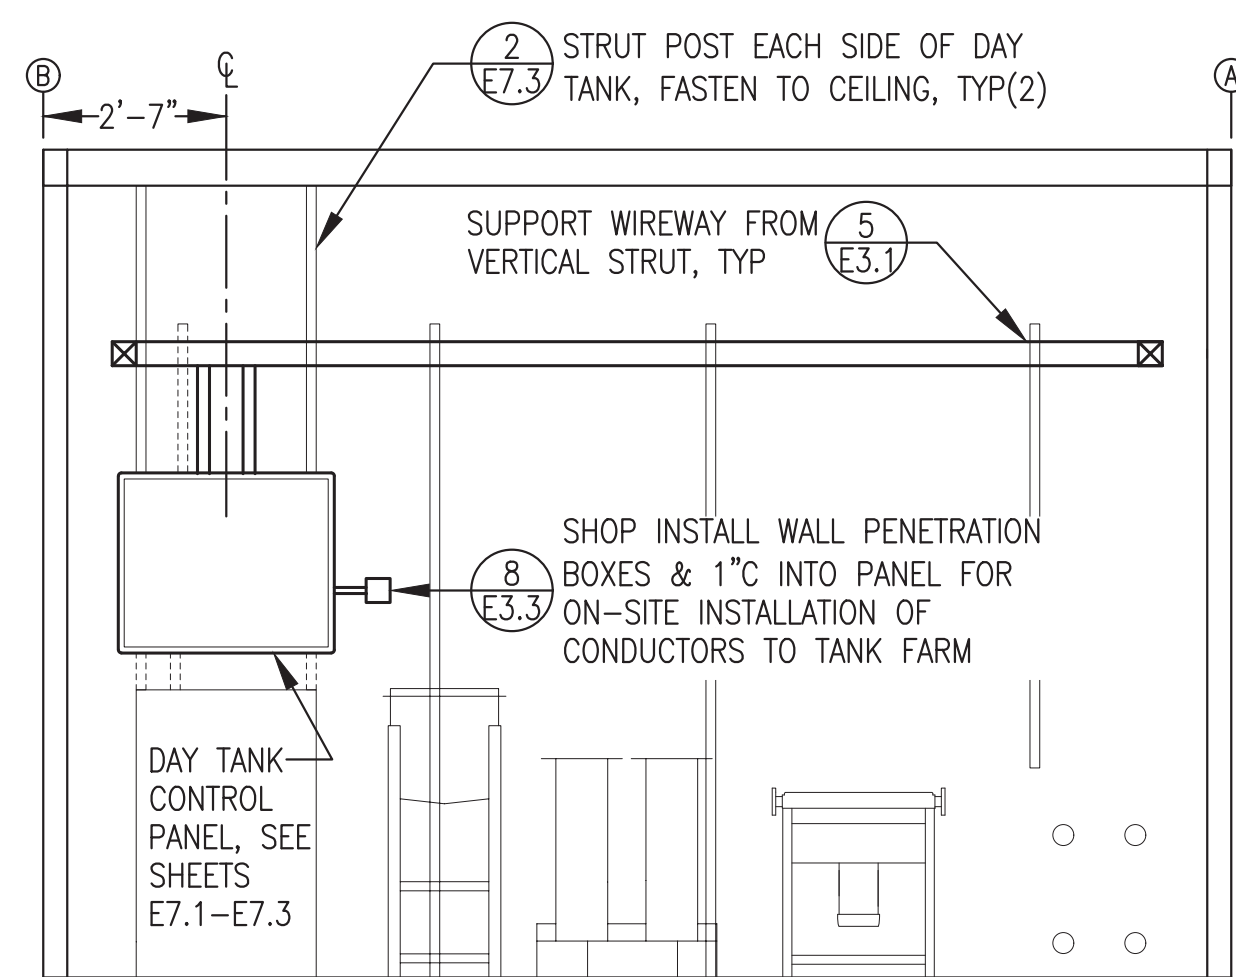


5 WALL ELEVATION AT GRID 1
E3.2 3/8"=1'-0"

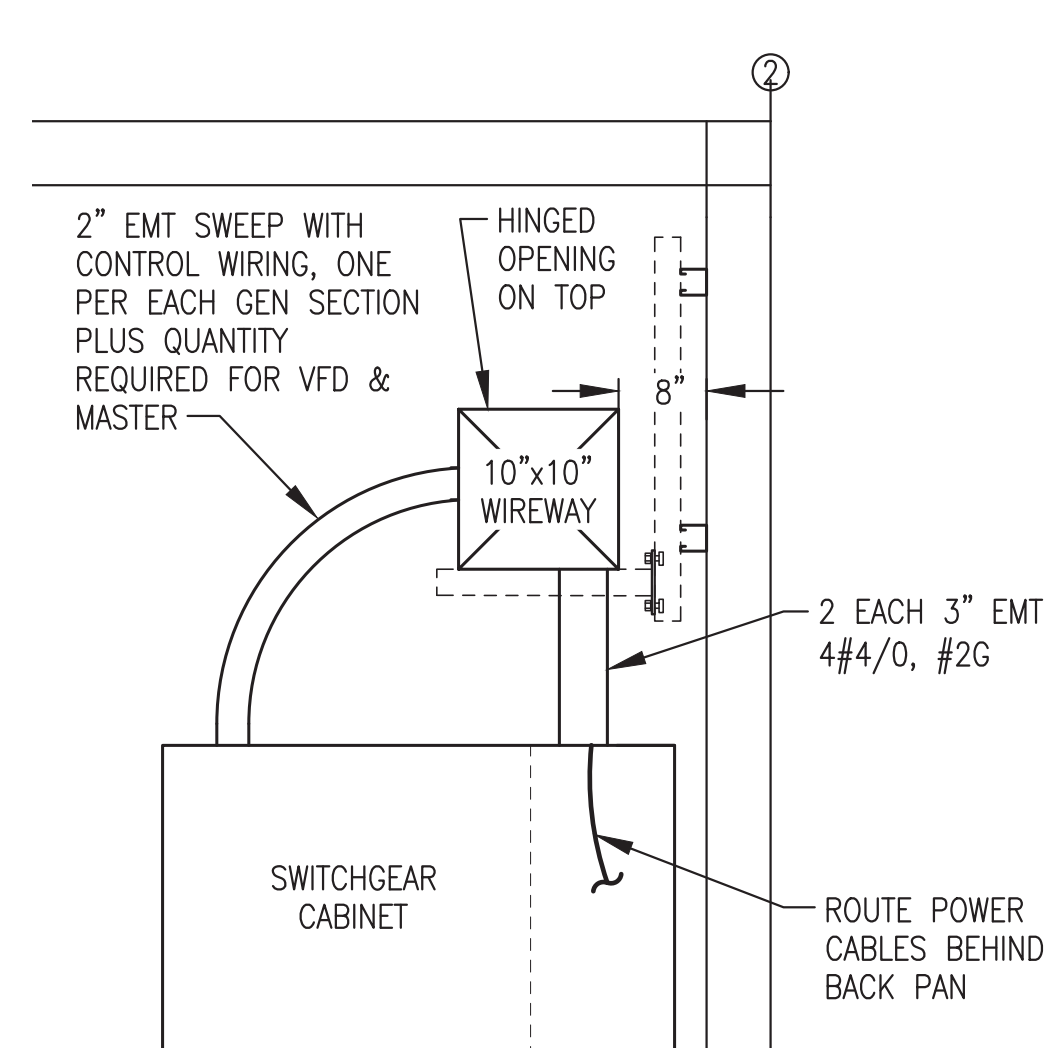

6 SWITCHGEAR ENTRY & WIREWAY SUPPORT
E3.2 NO SCALE


ALL WORK ON THIS SHEET WAS PERFORMED AS PART OF THE PRIOR MODULE FABRICATION CONTRACT AND IS SHOWN HERE FOR REFERENCE ONLY.

ISSUED FOR CONSTRUCTION
JULY 2022

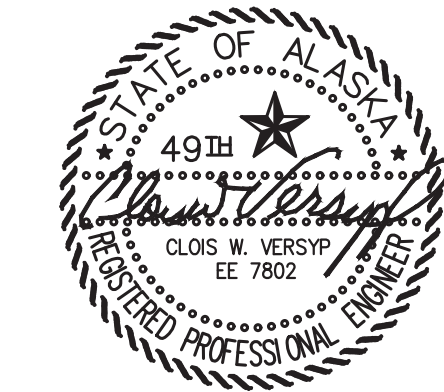


PROJECT: NAPASKIAK POWER SYSTEM UPGRADE	
TITLE: ELEVATIONS & DETAILS	
DRAWN BY: JTD	SCALE: AS NOTED
DESIGNED BY: CWV/BCG	DATE: 7/29/22
FILE NAME: NAPS PP E2-5	SHEET: E3.2
PROJECT NUMBER:	




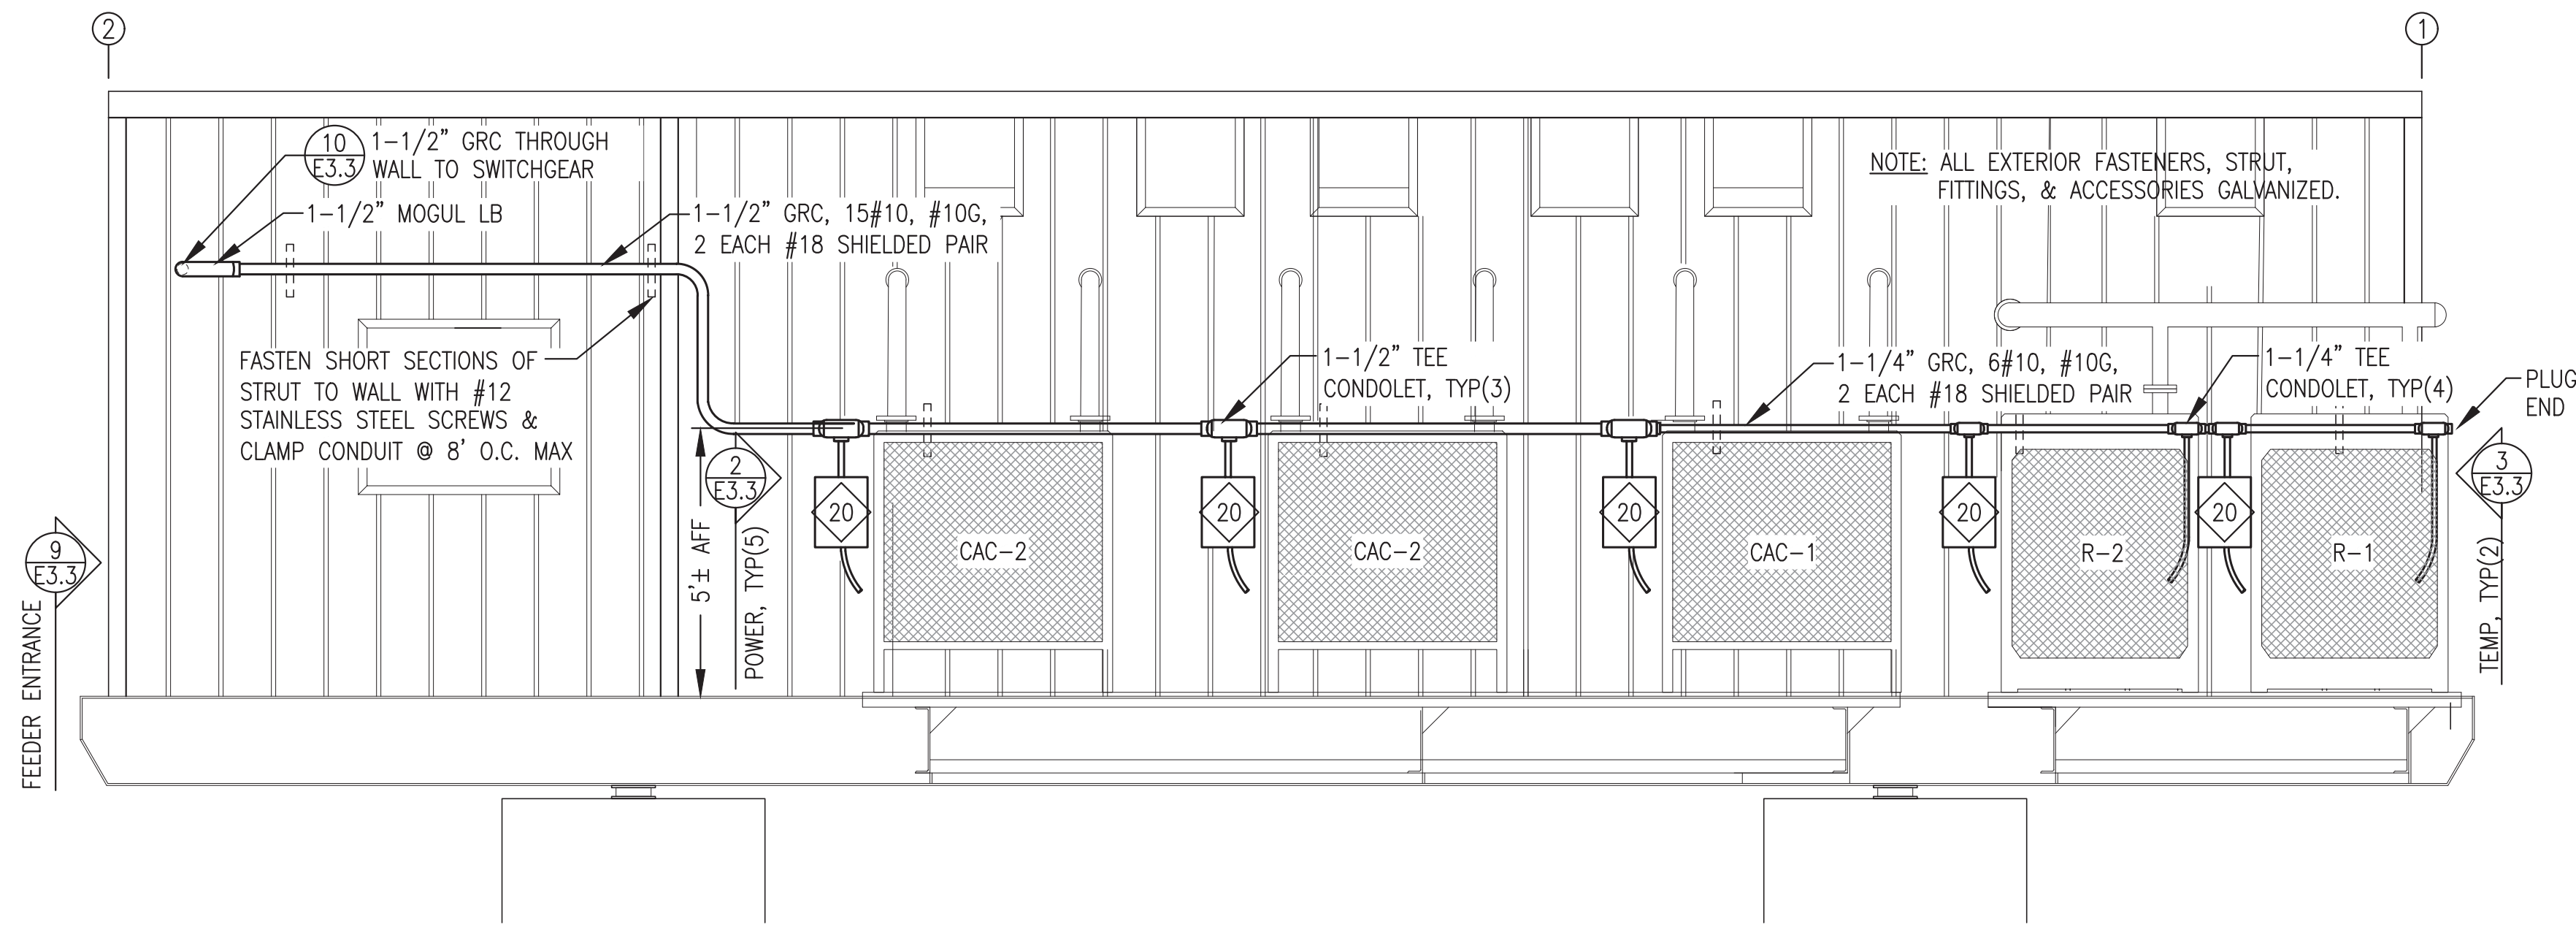

1 BACK WALL EXTERIOR ELEVATION
E3.3 3/8"=1'-0"

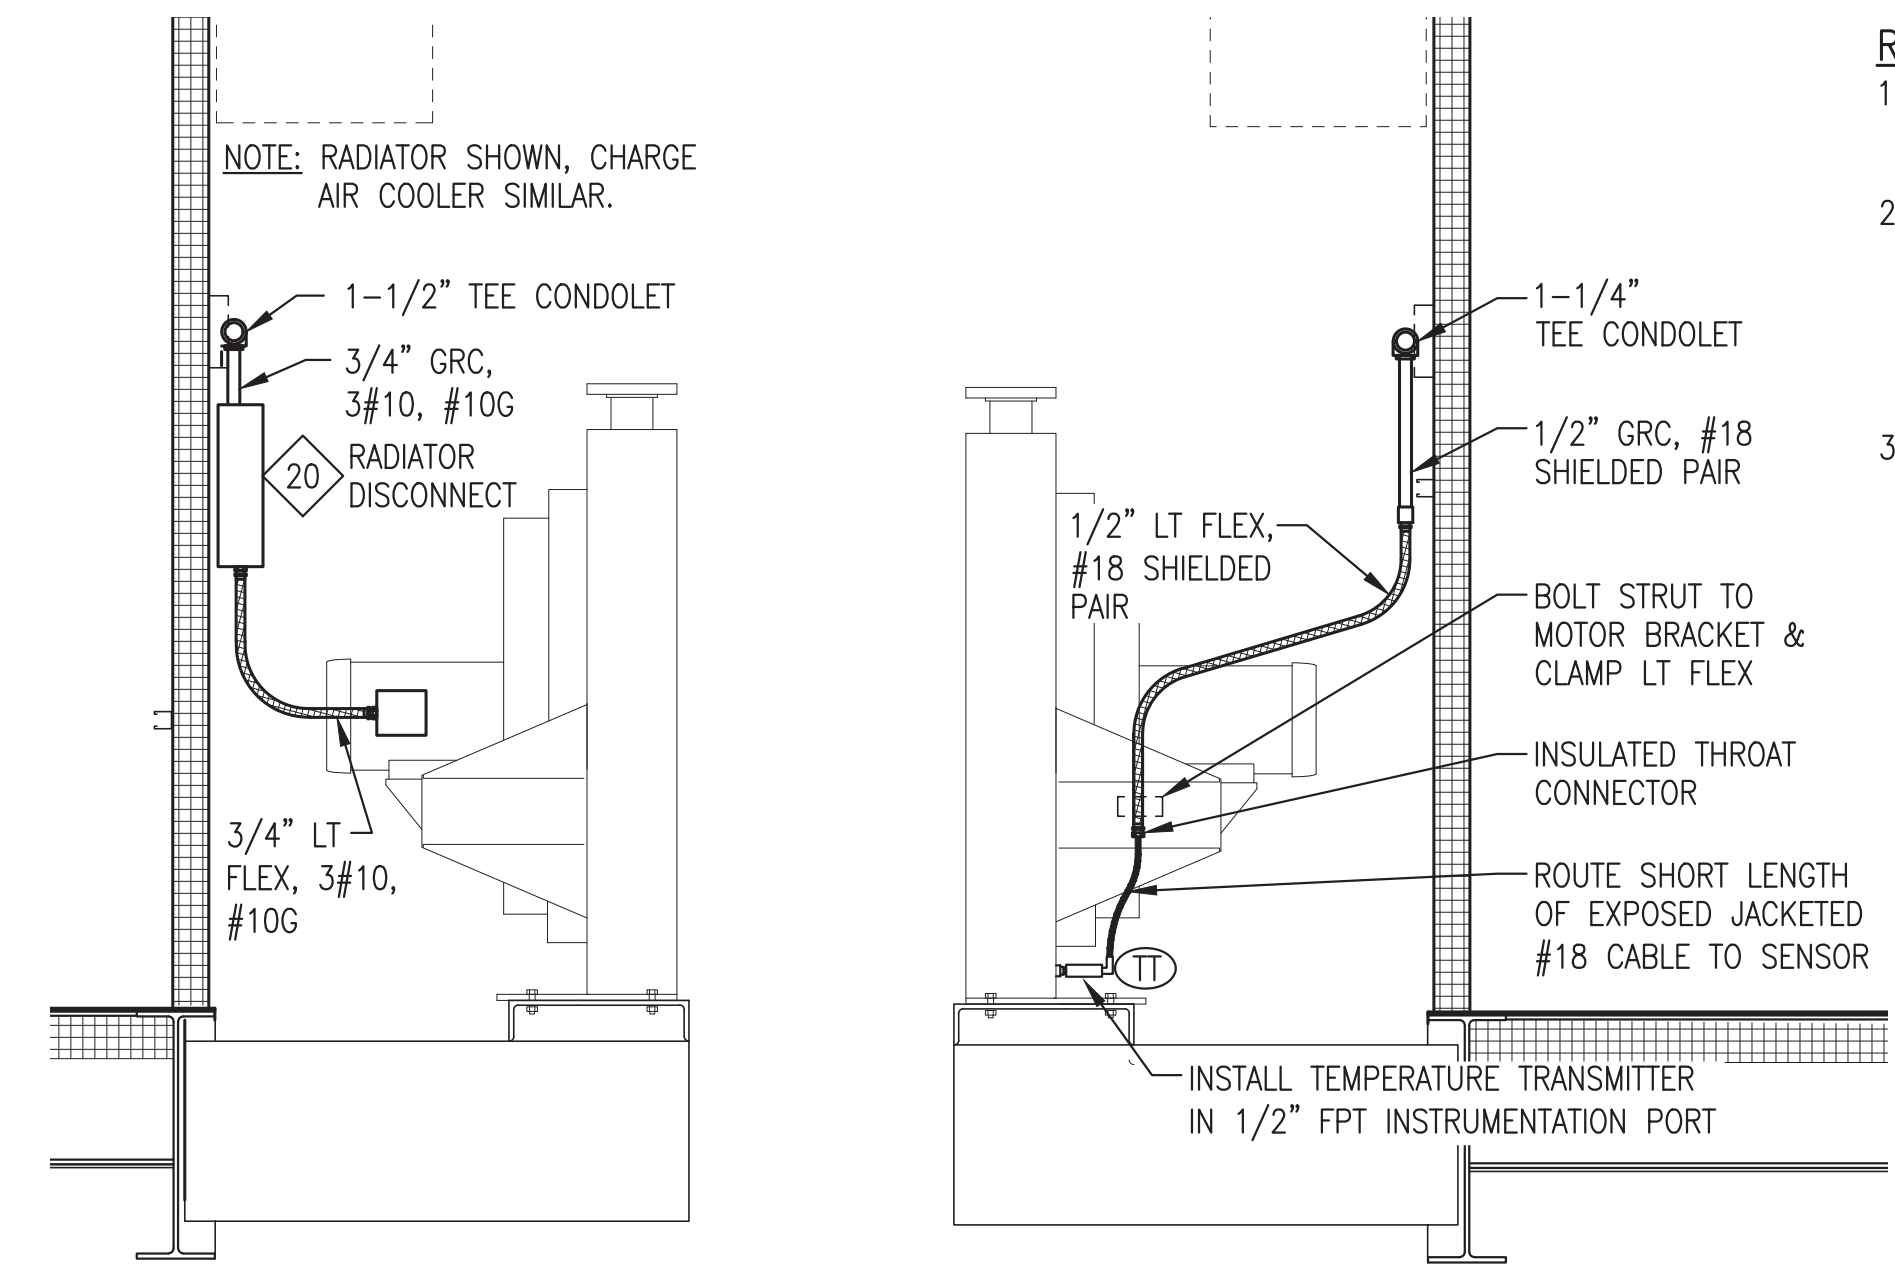


2 RADIATOR POWER CONNECTION
E3.3 3/4"=1'-0"

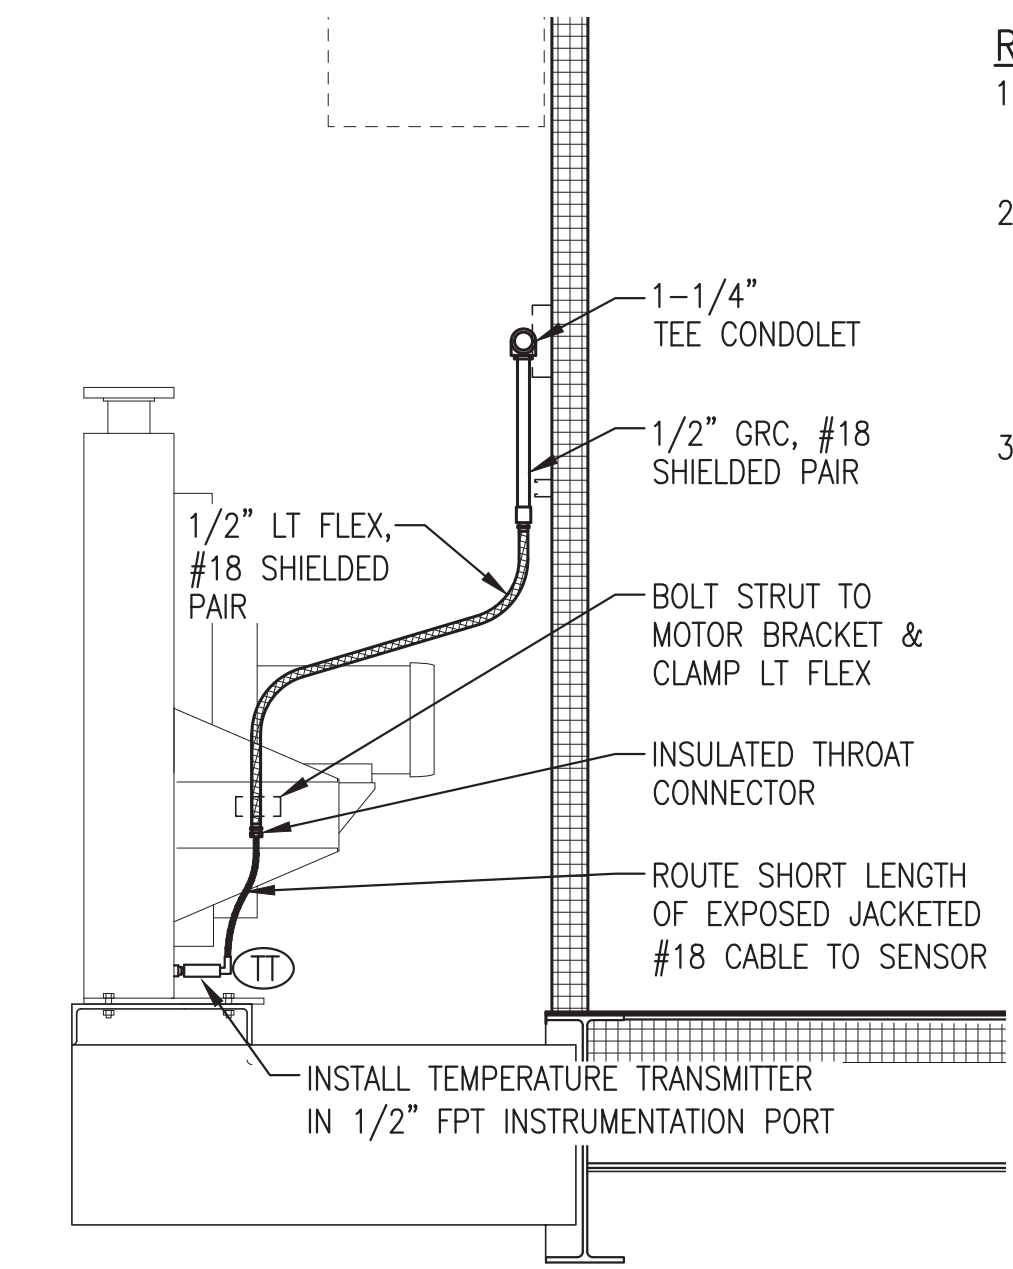


3 RADIATOR TEMPERATURE TRANSMITTER
E3.3 3/4"=1'-0"

RADIATOR SHOP/ON-SITE NOTES:
 1) DURING SHOP FABRICATION INSTALL ALL DEVICES AND RACEWAYS AS INDICATED.
 2) AS PART OF ON-SITE WORK, IF RADIATORS ARE REMOVED FOR SHIPPING DISCONNECT LIQUID TIGHT FLEXES AND SEAL ENDS. COIL AND SECURE CONDUCTORS AND FLEXES FOR SHIPPING.
 3) AS PART OF ON-SITE WORK REINSTALL AS INDICATED.

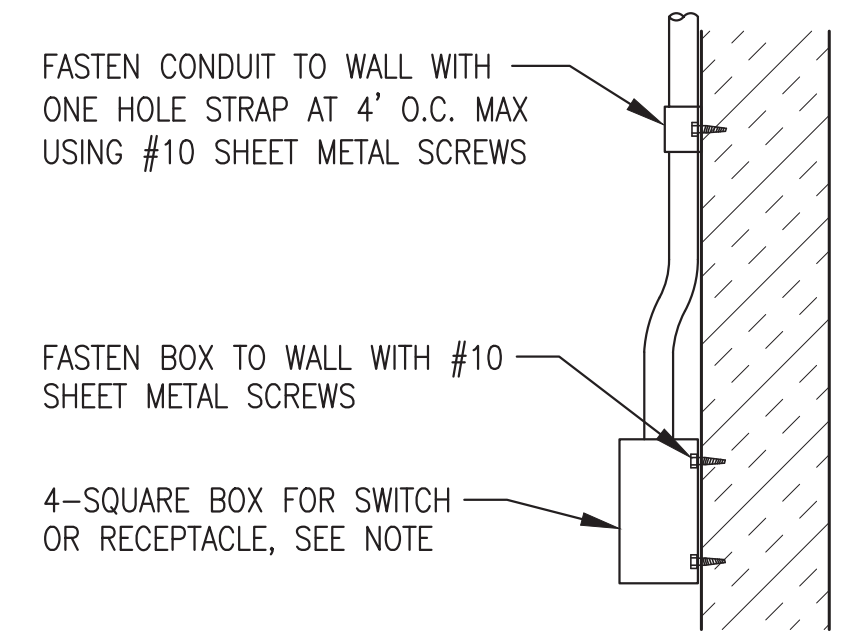


4 TYPICAL INTERIOR DEVICE MOUNTING
E3.3 NO SCALE

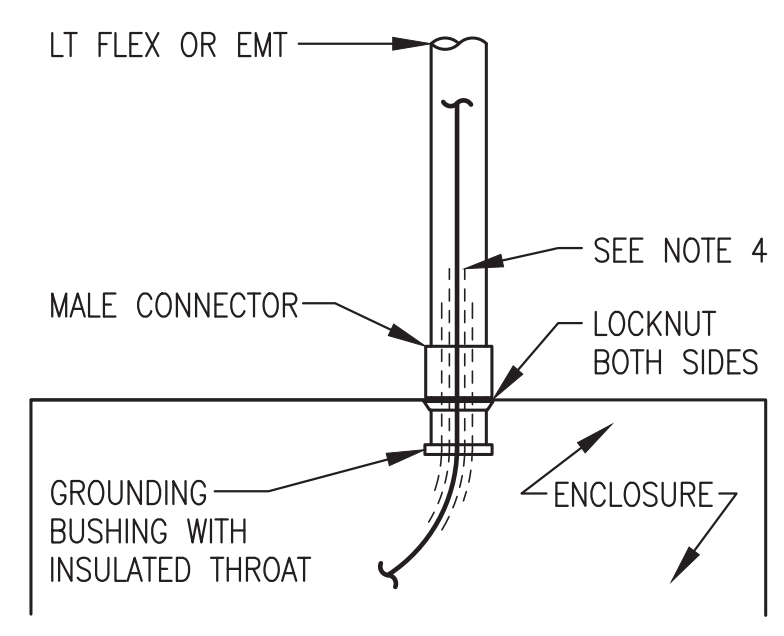


5 TYP ENCLOSURE CONNECTION
E3.3 NO SCALE


NOTES:
 1) THIS DETAIL APPLIES TO CONNECTIONS TO WIREWAY, GENERATOR ENCLOSURES, SWITCHGEAR, AND PANELS.
 2) AT A MINIMUM INSTALL GROUNDING BUSHING ON ALL GENERATOR POWER CONDUIT, COMMUNITY FEEDER CONDUIT, STATION SERVICE FEEDERS, AND WHERE OTHERWISE INDICATED OR REQUIRED. BOND GROUNDING BUSHING TO EQUIPMENT GROUNDING CONDUCTOR.
 3) INSTALL PLASTIC BUSHING WHERE GROUNDING BUSHING IS NOT REQUIRED.
 4) ON GENERATOR ENCLOSURES PROTECT CABLES FROM WEAR BY INSTALLING 2 LAYERS OF HEAVY WALL HEAT SHRINK. BASE LAYER 12" LONG & SECOND LAYER 8" LONG, CENTERED IN CONNECTOR.

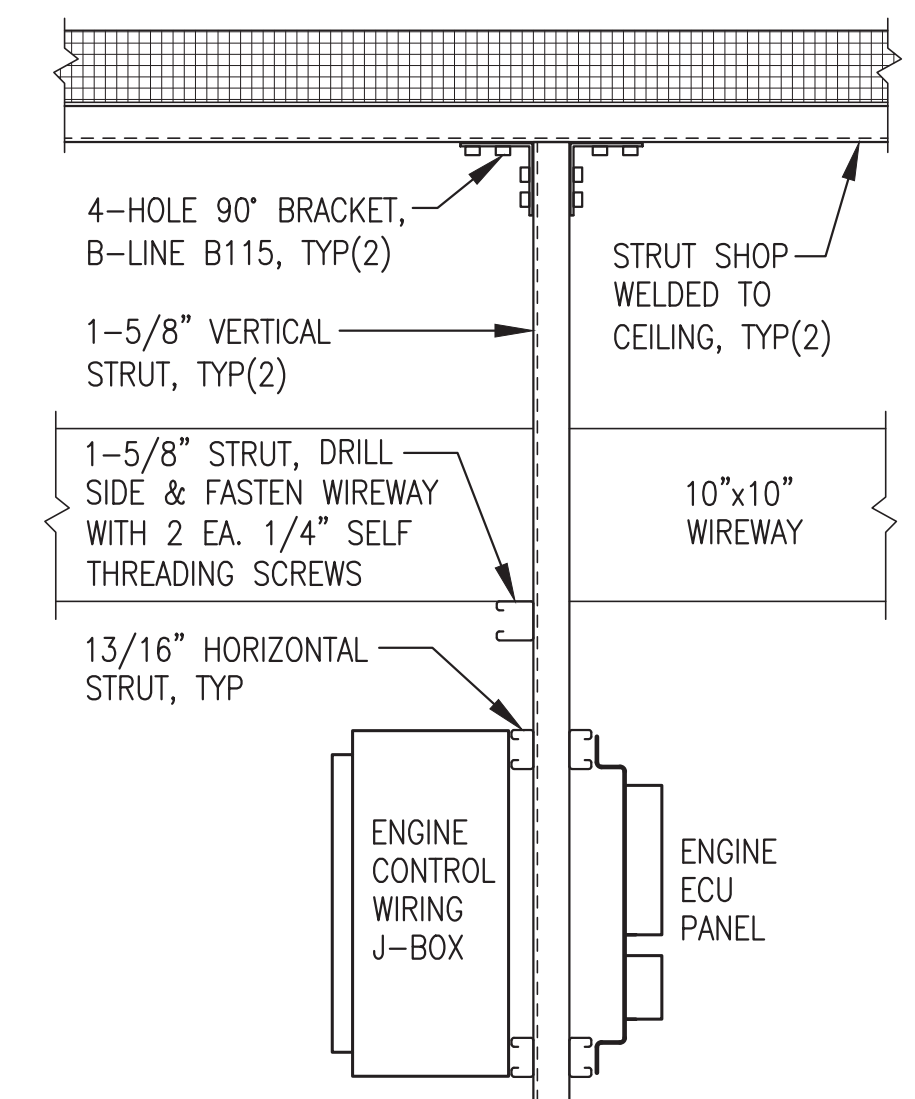


6 ENGINE WIRING J-BOX SUPPORT
E3.3 NO SCALE

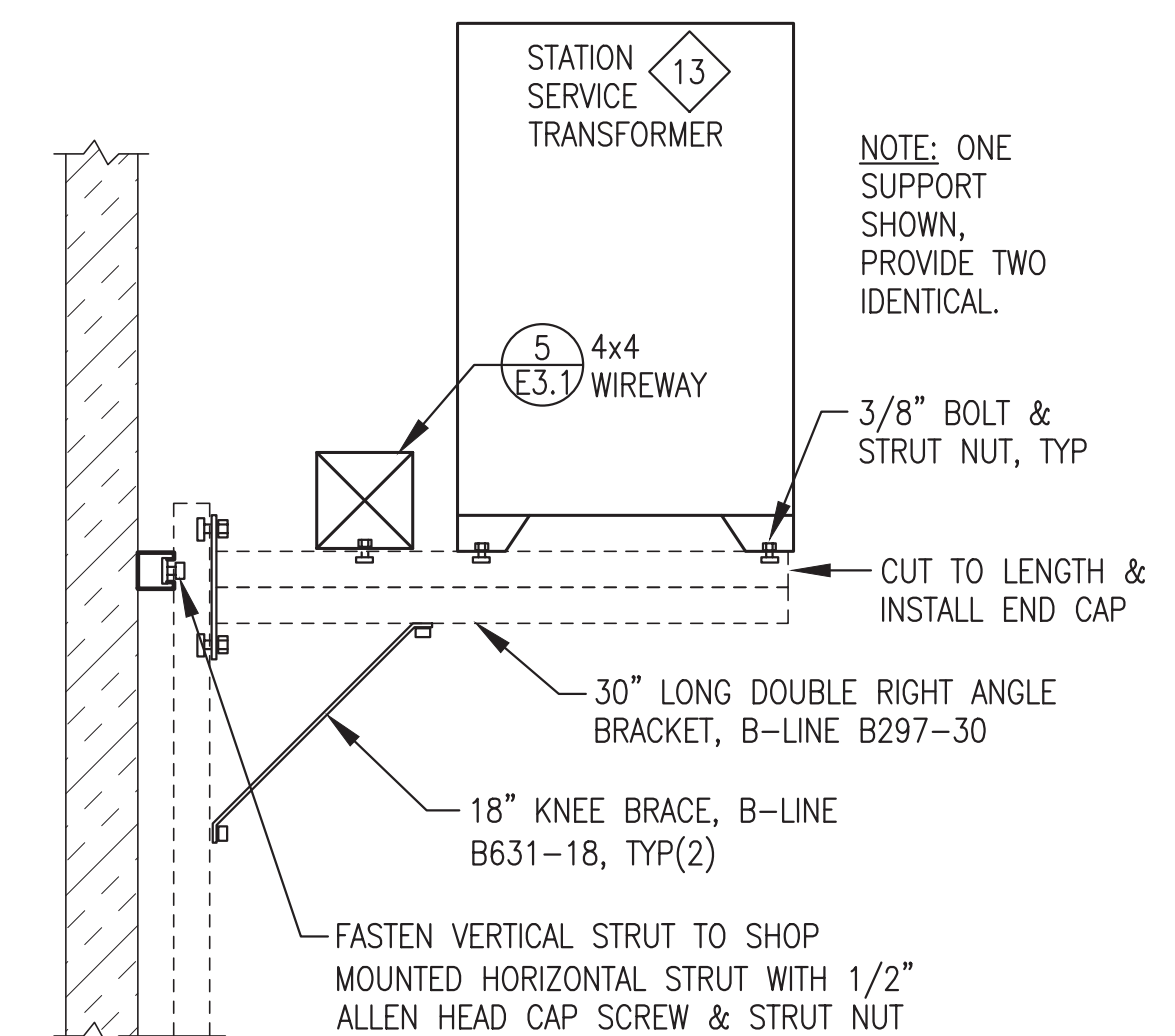


7 STATION SERVICE TRANSFORMER SUPPORT
E3.3 NO SCALE

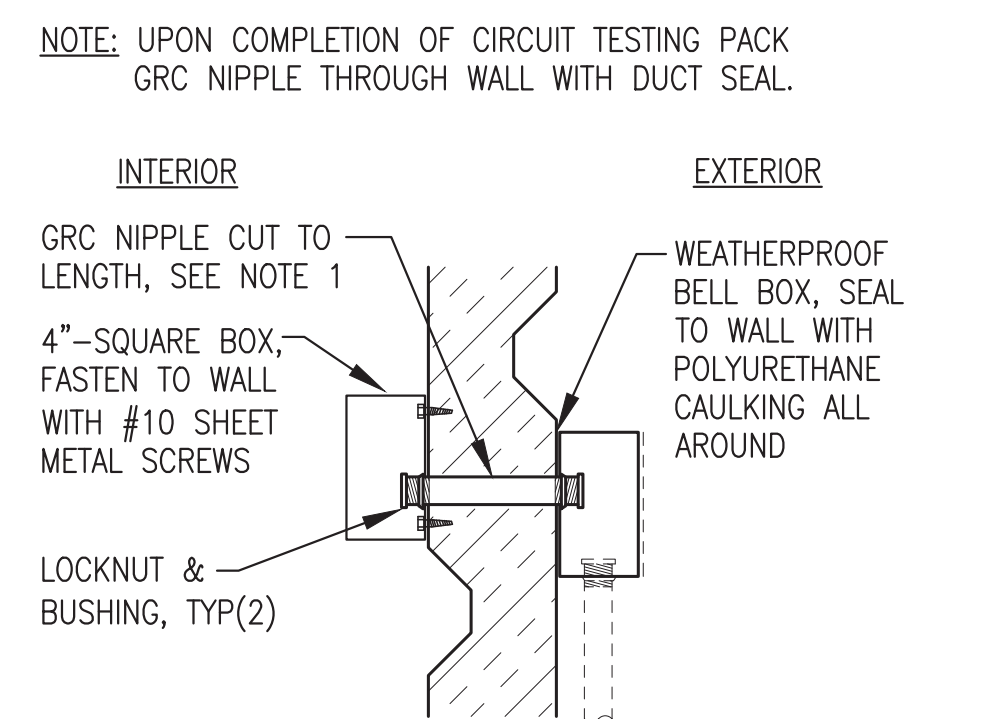

8 TYP EXTERIOR WALL-MOUNT DEVICE
E3.3 NO SCALE

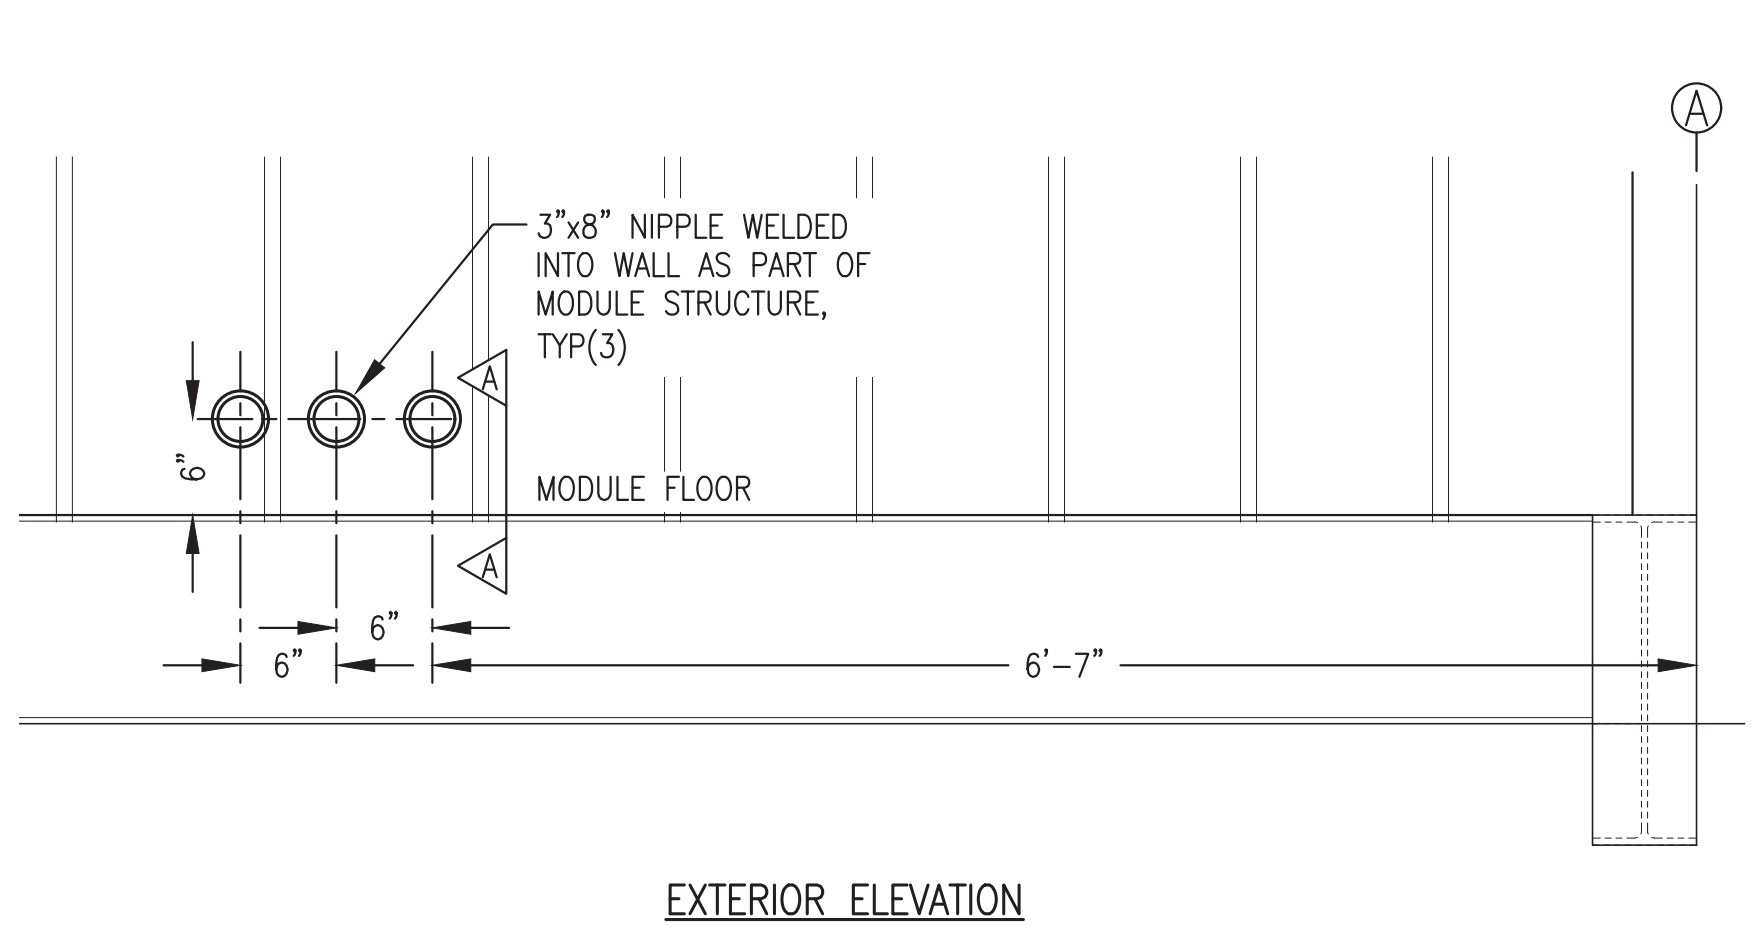

9 FEEDER ENTRANCE DETAIL
E3.3 1"=1'-0"

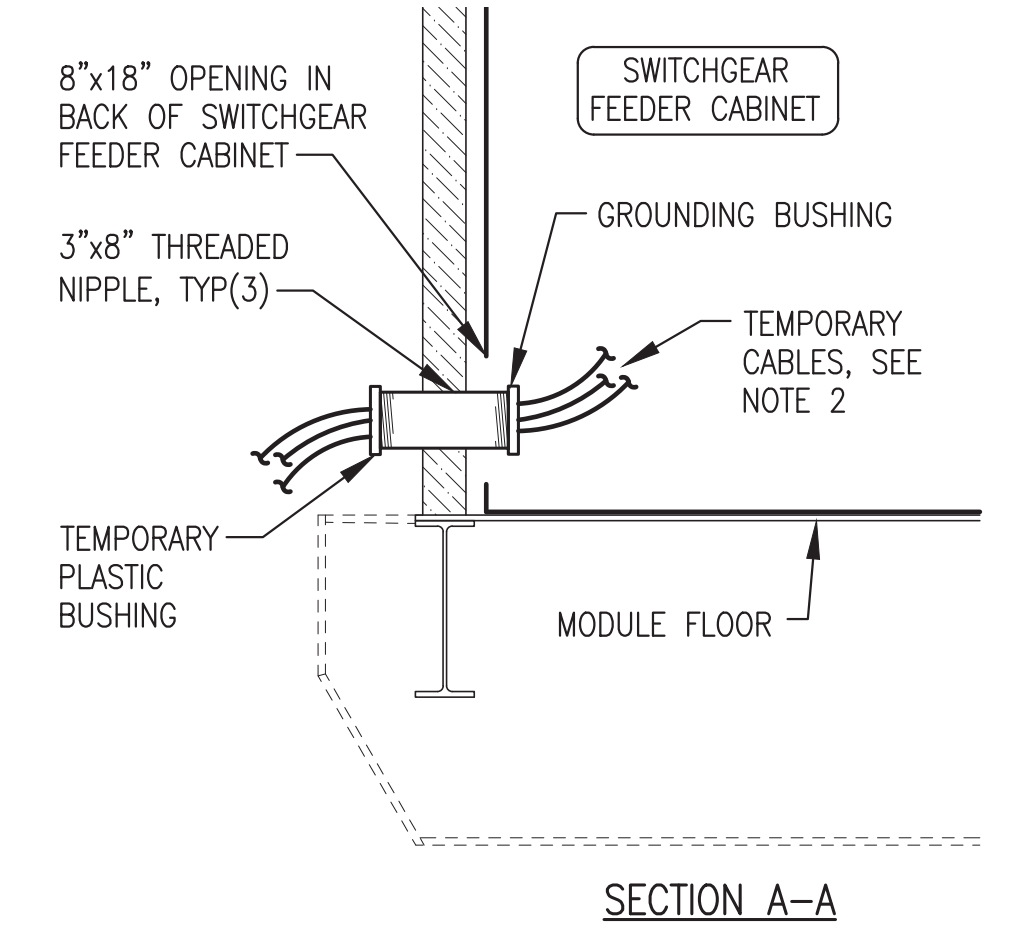


10 TYP CONDUIT WALL PENETRATION
E3.3 NO SCALE

FEEDER SHOP/ON-SITE NOTES:

- 1) DURING SHOP FABRICATION INSTALL TEMPORARY FEEDER CABLES THROUGH ONE NIPPLE AS SHOWN. SPARE NIPPLE TO REMAIN CAPPED.
- 2) ROUTE TEMPORARY CABLES TO LOAD BANK FOR TESTING. AFTER TESTING INSTALL THREADED CAP ON EXTERIOR END OF NIPPLE.
- 3) INSTALL FEEDER TO TRANSFORMER AS PART OF ON-SITE WORK, SEE SHEET E1.2. FOR CONTINUATION.
- 4) UPON COMPLETION OF TESTING PACK GRC NIPPLES THROUGH WALL WITH DUCT SEAL.

NOTE: UPON COMPLETION OF CIRCUIT TESTING PACK GRC NIPPLE THROUGH WALL WITH DUCT SEAL.

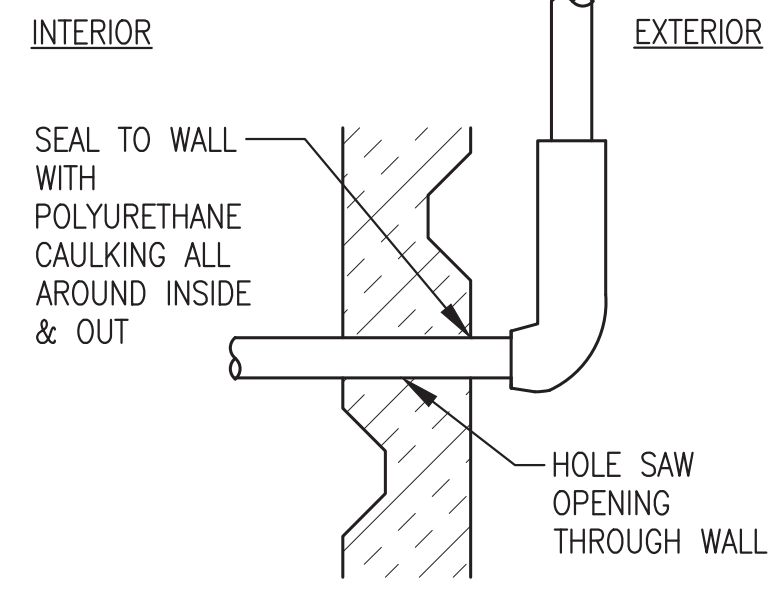


ALL WORK ON THIS SHEET WAS PERFORMED AS PART OF THE PRIOR MODULE ASSEMBLY CONTRACT EXCEPT AS SPECIFICALLY INDICATED IN THE SHOP/ON SITE NOTES.

ISSUED FOR CONSTRUCTION
JULY 2022



ALASKA ENERGY AUTHORITY		
PROJECT: NAPASKIAK POWER SYSTEM UPGRADE		
TITLE: ELEVATIONS & DETAILS		
 Gray Stassel Engineering, Inc. P.O. 111405, Anchorage, AK 99511 (907)349-0100	DRAWN BY: JTD DESIGNED BY: CWV/BCG FILE NAME: NAPS PP E2-5 PROJECT NUMBER:	SCALE: AS NOTED DATE: 7/29/22 SHEET: E3.3

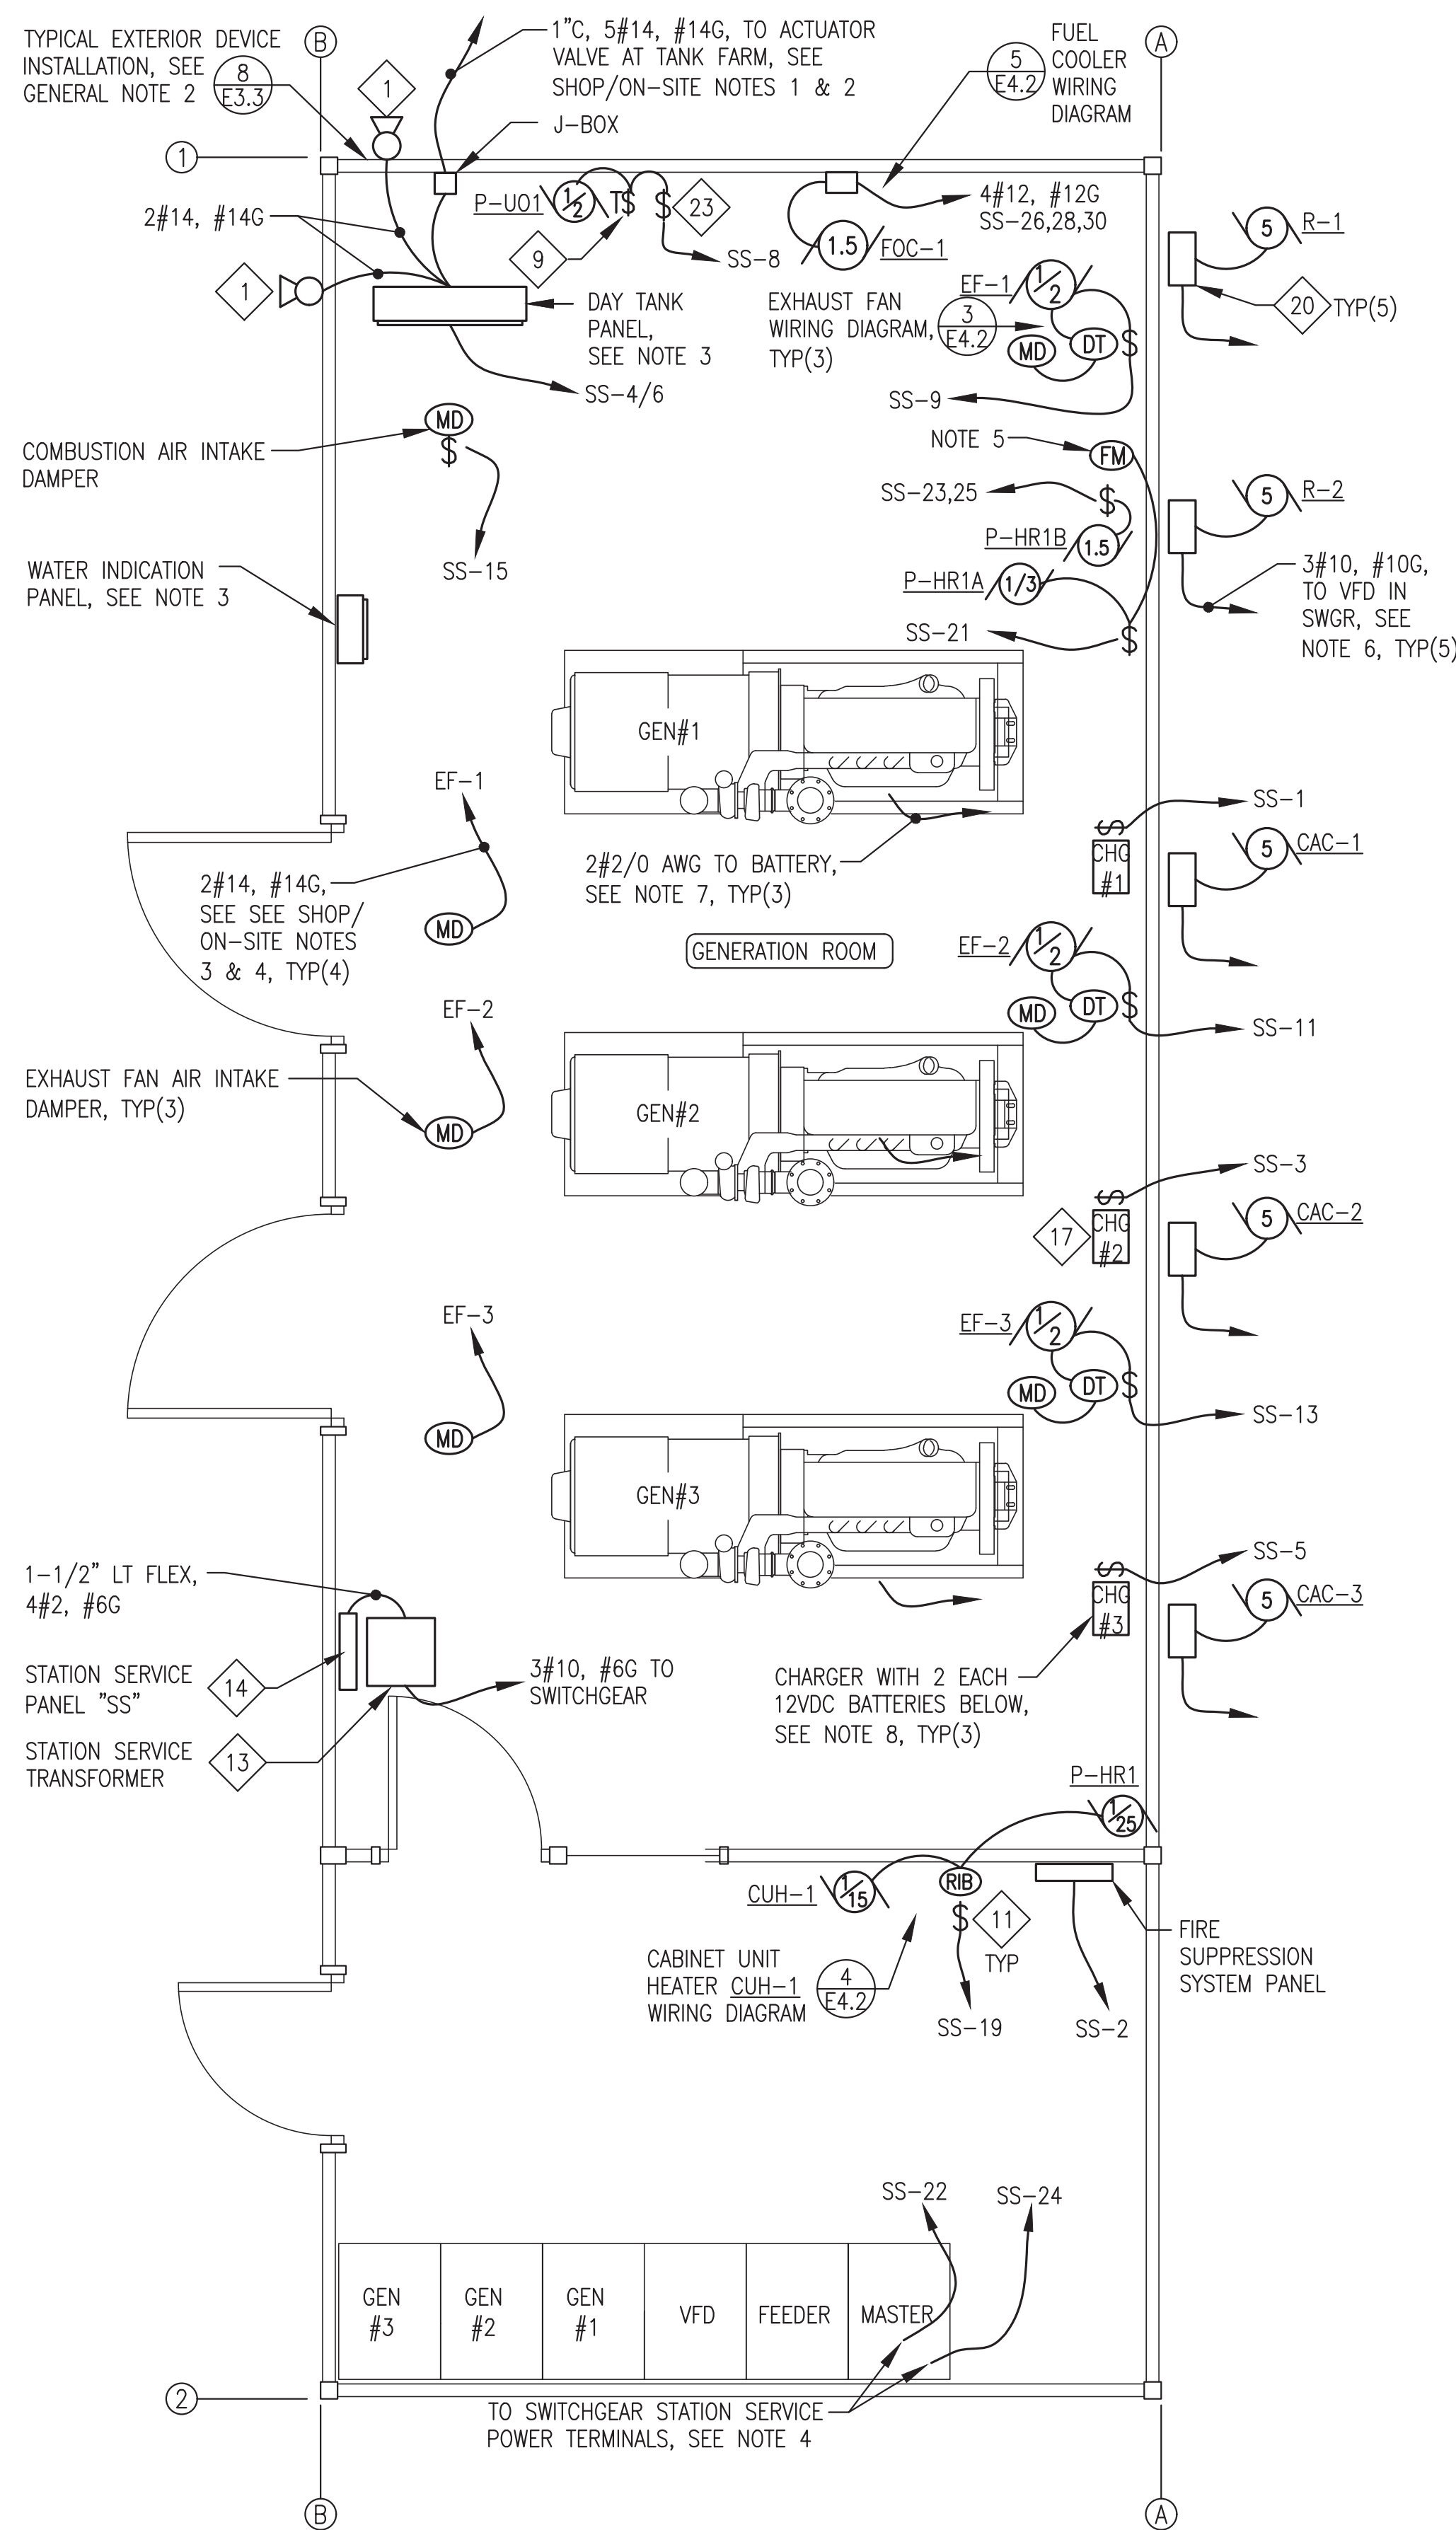


1 STATION SERVICE PLAN
E4.2 3/8"=1'-0"

STATION SERVICE GENERAL NOTES:


- 1) ALL WIRING RUNS 2#12, #12G UNLESS SPECIFICALLY NOTED OTHERWISE.
- 2) MOUNT ALARMS HORNS WITH TOP AT 10'-0" AFF TO MATCH EXTERIOR LIGHTS, SEE SHEET E4.1
- 3) SEE SHEETS E7.1-E7.4 FOR DAY TANK AND WATER INDICATION PANEL DESIGN AND WIRING TERMINATIONS. ALL ACCESSORIES NOT SHOWN ON PLANS. SEE LOGIC DIAGRAMS FOR ADDITIONAL DETAIL.
- 4) SEE SWITCHGEAR SHOP DRAWINGS FOR TERMINATION OF ALL POWER AND CONTROL WIRING.
- 5) INSTALL FLOW METER FOR HEAT RECOVERY MONITORING WHERE SHOWN ON HEAT RECOVERY PIPING ISOMETRIC 2/M4.2. PROVIDE CONTROL POWER FROM P-HR1A DISCONNECT.
- 6) ROUTE RADIATOR VFD POWER CONDUCTORS IN SEPARATE EXTERIOR CONDUIT, SEE ELEVATION 1/E3.3. DO NOT ROUTE IN WIREWAY. NOTE THAT CONDUCTORS ARE OVERSIZED FOR 50% DE-RATE AND PROVIDED WITH 15A BREAKER IN SWITCHGEAR.
- 7) ROUTE BATTERY CABLES TO FRONT OF SKID SUPPORTED WITH CUSHIONED CLAMPS, SEE SHEET M3.4. ROUTE FROM SKID DIRECTLY UNDER FUEL HOSES TO WALL AND TYWRAP CABLES TO USED OIL PIPE ALONG WALL, SEE DETAIL 2/E3.1. CUT TO PROVIDE 6"± SERVICE LOOP FOR FINAL TERMINATION ON BATTERIES.
- 8) MOUNT BATTERY CHARGER TO WALL ON SHALLOW STRUT AND INSTALL BATTERIES IN RACK ON FLOOR BELOW, SEE ELEVATION 1/E3.2.

STATION SERVICE SHOP/ON-SITE NOTES:

- 1) DURING SHOP FABRICATION INSTALL WALL PENETRATION AND CONDUIT INTO DAY TANK PANEL. SEE ELEVATION 5/E3.2.
- 2) AS PART OF ON-SITE WORK INSTALL CONDUIT AND CONDUCTORS TO ACTUATOR VALVE AT TANK FARM, SEE ENLARGED SITE PLAN.
- 3) DURING SHOP FABRICATION INSTALL CEILING MOUNTED BOX ADJACENT TO DAMPER ACTUATOR AND TEMPORARILY CONNECT DAMPER TO VERIFY OPERATION.
- 4) AS PART OF ON-SITE WORK INSTALL CONDUIT AND CONDUCTORS TO DAMPER ACTUATOR. SEE SHEET M7.

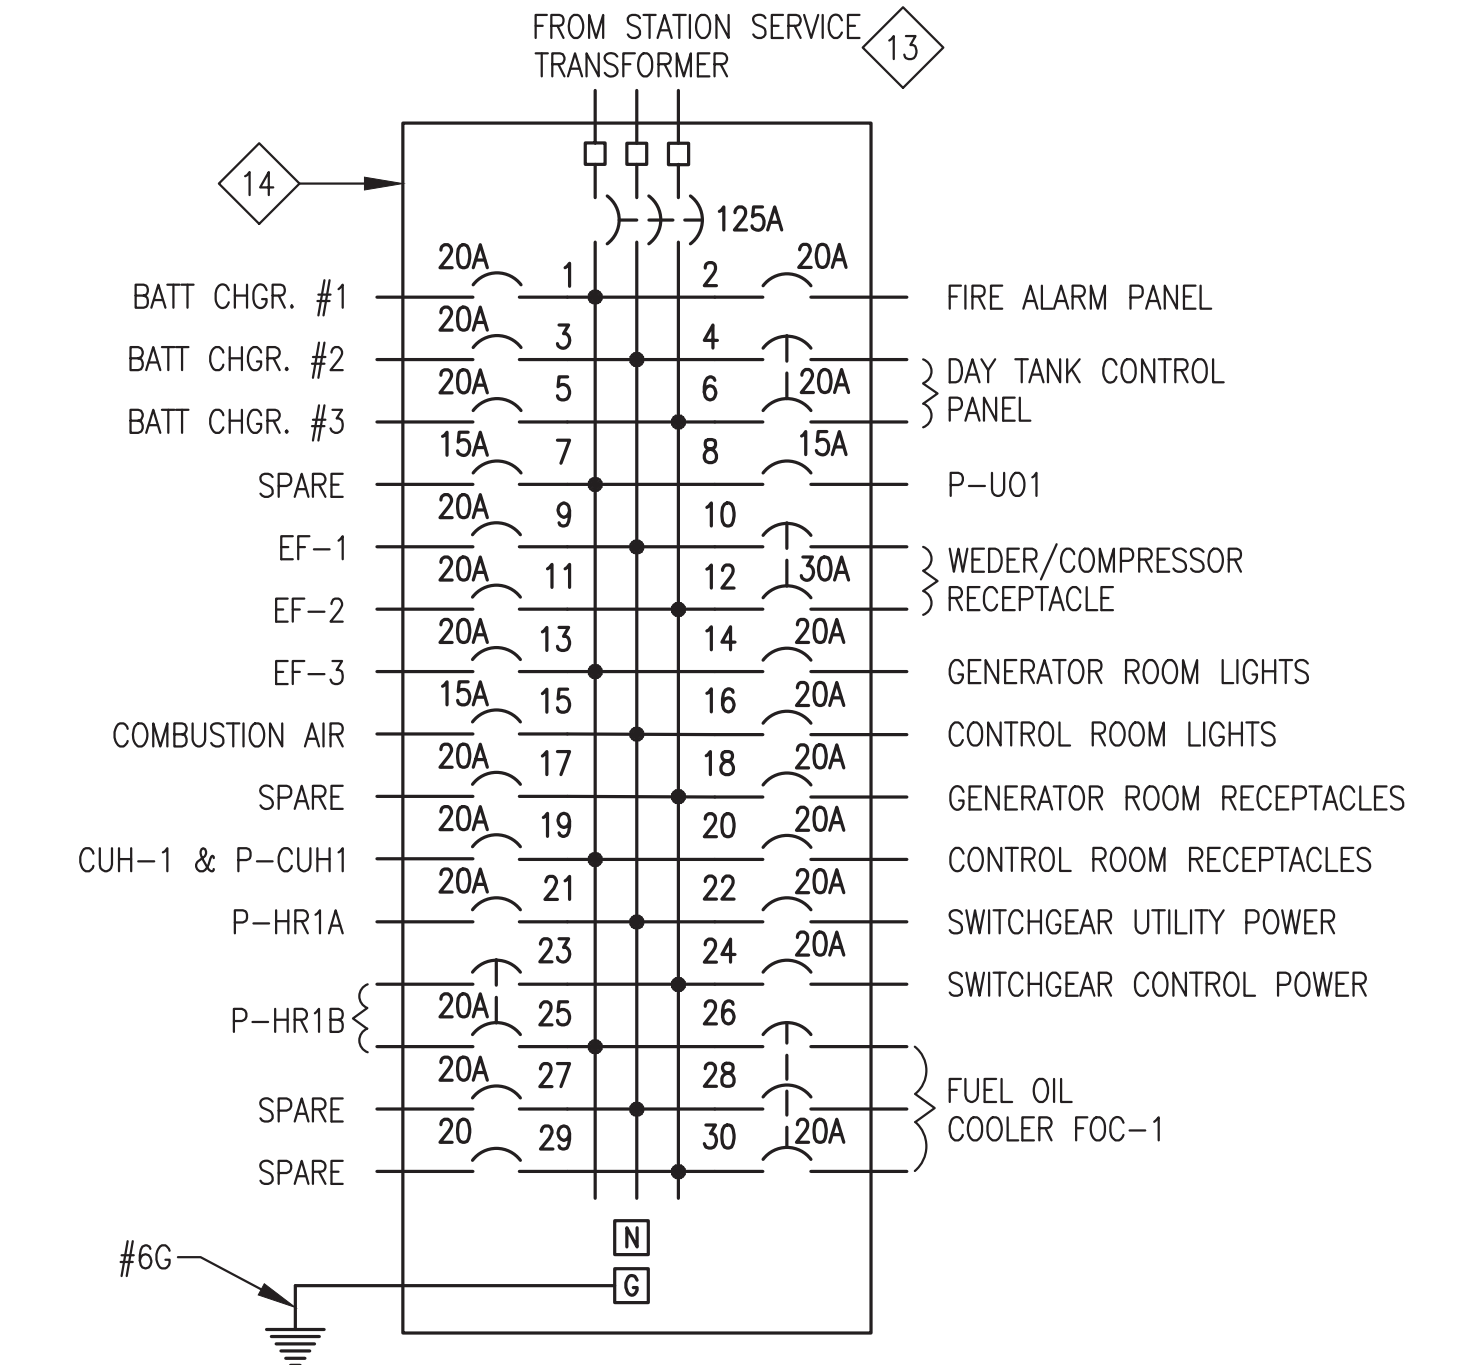


2 STATION SERVICE PANEL "SS"
E4.2 NO SCALE

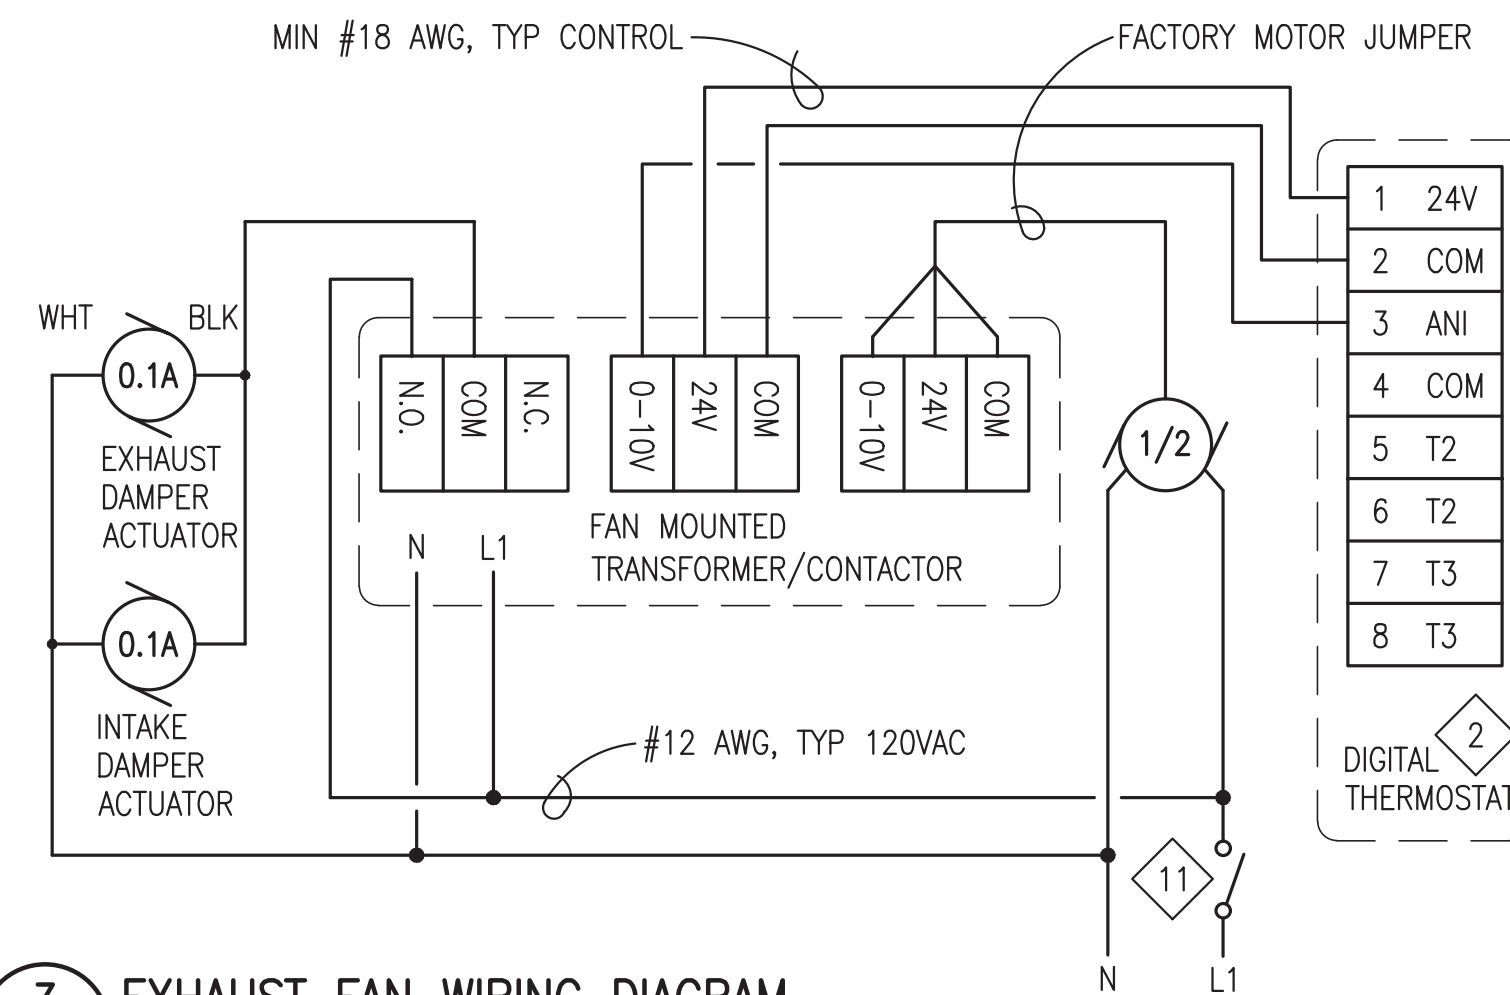


3 EXHAUST FAN WIRING DIAGRAM
E4.2 NO SCALE

NOTES:


- 1) ALL WIRING #12AWG EXCEPT AS NOTED.
- 2) PLACE TEMPERATURE CONTROLLER IN COOLING/CUT-IN MODE. SETPOINT = 120°F, DIFFERENTIAL = 10°F
- 3) MOUNT TEMP CONTROLLER TO WALL ABOVE FOC-1 ADJACENT TO CONTACTOR

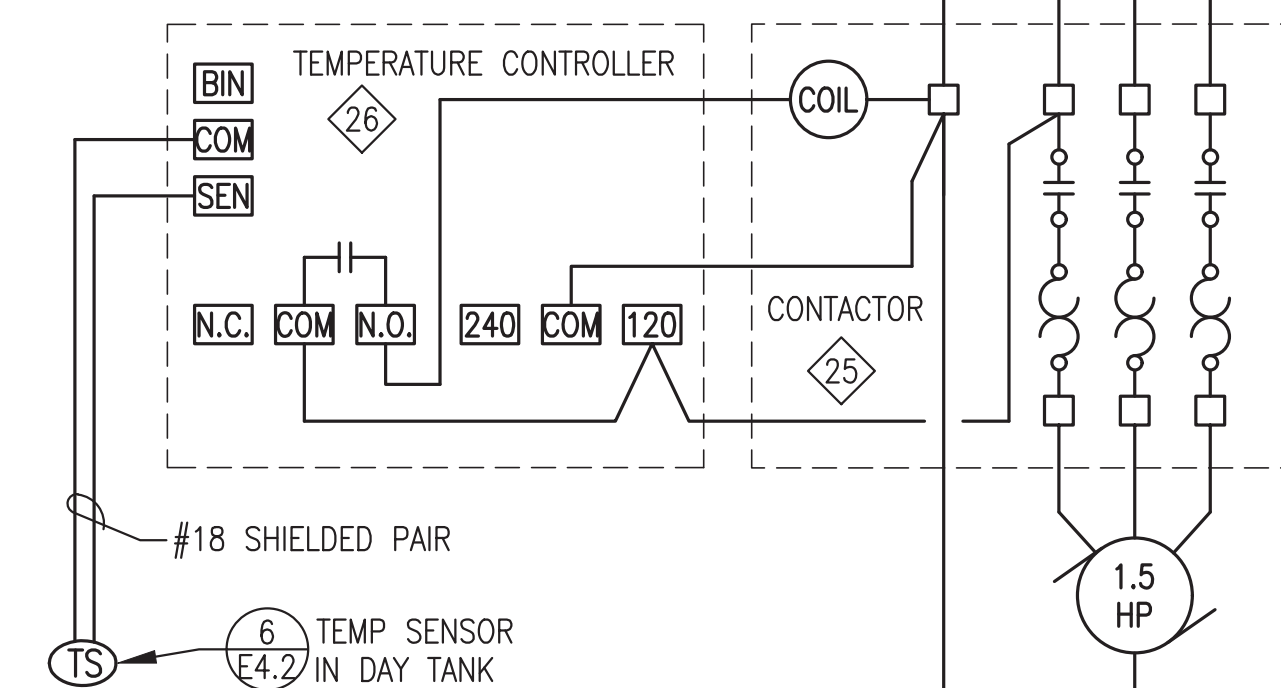

5 FOC-1 WIRING DIAGRAM
E4.2 NO SCALE

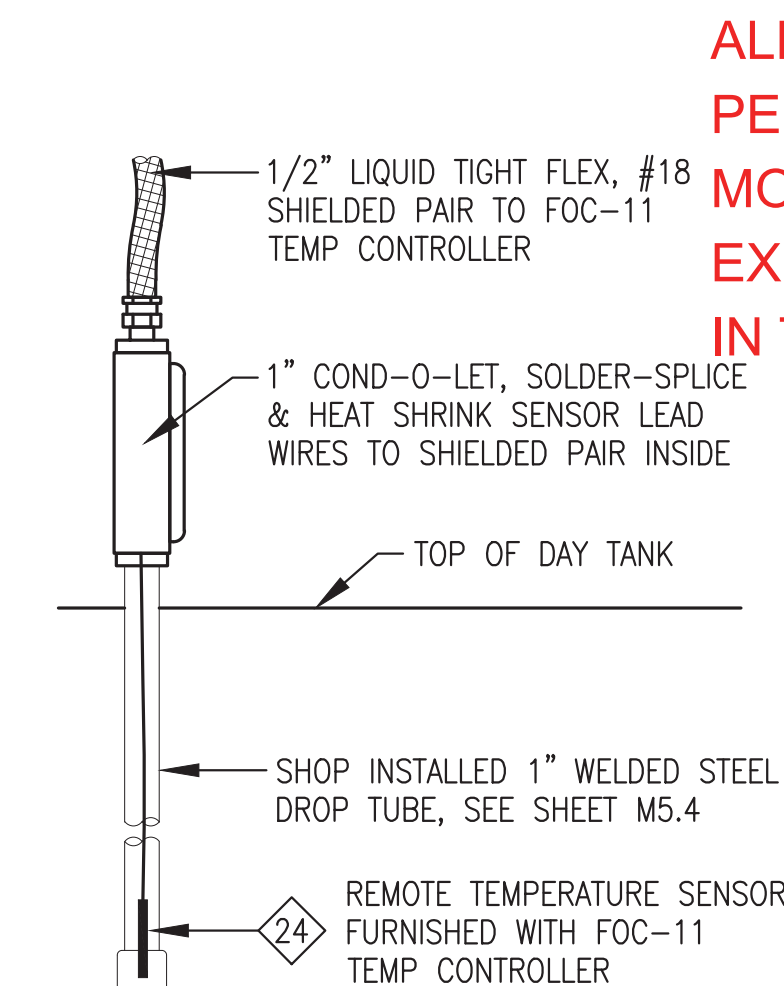


6 TANK TEMP SENSOR INSTALLATION
E4.2 NO SCALE

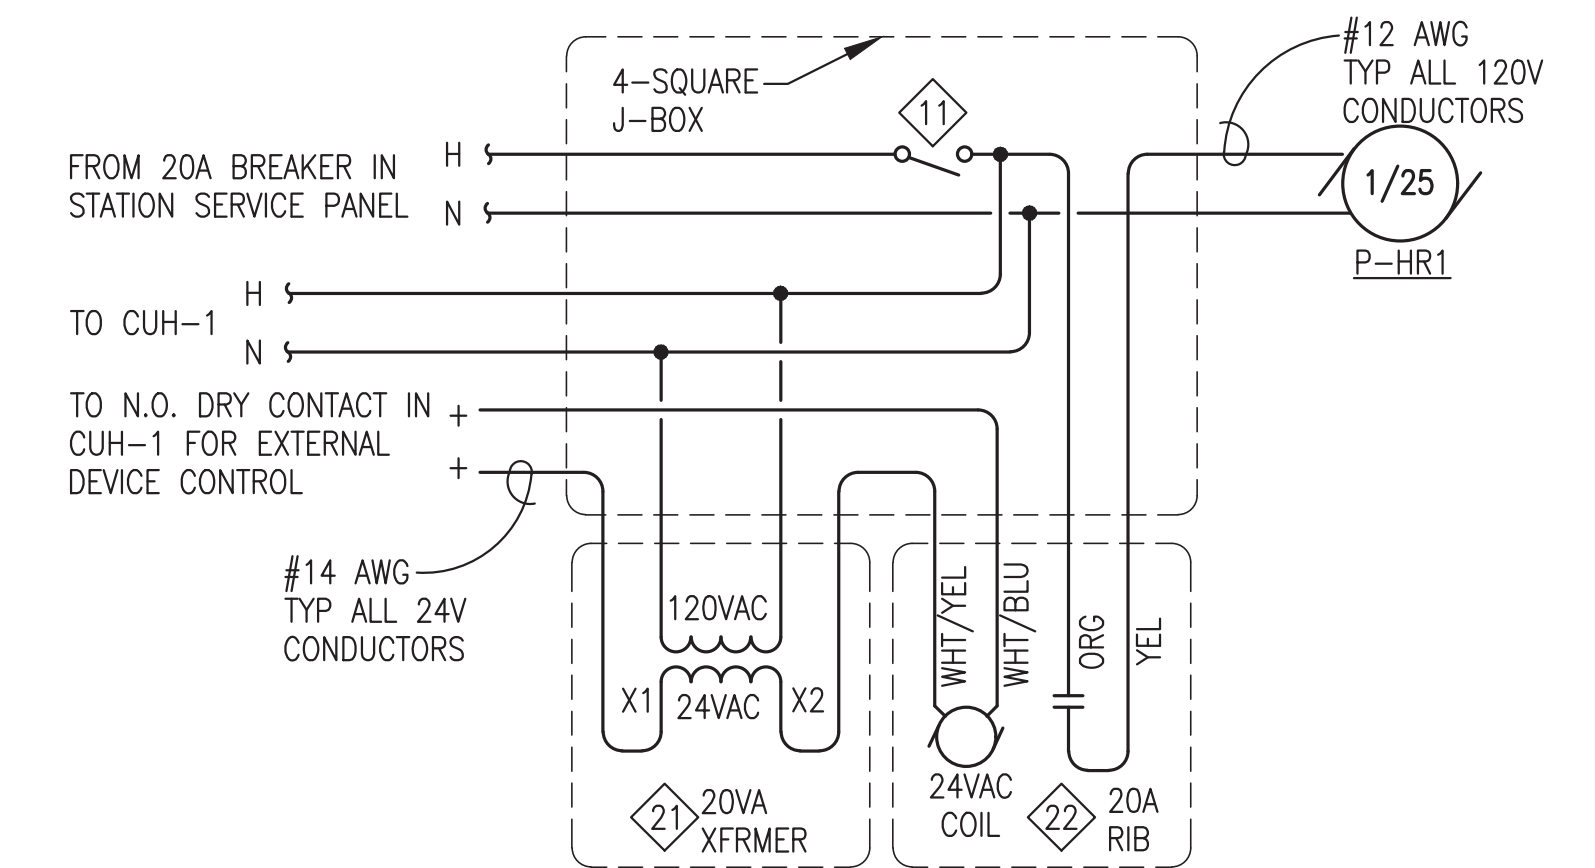


4 CUH-1 WIRING DIAGRAM
E4.2 NO SCALE

ALL WORK ON THIS SHEET WAS PERFORMED AS PART OF THE PRIOR MODULE ASSEMBLY CONTRACT EXCEPT AS SPECIFICALLY INDICATED IN THE SHOP/ON SITE NOTES.

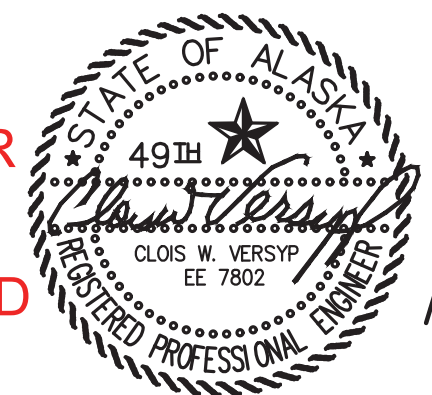

REVISION #1
ISSUED
AUGUST 2022

1	REVISED TO COORDINATE WITH FINAL ON-SITE DESIGN	8/26/22	BCG
REV.	DESCRIPTION	DATE	BY
PROJECT: NAPASKIAK POWER SYSTEM UPGRADE			
TITLE: STATION SERVICE PLAN, DETAILS, & PANELBOARD			
		DRAWN BY: JTD DESIGNED BY: CWV/BCG FILE NAME: NAPS PP E2-5 PROJECT NUMBER:	SCALE: AS NOTED DATE: 7/29/22 SHEET: E4.2

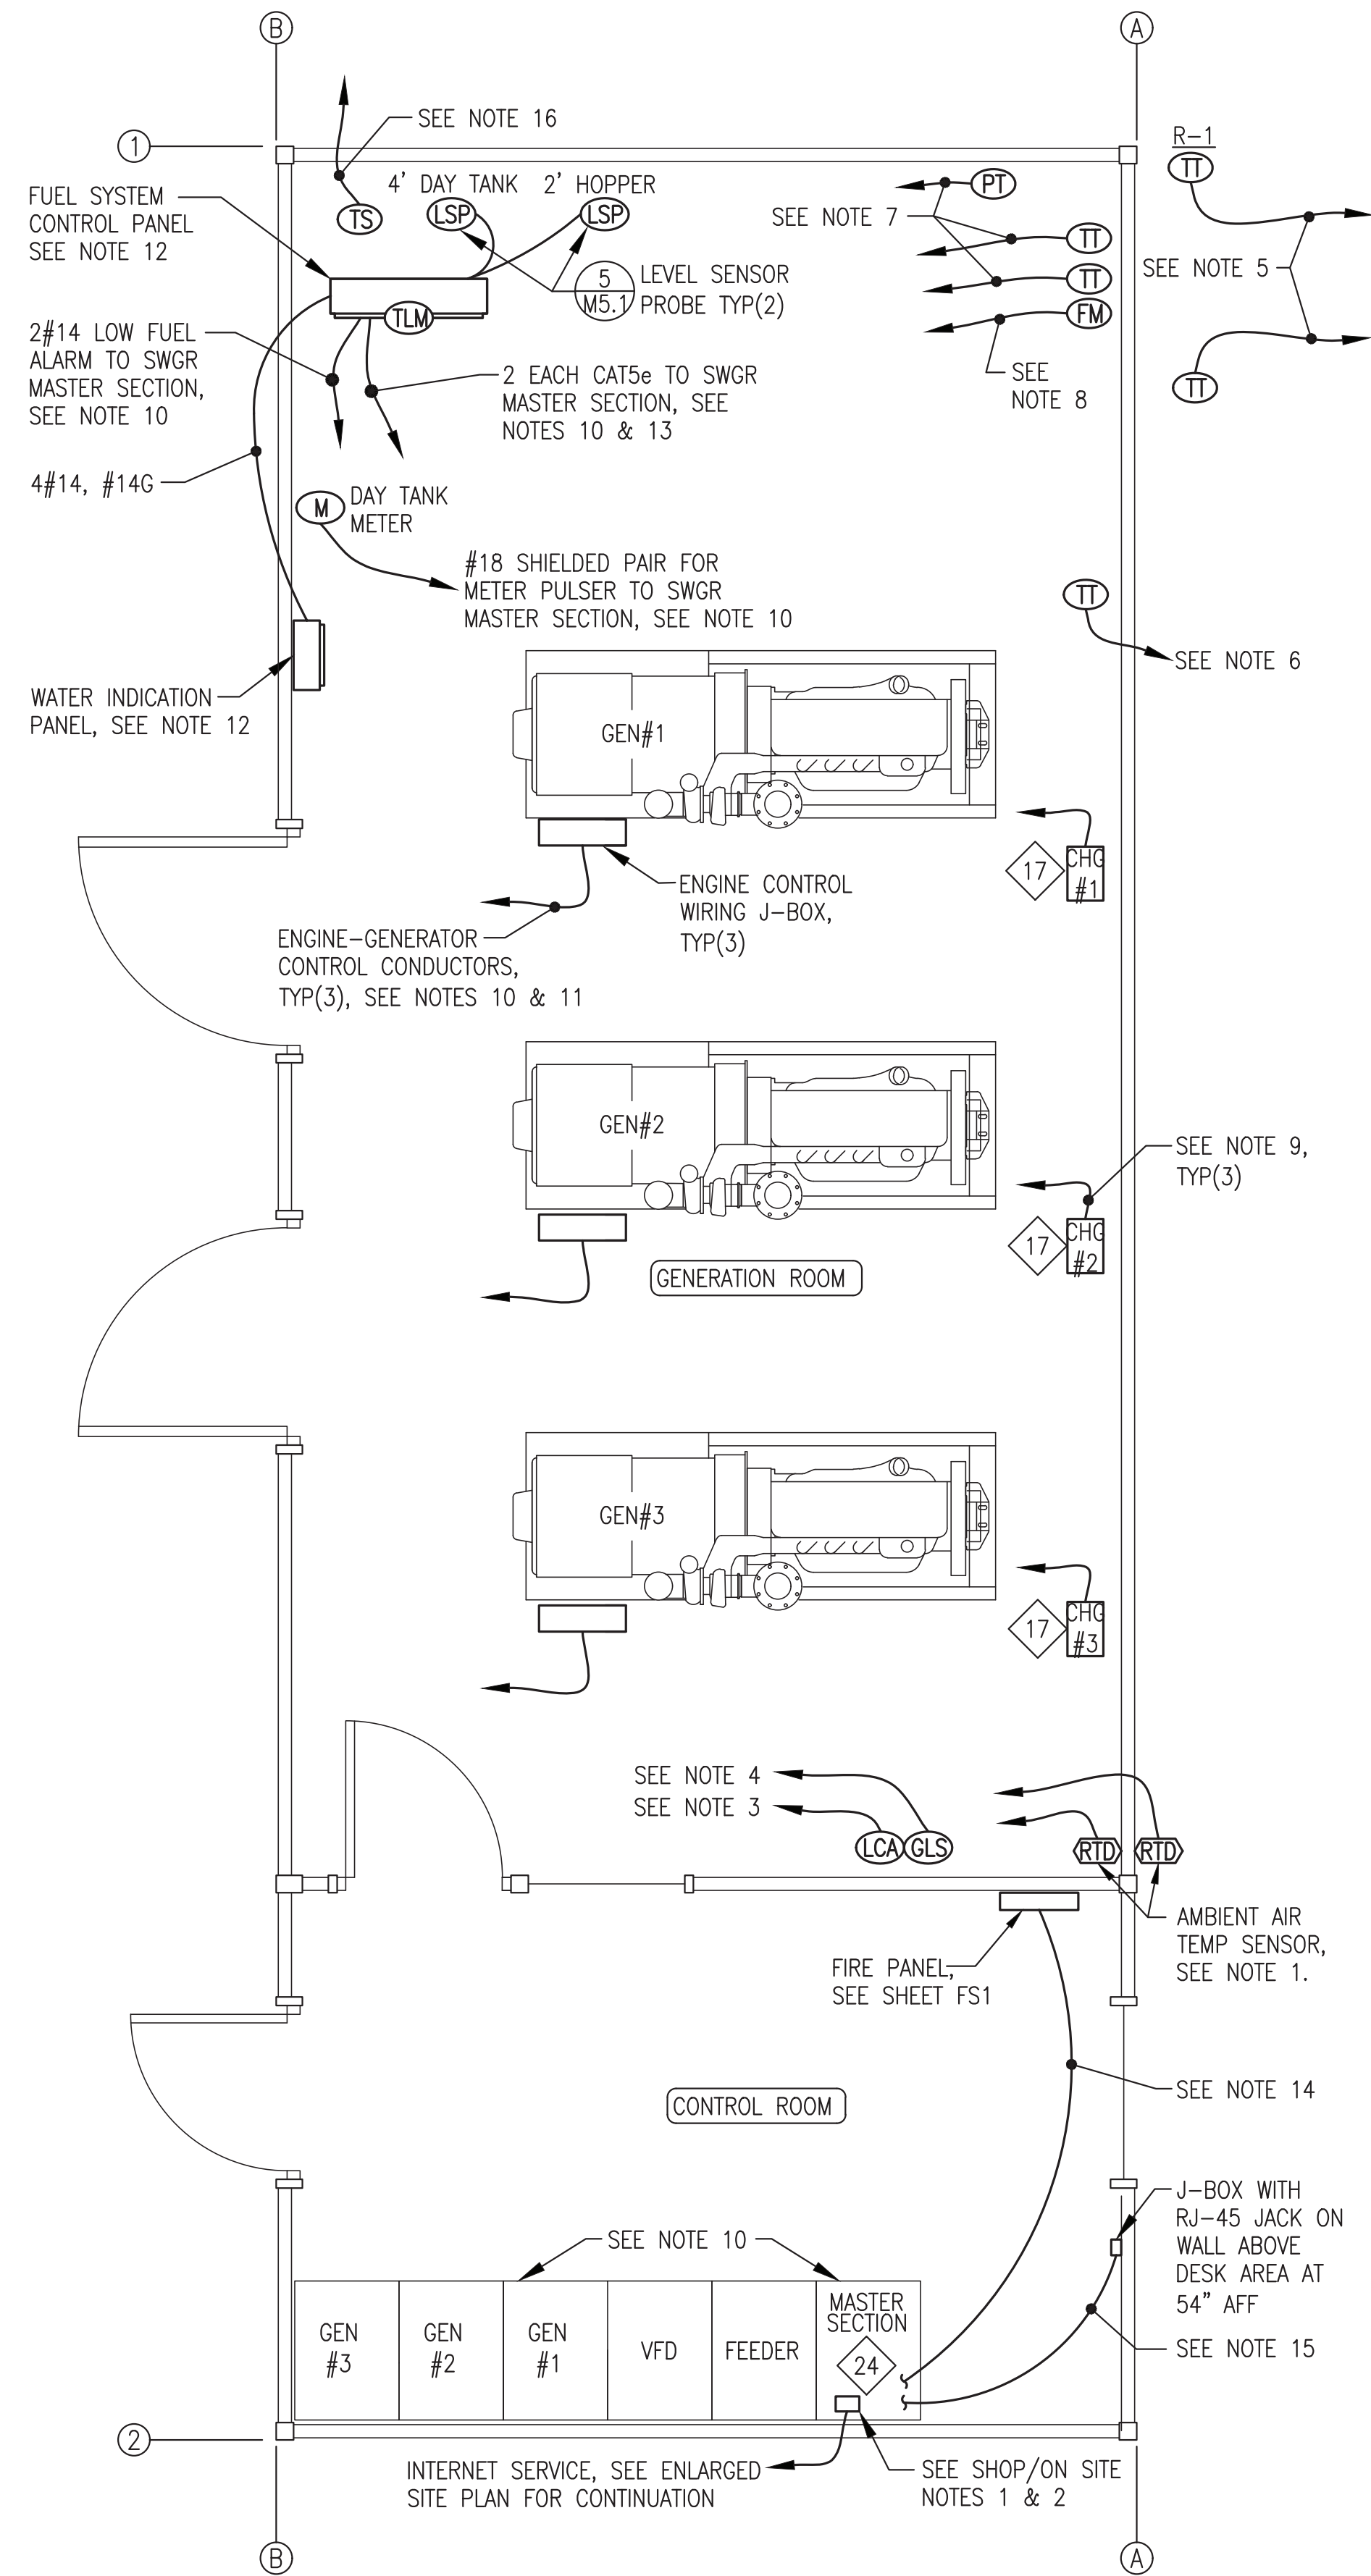


INSTRUMENTATION & DATA PLAN NOTES:

1. RTD TEMPERATURE SENSOR PROVIDED WITH SWITCHGEAR. ROUTE #18 SHIELDED PAIR TO SWITCHGEAR MASTER SECTION. SEE DETAIL 3/E5 AND NOTE 10.
2. INSTALL RBB WIFI ROUTER MODEM AND INTERNET ROUTER ON TOP OF MASTER SECTION IN RACK OR CABINET. CONNECT MODEM TO ROUTER. CONNECT ROUTER TO ETHERNET SWITCH INSIDE MASTER SECTION. CONNECT BOTH TO 120VAC UPS. SEE NOTE 10 AND SHOP/ON SITE NOTES 1 AND 2.
3. LOW COOLANT LEVEL ALARM SWITCH INSTALLED AT EXPANSION TANK, SEE MECHANICAL. CONNECT TO N.C. SWITCH (WHITE & RED) AND ROUTE 2#14 TO SWITCHGEAR MASTER SECTION. SEE NOTE 10.
4. GLYCOL LEVEL SENSOR PROBE INSTALLED IN EXPANSION TANK, SEE MECHANICAL. ROUTE #18 SHIELDED PAIR TO SWITCHGEAR. SEE NOTE 10.
5. INSTALL TEMP TRANSMITTER IN EACH RADIATOR, SEE DETAIL 3/E3.3. ROUTE #18 SHIELDED PAIR FROM EACH TO SWITCHGEAR VFD SECTION, SEE NOTE 10.
6. INSTALL COOLANT RETURN TEMP TRANSMITTER IN PIPING MAIN WHERE SHOWN ON COOLING PIPING ISOMETRIC 1/M4.2. ROUTE #18 SHIELDED PAIR TO SWITCHGEAR MASTER SECTION, SEE NOTE 10.
7. INSTALL TWO TEMP TRANSMITTERS AND ONE PRESSURE TRANSMITTER FOR HEAT RECOVERY MONITORING WHERE SHOWN ON HEAT RECOVERY PIPING ISOMETRIC 2/M4.2. ROUTE #18 SHIELDED PAIR FROM EACH TO SWITCHGEAR MASTER SECTION. SEE NOTE 10.
8. INSTALL FLOW METER FOR HEAT RECOVERY MONITORING WHERE SHOWN ON HEAT RECOVERY PIPING ISOMETRIC 2/M4.2. ROUTE #18 SHIELDED PAIR TO SWITCHGEAR MASTER SECTION. SEE NOTE 10.
9. ROUTE 2#14 FROM BATTERY CHARGER ALARM CONTACTS TO ASSOCIATED SWITCHGEAR GENERATOR SECTION, SEE NOTE 10 AND WIRING DIAGRAM 2/E5.
10. SEE SWITCHGEAR SHOP DRAWINGS FOR TERMINATION OF ALL INSTRUMENTATION AND DATA WIRING INCLUDING CONTROL POWER.
11. ROUTE ENGINE-GENERATOR CONTROL CONDUCTORS TO SWITCHGEAR IN 10x10 WIREWAY WITH POWER CONDUCTORS. SEE DETAIL 2/E3.1, SHEET E6.3, AND NOTE 10.
12. SEE SHEETS E7.1-E7.4 FOR DAY TANK AND WATER INDICATION CONTROL PANEL DESIGN AND WIRING TERMINATIONS. ALL ACCESSORIES NOT SHOWN ON PLANS. SEE LOGIC DIAGRAMS FOR ADDITIONAL DETAIL.
13. ROUTE CAT5e CONDUCTORS FROM DAY TANK PANEL REMOTE I/O AND TANK LEVEL MONITOR TO ETHERNET SWITCH IN SWITCHGEAR MASTER SECTION. INSTALL IN SEPARATE DEDICATED RACEWAY. DO NOT ROUTE WITH STATION SERVICE OR POWER CONDUCTORS.
14. ROUTE CAT5e FOR DATA AND 2#14 FOR GENERATOR SHUT DOWN FROM FIRE PANEL TO SWITCHGEAR MASTER SECTION, SEE SHEET FS1 AND NOTE 10. INSTALL IN SEPARATE DEDICATED RACEWAY, COLOR RED. DO NOT ROUTE WITH STATION SERVICE OR POWER CONDUCTORS.
15. ROUTE CAT5e FROM RJ-45 JACK IN DESK AREA TO ETHERNET SWITCH IN MASTER SECTION. INSTALL IN SEPARATE DEDICATED RACEWAY. DO NOT ROUTE WITH STATION SERVICE OR POWER CONDUCTORS.
16. INSTALL FUEL COOLER TEMP SENSOR IN DAY TANK AND ROUTE #18 SHIELDED PAIR TO FUEL COOLER CONTROLLER, SEE DETAILS 5/E4.2 AND 6/E4.2.


INSTRUMENTATION SHOP/ON-SITE NOTES:

1. AS PART OF SHOP FABRICATION INSTALL ETHERNET SWITCH IN MASTER SECTION.
2. AS PART OF ON-SITE WORK INSTALL STARLINK MODEM WITH ETHERNET ADAPTER IN BOTTOM OF MASTER SECTION. CONNECT MODEM TO ETHERNET SWITCH AND TO 120VAC UPS INSIDE MASTER SECTION. SEE NOTE 10.

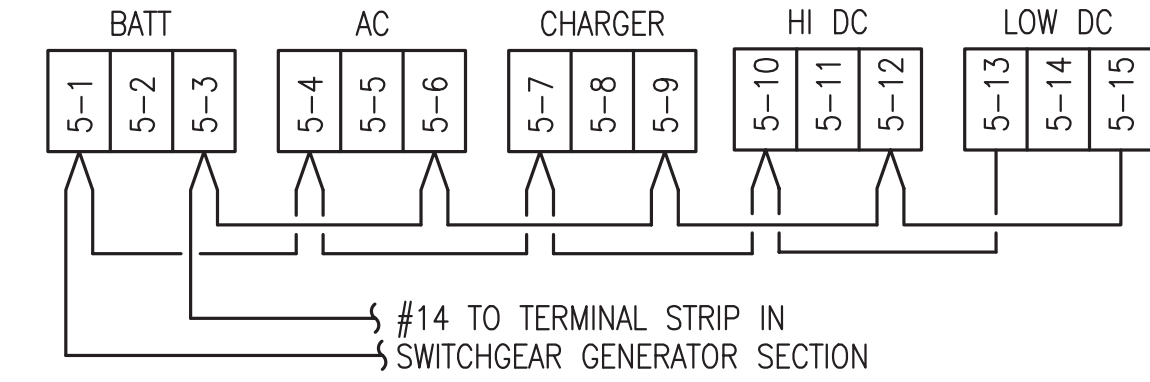

NOTE: PRIOR TO ENERGIZING MAKE THE FOLLOWING SETTINGS ON CHARGER:
 1) AC LINE VOLTAGE SWITCH TO "115V".
 2) AUTO BOOST JUMPER TO "NORM".
 3) FLOAT VOLTAGE JUMPER TO "13.50/27.00" (FOR GEL CELL).
 4) BATTERY RANGE JUMPER TO "24V".

2 BATTERY CHARGER ALARM WIRING DIAGRAM
 NO SCALE

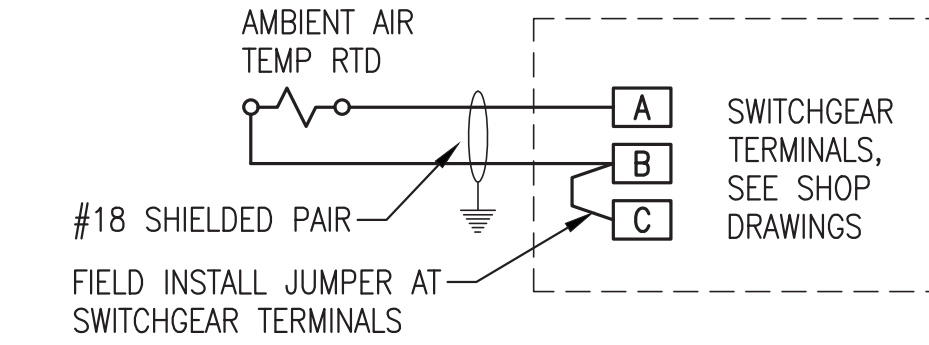


3 AMBIENT AIR TEMP RTD TERMINATION
 NO SCALE

ALL WORK ON THIS SHEET WAS PERFORMED AS PART OF THE PRIOR MODULE ASSEMBLY CONTRACT EXCEPT AS SPECIFICALLY INDICATED IN THE SHOP/ON SITE NOTES.

1 INSTRUMENTATION & DATA PLAN
 3/8"=1'-0"

REV#1
 ISSUED FOR
 CONSTRUCTION
 NOV 2023

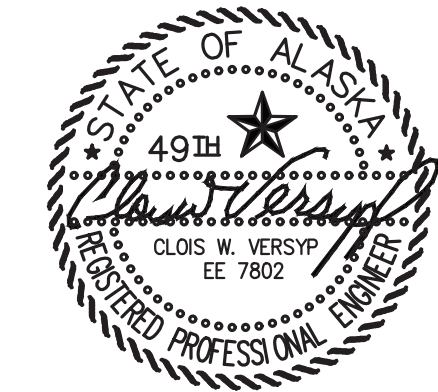

1	CHANGED INTERNET SERVICE TO STARLINK	11/10/23	BCG
REV.	DESCRIPTION	DATE	BY
 ALASKA ENERGY AUTHORITY			
PROJECT: NAPASKIAK POWER SYSTEM UPGRADE			
TITLE: INSTRUMENTATION & DATA PLAN & DETAILS			
DRAWN BY: JTD		SCALE: AS NOTED	
DESIGNED BY: CWV/BCG		DATE: 7/29/22	
FILE NAME: NAPS PP E2-5		SHEET: E5	
PROJECT NUMBER:			
P.O. 111405, Anchorage, AK 99511 (907)349-0100			

Final (Permanent) Demand Control Table (PLC)				
Demand Control	Generator(s) On Line	On-line kW (Overload)	Level Increase	Level Decrease
Level 1	One Gen	350	310	---
Level 2	Two Gens	700	620	280
Level 3	All	1050	---	560

Note: All generators are equal capacity. Manually select lead unit.

Temporary Demand Control for Shop Load Test with 300kW Load Bank

Level 1	One Gen	150	135	---
Level 2	Two Gens	300	270	120
Level 3	All	450	---	240

Note: Temporarily set to reduced values in order to test all demand levels.

Engine-Generator Alarm Settings (EZGN Genset Controller)

Function	Normal Range	Alarm	Shut Down
Overspeed	1795-1805	----	1900 RPM
Oil Pressure	30-50 PSI	14.5 PSI	10 PSI
Air Filter Vacuum	1-10" H2O	15" H2O	20" H2O
Coolant Temp.	180-200°F	210°F	215°F
Exhaust Temp.	500-850°F	900°F	----
Charge Air Temp.	100-120°F	140°F	150°F
Under Frequency	59.5-60.5 Hz	----	58.2 Hz
Over Frequency	59.5-60.5 Hz	----	61.8 Hz
Under Voltage	470-490 V	----	432 V
Over Voltage	470-490 V	----	528 V
Reverse Power	0	----	10%

Generator Breaker Settings (EZGN Genset Controller)

Function	Setting
Gen Breaker Trip Setpoint (EZGN Rated Current)	600 A
Gen Breaker Level 1 (100%) Time Over Current	3 sec.
Gen Breaker Level 2 (120%) Time Over Current	1 sec.
Gen Breaker Level 3 (250%) Time Over Current	0.4 sec.

Feeder Breaker Settings (Feeder Protection Relay - FPR)


Function (Note: Element 1 is the only active element)	Setting
T.O.C. Trip Pickup (amps) Note: 5A = 100% of CT rating	4.7
T.O.C. Curve Selection	U4
T.O.C. Time Dial	5.00
E.M Reset delay (Y/N)	N
Constant Time Adder (seconds)	0.00
Minimum Response Time (seconds)	0.00
Maximum Phase T.O.C. Torque Control	1

Radiator VFD Settings


Function	Setting
Min PID Feedback	20
Max PID Feedback	240
rSL (Wake UP Threshold)	1
PID Reference Temperature	175°F
Proportional Gain	0.93
Integral Gain	0.3
Derivative	0
Minimum Speed	10 Hz.
Low Speed Timeout	10 sec.
Loss of Phase	Ignore

Charge Air Cooler VFD Settings


Function	Setting
Min PID Feedback	20
Max PID Feedback	240
rSL (Wake UP Threshold)	Not Used
PID Reference Temperature	100°F
Proportional Gain	0.2
Integral Gain	0.1
Derivative	0

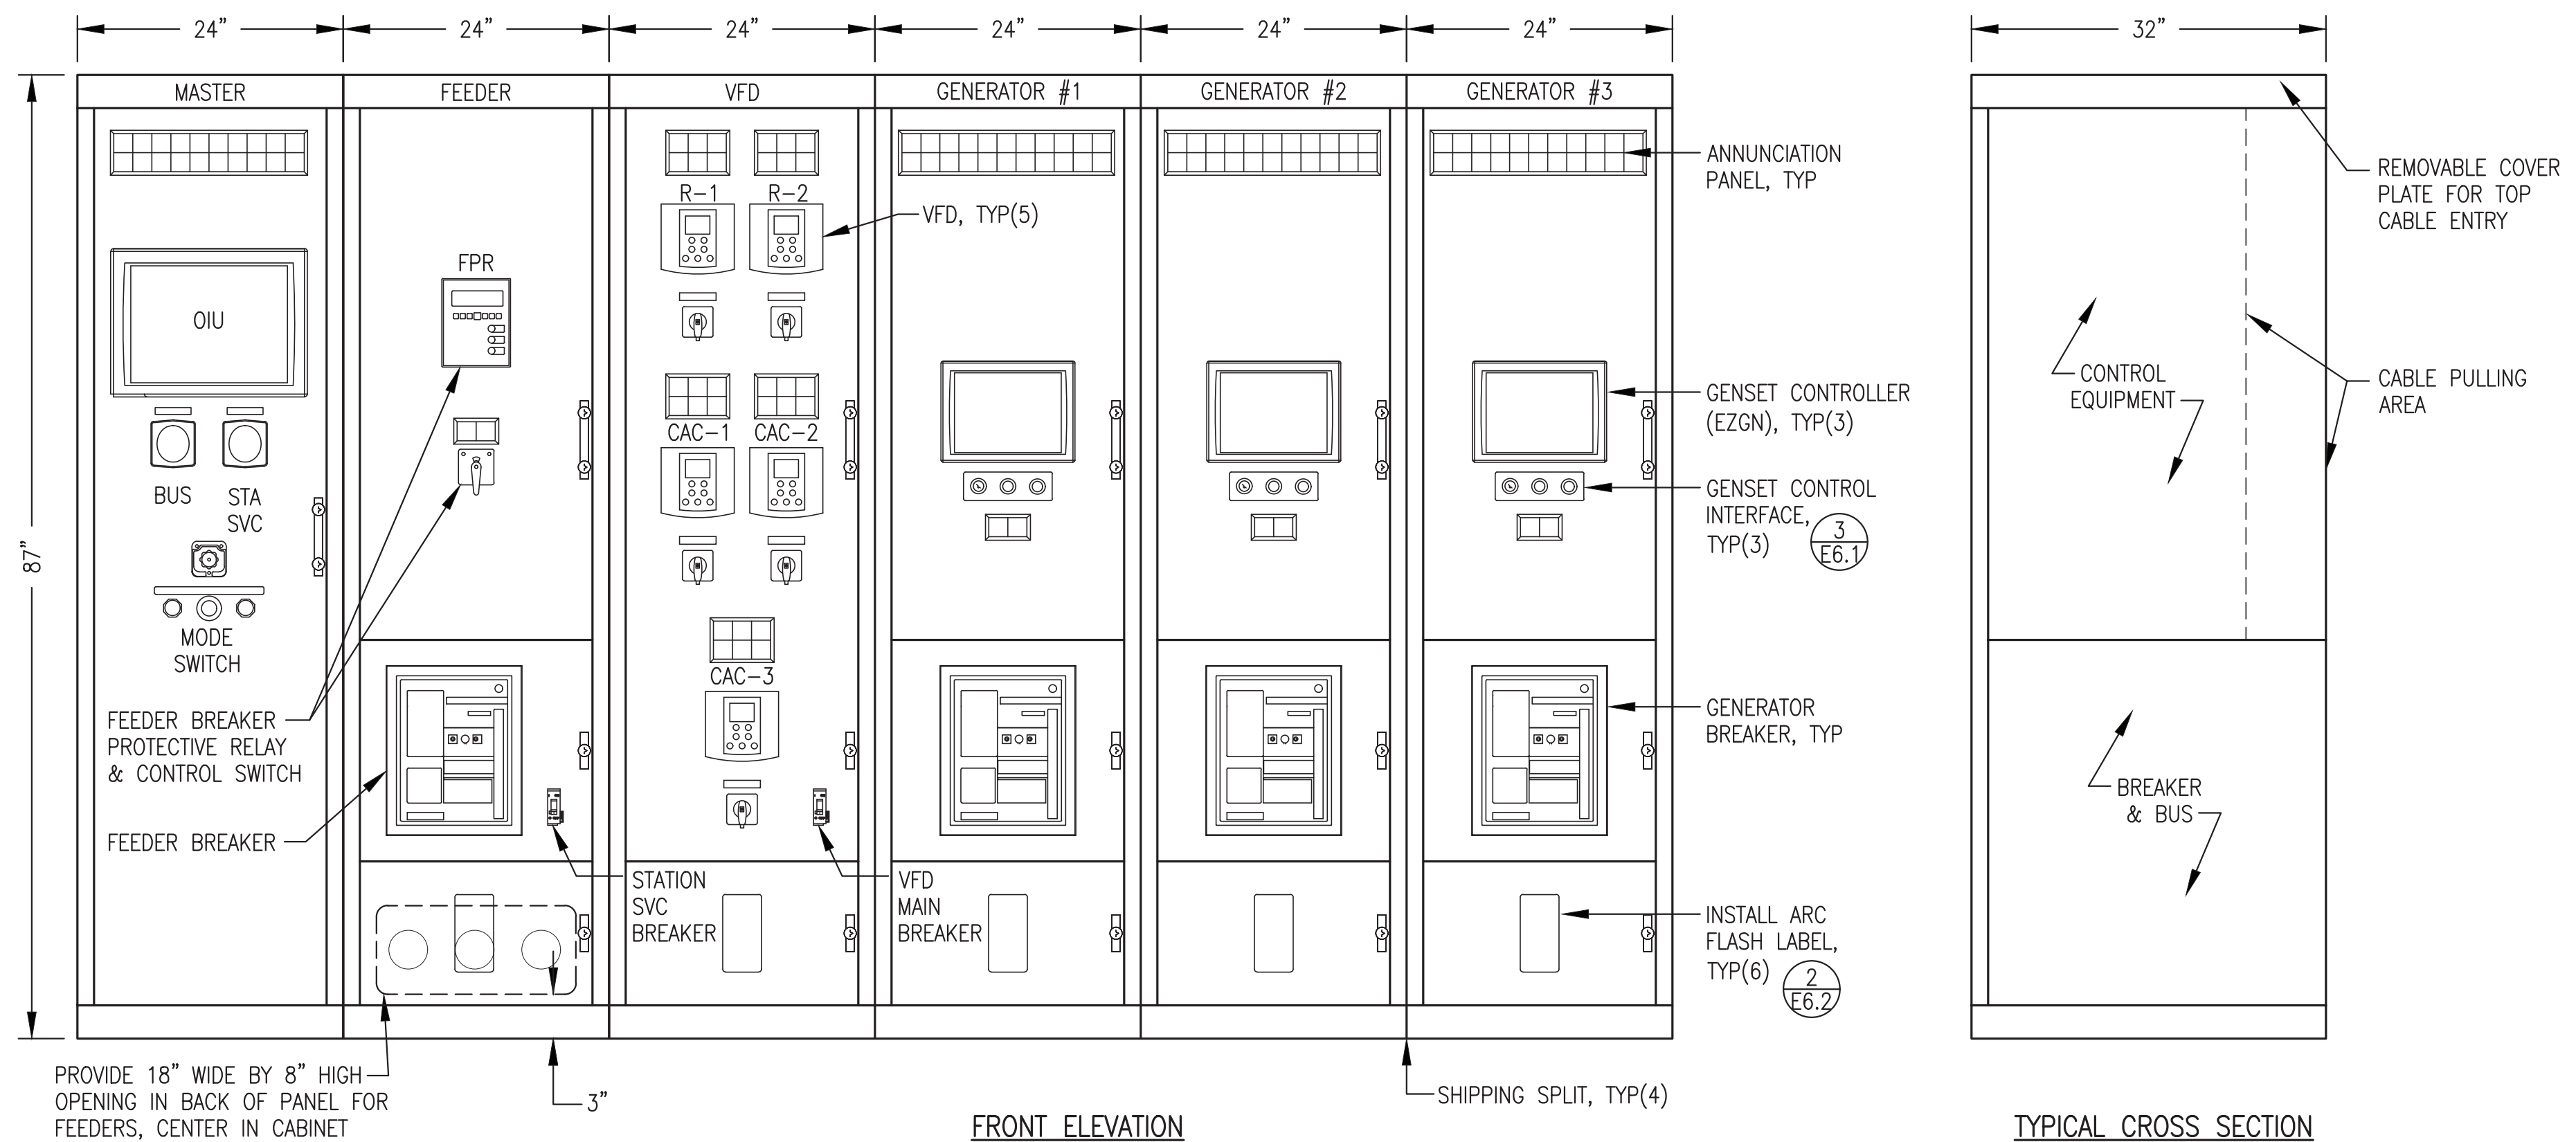

1 SWITCHGEAR ENCLOSURE LAYOUT
E6.1 NO SCALE

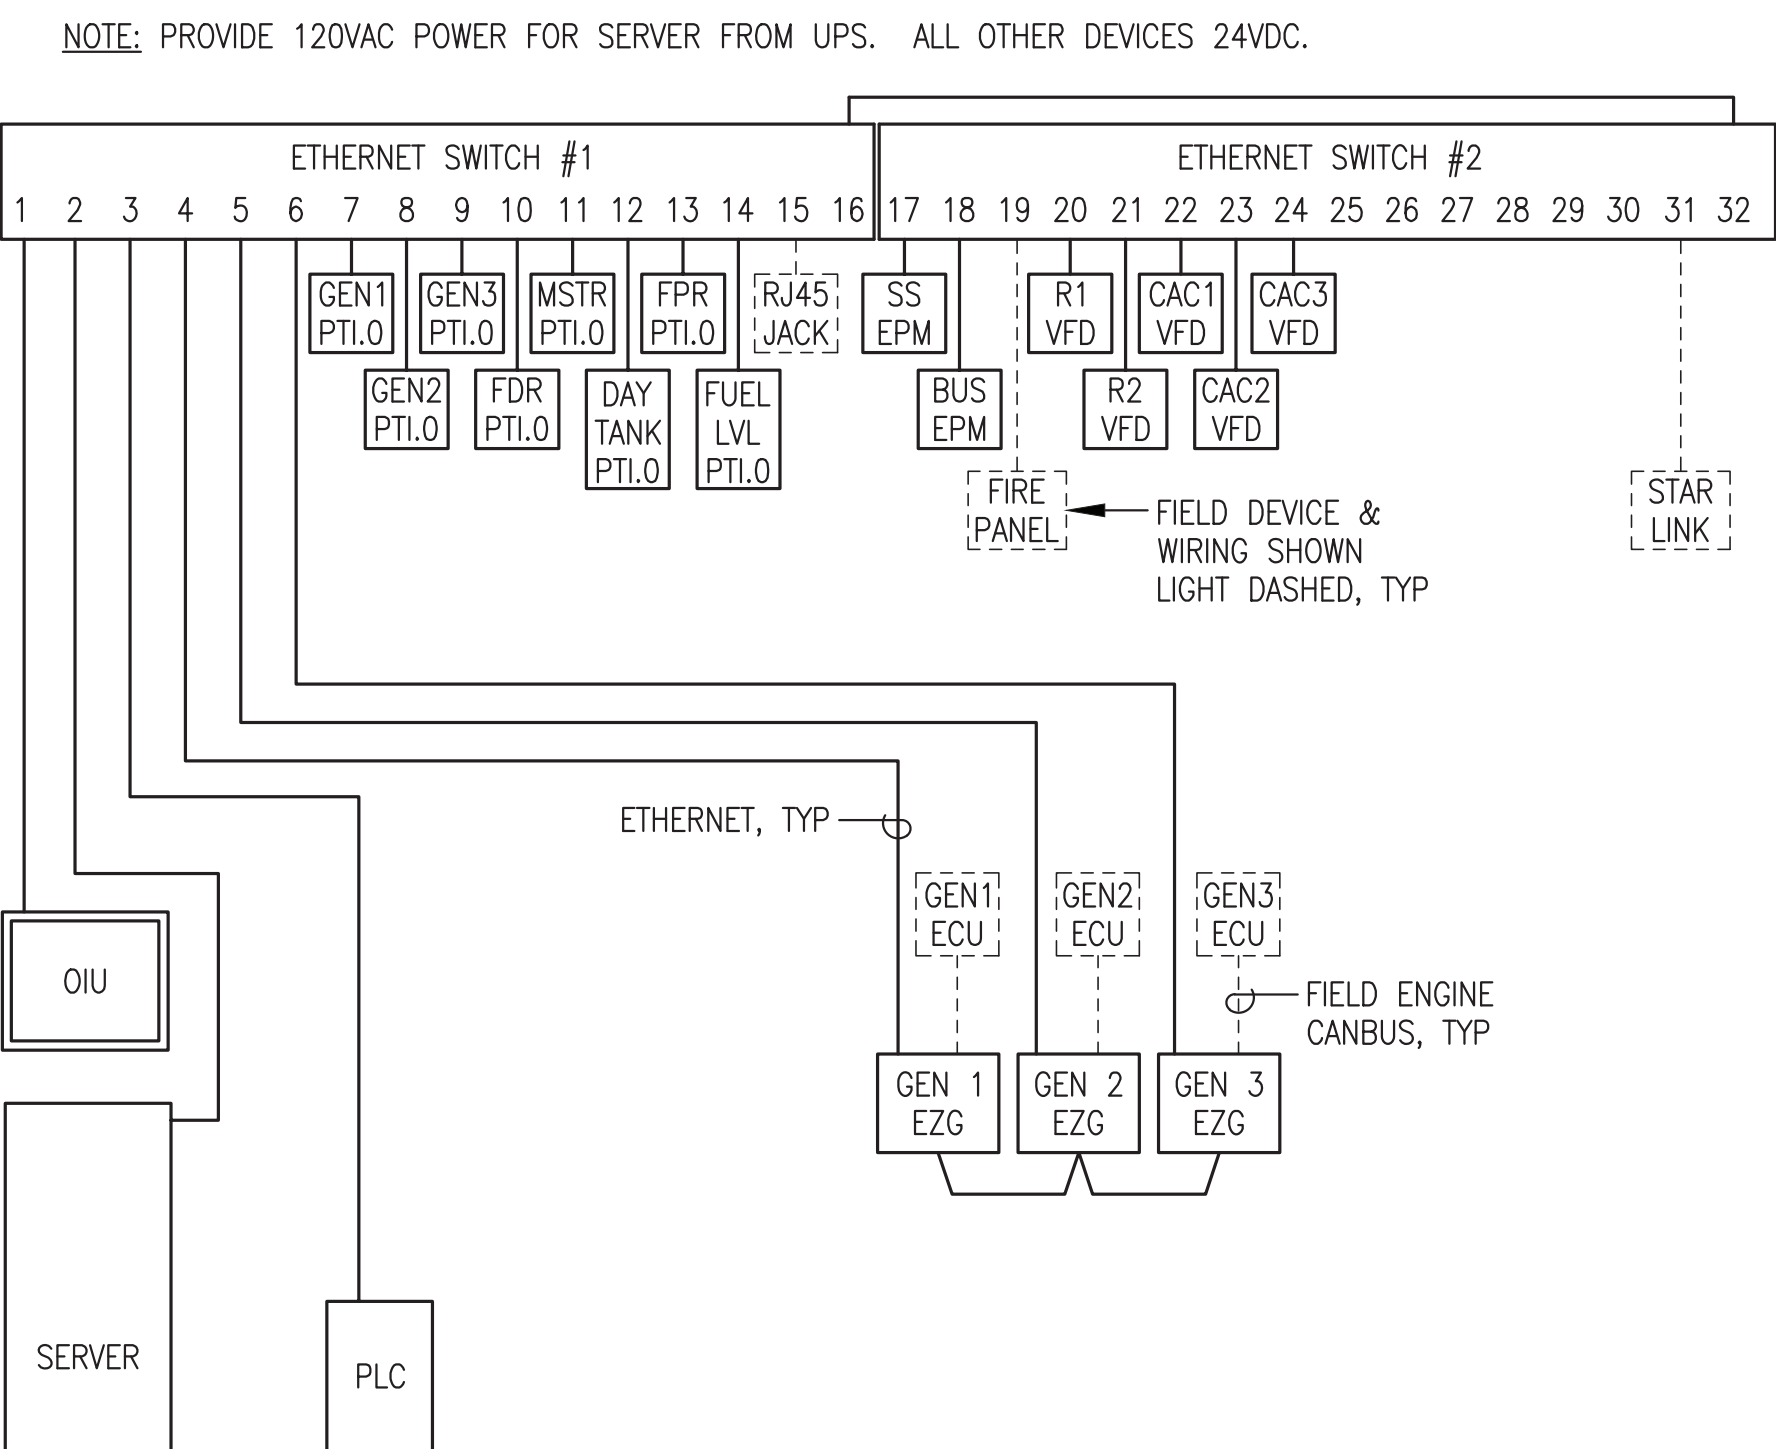

2 COMMUNICATION SCHEMATIC
E6.1 NO SCALE

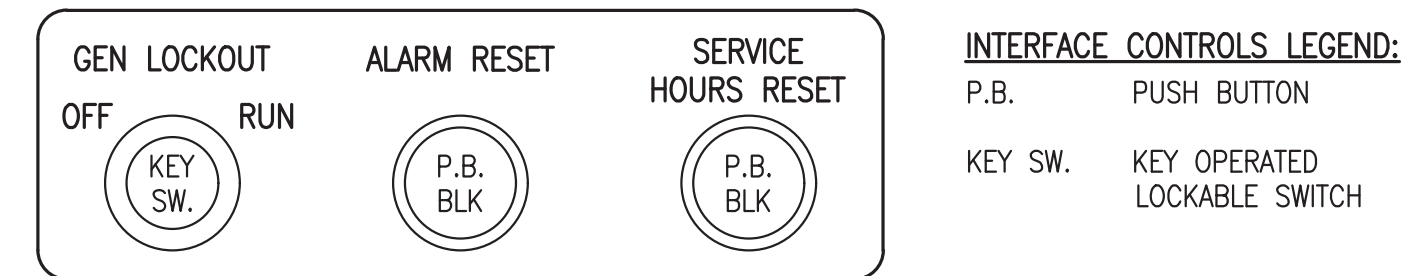

3 GENSET CONTROL (EZGN) INTERFACE CONTROLS
E6.1 NO SCALE

ALL WORK ON THIS SHEET WAS PERFORMED AS PART OF THE PRIOR MODULE FABRICATION CONTRACT AND IS SHOWN HERE FOR REFERENCE ONLY.

REV#1
ISSUED FOR
CONSTRUCTION
NOV 2023



REV.	DESCRIPTION	DATE	BY
1	REVISE PANEL TO MATCH SHOP AS BUILT	11/13/23	BCG

PROJECT: NAPASKIAK POWER SYSTEM UPGRADE


TITLE: SWITCHGEAR ENCLOSURE LAYOUT, SETTING TABLE, & DETAILS

ALASKA ENERGY AUTHORITY

Gray Stassel Engineering, Inc.
P.O. 111405, Anchorage, AK 99511 (907)349-0100

DRAWN BY: JTD
DESIGNED BY: CWV/BCG
FILE NAME: NAPS PP E6
PROJECT NUMBER:

SCALE: NO SCALE
DATE: 7/29/22
SHEET: E6.1

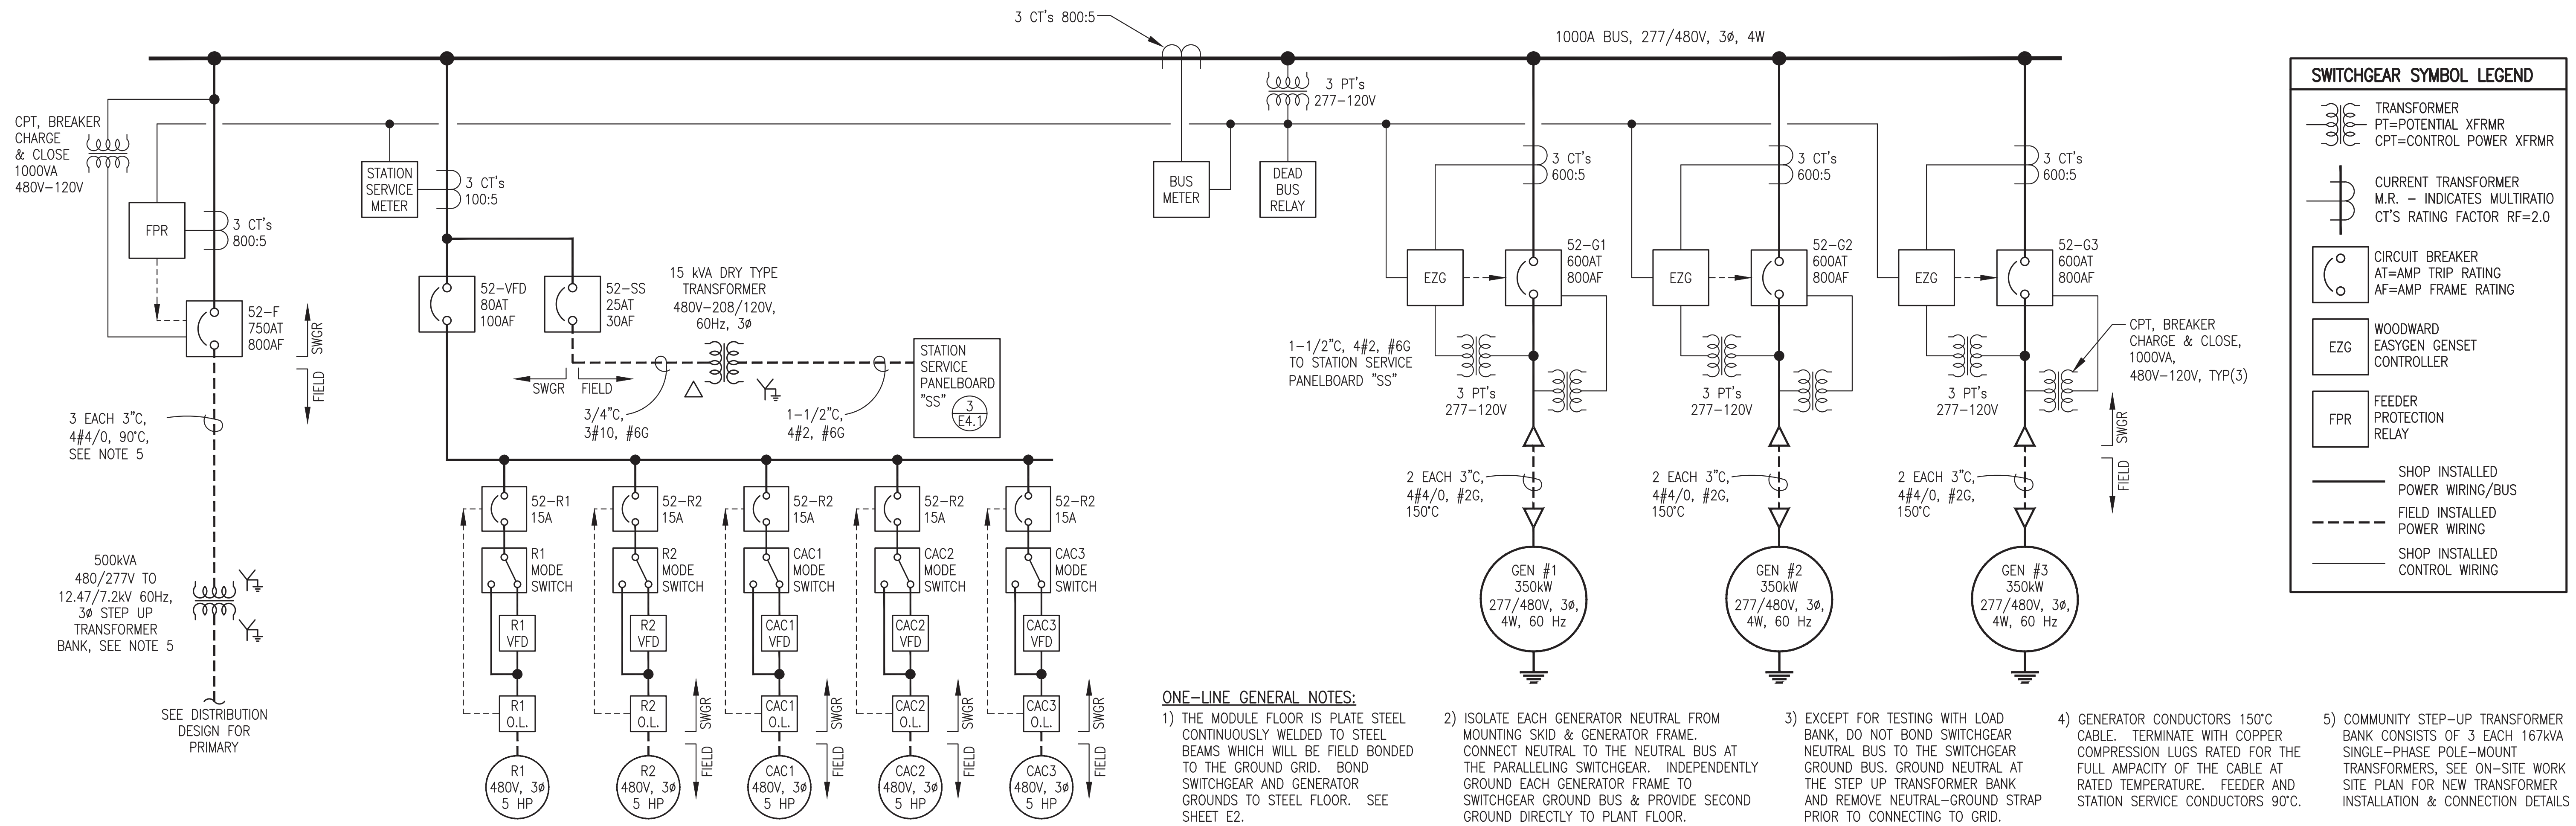

SWITCHGEAR SYMBOL LEGEND	
	TRANSFORMER PT=POTENTIAL XFRMR CPT=CONTROL POWER XFRMR
	CURRENT TRANSFORMER M.R. - INDICATES MULTIRATIO CT'S RATING FACTOR RF=2.0
	CIRCUIT BREAKER AT=AMP TRIP RATING AF=AMP FRAME RATING
	WOODWARD EASYGEN GENSET CONTROLLER
	FEEDER PROTECTION RELAY
	SHOP INSTALLED POWER WIRING/BUS
	FIELD INSTALLED POWER WIRING
	SHOP INSTALLED CONTROL WIRING

ONE-LINE GENERAL NOTES:

- 1) THE MODULE FLOOR IS PLATE STEEL CONTINUOUSLY WELDED TO STEEL BEAMS WHICH WILL BE FIELD BONDED TO THE GROUND GRID. BOND SWITCHGEAR AND GENERATOR GROUNDS TO STEEL FLOOR. SEE SHEET E2.
- 2) ISOLATE EACH GENERATOR NEUTRAL FROM MOUNTING SKID & GENERATOR FRAME. CONNECT NEUTRAL TO THE NEUTRAL BUS AT THE PARALLELING SWITCHGEAR. INDEPENDENTLY GROUND EACH GENERATOR FRAME TO SWITCHGEAR GROUND BUS & PROVIDE SECOND GROUND DIRECTLY TO PLANT FLOOR.
- 3) EXCEPT FOR TESTING WITH LOAD BANK, DO NOT BOND SWITCHGEAR NEUTRAL BUS TO THE SWITCHGEAR GROUND BUS. GROUND NEUTRAL AT THE STEP UP TRANSFORMER BANK AND REMOVE NEUTRAL-GROUND STRAP PRIOR TO CONNECTING TO GRID.
- 4) GENERATOR CONDUCTORS 150°C CABLE. TERMINATE WITH COPPER COMPRESSION LUGS RATED FOR THE FULL AMPACITY OF THE CABLE AT RATED TEMPERATURE. FEEDER AND STATION SERVICE CONDUCTORS 90°C.
- 5) COMMUNITY STEP-UP TRANSFORMER BANK CONSISTS OF 3 EACH 167kVA SINGLE-PHASE POLE-MOUNT TRANSFORMERS, SEE ON-SITE WORK SITE PLAN FOR NEW TRANSFORMER INSTALLATION & CONNECTION DETAILS

1 SWITCHGEAR ONE-LINE DIAGRAM
E6.2 NO SCALE

ARC FLASH NOTES:

- 1) PERMANENTLY AFFIX ARC FLASH LABELS TO EACH SECTION WITH 480V POWER AS INDICATED.
- 2) SCALED PDF IMAGES OF THESE LABELS WILL BE FURNISHED TO THE FABRICATOR UPON REQUEST.

Arc Flash and Shock Hazard
Appropriate PPE Required

Arc Flash Boundary	1.6 ft
Incident Energy (cal/cm ²)	1.3
Working Distance	18.0 in

Shock Hazard Exposure: 480 V
Shock Hazard when covers removed

Limited Approach	3.5 ft Class 00
Restricted Approach	1.0 ft Insulating Gloves V-rating 500 VAC

GENERATOR

Arc Flash and Shock Hazard
Appropriate PPE Required


Arc Flash Boundary	1.6 ft
Incident Energy (cal/cm ²)	1.3
Working Distance	18.0 in

Shock Hazard Exposure: 480 V
Shock Hazard when covers removed


Limited Approach	3.5 ft Class 00
Restricted Approach	1.0 ft Insulating Gloves V-rating 500 VAC

FEEDER

2 ARC FLASH LABELS
E6.2 NO SCALE

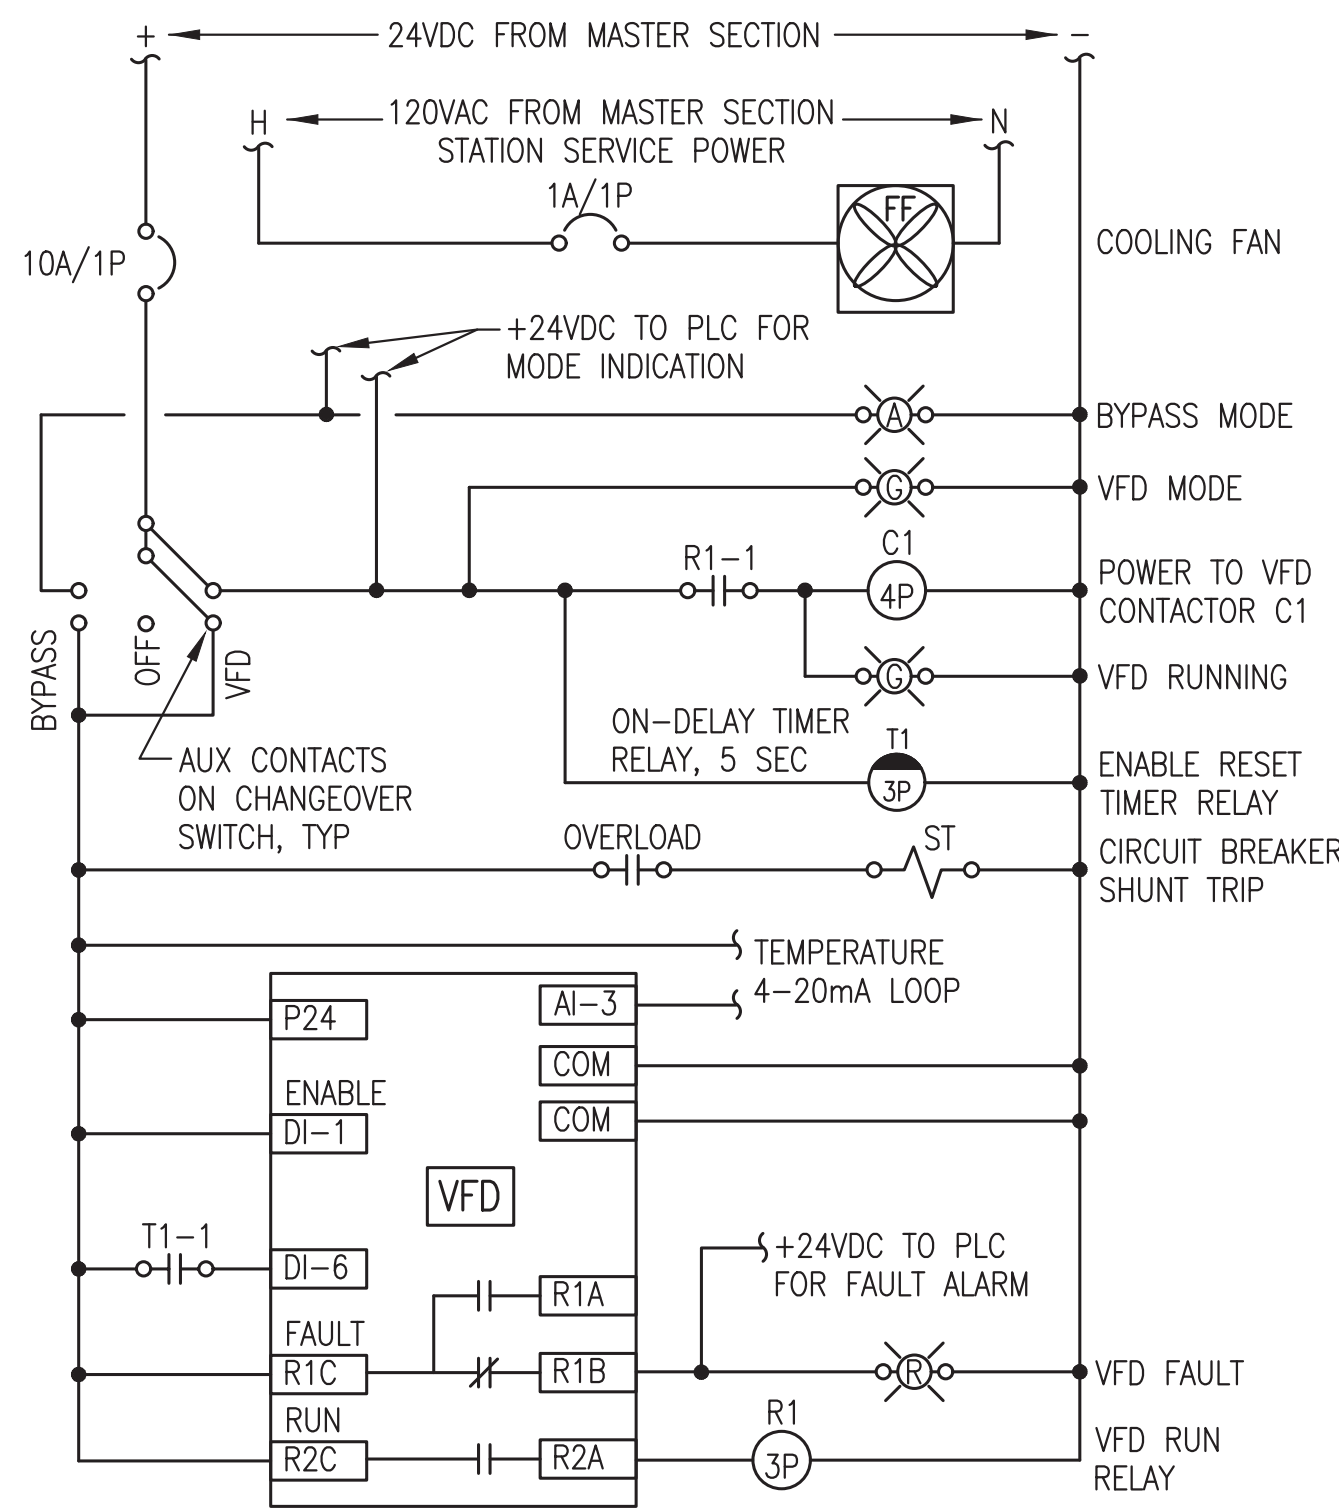

3 TYPICAL RADIATOR VFD LOGIC DIAGRAM
E6.2 NO SCALE

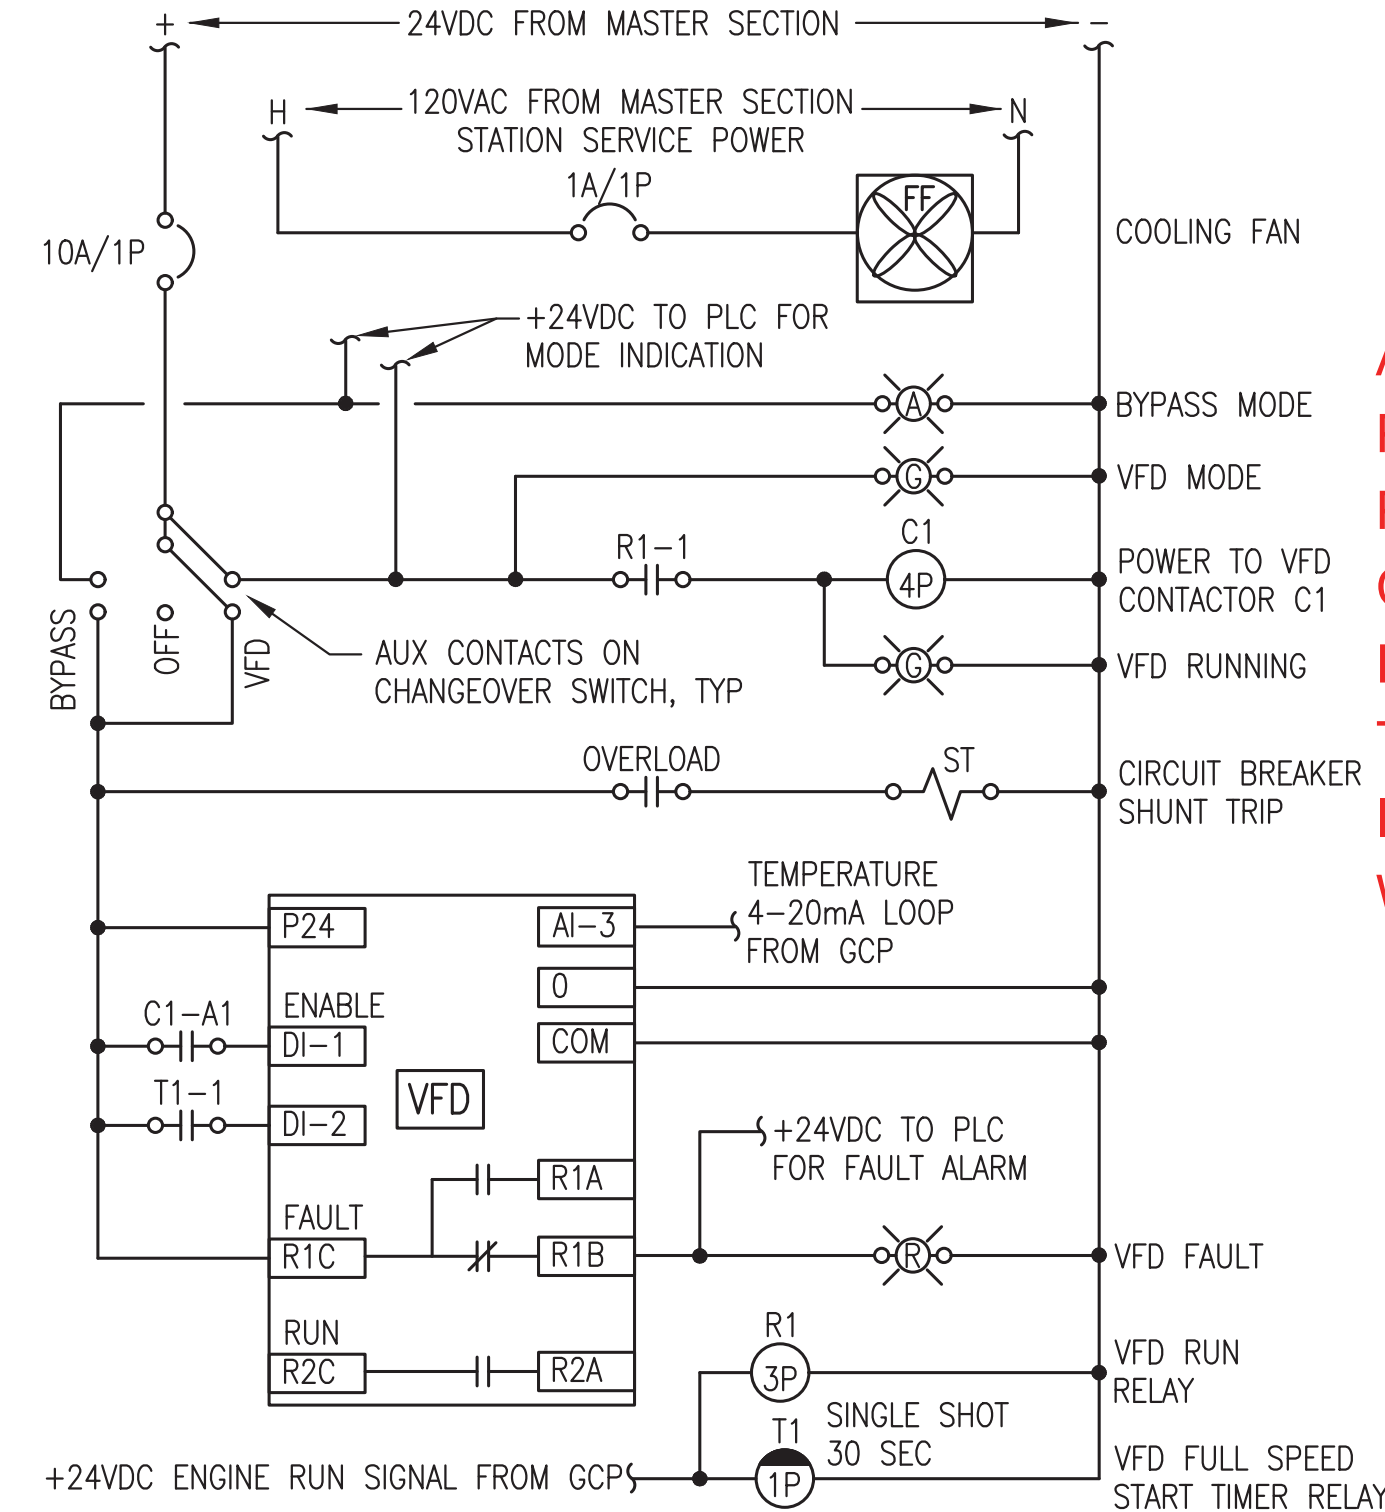

4 TYPICAL CHARGE AIR COOLER VFD LOGIC DIAGRAM
E6.2 NO SCALE

ALL WORK ON THIS SHEET WAS PERFORMED AS PART OF THE PRIOR MODULE ASSEMBLY CONTRACT EXCEPT FOR THE FEEDER AND STEP UP TRANSFORMER WHICH ARE INCLUDED IN THE ON SITE WORK.



ISSUED FOR CONSTRUCTION
JULY 2022


ALASKA ENERGY AUTHORITY

PROJECT: **NAPASKIAK POWER SYSTEM UPGRADE**


TITLE: **SWITCHGEAR ONE-LINE & DETAILS**

DESIGNED BY: CWV/BCG	DATE: 7/29/22
FILE NAME: NAPS PP E6	SHEET: E6.2
PROJECT NUMBER:	


Gray Stassel Engineering, Inc.
P.O. 111405, Anchorage, AK 99511 (907)349-0100

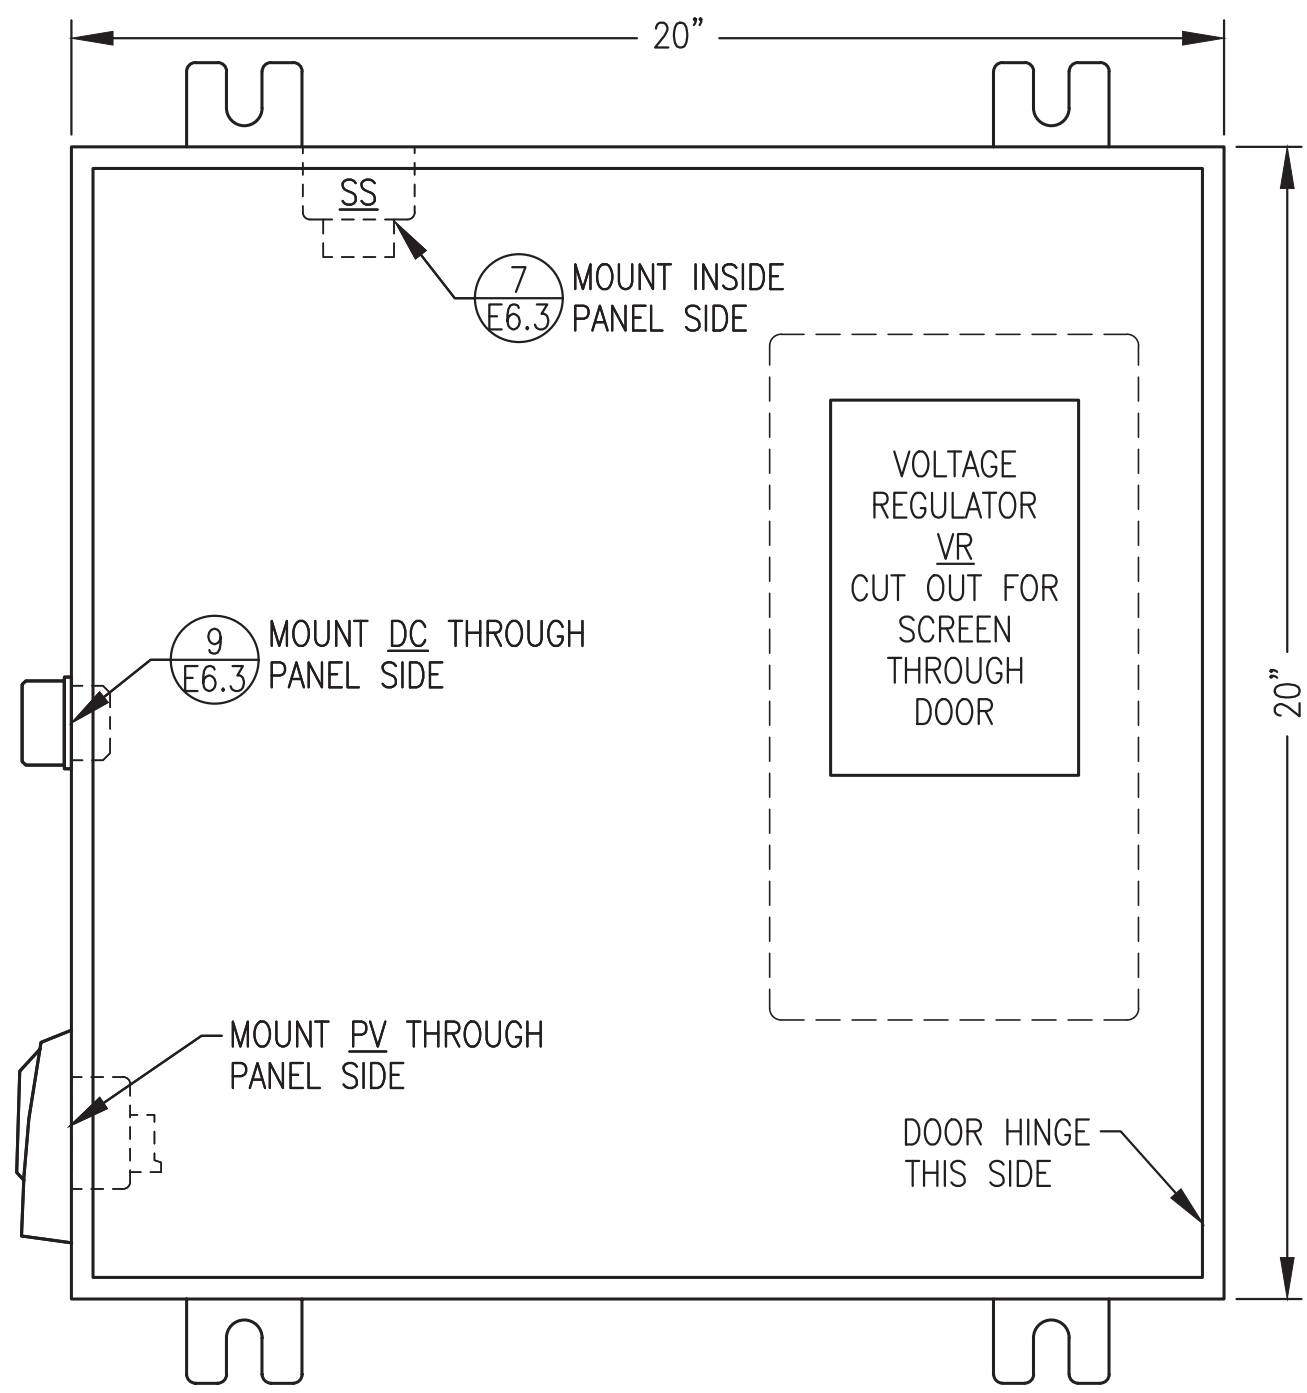


1 JUNCTION BOX FRONT PANEL LAYOUT
E6.3 NO SCALE

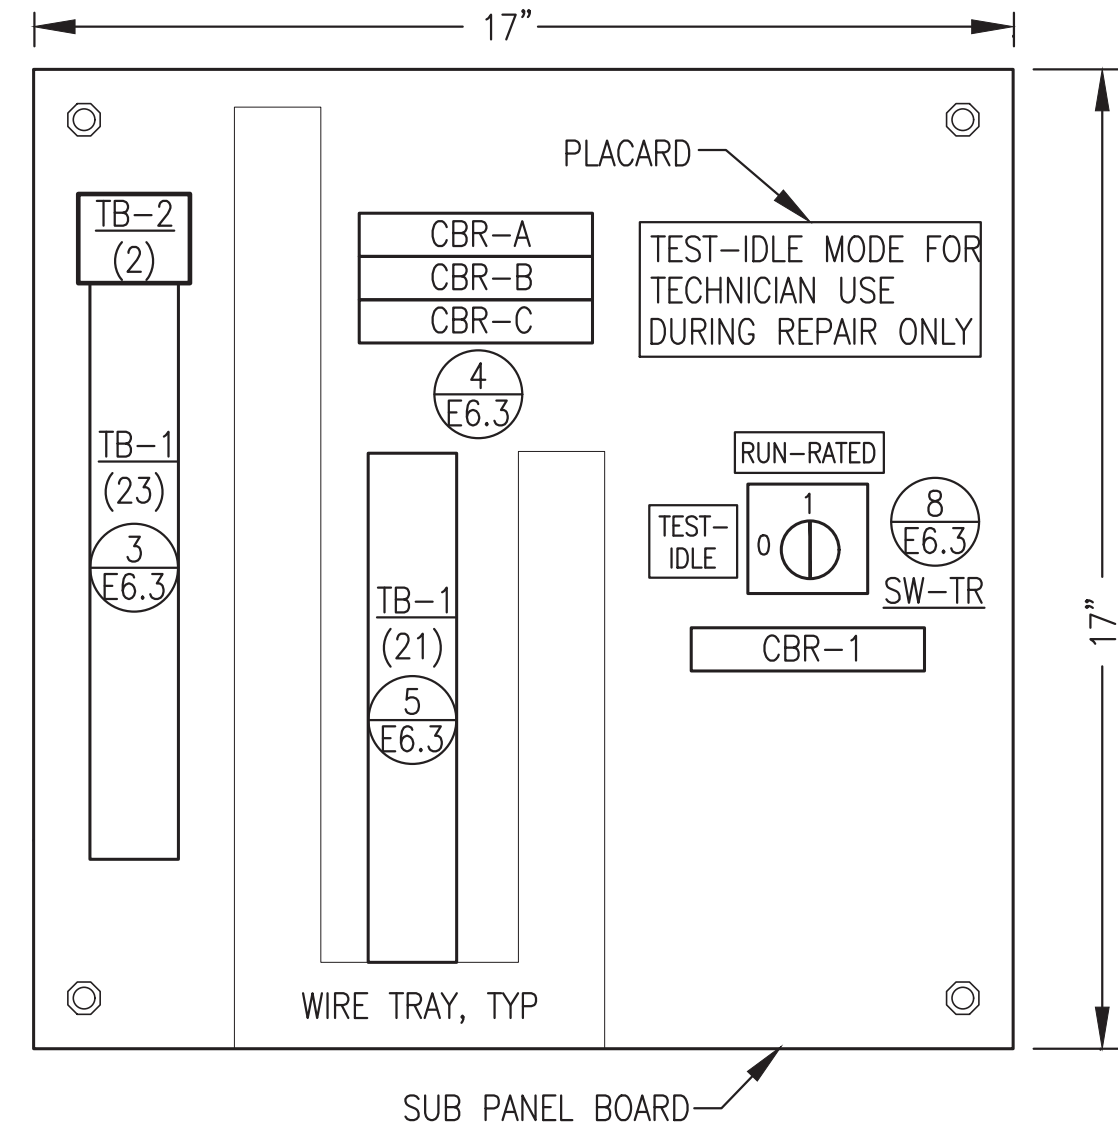


2 JUNCTION BOX SUB PANEL LAYOUT
E6.3 NO SCALE

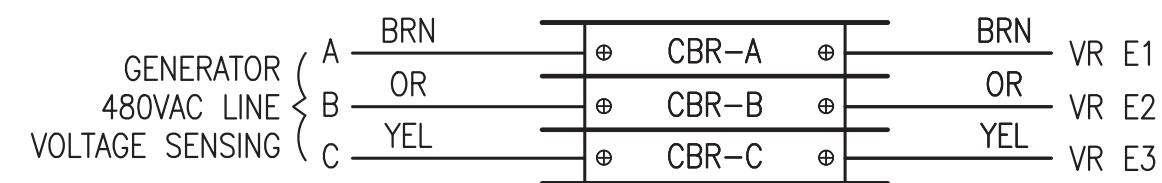

4 CIRCUIT BREAKER CONNECTIONS
E6.3 NO SCALE

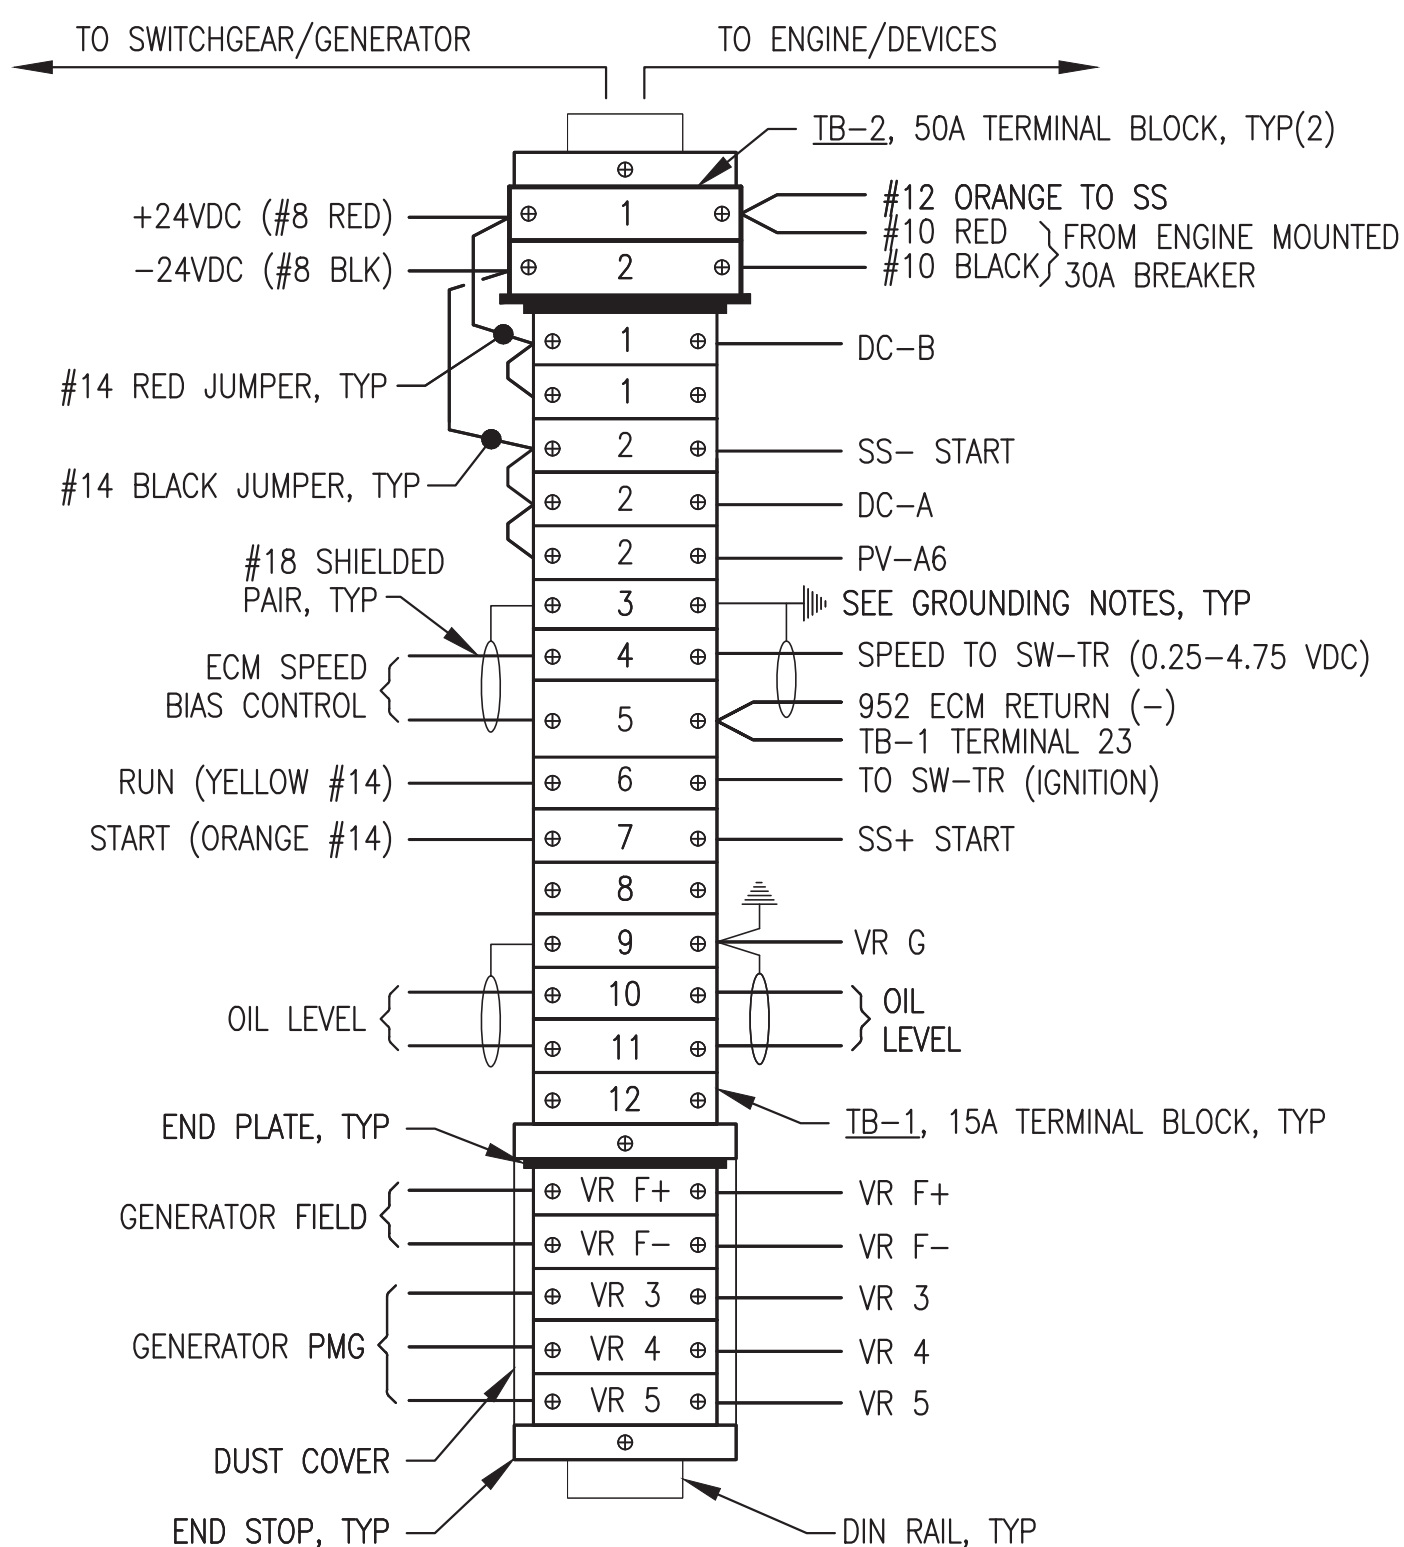

3 TERMINAL STRIP CONNECTIONS
E6.3 NO SCALE

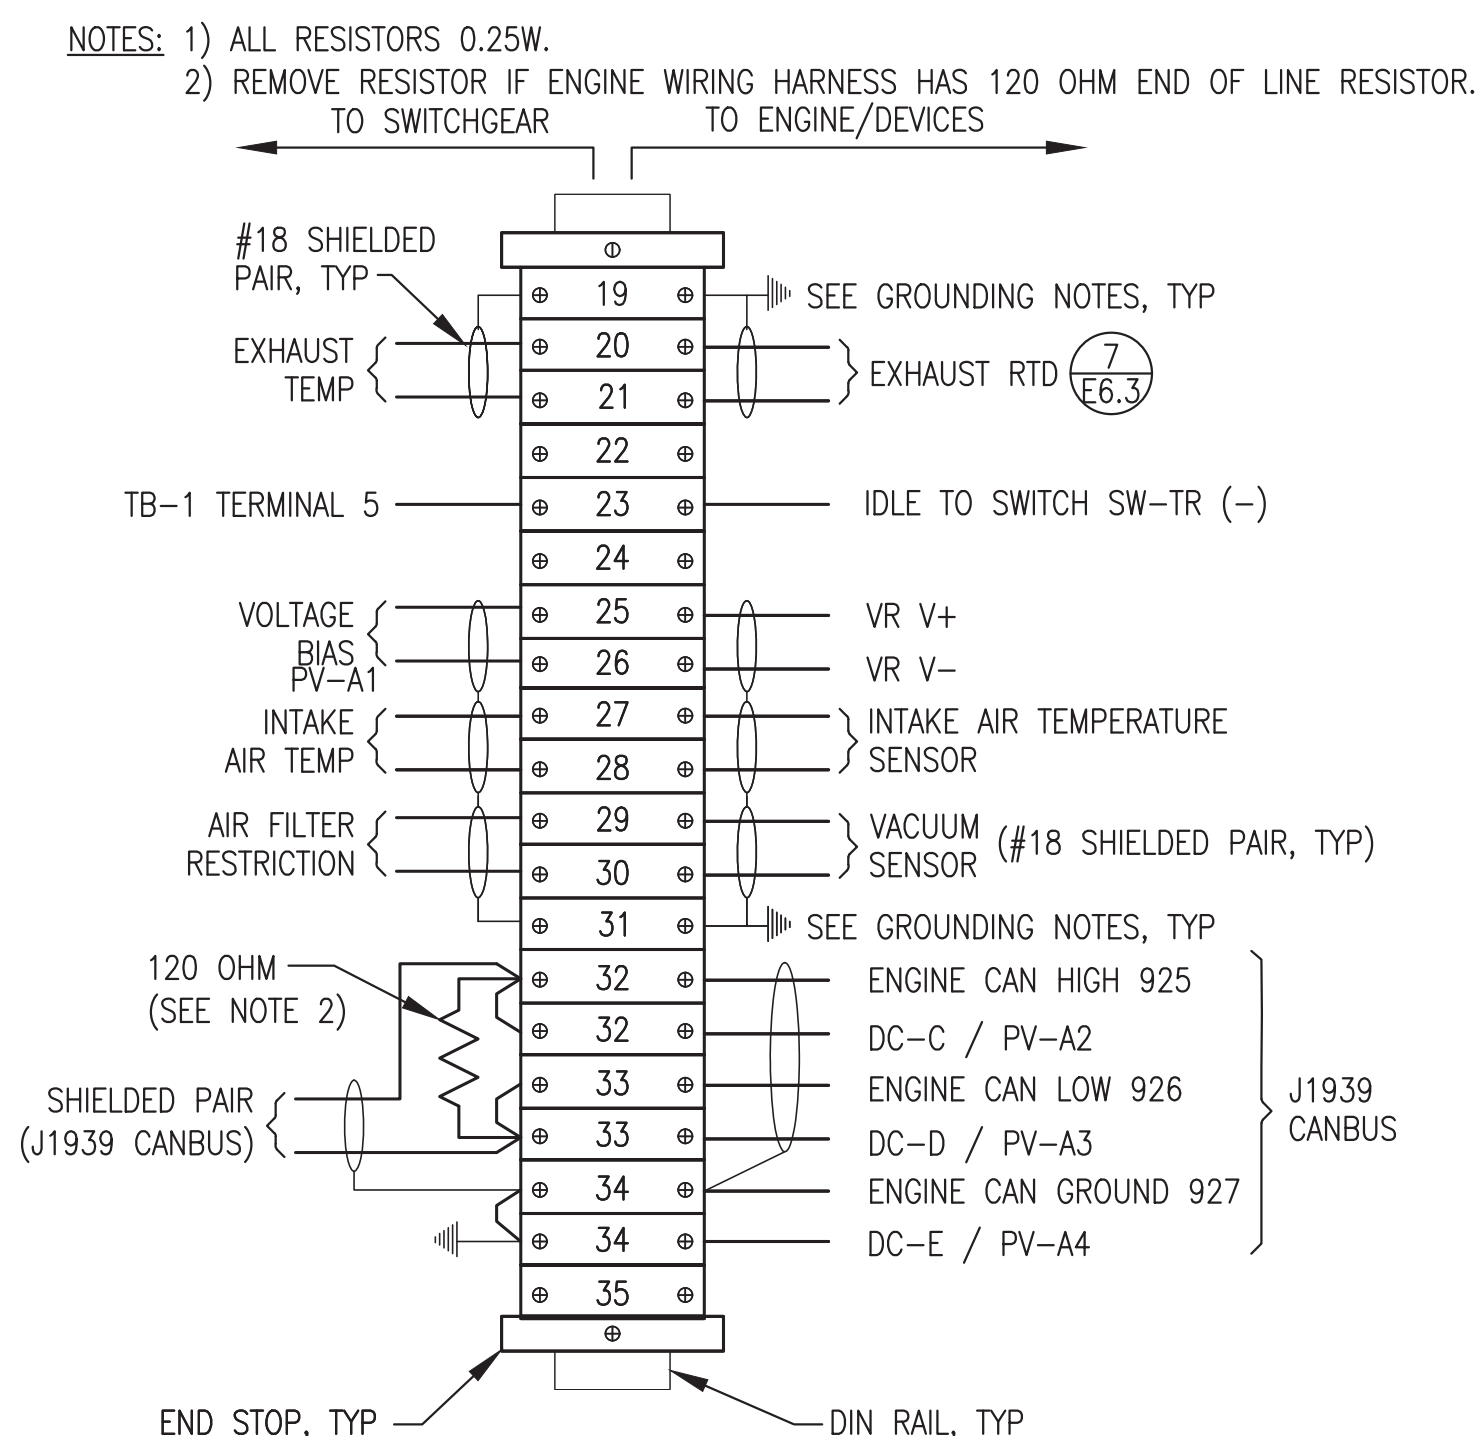

5 TERMINAL STRIP CONNECTIONS
E6.3 NO SCALE

TAG	MANUFACTURER	MODEL	DESCRIPTION
CBR-A/B/C	ALLEN-BRADLEY	1489-M1-C010	RAIL MOUNT CIRCUIT BREAKER, 1P, 1A
CBR-1	ALLEN-BRADLEY	1489-M1-C050	RAIL MOUNT CIRCUIT BREAKER, 1P, 5A
DC	DEUTSCH	HD10-9-1939P	DIAGNOSTIC CONNECTOR, 9-PIN, CAN-BUS
	DEUTSCH	HD18-009	CONNECTOR STRAIN RELIEF
	DEUTSCH	HDC16-9	CONNECTOR PROTECTIVE DUST CAP
	DEUTSCH	HD10-9-GKT	CONNECTOR GASKET
	DEUTSCH	JDL062397	CONNECTOR LANYARD
ENCL.	HOFFMAN	A20H20ALP	20x20x8" NEMA 12
	HOFFMAN	A20P20	BACK PANEL
PV	MURPHY	PV101-C	POWER VIEW (NON-TIER 4) WITH HARNESS
SS	JOHN DEERE	AT145341	STARTER AUXILIARY SOLENOID, 24V
SW-TR	ALLEN-BRADLEY	194L-A12-225-2	CHANGEOVER SWITCH, 12A, 2P
	ALLEN-BRADLEY	194L-HE-4A-175	90 DEGREE I-O HANDLE
TB-1	IDEC	BNH15LW	15A DIN RAIL-MOUNT TERMINAL BLOCK
TB-2	IDEC	BNH50W	50A DIN RAIL-MOUNT TERMINAL BLOCK
VR	BASLER	DECS-150 5NS1V1N1S	DIGITAL VOLTAGE REGULATOR


BRAND SPECIFIC NOTE: SPECIFIC PARTS MANUFACTURER AND MODEL SELECTED NOT ONLY TO MEET PERFORMANCE FUNCTION BUT ALSO TO COORDINATE AND INTERFACE WITH OTHER DEVICES AND SYSTEMS. APPROVED EQUAL SUBSTITUTIONS WILL BE ALLOWED ONLY BY ENGINEER'S APPROVAL. TO OBTAIN APPROVAL, SUBMITTALS MUST CLEARLY DEMONSTRATE HOW SUBSTITUTE ITEM MEETS OR EXCEEDS SPECIFIED ITEM QUALITY AND PERFORMANCE CHARACTERISTICS AND ALSO COMPLIES WITH MECHANICAL AND/OR ELECTRICAL CONNECTIONS AND PHYSICAL LAYOUT REQUIREMENTS.

SHOP FABRICATION NOTES:


- 1) PROVIDE ASSEMBLY WITH ALL DEVICES AND WIRING INDICATED.
- 2) INSTALL IN A NEMA 12 ENCLOSURE WITH MOUNTING FLANGES AT BACK, A MIN 14 GAUGE INTERIOR BACK PANEL AND HINGED LOCKABLE DOOR. SIZE AS INDICATED.
- 3) PROVIDE DIN RAIL, TERMINAL END PLATES, TERMINAL END STOPS, TERMINAL DUST COVERS AND OTHER MISCELLANEOUS HARDWARE AS REQUIRED TO MATCH TERMINALS. LABEL ALL TERMINALS EXACTLY AS INDICATED ON THE DETAILS.
- 4) ALL WIRE #14AWG EXCEPT WHERE SPECIFICALLY INDICATED OTHERWISE. LABEL BOTH ENDS OF ALL JUMPERS WITH THE ENGINE PANEL TERMINAL NUMBER.
- 5) PROVIDE MECHANICAL GROUND LUGS FASTENED TO BACK PANEL AND GROUNDED TO ENGINE-GENERATOR. GROUND ALL SHIELD DRAIN WIRES TO LUGS AT BACK PANEL ONLY.
- 6) PROVIDE WIRING HARNESSSES FOR CONNECTION TO GENERATOR AND TO ENGINE. INSTALL WIRES IN LIQUID TIGHT FLEX OR FLEXIBLE PLASTIC WIRE LOOM AND PROVIDE SERVICE LOOPS IN ACCORDANCE WITH SPECIFICATIONS.
- 7) SHOP TEST EACH NEW ENGINE-GENERATOR WITH ASSOCIATED JUNCTION BOX PERMANENTLY CONNECTED. UPON COMPLETION OF TESTING, COIL WIRING HARNESSSES AND SECURE JUNCTION BOX TO GENERATOR FOR SHIPPING.

FIELD INSTALLATION NOTES:


- 1) PERFORM ALL FIELD WIRING IN ACCORDANCE WITH SPECIFICATIONS. LABEL BOTH ENDS OF ALL FIELD WIRING WITH THE ENGINE PANEL TERMINAL NUMBER.
- 2) ON SHIELDED CONDUCTORS GROUND ALL SHIELD DRAIN WIRES AT ENGINE J-BOX ONLY. CLIP DRAIN WIRES AT OPPOSITE ENDS.

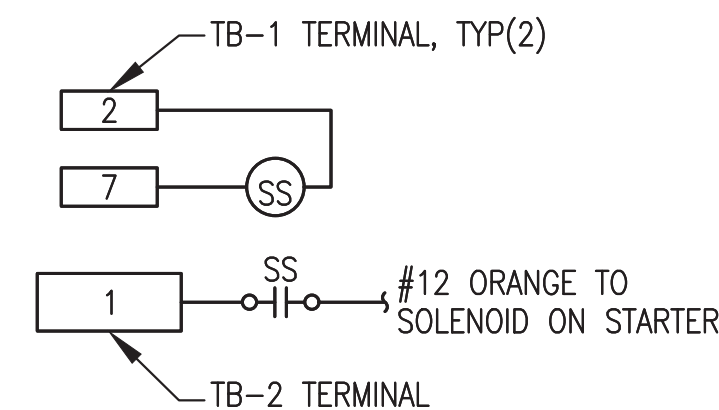


6 STARTER AUX SOLENOID SS WIRING
E6.3 NO SCALE

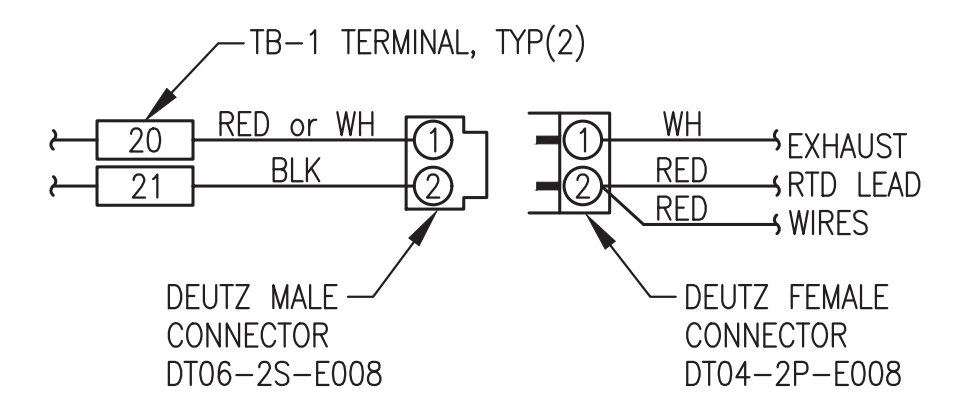

7 EXHAUST RTD CONNECTOR
E6.3 NO SCALE

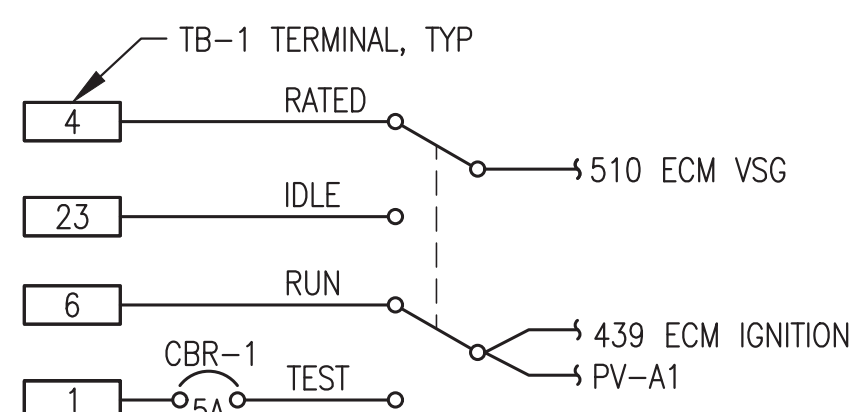


8 TEST-IDLE/RUN-RATED SWITCH SW-TR WIRING
E6.3 NO SCALE

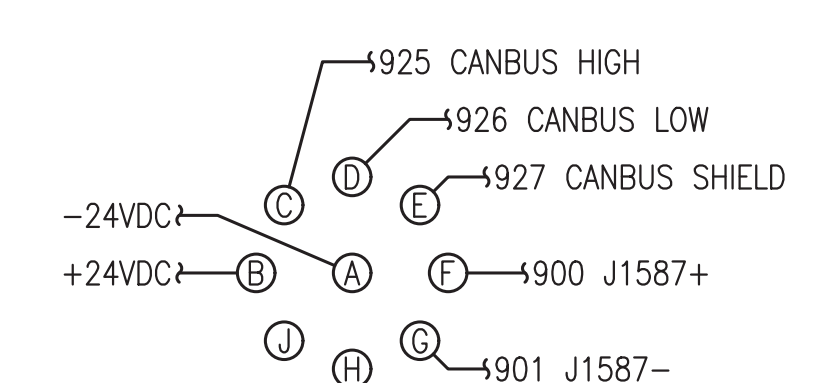

9 DIAGNOSTIC CONNECTOR WIRING
E6.3 NO SCALE

ALL WORK ON THIS SHEET WAS PERFORMED AS PART OF THE PRIOR MODULE FABRICATION CONTRACT AND IS SHOWN HERE FOR REFERENCE ONLY.

ISSUED FOR CONSTRUCTION JULY 2022

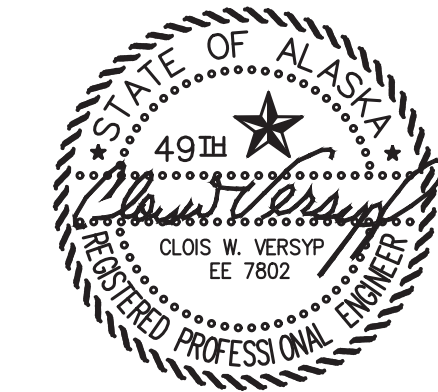

ALASKA ENERGY AUTHORITY


PROJECT: **NAPASKIAK POWER SYSTEM UPGRADE**

TITLE: **24VDC ENGINE WIRING JUNCTION BOX**


Gray Stassel Engineering, Inc.
P.O. 111405, Anchorage, AK 99511 (907)349-0100

DRAWN BY: JTD
DESIGNED BY: CWV/BCG
FILE NAME: NAPS PP E6
PROJECT NUMBER:

SCALE: NO SCALE
DATE: 7/29/22
SHEET: **E6.3**

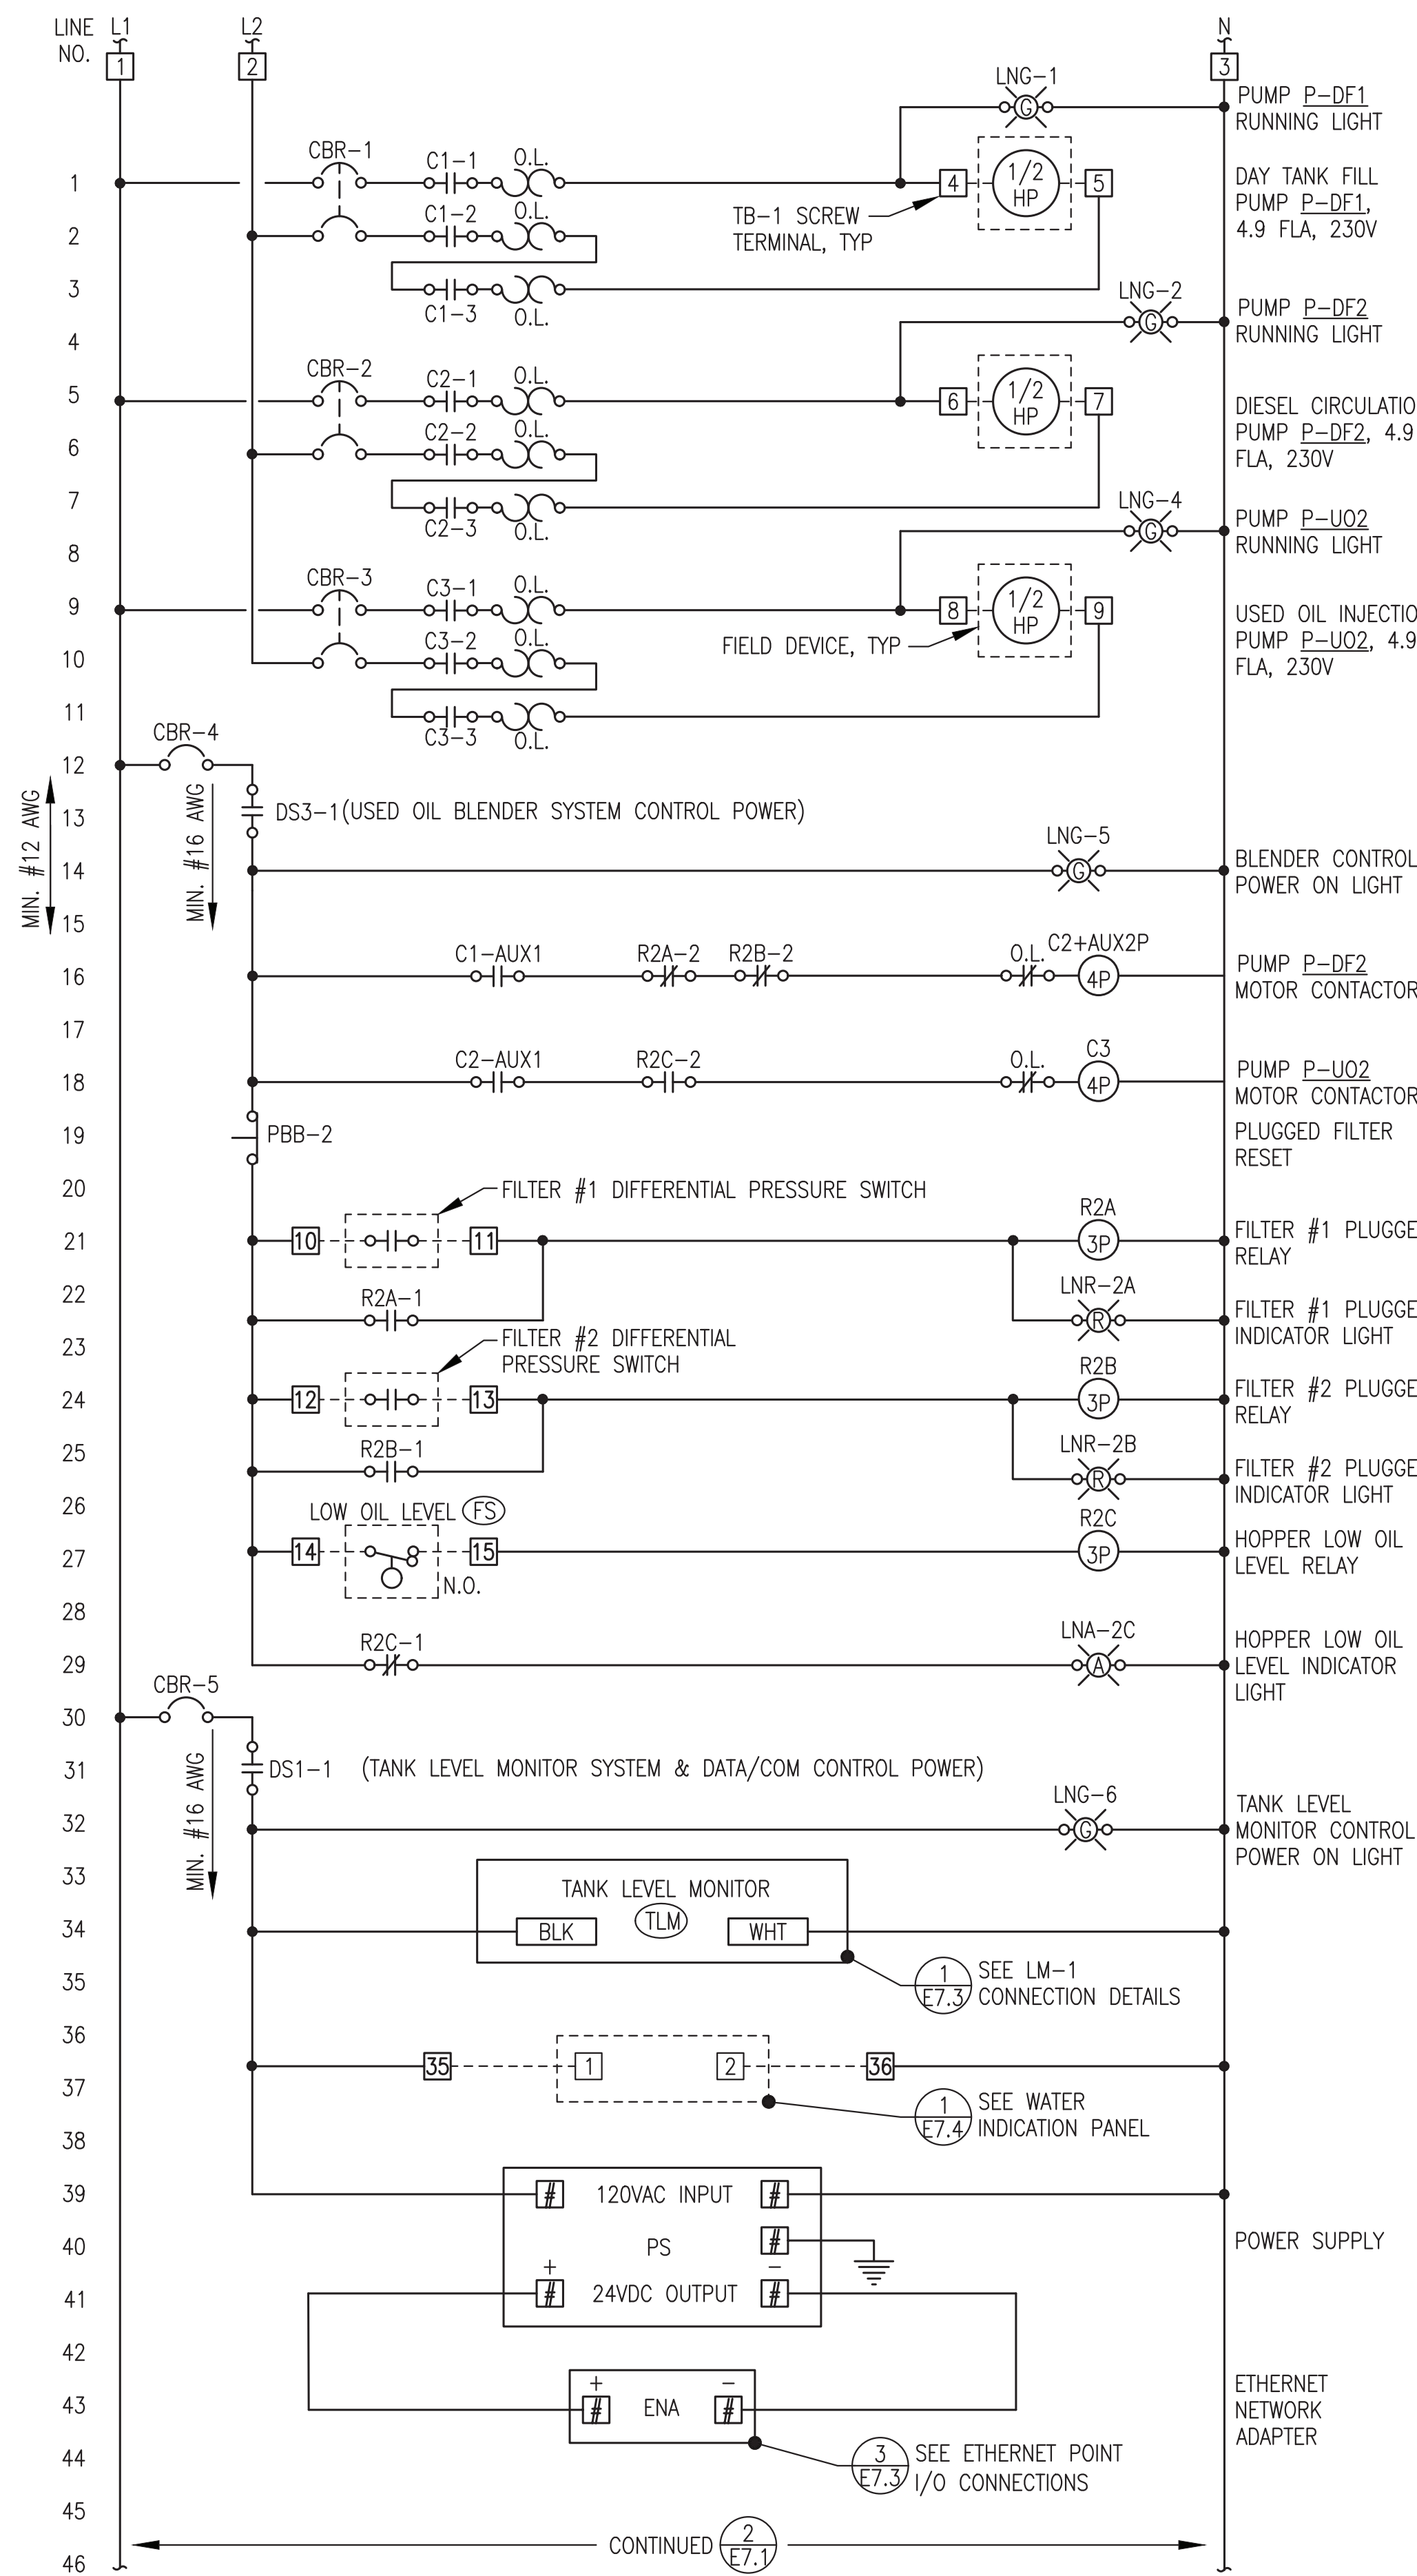

1 USED OIL BLENDER SYSTEM LOGIC DIAGRAM
E7.1 NO SCALE

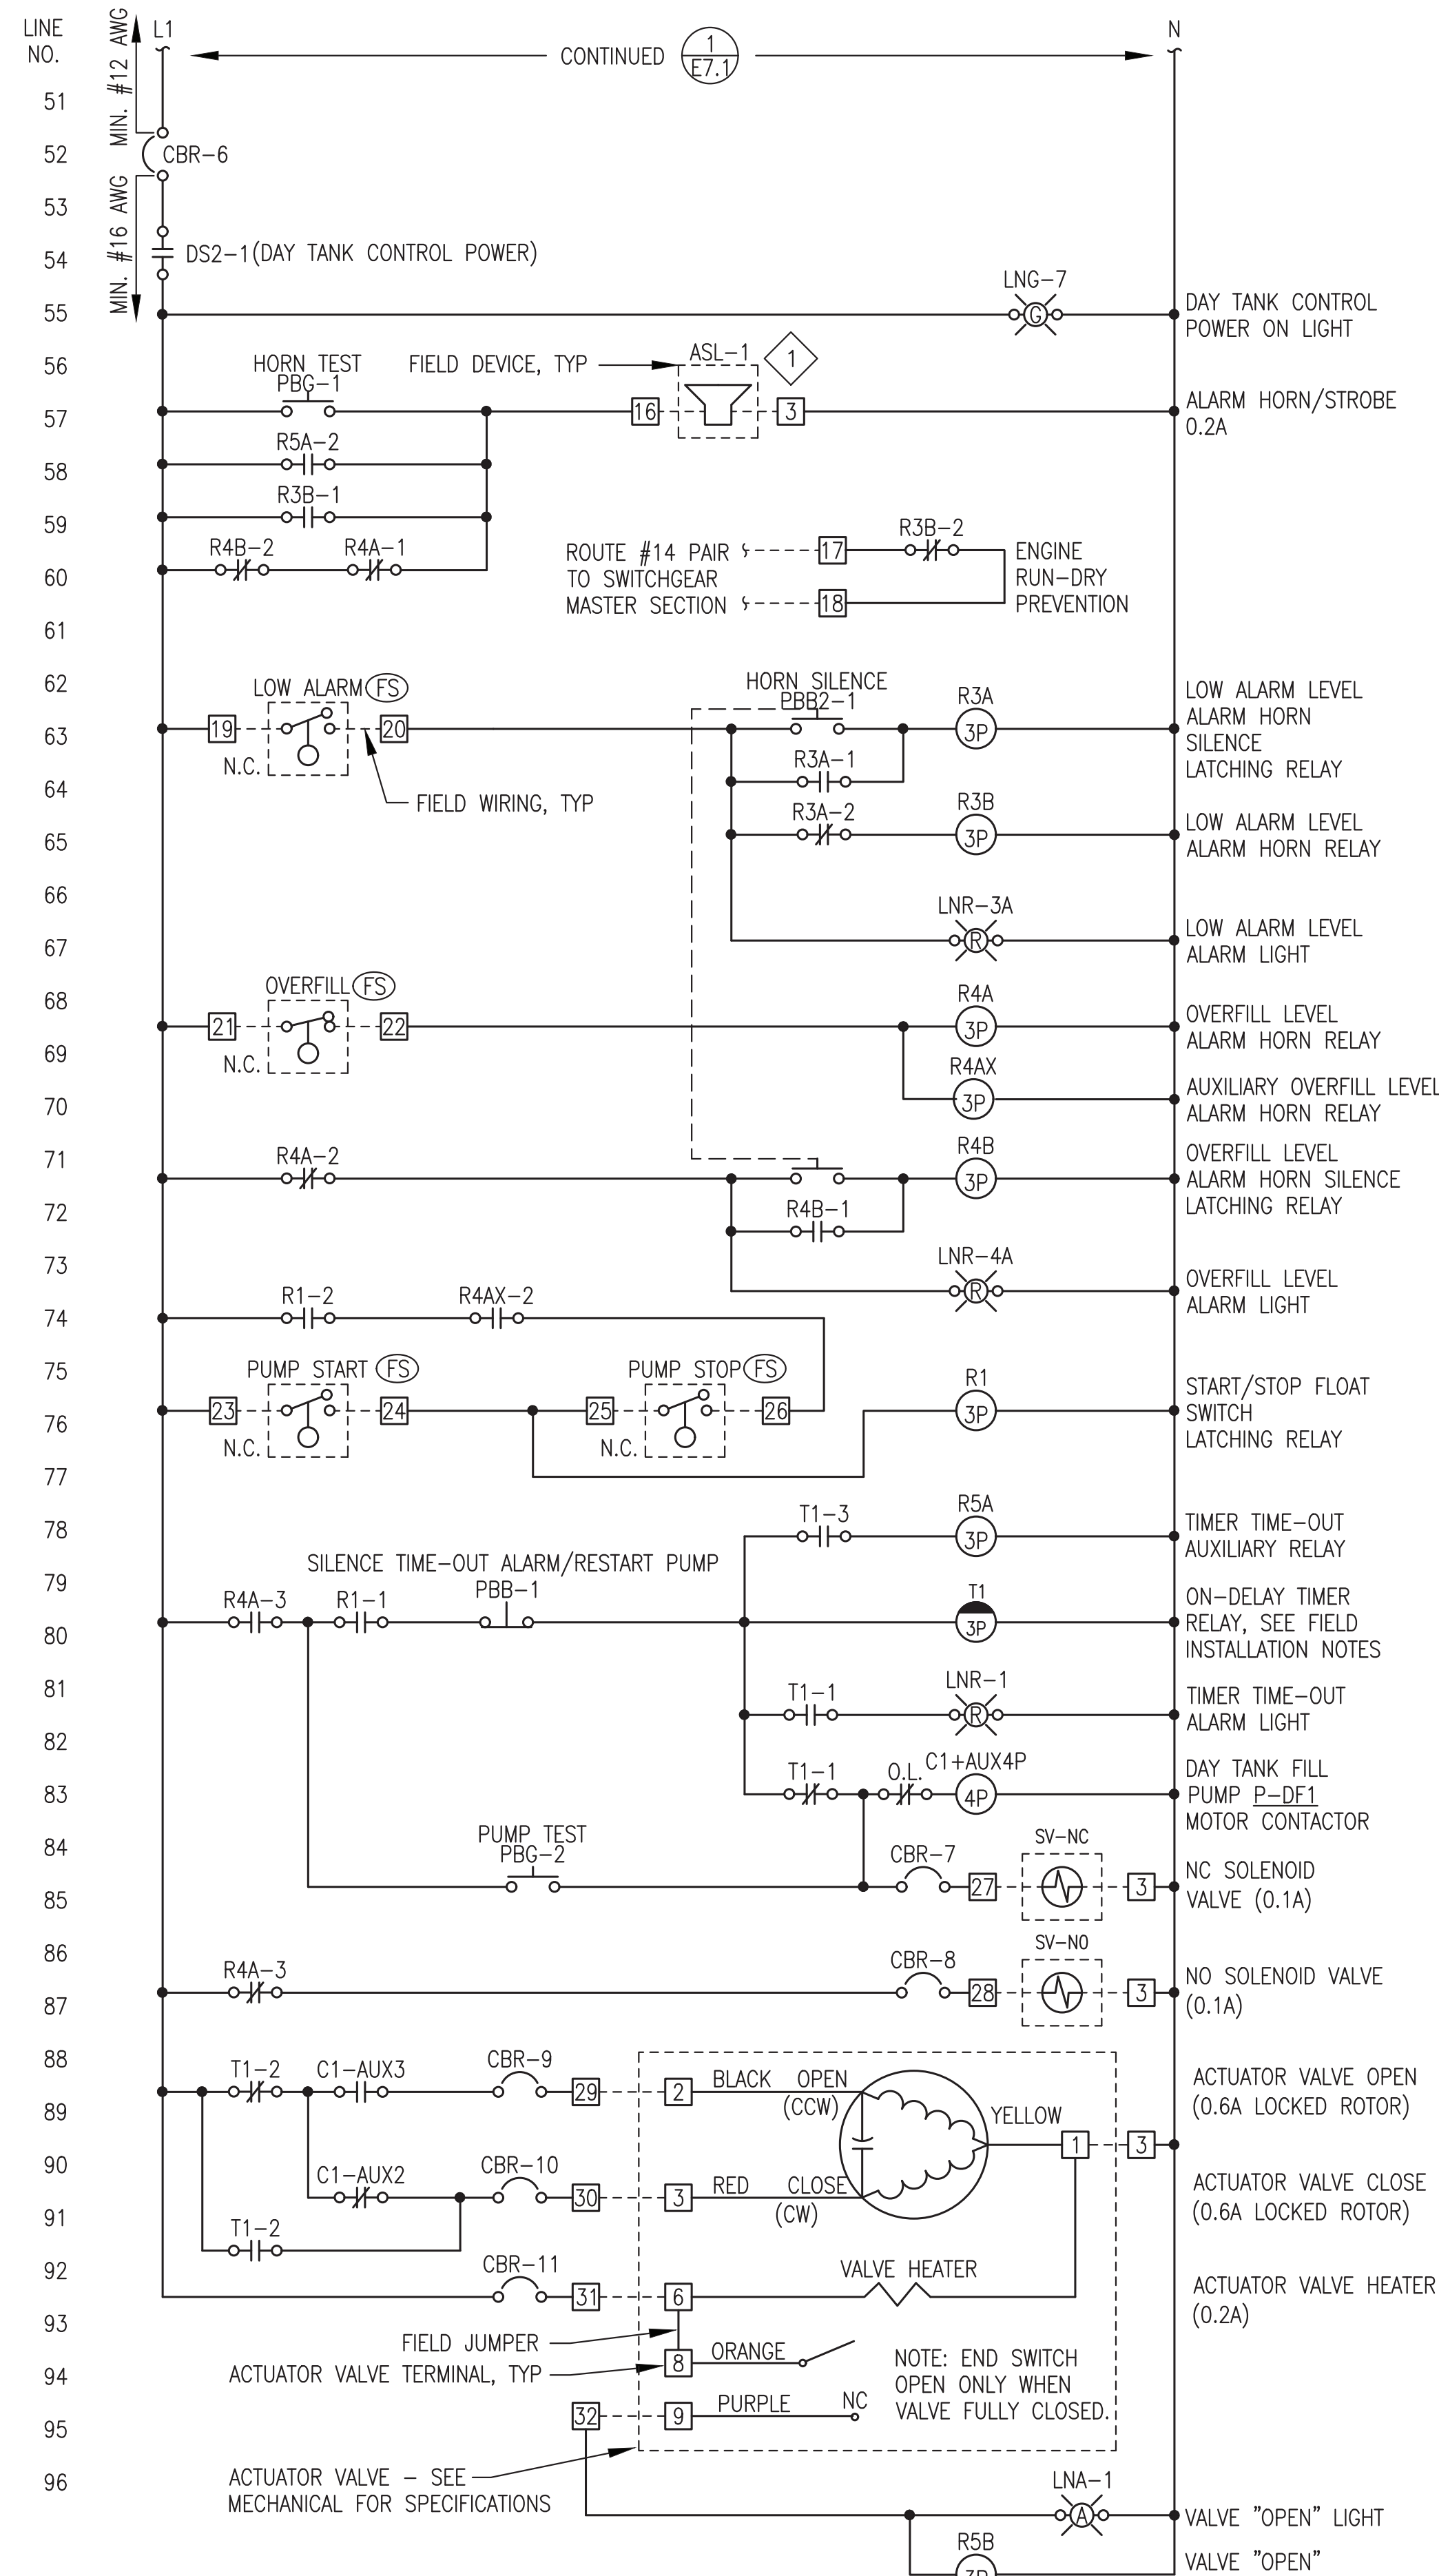

2 DAY TANK LOGIC DIAGRAM
E7.1 NO SCALE

BILL OF MATERIALS

NOTE: ON THIS SHEET AND THE PANEL DRAWINGS THAT FOLLOW SPECIFIC PARTS MANUFACTURER AND MODEL ARE SELECTED NOT ONLY TO MEET PERFORMANCE FUNCTION BUT ALSO TO COORDINATE AND INTERFACE WITH OTHER DEVICES AND SYSTEMS. APPROVED EQUAL SUBSTITUTIONS WILL BE ALLOWED ONLY BY ENGINEER'S APPROVAL. TO OBTAIN APPROVAL, SUBMITTALS MUST CLEARLY DEMONSTRATE HOW SUBSTITUTE ITEM MEETS OR EXCEEDS SPECIFIED ITEM QUALITY AND PERFORMANCE CHARACTERISTICS AND ALSO COMPLIES WITH MECHANICAL AND/OR ELECTRICAL CONNECTIONS AND PHYSICAL LAYOUT REQUIREMENTS.

TAG	MANUFACTURER	MODEL	DESCRIPTION
AUX2P	ALLEN-BRADLEY	100FA11	AUXILIARY CONTACT FOR CONTACTOR, 2 POLE, NO, NC
AUX4P	ALLEN-BRADLEY	100FA31	AUXILIARY CONTACT FOR CONTACTOR, 4 POLE, 3NO, 1NC
C	ALLEN-BRADLEY	100C09D10	CONTACTOR, 120V COIL, 9A, 4 POLE
CBR-1,2,3	ALLEN-BRADLEY	1489-M2-C150	RAIL-MOUNT CIRCUIT BREAKER, 2 POLE, 15A
CBR-4,5,6	ALLEN-BRADLEY	1489-M1-C050	RAIL-MOUNT CIRCUIT BREAKER, 1 POLE, 5A
CBR-7,8,9,10,11	ALLEN-BRADLEY	1489-M1-C010	RAIL-MOUNT CIRCUIT BREAKER, 1 POLE, 1A
DS	ALLEN-BRADLEY	194LE201753	DISCONNECT, 2 POSITION, 3 N.O., 20A, FACE MOUNT
ENA	ALLEN-BRADLEY	194LHC4E1751	KNOB ACTUATOR FOR LOAD SWITCH, ON/OFF, LOCKABLE
Di8	ALLAN-BRADLEY	1734-AENTR	I/O DUAL PORT ETHERNET NETWORK ADAPTER
LNG	ALLEN-BRADLEY	800HORH2G	GREEN LED PILOT LIGHT, 12-130V, NEMA 4X
LNR	ALLEN-BRADLEY	800HORH2R	RED LED PILOT LIGHT, 12-130V, NEMA 4X
LNA	ALLEN-BRADLEY	800HORH2A	AMBER LED PILOT LIGHT, 12-130V, NEMA 4X
OL	ALLEN-BRADLEY	193-1EEDB	OVERLOAD, 230V, 1Ø, ADJUSTABLE 3.2A-16.0A RANGE
PBB	ALLEN-BRADLEY	800HAR2D2	MOMENTARY PUSH BUTTON, 1 NO, NEMA 4X, BLACK
PBB2	ALLEN-BRADLEY	800HAR2A2	MOMENTARY PUSH BUTTON, 2 NO, NEMA 4X, BLACK
PBG	ALLEN-BRADLEY	800HAR1D1	MOMENTARY PUSH BUTTON, 1 NO, NEMA 4X, GREEN
PP	PHOENIX CONTACTS	FLPPRJ45/RJ45	ETHERNET PATCH PANEL, RJ45xRJ45, DIN RAIL MOUNT
PS	ALLEN-BRADLEY	CP5.241-S1	5A, 120VAC/24VDC POWER SUPPLY
R	ALLEN-BRADLEY	700HA33A1	3PDT RELAY
	ALLEN-BRADLEY	700HN101	11 PIN SOCKET BASE
T	ALLEN-BRADLEY	700HT3	SERIES B TIMING MODULE
	ALLEN-BRADLEY	700HA33A1	3PDT RELAY
	ALLEN-BRADLEY	700HN205	11 PIN RELAY SOCKET BASE FOR TIMER
TB-1,2	ALLEN-BRADLEY	1492CAM1L	35A, 600V, LARGE-HEAD SCREW TERMINALS
(TLM)			TANK LEVEL MONITOR, SEE INSTRUMENTATION SCHEDULE ON SHEET M1.1

LEGEND




—	PANEL WIRING	----	FIELD WIRING	O.L.	OVERLOADS
R#	CONTROL RELAY	R#-#	NORMALLY OPEN CONTACT	PB-#	NORMALLY OPEN MOMENTARY PUSH BUTTON
T#	TIME DELAY RELAY	SS-#	2-POSITION SELECTOR SWITCH	PB-#	NORMALLY CLOSED MOMENTARY PUSH BUTTON
C#	CONTACTOR	R#-#	NORMALLY CLOSED CONTACT	SV#	SOLENOID VALVE
#	TERMINAL BLOCK	SW-#	NORMALLY OPEN FLOAT SWITCH	ASL-#	ALARM & STROBE LIGHT
CB-#	CIRCUIT BREAKER	SW-#	NORMALLY CLOSED FLOAT SWITCH		

ALL WORK ON THIS SHEET WAS PERFORMED AS PART OF THE PRIOR MODULE ASSEMBLY CONTRACT EXCEPT FOR TERMINATION AT THE PANEL OF EXTERIOR FIELD CONDUCTORS SHOWN ON SHEET E1.7 IS INCLUDED IN THE ON SITE WORK.

REV#1
ISSUED FOR
CONSTRUCTION
NOV 2023



1	REVISE PANEL TO MATCH SHOP AS BUILT	11/13/23	BCG
REV.	DESCRIPTION	DATE	BY
PROJECT: NAPASKIAK POWER SYSTEM UPGRADE			
TITLE: DAY TANK CONTROL PANEL LOGIC DIAGRAM & BILL OF MATERIALS			
DRAWN BY: BCG/JTD		SCALE: AS NOTED	
DESIGNED BY: CWP/BCG		DATE: 7/29/22	
FILE NAME: NAP5 PP E7		SHEET: E7.1	
P.O. 111405, Anchorage, AK 99511 (907)349-0100			

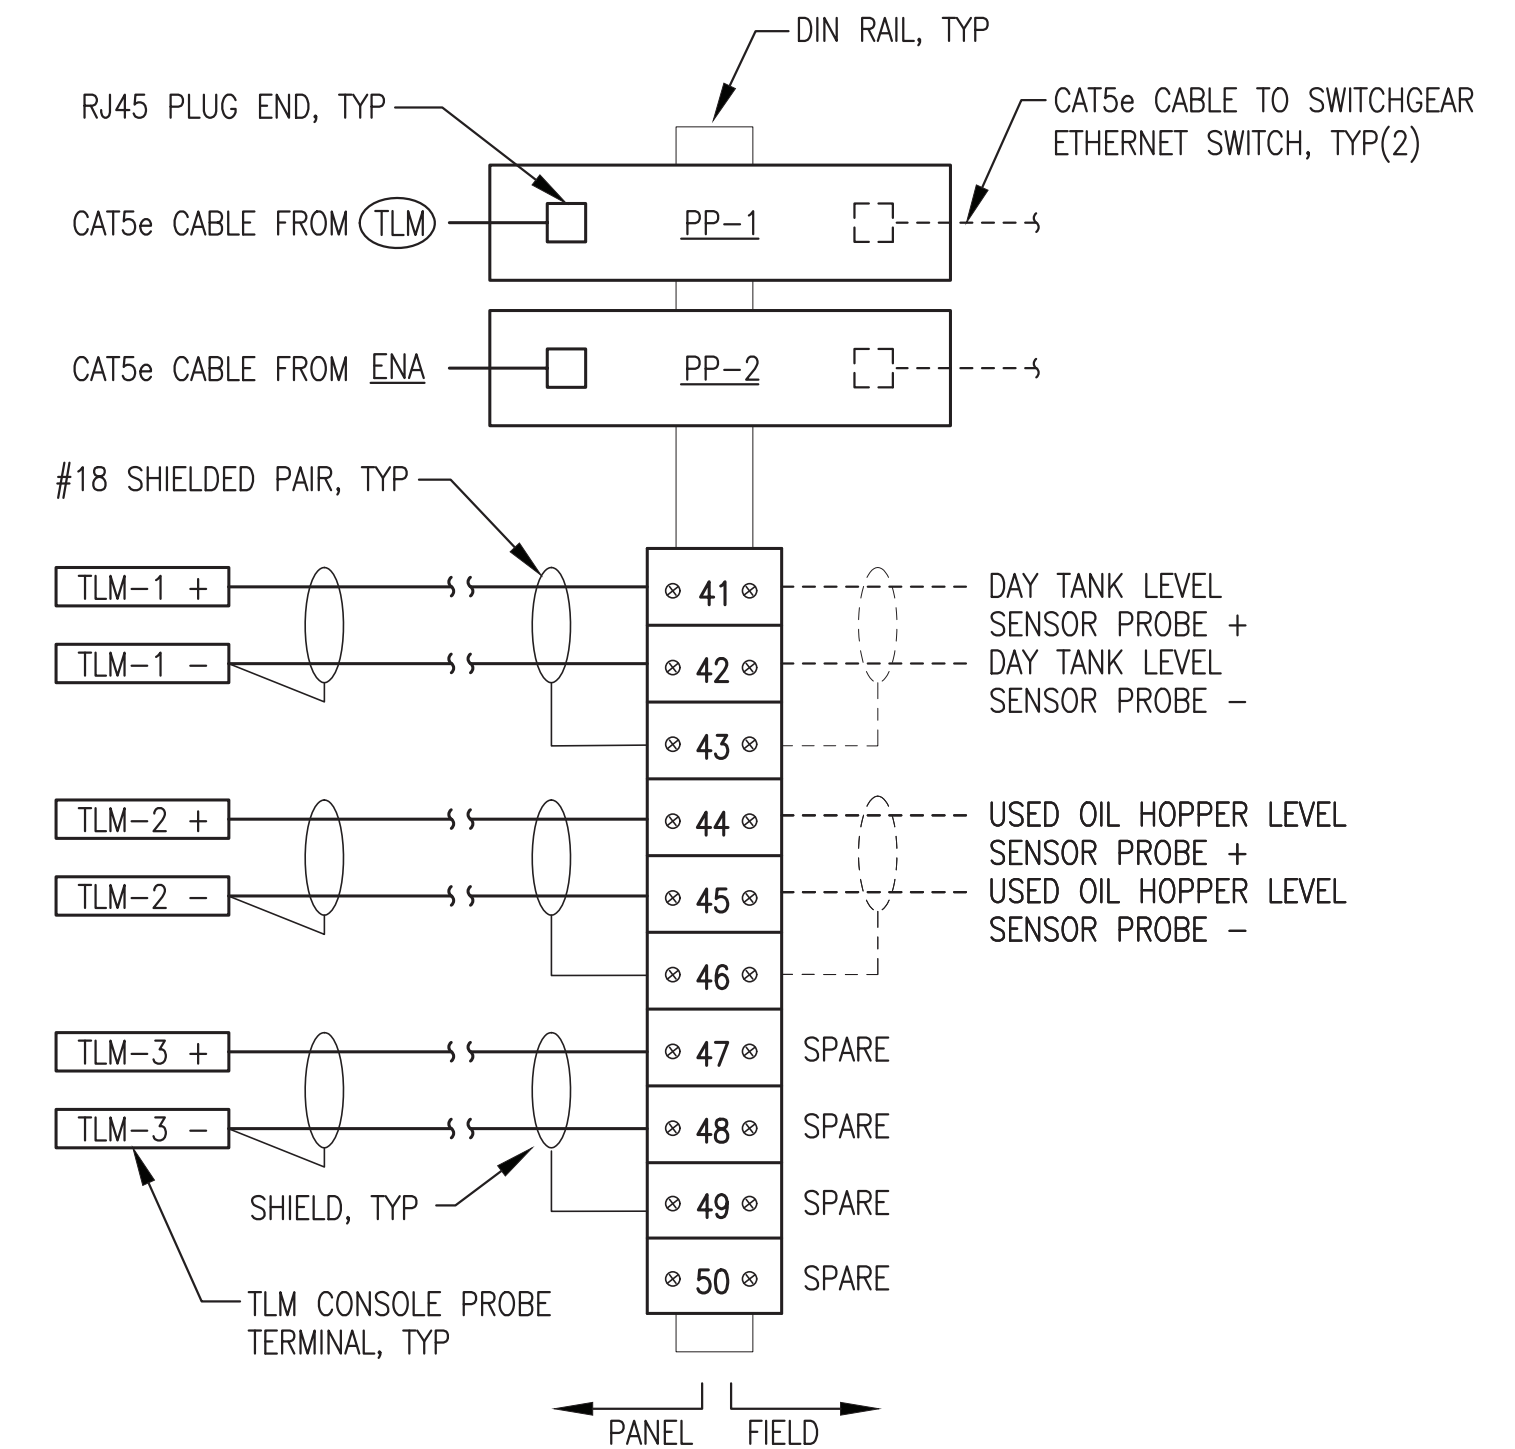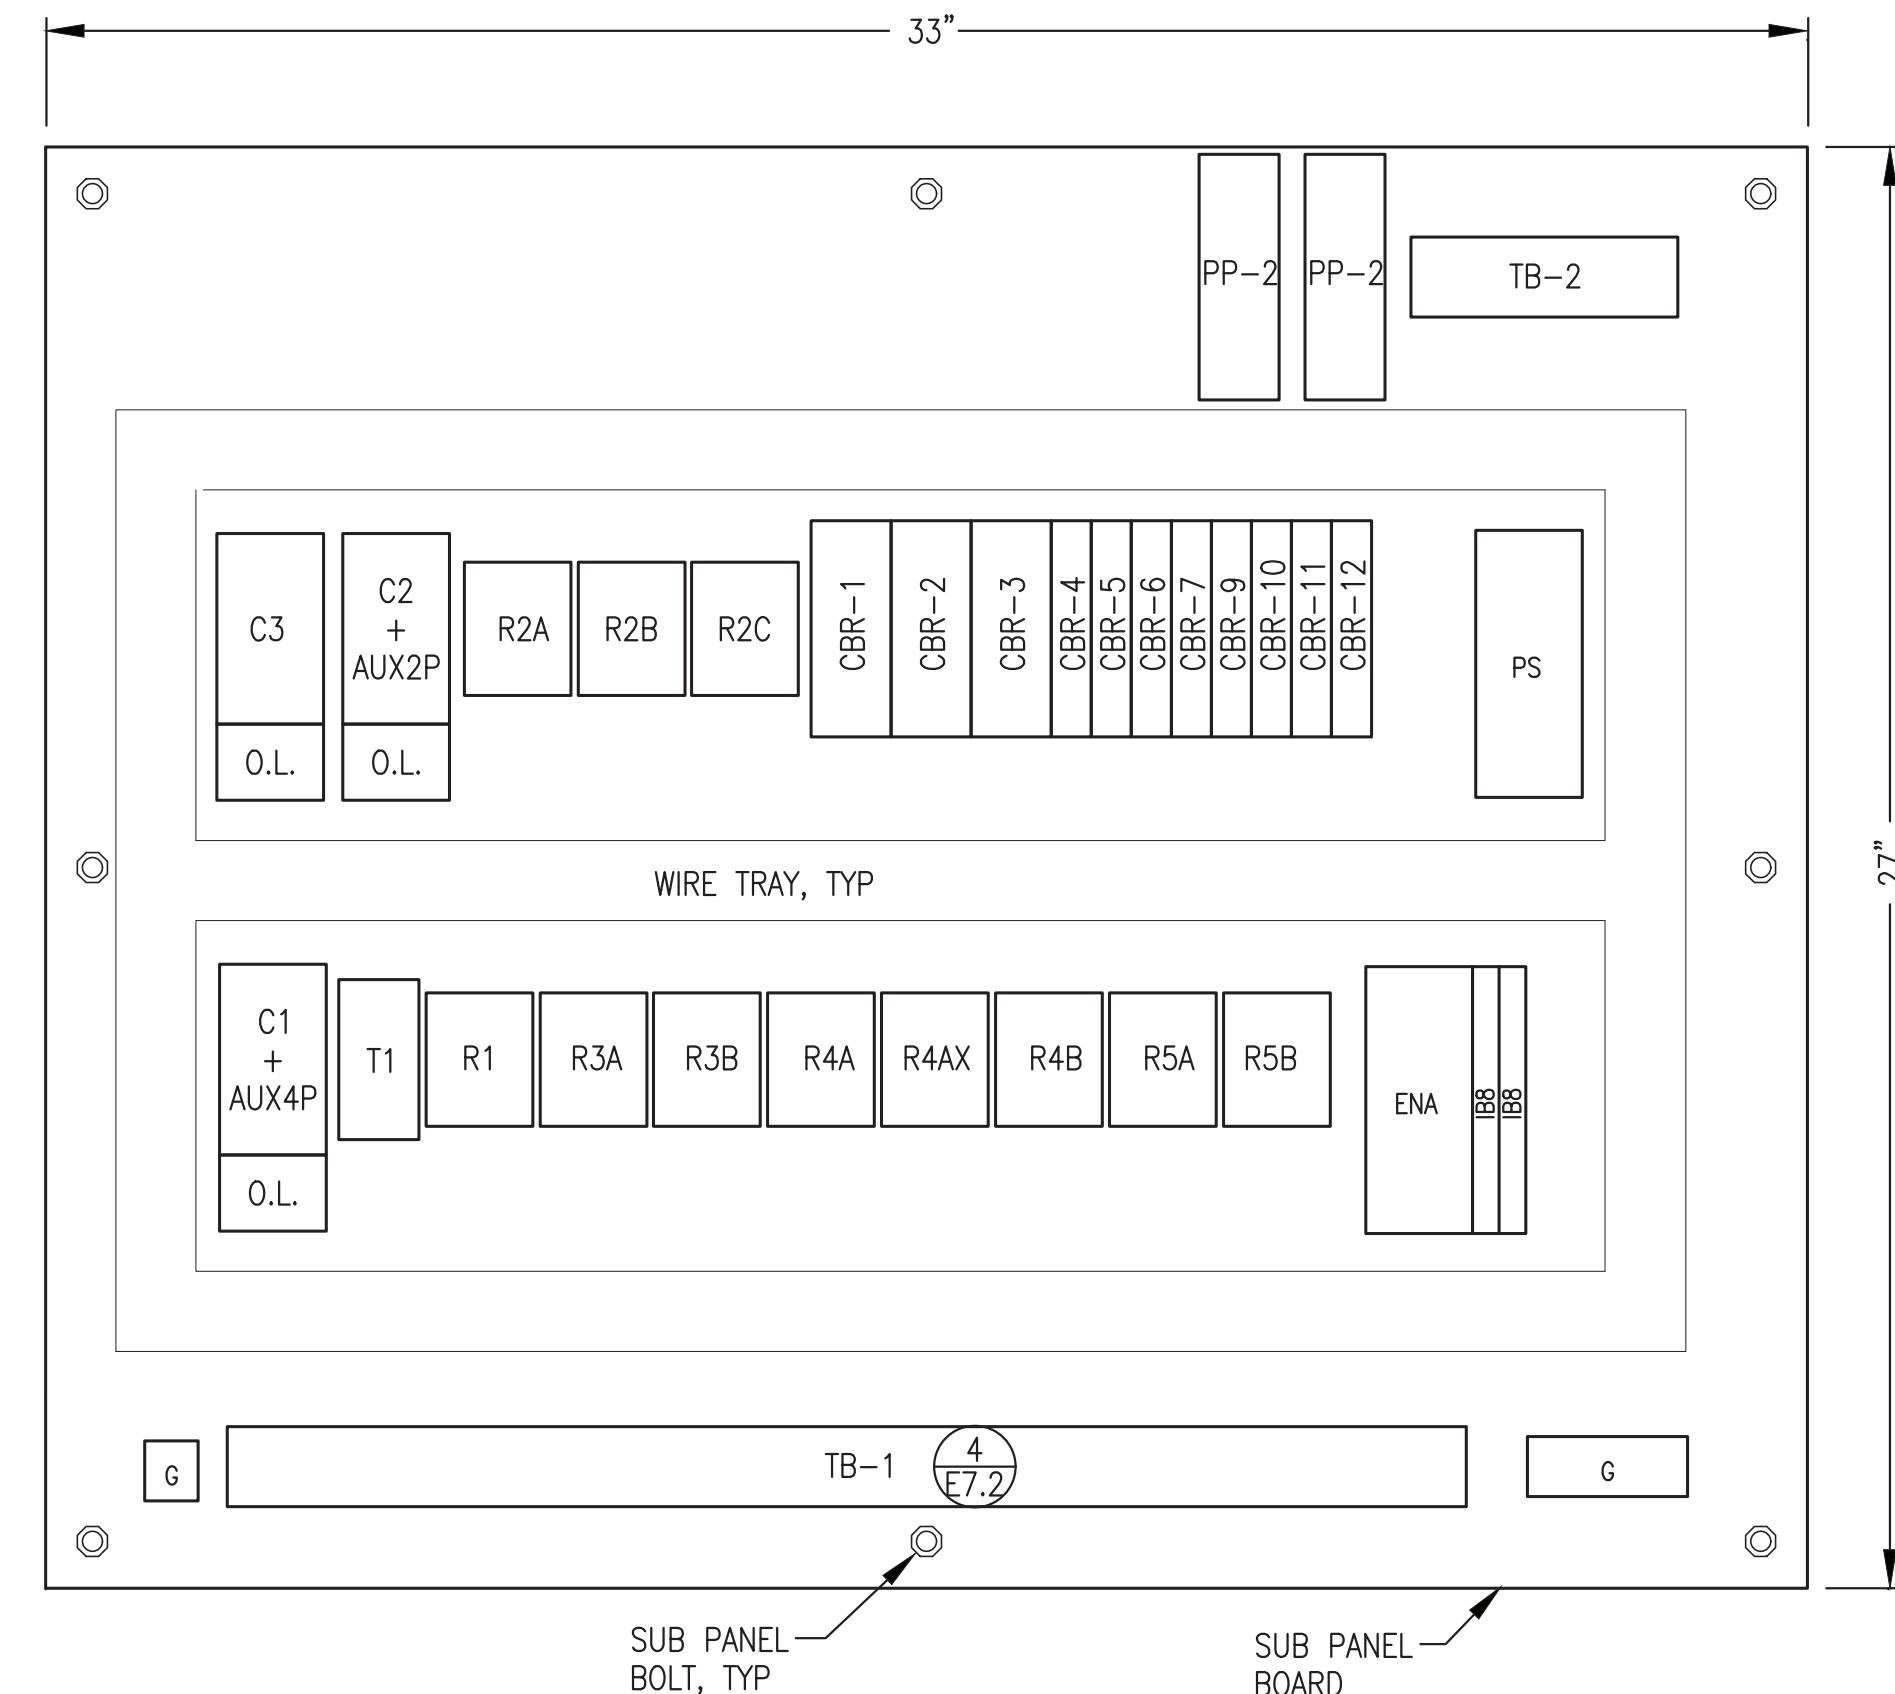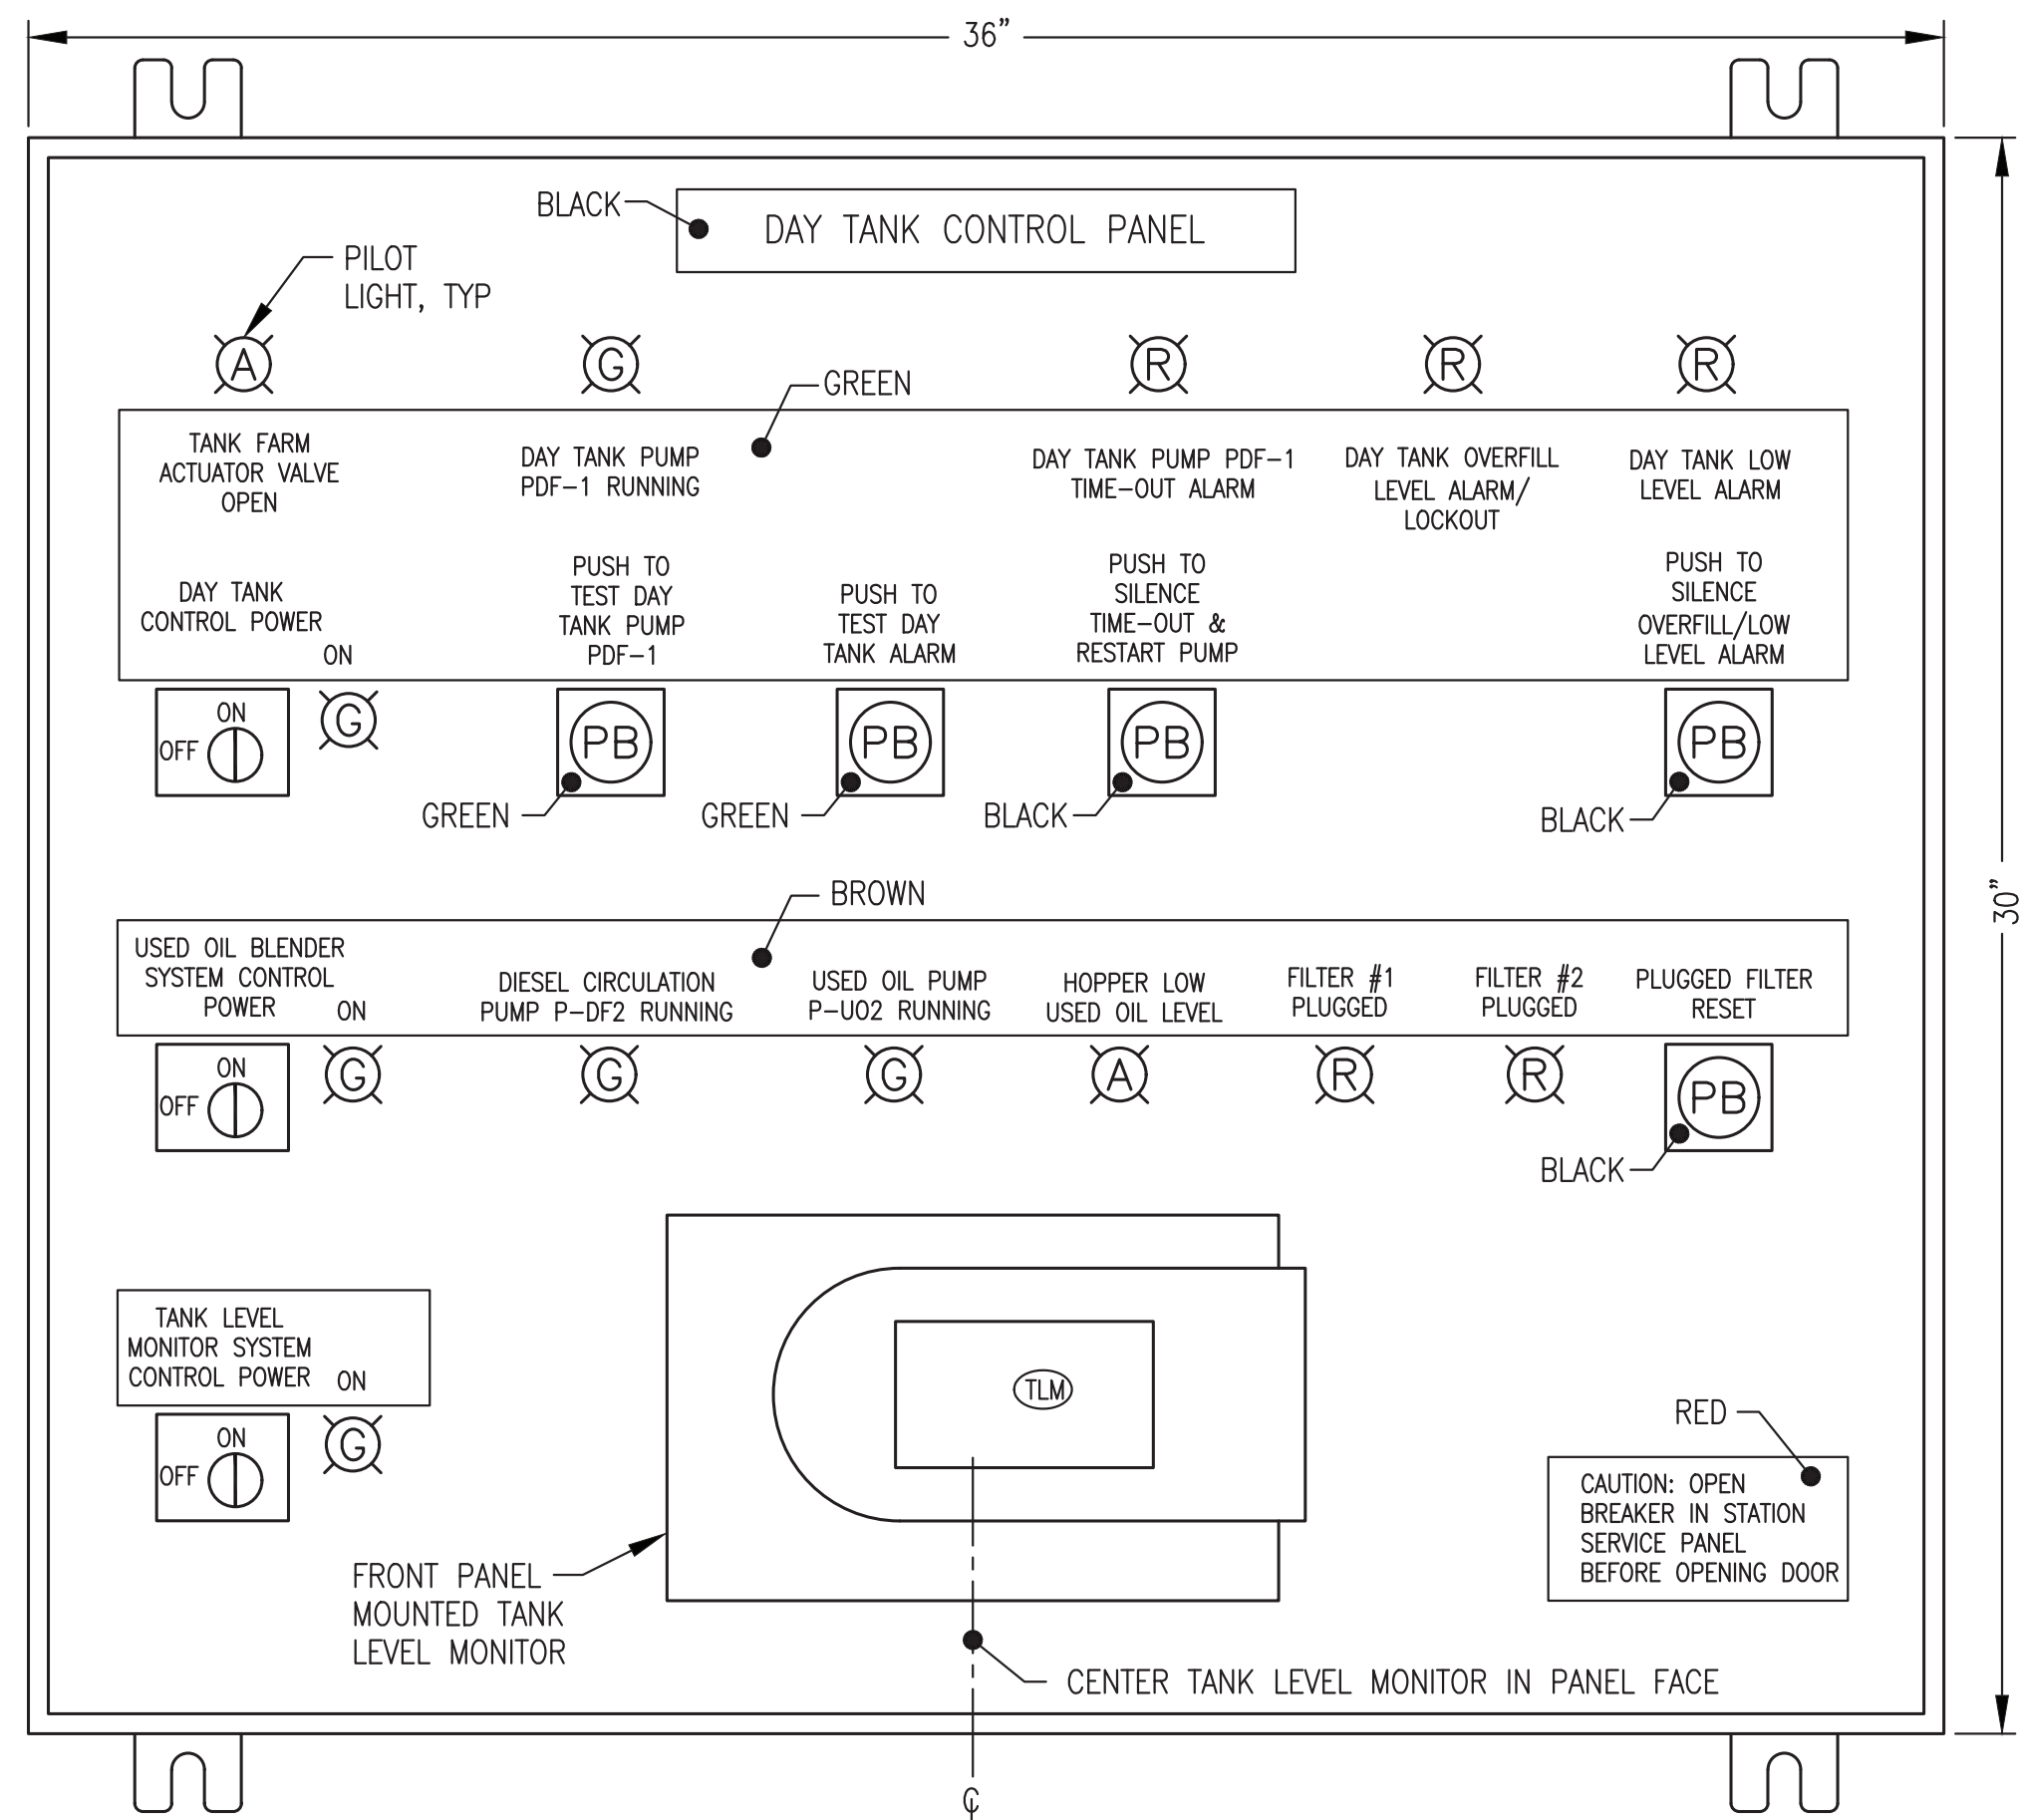


NOTES:

- INSTALL TERMINAL STRIP TB-2 AND ETHERNET PATCH PANEL PP-1 ON VERTICAL DIN RAIL AS SHOWN. LOCATE TERMINAL STRIP IN THE UPPER RIGHT CORNER OF PANEL TO ACCOMMODATE CONDUCTOR ENTRY THROUGH RIGHT SIDE OF PANEL, SEE SUB-PANEL LAYOUT.

1 FRONT PANEL LAYOUT
E7.2 NO SCALE

2 SUB PANEL LAYOUT
E7.2 NO SCALE

3 TB-2 TERM STRIP LAYOUT
E7.2 NO SCALE

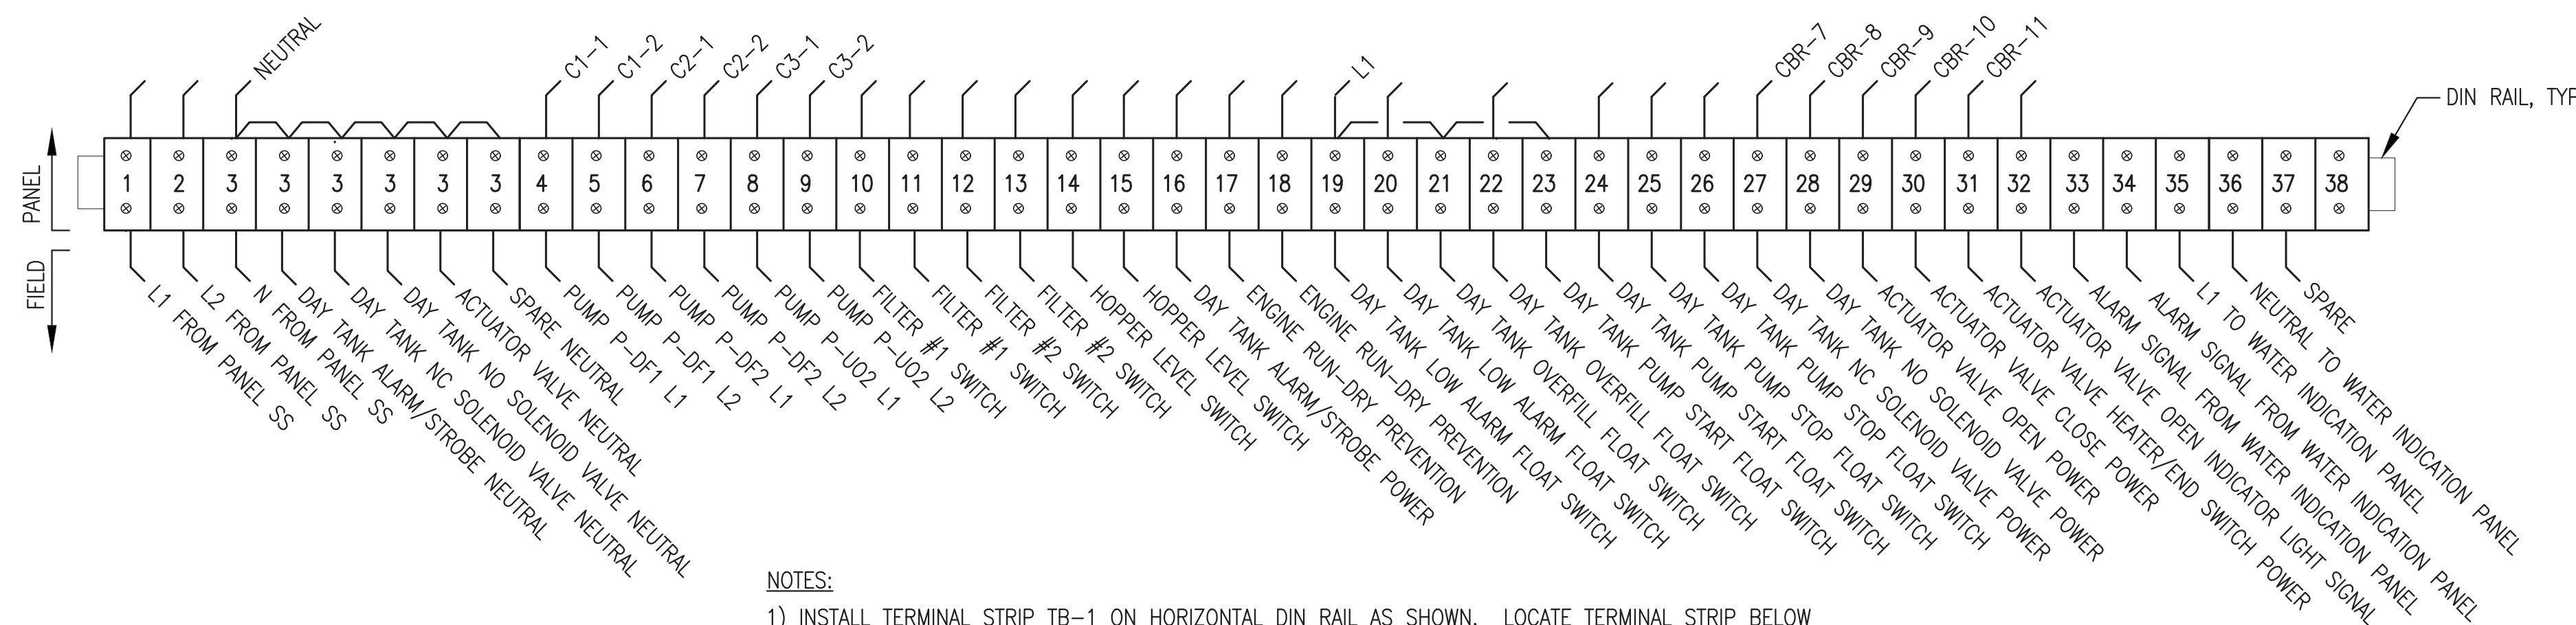


NOTES:

- INSTALL TERMINAL STRIP TB-1 ON HORIZONTAL DIN RAIL AS SHOWN. LOCATE TERMINAL STRIP BELOW PANEL DEVICES TO ACCOMMODATE CONDUCTOR ROUTING FROM CONDUITS CONNECTING TO BOTTOM OF PANEL, SEE SUB-PANEL LAYOUT.
- IN ADDITION TO THE TERMINAL STRIPS SHOWN, PROVIDE 6 EACH 35A SCREW TERMINAL GROUNDING BUS.

4 TB-1 TERMINAL STRIP LAYOUT
E7.2 NO SCALE

ALL WORK ON THIS SHEET WAS PERFORMED AS PART OF THE PRIOR MODULE FABRICATION CONTRACT AND IS SHOWN HERE FOR REFERENCE ONLY.

REV#1
ISSUED FOR
CONSTRUCTION
NOV 2023

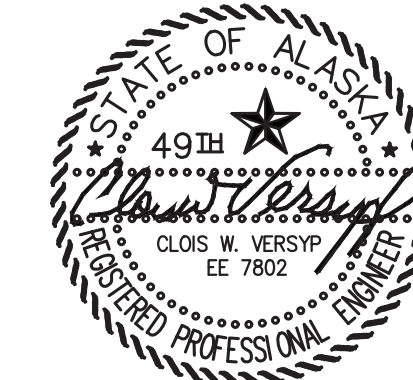

1	REVISE PANEL TO MATCH SHOP AS BUILT	11/13/23	BCG
REV.	DESCRIPTION	DATE	BY
 ALASKA ENERGY AUTHORITY			
PROJECT: NAPASKIAK POWER SYSTEM UPGRADE			
TITLE: DAY TANK CONTROL PANEL LAYOUT & TERMINAL STRIPS			
DRAWN BY: BCG/JTD		SCALE: AS NOTED	
DESIGNED BY: CWV/BCG		DATE: 7/29/22	
FILE NAME: NAPS PP E7		SHEET: E7.2	
PROJECT NUMBER:			
P.O. 111405, Anchorage, AK 99511 (907)349-0100			

PANEL NOTES:

- 1) PROVIDE COMPLETE LISTED PANEL ASSEMBLY WITH ALL DEVICES INDICATED IN LOGIC DIAGRAM EXCEPT FOR FIELD DEVICES. INSTALL IN A NEMA 12 ENCLOSURE WITH 4 EACH INTEGRAL MOUNTING LUGS AT BACK. SEE SHEET E7.2 FOR PANEL LAYOUT DETAILS.
- 2) USE MIN #12 WIRE FOR ALL CIRCUITS UP TO FIRST IN-LINE PANEL BREAKERS (FOR 20A FEED). USE MIN #16 AWG ON ALL 5 AMP CIRCUITS AND MIN #14 AWG WIRE ON ALL 15A CIRCUITS. TAG EACH END OF ALL JUMPERS WITH DEVICE OR TERMINATION DESIGNATOR OF LANDING OF OPPOSITE END OF JUMPER (REVERSE ADDRESS).
- 3) LABEL ALL PANEL DEVICES ON BASE OR BACK PANEL ADJACENT TO ITEM. LABEL REMOTE EQUIPMENT CONNECTIONS AT EACH TERMINAL BLOCK BY THE ITEM TITLE AS SHOWN ON THE FIELD SIDE OF THE TERMINAL STRIP DRAWING. PROVIDE BEVELED EDGE WHITE CORE NAMEPLATES AS SHOWN ON THE PANEL FACE LAYOUT AND SECURE TO PANEL FACE WITH A MINIMUM OF TWO STAINLESS STEEL MOUNTING SCREWS, COLOR AS INDICATED.
- 4) BENCH TEST COMPLETED UNIT. PROVIDE MIN 48 HOURS NOTICE TO ENGINEER TO SCHEDULE OBSERVATION OF BENCH TEST. PROVIDE SWITCHES AND LAMPS TO SIMULATE OPERATION OF ALL FIELD DEVICES.
- 5) DEVICES AND WIRING NOTED AS "FIELD" AND SHOWN WITH DASHED LINES WILL BE FIELD INSTALLED AND ARE NOT PART OF THE PANEL SHOP FABRICATION. FOR BENCH TEST, PROVIDE TEMPORARY DEVICES AND WIRING AS REQUIRED TO SIMULATE FIELD DEVICES.
- 6) POWER TO PANEL PROVIDED FROM DEDICATED 20A 2-POLE CIRCUIT BREAKER IN LISTED LOAD CENTER. SEE FIELD INSTALLATION NOTE #3.

FIELD INSTALLATION NOTES:


- 1) SEE MECHANICAL FOR DAY TANK INSTALLATION & PIPING. INSTALL CONTROL PANEL & FIELD DEVICES AS INDICATED TO PROVIDE REDUNDANT HIGH & LOW LIMIT CONTROLS & OVERFILL PROTECTION.
- 2) FIELD WIRING TO FLOAT SWITCHES, SOLENOID VALVES, ACTUATOR VALVE, & ALARM HORN #14 AWG. ALL OTHER FIELD WIRING #12 AWG. LABEL BOTH ENDS OF ALL CONDUCTORS WITH CONTROL PANEL TERMINAL BLOCK TERMINATION NUMBERS. WHEN NOT IN CONDUIT, MAKE JACKETED COM CABLE ENCLOSURE ENTRIES WITH CABLE GLAND CONNECTORS.
- 3) PERFORM ALL FIELD WIRING IN ACCORDANCE WITH ELECTRICAL SPECIFICATIONS ON SHEET E2. PROVIDE POWER TO DAY TANK PANEL FROM DEDICATED 20A 2-POLE CIRCUIT BREAKER IN STATION SERVICE PANELBOARD.
- 4) VERIFY THAT ALL DAY TANK FLOAT SWITCHES ARE ORIENTED FOR N.C. (OPEN ON RISE) OPERATION PRIOR TO INSTALLATION. ALL FLOATS SHOWN ON LOGIC DIAGRAM WITH TANK AT FULL (PUMP STOP) LEVEL. VERIFY THAT THE HOPPER FLOAT SWITCH IS ORIENTED FOR N.O. (CLOSE ON RISE) OPERATION.
- 5) FILL PUMP CAVITIES WITH LUBE OIL PRIOR TO INITIAL OPERATION. VERIFY PROPER ROTATION OF PUMPS. PRIME SYSTEM WITH HAND PRIMING PUMP PRIOR TO BEGINNING DAY TANK FILL.
- 6) FIELD TEST COMPLETED UNIT TO VERIFY ALL CONTROL AND ALARM FUNCTIONS. MANIPULATE FLOAT SWITCHES BY REACHING IN THROUGH ADJACENT 4" BUNG. TEMPORARILY SET TIMING RELAY TO 30 SECONDS TO VERIFY TIME-OUT AND RESET FUNCTIONS.
- 7) SET TIMING RELAY TIME DELAY TO 30 MINUTES (APPROX. 55 GALS. REQUIRED FROM PUMP START TO PUMP STOP LEVEL @ APPROX. 4 GPM). ON THE INITIAL TANK FILL, THE PUMP TEST/RESET BUTTON MAY HAVE TO BE MANUALLY RESET IN ORDER TO GET THE FUEL LEVEL TO WITHIN THE NORMAL OPERATING RANGE. SEE SEQUENCE OF OPERATIONS.

DAY TANK FILL SEQUENCE OF OPERATIONS:


- 1) WHEN THE DAY TANK CIRCUIT BREAKER AND CONTROL POWER SWITCH ARE CLOSED, THE POWER LIGHT IS ON AND POWER IS PROVIDED TO THE REMOTE ACTUATOR VALVE HEATER/OPEN LIGHT CIRCUIT.
- 2) WHEN THE DAY TANK IS NOT CALLING FOR FUEL, POWER IS PROVIDED TO THE REMOTE ACTUATOR VALVE CLOSE CIRCUIT. WHEN THE ACTUATOR IS IN THE FULLY CLOSED POSITION, THE CLOSING CIRCUIT IS BROKEN BY INTERNAL ACTUATOR LIMIT SWITCH #2 AND THE REMOTE ACTUATOR VALVE "OPEN" LIGHT IS OFF.
- 3) NORMAL FILL OPERATION - WHEN THE FUEL LEVEL DROPS TO THE "PUMP START" SWITCH, THE TIMER IS STARTED, THE N.C. DAY TANK SOLENOID VALVE OPENS, THE REMOTE ACTUATOR VALVE OPENS & THE VALVE "OPEN" LIGHT TURNS ON, THE DAY TANK PUMP IS ENERGIZED, THE PUMP "ON" LIGHT TURNS ON, AND THE USED OIL BLENDER RUN SIGNAL DRY CONTACT CLOSURES. WHEN THE ACTUATOR IS IN THE FULLY OPEN POSITION, THE OPENING CIRCUIT IS BROKEN BY INTERNAL ACTUATOR LIMIT SWITCH #7 AND THE REMOTE ACTUATOR VALVE "OPEN" LIGHT REMAINS ON. WHEN FUEL REACHES THE "PUMP STOP" FLOAT SWITCH BEFORE THE TIMER TIMES-OUT, THE TIMER IS RESET, THE N.C. DAY TANK SOLENOID VALVE AND REMOTE ACTUATOR VALVE CLOSE, THE REMOTE ACTUATOR VALVE "OPEN" LIGHT TURNS OFF, THE PUMP DE-ENERGIZES, THE PUMP "ON" LIGHT TURNS OFF, AND THE USED OIL BLENDER RUN SIGNAL DRY CONTACT OPENS.
- 4) TIMER OPERATION - IF THE TIMER TIMES-OUT THE N.C. DAY TANK SOLENOID VALVE AND REMOTE ACTUATOR VALVE CLOSE, THE REMOTE ACTUATOR VALVE "OPEN" LIGHT TURNS OFF, THE PUMP DE-ENERGIZES, THE PUMP "ON" LIGHT TURNS OFF, THE USED OIL BLENDER RUN SIGNAL DRY CONTACT OPENS, THE "TIME-OUT" ALARM LIGHT TURNS ON, AND THE TIME-OUT ALARM HORN SOUNDS. PRESSING THE "TIME-OUT ALARM SILENCE / PUMP RESTART" BUTTON RESETS THE TIMER, SILENCES THE ALARM HORN, AND STARTS THE NORMAL FILL OPERATION. SEE FIELD INSTALLATION NOTES FOR TIMER SETTING.
- 5) OVERFILL FUEL LEVEL - IF THE TANK OVERFILLS AND THE FUEL LEVEL REACHES THE "OVERFILL" FLOAT SWITCH, THE N.O. DAY TANK SOLENOID VALVE CLOSES, THE "OVERFILL LEVEL" ALARM LIGHT TURNS ON, THE N.C. DAY TANK SOLENOID VALVE AND REMOTE ACTUATOR VALVE CLOSE, THE VALVE "OPEN" LIGHT TURNS OFF, THE PUMP DE-ENERGIZES, THE PUMP "ON" LIGHT TURNS OFF, THE USED OIL BLENDER RUN SIGNAL DRY CONTACT OPENS, THE "OVERFILL LEVEL" ALARM LIGHT TURNS ON, AND THE ALARM HORN SOUNDS. PRESSING THE LEVEL ALARM HORN "SILENCE" BUTTON SILENCES THE ALARM HORN WHILE LEAVING THE "OVERFILL LEVEL" ALARM LIGHT ON. WHEN THE FUEL LEVEL FALLS BELOW THE "OVERFILL" FLOAT SWITCH, THE "OVERFILL LEVEL" ALARM LIGHT TURNS OFF, THE N.O. DAY TANK SOLENOID VALVE OPENS AND THE ALARM HORN TURNS OFF (IF NOT PREVIOUSLY SILENCED). WHEN THE FUEL LEVEL REACHES THE "PUMP START" FLOAT SWITCH, THE NORMAL FILL OPERATION IS REPEATED.
- 6) LOW FUEL LEVEL - IF THE FUEL LEVEL FALLS BELOW THE "LOW ALARM" FLOAT SWITCH, THE "LOW FUEL LEVEL" ALARM LIGHT TURNS ON, THE ENGINE RUN-DRY PREVENTION DRY CONTACT OPENS, AND THE ALARM HORN SOUNDS. THE LEVEL ALARM HORN "SILENCE" BUTTON SILENCES THE ALARM HORN WHILE LEAVING THE "LOW FUEL LEVEL" ALARM LIGHT ON. WHEN THE FUEL LEVEL RISES ABOVE THE "LOW ALARM" FLOAT SWITCH THE "LOW FUEL LEVEL" ALARM LIGHT TURNS OFF, THE ENGINE RUN-DRY PREVENTION DRY CONTACT CLOSURES, AND THE ALARM HORN TURNS OFF (IF NOT PREVIOUSLY SILENCED).
- 7) PUMP & HORN TEST - MOMENTARY CONTACT BUTTONS ARE PROVIDED TO TEST FUNCTION OF THE DAY TANK PUMP AND ALARM HORN. PRESSING THE "PUSH TO TEST DAY TANK PUMP" BUTTON STARTS THE TIMER, MOMENTARILY OPENS THE N.C. DAY TANK SOLENOID VALVE & ACTUATED BALL VALVE, ENERGIZES THE DAY TANK PUMP, TURNS ON THE DAY TANK PUMP "RUNNING" LIGHT AND CLOSURES THE USED OIL BLENDER RUN SIGNAL DRY CONTACT. THE "PUSH TO TEST DAY TANK PUMP" BUTTON IS LOCKED OUT IF THE DAY TANK IS AT THE OVERFILL LEVEL. PRESSING THE "PUSH TO TEST DAY TANK ALARM" BUTTON MOMENTARILY ENERGIZES THE ALARM HORN/STROBE.

USED OIL BLENDER SYSTEM SEQUENCE OF OPERATIONS:


- 1) WHEN THE BLENDER CIRCUIT BREAKER AND CONTROL POWER SWITCH ARE CLOSED; THE GREEN POWER LIGHT IS ON AND POWER IS PROVIDED TO ALL CONTROL DEVICES.
- 2) NORMAL OPERATION - WHENEVER THE DAY TANK FILL SEQUENCE IS INITIATED, BOTH THE DIESEL CIRCULATING PUMP P-DF2 AND THE USED OIL INJECTION PUMP P-U02 RUN AND THE ASSOCIATED GREEN PUMP RUNNING LIGHTS ARE ON.
- 3) PLUGGED FILTER - IF THE DIFFERENTIAL PRESSURE ACROSS A FILTER REACHES THE ALARM SETPOINT, BOTH PUMPS STOP RUNNING AND THE RED FILTER PLUGGED LIGHT FOR THE ASSOCIATED FILTER TURNS ON. THE ALARM LATCHES AND THE SYSTEM WILL NOT OPERATE UNTIL THE PROBLEM IS CORRECTED. AFTER THE FILTER ELEMENT HAS BEEN CHANGED THE BLACK RESET BUTTON MUST BE PRESSED TO RESUME NORMAL OPERATION.
- 4) HOPPER LOW OIL LEVEL - WHEN THE OIL LEVEL FALLS BELOW THE LOW LEVEL FLOAT SWITCH, USED OIL INJECTION PUMP P-U02 STOPS RUNNING AND THE AMBER HOPPER LOW OIL LEVEL LIGHT TURNS ON. PUMP P-U02 WILL NOT OPERATE UNTIL THE USED OIL LEVEL IN THE HOPPER RISES ABOVE THE LOW LEVEL. RESET IS NOT REQUIRED.

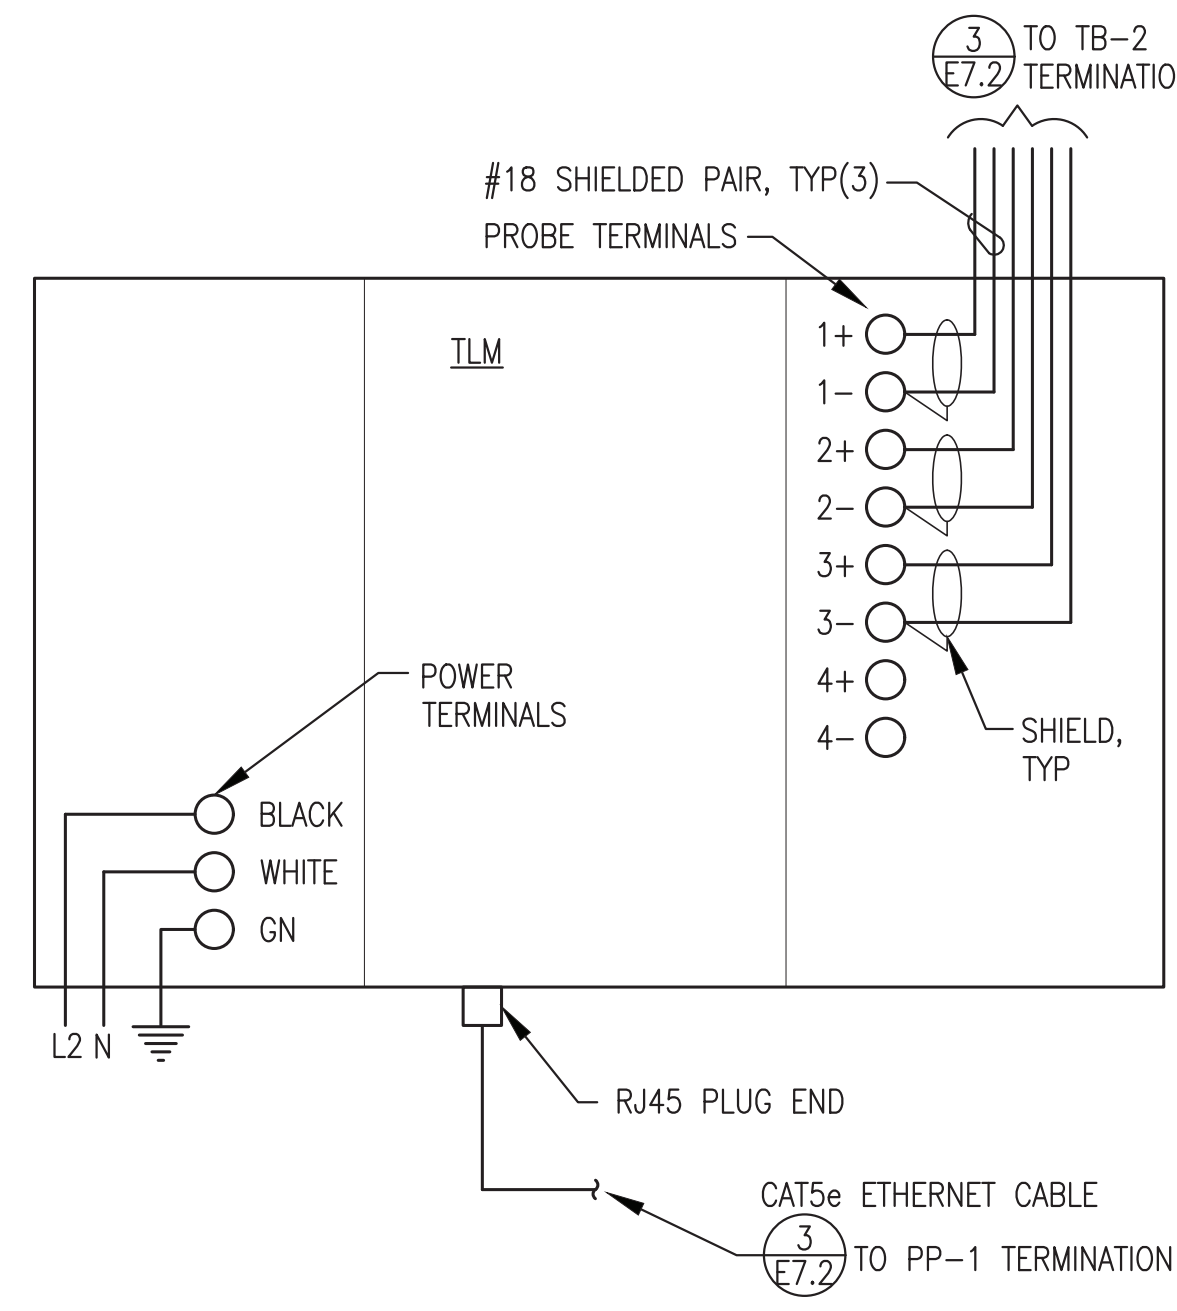

1 TANK LEVEL MONITOR (TLM) CONSOLE CONNECTIONS
NO SCALE

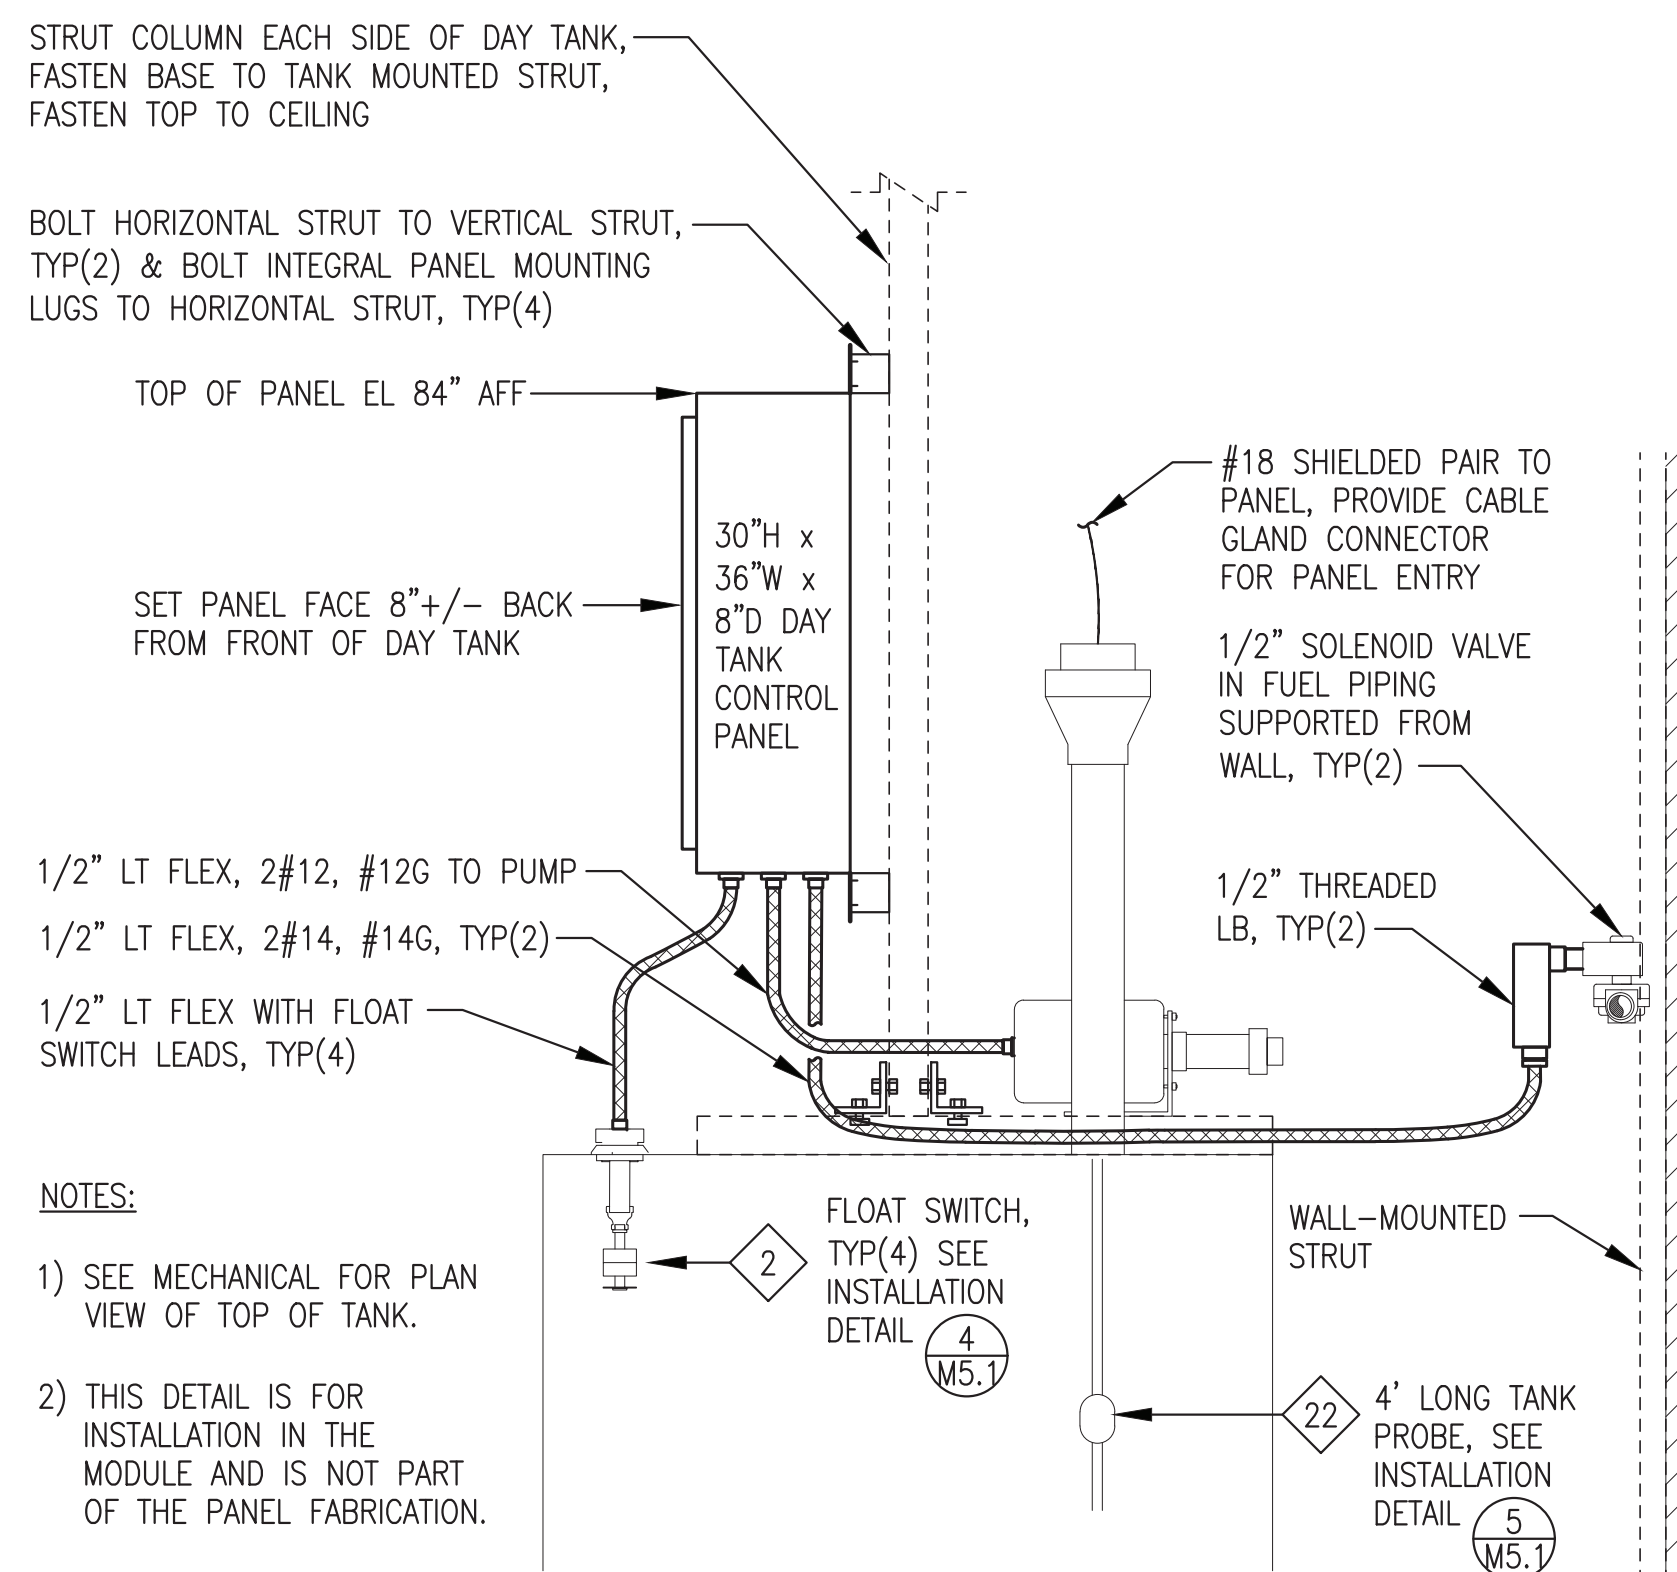


2 DAY TANK CONTROL PANEL & DEVICE INSTALLATION
NO SCALE

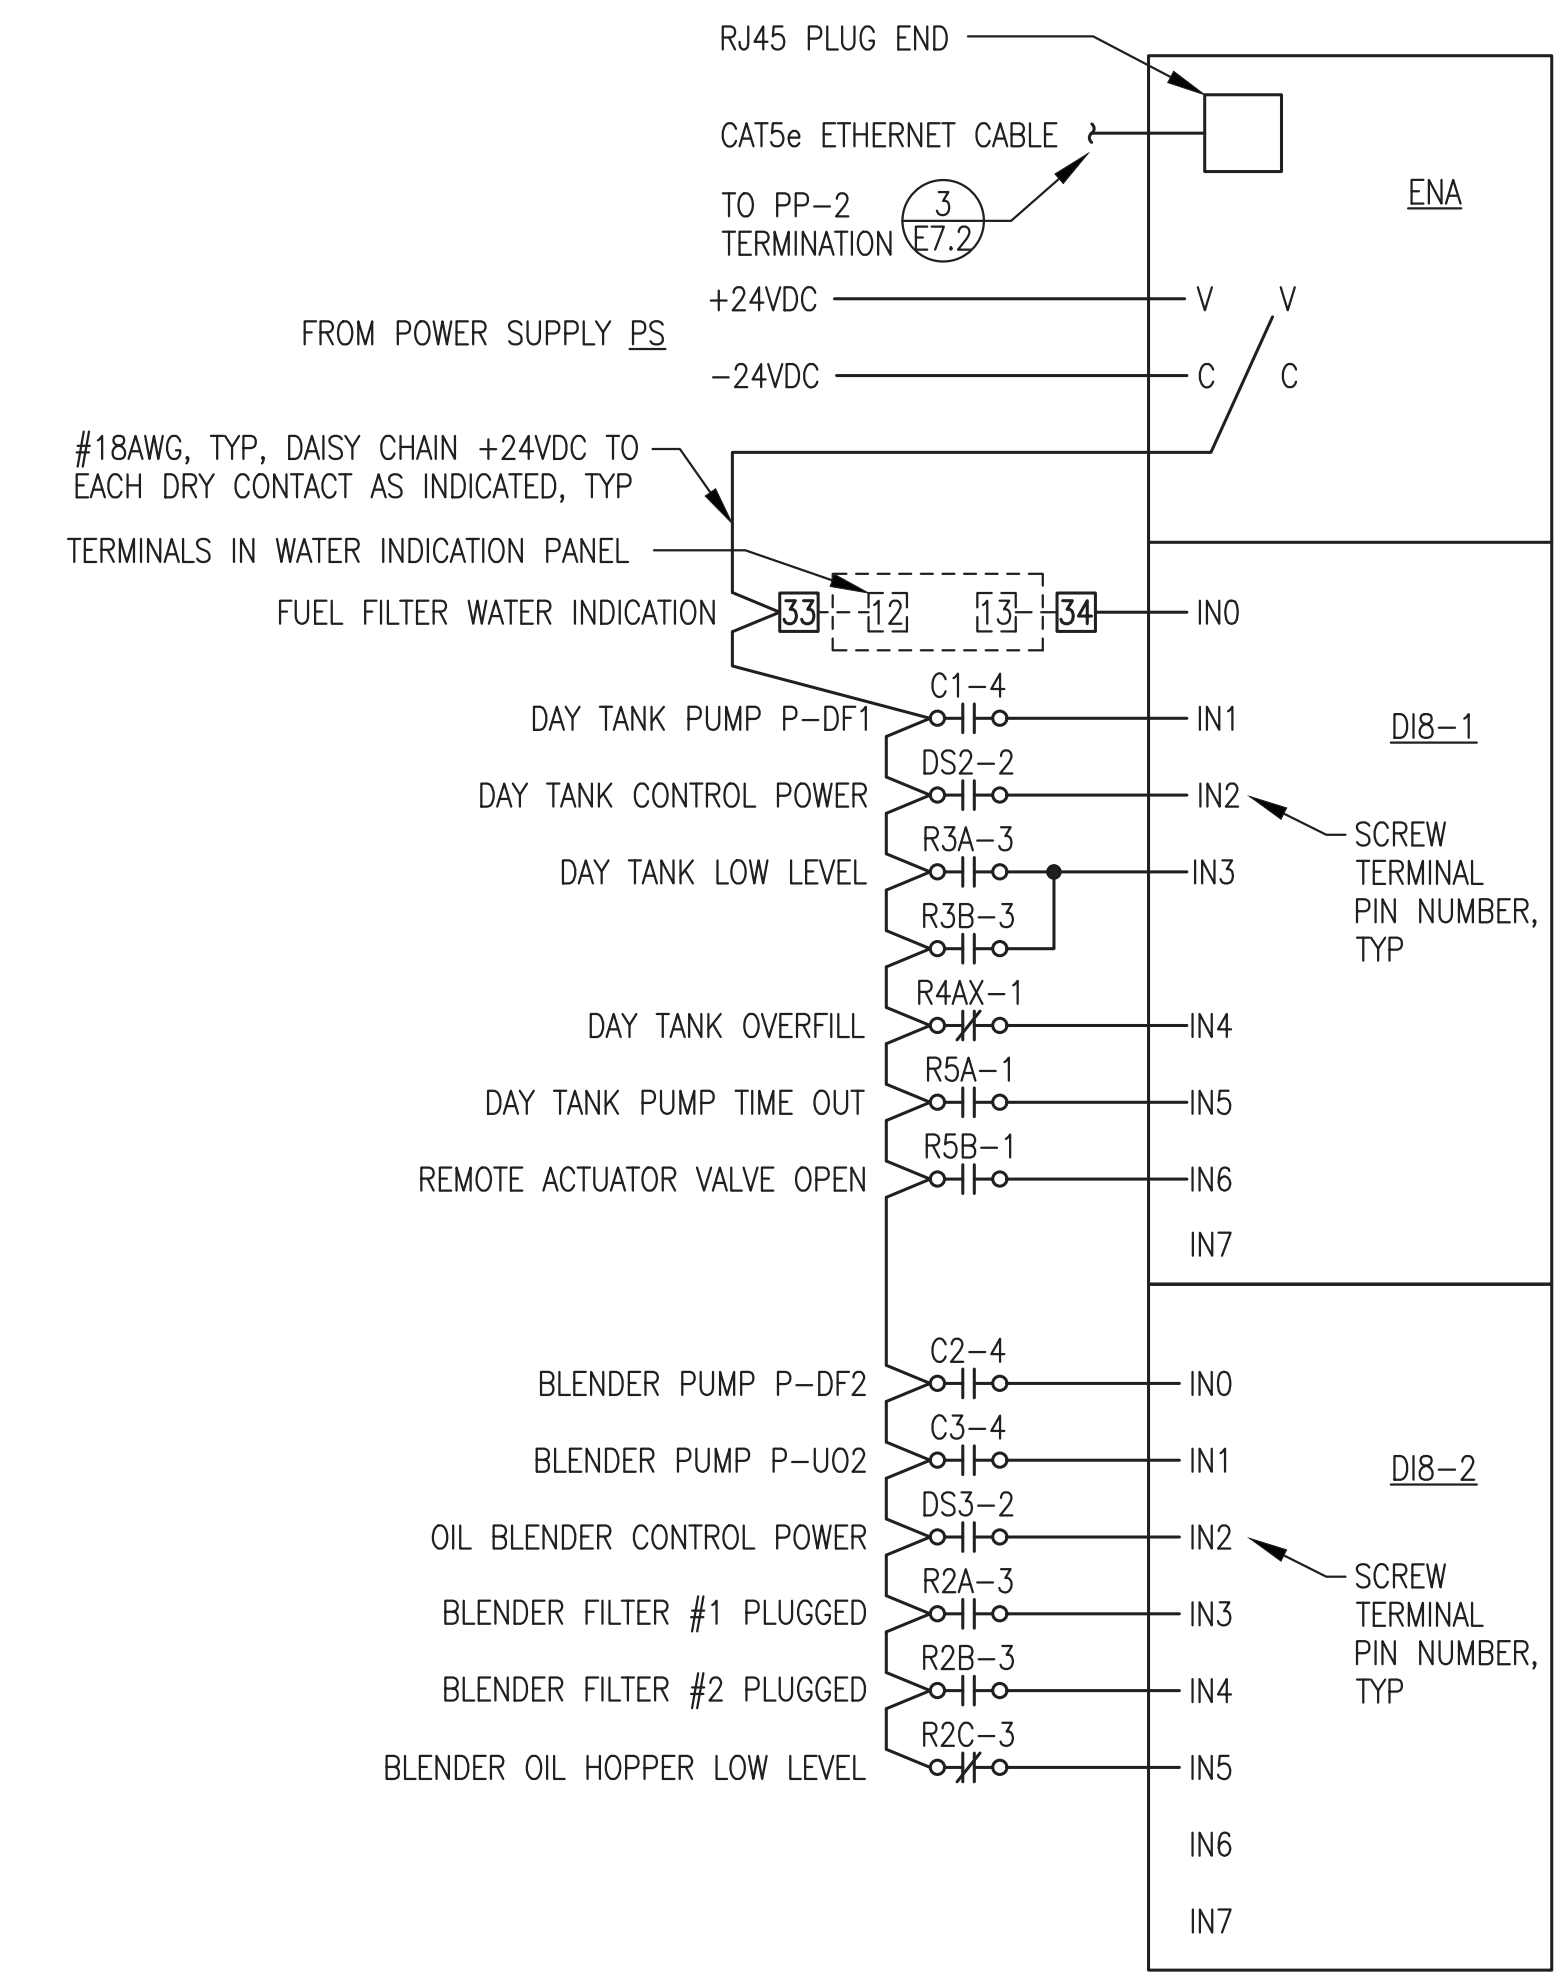


3 ETHERNET POINT I/O CONNECTIONS
NO SCALE

ALL WORK ON THIS SHEET WAS PERFORMED AS PART OF THE PRIOR MODULE FABRICATION CONTRACT AND IS SHOWN HERE FOR REFERENCE ONLY.


1	REVISE PANEL TO MATCH SHOP AS BUILT	11/13/23	BCG
REV.	DESCRIPTION	DATE	BY
<p>ALASKA ENERGY AUTHORITY</p>			
PROJECT: NAPASKIAK POWER SYSTEM UPGRADE			
TITLE: DAY TANK CONTROL PANEL NOTES, SEQUENCE OF OPERATIONS & INTERCONNECT DETAILS			
DRAWN BY: BCG/JTD		SCALE: AS NOTED	
DESIGNED BY: CWV/BCG		DATE: 7/29/22	
FILE NAME: NAP5 PP E7		SHEET: E7.3	
P.O. 111405, Anchorage, AK 99511 (907)349-0100			

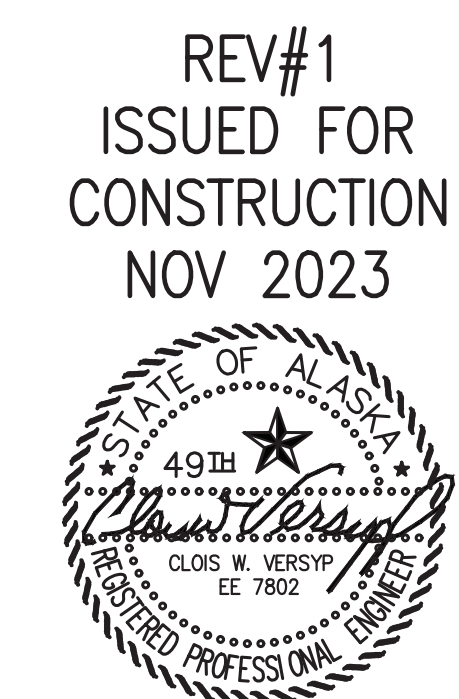


REV#1
ISSUED FOR
CONSTRUCTION
NOV 2023

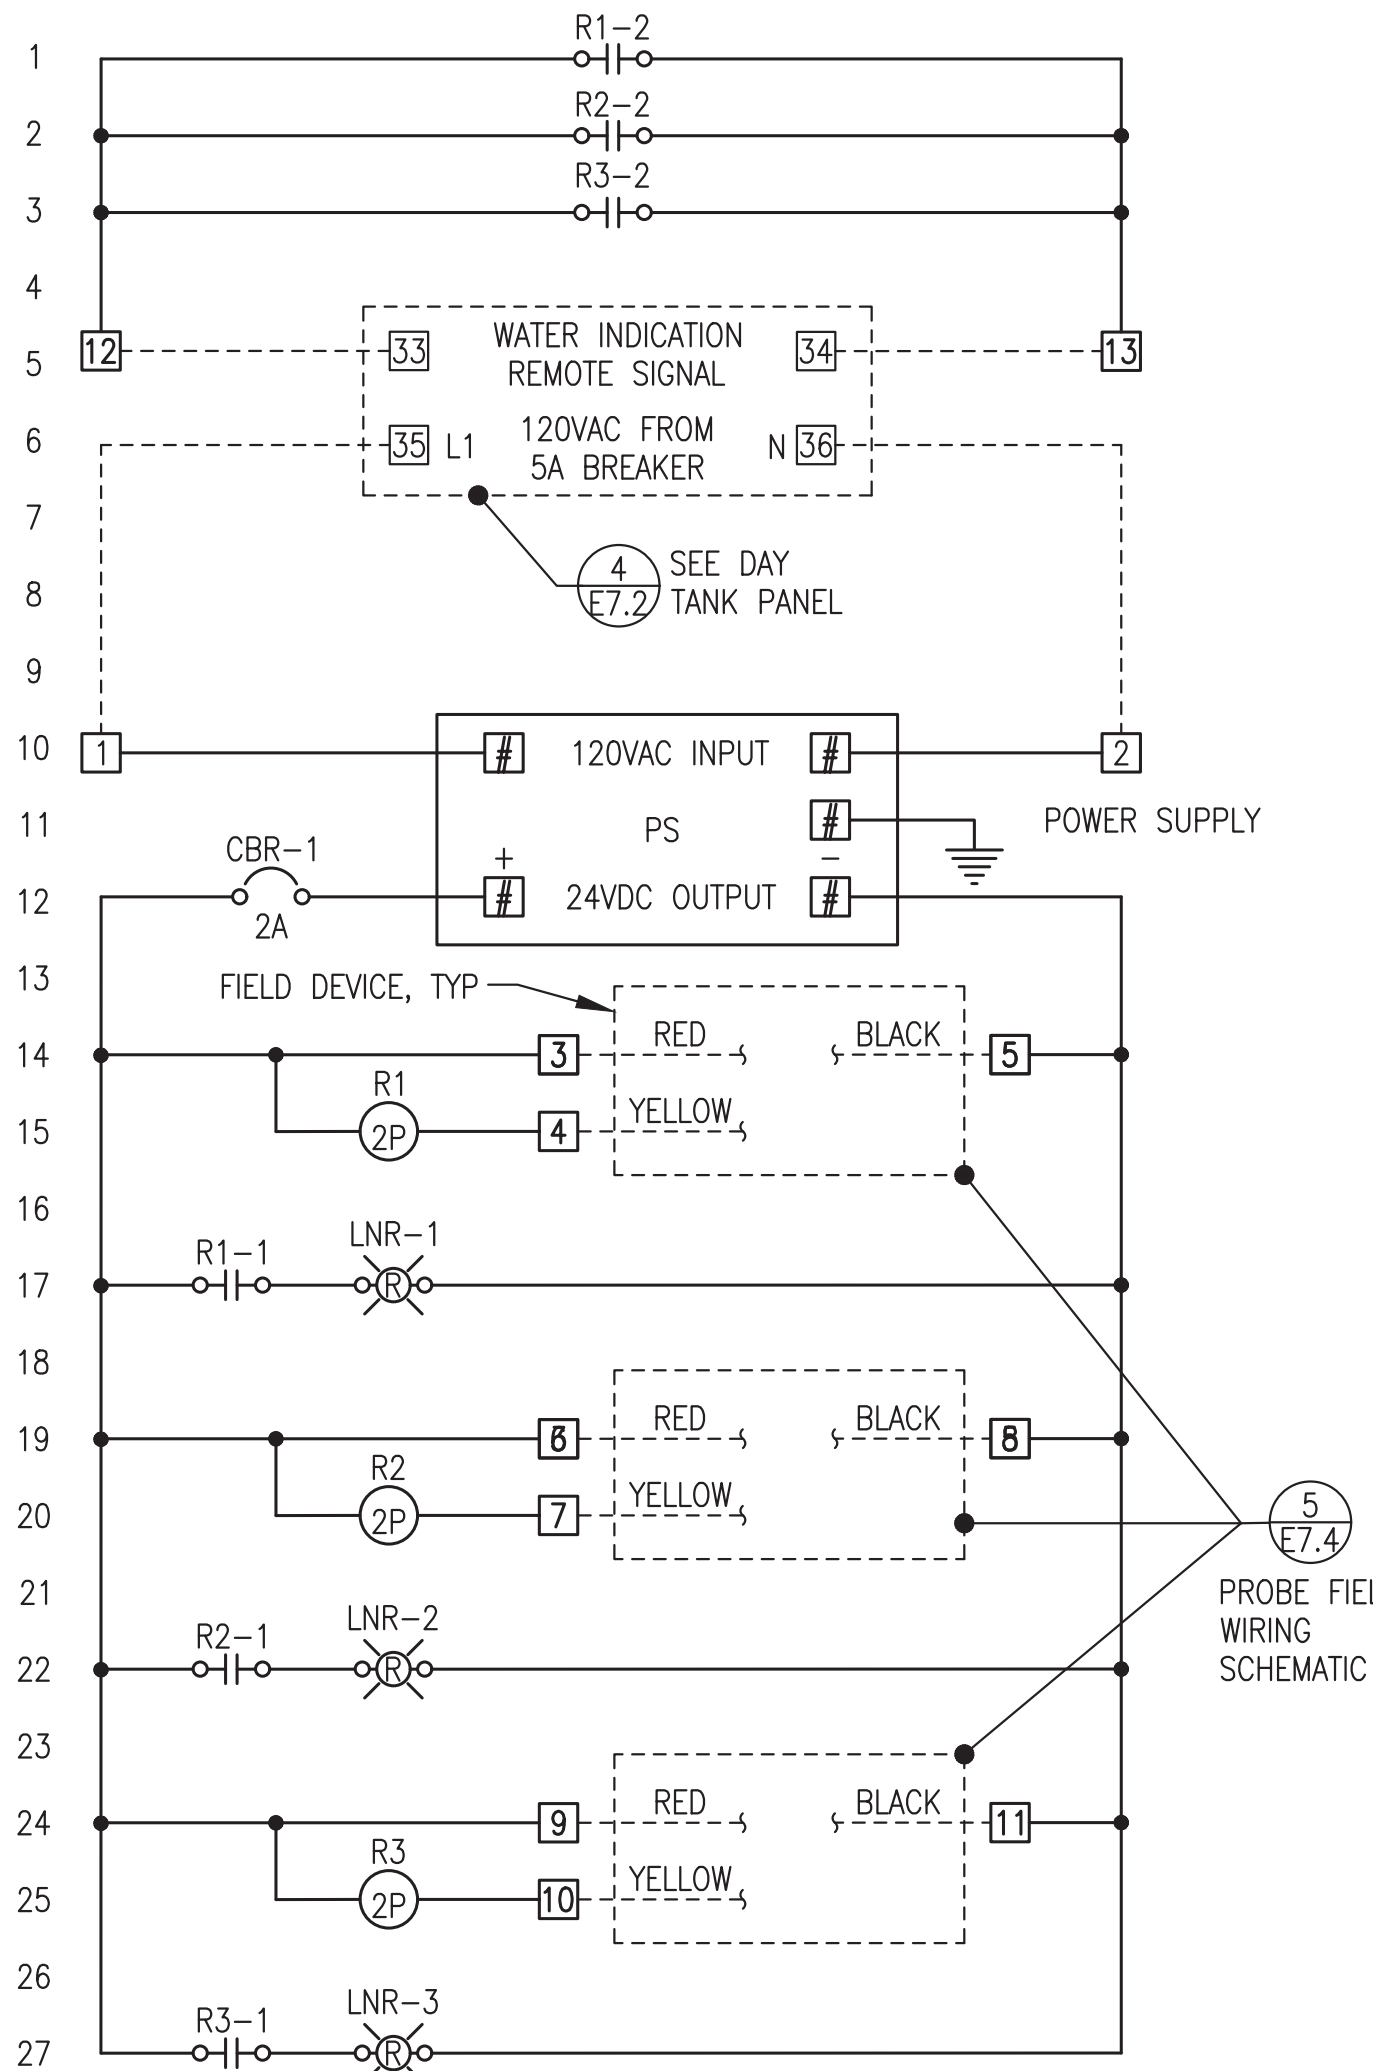

1 PANEL WIRING DIAGRAM
E7.4 NO SCALE

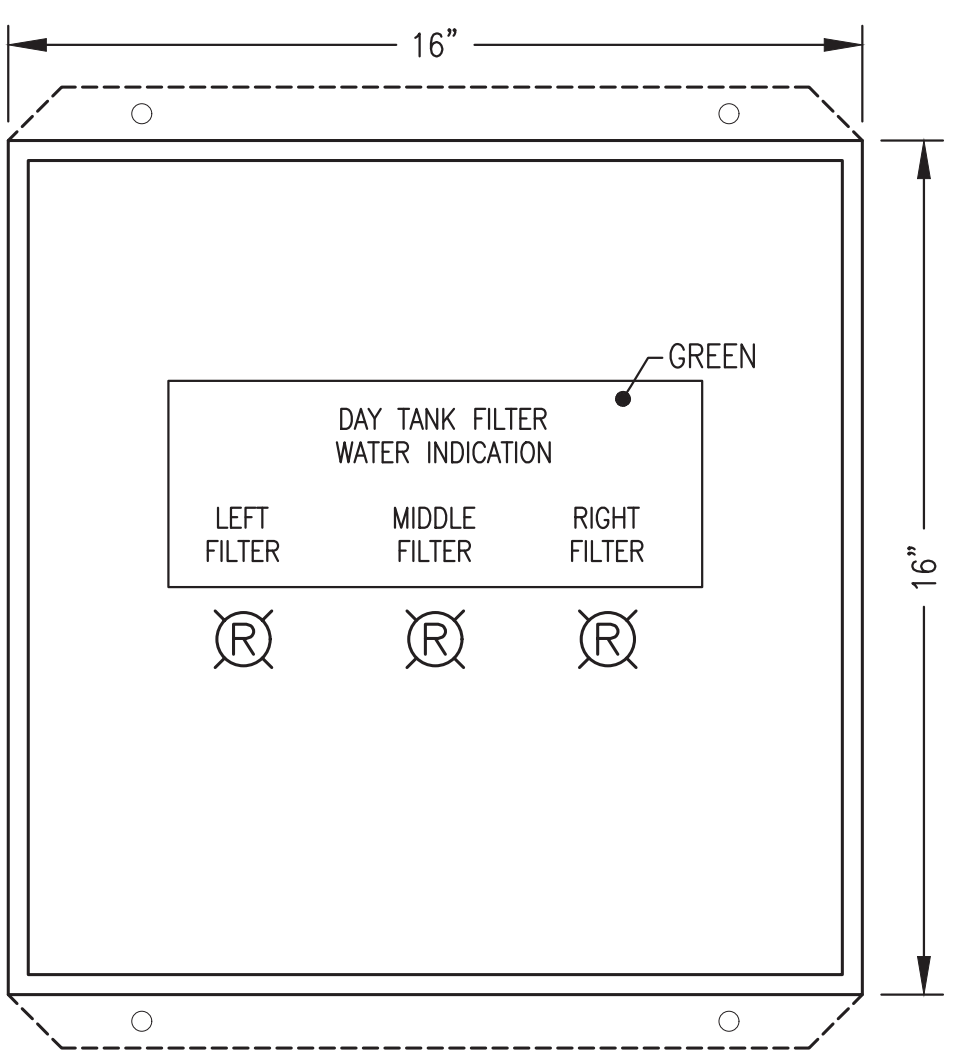

2 FRONT PANEL LAYOUT
E7.4 NO SCALE

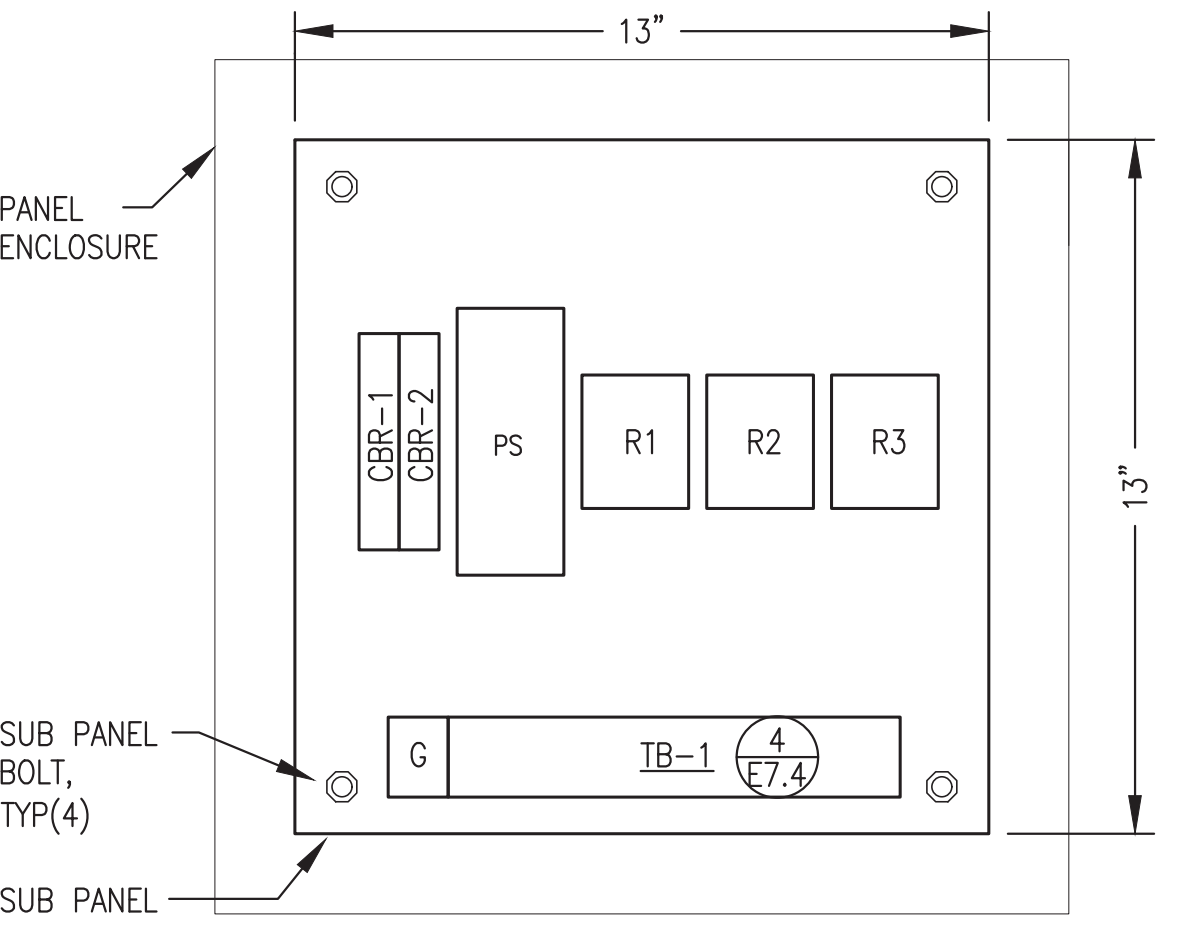


3 SUB PANEL LAYOUT
E7.4 NO SCALE

TAG	QTY	MANUFACTURER	MODEL	DESCRIPTION
CBR-1	1	ALLEN-BRADLEY	1489-M1-C020	RAIL-MOUNT CIRCUIT BREAKER, 1 POLE, 2A
LNR	3	ALLEN-BRADLEY	800HQRH2R	RED LED PILOT LIGHT, 12-130V, NEMA 4X
PS	1	PULS	CP.241-S1	5A, 120VAC/24VDC POWER SUPPLY
R	3	ALLEN-BRADLEY	700HA32A1	2PDT RELAY
	3	ALLEN-BRADLEY	700HN100	8 PIN SOCKET BASE
TB	15	ALLEN-BRADLEY	1492CAM1L	35A, 600V, LARGE-HEAD SCREW TERMINALS

PANEL SHOP FABRICATION NOTES:


- FURNISH COMPLETE PANEL ASSEMBLY WITH ALL DEVICES INDICATED IN WIRING DIAGRAM AND BILL OF MATERIALS ALONG WITH ALL PANEL DEVICE ACCESSORIES, DIN RAIL, & HARDWARE REQUIRED FOR COMPLETE INSTALLATION.
- INSTALL IN A 16"x16"x8" NEMA 12 STEEL ENCLOSURE WITH INTEGRAL MOUNTING FLANGES AT BACK, A MIN 16 GAUGE INTERIOR BACK PANEL, AND HINGED DOOR. ENCLOSURE COLOR ANSI 61 GRAY AND BACK PANEL COLOR WHITE.
- PROVIDE BEVELED EDGE WHITE CORE NAMEPLATES, FACE COLOR AS INDICATED. SECURE TO PANEL FACE WITH A MINIMUM OF TWO MOUNTING SCREWS.
- CONNECT DEVICES WITH MANUFACTURER PROVIDED CABLES IN ACCORDANCE WITH INSTALLATION INSTRUCTIONS.

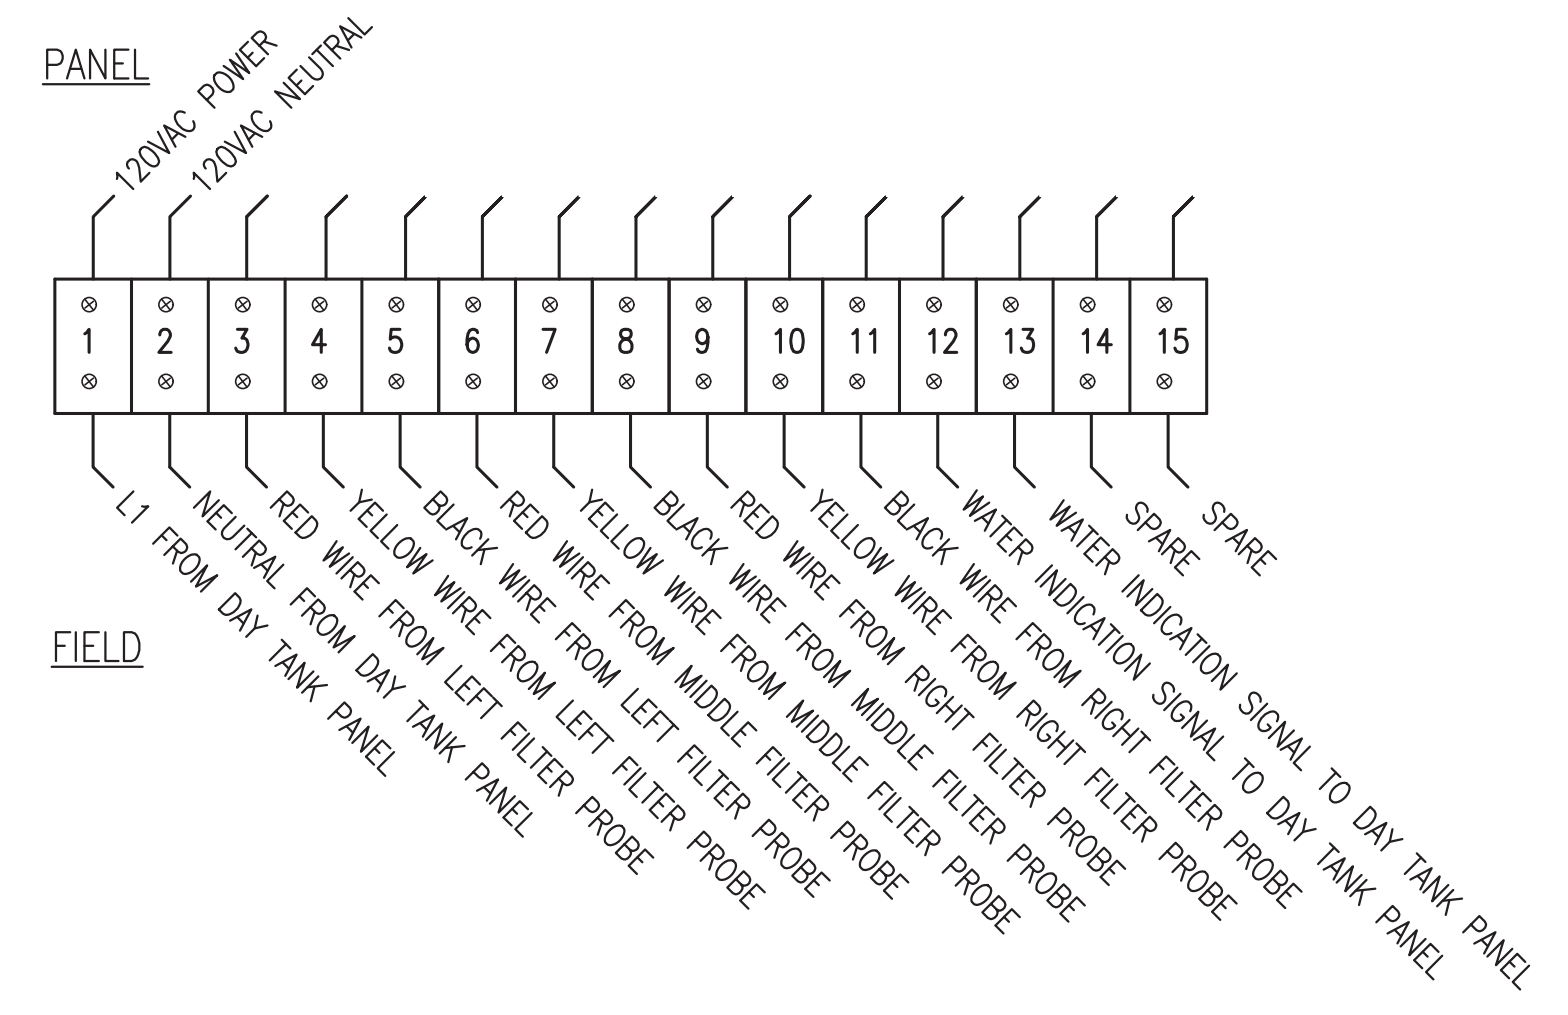

NOTES:

- INSTALL TERMINAL STRIP TB-1 HORIZONTALLY AS SHOWN. LOCATE TERMINAL STRIP BELOW WIRE TRAY TO ACCOMMODATE FIELD CONDUCTORS ENTERING BOTTOM OF PANEL, SEE SUB-PANEL LAYOUT.
- IN ADDITION TO THE TERMINAL STRIPS SHOWN, PROVIDE 2 EACH 60A SCREW TERMINAL GROUNDING BUS.

4 TERMINAL STRIP TB-1 LAYOUT
E7.4 NO SCALE

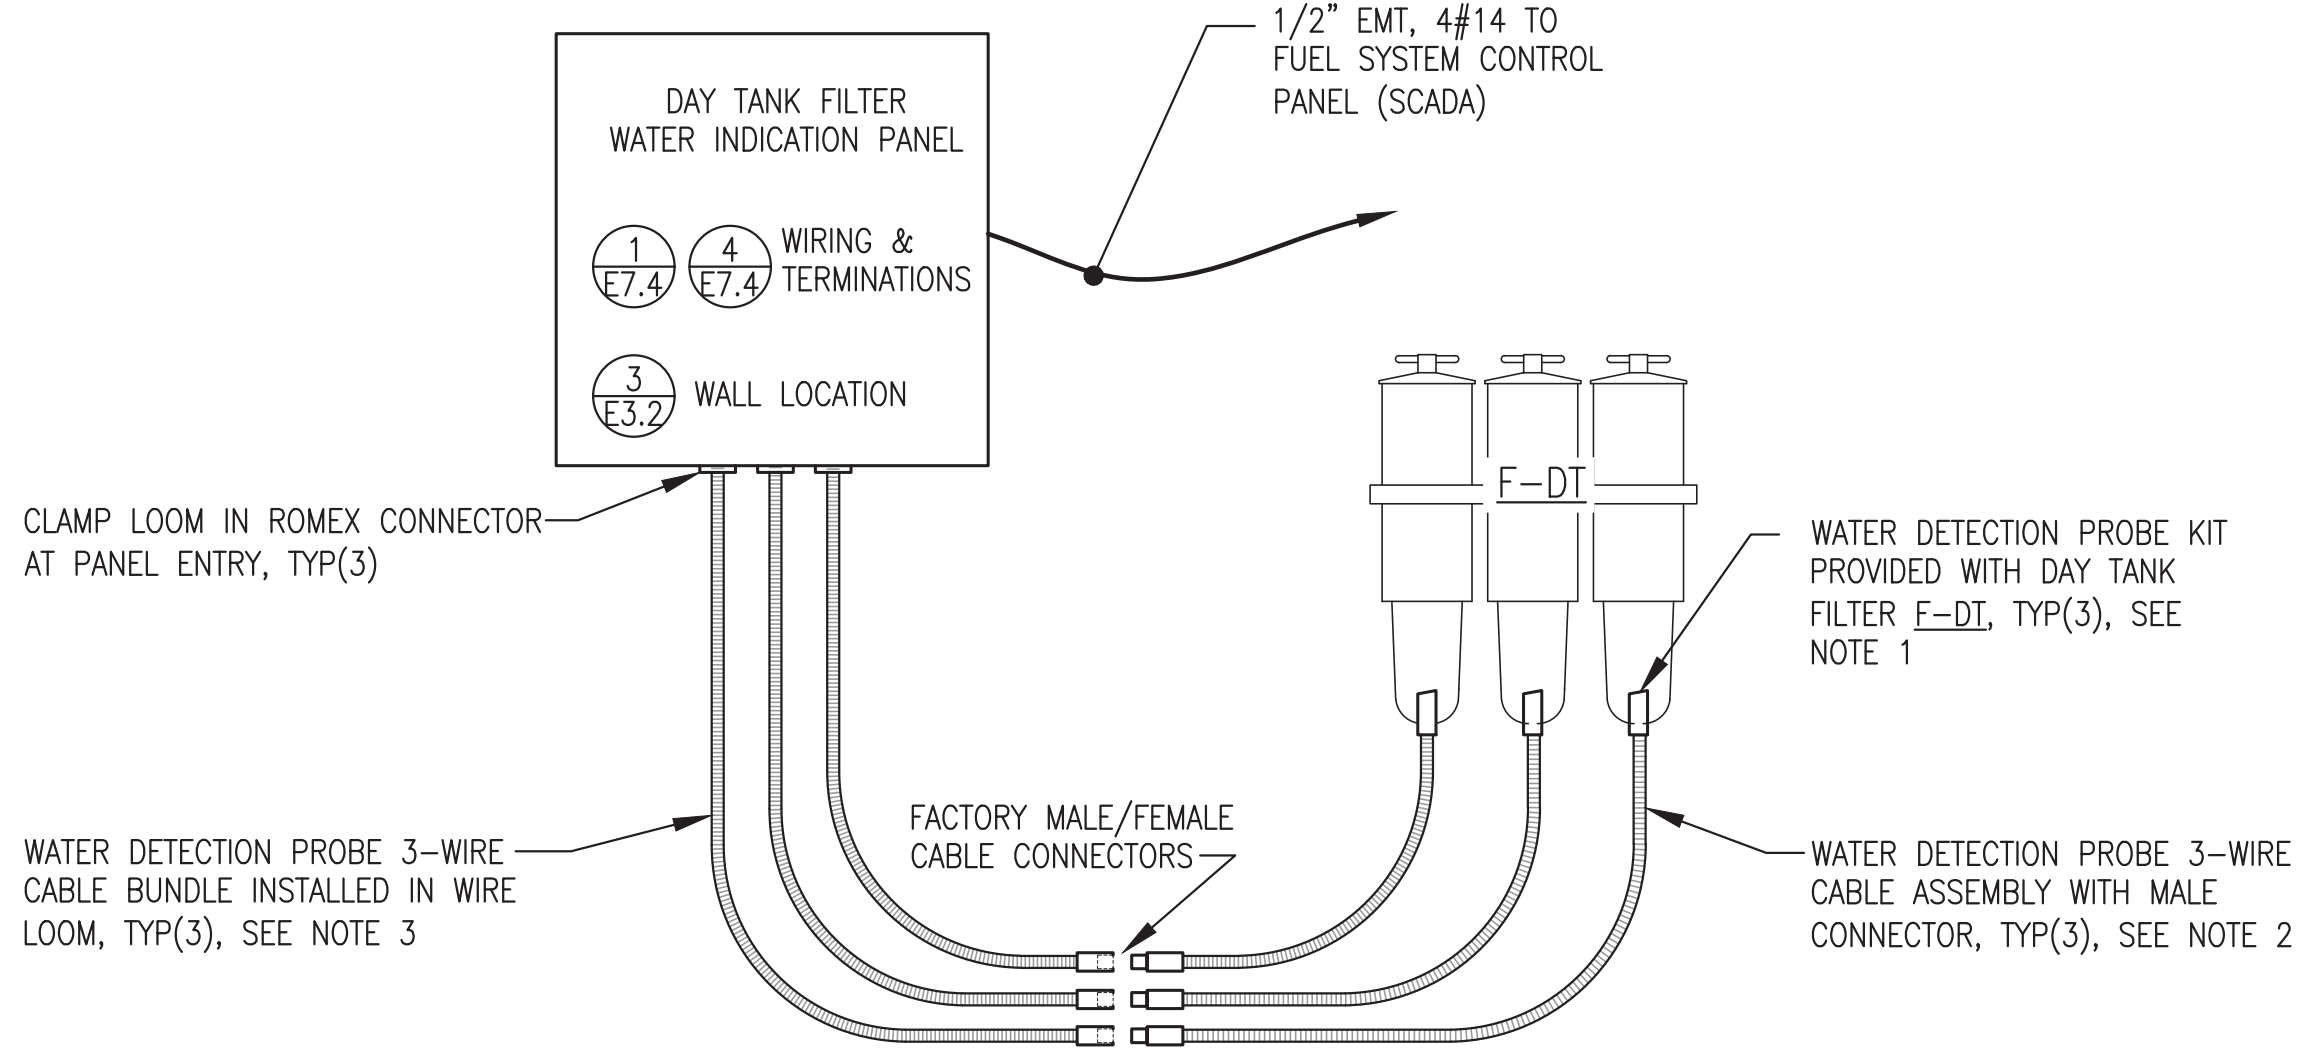


5 FIELD WIRING SCHEMATIC
E7.4 NO SCALE

NOTES:


- THREE EACH RACOR WATER DETECTION PROBE KITS, MODEL RK30880E, SHIPPED LOOSE WITH 3-FILTER BANK. NOT ALL KIT COMPONENTS USED THIS INSTALLATION. KEEP THREE EACH WATER DETECTION PROBE CABLES WITH MOLDED MALE CONNECTORS AND KEEP THREE EACH 3-WIRE CABLE BUNDLES WITH MOLDED FEMALE CONNECTORS. DISCARD THREE EACH PILOT LIGHTS AND DISCARD THREE EACH MOUNTING PANELS.
- PRIOR TO FLOODING SYSTEM WITH FUEL INSTALL WATER DETECTION PROBES IN EACH FILTER ACCORDING TO MANUFACTURER'S INSTRUCTIONS. ROUTE FACTORY LOOMED CABLES WITH MOLDED FEMALE CONNECTORS BACK TO WALL IN NEAT AND ORGANIZED FASHION FOR CONNECTION TO WIRE EXTENSION CONNECTORS. TYWRAP LOOM TO CONDUIT OR PIPING.
- FACTORY 3-WIRE CABLE BUNDLES FURNISHED WITH MOLDED MALE CONNECTORS. FIELD INSTALL IN 3/8" PLASTIC WIRE LOOM FROM CONNECTOR TO PANEL ENTRY AND ROUTE TO PANEL IN NEAT AND ORGANIZED FASHION. TYWRAP LOOM TO ADJACENT CONDUIT, PIPING, OR STRUT.

ALL WORK ON THIS SHEET WAS PERFORMED AS PART OF THE PRIOR MODULE FABRICATION CONTRACT AND IS SHOWN HERE FOR REFERENCE ONLY.


ISSUED FOR CONSTRUCTION
JULY 2022

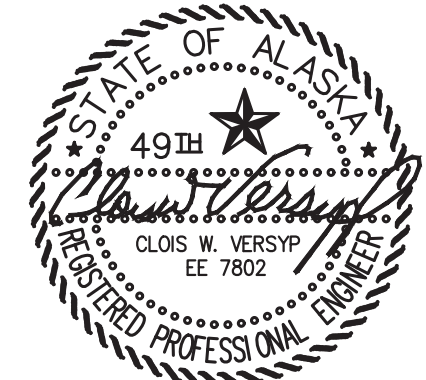

PROJECT: NAPASKIAK POWER SYSTEM UPGRADE	
TITLE: DAY TANK FILTER WATER INDICATION PANEL	
DRAWN BY: BCG/JTD	SCALE: AS NOTED
DESIGNED BY: CWV/BCG	DATE: 7/29/22
FILE NAME: NAPS PP E7	SHEET: E7.4
PROJECT NUMBER:	
P.O. 111405, Anchorage, AK 99511 (907)349-0100	

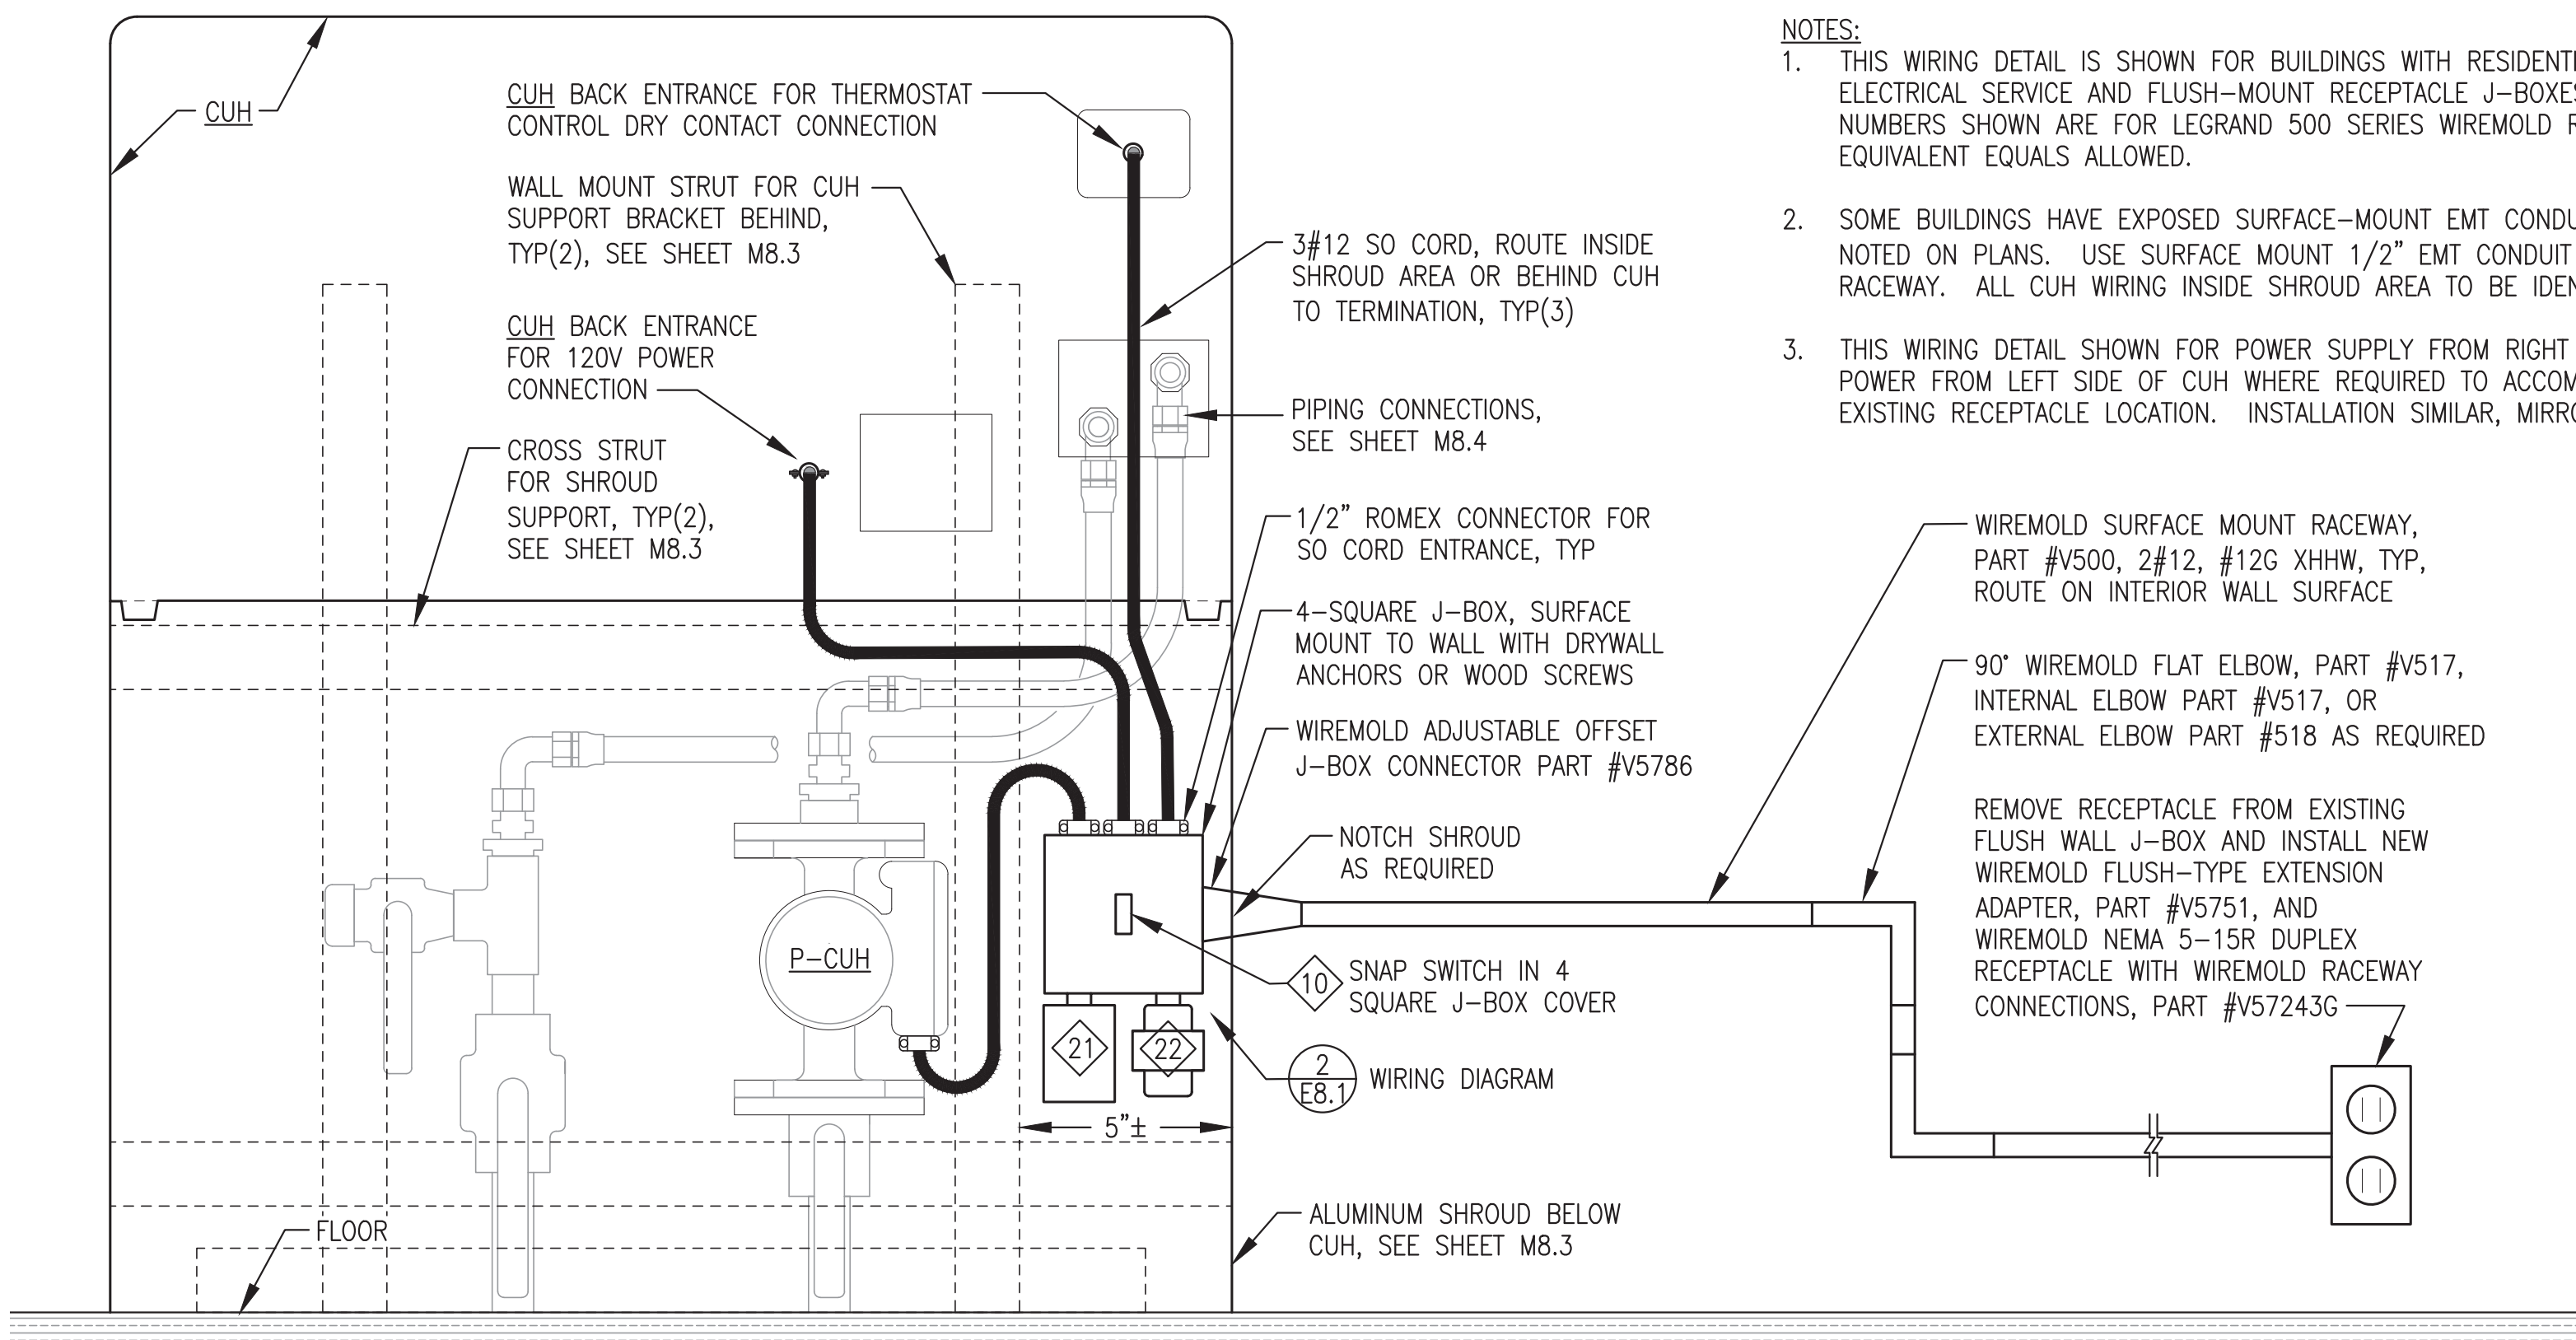


- NOTES:**
1. THIS WIRING DETAIL IS SHOWN FOR BUILDINGS WITH RESIDENTIAL STYLE IN-WALL ELECTRICAL SERVICE AND FLUSH-MOUNT RECEPTACLE J-BOXES. WIREMOLD PART NUMBERS SHOWN ARE FOR LEGRAND 500 SERIES WIREMOLD RACEWAY & FITTINGS. EQUIVALENT EQUALS ALLOWED.
 2. SOME BUILDINGS HAVE EXPOSED SURFACE-MOUNT EMT CONDUIT AND J-BOXES AS NOTED ON PLANS. USE SURFACE MOUNT 1/2" EMT CONDUIT IN PLACE OF WIREMOLD RACEWAY. ALL CUH WIRING INSIDE SHROUD AREA TO BE IDENTICAL TO THIS DETAIL.
 3. THIS WIRING DETAIL SHOWN FOR POWER SUPPLY FROM RIGHT SIDE OF CUH. PROVIDE POWER FROM LEFT SIDE OF CUH WHERE REQUIRED TO ACCOMMODATE NEAREST EXISTING RECEPTACLE LOCATION. INSTALLATION SIMILAR, MIRROR IMAGE.

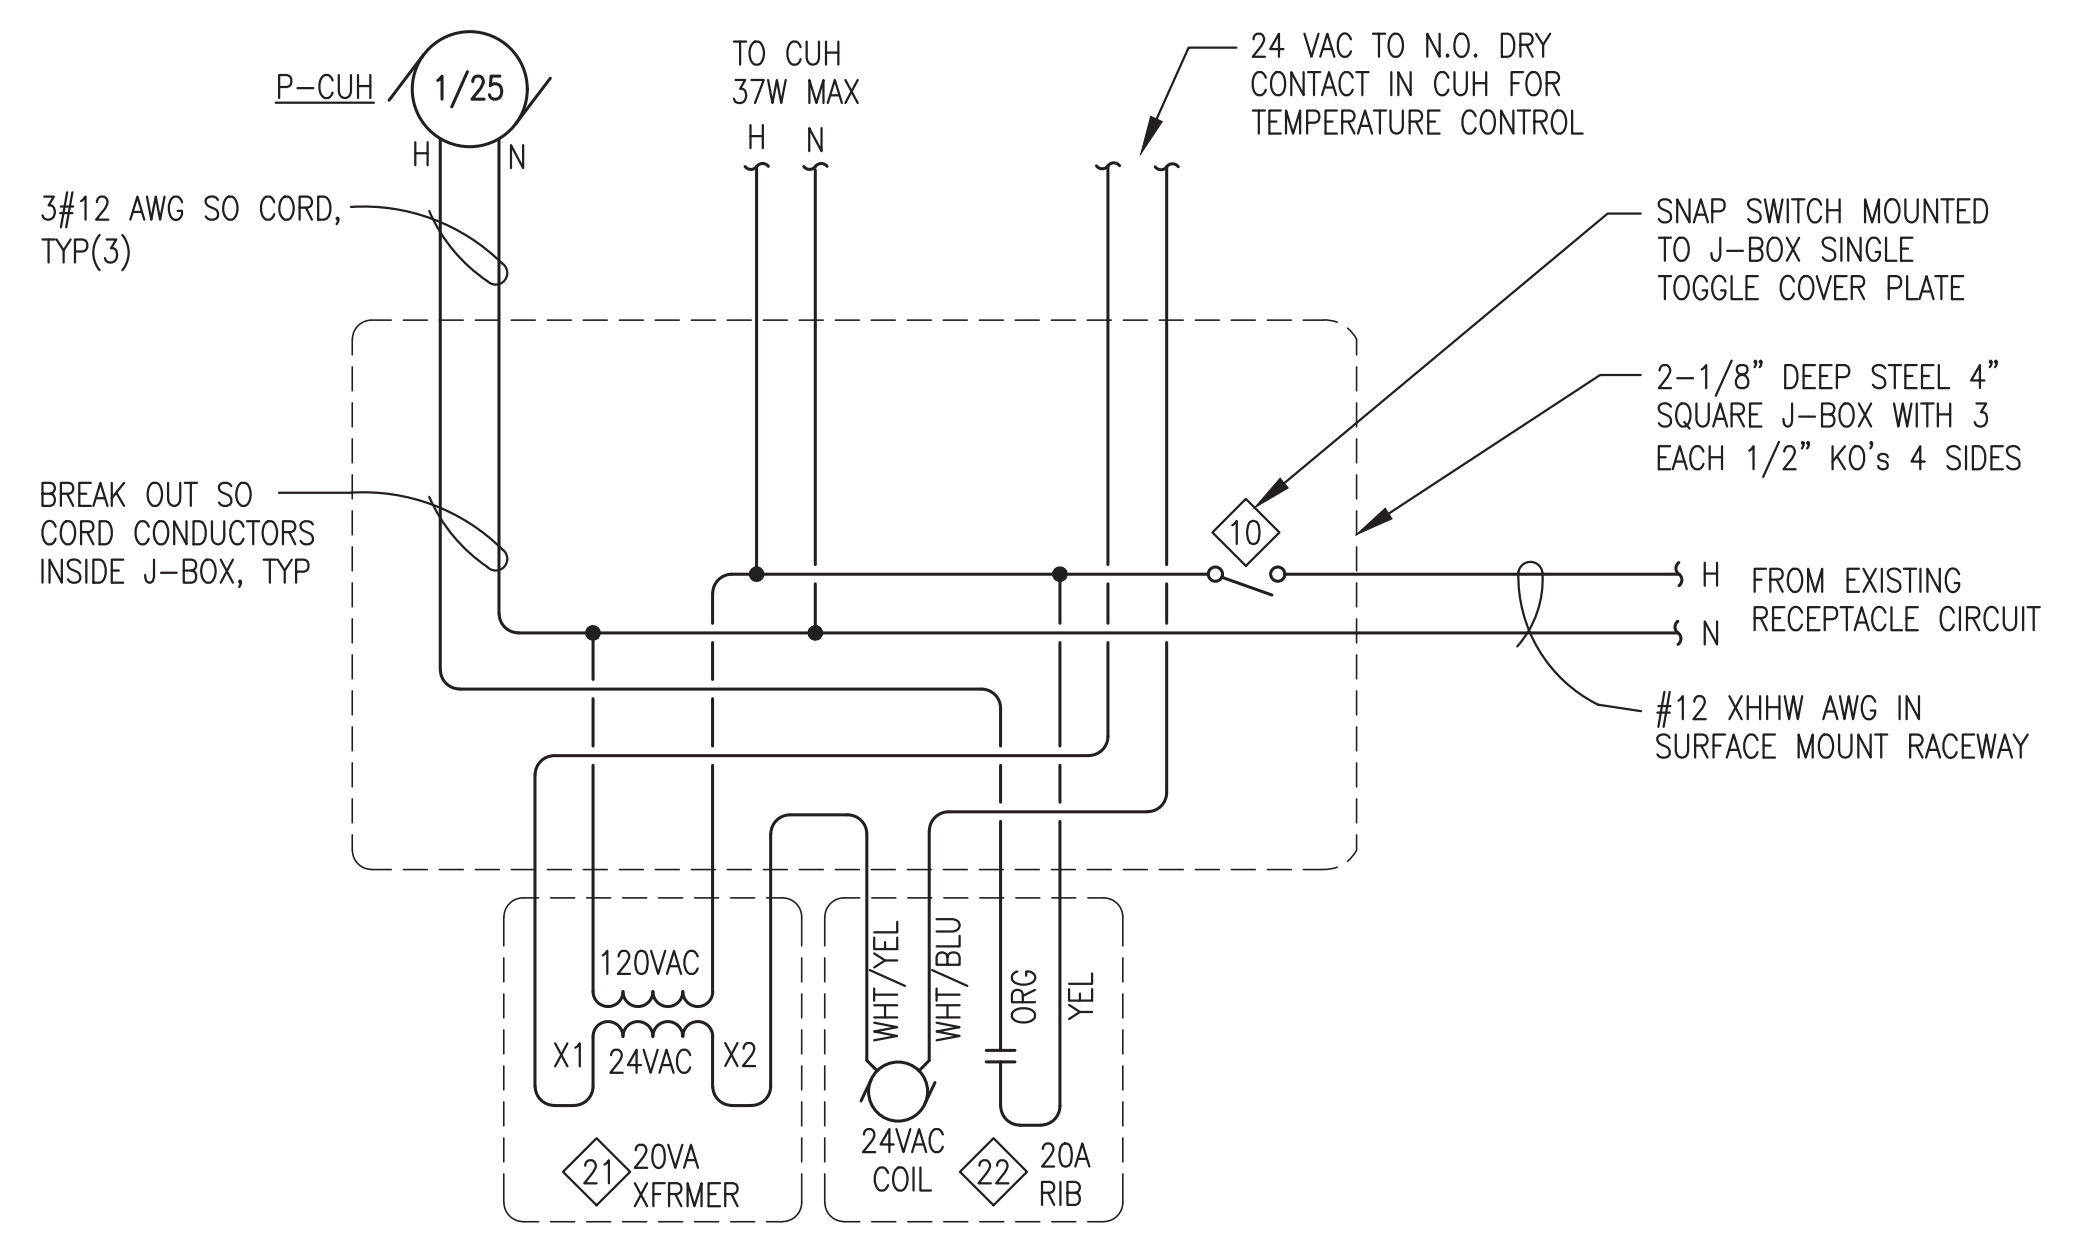


2 TYPICAL CUH WIRING DIAGRAM
E8.1 NO SCALE

1 TYPICAL CUH WIRING ELEVATION
E8.1 NO SCALE

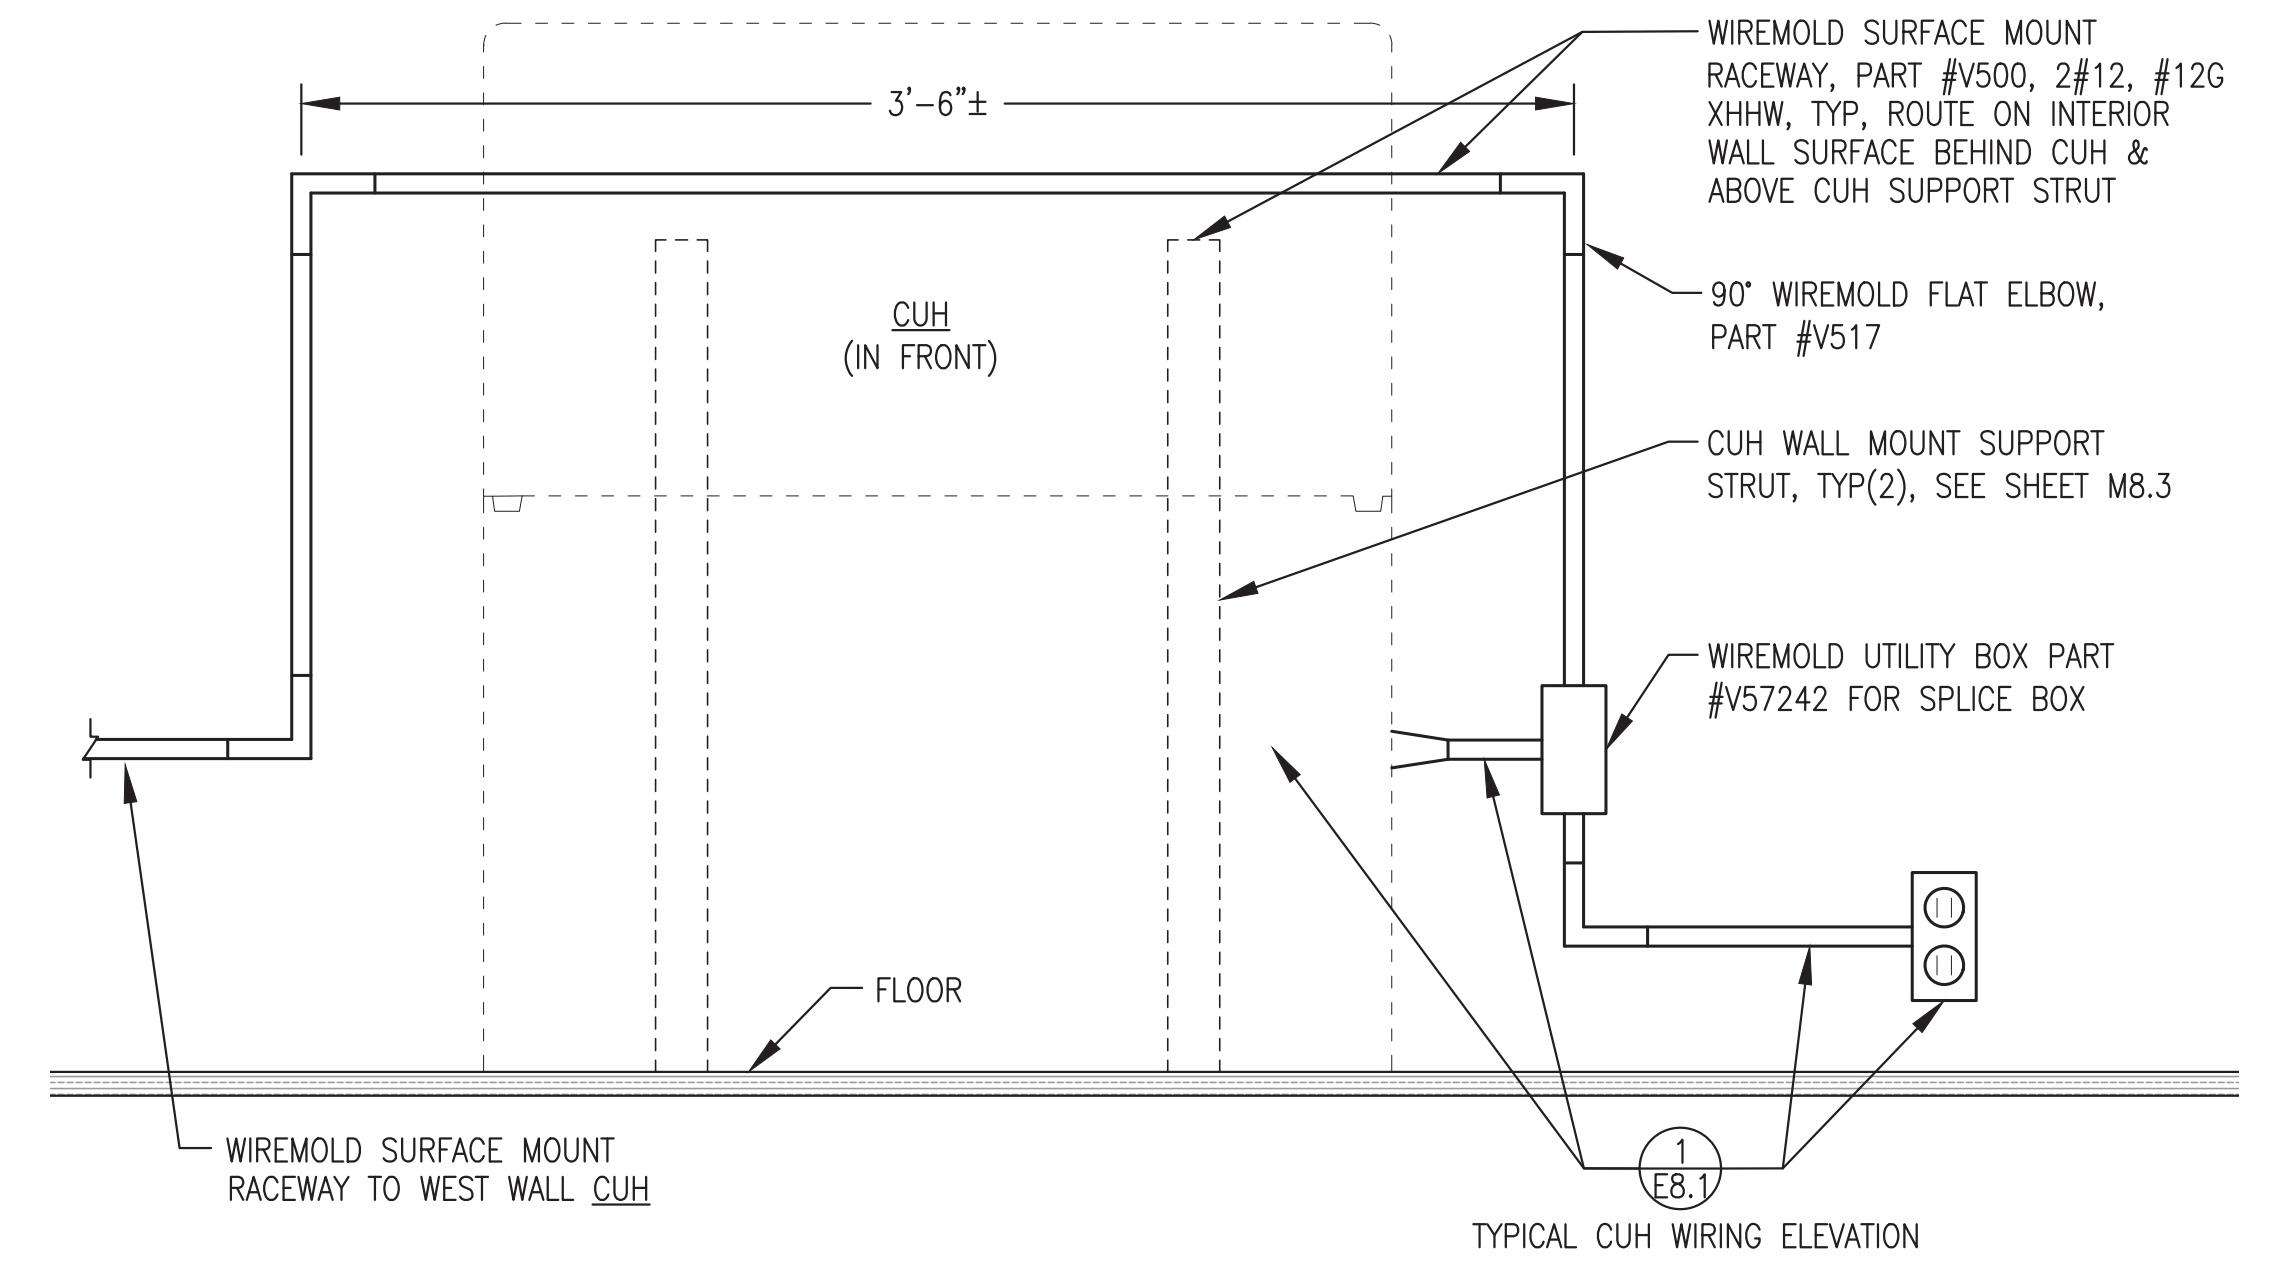


4 WIREMOLD RACEWAY BRANCH CIRCUIT BEHIND CUH ON CHURCH NORTH WALL
E8.1 NO SCALE

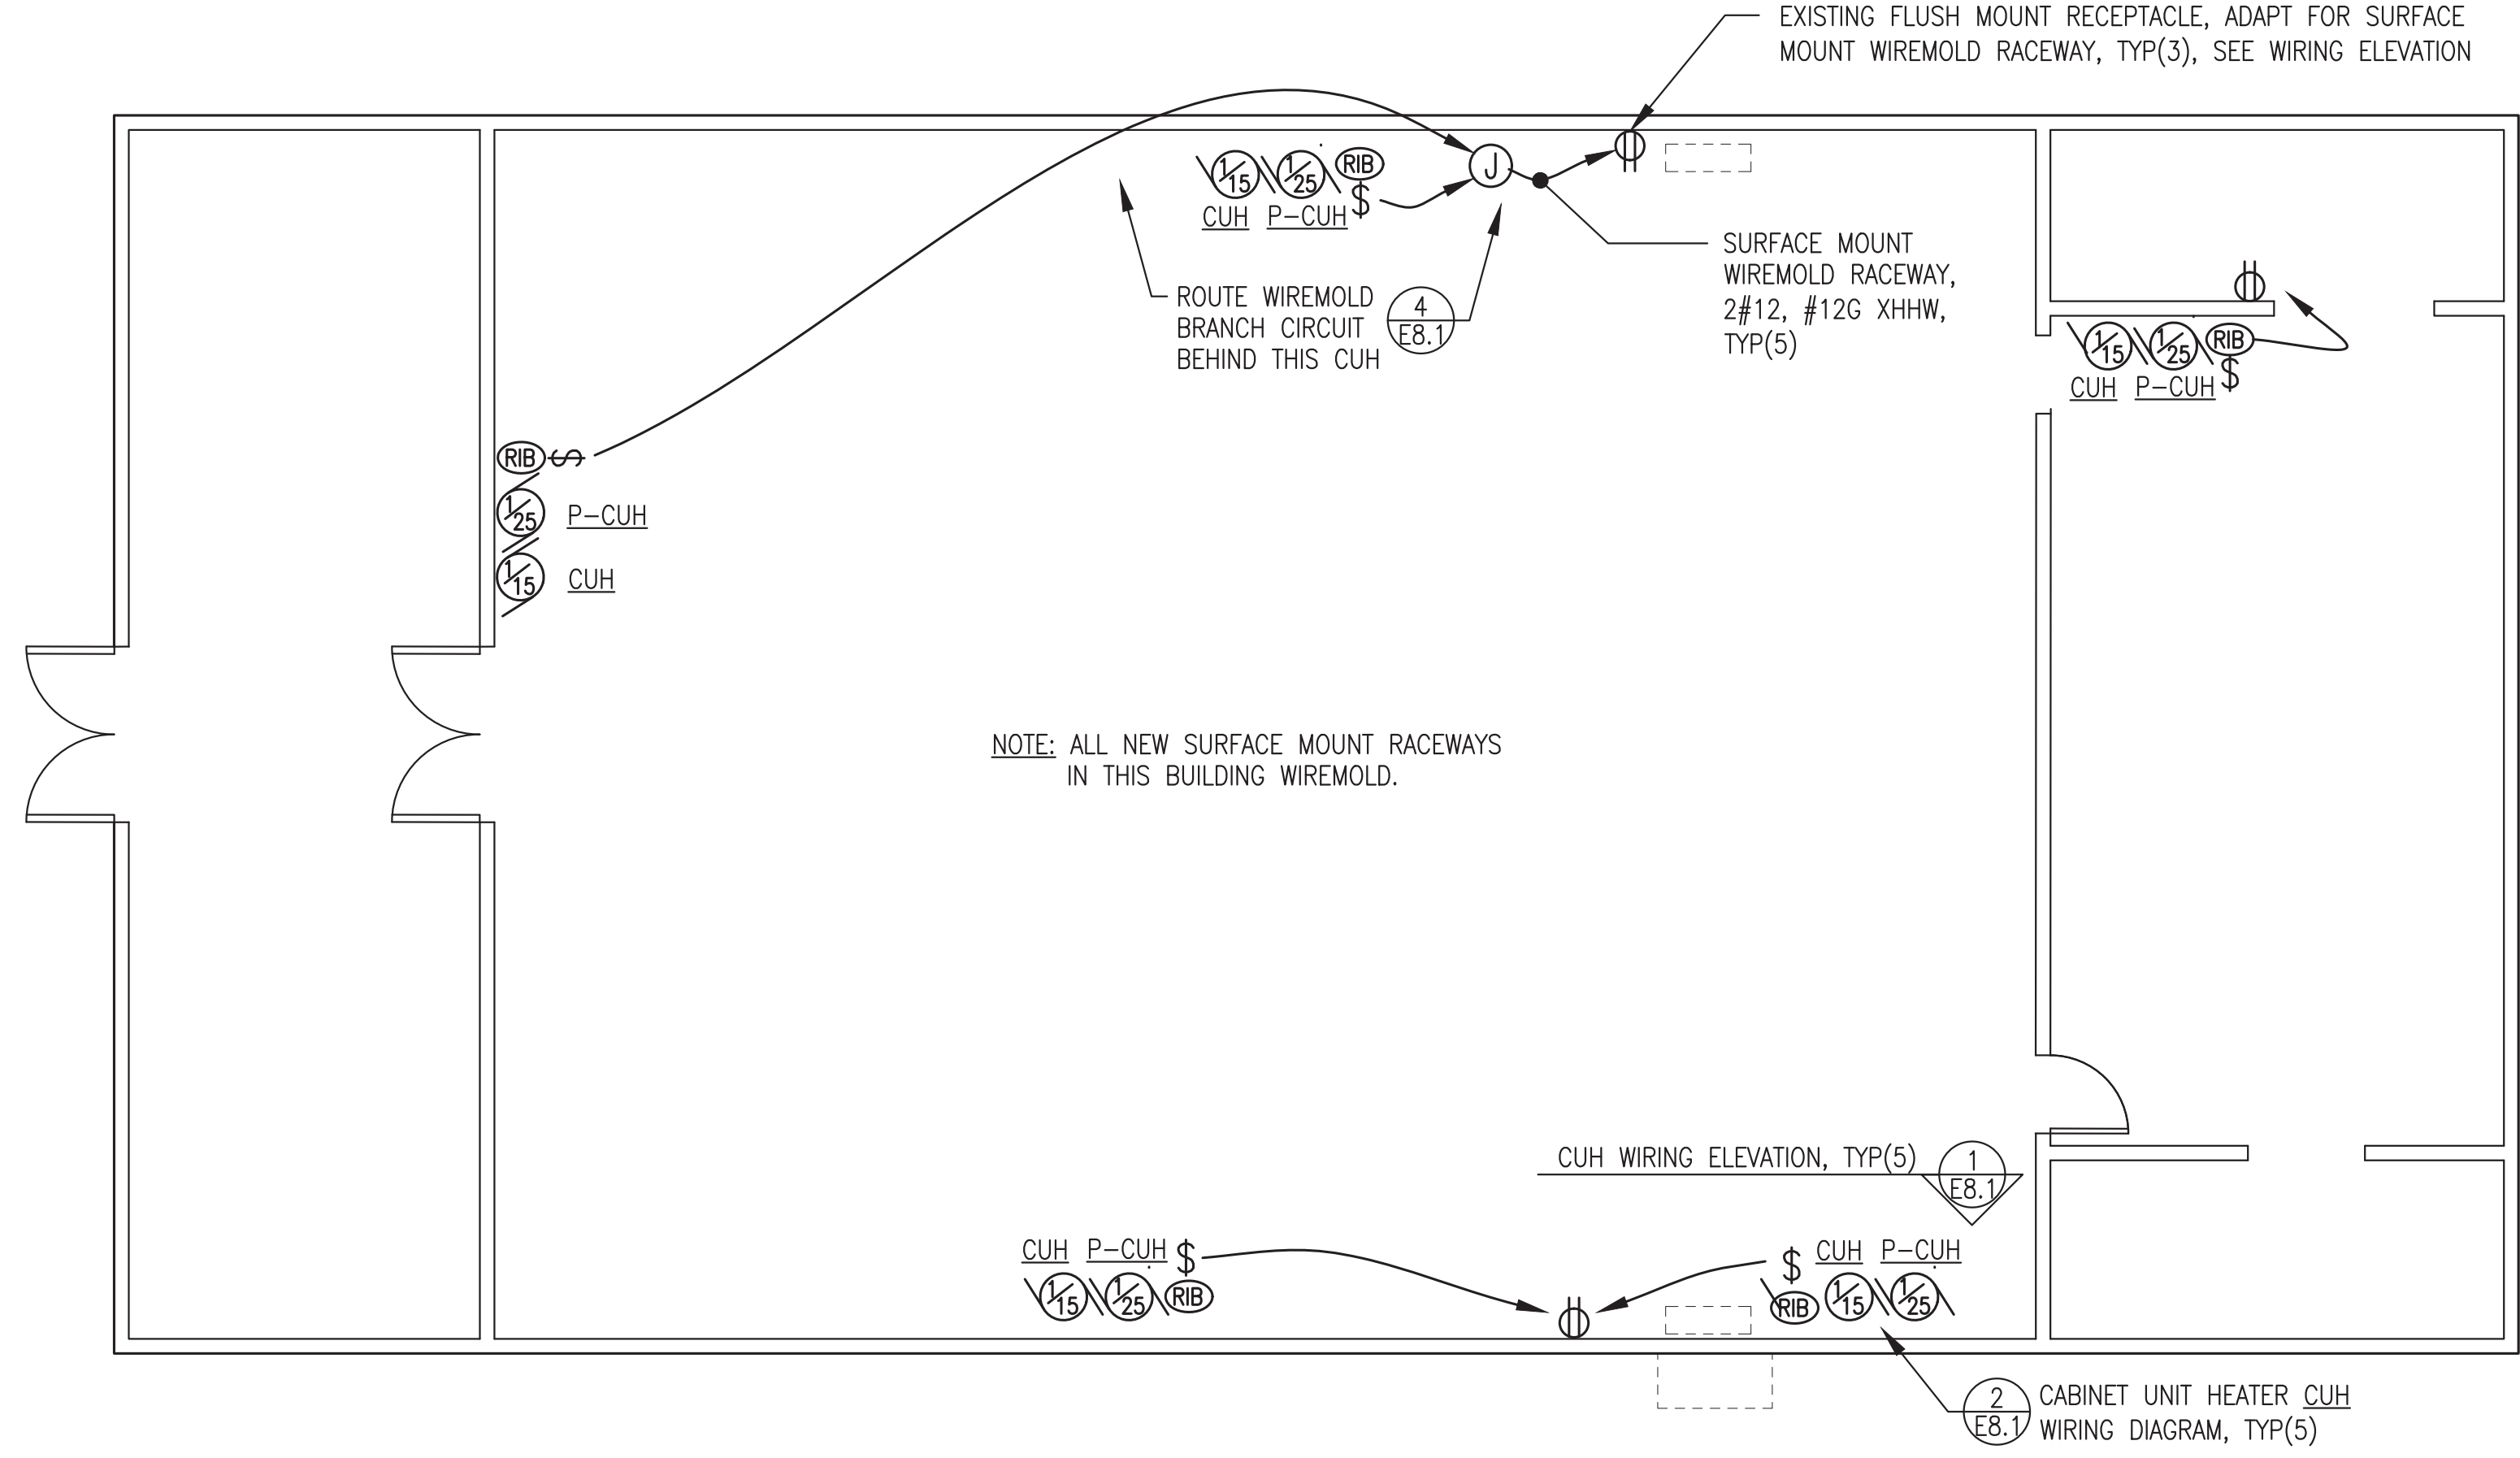


3 BUILDING A RUSSIAN OTHODOX CHURCH ELECTRICAL PLAN
E8.1 3/16"=1'-0"

ALL WORK ON SHEETS E8.1 THROUGH E8.4 IS INCLUDED IN THE ON SITE CONTRACT. PROVIDE ENTIRE HEAT RECOVERY SYSTEM AS SHOWN ON SHEETS E8.1 THROUGH E8.4 UNDER ADDITIVE ALTERNATE #1.

ISSUED FOR CONSTRUCTION
DECEMBER 2022

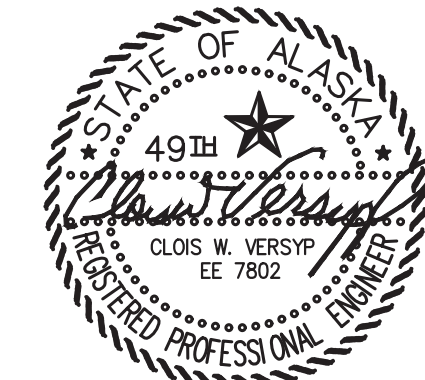



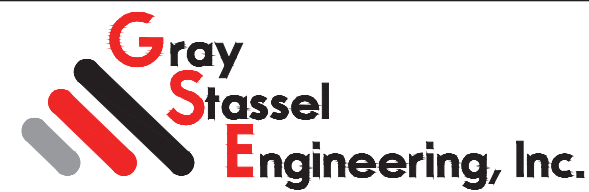
ALASKA ENERGY AUTHORITY		
PROJECT: NAPASKIAK POWER SYSTEM UPGRADE		
TITLE: HEAT RECOVERY SYSTEM BUILDING A ELECTRICAL PLAN & DETAILS		
DESIGNED BY: CWV/BCG	SCALE: AS NOTED	DATE: 12/15/22
DRAWN BY: JTD	FILE NAME: NAPS PP E8	SHEET: E8.1
PROJECT NUMBER: E8.1		
P.O. 111405, Anchorage, AK 99511 (907)349-0100		

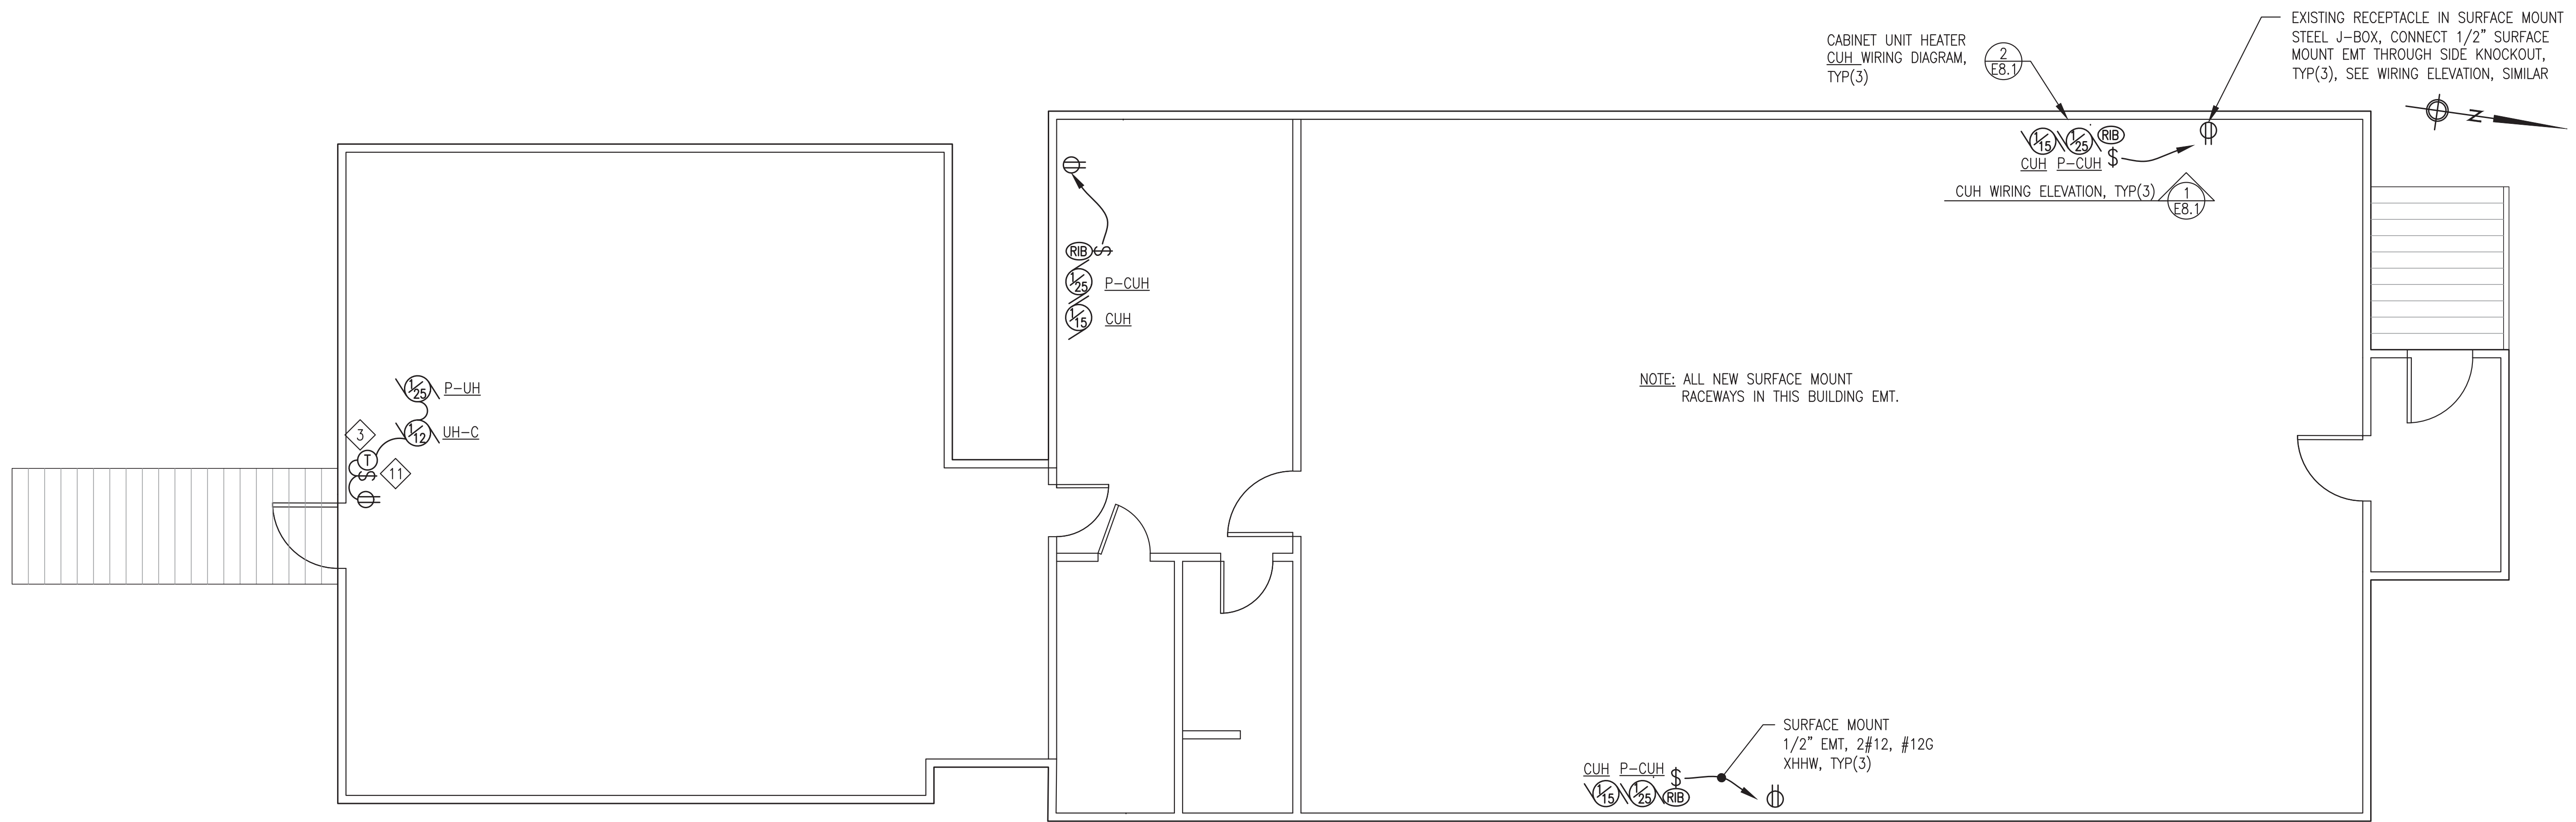


1 BUILDING B NEW OFFICE BUILDING ELECTRICAL PLAN
 E8.2 3/16"=1'-0"


ISSUED FOR
 CONSTRUCTION
 DECEMBER 2022

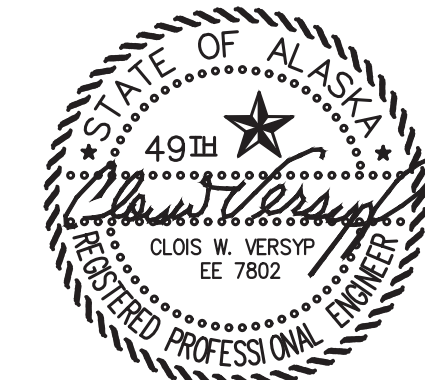

 ALASKA ENERGY AUTHORITY		
PROJECT: NAPASKIAK POWER SYSTEM UPGRADE		
TITLE: HEAT RECOVERY SYSTEM BUILDING B ELECTRICAL PLAN		
 Gray Stassel Engineering, Inc. P.O. 111405, Anchorage, AK 99511 (907)349-0100	DRAWN BY: JTD DESIGNED BY: CWV/BCG FILE NAME: NAPS PP E8 PROJECT NUMBER:	SCALE: AS NOTED DATE: 12/15/22 SHEET: E8.2

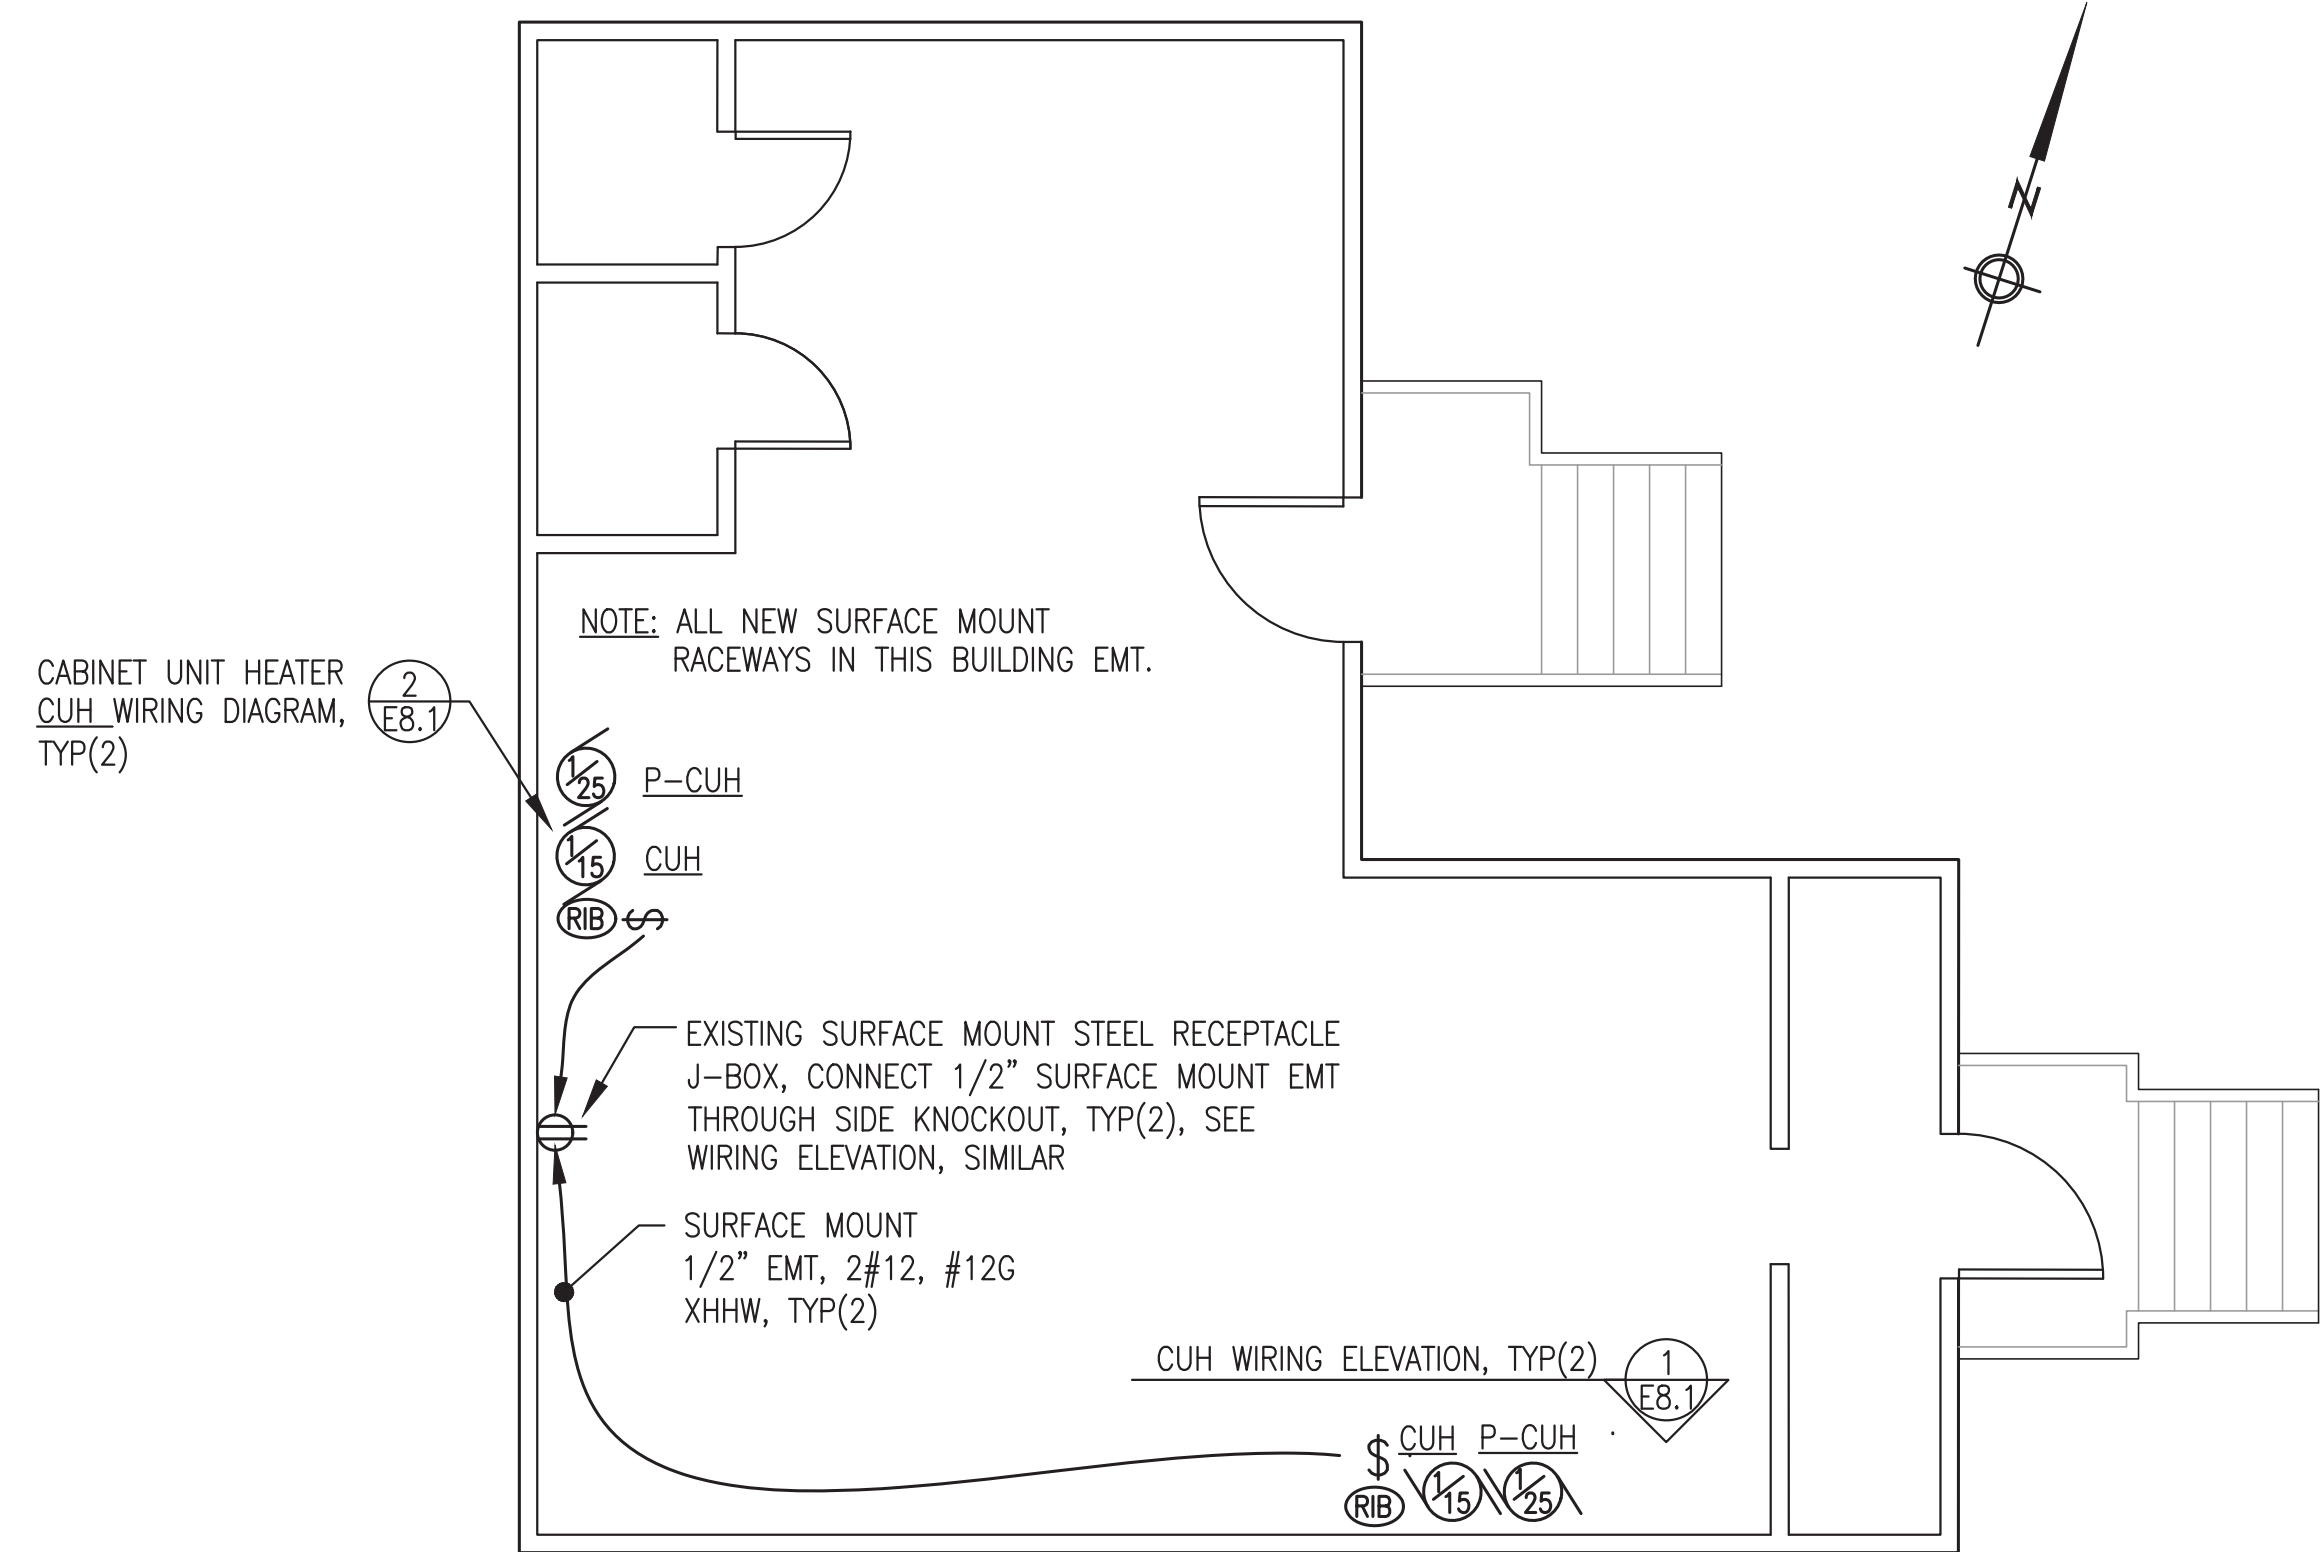


1 BUILDING C BINGO HALL ELECTRICAL PLAN
E8.3 3/16"=1'-0"

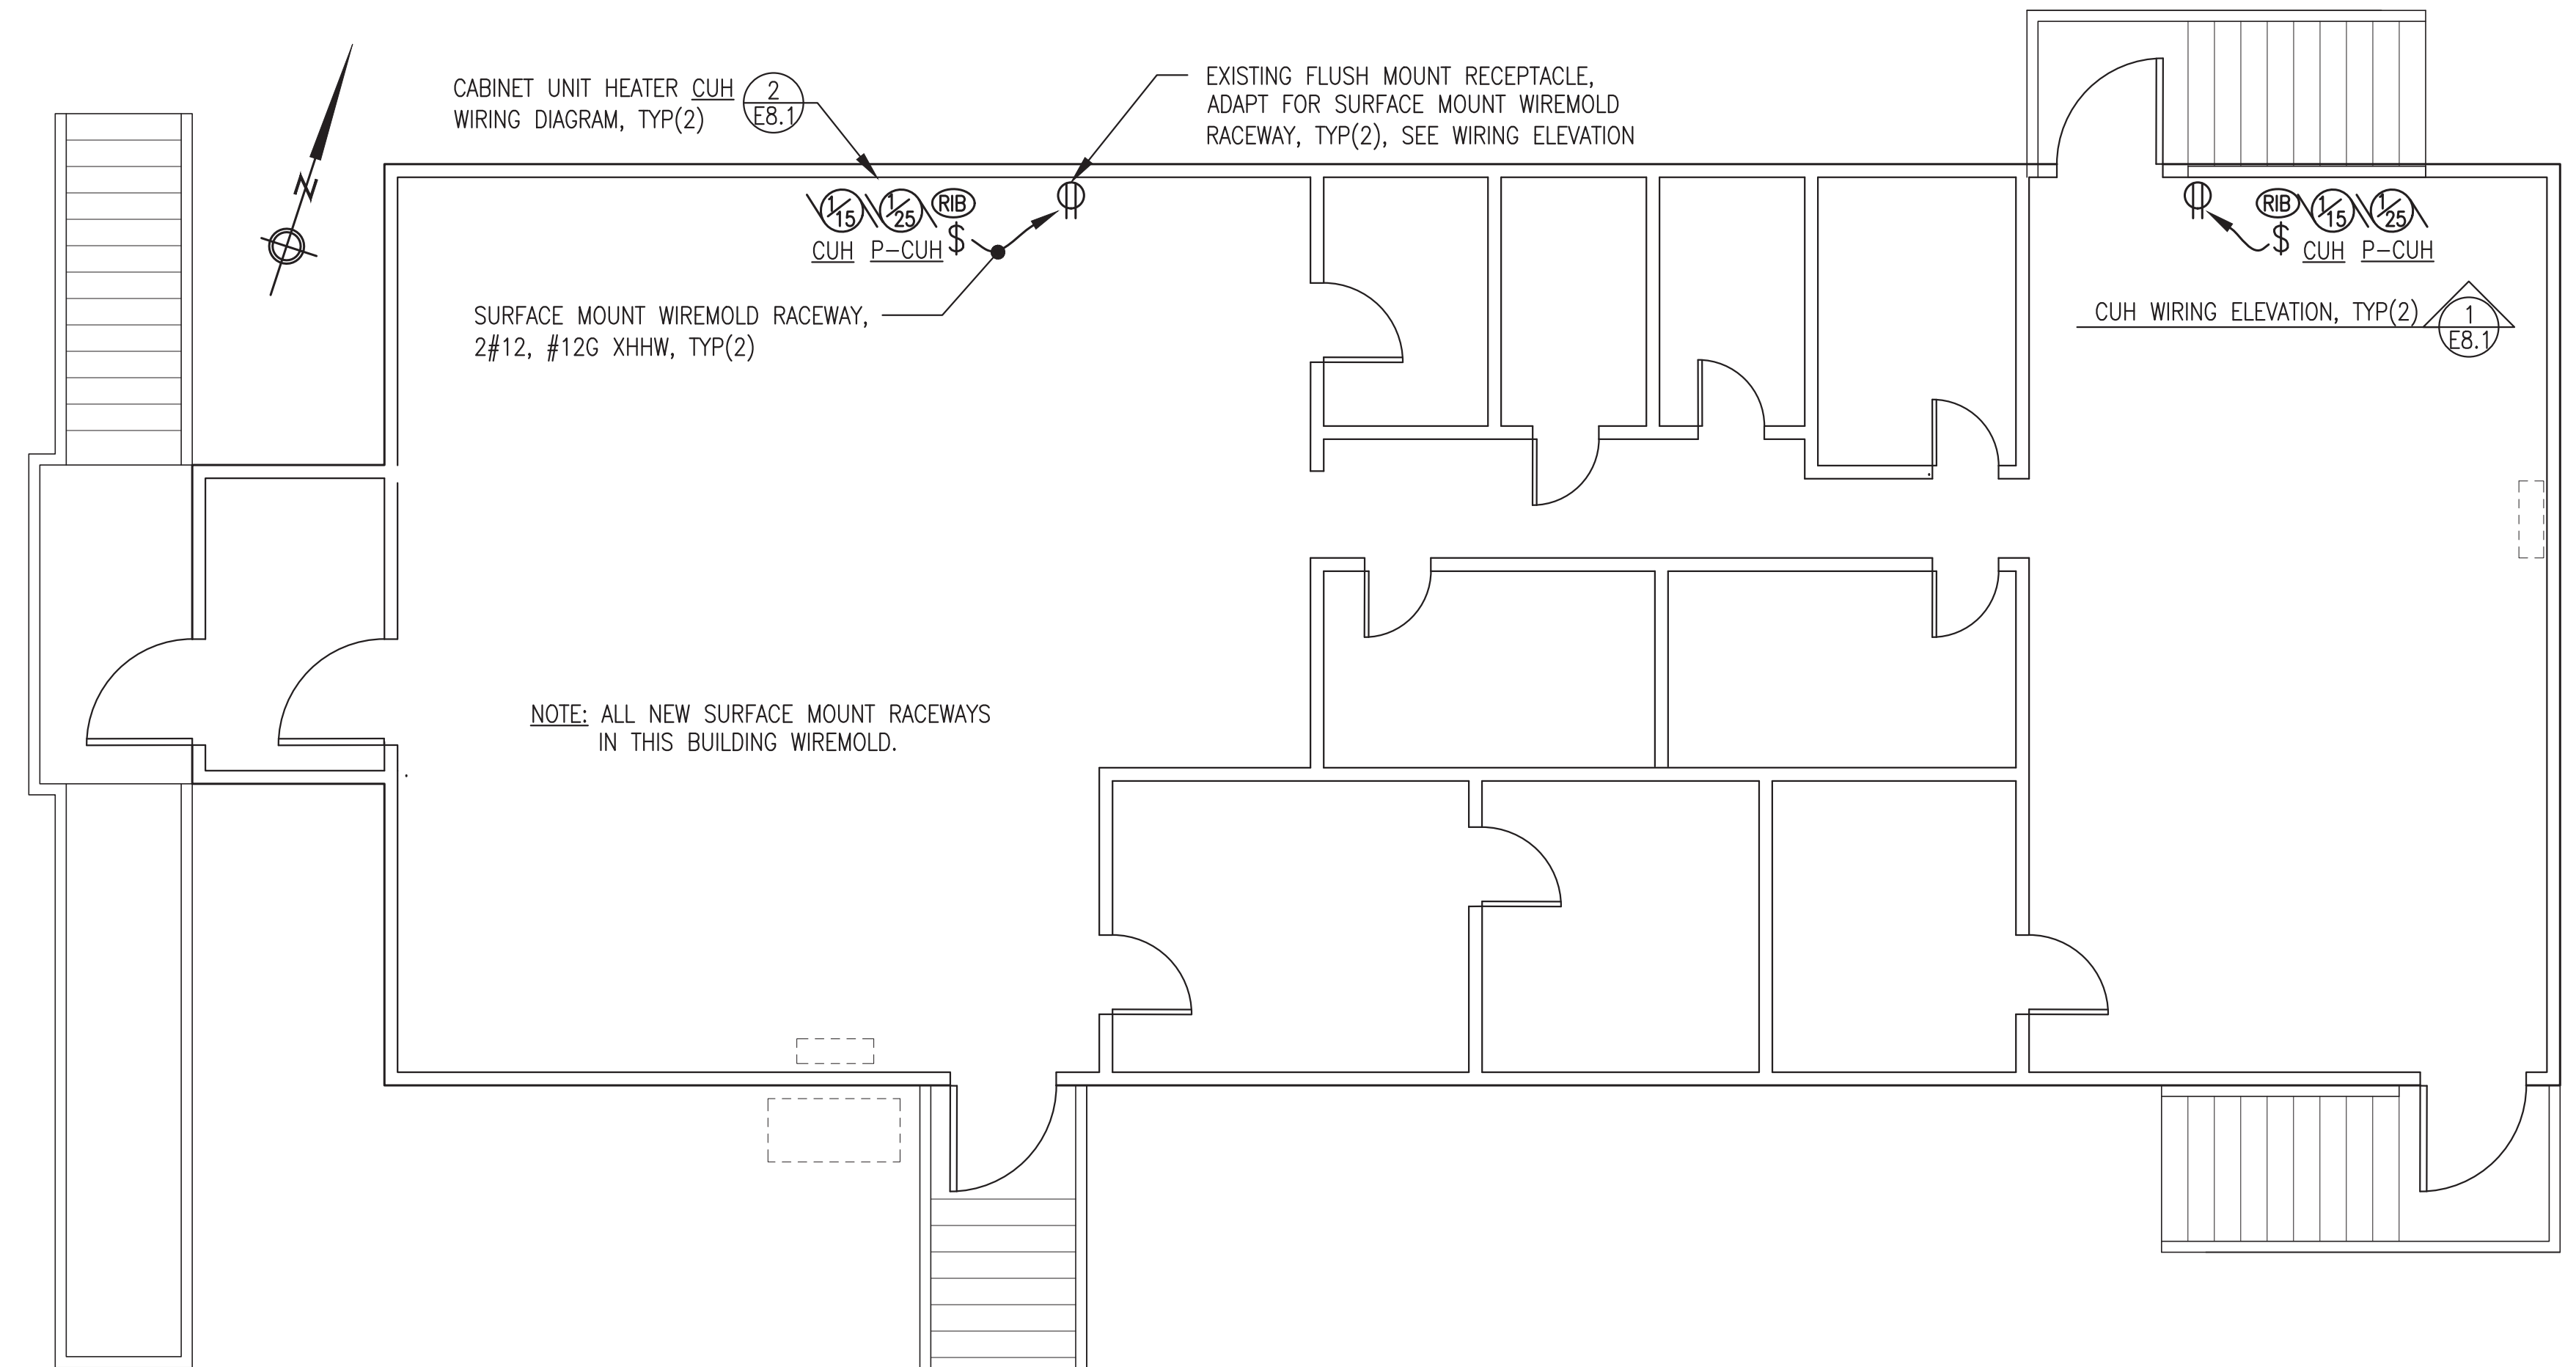


2 BUILDING D HEADSTART ELECTRICAL PLAN
E8.3 3/16"=1'-0"

ISSUED FOR
CONSTRUCTION
DECEMBER 2022

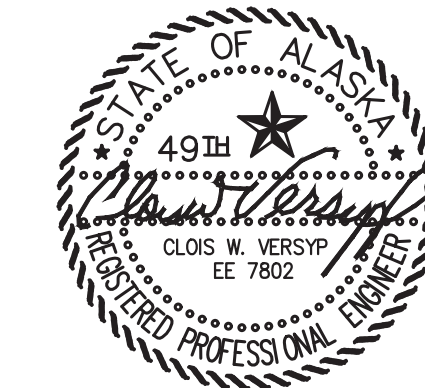


PROJECT: NAPASKIAK POWER SYSTEM UPGRADE		
TITLE: HEAT RECOVERY SYSTEM BUILDINGS C & D ELECTRICAL PLANS		
DRAWN BY: JTD	SCALE: AS NOTED	DATE: 12/15/22
DESIGNED BY: CWV/BCG	FILE NAME: NAPS PP E8	SHEET: E8.3
PROJECT NUMBER:		




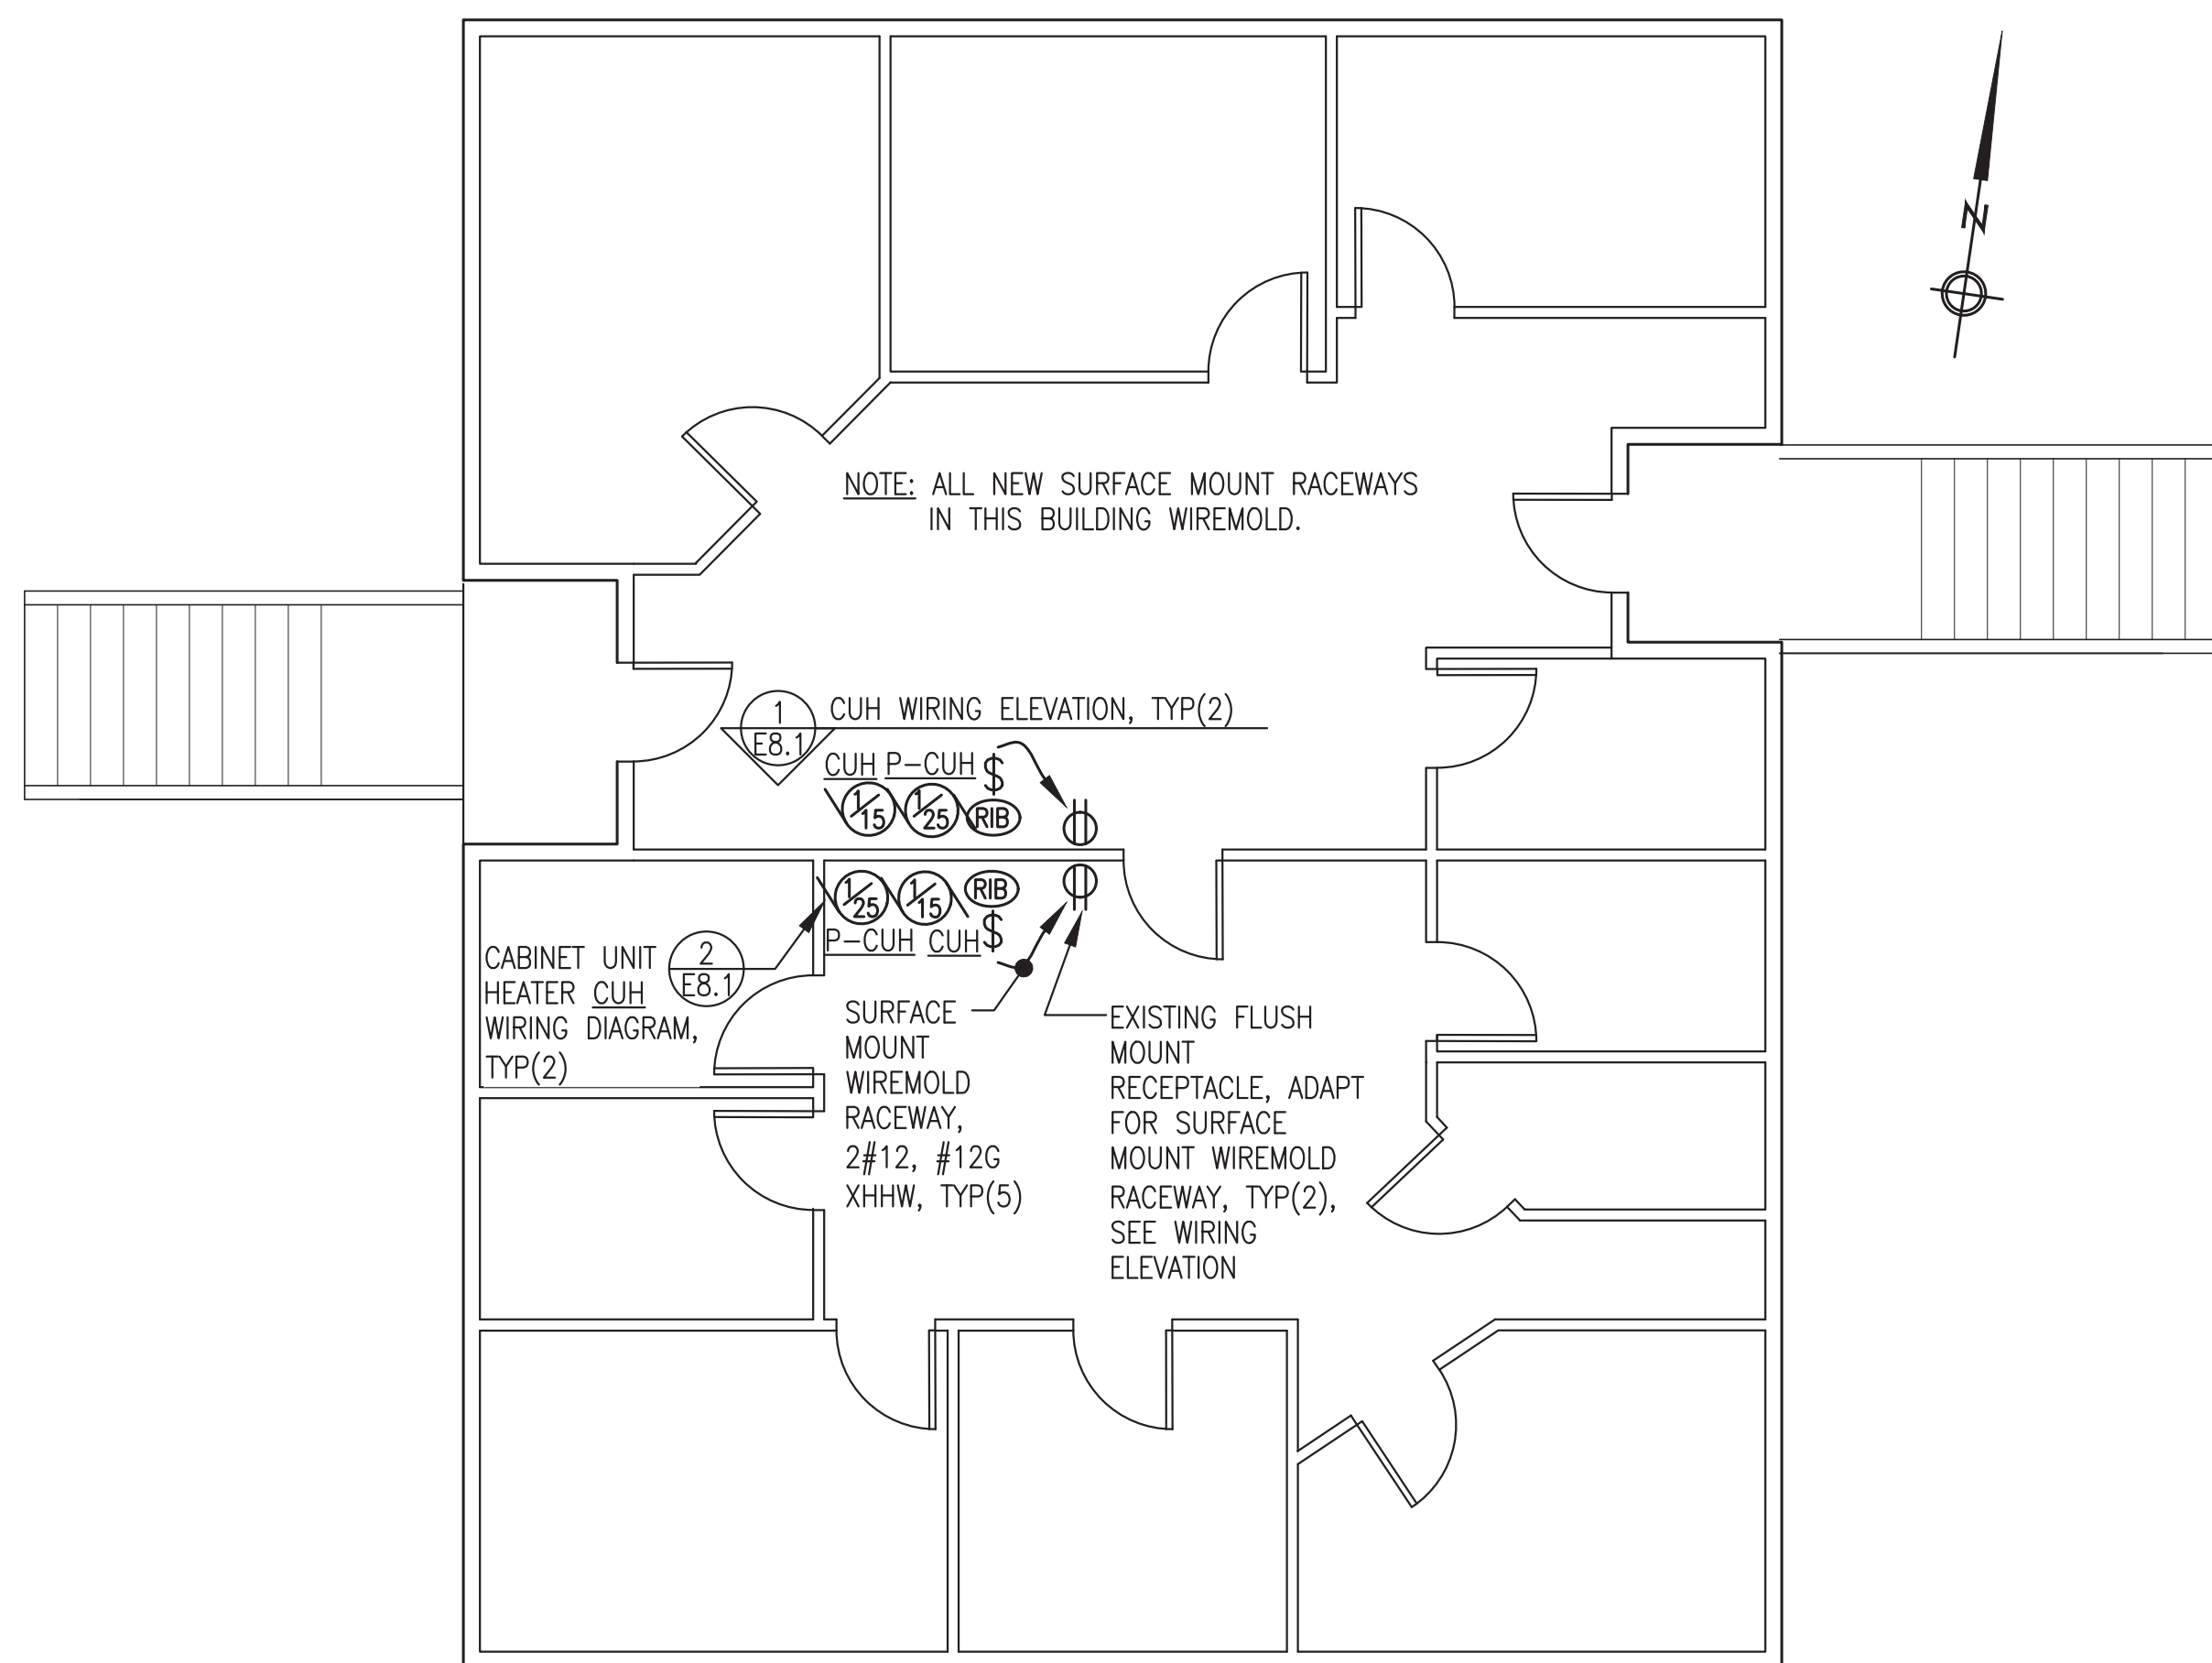

1 BUILDING E VPSO ELECTRICAL PLAN
E8.4 3/16"=1'-0"

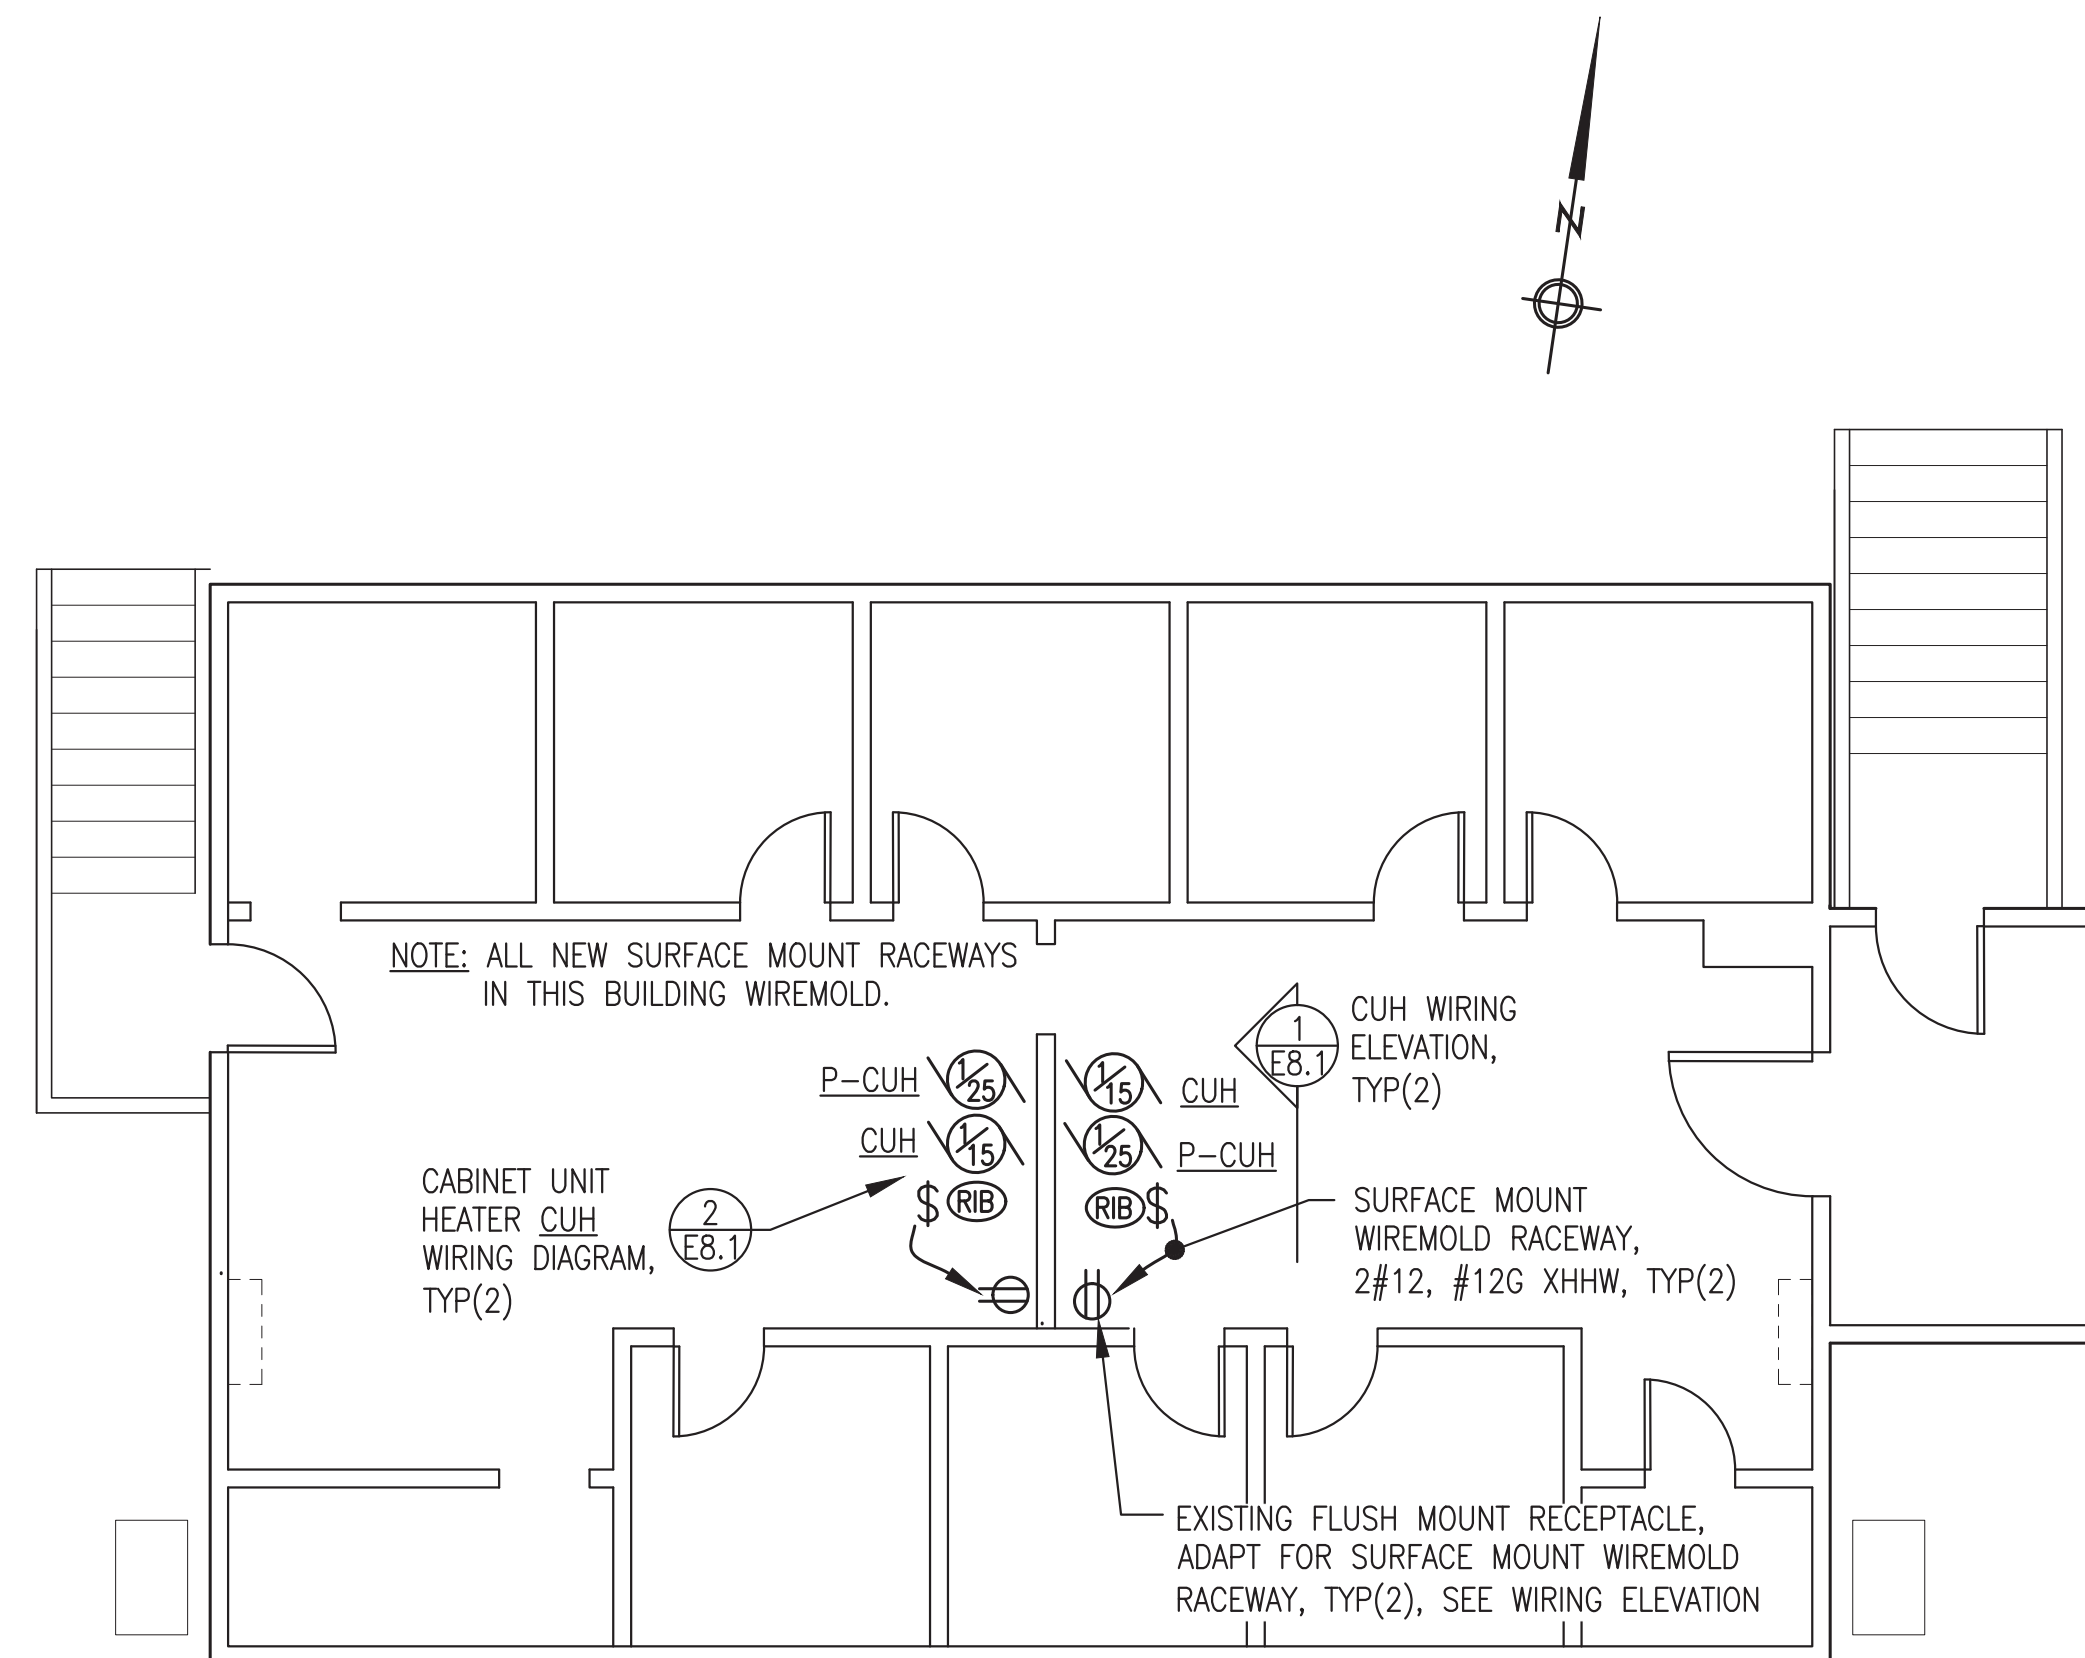



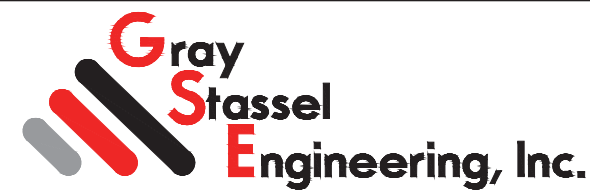
2 BUILDING F OLD OFFICE BUILDING ELECTRICAL PLAN
E8.4 3/16"=1'-0"

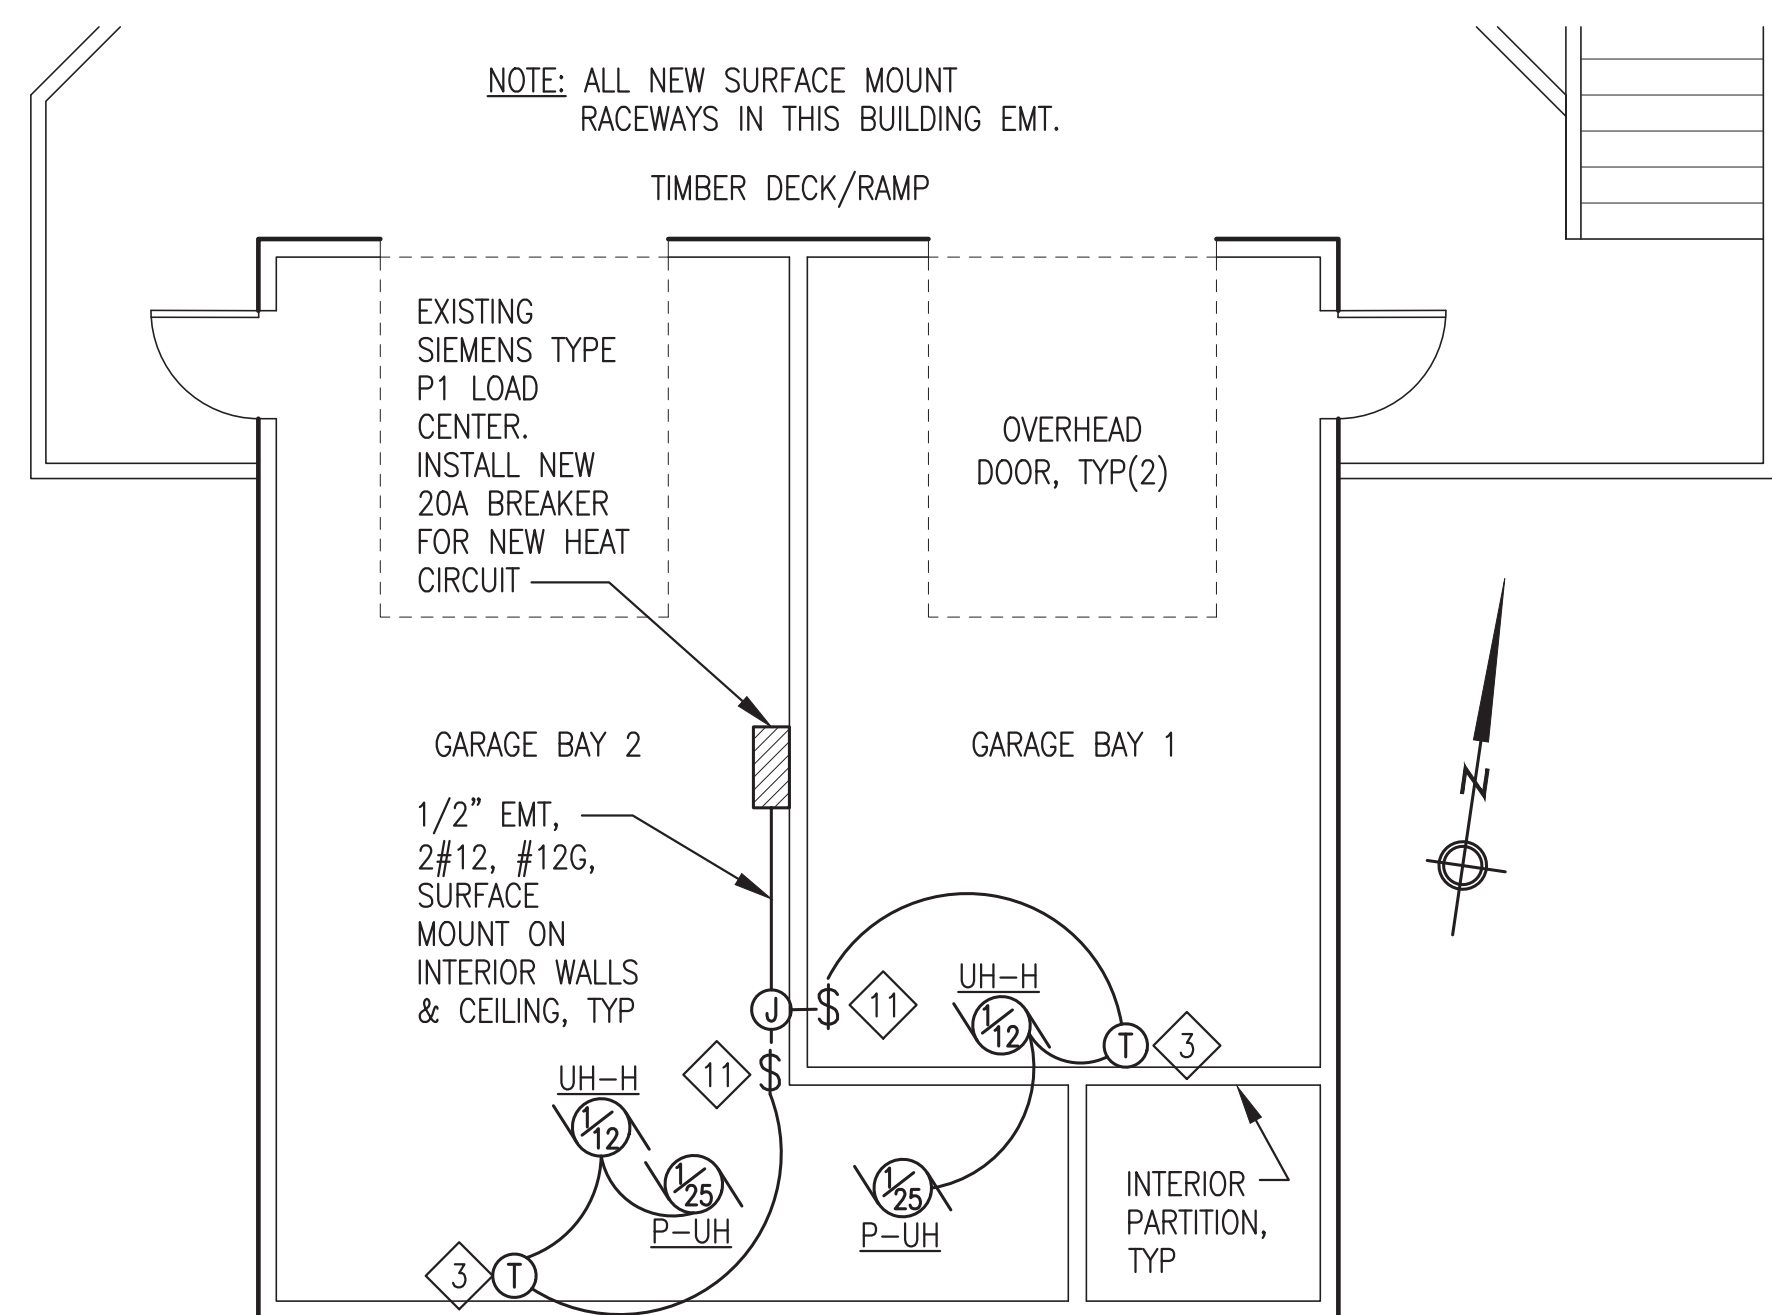

3 BUILDING G GARAGE ELECTRICAL PLAN
E8.4 3/16"=1'-0"

ISSUED FOR CONSTRUCTION
DECEMBER 2022

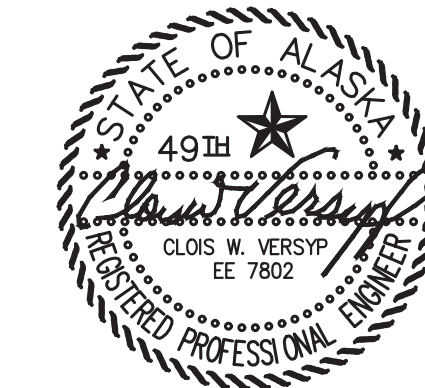

 ALASKA ENERGY AUTHORITY		
PROJECT: NAPASKIAK POWER SYSTEM UPGRADE		
TITLE: HEAT RECOVERY SYSTEM BUILDINGS E, F, & G ELECTRICAL PLANS		
	DRAWN BY: JTD DESIGNED BY: CWV/BCG FILE NAME: NAPS PP E8 PROJECT NUMBER:	SCALE: AS NOTED DATE: 12/15/22 SHEET: E8.4
P.O. 111405, Anchorage, AK 99511 (907)349-0100		

DISTRIBUTION SYSTEM GENERAL NOTES

- ALL CONSTRUCTION WORK SHALL BE DONE IN ACCORDANCE WITH THE STAKING SHEETS, NOTES TO STAKING SHEETS, SPECIFICATIONS, AND THE DRAWINGS.
- ALL INSTALLATION SHALL MEET THE LATEST ADOPTED EDITION OF THE NATIONAL ELECTRICAL SAFETY CODE (NEC), ANSI C2, AND THE NATIONAL ELECTRICAL CODE, NFPA 70, INCLUDING ANY STATE OF ALASKA AMENDMENTS. RUS BULLETIN 1728F-804, SPECIFICATIONS AND DRAWINGS FOR 12.47/7.2 kV LINE CONSTRUCTION SHALL BE FOLLOWED UNLESS SPECIFICALLY MODIFIED BY THESE DRAWINGS OR SPECIFICATIONS. ALL MATERIALS SHALL BE RUS APPROVED. OBTAIN COPIES OF THE RUS BULLETINS AND MAINTAIN COPIES ON THE JOB SITE. ADDITIONALLY, CONSTRUCTION SPECIFICATIONS ARE INCLUDED IN DIVISIONS 26 AND 33 OF THE CONSTRUCTION DOCUMENTS. CONTRACTOR SHALL BE THOROUGHLY FAMILIAR WITH THE CONTRACT DOCUMENTS, RUS CONSTRUCTION UNITS, AND ANSI C2.
- THE EXISTING ELECTRICAL DISTRIBUTION SYSTEM CURRENTLY SERVES CUSTOMERS. SERVICE SHALL BE MAINTAINED AT ALL TIMES TO THE CUSTOMERS EXCEPT WHEN OUTAGES ARE REQUIRED FOR SERVICE CONVERSION OR OTHER CONSTRUCTION RELATED ACTIVITIES. ALL OUTAGES SHALL BE COORDINATED IN ADVANCE WITH NAPASKIAK ELECTRIC UTILITY (OWNER). PRIOR TO COMMENCING WORK ON THE UPGRADE, MEET WITH NAPASKIAK ELECTRIC UTILITY TO DEVELOP AN OUTAGE SCHEDULE THAT WILL KEEP DISRUPTIONS OF POWER TO THE CUSTOMERS TO A MINIMUM. NAPASKIAK ELECTRIC UTILITY SHALL HAVE FINAL AUTHORITY ON WHEN OUTAGES CAN OCCUR.
- UNLESS OTHERWISE INDICATED, THE EXISTING PRIMARY AND SECONDARY DISTRIBUTION SYSTEM, INCLUDING HARDWARE, CONDUCTORS (BOTH PRIMARY AND SECONDARY), TRANSFORMERS, CROSSARMS, INSULATORS, LIGHTS, ANCHOR RODS, GUYS, AND ALL OTHER MATERIAL DIRECTLY RELATED TO THE EXISTING ELECTRICAL DISTRIBUTION SYSTEM BEING TAKEN OUT OF SERVICE SHALL BE REMOVED AFTER COMPLETION OF THE INSTALLATION, ENERGIZATION, AND SERVICE CONVERSIONS TO THE NEW ELECTRICAL DISTRIBUTION SYSTEM. POLES THAT HAVE TELECOM SYSTEM CONDUCTORS OR EQUIPMENT ATTACHED SHALL NOT BE REMOVED.
- ALL EXISTING UTILITIES MAY NOT BE SHOWN. CONTRACTOR SHALL LOCATE ALL UNDERGROUND UTILITIES PRIOR TO DIGGING HOLES FOR POLES AND ANCHORS. COORDINATE WITH THE NAPASKIAK ELECTRIC UTILITY AND THE CITY OF NAPASKIAK TO LOCATE UNDERGROUND UTILITIES.
- THE DRAWINGS ARE DIAGRAMMATIC AND DO NOT NECESSARILY SHOW ALL FEATURES OF THE REQUIRED WORK. PROVIDE ALL EQUIPMENT AND MATERIALS REQUIRED FOR A COMPLETE SYSTEM. VERIFY EXISTING FIELD CONDITIONS PRIOR TO STARTING CONSTRUCTION. IMMEDIATELY CONTACT THE ENGINEER FOR CLARIFICATION OF QUESTIONABLE ITEMS OR APPARENT CONFLICTS.
- ENSURE THAT APPROPRIATE SAFETY MEASURES ARE IMPLEMENTED AND THAT ALL WORKERS ARE AWARE OF THE POTENTIAL HAZARDS FROM ELECTRICAL SHOCK ASSOCIATED WITH WORKING ON OR NEAR AN ENERGIZED MEDIUM VOLTAGE DISTRIBUTION SYSTEM.
- THE SITE PLANS USED WERE DEVELOPED USING A COMBINATION OF AERIAL PHOTOGRAPHY AND SURVEY DATA PROVIDED BY OTHERS. ANY VARIATIONS BETWEEN WHAT IS SHOWN AND THE ACTUAL FIELD CONDITIONS SHALL BE BROUGHT TO THE ATTENTION OF THE ENGINEER.
- SEE CONSTRUCTION SPECIFICATIONS FOR ADDITIONAL INFORMATION.
- THE CONTRACTOR SHALL BE SOLELY RESPONSIBLE FOR COORDINATING HIS WORK WITH EXISTING FACILITY OPERATORS, OTHER CONTRACTORS AND/OR SUBCONTRACTORS WORKING IN THE COMMUNITY, LOCAL UTILITY AND GOVERNMENT ORGANIZATIONS, AND STATE AND FEDERAL AUTHORITIES.
- THE CONTRACTOR SHALL BE SOLELY RESPONSIBLE FOR PROVIDING CONSTRUCTION ACCESS FOR EQUIPMENT AND PERSONNEL AS REQUIRED TO COMPLETE POLE INSTALLATION, POLE HARDWARE AND CONDUCTOR INSTALLATION, AND ALL OTHER PROJECT TASKS. CONTRACTOR SHALL COORDINATION WITH LOCAL ENTITIES AND RESIDENTS, ERECT TEMPORARY STRUCTURES, AND PERFORM TEMPORARY REMOVAL/RELOCATION AND REPLACEMENT OF ALL STRUCTURES, STEAM HOUSES, ETC. AS NECESSARY TO COMPLETE THE WORK. ALL EXISTING STRUCTURES AFFECTED BY THE WORK SHALL BE RETURNED TO THEIR ORIGINAL OR BETTER CONDITION BY THE CONTRACTOR IMMEDIATELY AFTER THE CONTRACTOR'S WORK IN THAT AREA IS COMPLETED. CONTRACTOR SHALL COORDINATE ALL NECESSARY PUBLIC SAFETY ACTIVITIES INCLUDING SIGNAGE, BARRIERS, TRAFFIC CONTROL PLANS, LIGHTING, PUBLIC NOTIFICATIONS, AND OTHER ITEMS DEEMED NECESSARY TO PROTECT THE PUBLIC DURING CONSTRUCTION ACTIVITIES.
- NEW TRANSFORMERS ADD TO THE DISTRIBUTION SYSTEM OR REPLACING EXISTING TRANSFORMERS SHALL BE CONNECTED TO PHASES IN A WAY THAT BALANCES THE DISTRIBUTION SYSTEM. DURING CONSTRUCTION LOAD IMBALANCE SHOULD BE KEPT TO A MINIMUM AND SHALL NOT EXCEED 10%.

TELECOM SYSTEM GENERAL NOTES

- THE EXISTING ELECTRICAL DISTRIBUTION SYSTEM POLES ARE SHARED WITH THE TELECOM SYSTEM, UNITED UTILITY, INC. CONTRACTOR SHALL NOT DISRUPT THE EXISTING TELECOM SYSTEM WITHOUT THE CONSENT OF THE TELECOM COMPANY. ANY PART OF THE EXISTING TELECOM SYSTEM DAMAGED BY THE CONTRACTOR SHALL BE REPAIRED OR REPLACED AS DIRECTED BY THE TELCOM COMPANY.
- UNLESS OTHERWISE NOTED ON THE DRAWINGS, THE EXISTING TELECOM SYSTEM SHALL REMAIN AS IS. WHERE POLES WITH TELECOM CONDUCTORS OR EQUIPMENT ARE REPLACED, TELECOM CONDUCTORS OR EQUIPMENT SHALL BE REATTACHED TO THE NEW POLE.
- POLES TAKEN OUT OF SERVICE THAT HAVE TELECOM CONDUCTORS OR EQUIPMENT ATTACHED SHALL NOT BE REMOVED.

DISTRIBUTION UPGRADE SCOPE OF WORK

- THE SCOPE OF WORK FOR UPGRADING THE EXISTING ELECTRICAL DISTRIBUTION SYSTEM IN NAPASKIAK, ALASKA, IS AS FOLLOWS:
 - REPLACE EXISTING TRANSFORMERS NOTED. UPSIZE TRANSFORMERS WHERE REQUIRED TO ACCOMMODATE THE NUMBER OF SERVICES BEING SERVED.
 - INSTALL NEW TRANSFORMERS TO REDUCE EXCESSIVELY LONG SECONDARY RUNS.
 - RESET LEANING POLES, RE-TENSION GUYS, INSTALL NEW GUYS AND ANCHORS WHERE NEEDED AND REPLACE POLES TO RAISE LOW SECONDARY CONDUCTORS OR WHERE POLE CONDITION REQUIRE REPLACEMENT.
 - EXTEND PRIMARY DISTRIBUTION WHERE REQUIRED.
- THE LIMIT OF CONSTRUCTION FOR NEW SERVICE DROPS IS THE CONNECTION TO THE EXISTING SERVICE MAST OF THE HOUSE BEING SERVED. THE CONTRACTOR SHALL REMOVE THE EXISTING SECONDARY SERVICE DROP CONDUCTORS AS INDICATED ON THE DRAWINGS AND INSTALL NEW SERVICE CONDUCTORS AS INDICATED ON THE DRAWINGS. THE EXISTING METER BASE OR SERVICE MAST WILL NOT BE THE RESPONSIBILITY OF THE CONTRACTOR EXCEPT FOR PROVIDING DEADEND ASSEMBLIES AND MAKING THE CONNECTION TO THE EXISTING SERVICE ENTRANCE CONDUCTORS AT THE SERVICE MAST. IF THE EXISTING SERVICE MAST IS NOT IN SATISFACTORY CONDITION TO SUPPORT THE NEW SERVICE, THE CONTRACTOR SHALL NOTIFY NAPASKIAK ELECTRIC UTILITY FOR RESOLUTION. THE CONTRACTOR SHALL PROVIDED NOTIFICATION FAR ENOUGH IN ADVANCE TO ALLOW NAPASKIAK ELECTRIC UTILITY TIME TO REPAIR OR REPLACE THE SERVICE MAST.

DISTRIBUTION SYSTEM INSTALLATION NOTES

- SEE SPECIFICATIONS FOR EQUIPMENT REQUIREMENTS AND COMPLETE REQUIREMENTS FOR ELECTRICAL DISTRIBUTION INSTALLATION.
- WHERE RUS UNITS ARE REFERENCED, MATERIAL ITEMS MAY NOT BE LISTED IN THE MATERIAL LIST. CONTRACTOR SHALL REFER TO RUS UNIT REFERENCED TO DETERMINE WHAT MATERIAL MUST BE PROVIDED.
- ANY MODIFIED RUS CONSTRUCTION UNIT OR ANY NEW CONSTRUCTION UNITS ARE INCLUDED IN THE DETAIL SHEETS OF THE DRAWINGS. ANY STANDARD RUS CONSTRUCTION UNITS REFERENCED ON THE DRAWINGS OR STAKING SHEETS SHALL BE OBTAINED BY THE CONTRACTOR. FAILURE TO HAVE THE CORRECT RUS CONSTRUCTION UNIT WILL NOT BE ACCEPTABLE AS AN EXCUSE FOR AN INCORRECT INSTALLATION.
- ALL HARDWARE SHALL BE ALUMINUM, HOT DIP GALVANIZED, OR STAINLESS STEEL. ALL SMALL FASTENERS SHALL BE STAINLESS STEEL.
- PRIMARY OVERHEAD CONDUCTOR SHALL #2 ACSR.
- ALL INSULATOR TIES SHALL BE PREFORMED TYPE. ALL NEUTRAL AND PHASE CONDUCTOR DEADENDS SHALL BE PREFORMED TYPE.
- ALL PHASE CONDUCTOR DEADENDS SHALL BE MADE USING A SHOE TYPE CLAMP.
- NOT ALL GROUNDS ARE SHOWN. GROUND NEUTRAL WIRE AND TRANSFORMER GROUNDED BUSHING ALONG WITH TRANSFORMER CASE. ROUTE #4 AWG SOLID COPPER GROUND CONDUCTOR DOWN POLE GROUND. ATTACH COPPER GROUND CONDUCTOR TO POLE WITH COPPER PLATED STAPLES. ALL CONNECTIONS TO CABLE SHALL BE MADE WITH COPPER COMPRESSION LUGS. NO ALUMINUM CONNECTORS OR CABLES SHALL BE USED, EXCEPT AT CONNECTIONS TO ACSR. AT ACSR CONNECTIONS, USE CONNECTORS RATED FOR COPPER/ALUMINUM.
- ALL QUANTITIES MAY NOT BE SHOWN. DETERMINE QUANTITIES OF ALL NECESSARY MATERIAL AND EQUIPMENT.
- ARMOR RODS SHALL BE PROVIDED FOR ALL NEW ACSR CONDUCTORS. ARMOR RODS SHALL BE INSTALLED AT EACH INSULATOR BUT WILL NOT BE REQUIRED AT PRIMARY DEAD-END ASSEMBLIES.
- INSULATORS SHALL BE SELECTED TO PROPERLY ACCOMMODATE THE ARMOR ROD INSTALLED ON THE CONDUCTOR.

DISTRIBUTION SYSTEM TEMPORARY INSTALLATION NOTES

- THE UPGRADES TO THE EXISTING ELECTRICAL DISTRIBUTION SYSTEM WILL REQUIRE TEMPORARY INSTALLATIONS TO MINIMIZE OUTAGES AND MAINTAIN POWER TO THE CUSTOMERS DURING THE CONSTRUCTION OF THE UPGRADES. AS INDICATED, ALL OUTAGES SHALL BE COORDINATED WITH AND APPROVED BY THE NAPASKIAK ELECTRIC UTILITY. ACCEPTABLE METHODS WILL BE AS FOLLOWS:
 - CONTRACTOR MAY INSTALL TEMPORARY INSULATED MEDIUM VOLTAGE CONDUCTORS AND ROUTE THE CONDUCTORS ON THE GROUND. IF THIS METHOD IS CHOSEN, THE AT-GRADE CONDUCTORS SHALL BE PROTECTED FROM VANDALISM AND DAMAGE AND PROVISIONS SHALL BE MADE FOR THE SUPPORT OF THE EXISTING POLES DURING THE INSTALLATION OF THE UPGRADES.
 - OTHER METHODS MAY BE PROPOSED BY THE CONTRACTOR AS APPLICABLE TO ALLOW INSTALLATION OF THE UPGRADES WHILE THE EXISTING SYSTEM REMAINS IN SERVICE.
- IN ALL CASES, THE CONTRACTOR IS RESPONSIBLE FOR DETERMINING THE BEST METHOD OF MAINTAINING POWER TO CUSTOMERS WHILE THE UPGRADES ARE BEING INSTALLED. THE CONTRACTOR SHALL PROVIDE ALL MATERIAL REQUIRED FOR TEMPORARY INSTALLATIONS.
- AT ALL TIMES AND IN ALL LOCATIONS, TEMPORARY INSTALLATIONS SHALL MEET THE NEC SAFETY REQUIREMENTS. ANY TEMPORARY INSTALLATION THAT IS ROUTED ON THE GROUND SHALL BE CLEARLY IDENTIFIED AND, IF REQUIRED, PROVISIONS SHALL BE INSTALLED FOR PERSONNEL AND VEHICLE CROSSING.

ABBREVIATIONS

(E)	EXISTING
A	AMPERE
AC	ALTERNATING CURRENT
AIC	AMPERES INTERRUPTING CAPACITY
AWG	AMERICA WIRE GAGE
BCu	BARE COPPER
C	CONDUCTOR
C	CONDUIT
CB	CIRCUIT BREAKER
CIC	CABLE IN CONDUIT
CT	CURRENT TRANSFORMER
DIA	DIAMETER
DISC	DISCONNECT
DWG	DRAWING
EA	EACH
EL	ELEVATION
F	FAHRENHEIT
FT	FEET
FU	FUSE
G,GND	GROUND
H	HOT CONDUCTOR
HDPE	HIGH DENSITY POLYETHYLENE
HPS	HIGH PRESSURE SODIUM
HZ	HERTZ
JCN	JACKETED CONCENTRIC NEUTRAL
KVA	KILOVOLT-AMPERES
KW	KILOWATT
LFMC	LIQUID-TIGHT FLEXIBLE METAL CONDUIT
LFNC	LIQUID-TIGHT FLEXIBLE NON-METALLIC CONDUIT
LTG	LIGHTING
M	METER
MAX	MAXIMUM
MCM	THOUSAND CIRCULAR MILLS
MFR	MANUFACTURER
MIN	MINIMUM
N	NEUTRAL CONDUCTOR
NTS	NOT TO SCALE
P	POLE
PED	SECONDARY SERVICE PEDESTAL
PDS	PRIMARY DISTRIBUTION SWITCHGEAR
PH	PHASE
PVC	POLYVINYL CHLORIDE
R	SHUNT REACTOR
RMC	RIGID METAL CONDUIT, GALVANIZED
TR	TRANSFORMER
TYP	TYPICAL
UD	UNDERGROUND DISTRIBUTION
U/G	UNDERGROUND
UON	UNLESS OTHERWISE NOTED
USGS	UNITED STATES GEOLOGICAL SURVEY
V	VOLTS
VA	VOLT-AMPERES
VAC	VOLTS-ALTERNATING CURRENT
W	WATTS
WP	WEATHERPROOF
XFMR	TRANSFORMER
XLP	CROSS LINKED POLYETHYLENE



ALL WORK ON SHEETS E10.0 THROUGH E12.4 IS INCLUDED IN THE ON SITE CONTRACT.

PROVIDE DISTRIBUTION UPGRADES UNDER ADDITIVE ALTERNATE #3 AND #4 AS SHOWN ON THE FOLLOWING SHEETS.

LEGEND

-----	EXISTING SINGLE PHASE OVERHEAD PRIMARY	-----	NEW SINGLE PHASE OVERHEAD PRIMARY
-#/#-	EXISTING 2-PHASE OVERHEAD PRIMARY	-#/#-	NEW 2-PHASE OVERHEAD PRIMARY
-#/#/#-	EXISTING 3-PHASE OVERHEAD PRIMARY	-#/#/#-	NEW 3-PHASE OVERHEAD PRIMARY
-----	EXISTING UNDERGROUND	-----	NEW UNDERGROUND
-----	EXISTING SECONDARY*	-----	NEW SECONDARY*
●	EXISTING ELECTRICAL POLE	●	NEW ELECTRICAL POLE
●	EXISTING STUB POLE	●	NEW STUB POLE
⌂ _{XX}	EXISTING TRANSFORMER XX=SIZE	⌂ _{XX}	NEW TRANSFORMER XX=SIZE
→	EXISTING GUY	→	NEW GUY
☀	EXISTING LIGHT	☀	NEW LIGHT



(NOTE: STANDARD LEGEND NOT ALL SYMBOLS MAY BE USED.)
*SINGLE PHASE UNLESS OTHERWISE NOTED

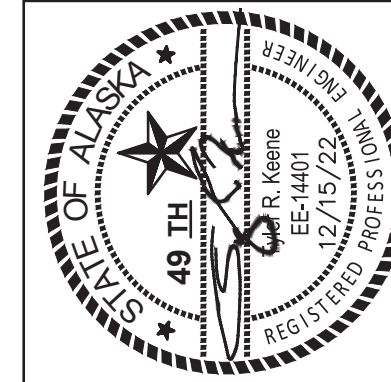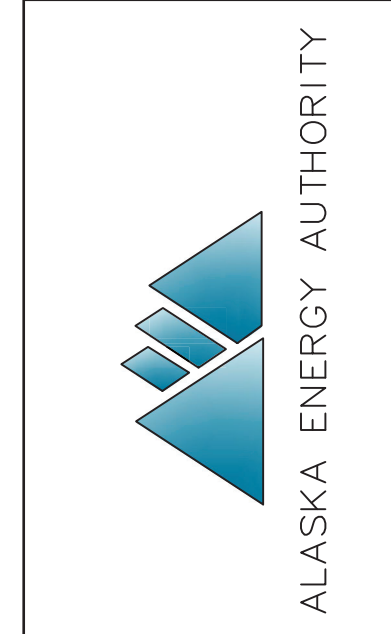


NAPASKIAK POWER SYSTEM UPGRADE
DISTRIBUTION LEGEND, ABBREVIATIONS, SPECIFICATIONS & NOTES
NAPASKIAK, ALASKA

NO.	REVISION	ISSUED FOR CONSTRUCTION	BY	DATE
0			TRK	12/15/22

Plot Date	12/9/22
Designed	TRK
Drawn	TRK
Approved	KH

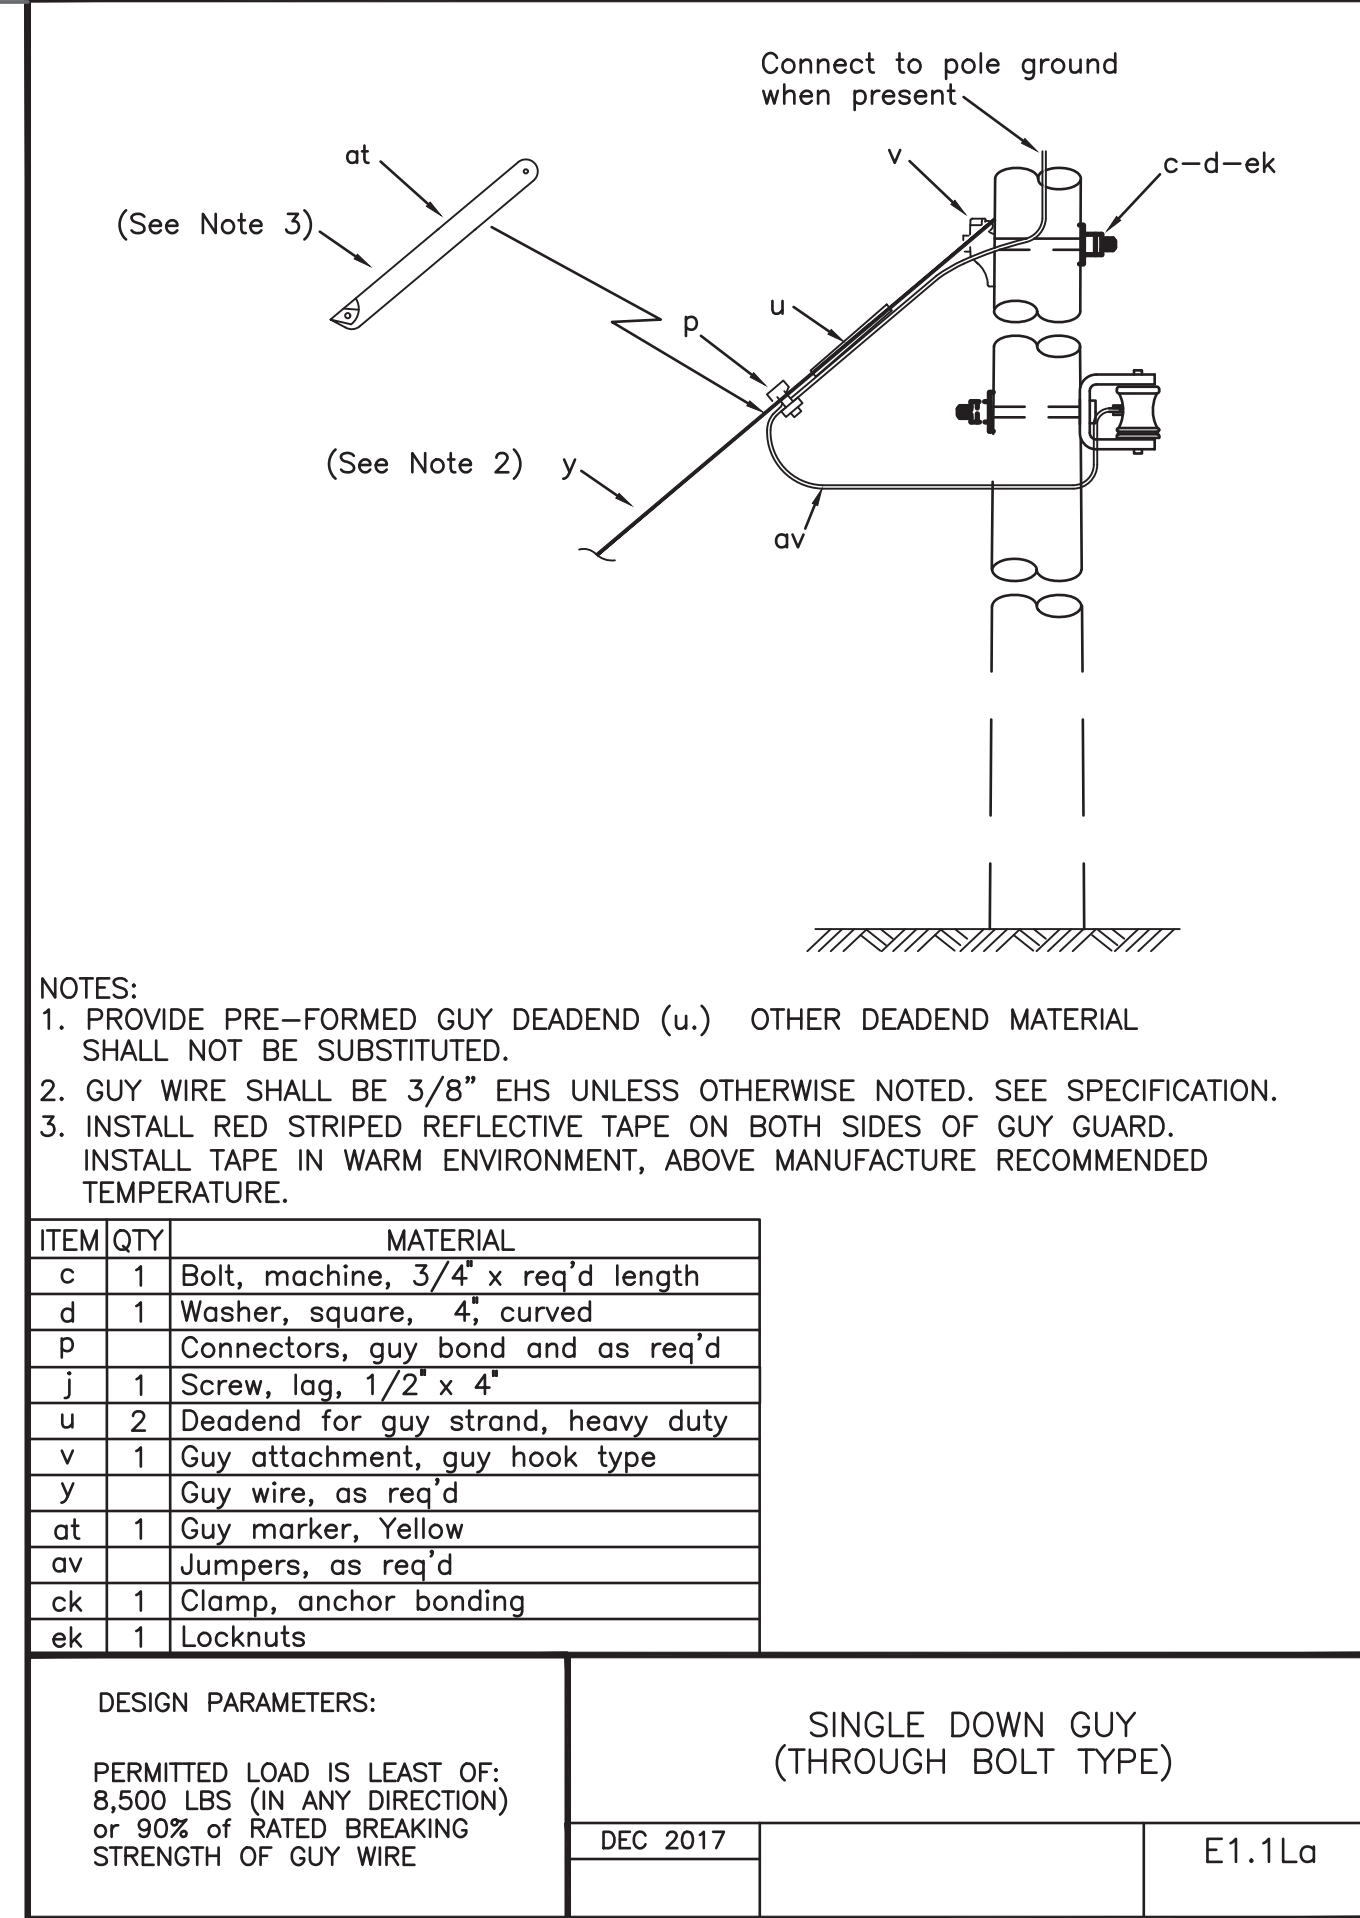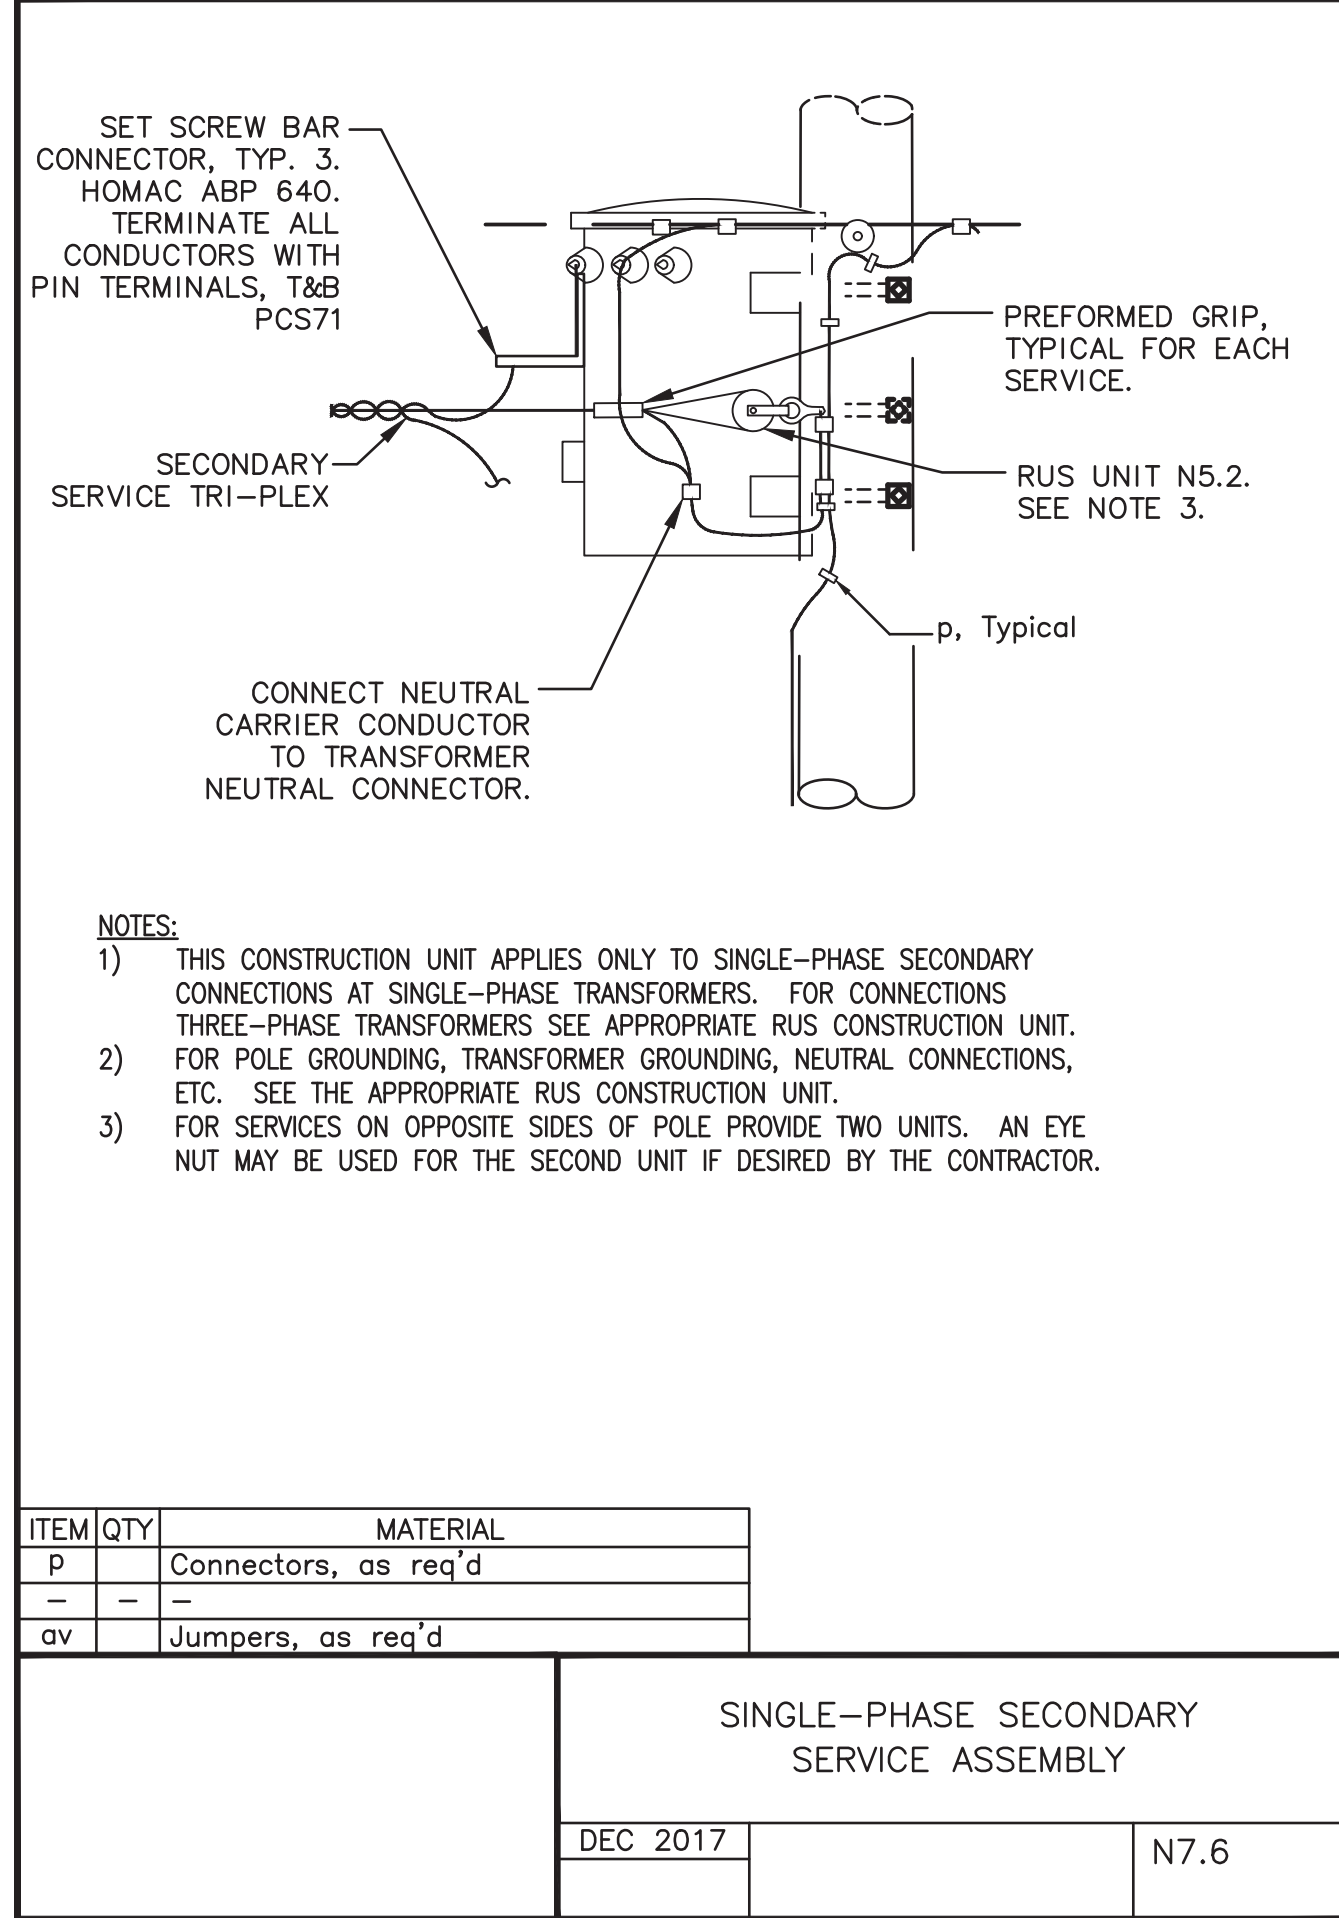

TRANSFORMER FUSE LINK SCHEDULE	
TRANSFORMER SIZE	FUSE LINK SIZE AND TYPE
10KVA	1.4 Amp, SloFast
15KVA	2.1 Amp, SloFast
25 KVA	3.5 Amp, SloFast
37.5 KVA	5.2 Amp, SloFast
75 KVA	10.4 Amp, SloFast
100 KVA	14 Amp, SloFast

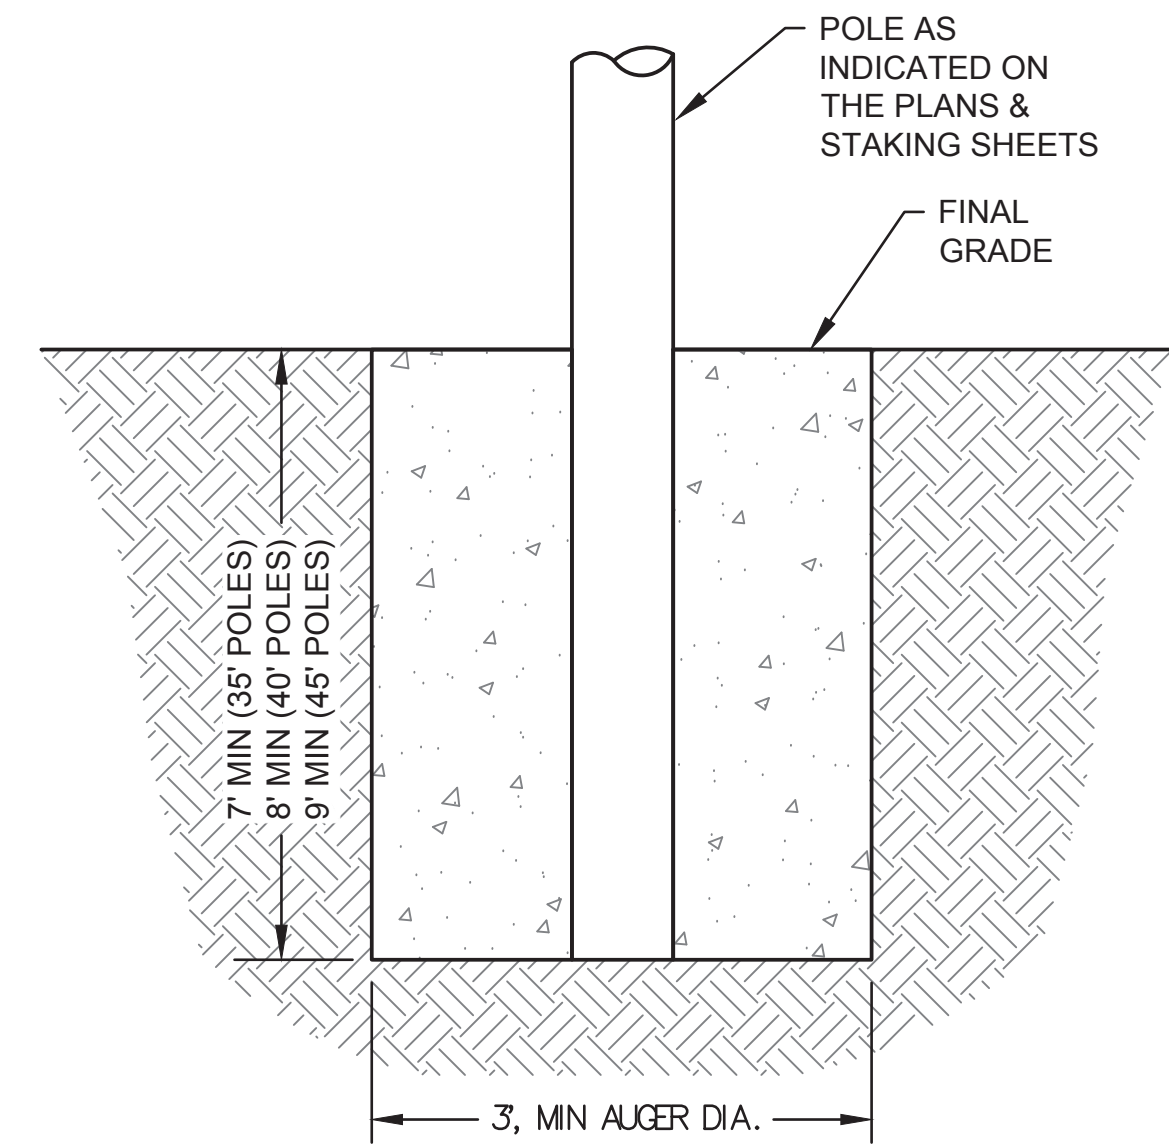

1 TYPICAL POLE INSTALLATION
E10.1 Scale: NTS



NAPASKIAK POWER SYSTEM UPGRADE



DISTRIBUTION DETAILS

NAPASKIAK, ALASKA

NO.	REVISION	BY	DATE
0	ISSUED FOR CONSTRUCTION	TRK	12/15/22

Plot Date	12/9/22
Designed	TRK
Drawn	TRK
Approved	KH

Sheet No. **E10.1**

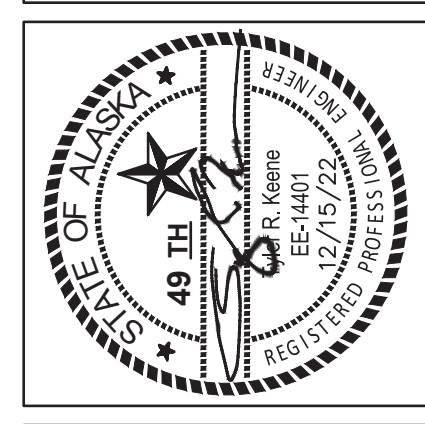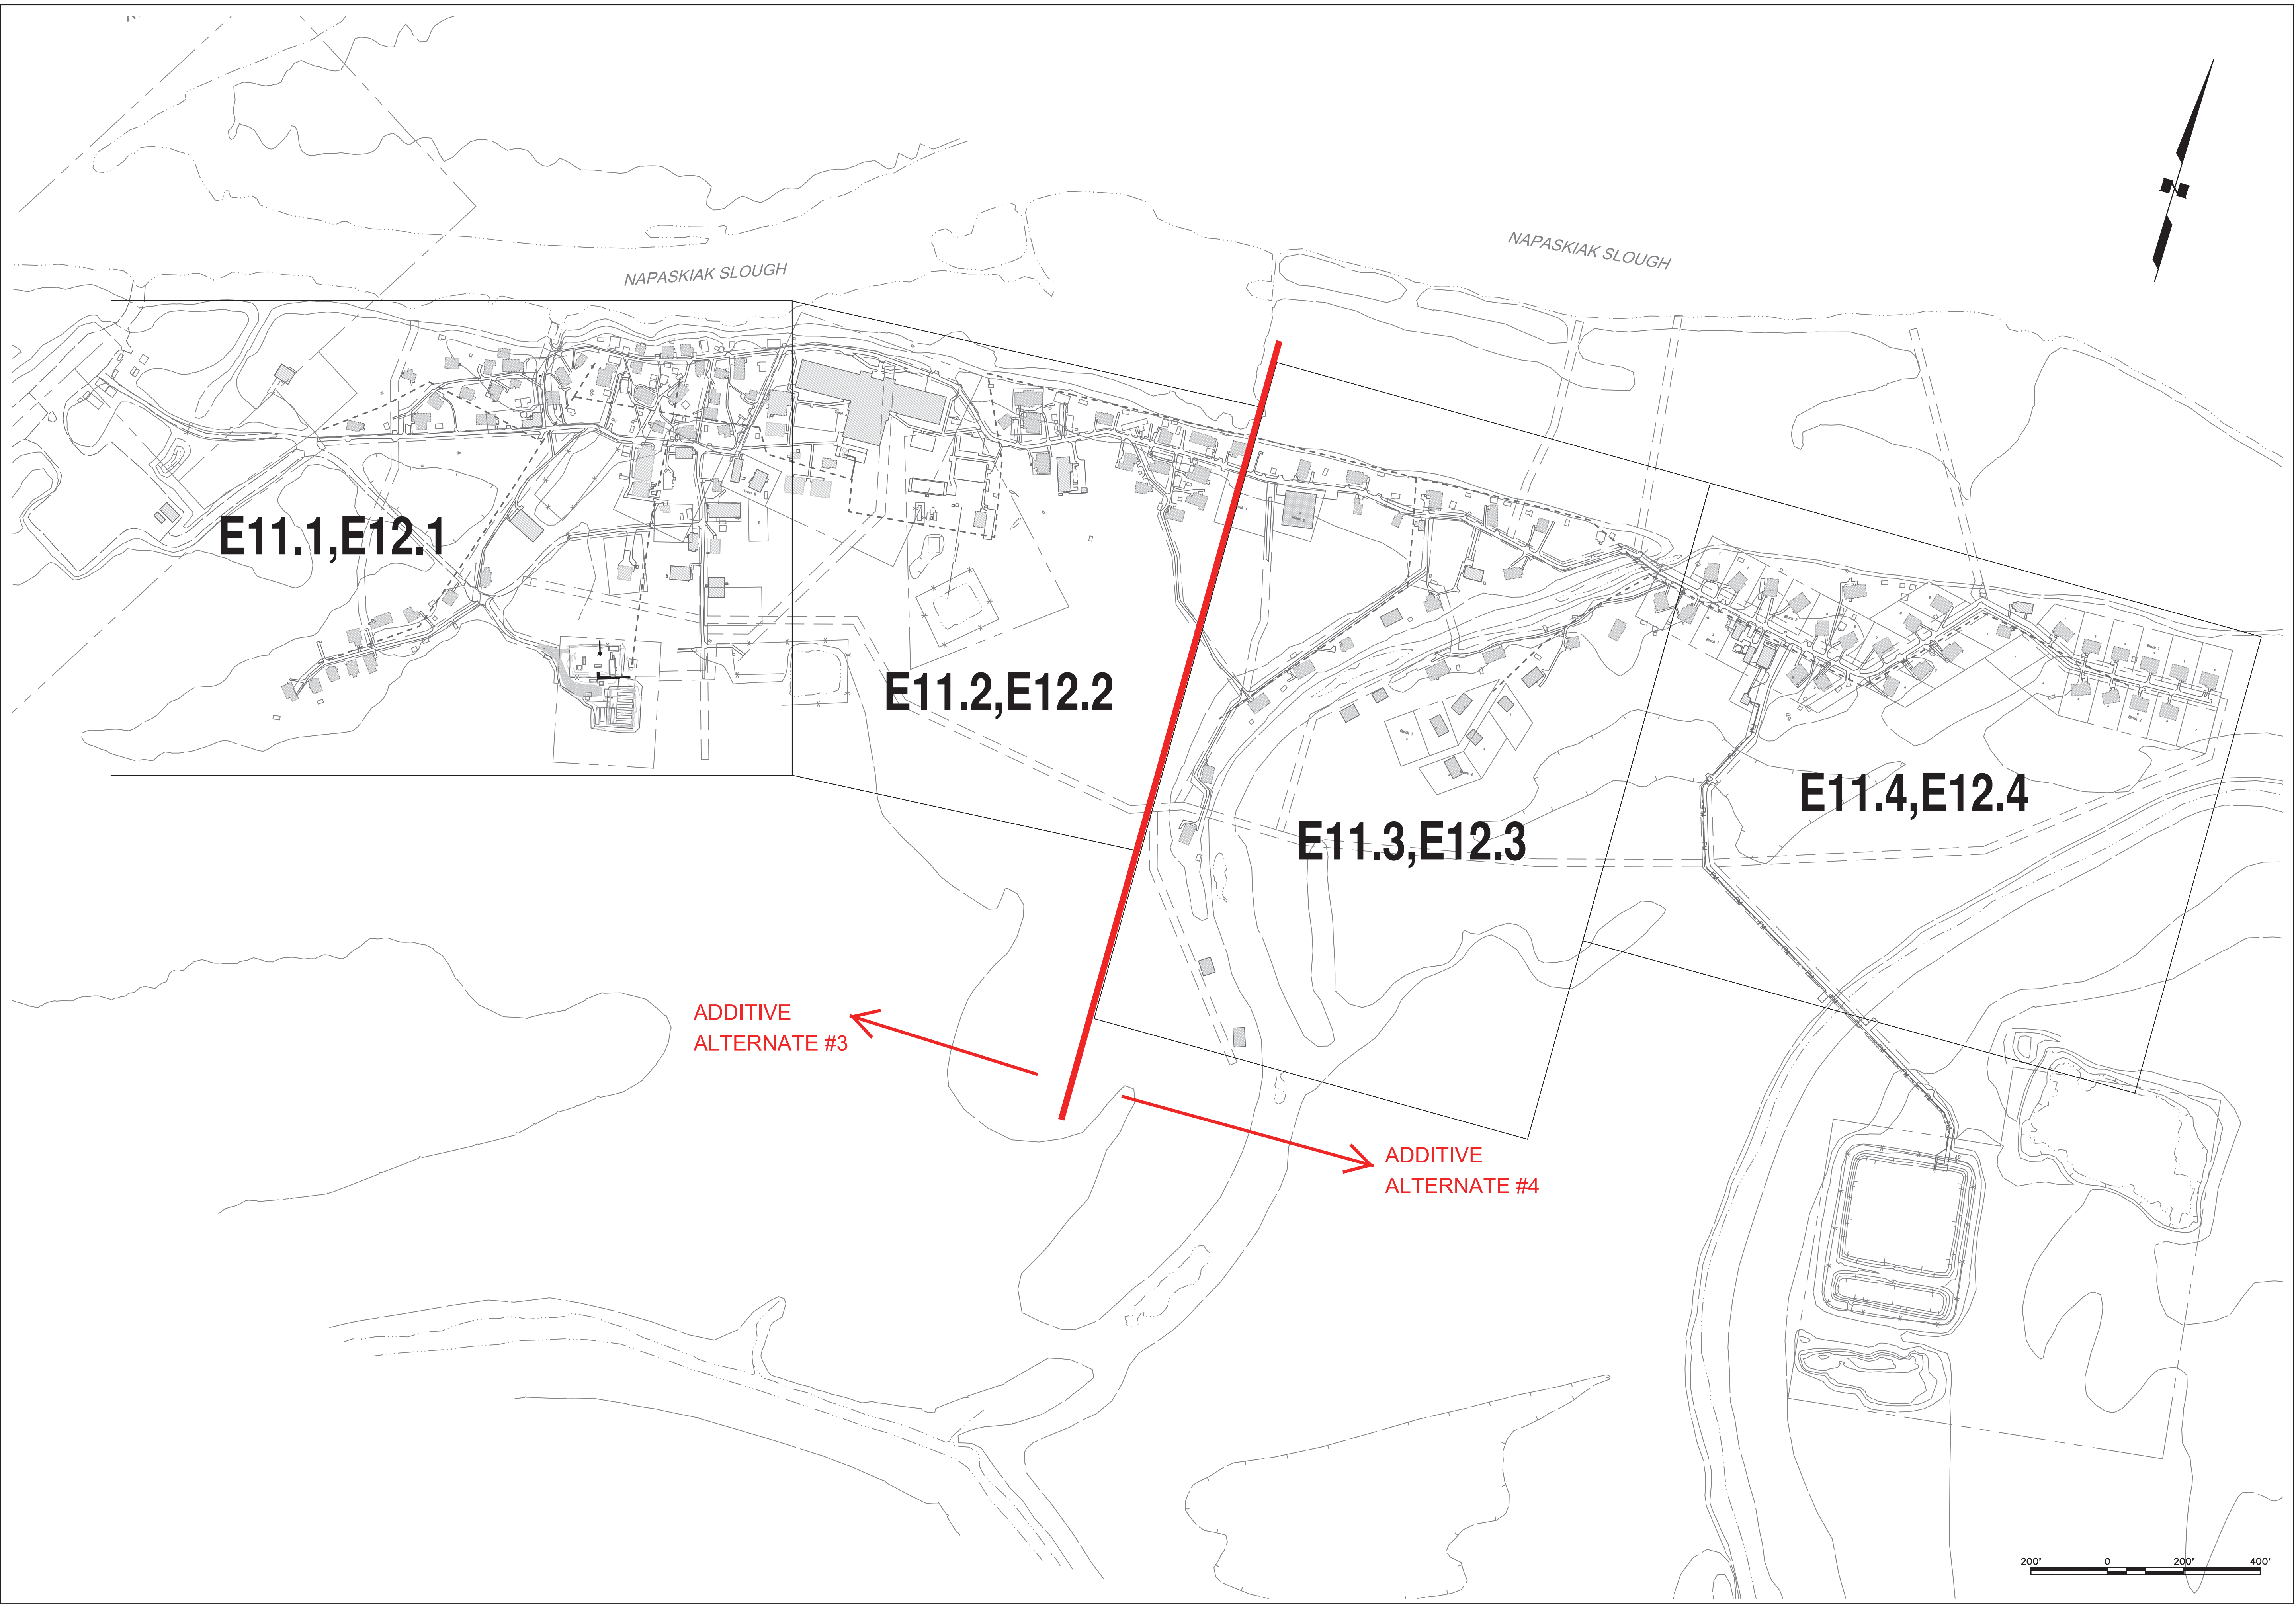


NAPASKIAK POWER SYSTEM UPGRADE
OVERALL DISTRIBUTION SITE PLAN
 NAPASKIAK, ALASKA

NO.	REVISION	BY	DATE
0	ISSUED FOR CONSTRUCTION	TRK	12/15/22

Plot Date: 12/9/22
 Designed: TRK
 Drawn: TRK
 Approved: KH

Sheet No. **E11.0**

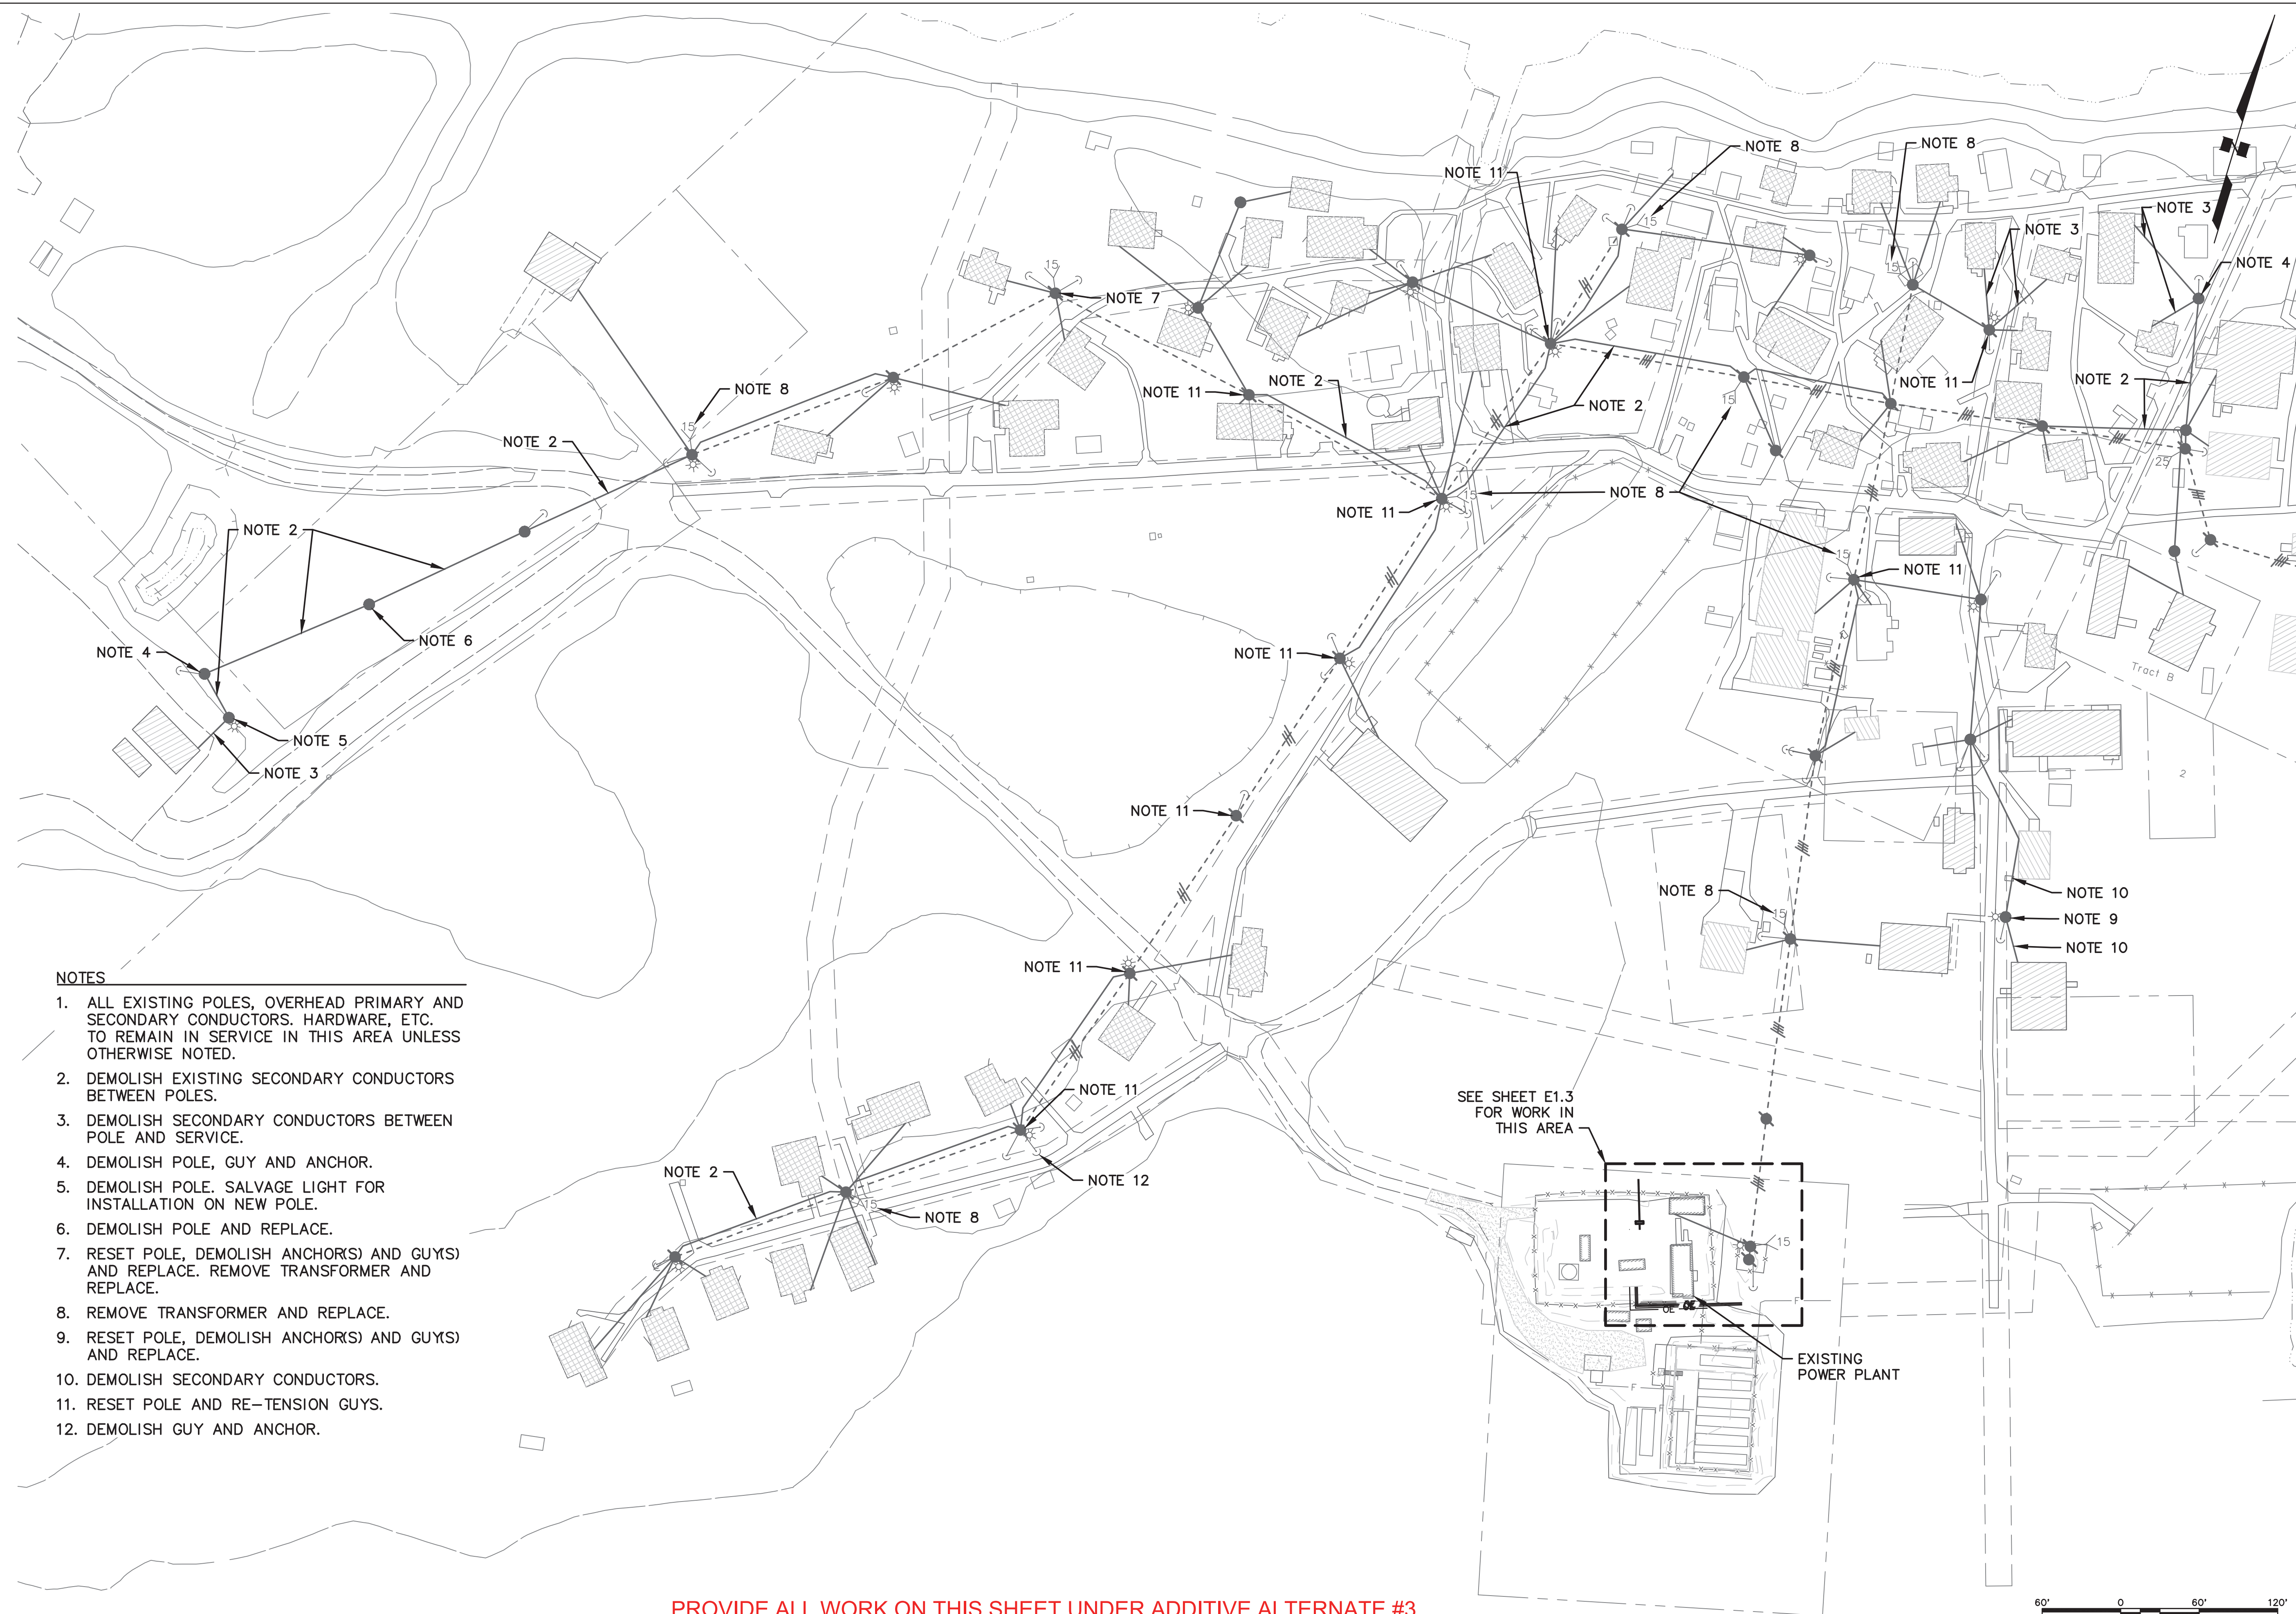


NOTES

1. ALL EXISTING POLES, OVERHEAD PRIMARY AND SECONDARY CONDUCTORS, HARDWARE, ETC. TO REMAIN IN SERVICE IN THIS AREA UNLESS OTHERWISE NOTED.
2. DEMOLISH EXISTING SECONDARY CONDUCTORS BETWEEN POLES.
3. DEMOLISH SECONDARY CONDUCTORS BETWEEN POLE AND SERVICE.
4. DEMOLISH POLE, GUY AND ANCHOR.
5. DEMOLISH POLE. SALVAGE LIGHT FOR INSTALLATION ON NEW POLE.
6. DEMOLISH POLE AND REPLACE.
7. RESET POLE, DEMOLISH ANCHOR(S) AND GUY(S) AND REPLACE. REMOVE TRANSFORMER AND REPLACE.
8. REMOVE TRANSFORMER AND REPLACE.
9. RESET POLE, DEMOLISH ANCHOR(S) AND GUY(S) AND REPLACE.
10. DEMOLISH SECONDARY CONDUCTORS.
11. RESET POLE AND RE-TENSION GUYS.
12. DEMOLISH GUY AND ANCHOR.


PROVIDE ALL WORK ON THIS SHEET UNDER ADDITIVE ALTERNATE #3




MATCH LINE E11.2




ALASKA ENERGY AUTHORITY





CRW ENGINEERING GROUP LLC
PHONE: (907) 562-3222



Gray Sussel Engineering, Inc.
PHONE: (907) 348-0100


NAPASKIAK POWER SYSTEM UPGRADE
DISTRIBUTION DEMOLITION PLAN
 (1 of 4)

NAPASKIAK, ALASKA

NO.	REVISION	BY	DATE
0	ISSUED FOR CONSTRUCTION	TRK	12/15/22



Plot Date: 12/9/22	Designed: TRK	Drawn: TRK	Approved: KH
--------------------	---------------	------------	--------------

Sheet No. **E11.1**

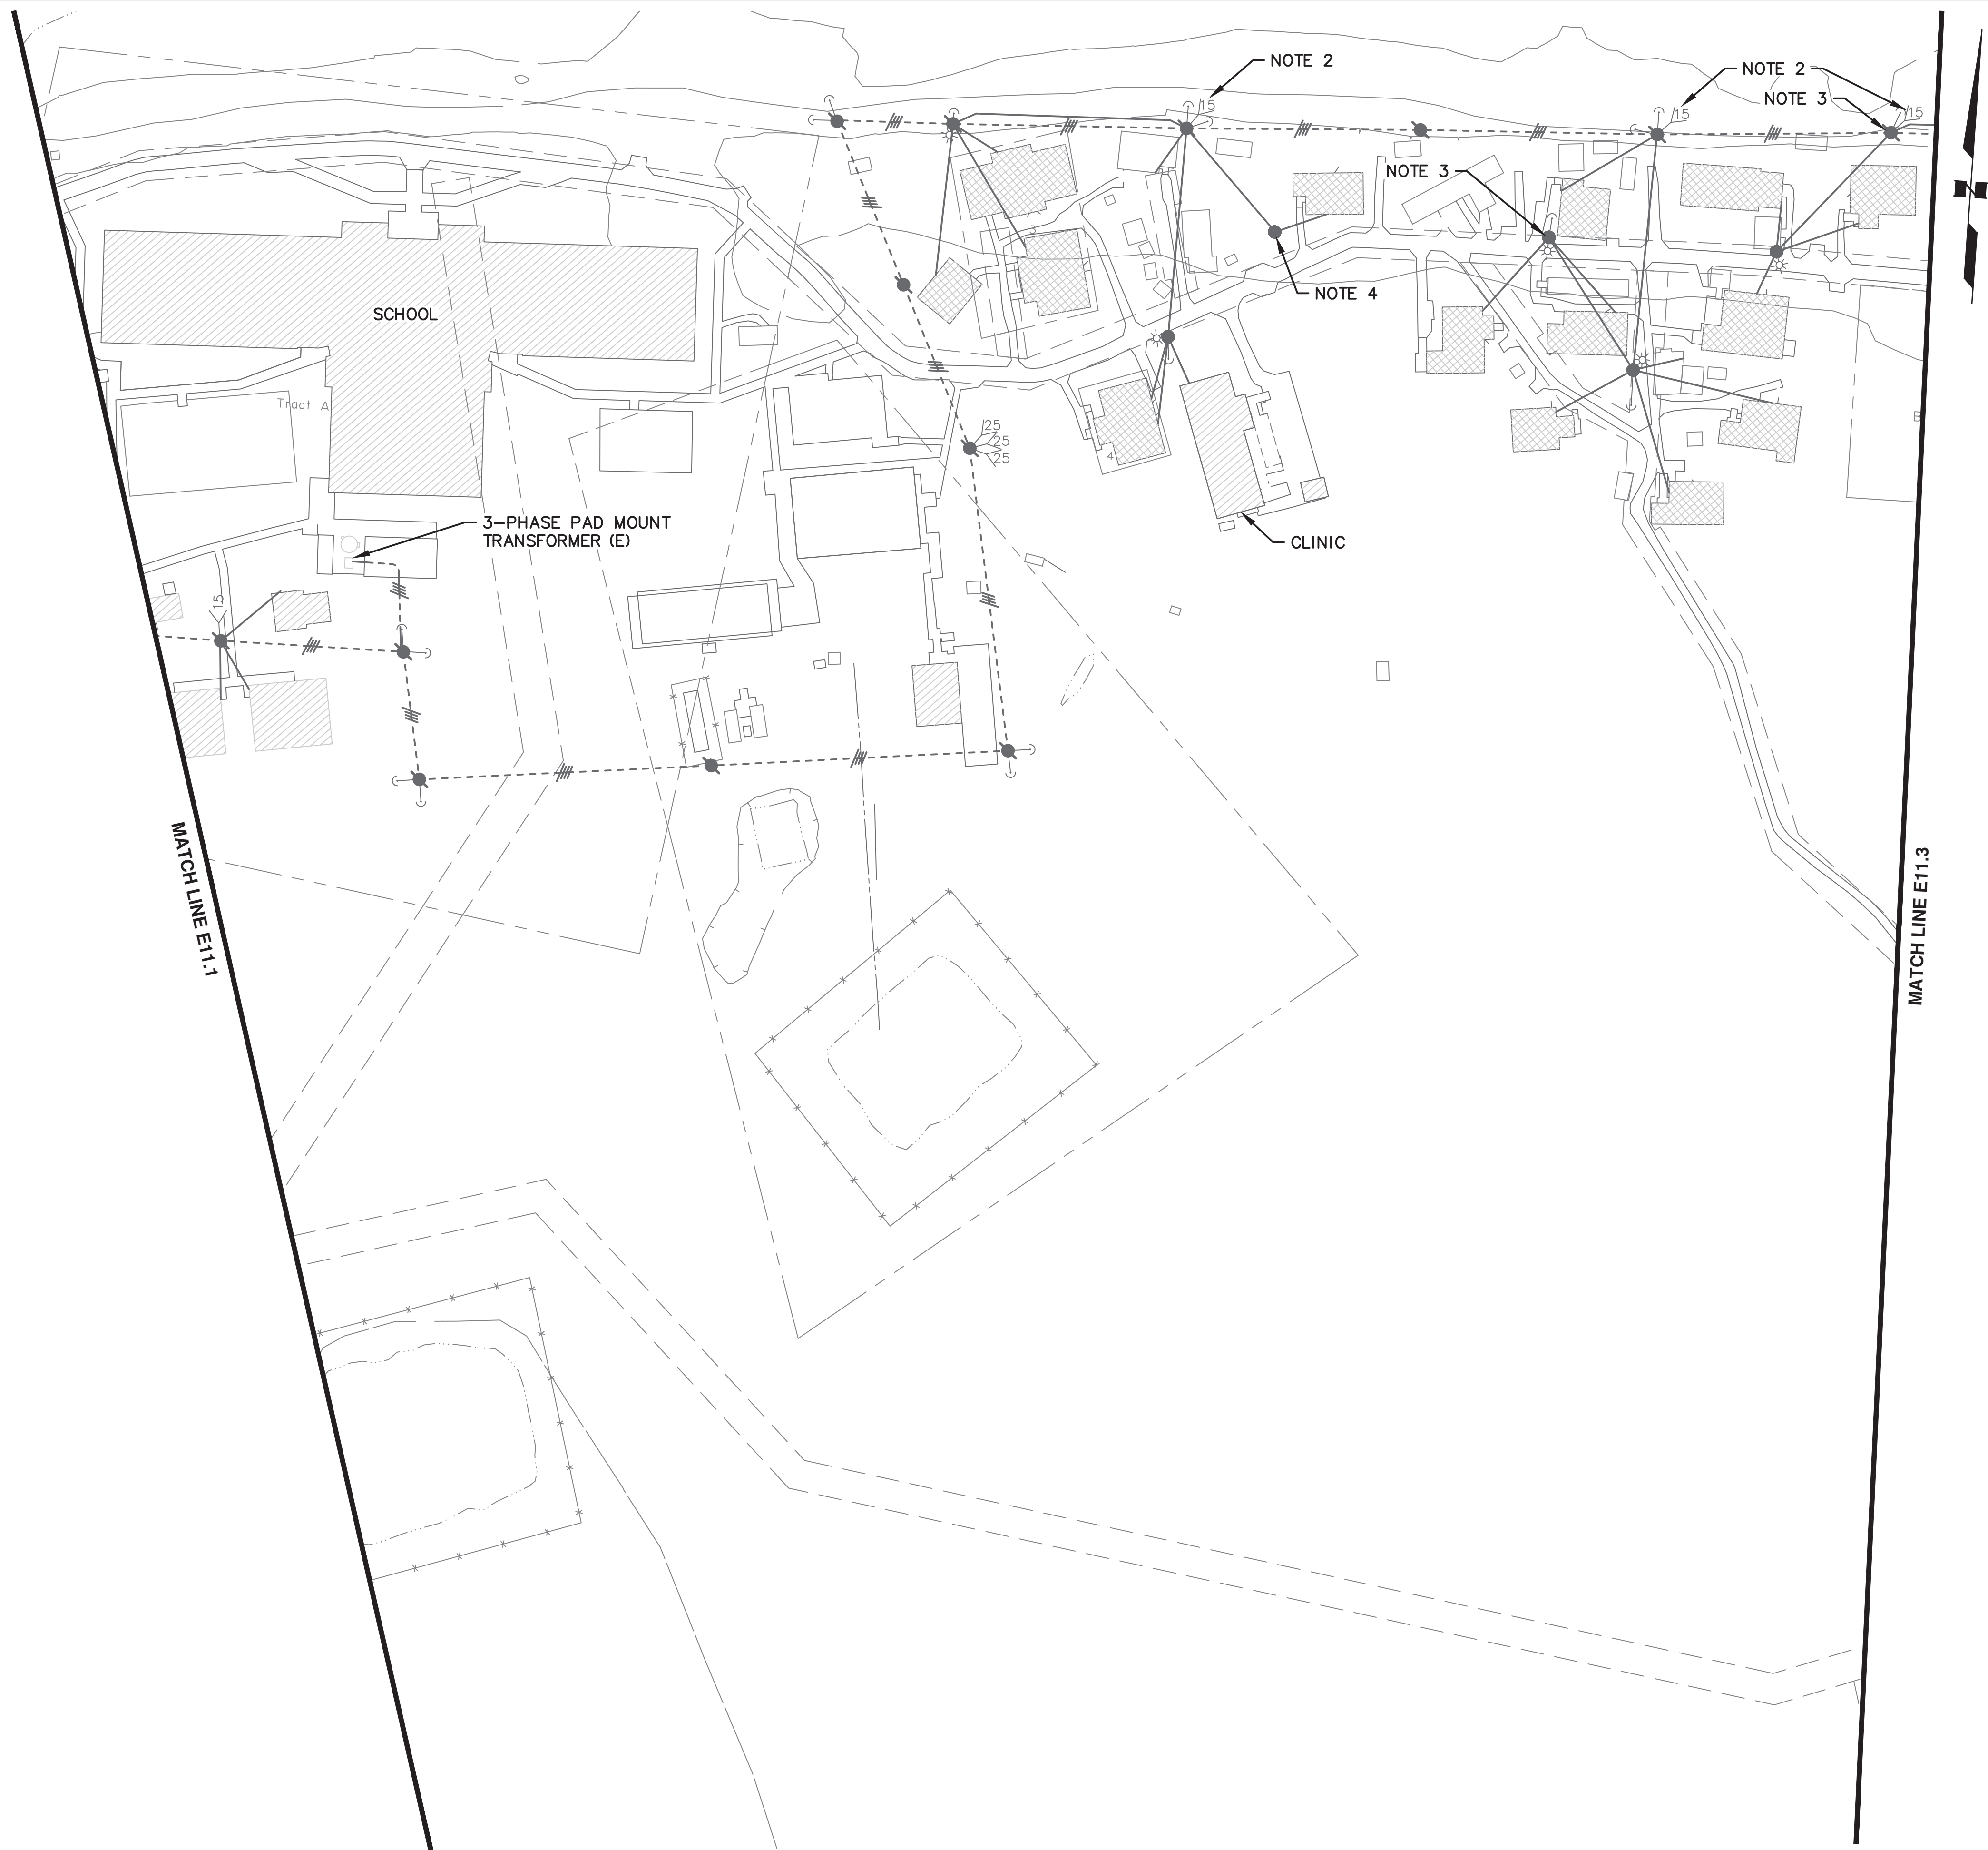

- NOTES**
1. ALL EXISTING POLES, OVERHEAD PRIMARY AND SECONDARY CONDUCTORS, HARDWARE, ETC. TO REMAIN IN SERVICE IN THIS AREA UNLESS OTHERWISE NOTED.
 2. REMOVE TRANSFORMER AND REPLACE.
 3. RESET POLE, DEMOLISH ANCHOR(S) AND GUYS AND REPLACE.
 4. RESET POLE AND ADD GUY AND ANCHOR.

PROVIDE ALL WORK ON THIS SHEET UNDER ADDITIVE ALTERNATE #3

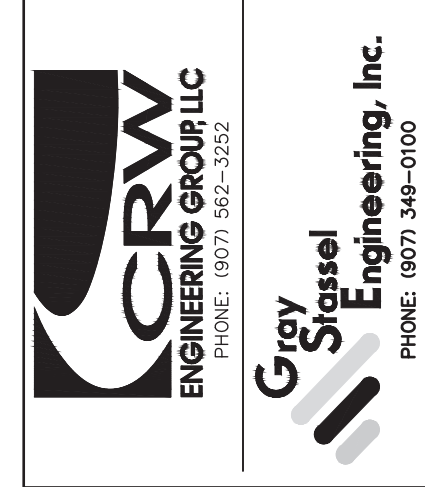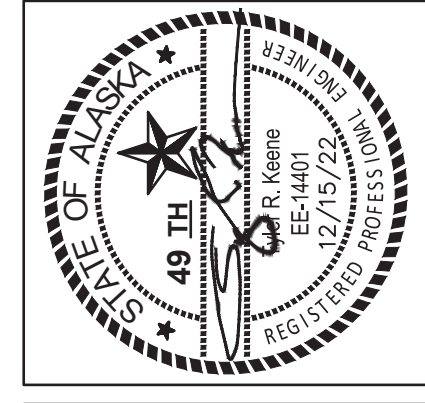


NAPASKIAK POWER SYSTEM UPGRADE
DISTRIBUTION DEMOLITION PLAN
 (2 of 4)
 NAPASKIAK, ALASKA

NO.	REVISION	BY	DATE
0	ISSUED FOR CONSTRUCTION	TRK	12/15/22

Plot Date: 12/9/22
 Designed: TRK
 Drawn: TRK
 Approved: KH

Sheet No. **E11.2**

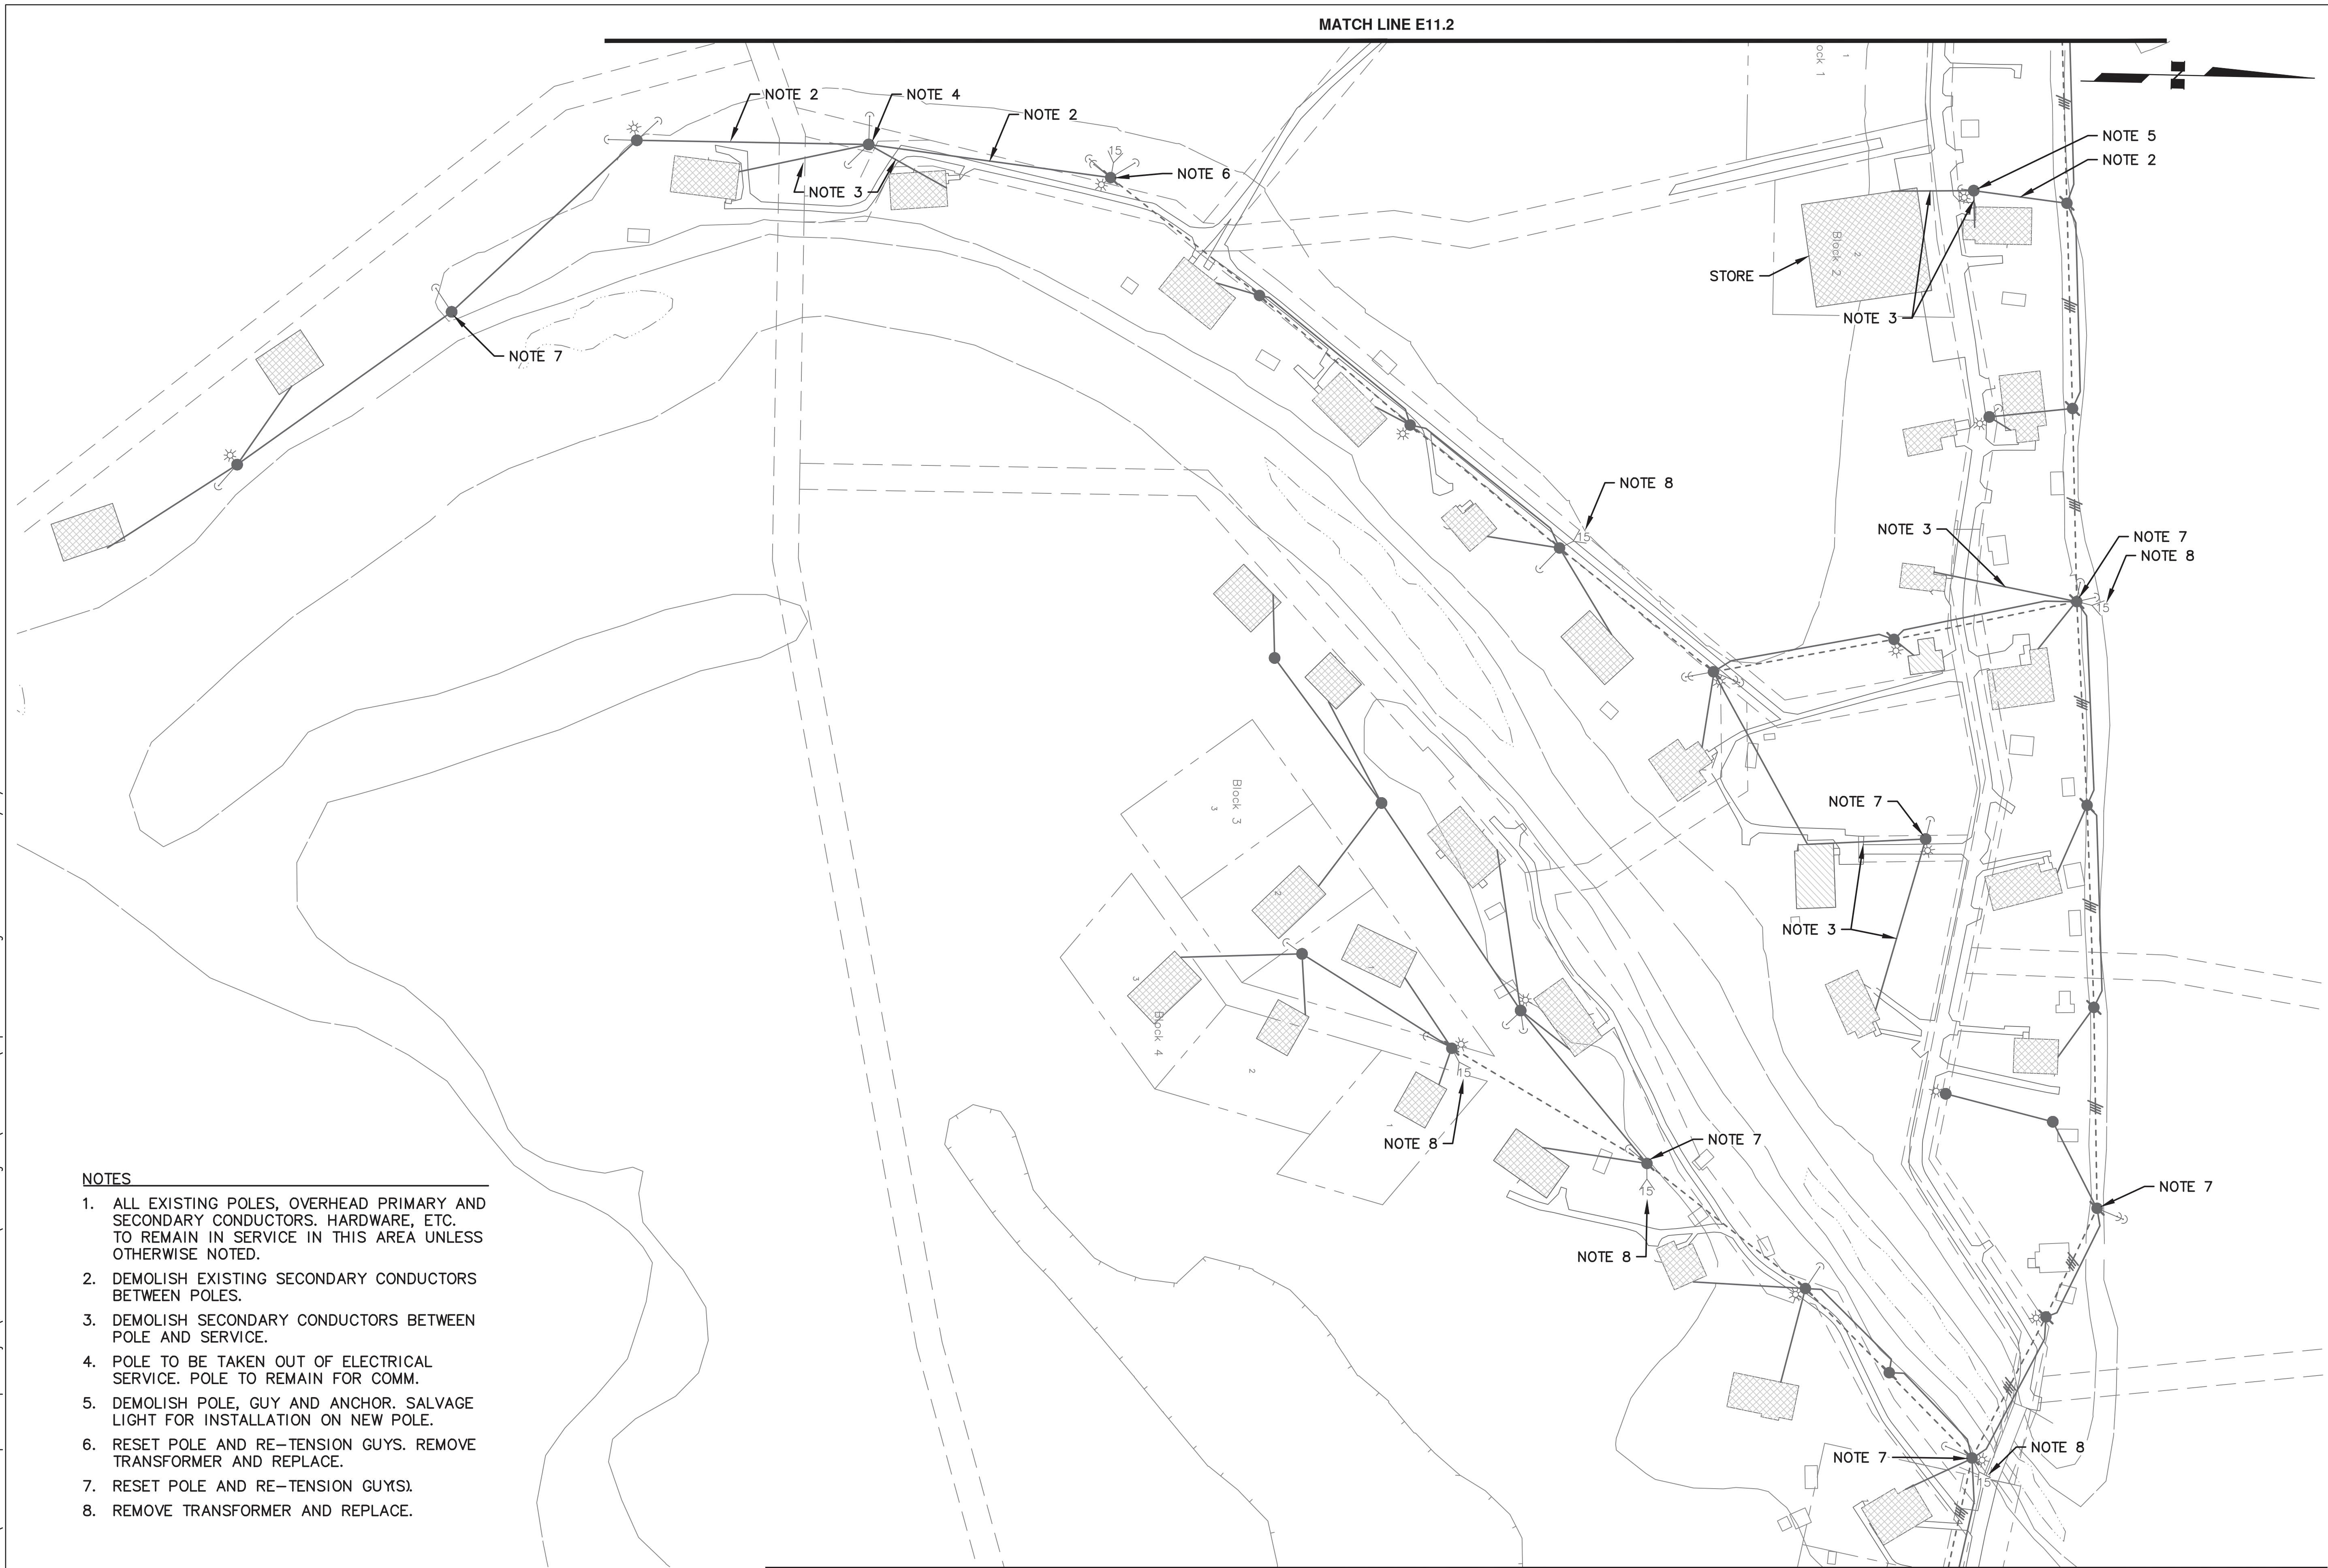


NOTES

1. ALL EXISTING POLES, OVERHEAD PRIMARY AND SECONDARY CONDUCTORS, HARDWARE, ETC. TO REMAIN IN SERVICE IN THIS AREA UNLESS OTHERWISE NOTED.
2. DEMOLISH EXISTING SECONDARY CONDUCTORS BETWEEN POLES.
3. DEMOLISH SECONDARY CONDUCTORS BETWEEN POLE AND SERVICE.
4. POLE TO BE TAKEN OUT OF ELECTRICAL SERVICE. POLE TO REMAIN FOR COMM.
5. DEMOLISH POLE, GUY AND ANCHOR. SALVAGE LIGHT FOR INSTALLATION ON NEW POLE.
6. RESET POLE AND RE-TENSION GUYS. REMOVE TRANSFORMER AND REPLACE.
7. RESET POLE AND RE-TENSION GUYS).
8. REMOVE TRANSFORMER AND REPLACE.

PROVIDE ALL WORK ON THIS SHEET UNDER ADDITIVE ALTERNATE #4

MATCH LINE E11.4

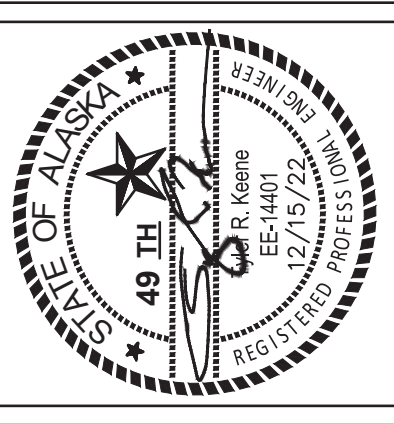

NAPASKIAK POWER SYSTEM UPGRADE
 DISTRIBUTION DEMOLITION PLAN
 (3 of 4)
 NAPASKIAK, ALASKA

NO.	REVISION	BY	DATE
0	ISSUED FOR CONSTRUCTION	TRK	12/15/22

Plot Date: 12/9/22
 Designed: TRK
 Drawn: TRK
 Approved: KH

Sheet No. E11.3


MATCH LINE E11.3



NOTES

1. ALL EXISTING POLES, OVERHEAD PRIMARY AND SECONDARY CONDUCTORS, HARDWARE, ETC. TO REMAIN IN SERVICE IN THIS AREA UNLESS OTHERWISE NOTED.
2. DEMOLISH SECONDARY CONDUCTORS BETWEEN POLES.
3. RESET POLE AND ADD GUY AND ANCHOR.
4. REMOVE TRANSFORMER AND REPLACE.

PROVIDE ALL WORK ON THIS SHEET UNDER ADDITIVE ALTERNATE #4

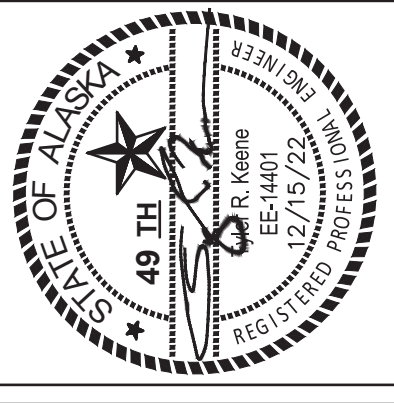


**NAPASKIAK POWER SYSTEM UPGRADE
DISTRIBUTION DEMOLITION PLAN
(4 of 4)**
NAPASKIAK, ALASKA


NO.	REVISION	BY	DATE
0	ISSUED FOR CONSTRUCTION	TRK	12/15/22

Plot Date	12/9/22
Designed	TRK
Drawn	TRK
Approved	KH

Sheet No. **E11.4**

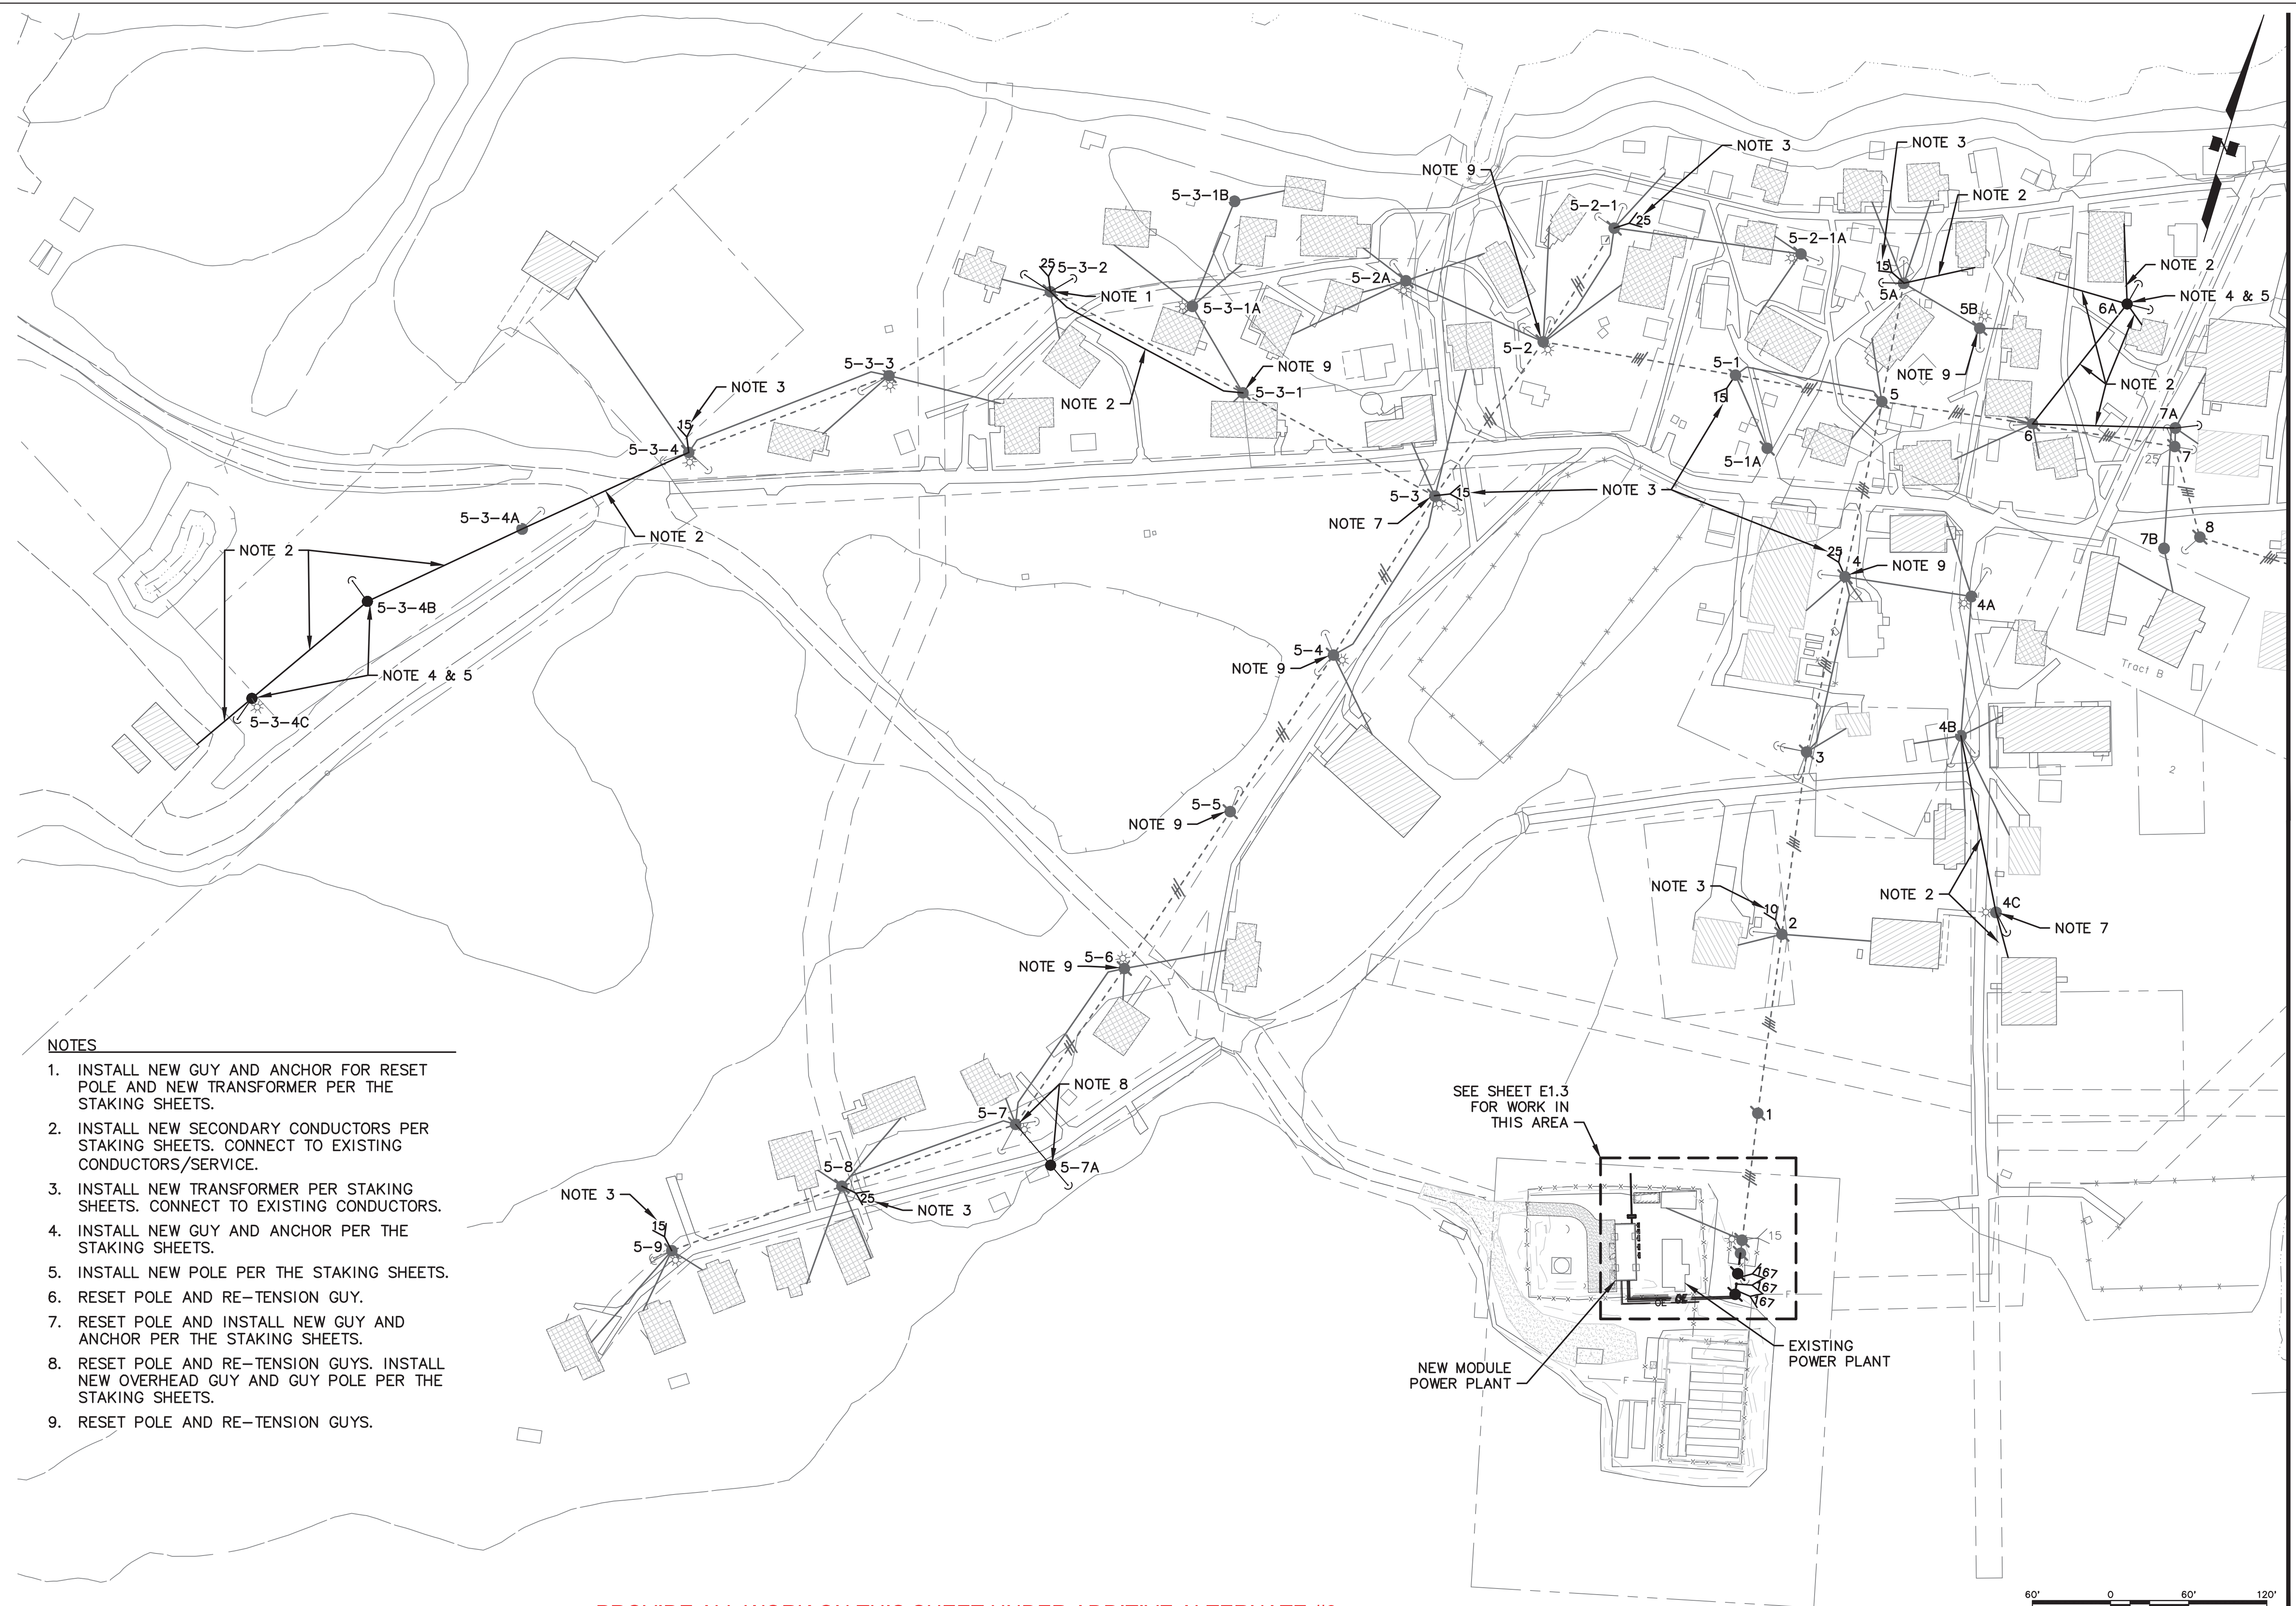

PROVIDE ALL WORK ON THIS SHEET UNDER ADDITIVE ALTERNATE #3

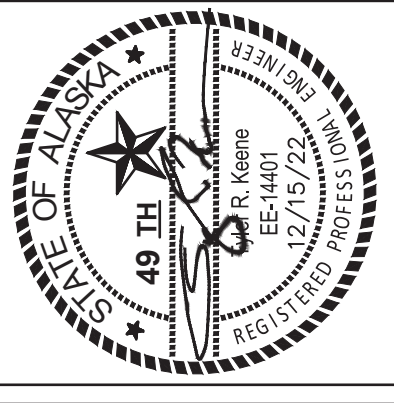

NAPASKIAK POWER SYSTEM UPGRADE
 DISTRIBUTION PLAN
 (1 of 4)
 NAPASKIAK, ALASKA

NO.	REVISION	BY	DATE
0	ISSUED FOR CONSTRUCTION	TRK	12/15/22


Plot Date: 12/9/22
 Designed: TRK
 Drawn: TRK
 Approved: KH

Sheet No. **E12.1**



- NOTES**
1. INSTALL NEW GUY AND ANCHOR PER THE STAKING SHEETS FOR RESET POLE.
 2. INSTALL NEW TRANSFORMER PER STAKING SHEETS. CONNECT TO EXISTING CONDUCTORS.

PROVIDE ALL WORK ON THIS SHEET UNDER ADDITIVE ALTERNATE #3

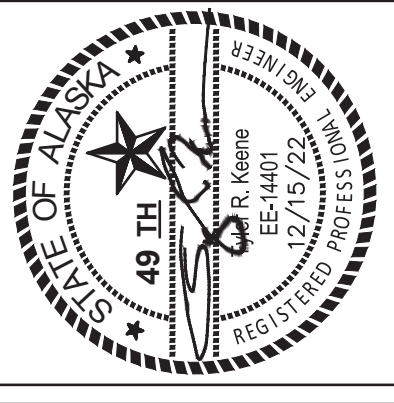

**NAPASKIAK POWER SYSTEM UPGRADE
DISTRIBUTION PLAN
(2 of 4)**

NAPASKIAK, ALASKA

NO.	REVISION	BY	DATE
0	ISSUED FOR CONSTRUCTION	TRK	12/15/22


Plot Date 12/9/22
Designed TRK
Drawn TRK
Approved KH

Sheet No. **E12.2**

MATCH LINE E12.3



- NOTES**
1. INSTALL NEW GUY AND ANCHOR FOR RESET POLE. SEE STAKING SHEETS.
 2. INSTALL NEW SECONDARY CONDUCTORS PER STAKING SHEETS. CONNECT TO EXISTING CONDUCTORS.
 3. INSTALL NEW TRANSFORMER PER STAKING SHEETS. CONNECT TO EXISTING CONDUCTORS.
 4. INSTALL NEW GUY AND ANCHOR PER THE STAKING SHEETS.

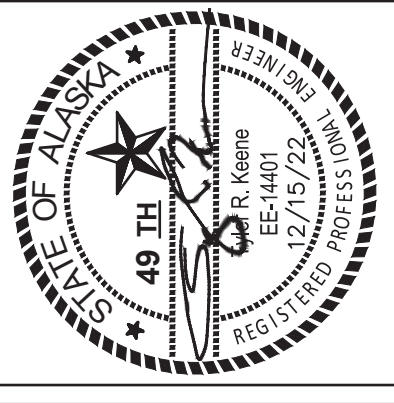

NAPASKIAK POWER SYSTEM UPGRADE
 DISTRIBUTION PLAN
 (4 of 4)
 NAPASKIAK, ALASKA

NO.	REVISION	BY	DATE
0	ISSUED FOR CONSTRUCTION	TRK	12/15/22

Plot Date 12/9/22
 Designed TRK
 Drawn TRK
 Approved KH

Sheet No. **E12.4**

PROVIDE ALL WORK ON THIS SHEET UNDER ADDITIVE ALTERNATE #4



NAPASKIAK RPSU DISTRIBUTION UPGRADES

STAKING SHEETS

**ISSUED FOR CONSTRUCTION
DECEMBER 2022**

CRW ENGINEERING GROUP, LLC
3940 ARCTIC BLVD, SUITE 300
ANCHORAGE, ALASKA 99503

ALL WORK ON THE STAKING SHEETS IS
INCLUDED IN THE ON SITE CONTRACT.

PROVIDE DISTRIBUTION UPGRADES FROM
LOCATION 2 THROUGH LOCATION 21
UNDER ADDITIVE ALTERNATE #3 AND
FROM LOCATION 22 THROUGH 38 UNDER
ADDITIVE ALTERNATE #4 AS SHOWN ON
THE DRAWINGS.

REV. NO.	DATE	DESCRIPTION	BY	CRW ENGINEERING GROUP, LLC 3940 ARCTIC BLVD, SUITE 300 ANCHORAGE, ALASKA 99503 (907) 562-3252	DESIGNER	DATE	NAPASKIAK RPSU DISTRIBUTION UPGRADES
0	12/2/22	ISSUED FOR CONSTRUCTION	TRK		TRK	December 2, 2022	
					CHECKER	DATE	
					TRK	December 2, 2022	
					DIST. ENG.	DATE	
					TRK	December 2, 2022	

STAKING SHEETS SHOW ONLY LOCATION WHERE NEW WORK IS REQUIRED.

LOCATION NUMBER	STATION	LINE ANGLE (DEG)	CONDUCTOR			POLE HEIGHT	POLE CLASS	PRIMARY ASSEMBLY		GUYS		ANCHORS		XFMRs		SECONDARY CONDUCTOR				SECONDARY SERVICE		MISCELLANEOUS CONSTRUCTION UNITS		RIGHT OF WAY	REMARKS/COMMENTS/NOTES		
			No.	SIZE/TYPE	Back Span			No.	Units	No.	Units	No.	Units	No.	Units	SERVICE		BACKFEED		No.	Units	No.	Units				
																No.	SIZE/TYPE	Back Span	No.							SIZE/TYPE	
2														1	G1.4-10 120/240V 1-PHASE	2	EXISTING							1	H1.1		EXISTING POLE. REPLACE XFMR. PROVIDE NEW #2 ACSR JUMPERS. CONNECT CONDUCTORS TO NEW XFMR.
4														1	G1.4-25 120/240V 1-PHASE	2	EXISTING							1	H1.1		EXISTING POLE. RESET POLE AND RE-TENSION GUY. REPLACE XFMR. PROVIDE #2 ACSR JUMPERS. CONNECT CONDUCTORS TO NEW XFMR.
4B																2	EXISTING					1	J3.1				EXISTING POLE. CONNECT NEW TO EXISTING SECONDARY CONNECT NEW TO EXISTING SECONDARY
4C										1	E1.1La	1	F3.10			1	#4 TRIPLEX	140		1	#4 TRIPLEX	2	J3.1				EXISTING POLE. RESET POLE. INSTALL NEW GUY AND ANCHOR.
5A										1	E1.1La	1	F3.10	1	G1.4-15 120/240V 1-PHASE	2	EXISTING							1	H1.1		EXISTING POLE. REPLACE XFMR. PROVIDE NEW #2 ACSR JUMPERS. INSTALL NEW GUY AND ANCHOR. CONNECT CONDUCTORS TO NEW XFMR.
5B																1	EXISTING										EXISTING POLE. RESET POLE AND RE-TENSION GUY.
5-1														1	G1.4-15 120/240V 1-PHASE									1	H1.1		EXISTING POLE. REPLACE XFMR. PROVIDE NEW #2 ACSR JUMPERS. CONNECT CONDUCTORS TO NEW XFMR.
5-2																											EXISTING POLE. RESET POLE AND RE-TENSION GUY.
5-2-1														1	G1.4-25 120/240V 1-PHASE	1	EXISTING							1	H1.1		EXISTING POLE. REPLACE XFMR. PROVIDE NEW #2 ACSR JUMPERS. CONNECT CONDUCTORS TO NEW XFMR.
5-3														1	G1.4-15 120/240V 1-PHASE	2	EXISTING							1	H1.1		EXISTING POLE. RESET POLE AND RE-TENSION GUYS. REPLACE XFMR. PROVIDE #2 ACSR JUMPERS. CONNECT CONDUCTORS TO NEW XFMR.

LOCATION NUMBER	STATION	LINE ANGLE (DEG)	CONDUCTOR			POLE		PRIMARY ASSEMBLY		GUYS		ANCHORS		XFMRs		SECONDARY CONDUCTOR				SECONDARY SERVICE		MISCELLANEOUS CONSTRUCTION UNITS		RIGHT OF WAY	REMARKS/COMMENTS/NOTES	
			No.	SIZE/TYPE	Back Span	HEIGHT	CLASS	No.	Units	No.	Units	No.	Units	SERVICE		BACKFEED		No.	Units	No.	Units					
														No.	SIZE/TYPE	Back Span	No.					SIZE/TYPE				
5-3-1															1	EXISTING							1	H1.1		EXISTING POLE. RESET POLE. CONNECT NEW TO EXISTING SECONDARY
5-3-2									2	E1.1La	2	F3.10	1	G1.4-25 120/240V 1-PHASE	2	EXISTING	175	1	#1/0 TRIPLEX	3	J3.1	1	H1.1		EXISTING POLE. RESET POLE, REMOVE GUYS/ANCHORS. INSTALL NEW GUYS AND ANCHORS. REPLACE XFMR. PROVIDE #2 ACSR JUMPERS. CONNECT CONDUCTORS TO NEW XFMR.	
5-3-4													1	G1.4-15 120/240V 1-PHASE	1	EXISTING				1	J3.1	1	H1.1		EXISTING POLE. REPLACE XFMR. PROVIDE NEW #2 ACSR JUMPERS. CONNECT CONDUCTORS TO NEW XFMR.	
5-3-4A																	141	1	#1/0 TRIPLEX	2	J3.1				EXISTING POLE.	
5-3-4B						35	4		1	E1.1La	1	F3.10					132	1	#1/0 TRIPLEX	2	J3.1				NEW POLE	
5-3-4C						35	4		1	E1.1La	1	F3.10			1	#4 TRIPLEX	116	1	#1/0 TRIPLEX	2	J3.1				NEW POLE INSTALL SALVAGED LIGHT ON NEW POLE	
5-4															1	EXISTING									EXISTING POLE. RESET POLE AND RE-TENSION GUYS.	
5-5																									EXISTING POLE. RESET POLE AND RE-TENSION GUY.	
5-6															2	EXISTING									EXISTING POLE. RESET POLE AND RE-TENSION GUY.	
5-7															1	EXISTING									EXISTING POLE. RESET POLE AND RE-TENSION GUYS. REMOVE (1) GUY/ANCHOR PER PLANS. CONNECT NEW OVERHEAD GUY.	
5-7A						40	4		1	E1.1La	1	F3.10											1	E1.4L		NEW POLE INSTALL OVERHEAD GUY
5-8													1	G1.4-25 120/240V 1-PHASE	4	EXISTING							1	H1.1		EXISTING POLE. REPLACE XFMR. PROVIDE NEW #2 ACSR JUMPERS. CONNECT CONDUCTORS TO NEW XFMR.

LOCATION NUMBER	STATION	LINE ANGLE (DEG)	CONDUCTOR			POLE		PRIMARY ASSEMBLY		GUYS		ANCHORS		XFMRs		SECONDARY CONDUCTOR				SECONDARY SERVICE		MISCELLANEOUS CONSTRUCTION UNITS		RIGHT OF WAY	REMARKS/COMMENTS/NOTES	
			No.	SIZE/TYPE	Back Span	HEIGHT	CLASS	No.	Units	No.	Units	No.	Units	SERVICE		BACKFEED		No.	Units	No.	Units					
														No.	SIZE/TYPE	Back Span	No.					SIZE/TYPE				
5-9													1	G1.4-15 120/240V 1-PHASE	3	EXISTING							1	H1.1		EXISTING POLE. REPLACE XFMR. PROVIDE NEW #2 ACSR JUMPERS. CONNECT CONDUCTORS TO NEW XFMR.
6									2	E1.1La	2	F3.10			3	#4 TRIPLEX	120	1	#1/0 TRIPLEX	3	J3.1					EXISTING POLE CONNECT NEW TO EXISTING SECONDARY
6A						35	4		2	E1.1La	2	F3.10			3	#4 TRIPLEX	120	1	#1/0 TRIPLEX	3	J3.1					NEW POLE
7A									1	E1.1La	1	F3.10			2	EXISTING	115	1	#1/0 TRIPLEX	1	J3.1					EXISTING POLE CONNECT NEW TO EXISTING SECONDARY
18													1	G1.4-25 120/240V 1-PHASE	1	EXISTING							1	H1.1		EXISTING POLE. REPLACE XFMR. PROVIDE #2 ACSR JUMPERS. CONNECT CONDUCTORS TO NEW XFMR.
18B									1	E1.1La	1	F3.10			1	EXISTING										EXISTING POLE. RESET POLE. INSTALL NEW GUYS AND ANCHORS.
20													1	G1.4-25 120/240V 1-PHASE	1	EXISTING							1	H1.1		EXISTING POLE. REPLACE XFMR. PROVIDE #2 ACSR JUMPERS. CONNECT CONDUCTORS TO NEW XFMR.
20B									1	E1.1La	1	F3.10			2	EXISTING										EXISTING POLE. RESET POLE, REMOVE GUY/ANCHOR. INSTALL NEW GUY AND ANCHOR.
21									1	E1.1La	1	F3.10	1	G1.4-25 120/240V 1-PHASE									1	H1.1		EXISTING POLE. RESET POLE. INSTALL NEW GUY AND ANCHOR. REPLACE XFMR. PROVIDE #2 ACSR JUMPERS. CONNECT CONDUCTORS TO NEW XFMR.
22									1	E1.1La	1	F3.10								1	J3.1					EXISTING POLE. INSTALL NEW GUY AND ANCHOR. CONNECT NEW TO EXISTING SECONDARY
22A						35	4		2	E1.1La	2	F3.10			1	#4 TRIPLEX	120	1	#1/0 TRIPLEX	3	J3.1					NEW POLE INSTALL SALVAGED LIGHT ON NEW POLE
24													1	G1.4-25 120/240V 1-PHASE	1	EXISTING				1	J3.1		1	H1.1		EXISTING POLE. RESET POLE AND RE-TENSION GUY. REPLACE XFMR. PROVIDE #2 ACSR JUMPERS. CONNECT CONDUCTORS TO NEW XFMR.
24A						35	4								1	#4 TRIPLEX	75	1	#2 TRIPLEX	2	J3.1					NEW POLE

LOCATION NUMBER	STATION	LINE ANGLE (DEG)	CONDUCTOR			POLE		PRIMARY ASSEMBLY		GUYS		ANCHORS		XFMRs		SECONDARY CONDUCTOR				SECONDARY SERVICE		MISCELLANEOUS CONSTRUCTION UNITS		RIGHT OF WAY	REMARKS/COMMENTS/NOTES		
			No.	SIZE/TYPE	Back Span	HEIGHT	CLASS	No.	Units	No.	Units	No.	Units	SERVICE		BACKFEED		No.	Units	No.	Units						
														No.	SIZE/TYPE	Back Span	No.					SIZE/TYPE					
24-3													1	G1.4-15 120/240V 1-PHASE	2	EXISTING							1	H1.1		EXISTING POLE. REPLACE XFMR. PROVIDE #2 ACSR JUMPERS. CONNECT CONDUCTORS TO NEW XFMR.	
24-6								1	A5.1	1	E1.1La	1	F3.10	1	G1.4-10 120/240V 1-PHASE					1	J3.1			1	H1.1 N7.6		EXISTING POLE. RESET POLE AND RE-TENSION GUYS. INSTALL NEW GUY AND ANCHOR. REPLACE XFMR. PROVIDE #2 ACSR JUMPERS. CONNECT NEW TO EXISTING PRIMARY.
24-7		110	2	#2 ACSR	175	45	4	1	A1.1							1	#4 TRIPLEX	110	1	#1/0 TRIPLEX	3	J3.1				NEW POLE.	
24-8		115	2	#2 ACSR	110	45	4	1	A2.1	1	E1.1La	1	F3.10			1	#4 TRIPLEX	115	1	#1/0 TRIPLEX	2	J3.1				NEW POLE.	
24-9			2	#2 ACSR	115	45	4	1	A5.1	2	E1.1La	2	F3.10	1	G1.4-15 120/240V 1-PHASE			115	1	#1/0 TRIPLEX	1	J3.1		1	H1.1 N7.6		NEW POLE.
24-9A																		55	1	#1/0 TRIPLEX	1	J3.1				EXISTING POLE. CONNECT NEW TO EXISTING SECONDARY	
24-9B																										EXISTING POLE. RESET POLE AND RE-TENSION GUY.	
25										1	E1.1La	1	F3.10			1	EXISTING									EXISTING POLE. INSTALL NEW GUY AND ANCHOR. CONNECT NEW TO EXISTING SECONDARY	
25A										1	E1.1La	1	F3.10					130	1	#2 TRIPLEX	2	J3.1				EXISTING POLE. RESET POLE AND RE-TENSION GUY. INSTALL NEW GUY AND ANCHOR.	
25B						35	4									1	#4 TRIPLEX	70	1	#2 TRIPLEX	2	J3.1				NEW POLE ATTACH TELECOM TO NEW POLE.	
27										2	E1.1La	2	F3.10													EXISTING POLE. RESET POLE AND RE-TENSION GUYS. INSTALL NEW GUYS AND ANCHORS.	
29														1	G1.4-25 120/240V 1-PHASE	1	EXISTING							1	H1.1		EXISTING POLE. RESET POLE AND RE-TENSION GUY. REPLACE XFMR. PROVIDE #2 ACSR JUMPERS. CONNECT CONDUCTORS TO NEW XFMR. CONNECT TO OVERHEAD GUY.
29A						45	4			1	E1.1La	1	F3.10												1	E1.4L	NEW POLE. INSTALL OVERHEAD GUY

LOCATION NUMBER	STATION	LINE ANGLE (DEG)	CONDUCTOR			POLE		PRIMARY ASSEMBLY		GUYS		ANCHORS		XFMRs		SECONDARY CONDUCTOR				SECONDARY SERVICE		MISCELLANEOUS CONSTRUCTION UNITS		RIGHT OF WAY	REMARKS/COMMENTS/NOTES
			No.	SIZE/TYPE	Back Span	HEIGHT	CLASS	No.	Units	No.	Units	No.	Units	SERVICE		BACKFEED		No.	Units	No.	Units				
														No.	SIZE/TYPE	Back Span	No.					SIZE/TYPE			
29-3									1	E1.1La	1	F3.10	1	G1.4-25 120/240V 1-PHASE	1	EXISTING						1	H1.1		EXISTING POLE. RESET POLE AND RE-TENSION GUY. INSTALL NEW GUY AND ANCHOR. REPLACE XFMR. PROVIDE #2 ACSR JUMPERS. CONNECT CONDUCTORS TO NEW XFMR.
29-4													1	G1.4-15 120/240V 1-PHASE	2	EXISTING						1	H1.1		EXISTING POLE. REPLACE XFMR. PROVIDE #2 ACSR JUMPERS. CONNECT CONDUCTORS TO NEW XFMR.
30A									1	E1.1La	1	F3.10			2	EXISTING									EXISTING POLE. INSTALL NEW GUY AND ANCHOR.
31													1	G1.4-25 120/240V 1-PHASE	1	EXISTING						1	H1.1		EXISTING POLE. REPLACE XFMR. PROVIDE #2 ACSR JUMPERS. CONNECT CONDUCTORS TO NEW XFMR.
31B									2	E1.1La	2	F3.10			2	EXISTING									EXISTING POLE. RESET POLE. INSTALL NEW GUYS AND ANCHORS.
32													1	G3.3-15 208Y120V 3-PHASE								1	H1.1		EXISTING POLE. REPLACE XFMRs. PROVIDE #2 ACSR JUMPERS. CONNECT CONDUCTORS TO NEW XFMR.
34													1	G1.4-25 120/240V 1-PHASE	1	EXISTING						1	H1.1		EXISTING POLE. REPLACE XFMR. PROVIDE #2 ACSR JUMPERS. CONNECT CONDUCTORS TO NEW XFMR.
35													1	G1.4-25 120/240V 1-PHASE								1	H1.1		EXISTING POLE. REPLACE XFMR. PROVIDE #2 ACSR JUMPERS. CONNECT CONDUCTORS TO NEW XFMR.
36															3	EXISTING					1	J3.1			EXISTING POLE. CONNECT NEW TO EXISTING SECONDARY
37															2	EXISTING	140	1	#1/0 TRIPLEX	1	J3.1				EXISTING POLE. CONNECT NEW TO EXISTING SECONDARY
38													1	G1.4-25 120/240V 1-PHASE	1	EXISTING						1	H1.1		EXISTING POLE. REPLACE XFMR. PROVIDE #2 ACSR JUMPERS. CONNECT CONDUCTORS TO NEW XFMR.

LOCATION NUMBER	STATION	LINE ANGLE (DEG)	CONDUCTOR			POLE		PRIMARY ASSEMBLY		GUYS		ANCHORS		XFMRS		SECONDARY CONDUCTOR				SECONDARY SERVICE		MISCELLANEOUS CONSTRUCTION UNITS		RIGHT OF WAY	REMARKS/COMMENTS/NOTES
			No.	SIZE/TYPE	Back Span	HEIGHT	CLASS	No.	Units	No.	Units	No.	Units	No.	Units	SERVICE		BACKFEED		No.	Units	No.	Units		
																No.	SIZE/TYPE	Back Span	No.						

STAKING SHEET NOTES:

1. SEE PROJECT DETAIL DRAWINGS FOR MODIFIED RUS CONSTRUCTION UNITS. UNLESS OTHERWISE INDICATED, GUY LEADS SHALL BE 30 FEET.
2. ON THE RUS CONSTRUCTION UNIT G1.4 AND G1.5 AN ARMOR ROD IS INDICATED AT THE CONNECTION TO THE LINE WITH A HOT LINE CLAMP. DO NOT INSTALL SURGE ARRESTERS ON TRANSFORMERS.