





RURAL ENERGY GROUP
813 W. NORTHERN LIGHTS BLVD.
ANCHORAGE, ALASKA 99503
HTTP: //WWW.AIDEA.ORG

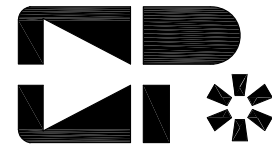

ENGINEERED & MANUFACTURED BY
Controlled Power, Inc.
BOTHELL, WASHINGTON USA
(425)-485-1778 www.controlledpowerinc.com








**NIKOLSKI VILLAGE GENERATOR SWITCHGEAR UPGRADE
ALASKA ENERGY AUTHORITY PURCHASE ORDER No. PREPAID
CONTROLLED POWER, INC. JOB No. 8555**

<u>DRAWING No.</u>	<u>DRAWING TITLE</u>
8555-2101-D	COVER SHEET
8555-3101-D	SCHEMATIC LEGEND AND NOTES
8555-4101-D	GENERATOR SWITCHGEAR ELEVATION VIEW, OUTLINE DIAGRAM
8555-4102-D	WALLMOUNT ENCLOSURE ELEVATION VIEW, OUTLINE DIAGRAM
8555-4103-D	BOILER PANEL ELEVATION VIEW, OUTLINE DIAGRAM
8555-5101-D	SINGLE LINE, SCHEMATIC DIAGRAM
8555-5201-D	GENERATOR 1 AC THREE LINE, SCHEMATIC DIAGRAM
8555-5202-D	GENERATOR 2 AC THREE LINE, SCHEMATIC DIAGRAM
8555-5203-D	GENERATOR 3 AC THREE LINE, SCHEMATIC DIAGRAM
8555-5204-D	MASTER AC THREE LINE AND DISTRIBUTION, SCHEMATIC DIAGRAM
8555-5301-D	GENERATOR 1 DC CONTROL, SCHEMATIC DIAGRAM
8555-5302-D	GENERATOR 1 DC CONTROL, SCHEMATIC DIAGRAM
8555-5303-D	GENERATOR 1 DC CONTROL, SCHEMATIC DIAGRAM
8555-5304-D	GENERATOR 2 DC CONTROL, SCHEMATIC DIAGRAM
8555-5305-D	GENERATOR 2 DC CONTROL, SCHEMATIC DIAGRAM
8555-5306-D	GENERATOR 2 DC CONTROL, SCHEMATIC DIAGRAM
8555-5307-D	GENERATOR 3 DC CONTROL, SCHEMATIC DIAGRAM
8555-5308-D	GENERATOR 3 DC CONTROL, SCHEMATIC DIAGRAM
8555-5309-D	GENERATOR 3 DC CONTROL, SCHEMATIC DIAGRAM
8555-5310-D	MASTER DC CONTROL, SCHEMATIC DIAGRAM
8555-5311-D	MASTER DC CONTROL, SCHEMATIC DIAGRAM
8555-5312-D	MASTER DC CONTROL, SCHEMATIC DIAGRAM
8555-5313-D	FUEL FLOW SYSTEM WIRING, SCHEMATIC DIAGRAM
8555-5501-D	PLC COMMUNICATION DIAGRAM
8555-5601-D	COMMUNICATION NETWORK DIAGRAM
8555-5602-D	EPM MONITORING AND SYSTEM COMMUNICATION DIAGRAM
8555-5701-D	HEATER & LIGHTING CONTROL, SCHEMATIC DIAGRAM
8555-6101-D	CONTROL SWITCH TARGET DIAGRAM
8555-6201-D	NAMEPLATE ENGRAVING SCHEDULE, FABRICATION DETAIL
8555-7101-D	INTERCONNECTION DIAGRAM

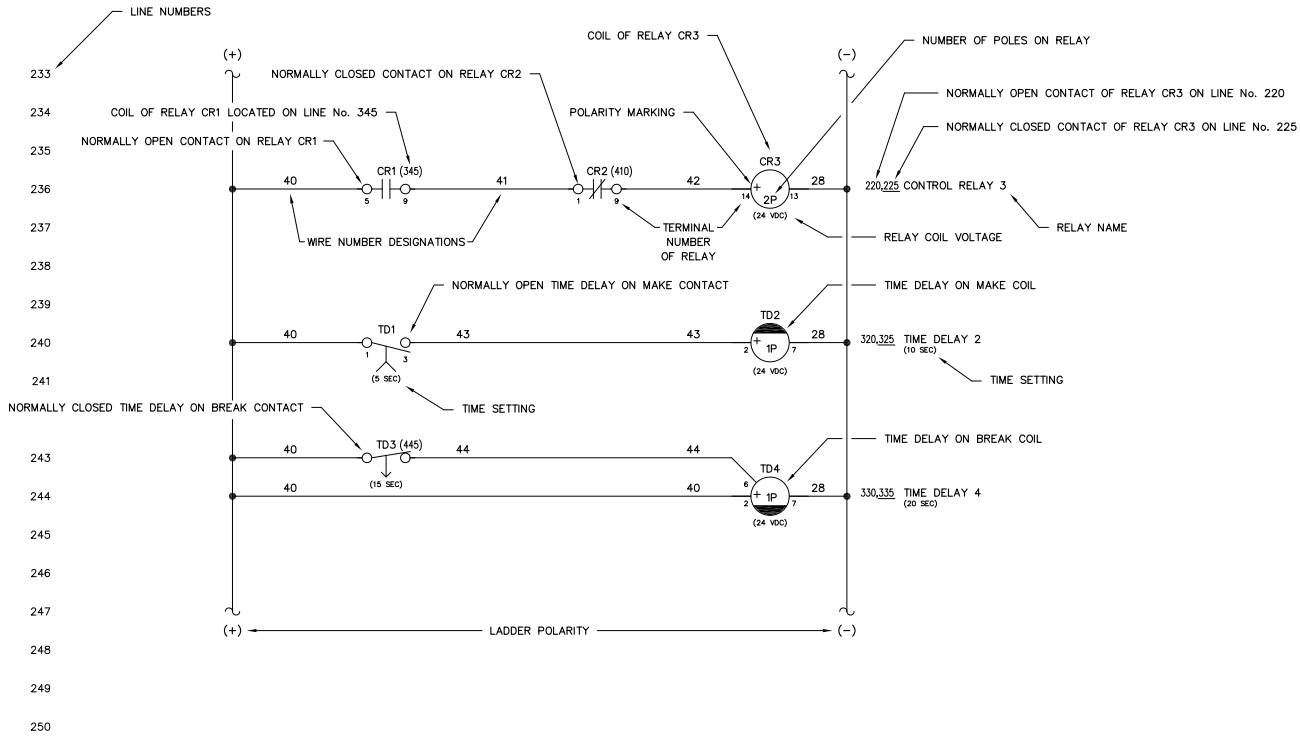

NOTES:

- SCHEMATIC IS SHOWN AS FOLLOWS:
 - ALL AC AND DC POWER REMOVED
 - ALL RELAY CONTACTS DE-ENERGIZED
 - ALL CIRCUIT BREAKERS IN THE OPEN/RESET POSITION
 - ALL MODE SWITCHES IN THE "OFF" POSITION
 - ALL EMERGENCY STOP SWITCHES IN THE "NORMAL" POSITION
 - ALL PRESSURE SWITCHES SHOWN WITHOUT PRESSURE PRESENT
 - ALL LEVEL SWITCHES SHOWN WITHOUT FLUID PRESENT
 - ALL TEMPERATURE SWITCHES SHOWN AT AMBIENT
- ⊙ INDICATES FIELD TERMINALS IN GENERATOR CONTROL SECTION.
- ⊠ INDICATES TERMINALS AT ENGINE/GENERATOR.
- ⊕ INDICATES INTERCONNECT TERMINALS IN MASTER SECTION.
- ⊗ INDICATES FIELD TERMINALS IN MASTER SECTION.
- ⊙ INDICATES INTERCONNECT TERMINALS IN GENERATOR CONTROL SECTION.
- INDICATES FIELD WIRING BY OTHERS
 - ALL CONTROL WIRING TO BE No. 14 AWG, 600 VOLT, TYPE SIS EXCEPT AS NOTED
- SHIELDED WIRING TO BE No. 18 AWG, 300 VOLT, TWISTED LINE WITH 100% FOIL COVERAGE
- ALL DIODES ARE 1N4007 EXCEPT AS NOTED

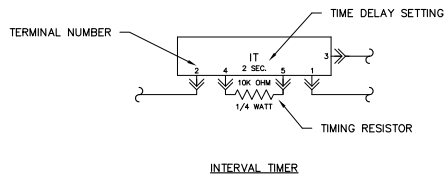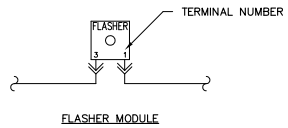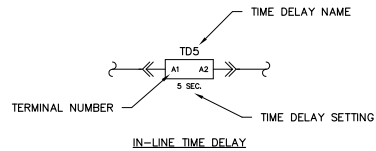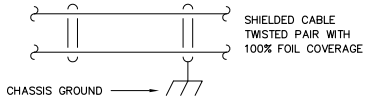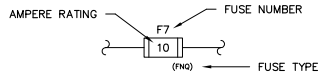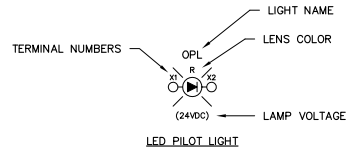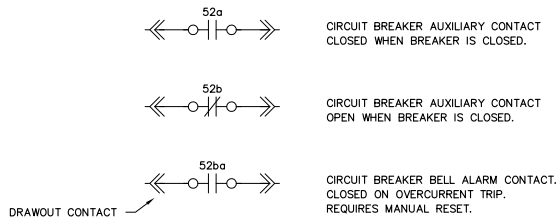

NOTE:

- FOR GENERAL WIRING & CONSTRUCTION NOTES, SEE DRAWING No. 8555-3101-D.


A	03-24-17	FIELD REVISION	GPN
REV.	DATE	DESCRIPTION	BY
AEA PURCHASE ORDER No. PREPAID CONTROLLED POWER JOB No. 8555			
TITLE: SCHEMATIC LEGEND & NOTES			
SCALE: NONE		DATE: 03-14-17	DWN. BY: GPN
DWG. No: 8555-3101-D		SHEET: 1 OF 1	CKD. BY: RTH
JOB: NIKOLSKI UPGRADE			
		RURAL ENERGY GROUP 813 W. NORTHERN LIGHTS BLVD. ANCHORAGE, ALASKA 99503 HTTP://WWW.AIDEA.ORG	

NOTICE


THE DRAWINGS, INFORMATION AND SUBJECT MATTER HEREOF ARE THE CONFIDENTIAL, SOLE AND EXCLUSIVE PROPERTY OF CONTROLLED POWER, INC., AND ARE NOT TO BE COPIED, REPRODUCED OR USED IN ANY MANNER FOR ANY PURPOSE WHATSOEVER WITHOUT WRITTEN CONSENT OR DIRECTION.




ENGINEERED & MANUFACTURED BY
Controlled Power, Inc.
BOTHELL, WASHINGTON USA
(425)-485-1778 www.controlledpowerinc.com

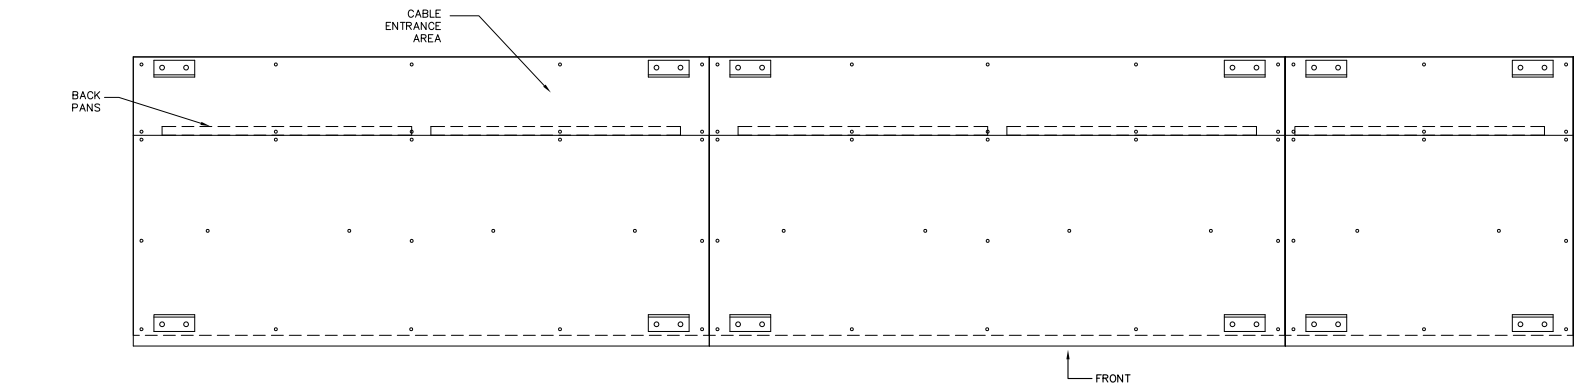


GENERATOR SWITCHGEAR – TOP VIEW

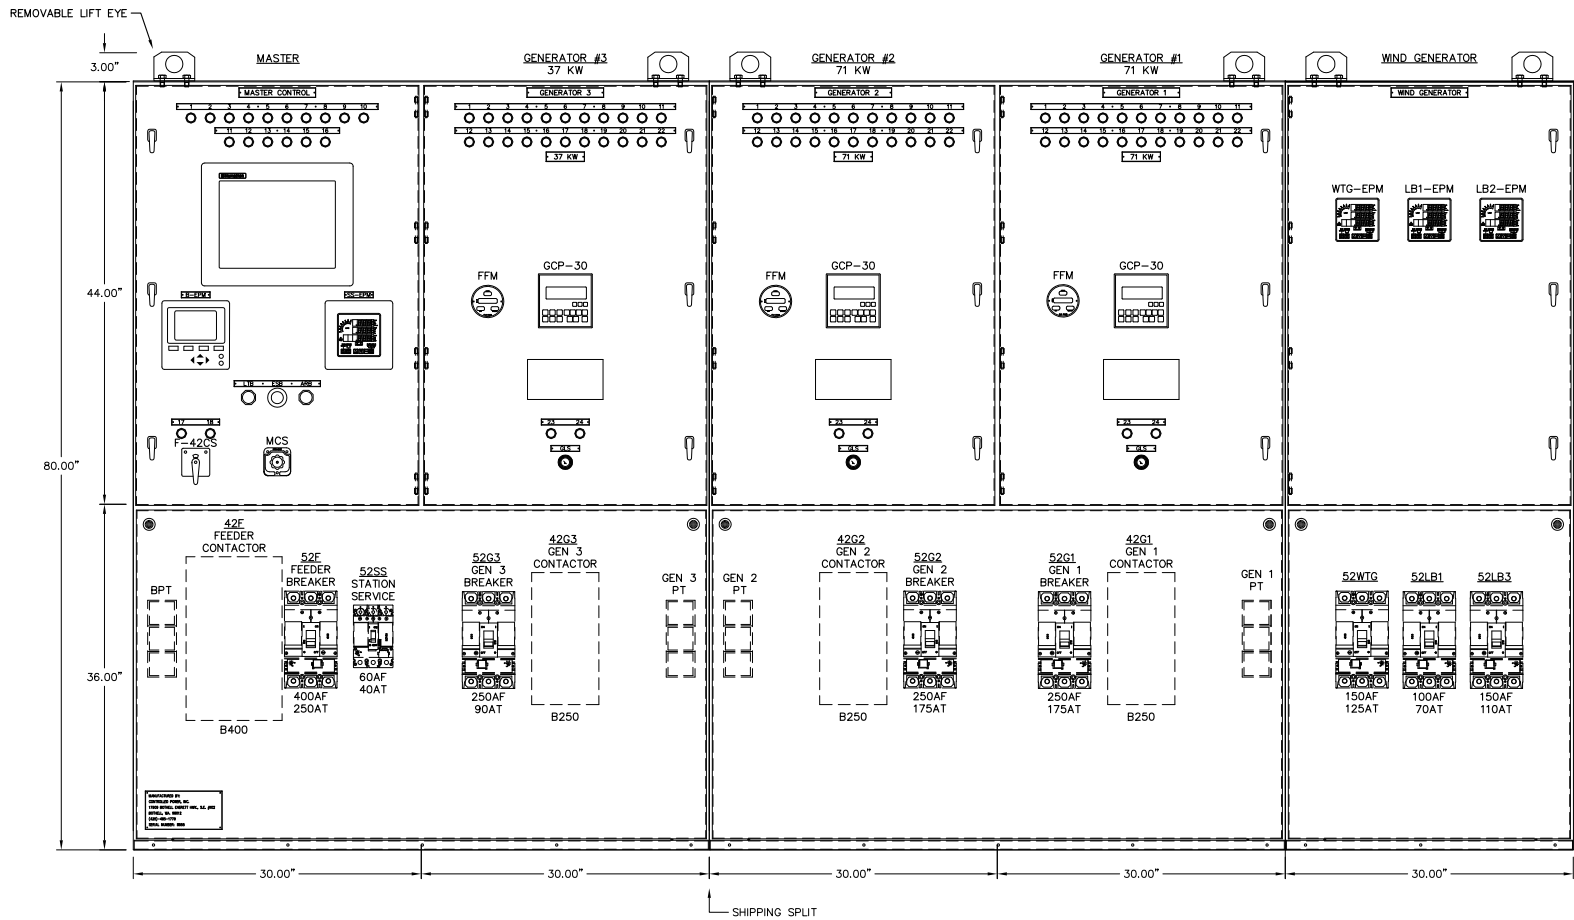

GENERATOR SWITCHGEAR – FRONT VIEW

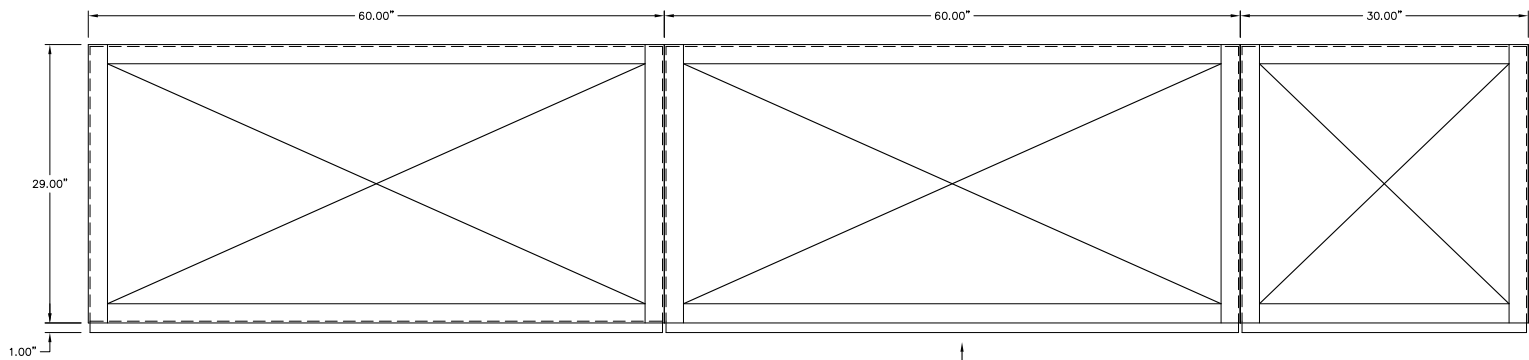

GENERATOR SWITCHGEAR – PLAN VIEW

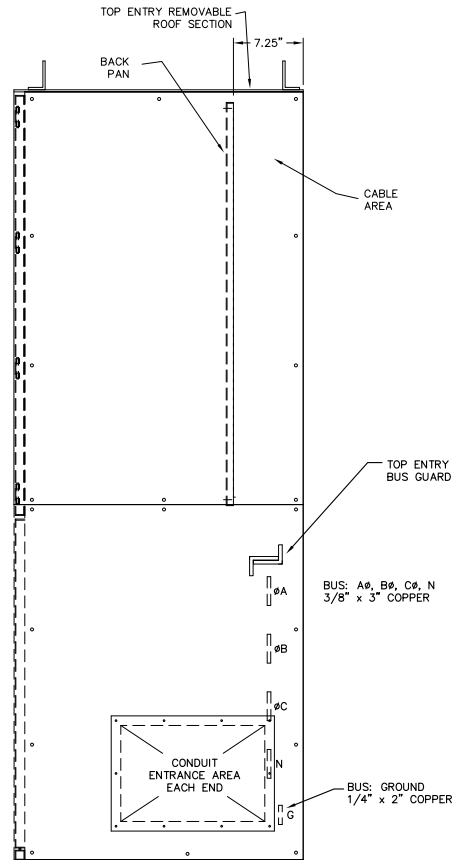

GENERATOR SWITCHGEAR – SIDE VIEW

GCP HEADOUT

* INCLUDES, BUT IS NOT LIMITED TO THE FOLLOWING LIST OF METERING, STATUS, AND ALARMS.

METERING LEGEND

1. VOLTS: A₀, B₀, C₀
L-N₀, L-L
2. AMPS: A₀, B₀, C₀
3. KW
4. PF
5. KWH

ALARM LEGEND

1. LOW OIL PRESSURE ALARM
2. LOW OIL PRESSURE SHUTDOWN
3. HIGH WATER TEMPERATURE ALARM
4. HIGH WATER TEMPERATURE SHUTDOWN
5. OVERCRANK
6. OVERSPEED
7. LOW OIL LEVEL

ANALOG INPUT LEGEND

1. OIL PRESSURE (PSI)
2. WATER TEMP (°F)

MISC. LEGEND

1. ENGINE HOURS
2. ENGINE START COUNTER
3. MAINTENANCE CALL

GCP FUNCTIONS

* INCLUDES, BUT NOT LIMITED TO:

- 27/59
- 81 o/u
- 32
- 50/51
- 40
- 47

SYMBOL

- | SYMBOL | DESCRIPTION |
|--------|---|
| ARB | ALARM RESET BUTTON |
| B-EPM | BUS ELECTRONIC POWER METER – 6200ION |
| ESB | EMERGENCY STOP BUTTON |
| F-EPM | FEEDER ELECTRONIC POWER METER – 7500ION |
| FFM | FUEL FLOW METER |
| GCP | GENERATOR CONTROL PACKAGE |
| GLS | GENERATOR LOCKOUT SWITCH |
| OIU | OPERATOR INTERFACE UNIT |
| LTB | LAMP TEST BUTTON |
| MCS | MASTER CONTROL SWITCH |
| SS-EPM | STATION SERVICE POWER METER – 6200ION |
| 42xx | CONTACTOR |
| 52CS | BREAKER CONTROL SWITCH |
| 52xx | CIRCUIT BREAKER |

GENERATOR ANNUNCIATOR LEGEND:


1. ENGINE RUNNING
2. ENGINE IDLE
3. ENGINE ALARM
4. LOW OIL PRESSURE
5. OIL LEVEL
6. HIGH OIL TEMPERATURE
7. HIGH WATER TEMPERATURE
8. OVERSPEED
9. OVERCRANK
10. COOLDOWN/LOCKOUT
11. BATTERY CHARGER FAILURE
12. NORMAL STOP
13. NOT IN AUTO POSITION
14. GENERATOR BREAKER OPEN
15. FAIL TO SYNCHRONIZE
16. OVERCURRENT
17. UNDER VOLTAGE
18. OVER VOLTAGE
19. UNDER FREQUENCY
20. OVER FREQUENCY
21. LOSS OF EXCITATION
22. REVERSE POWER
23. CONTACTOR OPEN
24. CONTACTOR CLOSED

MASTER ANNUNCIATOR LEGEND

1. FIRE ALARM LIGHT
2. EMERGENCY STOP LIGHT
3. SYSTEM LOW WATER LEVEL LIGHT
4. DAY TANK CRITICAL LOW LIGHT
5. BUS UNDER/OVER VOLTAGE LIGHT
6. BUS UNDER/OVER FREQUENCY LIGHT
7. FEEDER BREAKER OVERCURRENT LIGHT
8. PRIMARY PLC FAILURE
9. OPERATING ON BACKUP PLC
10. BACKUP PLC FAILURE
11. SPARE 1
12. SPARE 2
13. SPARE 3
14. SPARE 4
15. SPARE 5
16. WIND TURBINE ON
17. FEEDER CONTACTOR OPEN
18. FEEDER CONTACTOR CLOSED


NOTE:

1. FOR GENERAL WIRING & CONSTRUCTION NOTES, SEE DRAWING No. 8555-3101-D.

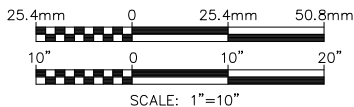


NOTICE
THE DRAWINGS, INFORMATION AND SUBJECT MATTER HEREOF ARE THE CONFIDENTIAL, SOLE AND EXCLUSIVE PROPERTY OF CONTROLLED POWER, INC. AND ARE NOT TO BE COPIED, REPRODUCED OR USED IN ANY MANNER FOR ANY PURPOSE WHATSOEVER WITHOUT WRITTEN CONSENT OR DIRECTION.


A	03-24-17	FIELD REVISION	GPN
REV.	DATE	DESCRIPTION	BY
AEA PURCHASE ORDER No. PREPAID CONTROLLED POWER JOB No. 8555			
TITLE: GENERATOR SWITCHGEAR ELEVATION VIEW, OUTLINE DIAGRAM			
SCALE: NONE		DATE: 03-14-17	DWN. BY: GPN
DWG. No: 8555-4101-D		SHEET: 1 OF 1	CKD. BY: RTH
JOB: NIKOLSKI UPGRADE			
		RURAL ENERGY GROUP 813 W. NORTHERN LIGHTS BLVD. ANCHORAGE, ALASKA 99503 HTTP://WWW.AIDEA.ORG	
		ENGINEERED & MANUFACTURED BY Controlled Power, Inc. BOTHELL, WASHINGTON USA (425)-485-1778 www.controlledpowerinc.com	

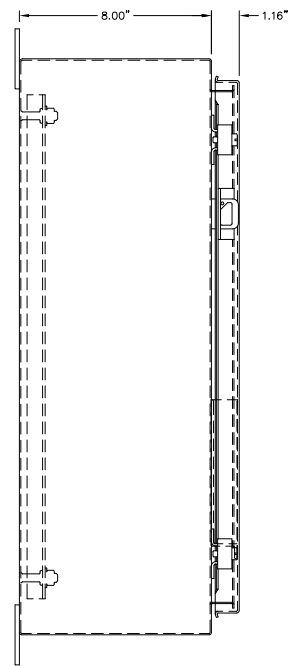


SIDE VIEW

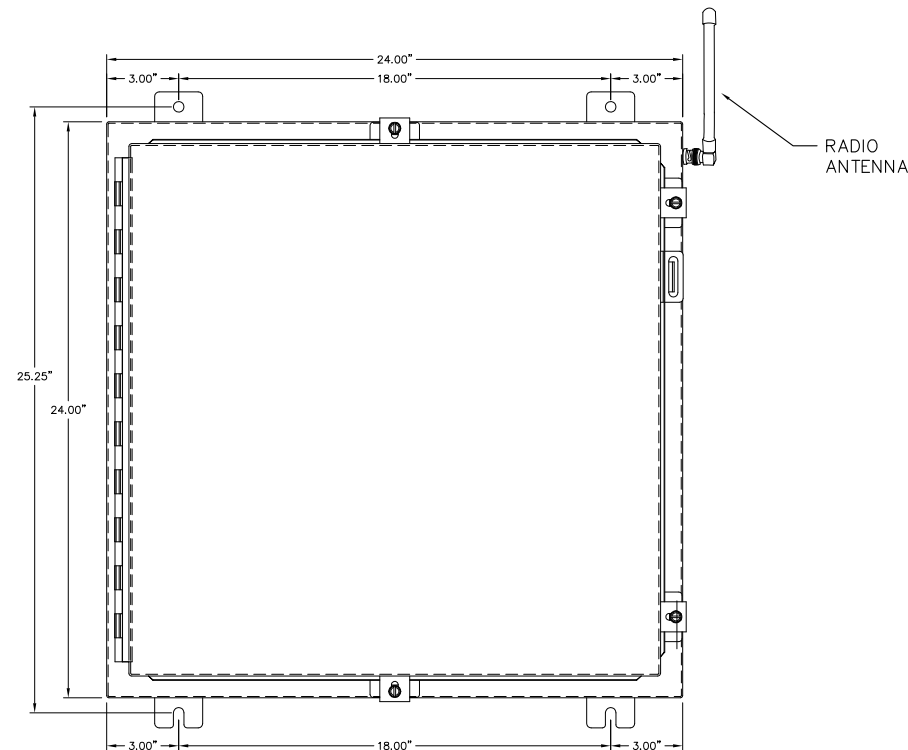


THERMAL NODE 2
(LODGE)

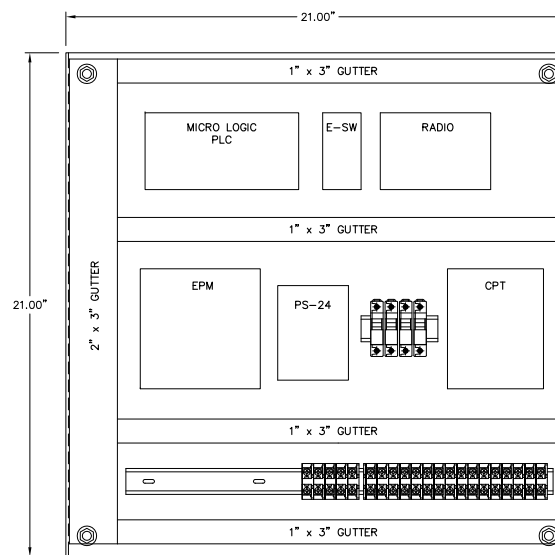


INTERNAL BACK PAN

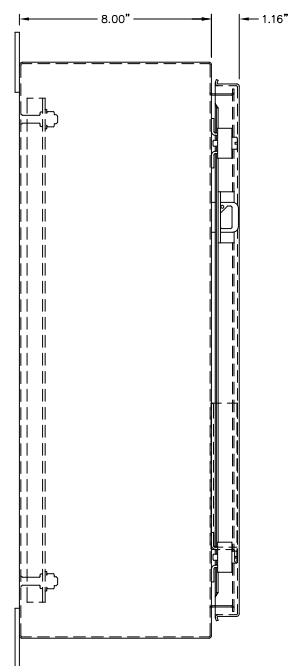

SIDE VIEW

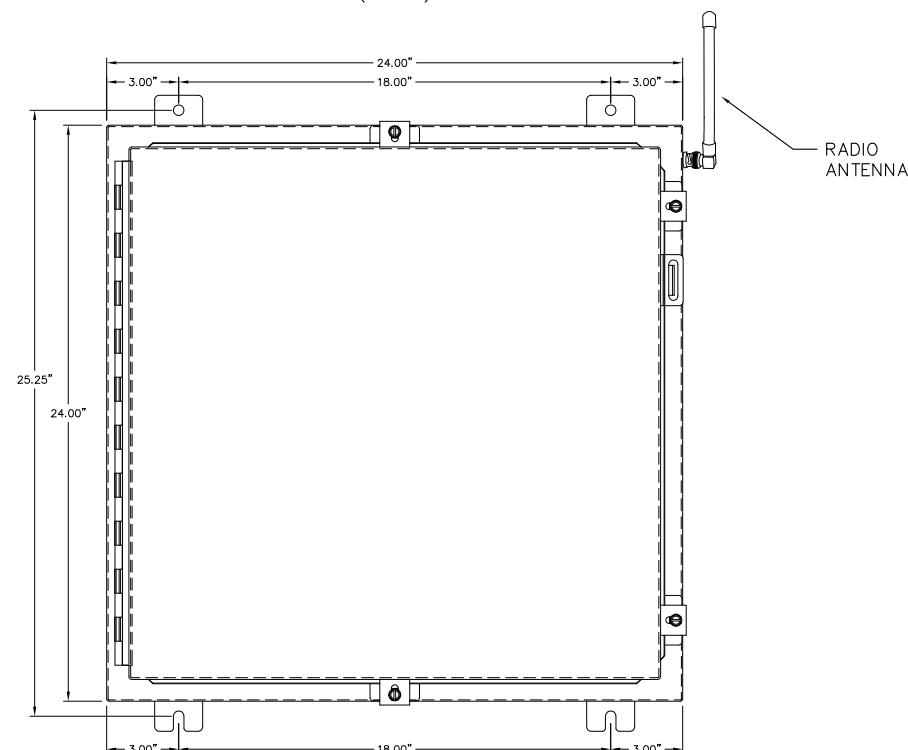

THERMAL NODE 1
(SHCOOL)

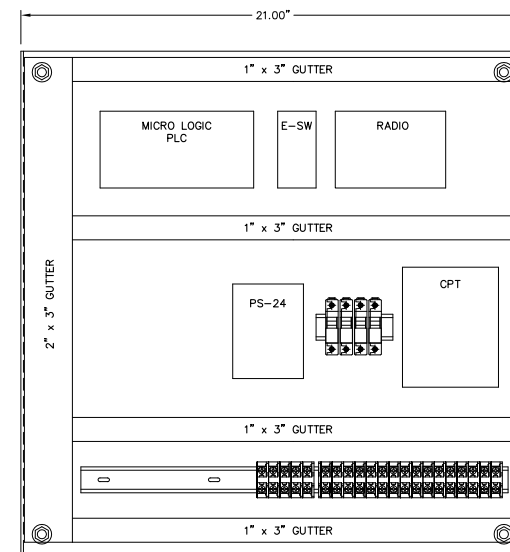

INTERNAL BACK PAN

- NOTE:
1. FOR GENERAL WIRING & CONSTRUCTION NOTES, SEE DRAWING No. 8555-3101-D.

A	03-24-17	FIELD REVISION	GPN
REV.	DATE	DESCRIPTION	BY
AEA PURCHASE ORDER No. PREPAID		CONTROLLED POWER JOB No. 8555	
TITLE: WALLMOUNT ENCLOSURE & BACK PAN, OUTLINE DIAGRAM			
SCALE: NONE		DATE: 03-14-17	DWN. BY: GPN
DWG. No: 8555-4102-D		SHEET: 1 OF 1	CKD. BY: RTH
JOB: NIKOLSKI UPGRADE			


ALASKA
ENERGY AUTHORITY

RURAL ENERGY GROUP
813 W. NORTHERN LIGHTS BLVD.
ANCHORAGE, ALASKA 99503
HTTP://WWW.AIDEA.ORG




ENGINEERED & MANUFACTURED BY
Controlled Power, Inc.
BOTHELL, WASHINGTON USA
(425)-485-1778 www.controlledpowerinc.com


NOTICE
THE DRAWINGS, INFORMATION AND SUBJECT MATTER HEREOF
ARE THE CONFIDENTIAL, SOLE AND EXCLUSIVE PROPERTY
OF CONTROLLED POWER, INC. AND ARE NOT TO BE COPIED,
REPRODUCED OR USED IN ANY MANNER FOR ANY PURPOSE
WHATSOEVER WITHOUT WRITTEN CONSENT OR DIRECTION.

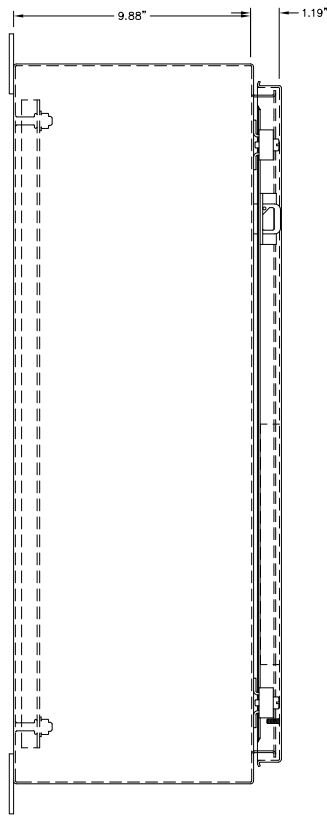


LEFT SIDE VIEW

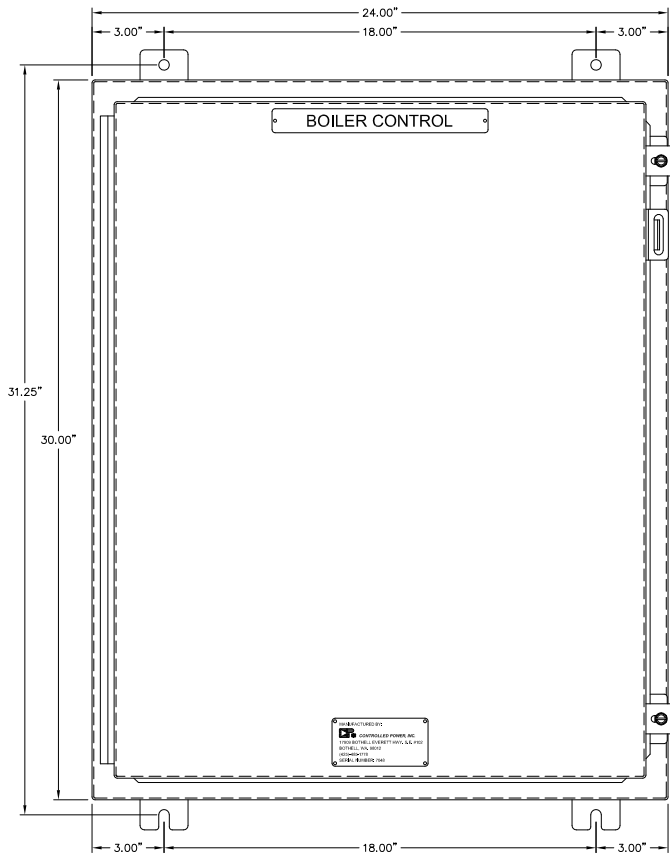

BOILER PANEL – TYPICAL FRONT VIEW

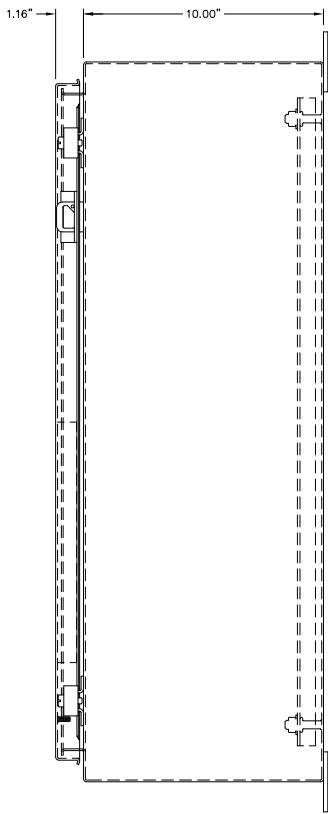

RIGHT SIDE VIEW

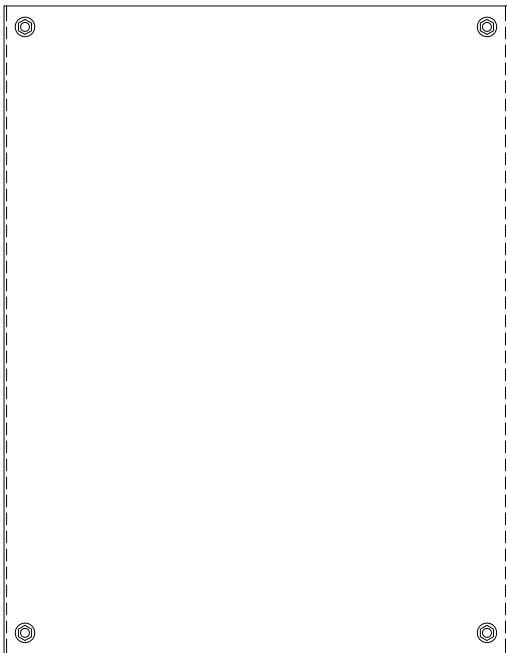

INTERNAL BACK PAN



TYPICAL BOTTOM VIEW

- NOTE:
1. FOR GENERAL WIRING & CONSTRUCTION NOTES, SEE DRAWING No. 8555-3101-D.

A	03-24-17	FIELD REVISION	GPN
REV.	DATE	DESCRIPTION	BY
AEA PURCHASE ORDER No. PREPAID CONTROLLED POWER JOB No. 8555			
TITLE: BOILER PANEL ELEVATION VIEW, OUTLINE DIAGRAM			
SCALE: NONE		DATE: 03-14-17	DWN. BY: GPN
DWG. No: 8555-4103-D		SHEET: 1 OF 1	CKD. BY: RTH
JOB: NIKOLSKI UPGRADE			


 **ALASKA**
ENERGY AUTHORITY

RURAL ENERGY GROUP
813 W. NORTHERN LIGHTS BLVD.
ANCHORAGE, ALASKA 99503
HTTP://WWW.AIDEA.ORG

NOTICE
THE DRAWINGS, INFORMATION AND SUBJECT MATTER HEREOF
ARE THE CONFIDENTIAL, SOLE AND EXCLUSIVE PROPERTY
OF CONTROLLED POWER, INC., AND ARE NOT TO BE COPIED,
REPRODUCED OR USED IN ANY MANNER FOR ANY PURPOSE
WHATSOEVER WITHOUT WRITTEN CONSENT OR DIRECTION.



ENGINEERED & MANUFACTURED BY
Controlled Power, Inc.
BOTHELL, WASHINGTON USA
(425)-485-1778 www.controlledpowerinc.com

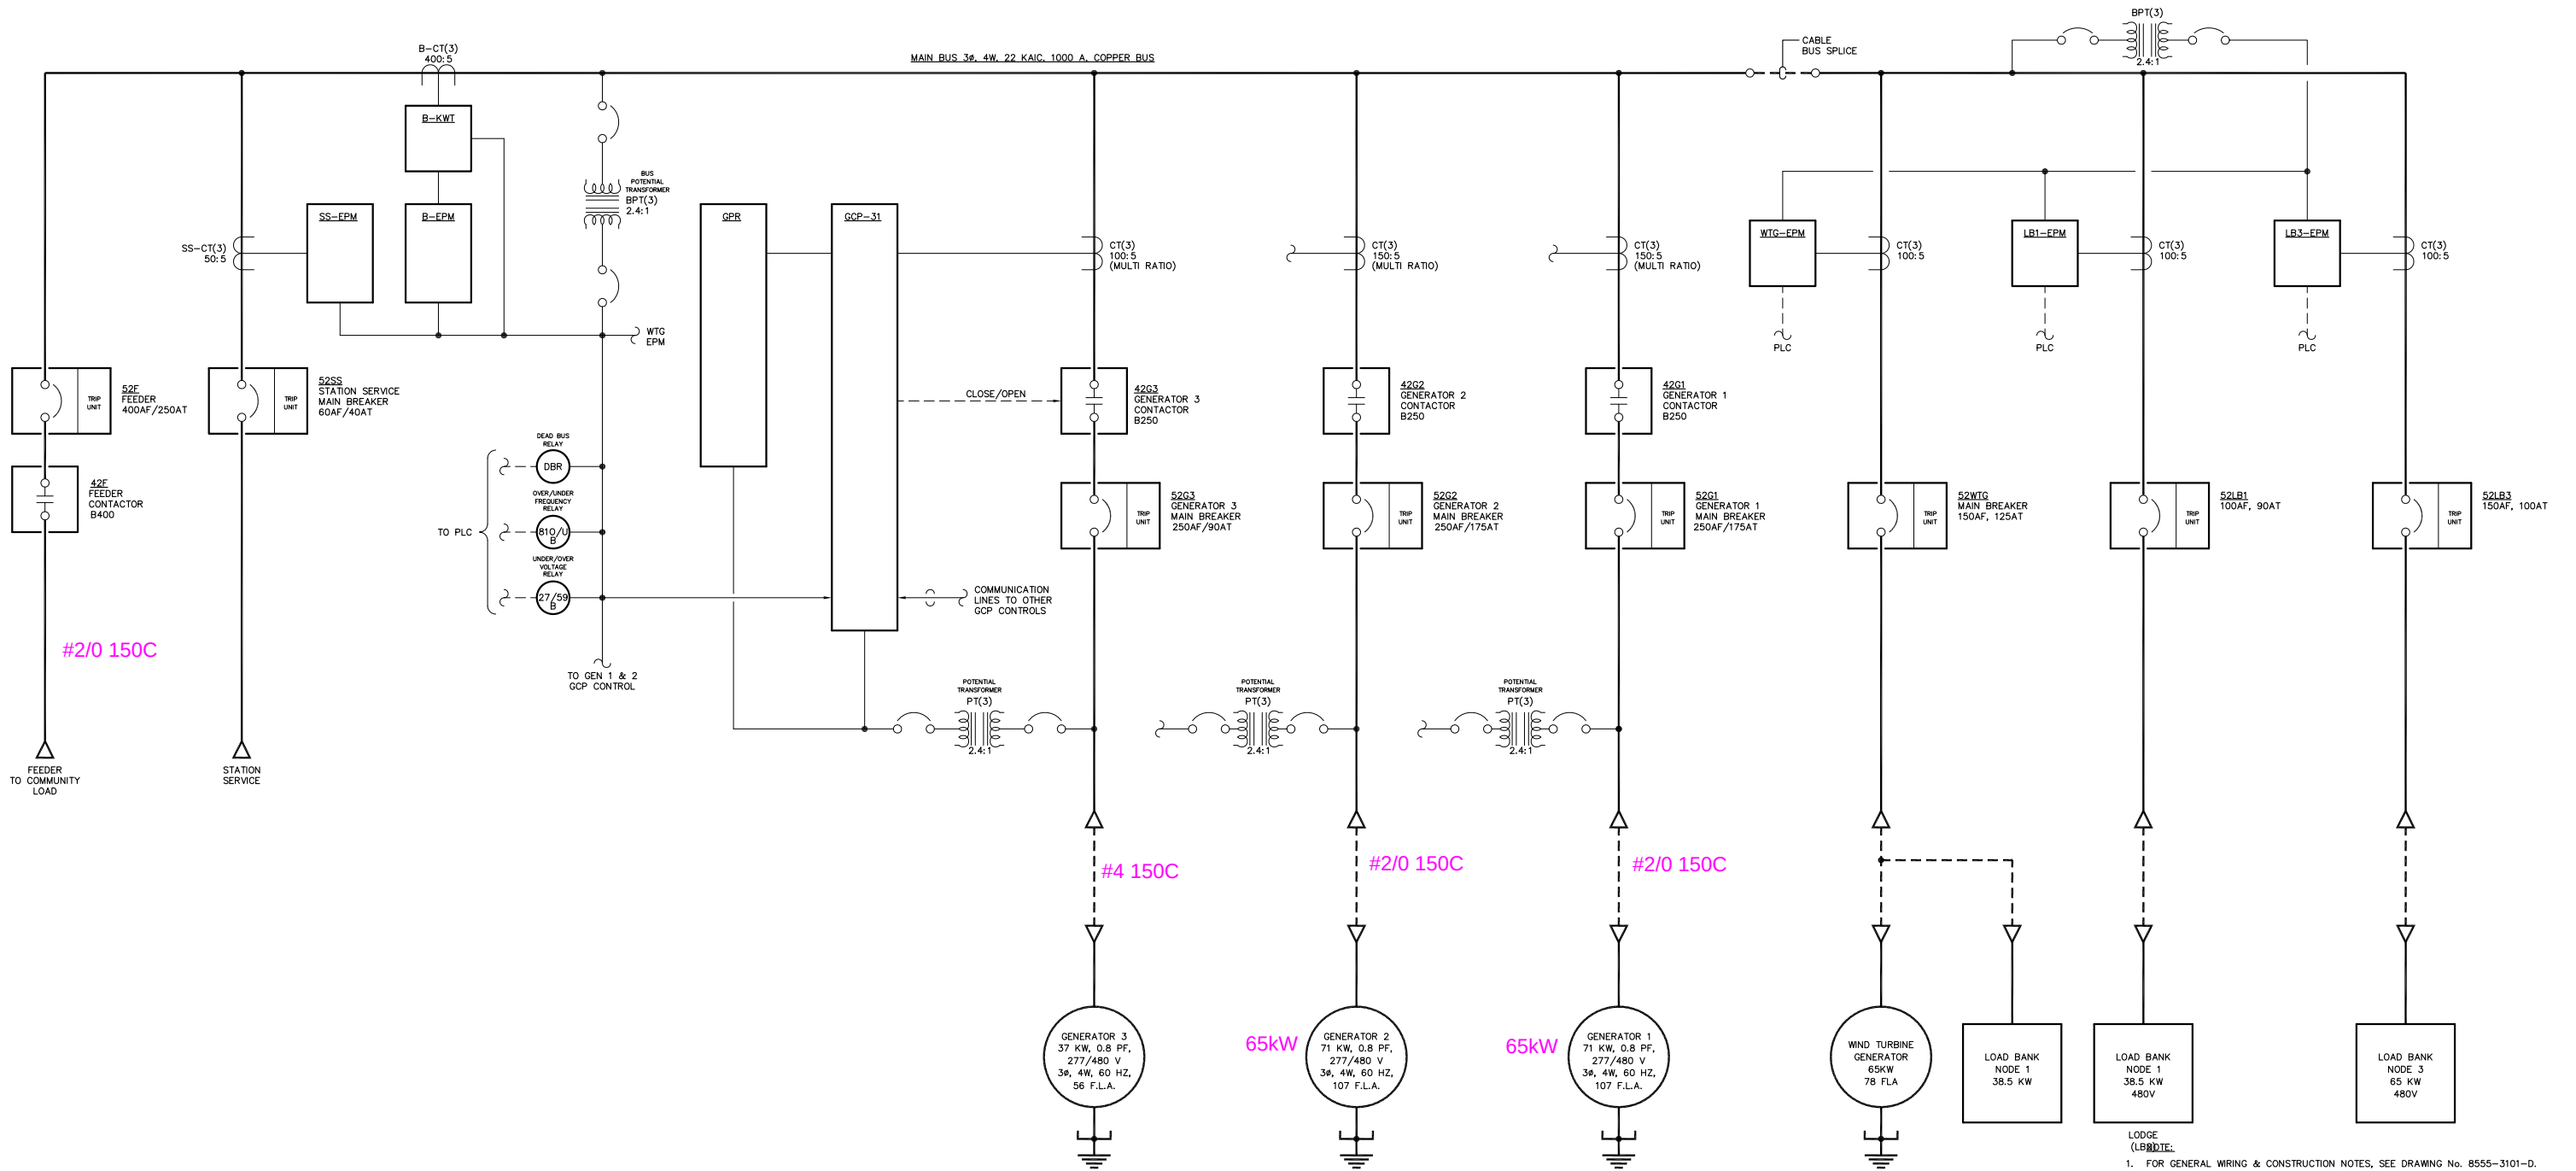

#2/0 150C

#4 150C

#2/0 150C

#2/0 150C

65kW

65kW

NOTES:

1. GENERATORS 1 & 2 SIMILAR TO GENERATOR 3.

Notes:

- 1) Conductor sizes and temperature ratings shown based on original design and have not been confirmed. Field verify.
- 2) Breaker trip setpoints shown based on 2017 field revision and may not match present operating conditions. Field verify.

1. FOR GENERAL WIRING & CONSTRUCTION NOTES, SEE DRAWING No. 8555-3101-D.

REV.	DATE	DESCRIPTION	BY
A	03-24-17	FIELD REVISION	GPN
AEA PURCHASE ORDER No. PREPAID CONTROLLED POWER JOB No. 8555			
TITLE: SINGLE LINE, SCHEMATIC DIAGRAM			
SCALE: NONE		DATE: 03-14-17	DWN. BY: GPN
DWG. No: 8555-5101-D		SHEET: 1 OF 1	CKD. BY: RTH
JOB: NIKOLSKI UPGRADE			
		RURAL ENERGY GROUP 813 W. NORTHERN LIGHTS BLVD. ANCHORAGE, ALASKA 99503 HTTP://WWW.AIDEA.ORG	



ENGINEERED & MANUFACTURED BY
Controlled Power, Inc.
BOTHILL, WASHINGTON USA
(425)-485-1778 www.controlledpowerinc.com

NOTICE
THE DRAWINGS, INFORMATION AND SUBJECT MATTER HEREOF ARE THE CONFIDENTIAL, SOLE AND EXCLUSIVE PROPERTY OF CONTROLLED POWER, INC. AND ARE NOT TO BE COPIED, REPRODUCED OR USED IN ANY MANNER FOR ANY PURPOSE WHATSOEVER WITHOUT WRITTEN CONSENT OR DIRECTION.




ALASKA
ENERGY AUTHORITY

RURAL ENERGY GROUP
813 W. NORTHERN LIGHTS BLVD.
ANCHORAGE, ALASKA 99503
[HTTP://WWW.AIDEA.ORG](http://www.aidea.org)

ENGINEERED & MANUFACTURED BY
Controlled Power, Inc.
BOTHELL, WASHINGTON USA
(425)-485-1778 www.controlledpowerinc.com

NOTICE

THE DRAWINGS, INFORMATION AND SUBJECT MATTER HEREOF ARE THE CONFIDENTIAL, SOLE AND EXCLUSIVE PROPERTY OF CONTROLLED POWER, INC., AND ARE NOT TO BE COPIED, REPRODUCED OR USED IN ANY MANNER FOR ANY PURPOSE WHATSOEVER WITHOUT WRITTEN CONSENT OR DIRECTION.

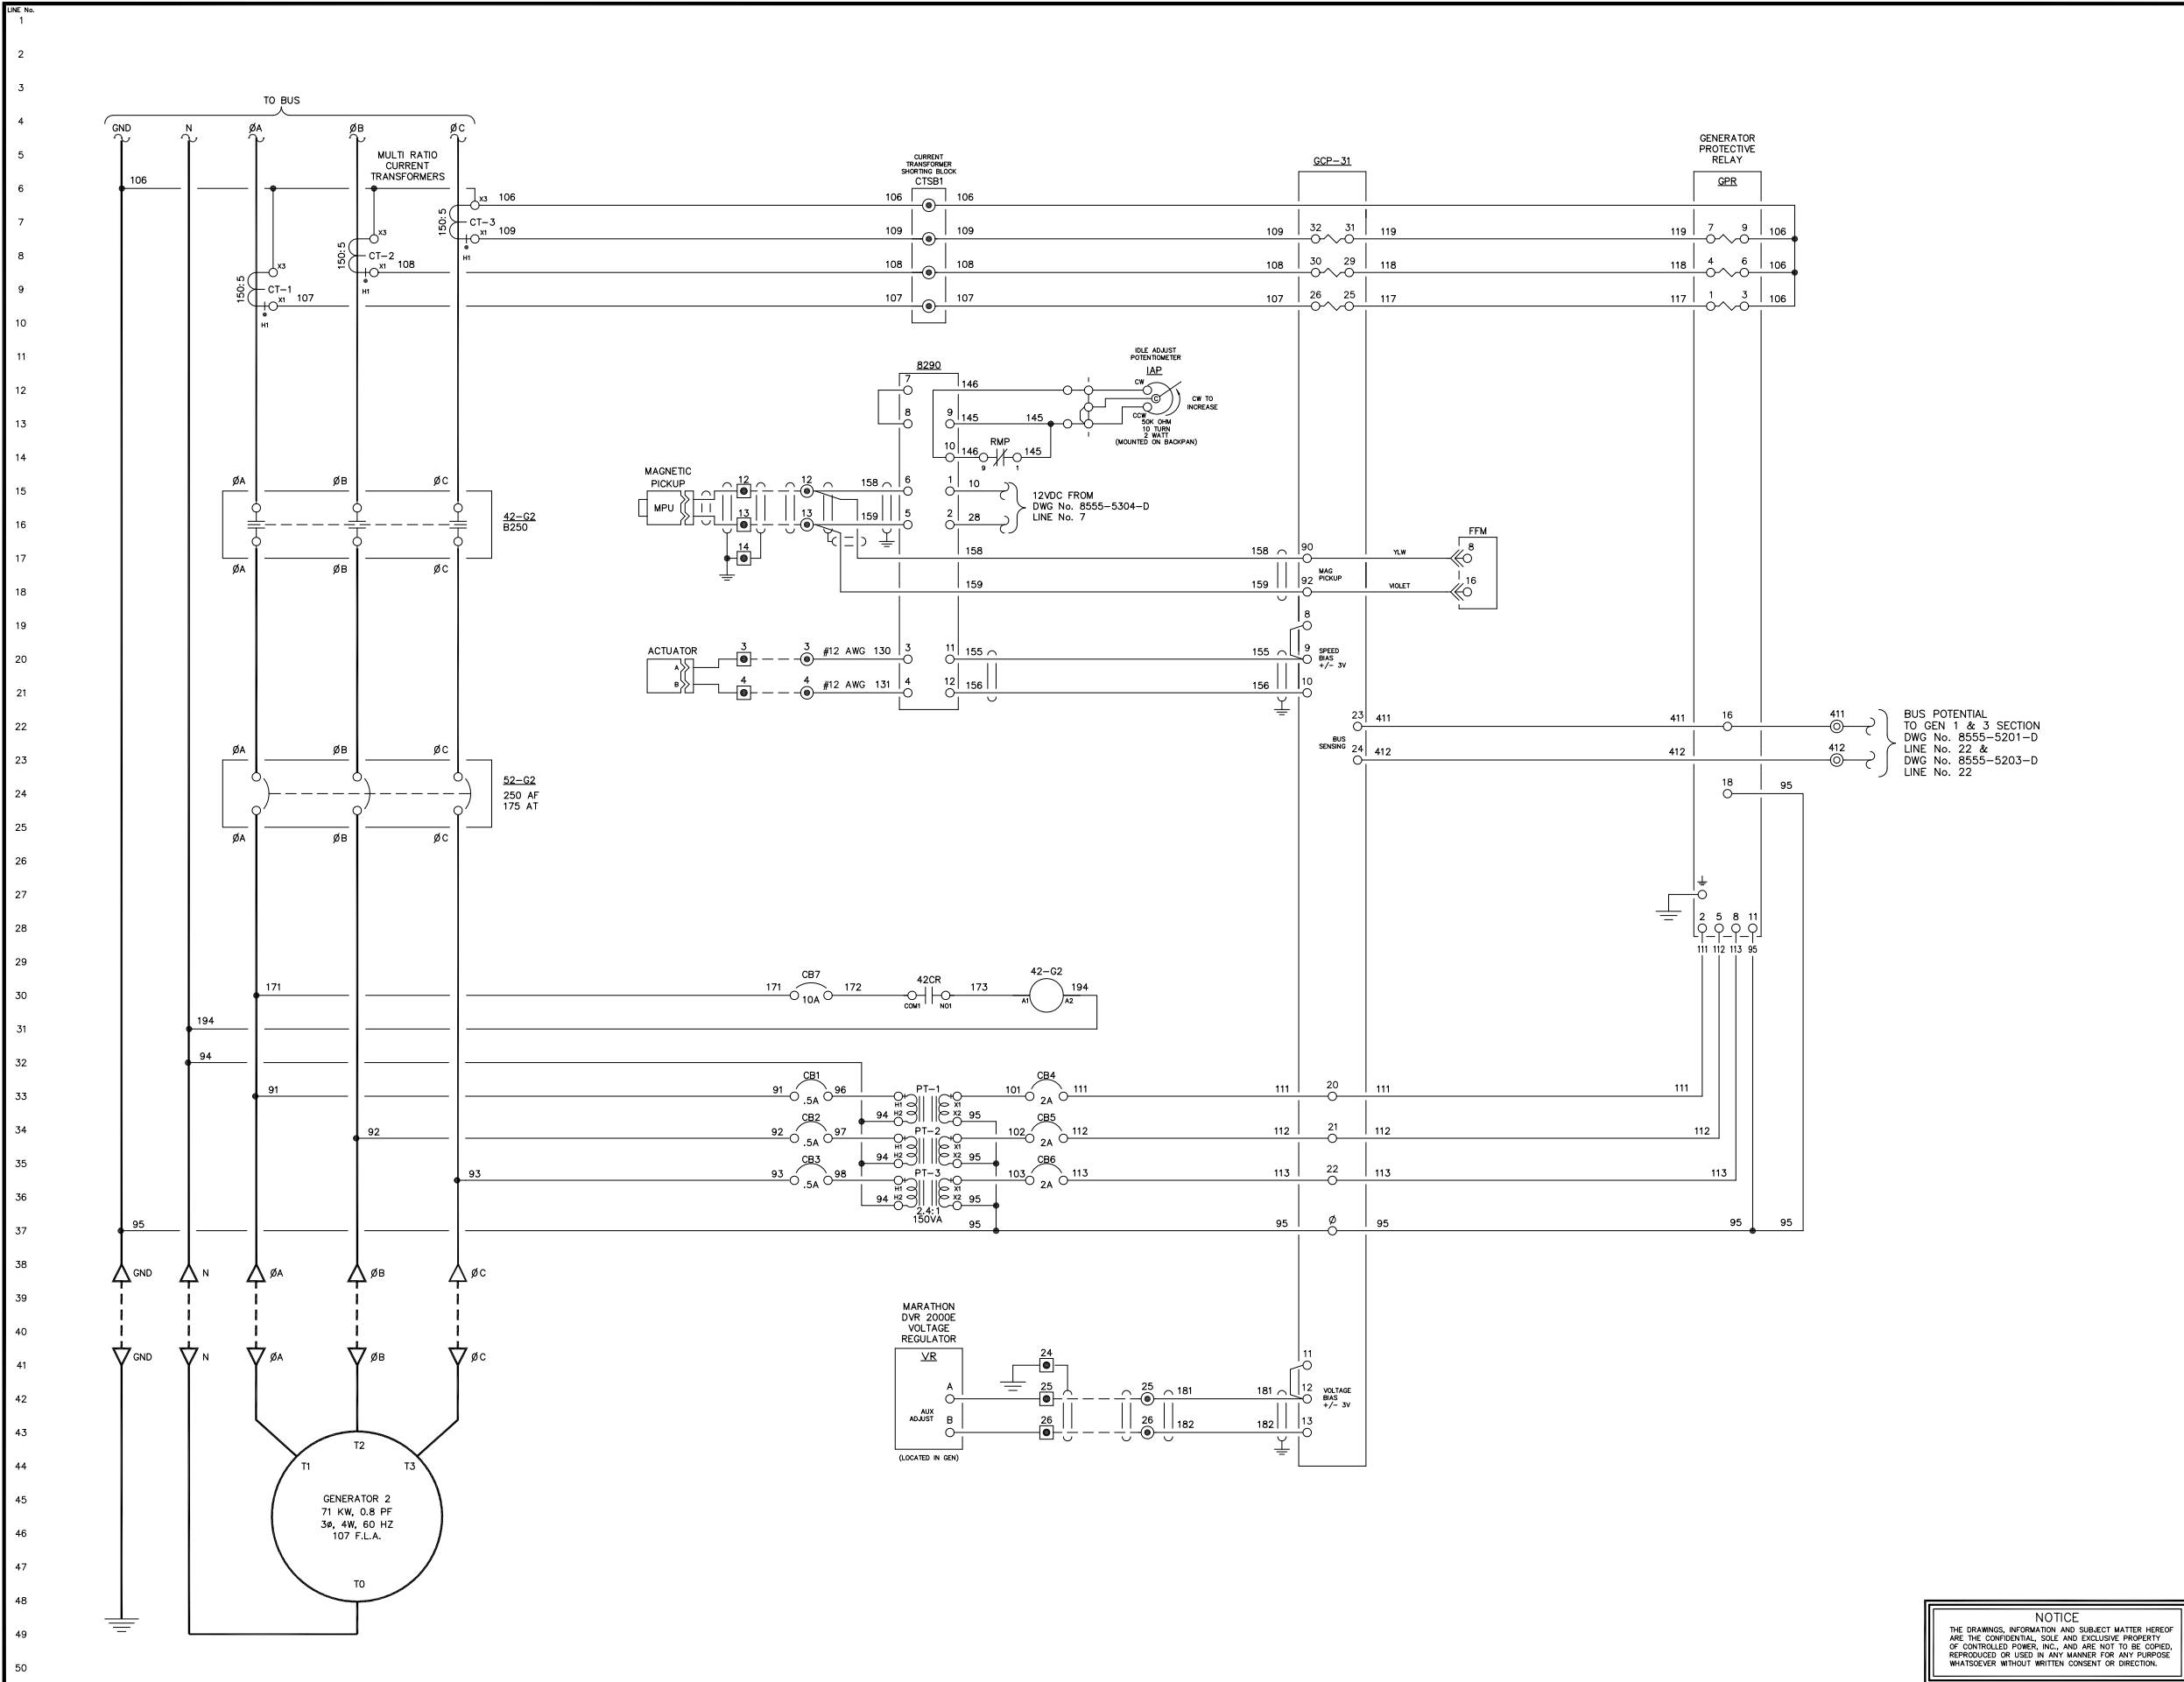




ALASKA
ENERGY AUTHORITY


RURAL ENERGY GROUP
813 W. NORTHERN LIGHTS BLVD.
ANCHORAGE, ALASKA 99503
HTTP://WWW.AIDEA.ORG



ENGINEERED & MANUFACTURED BY
Controlled Power, Inc.
BOTHELL, WASHINGTON USA
(425)-485-1778 www.controlledpowerinc.com

NOTICE

THE DRAWINGS, INFORMATION AND SUBJECT MATTER HEREOF ARE THE CONFIDENTIAL, SOLE AND EXCLUSIVE PROPERTY OF CONTROLLED POWER, INC., AND ARE NOT TO BE COPIED, REPRODUCED OR USED IN ANY MANNER FOR ANY PURPOSE WHATSOEVER WITHOUT WRITTEN CONSENT OR DIRECTION.

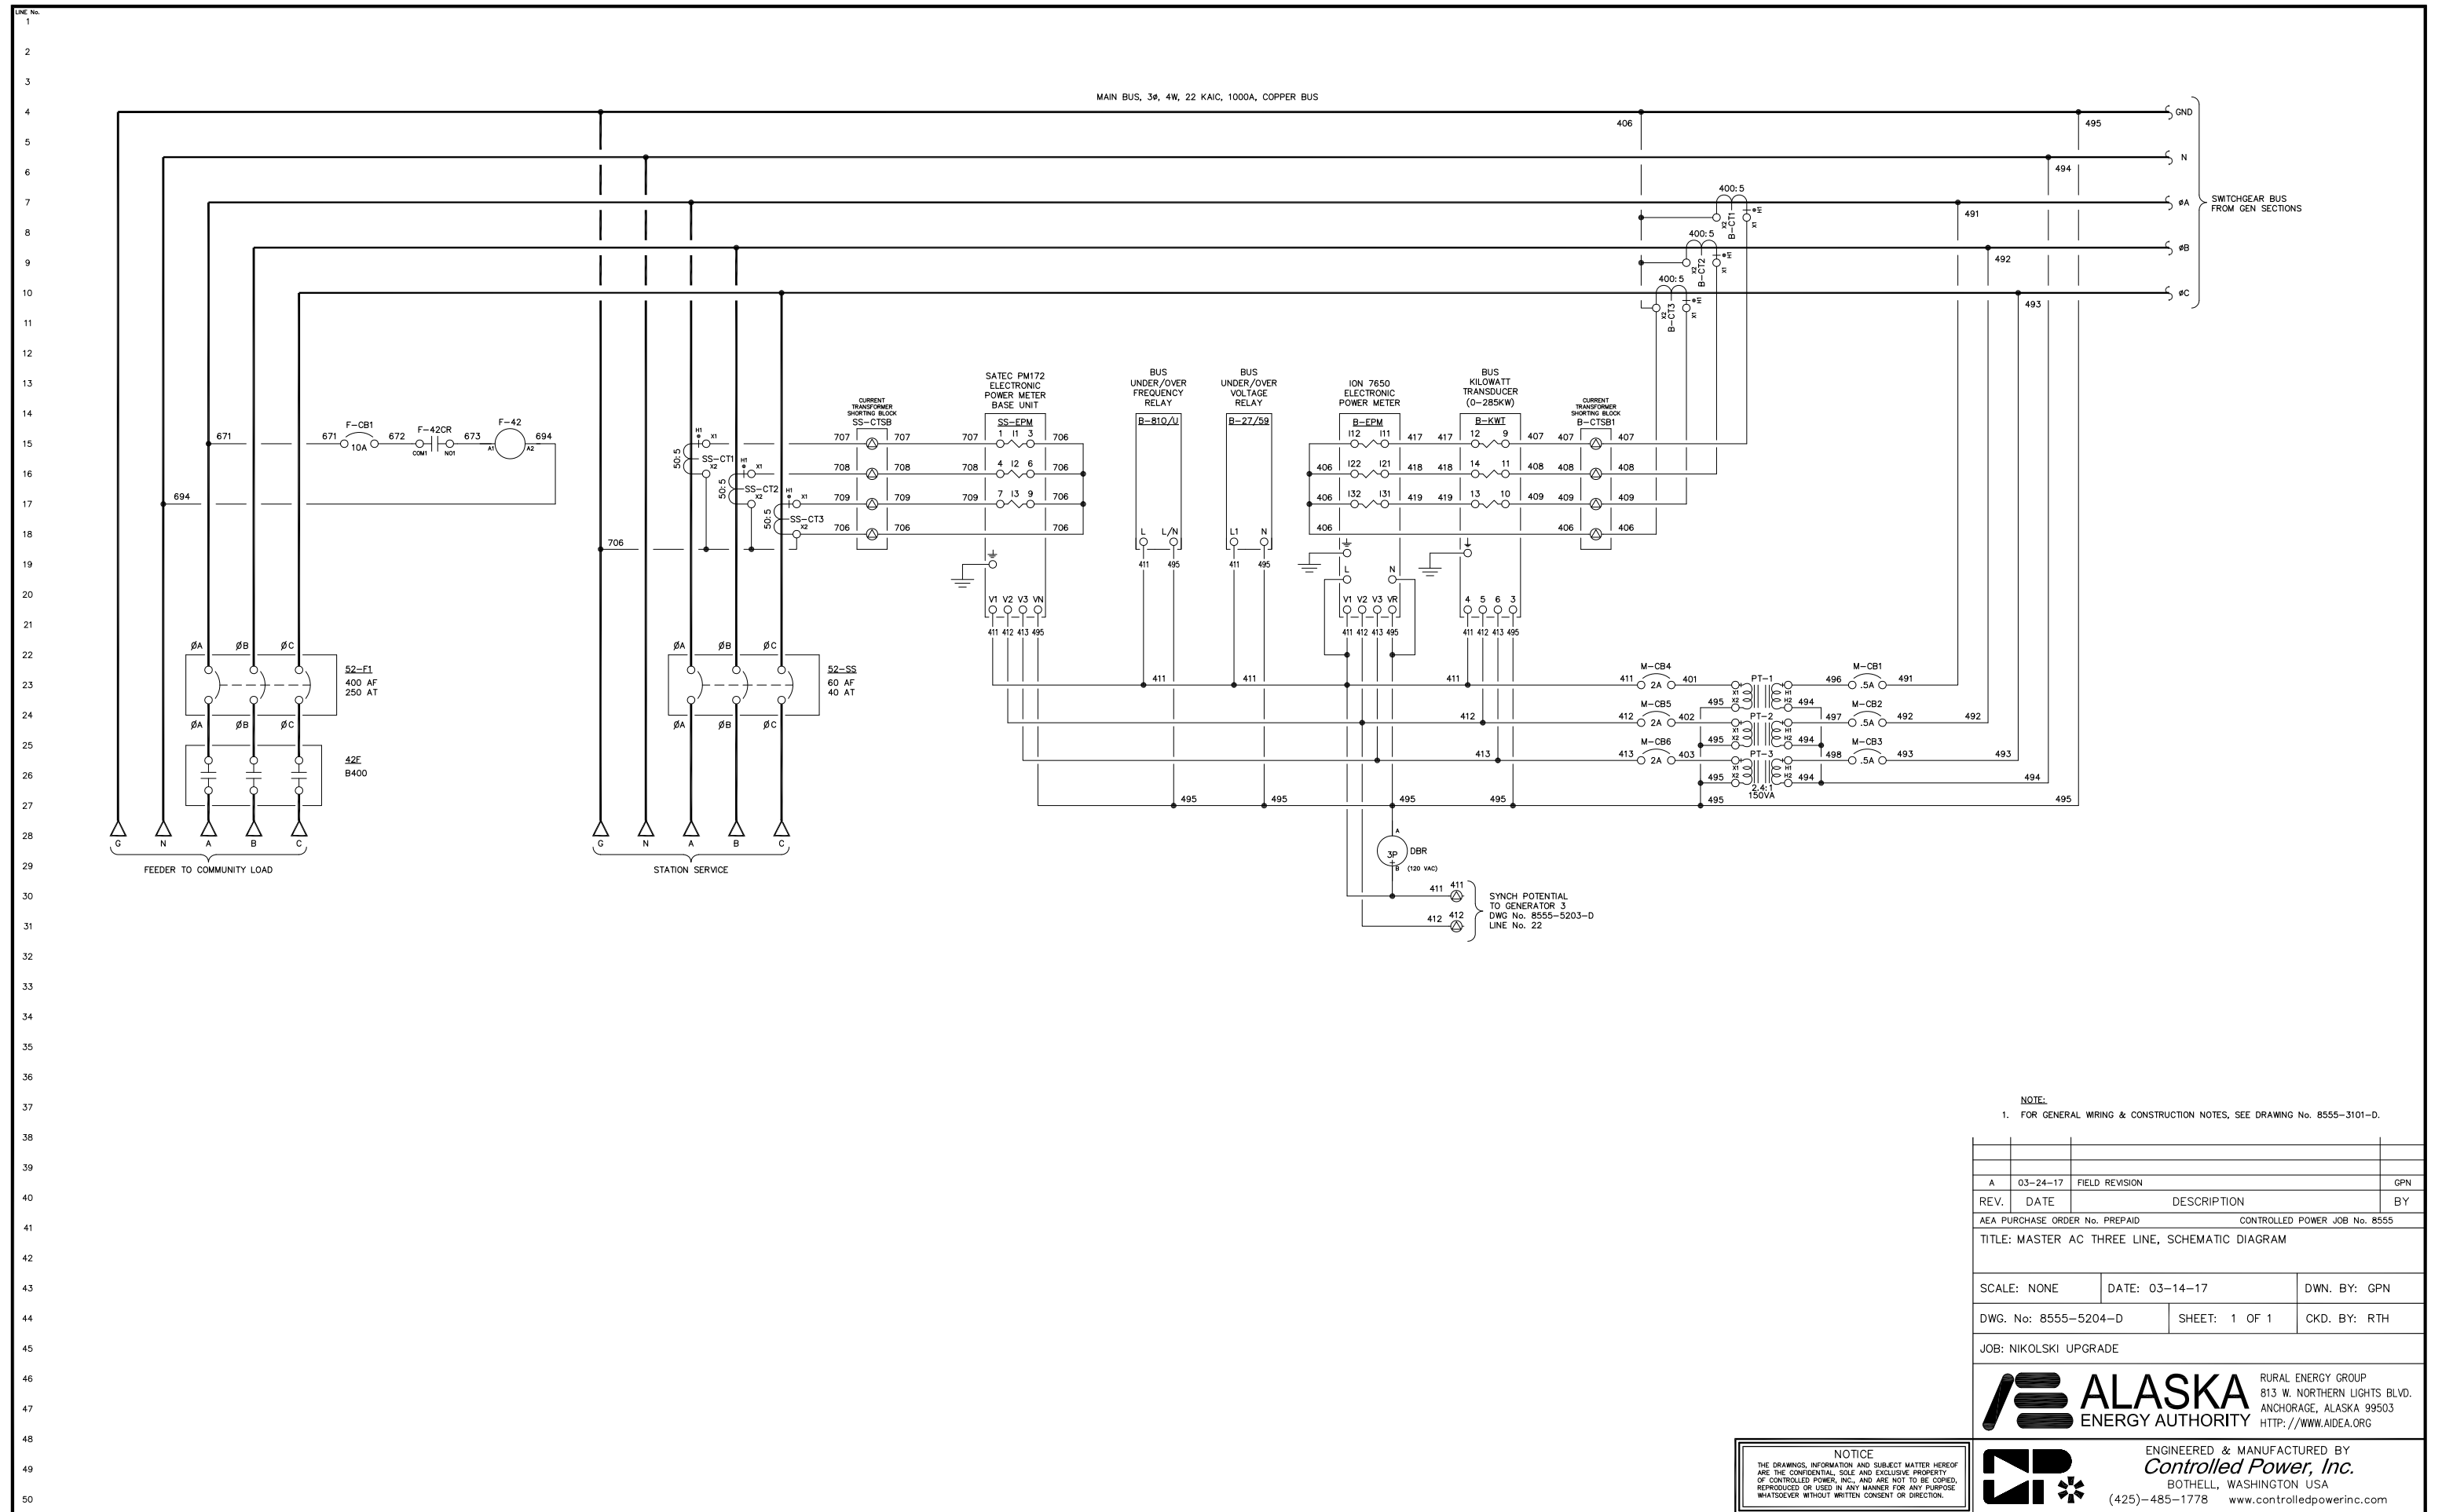


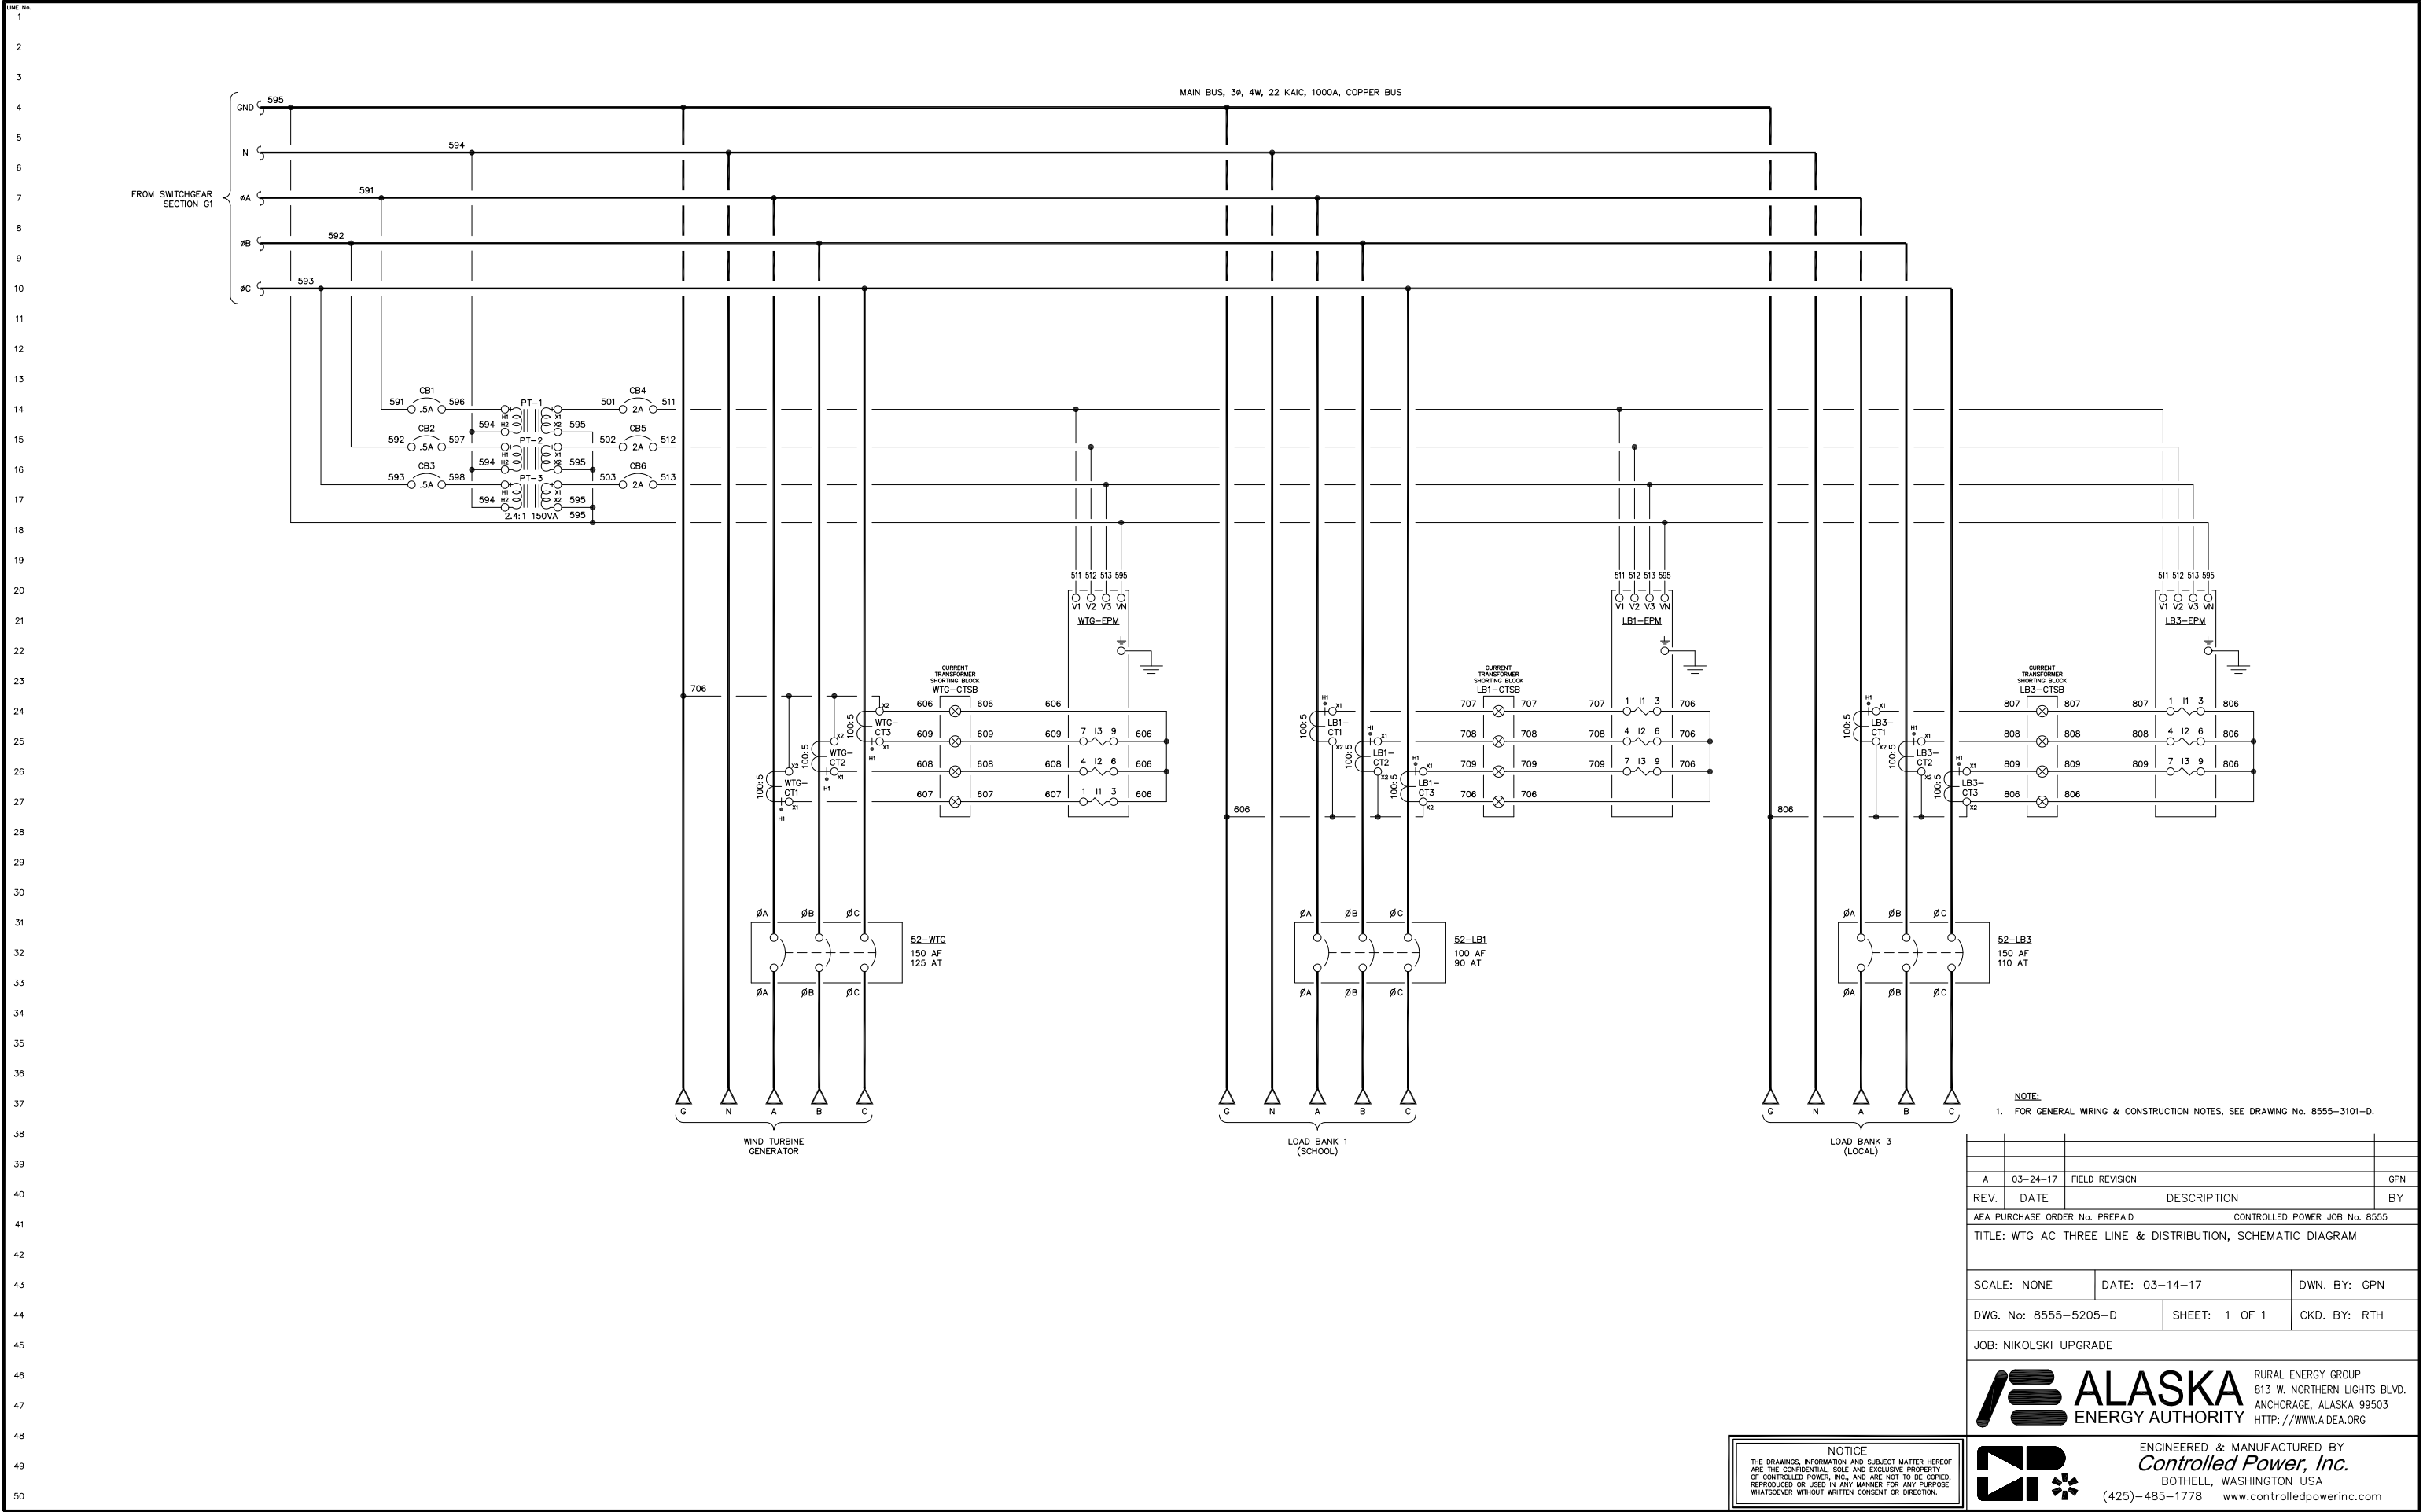


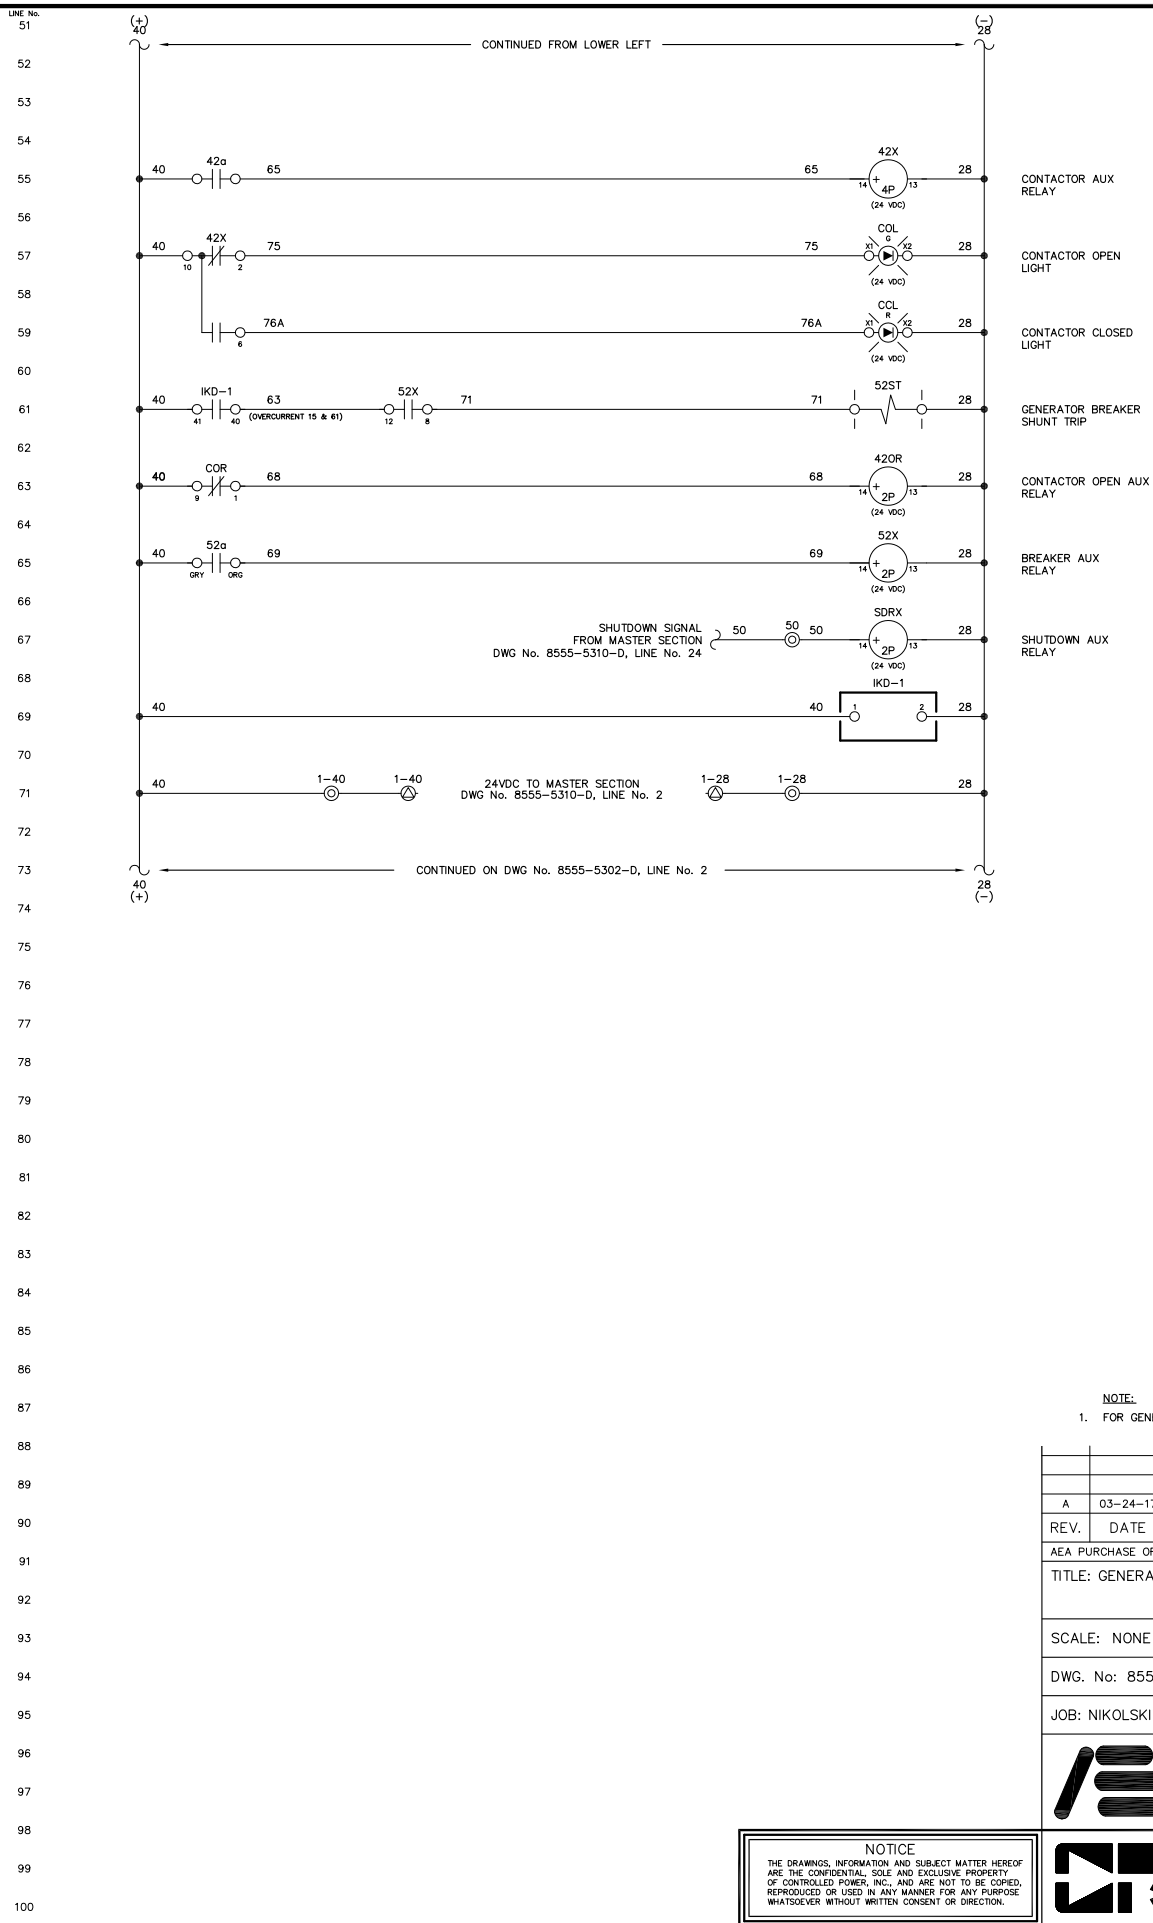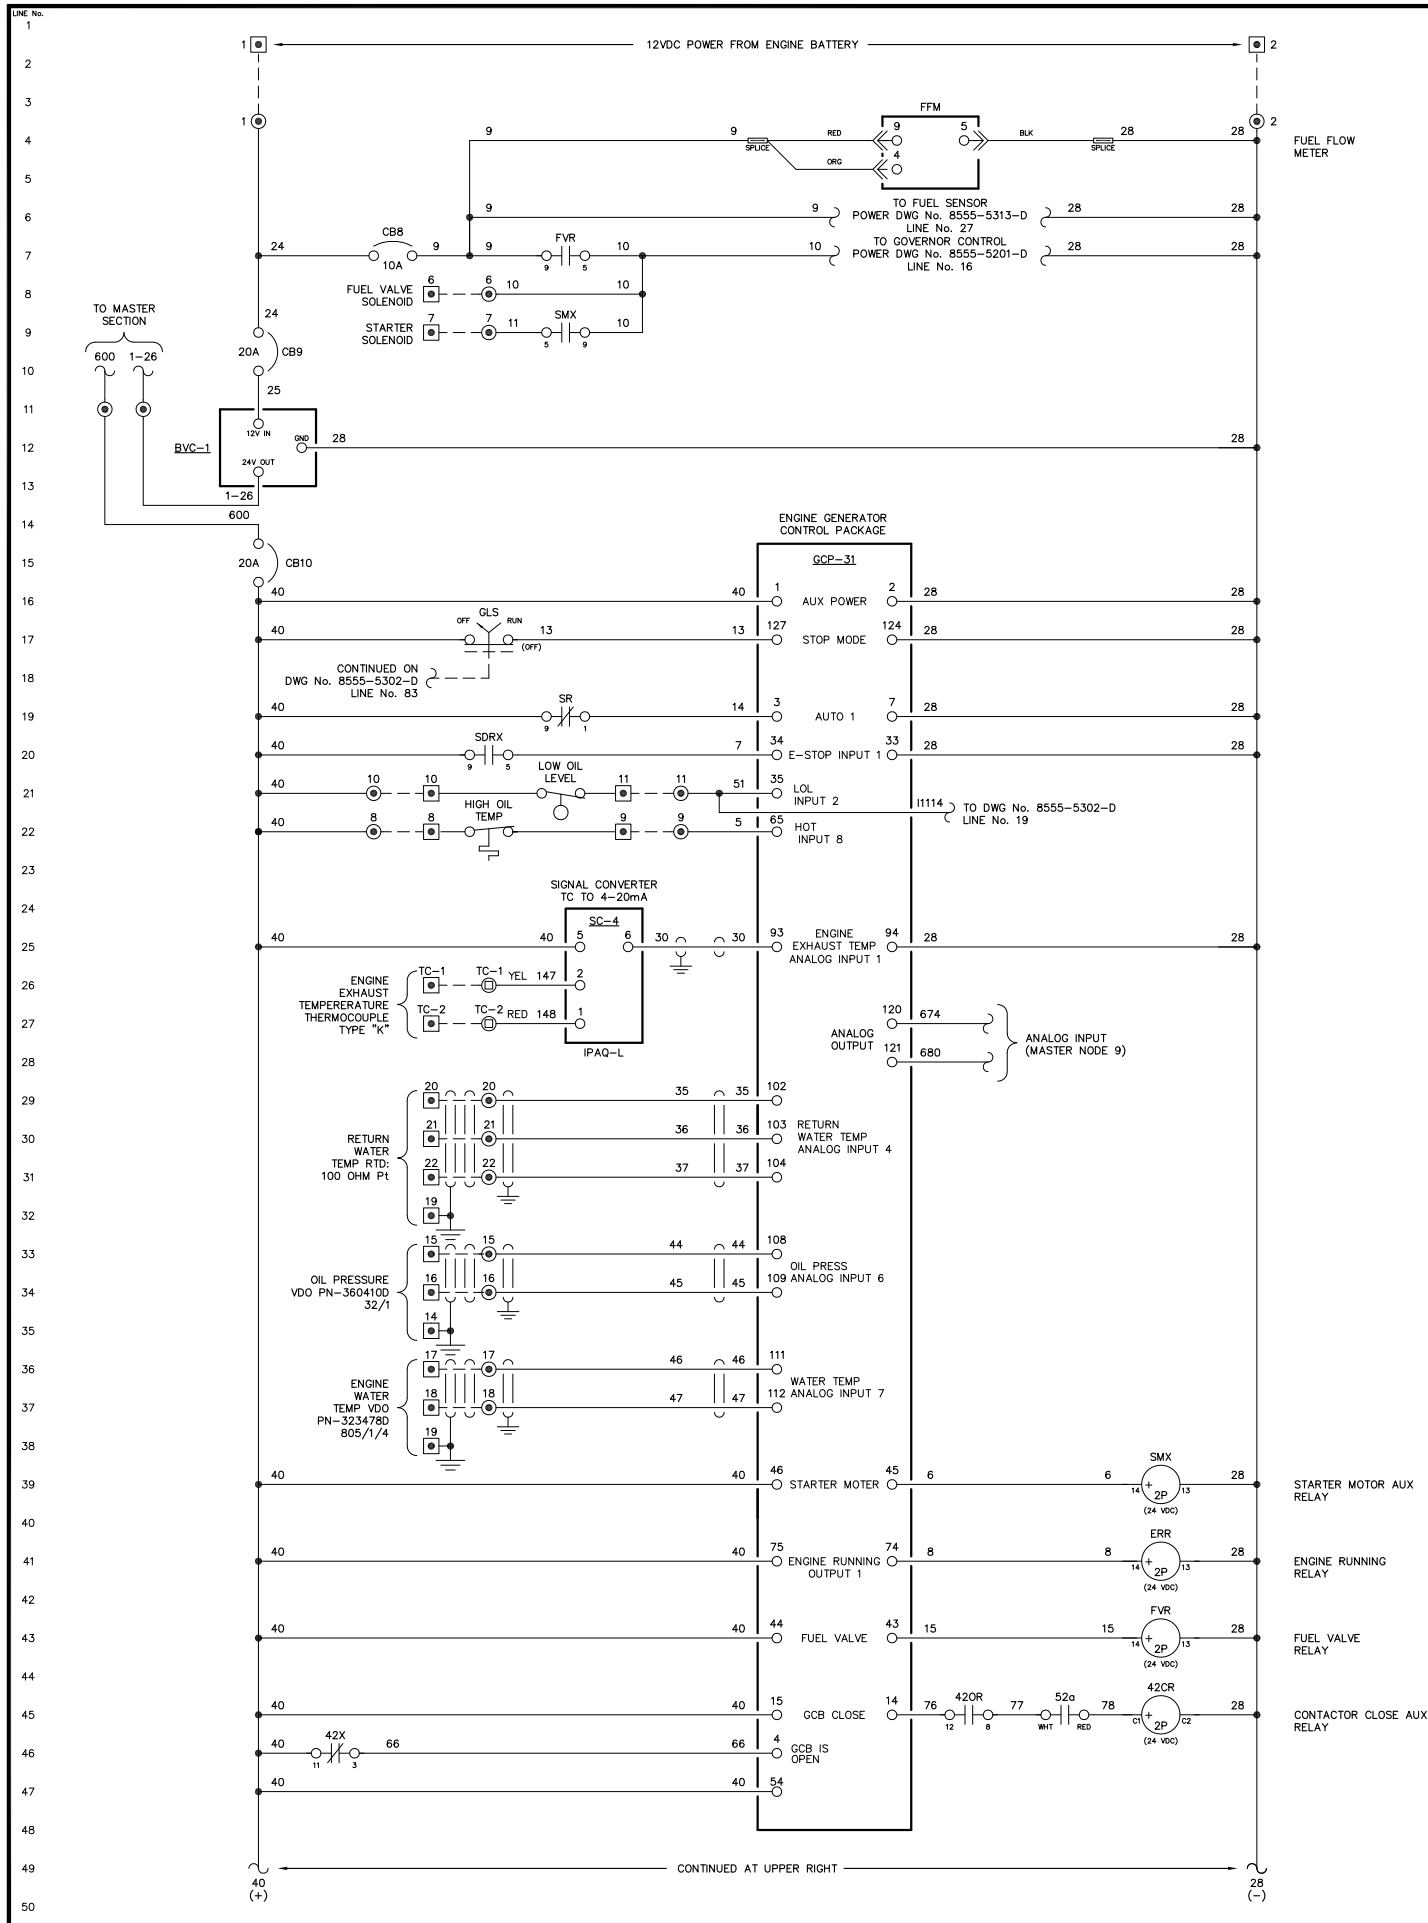

NOTE:
1. FOR GENERAL WIRING & CONSTRUCTION NOTES, SEE DRAWING No. 8555-3101-D.

A	03-24-17	FIELD REVISION	GPN
REV.	DATE	DESCRIPTION	BY
AEA PURCHASE ORDER No. PREPAID		CONTROLLED POWER JOB No. 8555	
TITLE: GENERATOR 1 DC CONTROL, SCHEMATIC DIAGRAM			
SCALE: NONE		DATE: 03-14-17	DWN. BY: GPN
DWG. No: 8555-5301-D		SHEET: 1 OF 1	CKD. BY: RTH
JOB: NIKOLSKI UPGRADE			
		RURAL ENERGY GROUP 813 W. NORTHERN LIGHTS BLVD. ANCHORAGE, ALASKA 99503 HTTP://WWW.AIDEA.ORG	
		ENGINEERED & MANUFACTURED BY <i>Controlled Power, Inc.</i> BOTHELL, WASHINGTON USA (425)-485-1778 www.controlledpowerinc.com	


NOTICE
THE DRAWINGS, INFORMATION AND SUBJECT MATTER HEREOF ARE THE CONFIDENTIAL, SOLE AND EXCLUSIVE PROPERTY OF CONTROLLED POWER, INC. AND ARE NOT TO BE COPIED, REPRODUCED OR USED IN ANY MANNER FOR ANY PURPOSE WHATSOEVER WITHOUT WRITTEN CONSENT OR DIRECTION.

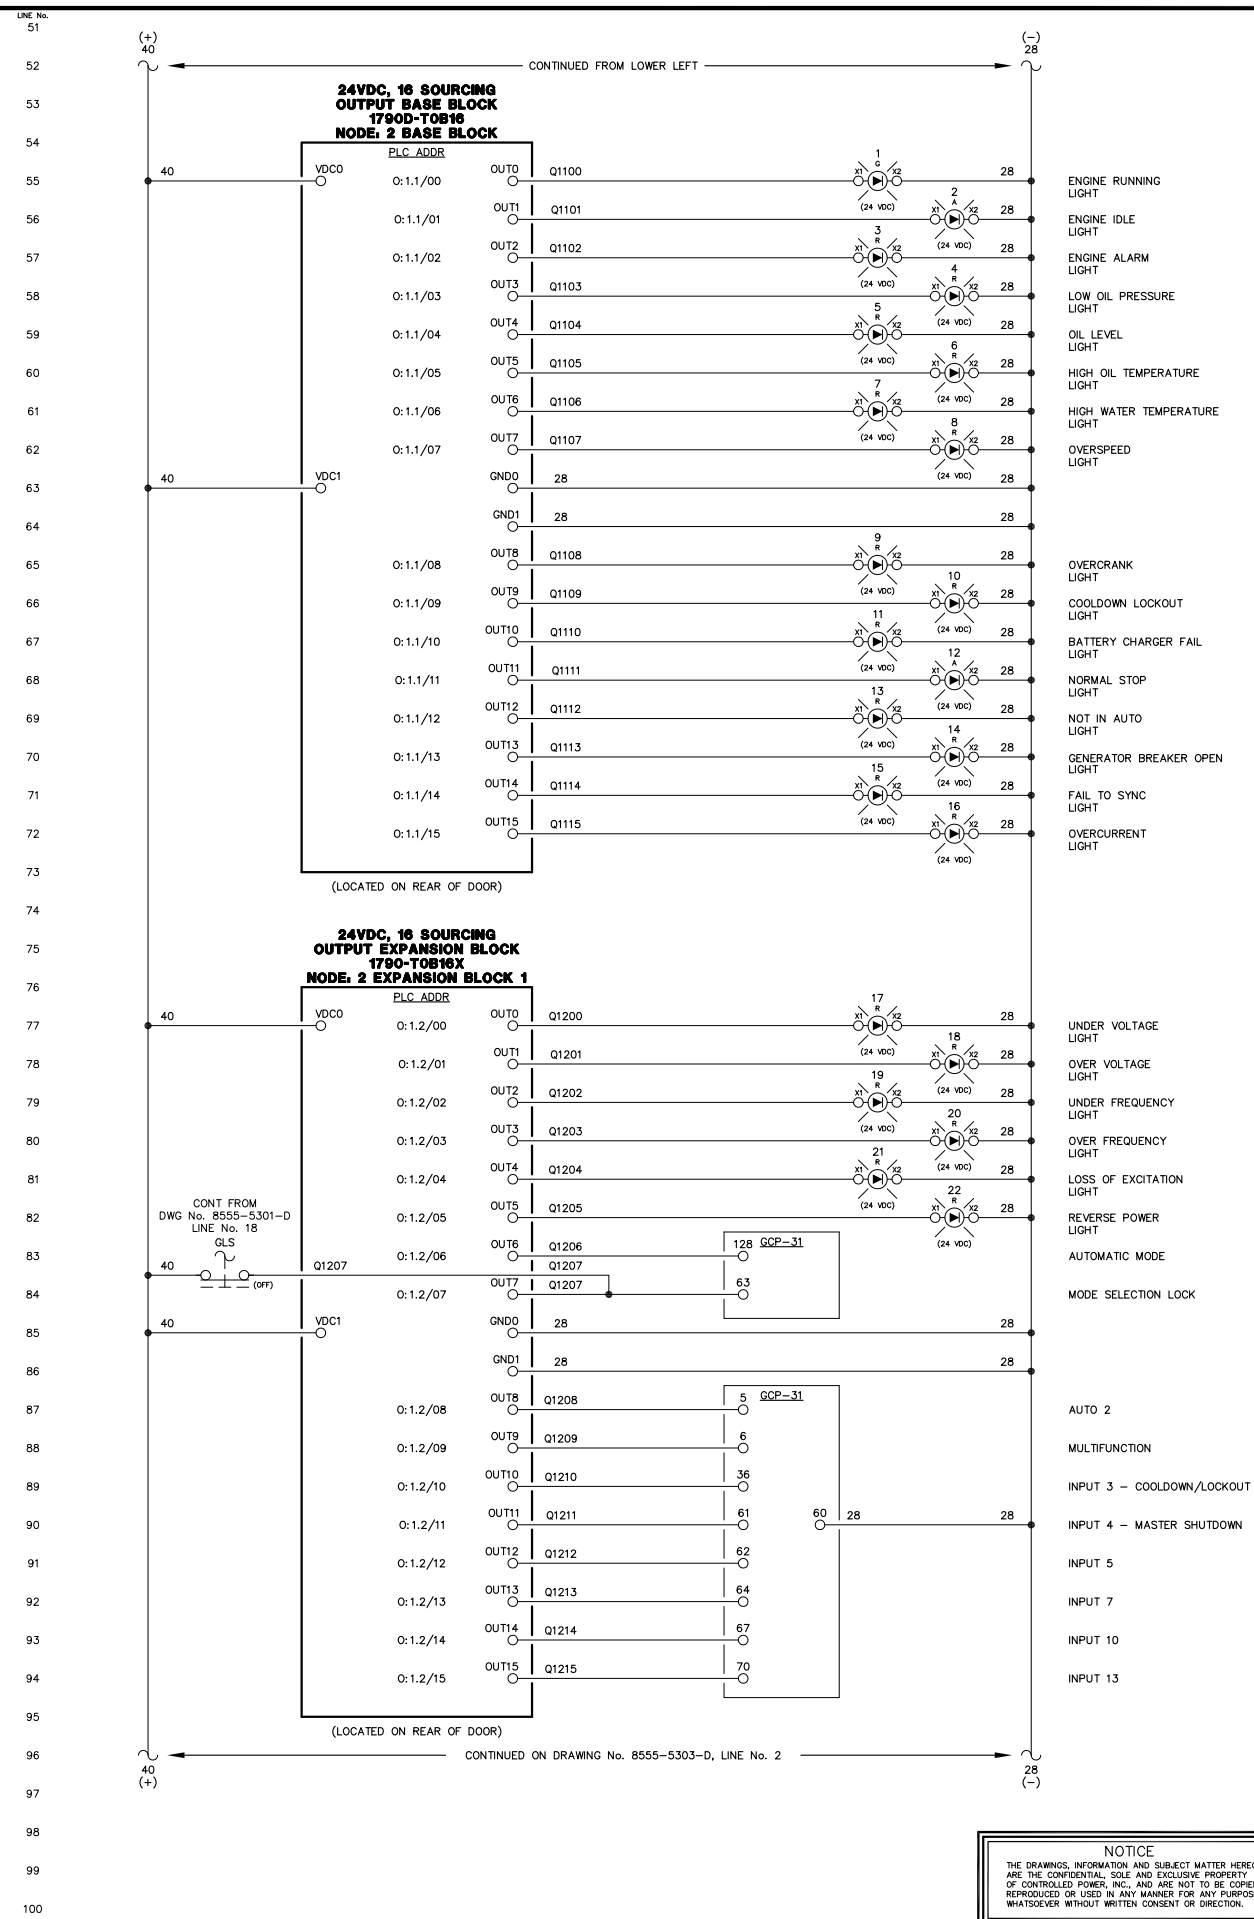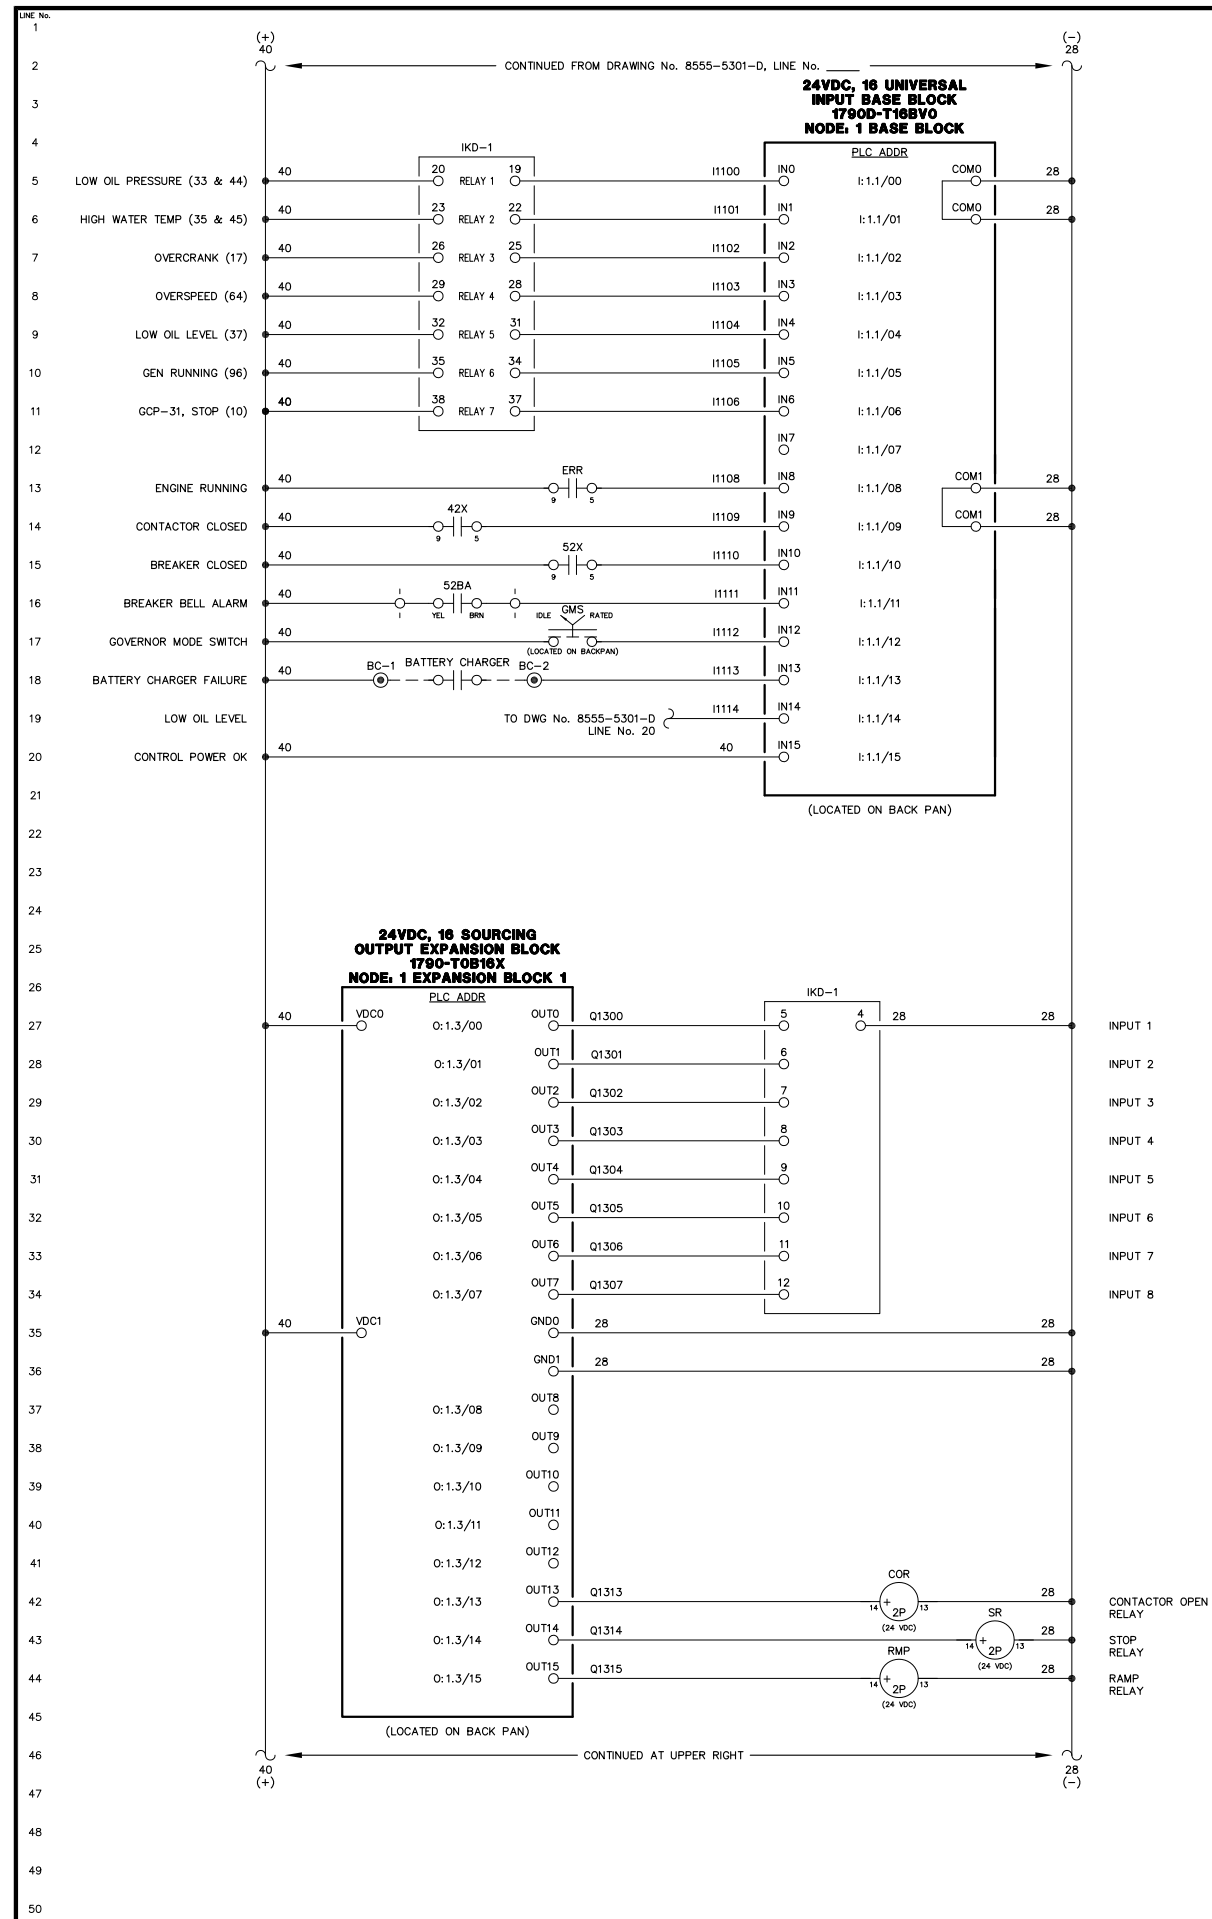




NOTICE

THE DRAWINGS, INFORMATION AND SUBJECT MATTER HEREOF ARE THE CONFIDENTIAL, SOLE AND EXCLUSIVE PROPERTY OF CONTROLLED POWER, INC., AND ARE NOT TO BE COPIED, REPRODUCED OR USED IN ANY MANNER FOR ANY PURPOSE WHATSOEVER WITHOUT WRITTEN CONSENT OR DIRECTION.

NOTE:			
1. FOR GENERAL WIRING & CONSTRUCTION NOTES, SEE DRAWING No. 8555-3101-D.			
A	03-24-17	FIELD REVISION	GPN
REV.	DATE	DESCRIPTION	BY
AEA PURCHASE ORDER No. PREPAID		CONTROLLED POWER JOB No. 8555	
TITLE: GENERATOR 1 DC CONTROL, SCHEMATIC DIAGRAM			
SCALE: NONE		DATE: 03-14-17	DWN. BY: GPN
DWG. No: 8555-5302-D		SHEET: 1 OF 1	CKD. BY: RTH
JOB: NIKOLSKI UPGRADE			
		RURAL ENERGY GROUP 813 W. NORTHERN LIGHTS BLVD. ANCHORAGE, ALASKA 99503 HTTP://WWW.AIDEA.ORG	
		ENGINEERED & MANUFACTURED BY <i>Controlled Power, Inc.</i> BOTHELL, WASHINGTON USA (425)-485-1778 www.controlledpowerinc.com	

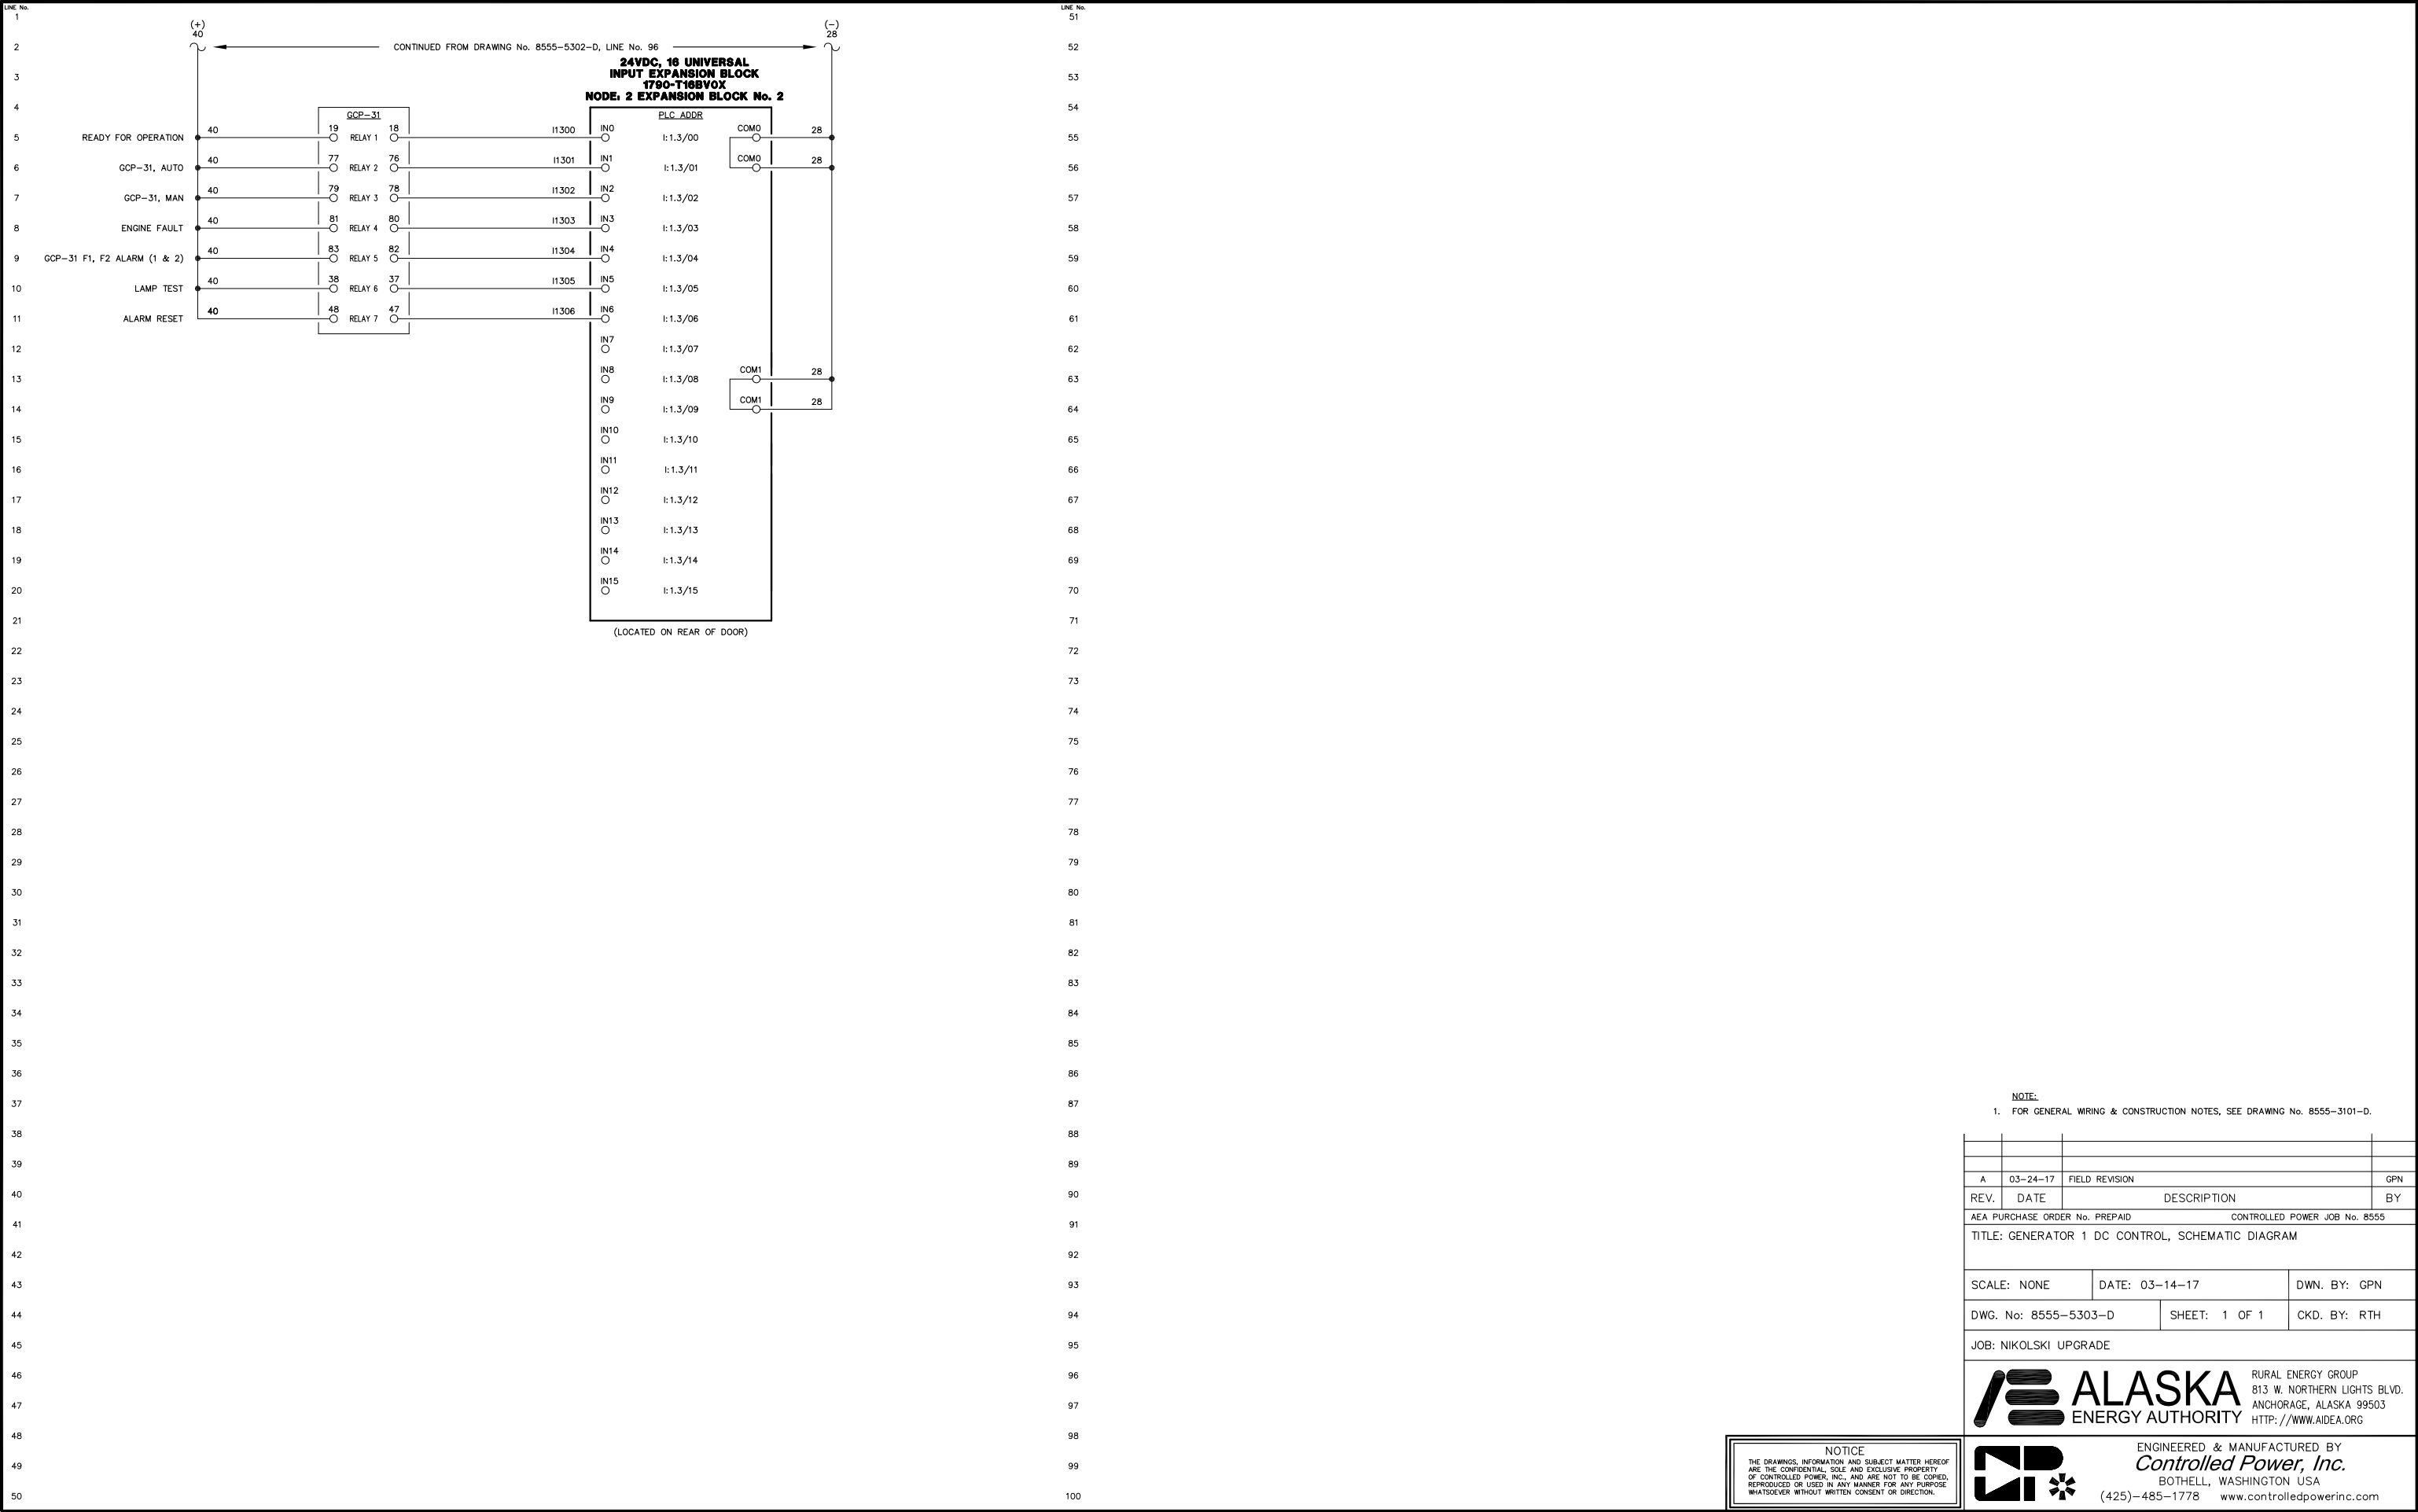

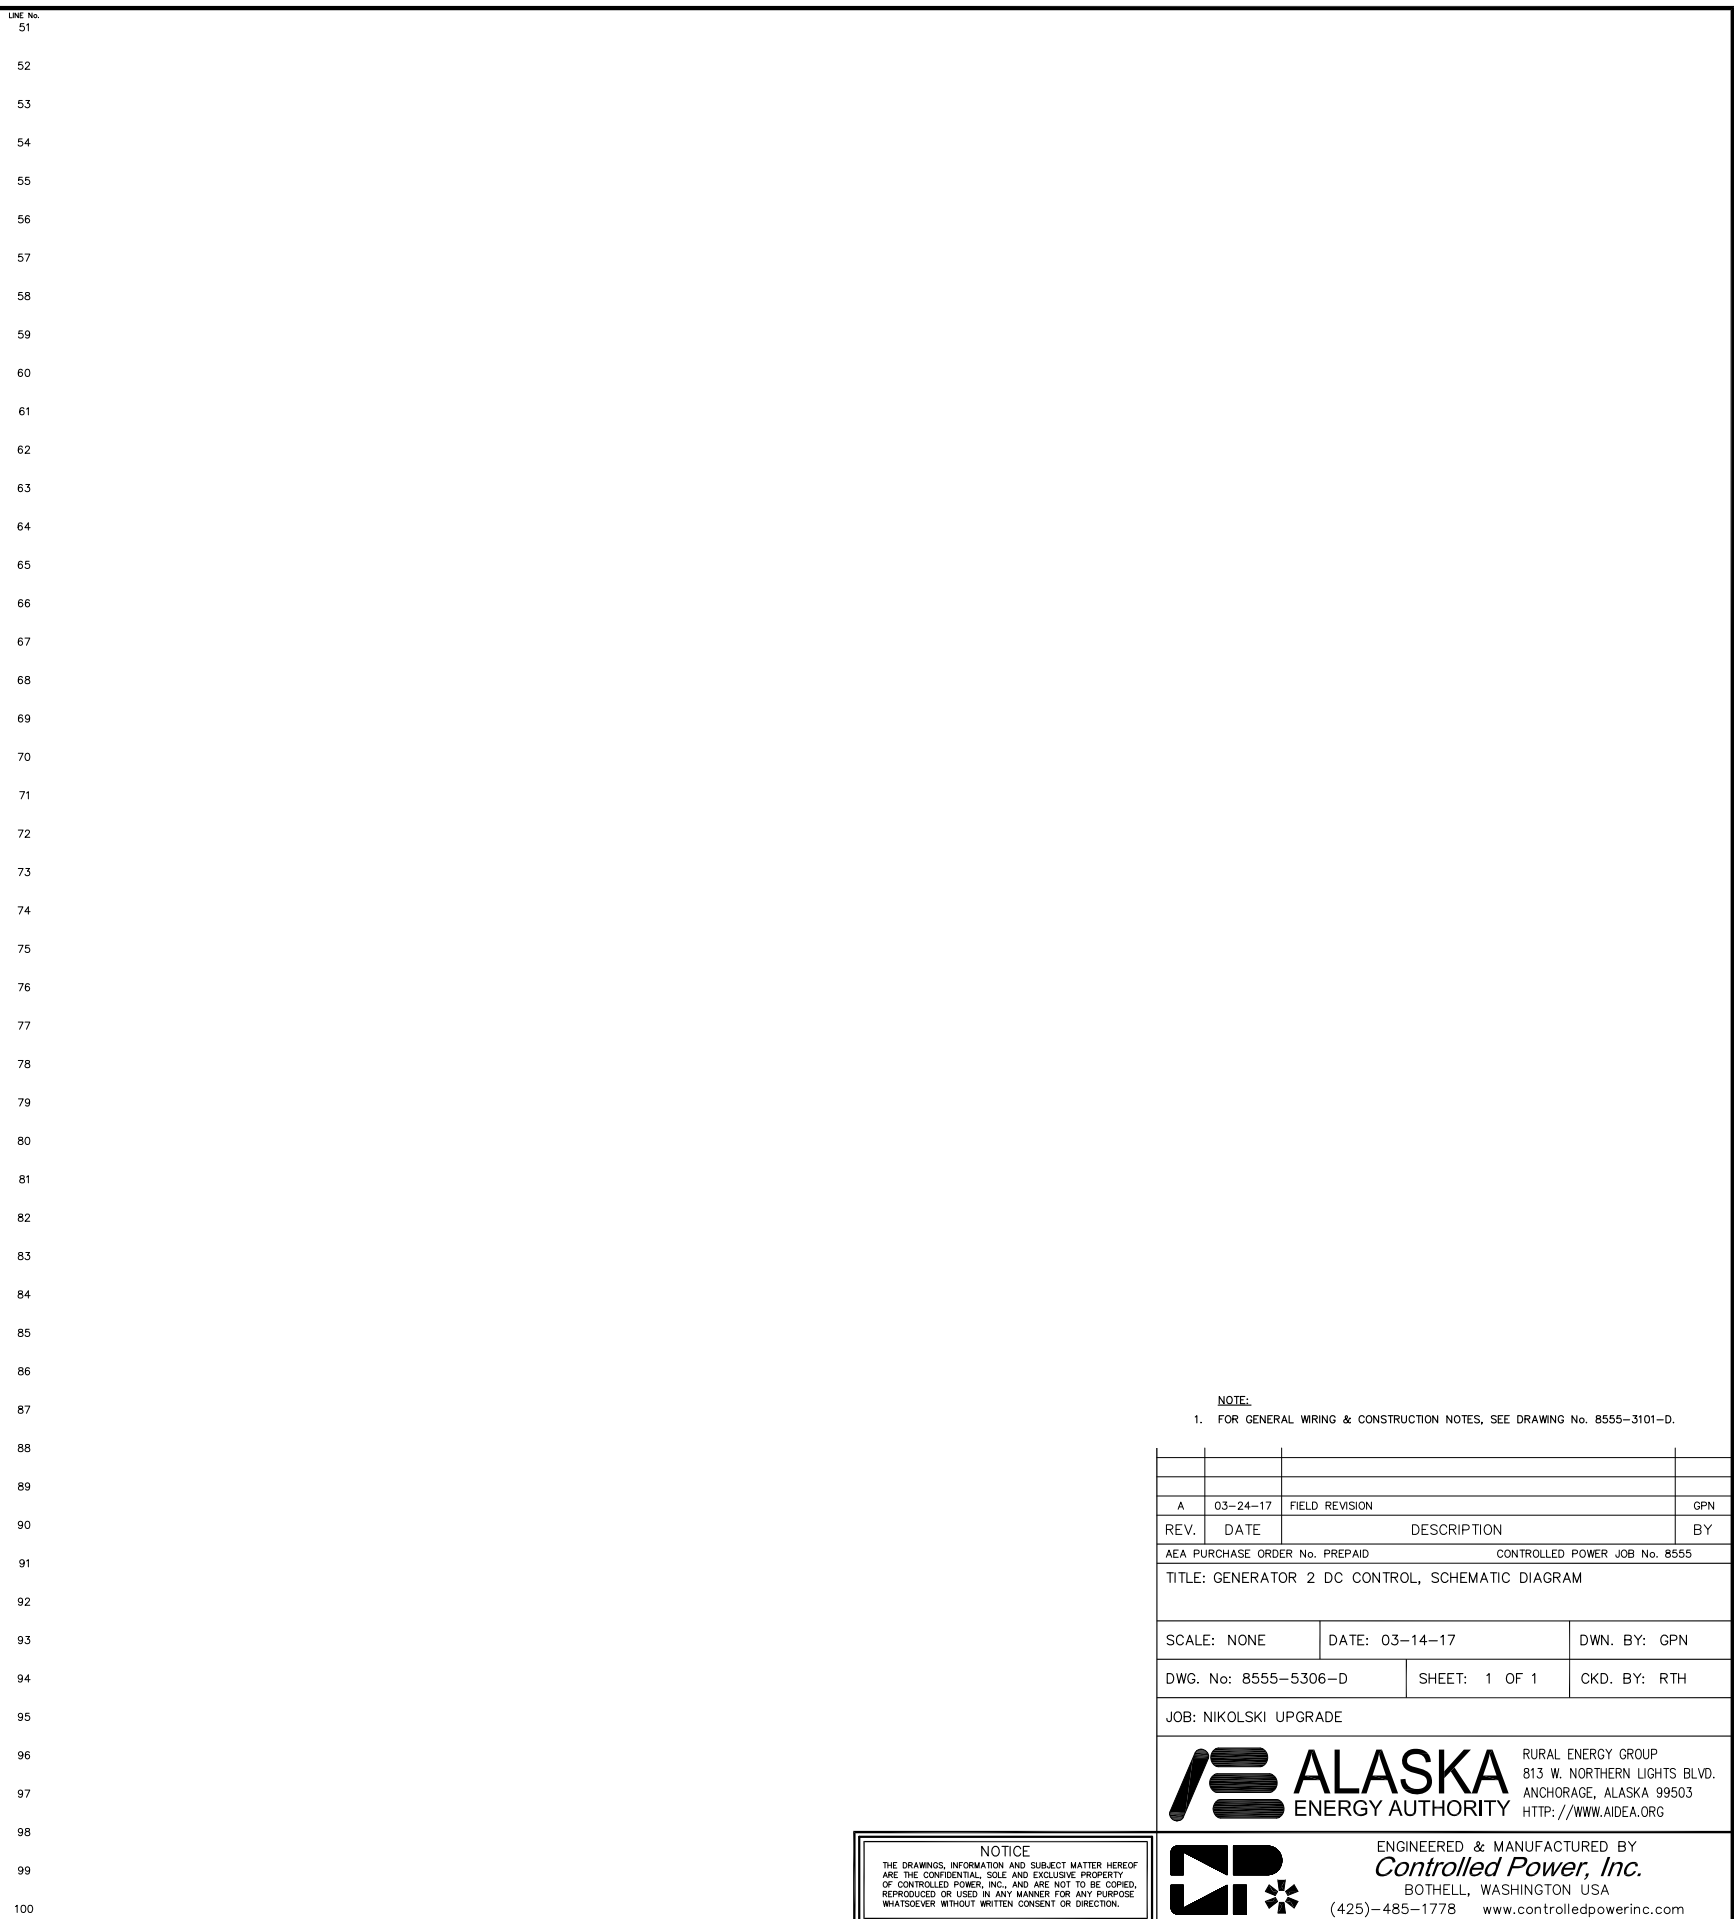


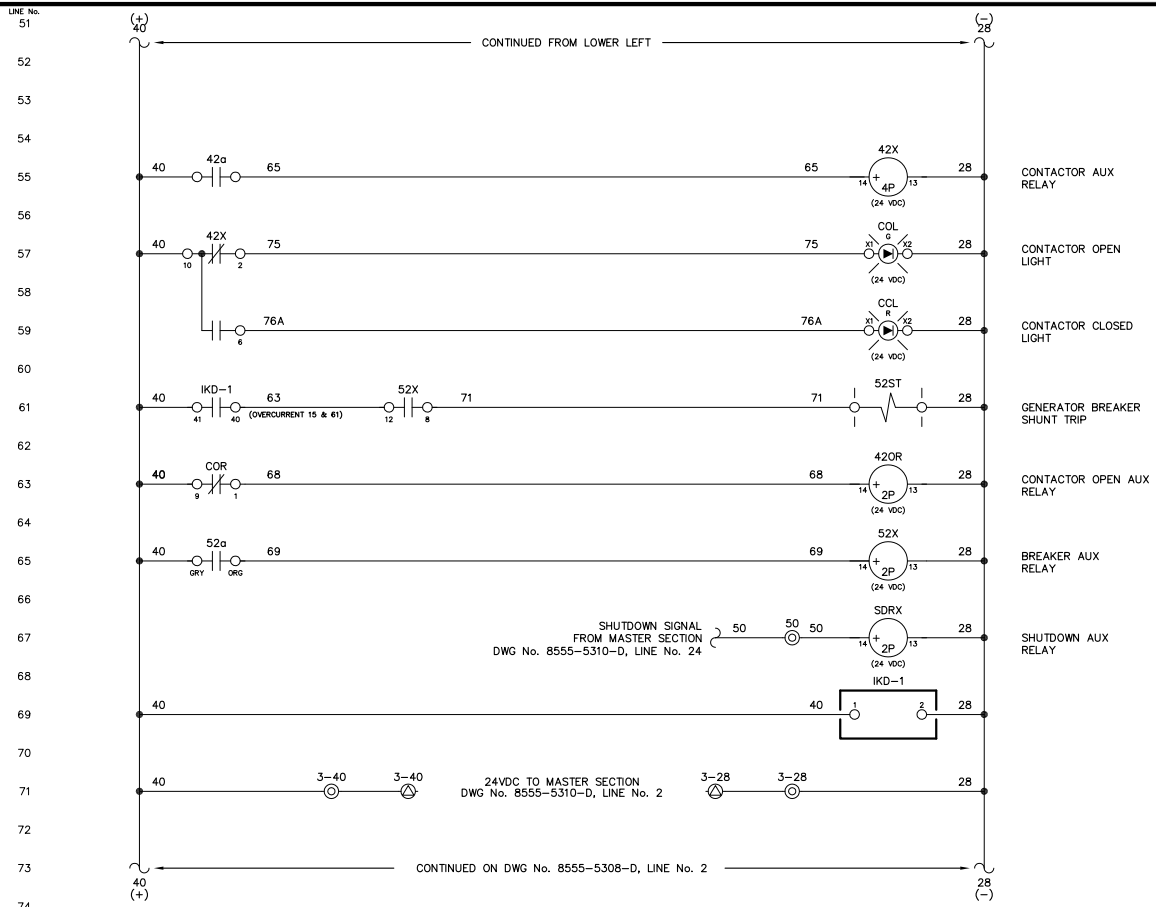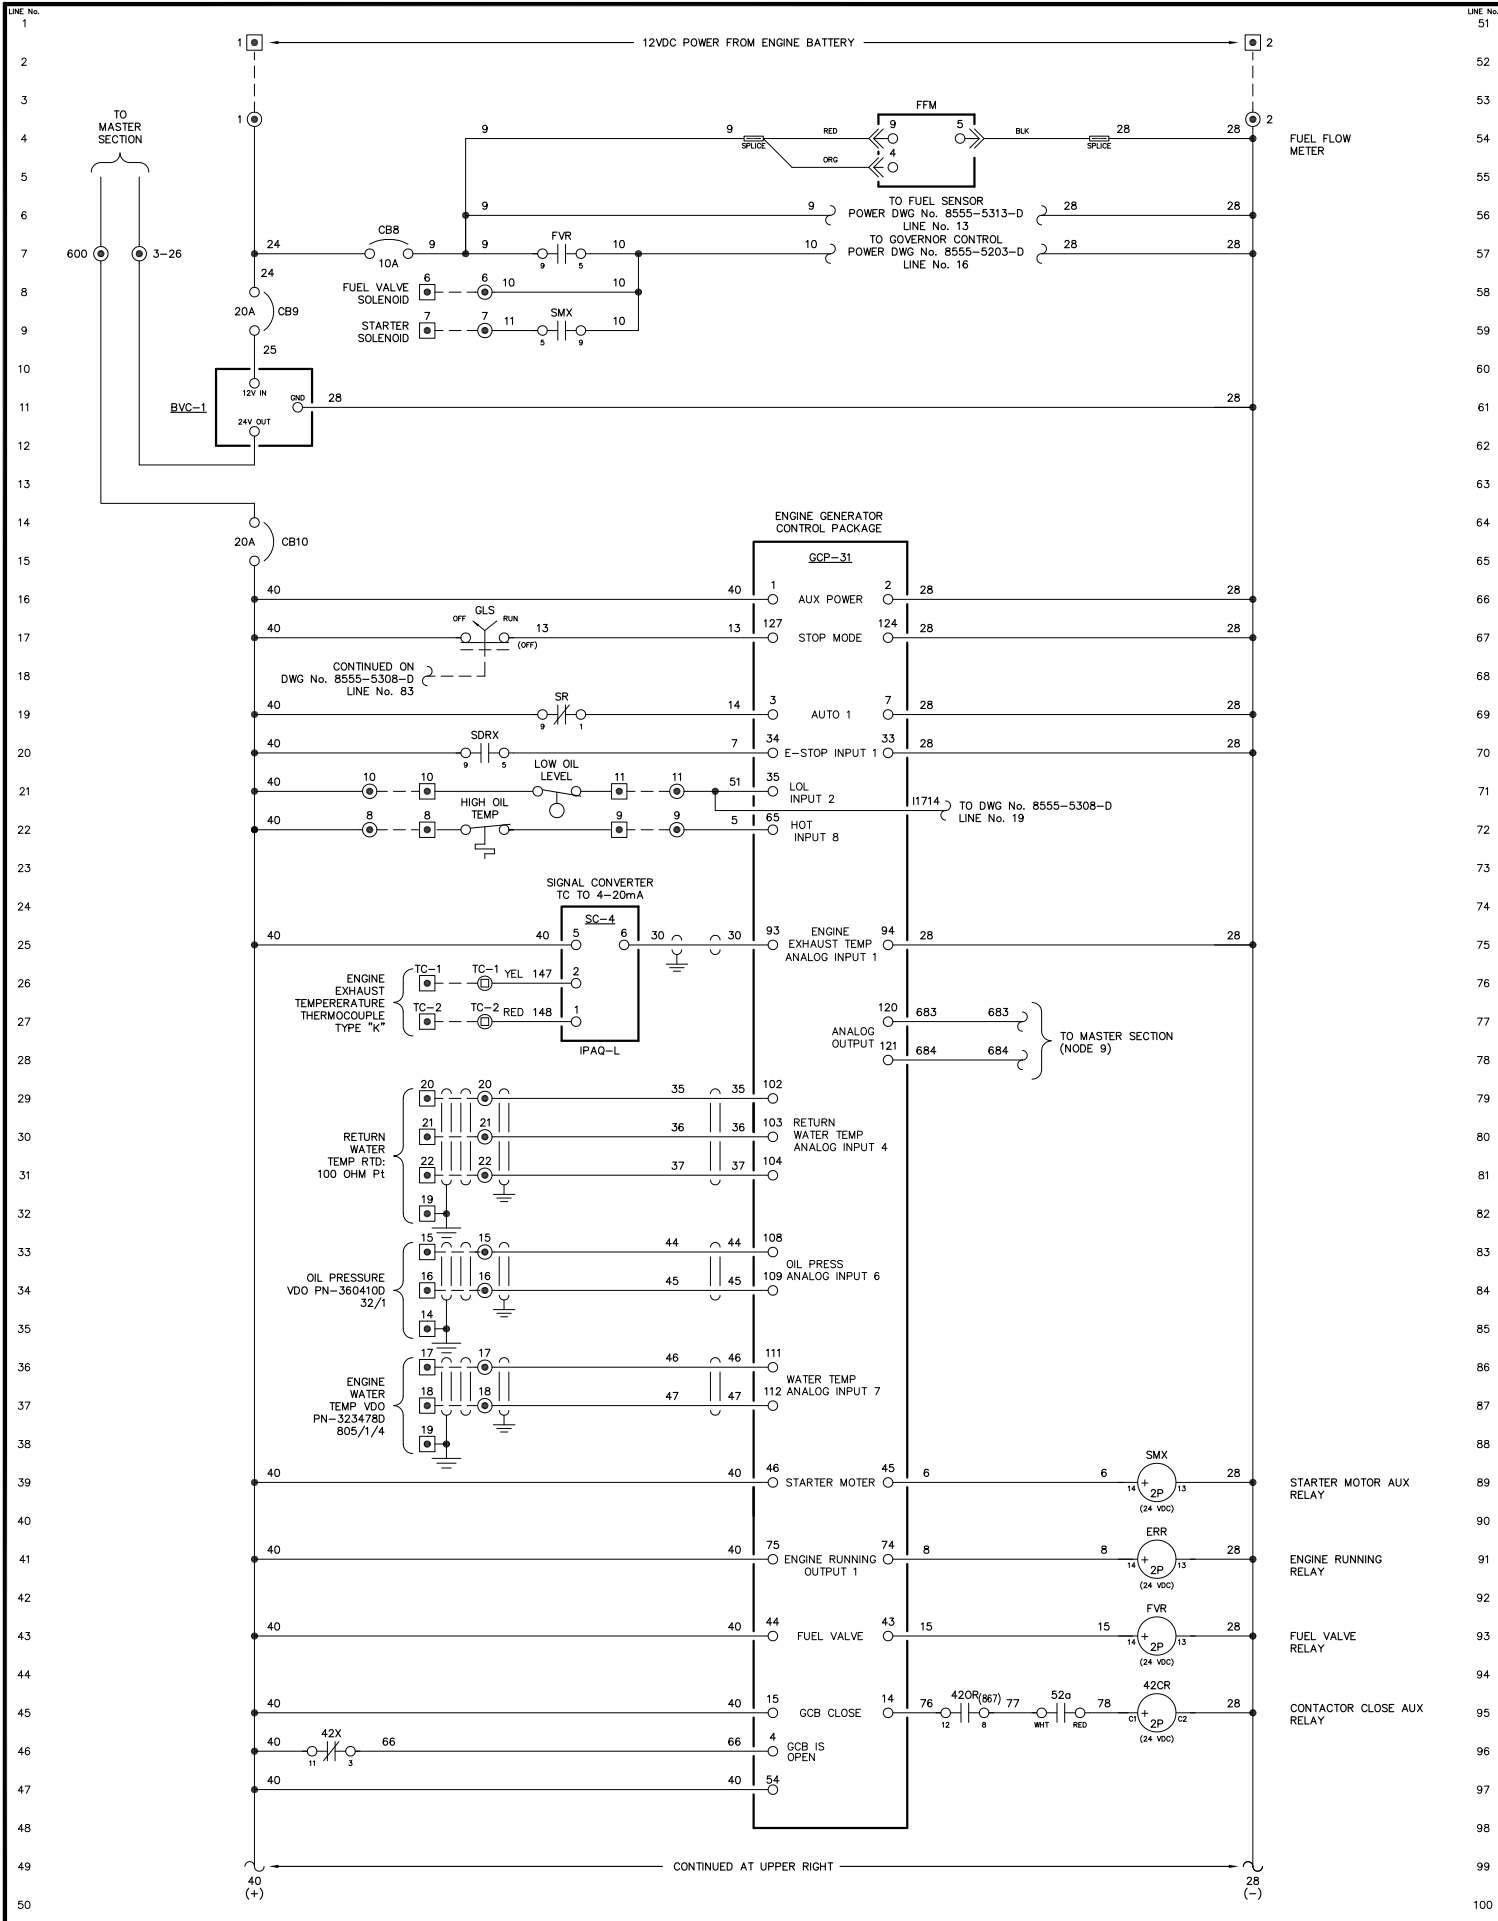

NOTE:
1. FOR GENERAL WIRING & CONSTRUCTION NOTES, SEE DRAWING No. 8555-3101-D.



A	03-24-17	FIELD REVISION			GPN
REV.	DATE	DESCRIPTION			BY
AEA PURCHASE ORDER No. PREPAID			CONTROLLED POWER JOB No. 8555		
TITLE: GENERATOR 3 DC CONTROL, SCHEMATIC DIAGRAM					
SCALE: NONE		DATE: 03-14-17		DWN. BY: GPN	
DWG. No: 8555-5307-D		SHEET: 1 OF 1		CKD. BY: RTH	
JOB: NIKOLSKI UPGRADE					
		ALASKA		RURAL ENERGY GROUP 813 W. NORTHERN LIGHTS BLVD. ANCHORAGE, ALASKA 99503 HTTP://WWW.AIDEA.ORG	
		ENGINEERED & MANUFACTURED BY <i>Controlled Power, Inc.</i> BOTHELL, WASHINGTON USA (425)-485-1778 www.controlledpowerinc.com			

NOTICE
THE DRAWINGS, INFORMATION AND SUBJECT MATTER HEREOF ARE THE CONFIDENTIAL, SOLE AND EXCLUSIVE PROPERTY OF CONTROLLED POWER, INC., AND ARE NOT TO BE COPIED, REPRODUCED OR USED IN ANY MANNER FOR ANY PURPOSE WHATSOEVER WITHOUT WRITTEN CONSENT OR DIRECTION.

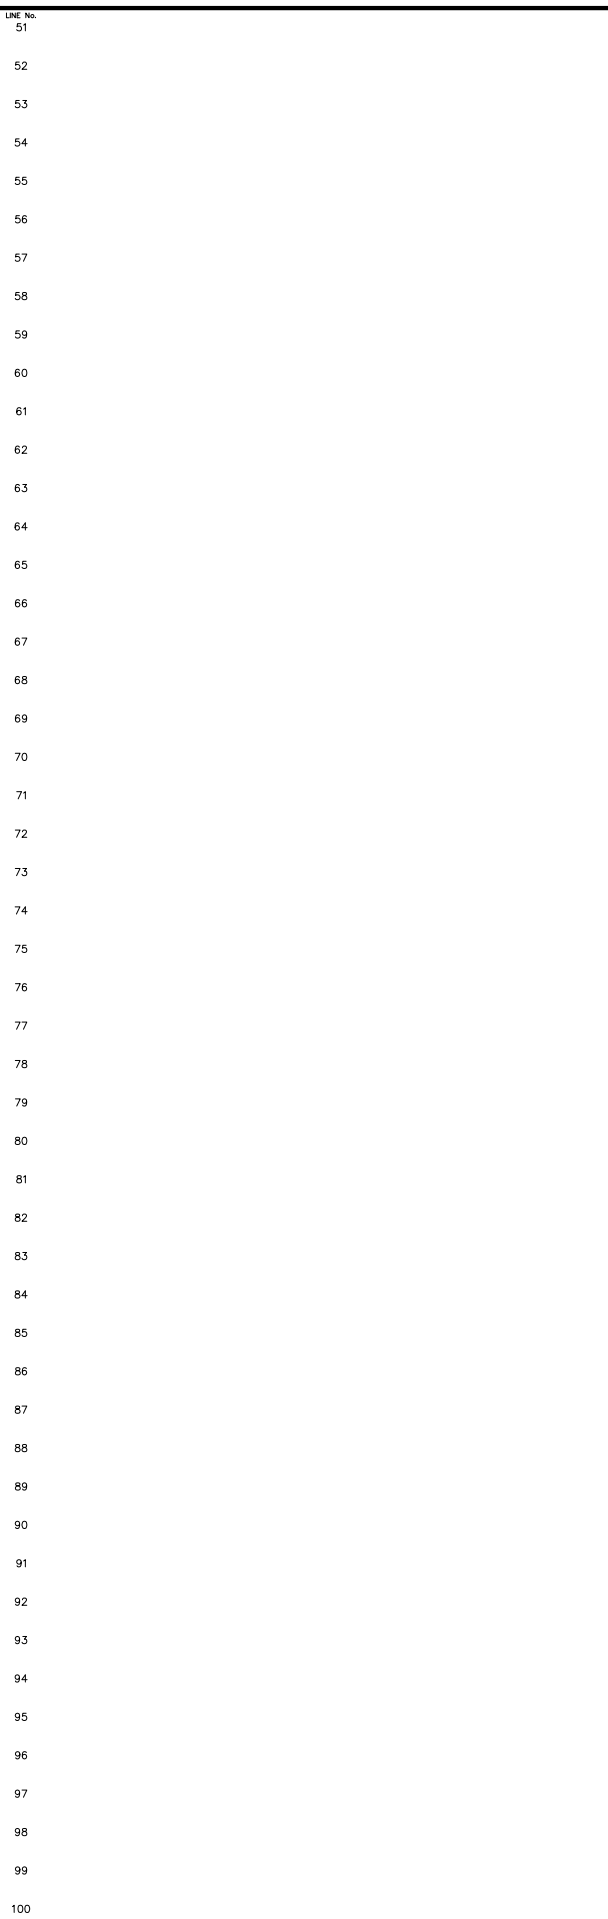

A	03-24-17	FIELD REVISION			GPN
REV.	DATE	DESCRIPTION			BY
AEA PURCHASE ORDER No. PREPAID			CONTROLLED POWER JOB No. 8555		
TITLE: GENERATOR 3 DC CONTROL, SCHEMATIC DIAGRAM					
SCALE: NONE		DATE: 03-14-17		DWN. BY: GPN	
DWG. No: 8555-5309-D		SHEET: 1 OF 1		CKD. BY: RTH	
JOB: NIKOLSKI UPGRADE					
 ALASKA ENERGY AUTHORITY			RURAL ENERGY GROUP 813 W. NORTHERN LIGHTS BLVD. ANCHORAGE, ALASKA 99503 HTTP://WWW.AIDEA.ORG		



 ENGINEERED & MANUFACTURED BY
Controlled Power, Inc.
BOTHELL, WASHINGTON USA
(425)-485-1778 www.controlledpowerinc.com

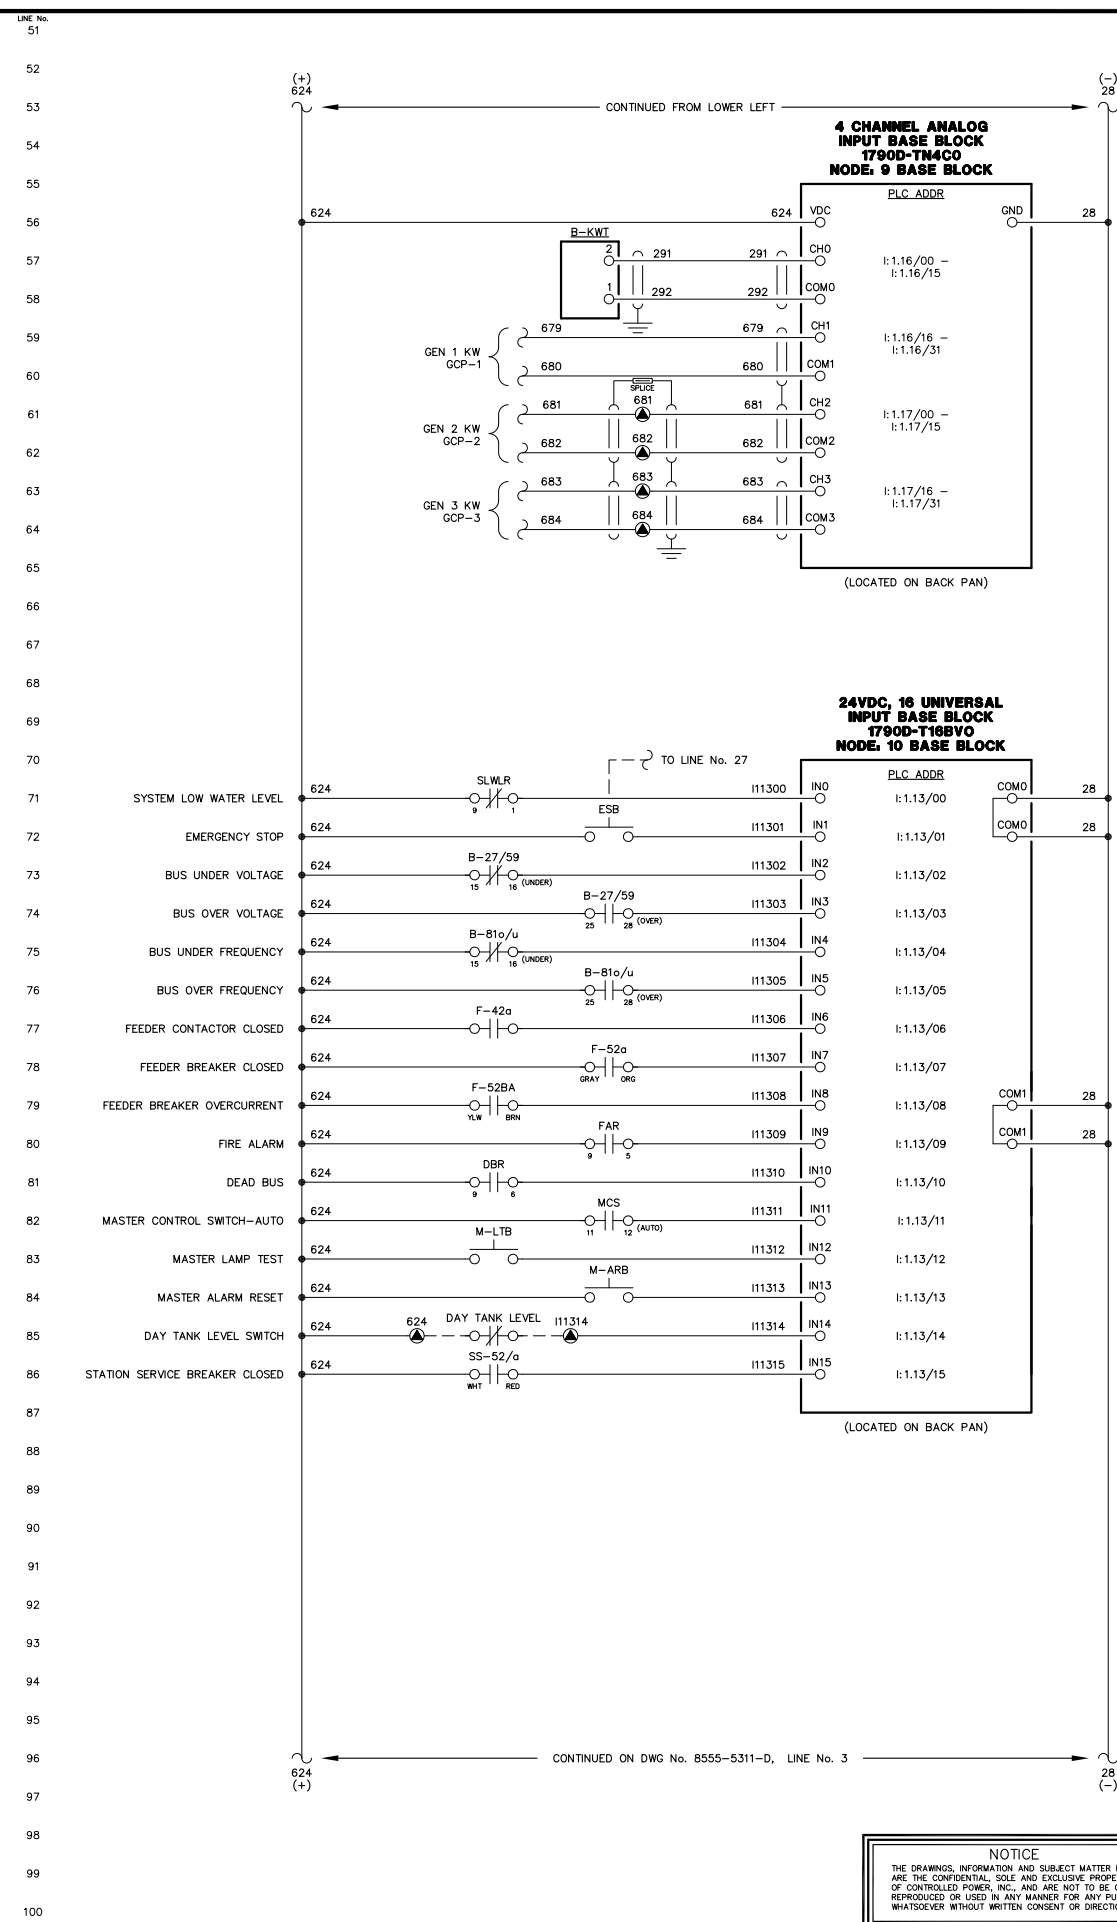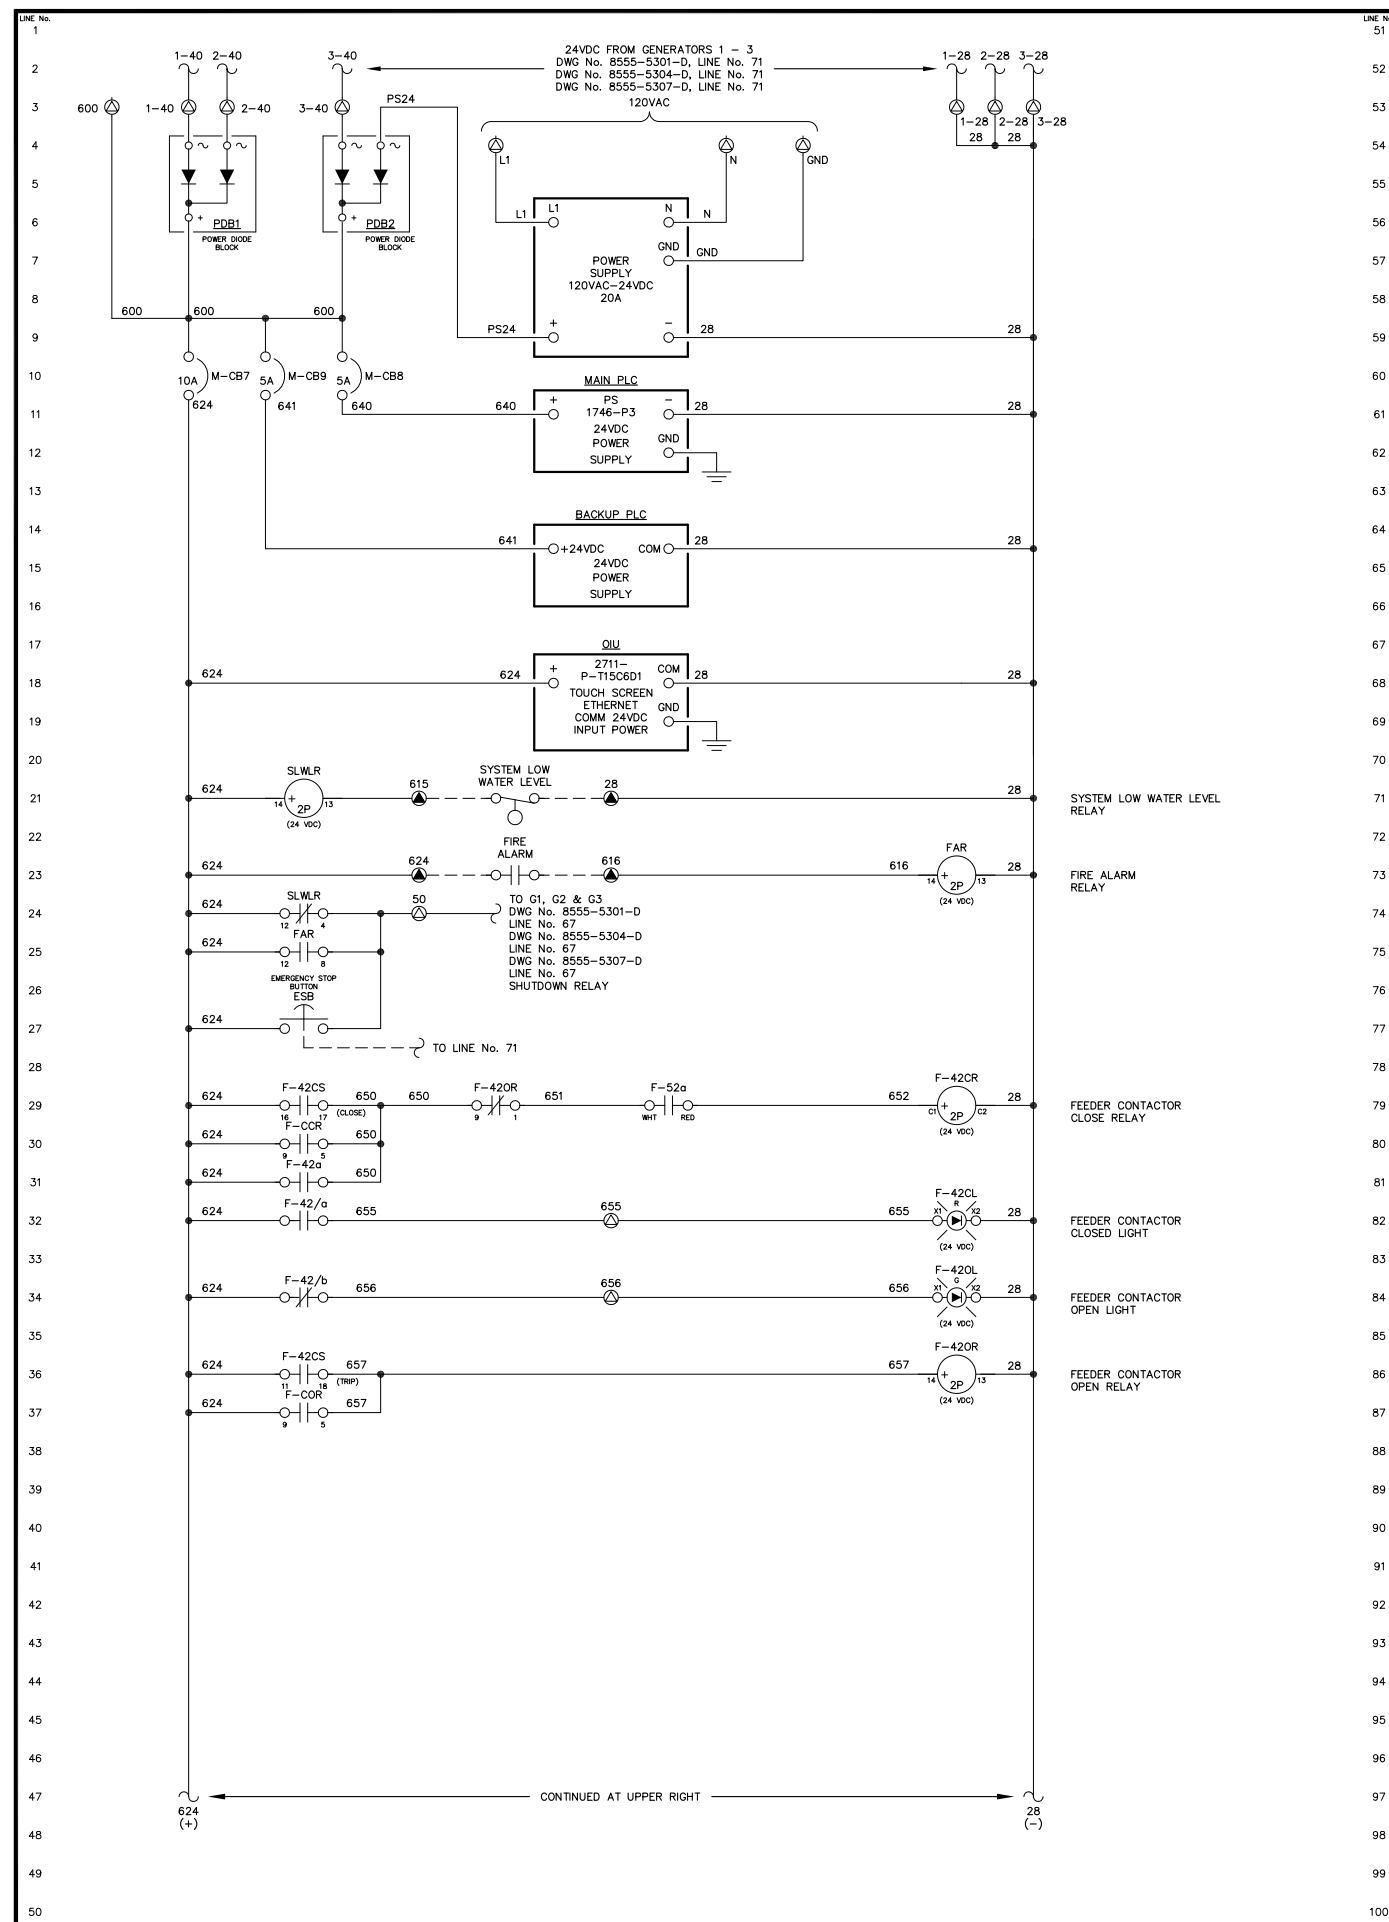

NOTE:

1. FOR GENERAL WIRING & CONSTRUCTION NOTES, SEE DRAWING No. 8555-3101-D.

A	03-24-17	FIELD REVISION	GP#
REV.	DATE	DESCRIPTION	BY
AEA PURCHASE ORDER No. PREPAID		CONTROLLED POWER JOB No. 8555	
TITLE: MASTER DC CONTROL, SCHEMATIC DIAGRAM			
SCALE: NONE		DATE: 03-14-17	DWN. BY: GPN
DWG. No: 8555-5310-D		SHEET: 1 OF 1	CKD. BY: RTH
JOB: NIKOLSKI UPGRADE			
		RURAL ENERGY GROUP 813 W. NORTHERN LIGHTS BLVD. ANCHORAGE, ALASKA 99503 HTTP://WWW.AIDEA.ORG	
		ENGINEERED & MANUFACTURED BY <i>Controlled Power, Inc.</i> BOTHELL, WASHINGTON USA (425)-485-1778 www.controlledpowerinc.com	

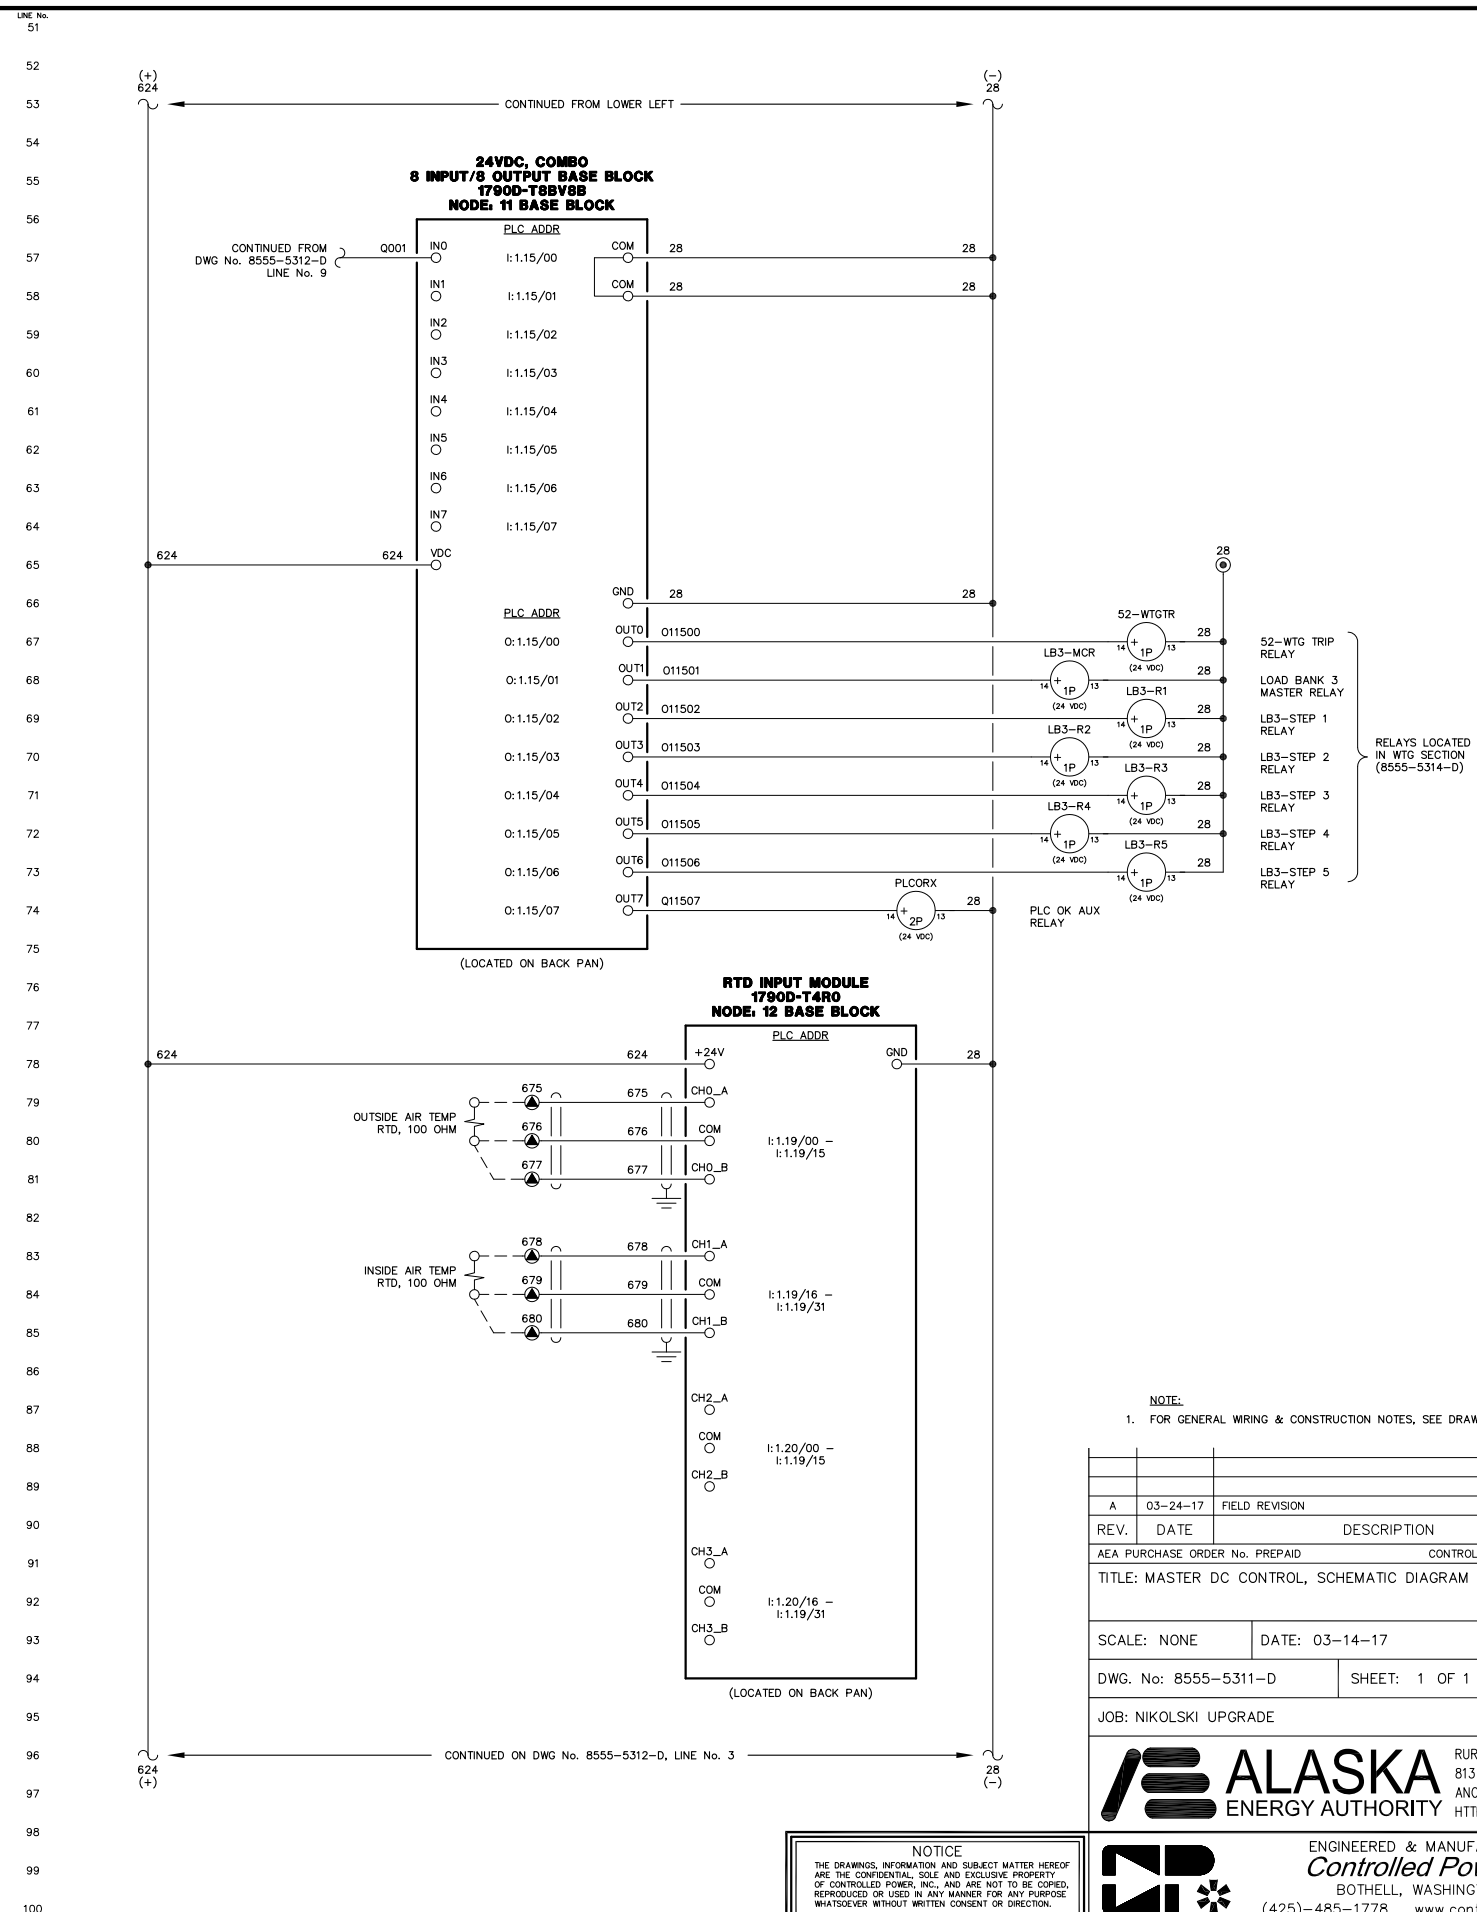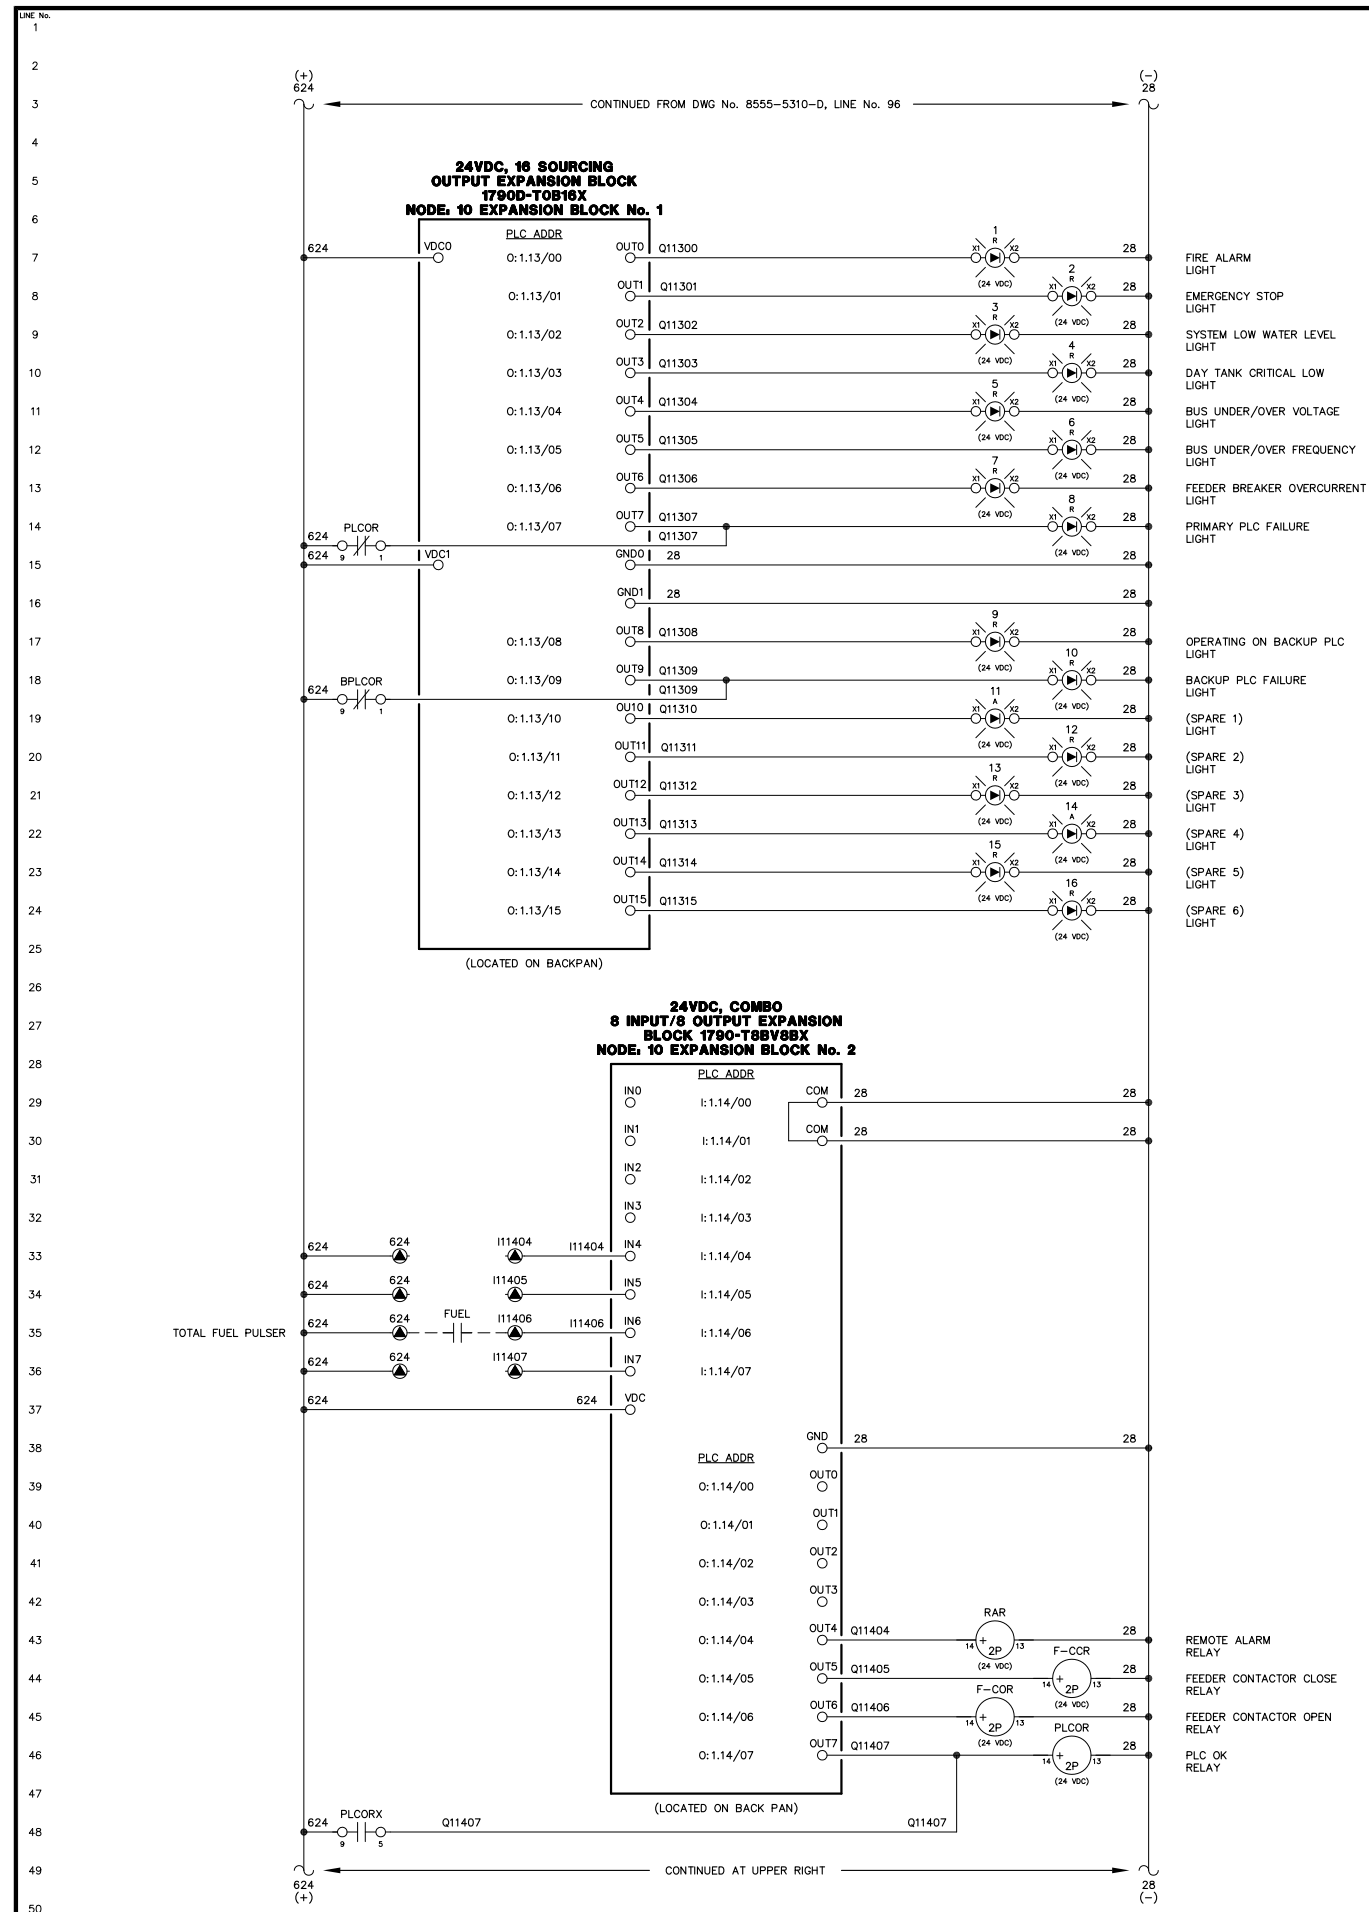

A	03-24-17	FIELD REVISION	GNP
REV.	DATE	DESCRIPTION	BY
AEA PURCHASE ORDER No. PREPAID		CONTROLLED POWER JOB No. 8555	
TITLE: MASTER DC CONTROL, SCHEMATIC DIAGRAM			
SCALE: NONE		DATE: 03-14-17	DWN. BY: GNP
DWG. No: 8555-5311-D		SHEET: 1 OF 1	CKD. BY: RTH
JOB: NIKOLSKI UPGRADE			




ALASKA
 ENERGY AUTHORITY

RURAL ENERGY GROUP
 813 W. NORTHERN LIGHTS BLVD.
 ANCHORAGE, ALASKA 99503
 HTTP://WWW.AIDEA.ORG



ENGINEERED & MANUFACTURED BY
Controlled Power, Inc.
BOTHELL, WASHINGTON USA
(425)-485-1778 www.controlledpowerinc.com

NOTICE
THE DRAWINGS, INFORMATION AND SUBJECT MATTER HEREON
ARE THE CONFIDENTIAL, SOLE AND EXCLUSIVE PROPERTY
OF CONTROLLED POWER, INC., AND ARE NOT TO BE COPIED,
REPRODUCED OR USED IN ANY MANNER FOR ANY PURPOSE
WHATSOEVER WITHOUT WRITTEN CONSENT OR DIRECTION.

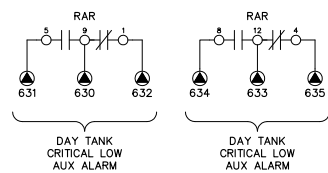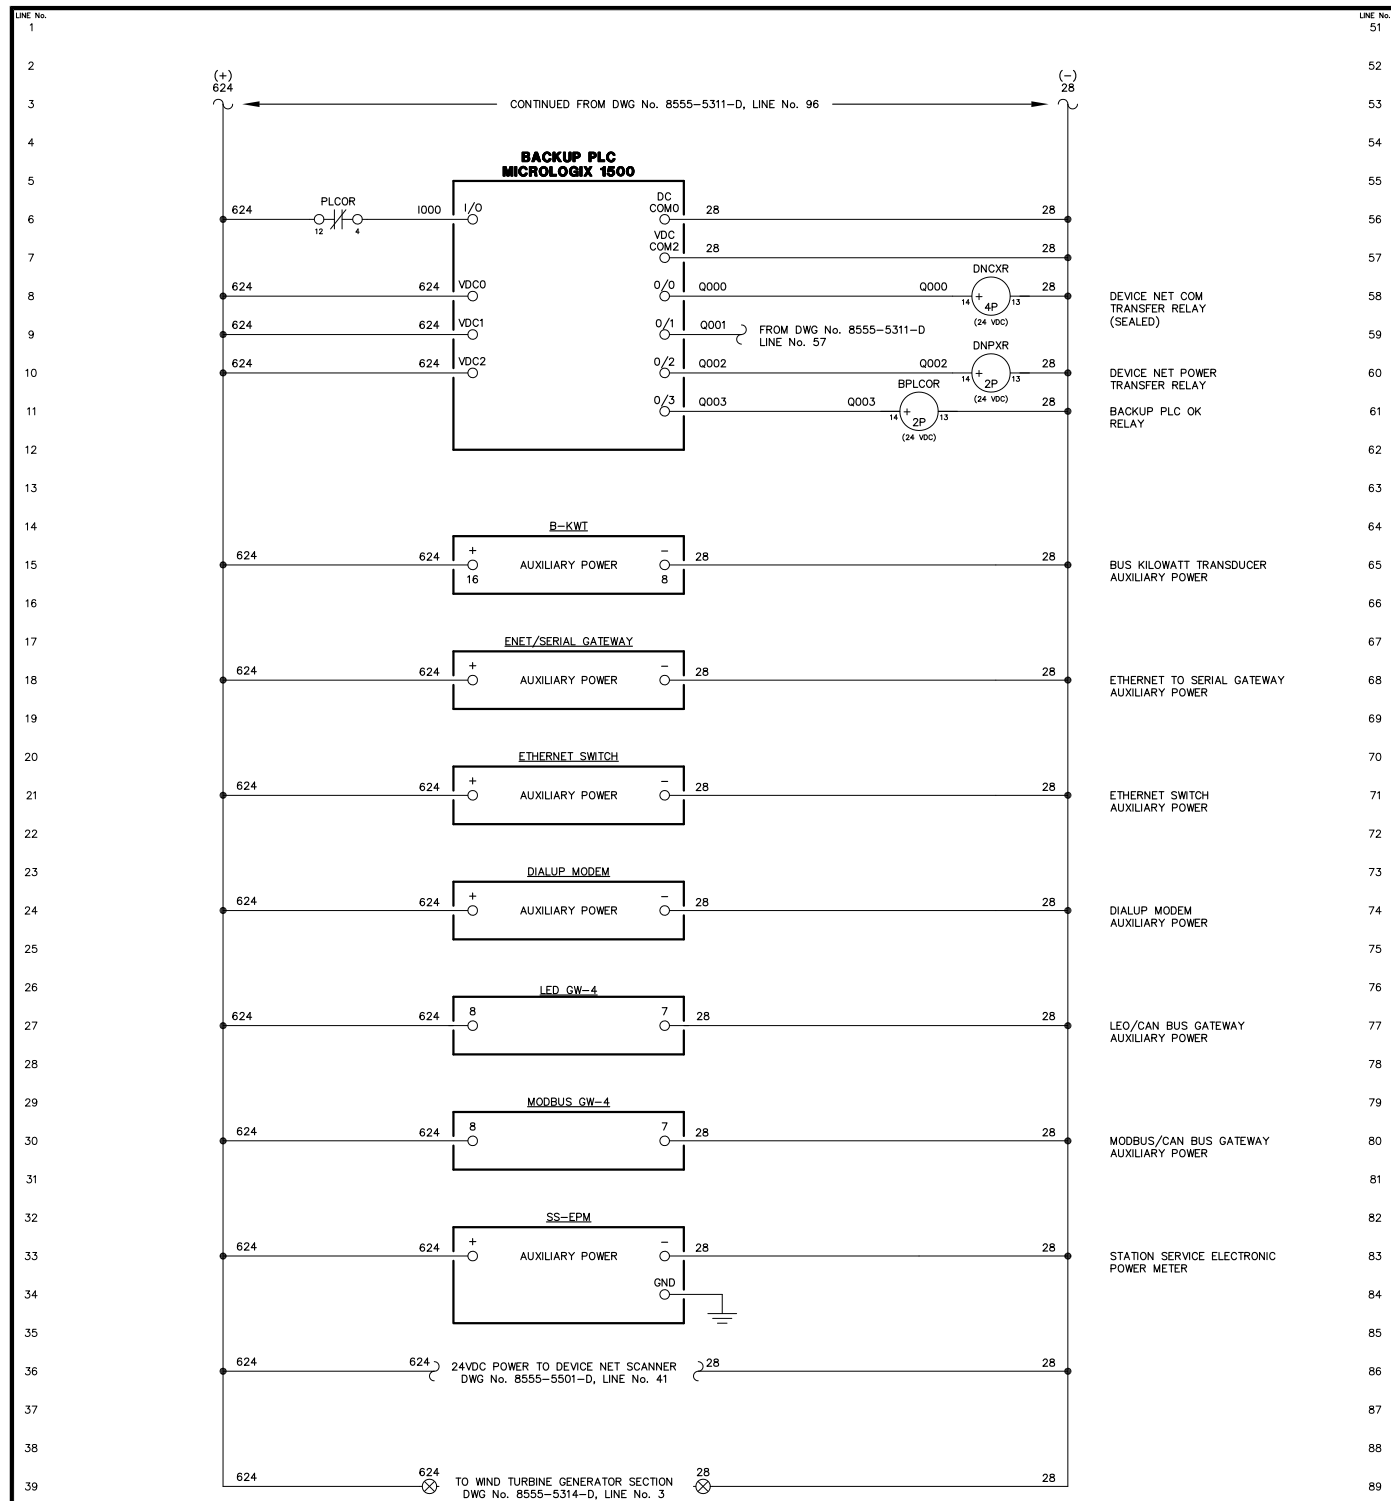

NOTE:

1. FOR GENERAL WIRING & CONSTRUCTION NOTES, SEE DRAWING No. 8555-3101-D.

A	03-24-17	FIELD REVISION	GPN
REV.	DATE	DESCRIPTION	BY

AEA PURCHASE ORDER No. PREPAID	CONTROLLED POWER JOB No. 8555
TITLE: MASTER DC CONTROL, SCHEMATIC DIAGRAM	

SCALE: NONE	DATE: 03-14-17	DWN. BY: GPN
-------------	----------------	--------------

DWG. No: 8555-5312-D	SHEET: 1 OF 1	CKD. BY: RTH
----------------------	---------------	--------------

JOB: NIKOLSKI UPGRADE




ENGINEERED & MANUFACTURED BY
Controlled Power, Inc.
BOTHELL, WASHINGTON USA
(425)-485-1778 www.controlledpowerinc.com

NOTICE
THE DRAWINGS, INFORMATION AND SUBJECT MATTER HEREOF
ARE THE CONFIDENTIAL, SOLE AND EXCLUSIVE PROPERTY
OF CONTROLLED POWER, INC., AND ARE NOT TO BE COPIED,
REPRODUCED OR USED IN ANY MANNER FOR ANY PURPOSE
WHATSOEVER WITHOUT WRITTEN CONSENT OR DIRECTION.

LINE No.
1
2
SPECTRUM
FUEL FLOW
COUNTER
PLC SLOT 3
1746-SC-CTR8

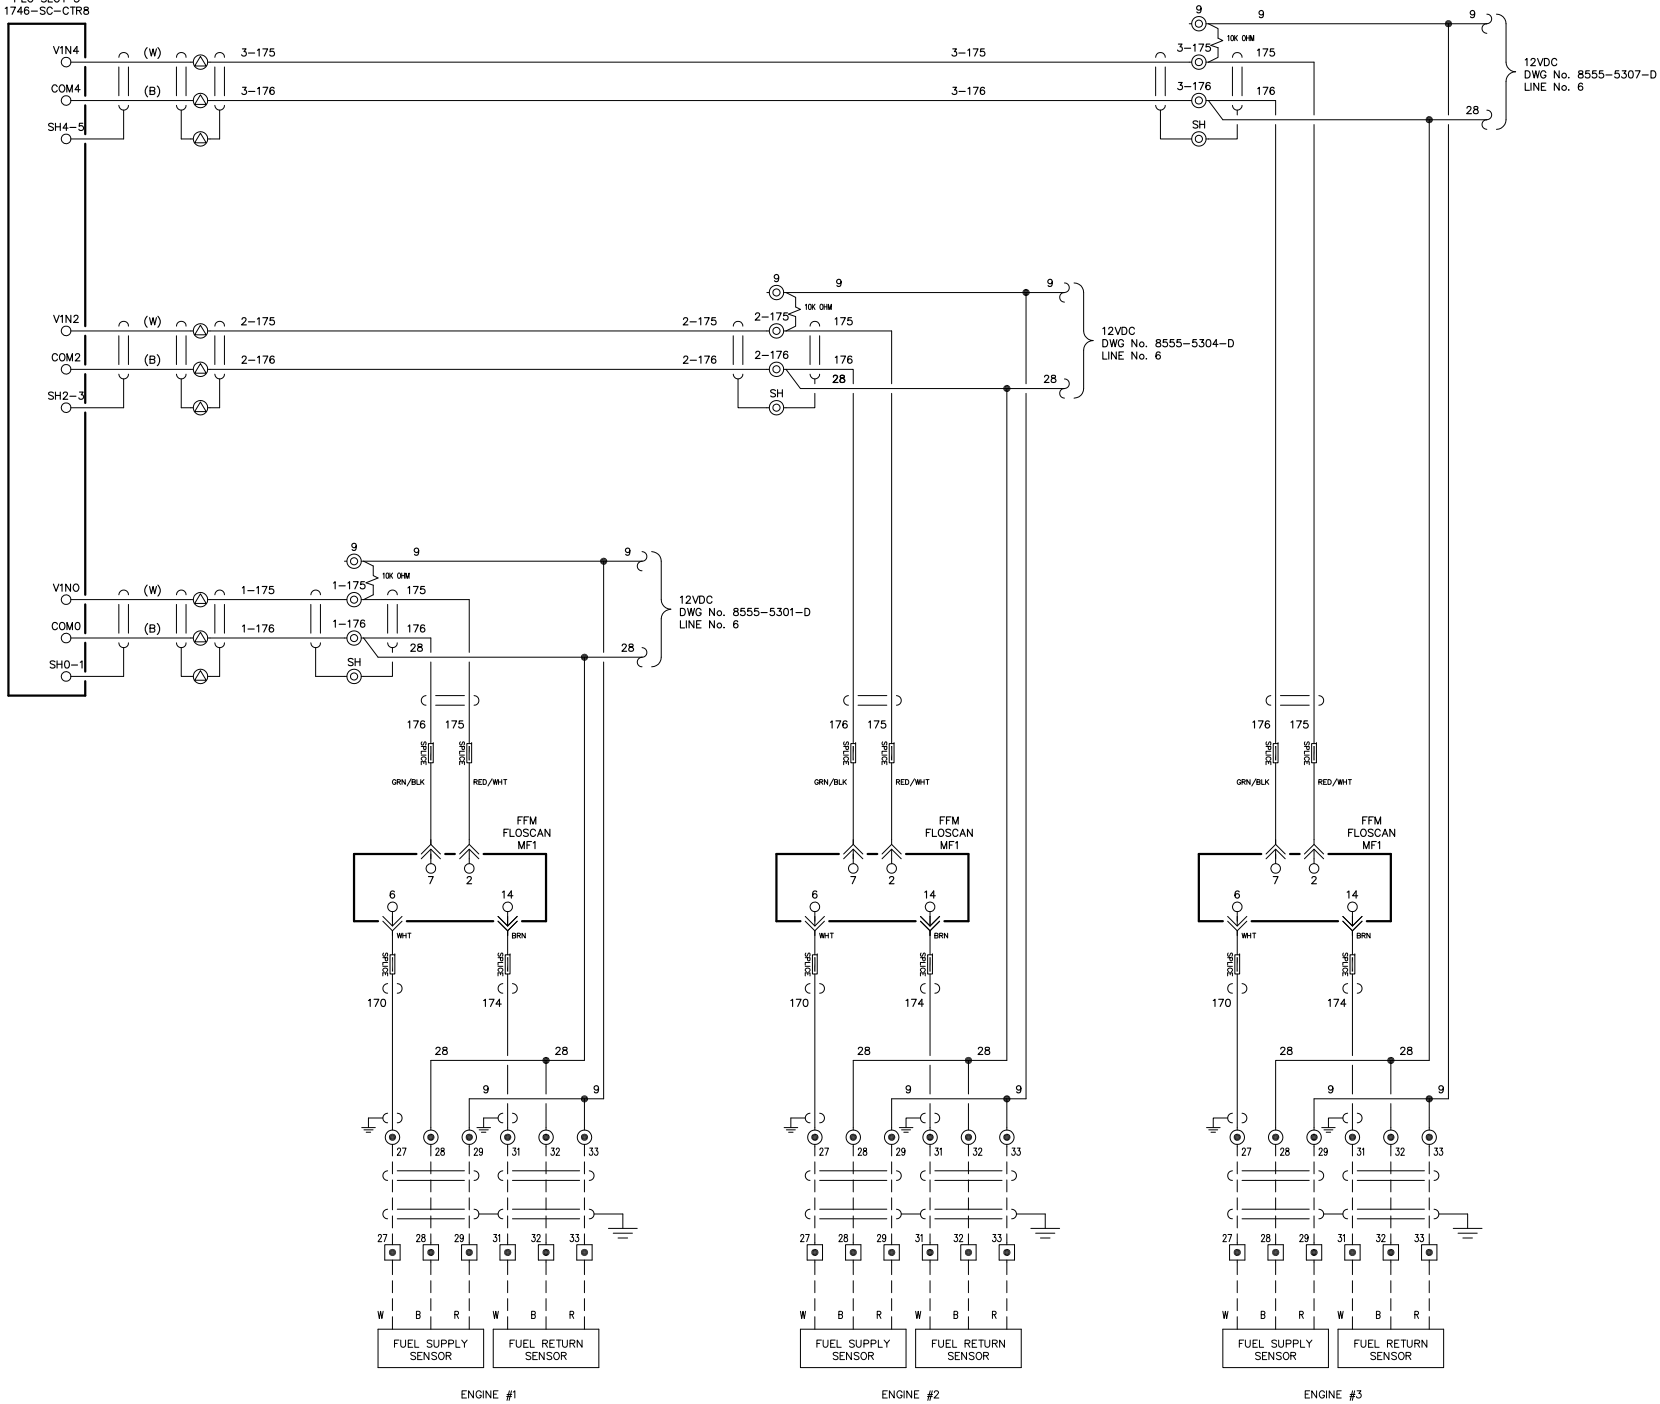



NOTE:
1. FOR GENERAL WIRING & CONSTRUCTION NOTES, SEE DRAWING No. 8555-3101-D.

A	03-24-17	FIELD REVISION	GPN
REV.	DATE	DESCRIPTION	BY
AEA PURCHASE ORDER No. PREPAID CONTROLLED POWER JOB No. 8555			
TITLE: FUEL FLOW SYSTEM, SCHEMATIC DIAGRAM			
SCALE: NONE		DATE: 03-14-17	DWN. BY: GPN
DWG. No: 8555-5313-D		SHEET: 1 OF 1	CKD. BY: RTH
JOB: NIKOLSKI UPGRADE			
		RURAL ENERGY GROUP 813 W. NORTHERN LIGHTS BLVD. ANCHORAGE, ALASKA 99503 HTTP://WWW.AIDEA.ORG	

NOTICE
THE DRAWINGS, INFORMATION AND SUBJECT MATTER HEREOF
ARE THE CONFIDENTIAL, SOLE AND EXCLUSIVE PROPERTY
OF CONTROLLED POWER, INC., AND ARE NOT TO BE COPIED,
REPRODUCED OR USED IN ANY MANNER FOR ANY PURPOSE
WHATSOEVER WITHOUT WRITTEN CONSENT OR DIRECTION.



ENGINEERED & MANUFACTURED BY
Controlled Power, Inc.
BOTHELL, WASHINGTON USA
(425)-485-1778 www.controlledpowerinc.com

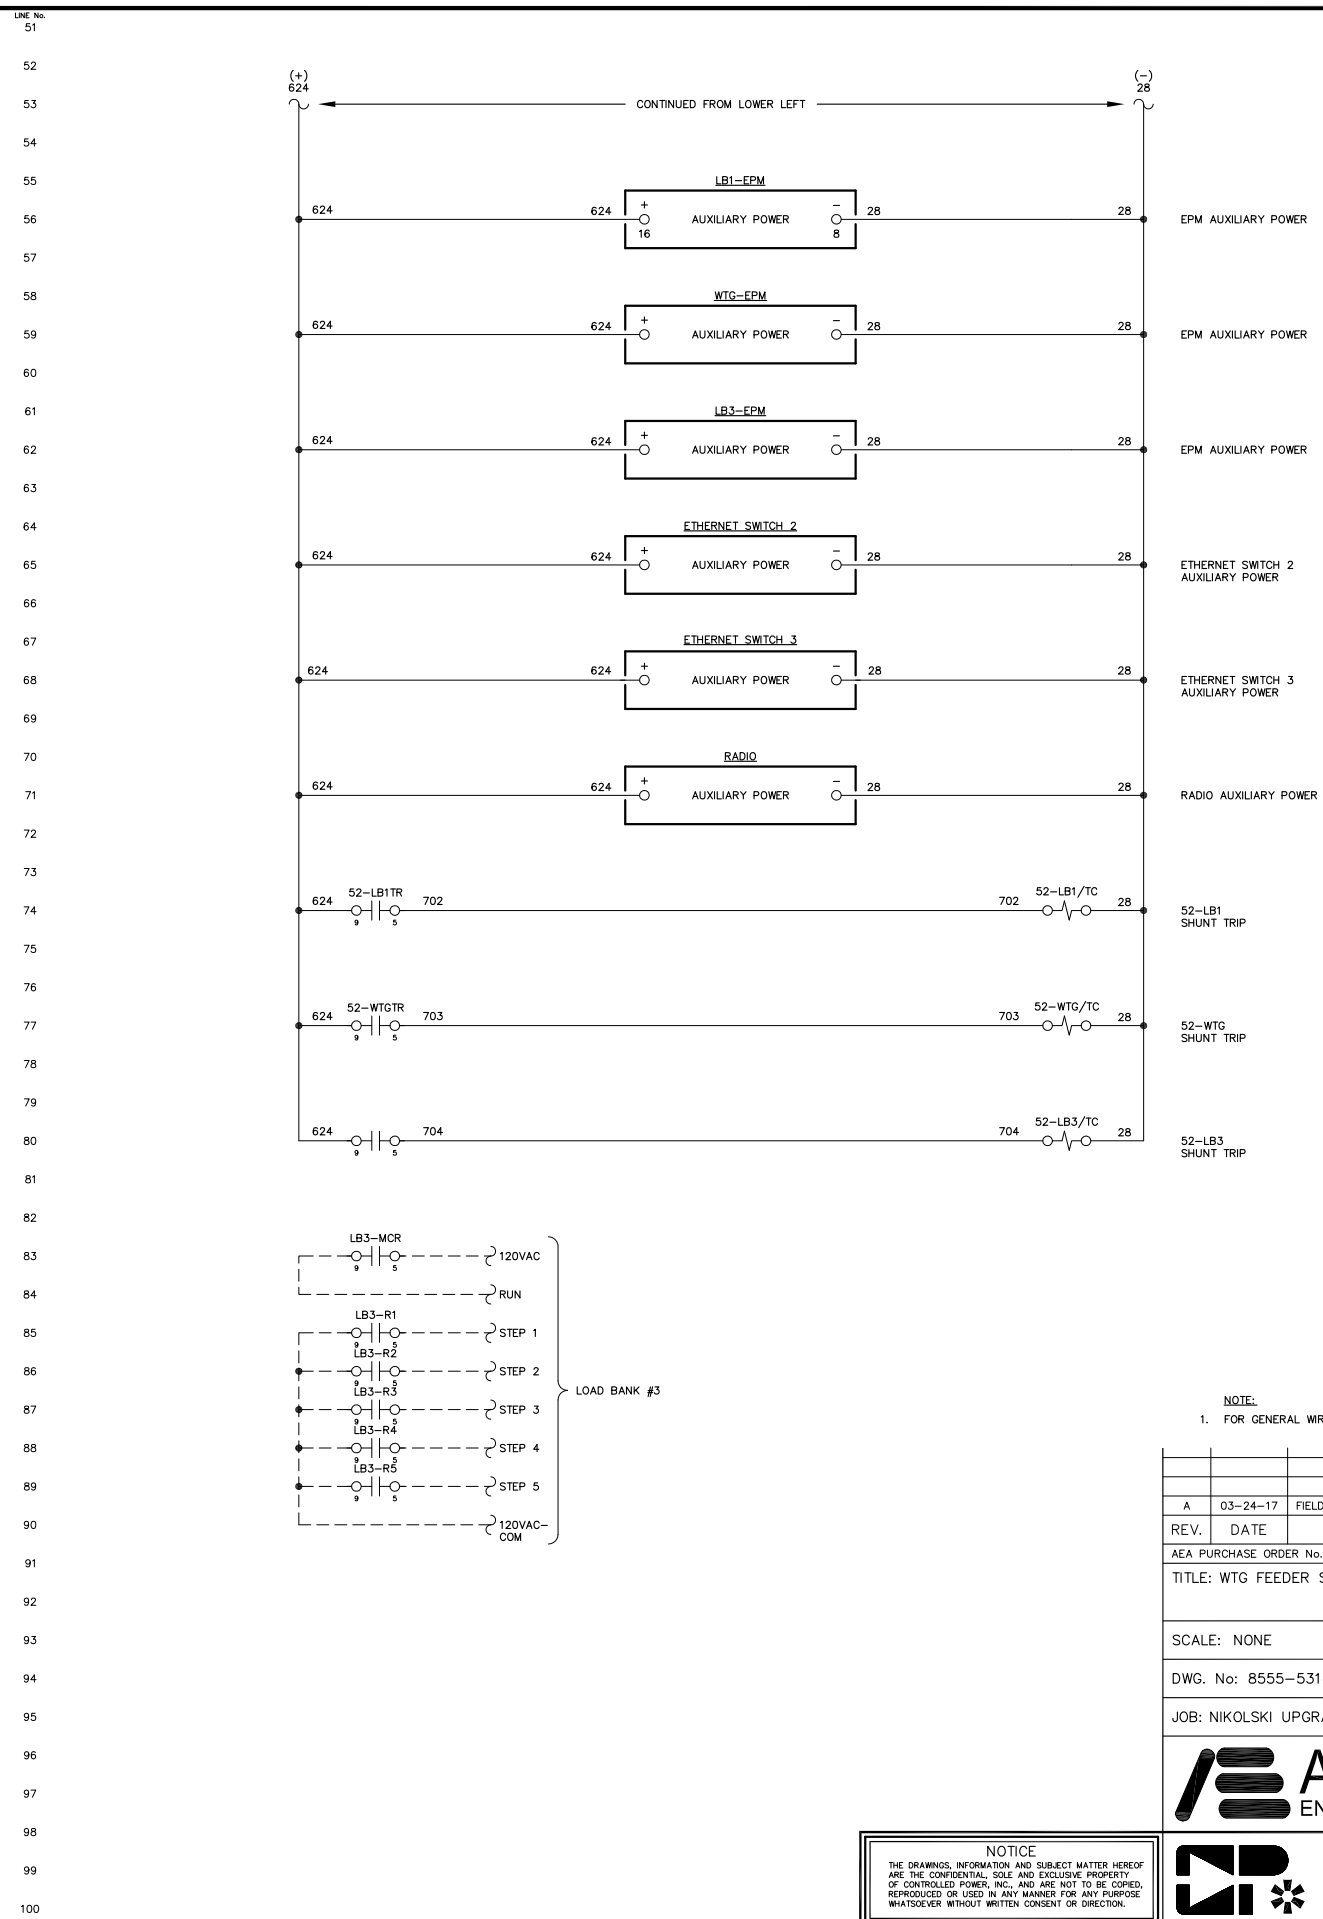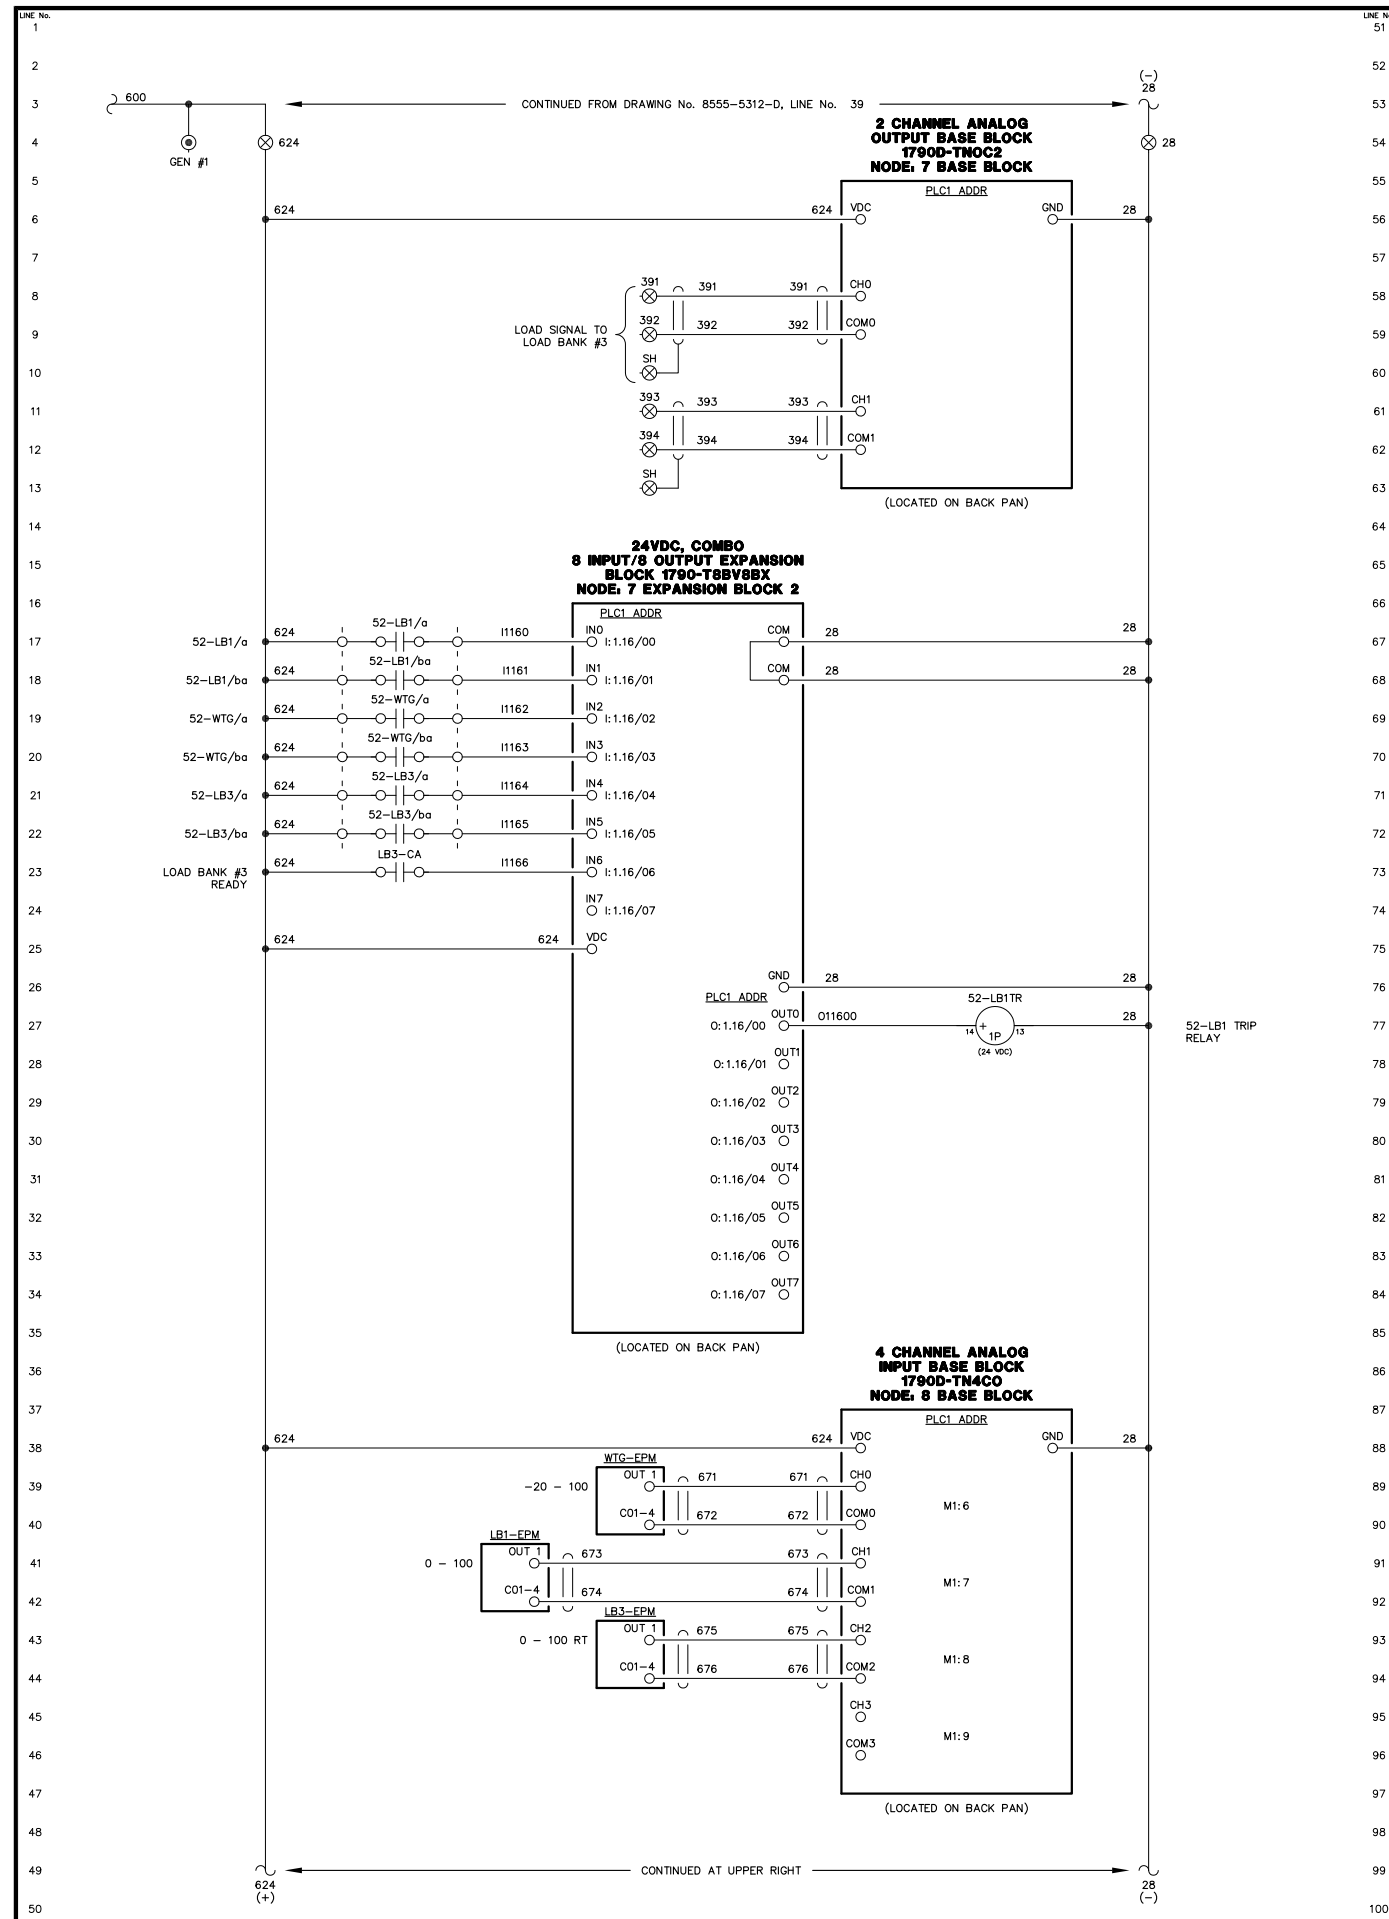

NOTE:



1. FOR GENERAL WIRING & CONSTRUCTION NOTES, SEE DRAWING No. 8555-3101-D.

A	03-24-17	FIELD REVISION			GPN
REV.	DATE	DESCRIPTION			BY
AEA PURCHASE ORDER No. PREPAID			CONTROLLED POWER JOB No. 8555		
TITLE: WTG FEEDER SECTION, SCHEMATIC DIAGRAM					
SCALE: NONE		DATE: 03-14-17		DWN. BY: GPN	
DWG. No: 8555-5314-D			SHEET: 1 OF 1		CKD. BY: RTH
JOB: NIKOLSKI UPGRADE					
 ALASKA ENERGY AUTHORITY			RURAL ENERGY GROUP 813 W. NORTHERN LIGHTS BLVD. ANCHORAGE, ALASKA 99503 HTTP://WWW.AIDEA.ORG		



ENGINEERED & MANUFACTURED BY
Controlled Power, Inc.
BOTHELL, WASHINGTON USA
(425)-485-1778 www.controlledpowerinc.com

NOTICE
THE DRAWINGS, INFORMATION AND SUBJECT MATTER HEREON
ARE THE CONFIDENTIAL, SOLE AND EXCLUSIVE PROPERTY
OF CONTROLLED POWER, INC., AND ARE NOT TO BE COPIED
REPRODUCED OR USED IN ANY MANNER FOR ANY PURPOSE
WHATSOEVER WITHOUT WRITTEN CONSENT OR DIRECTION.

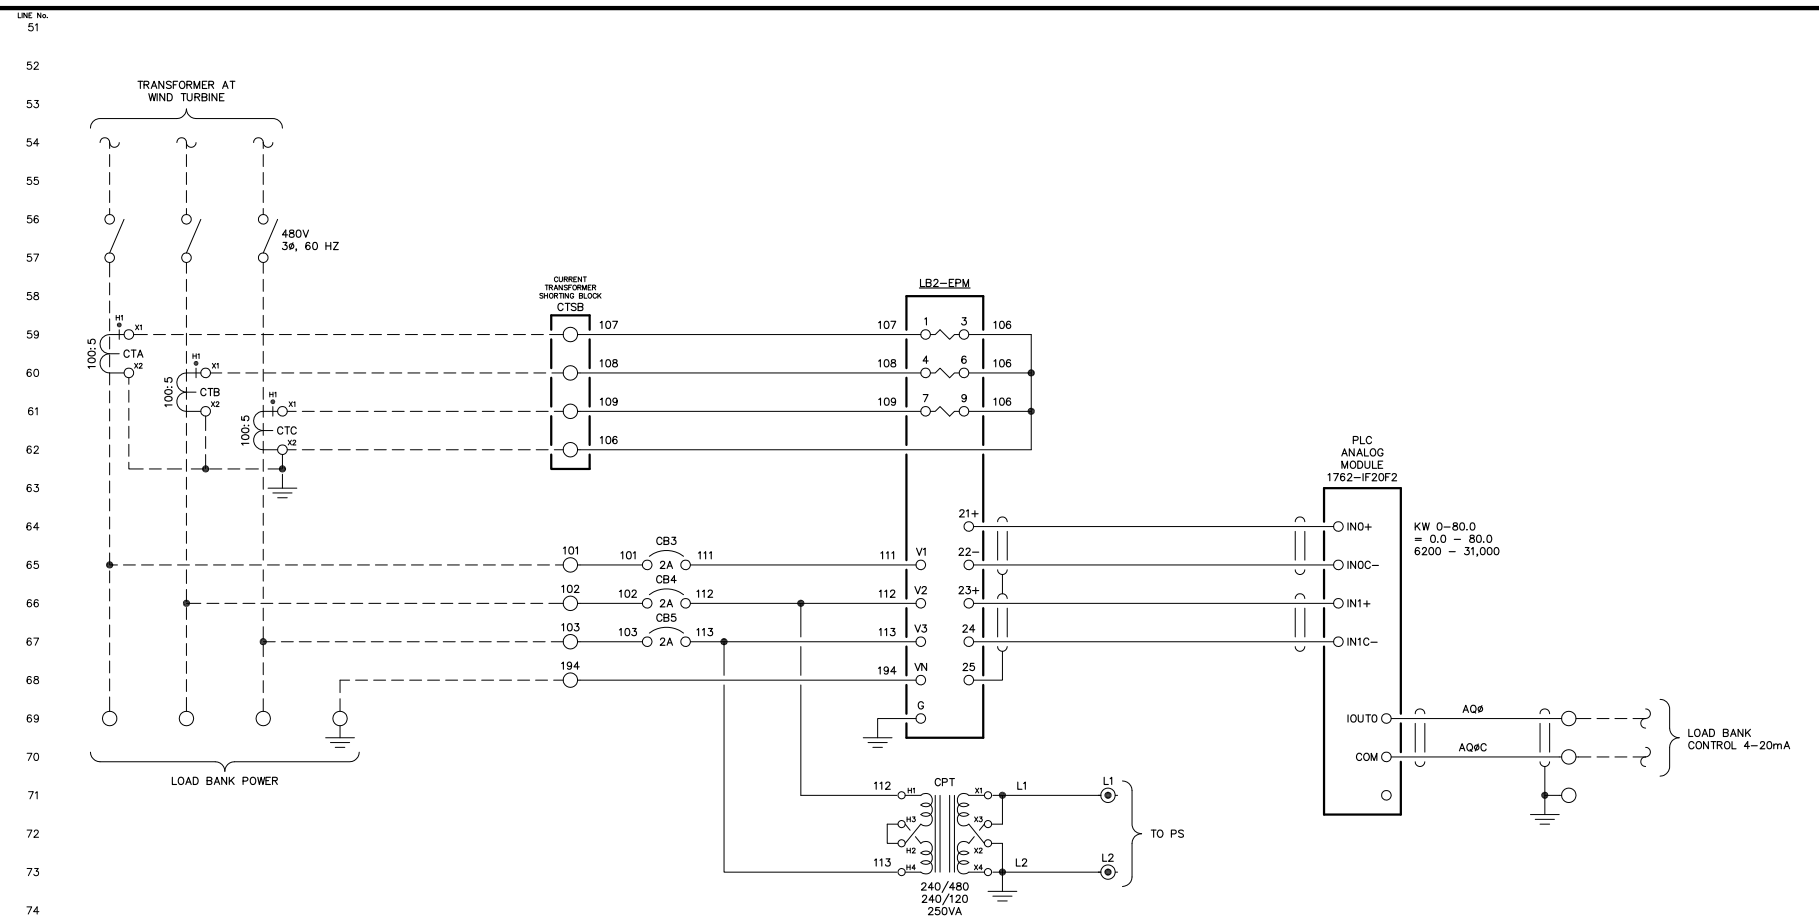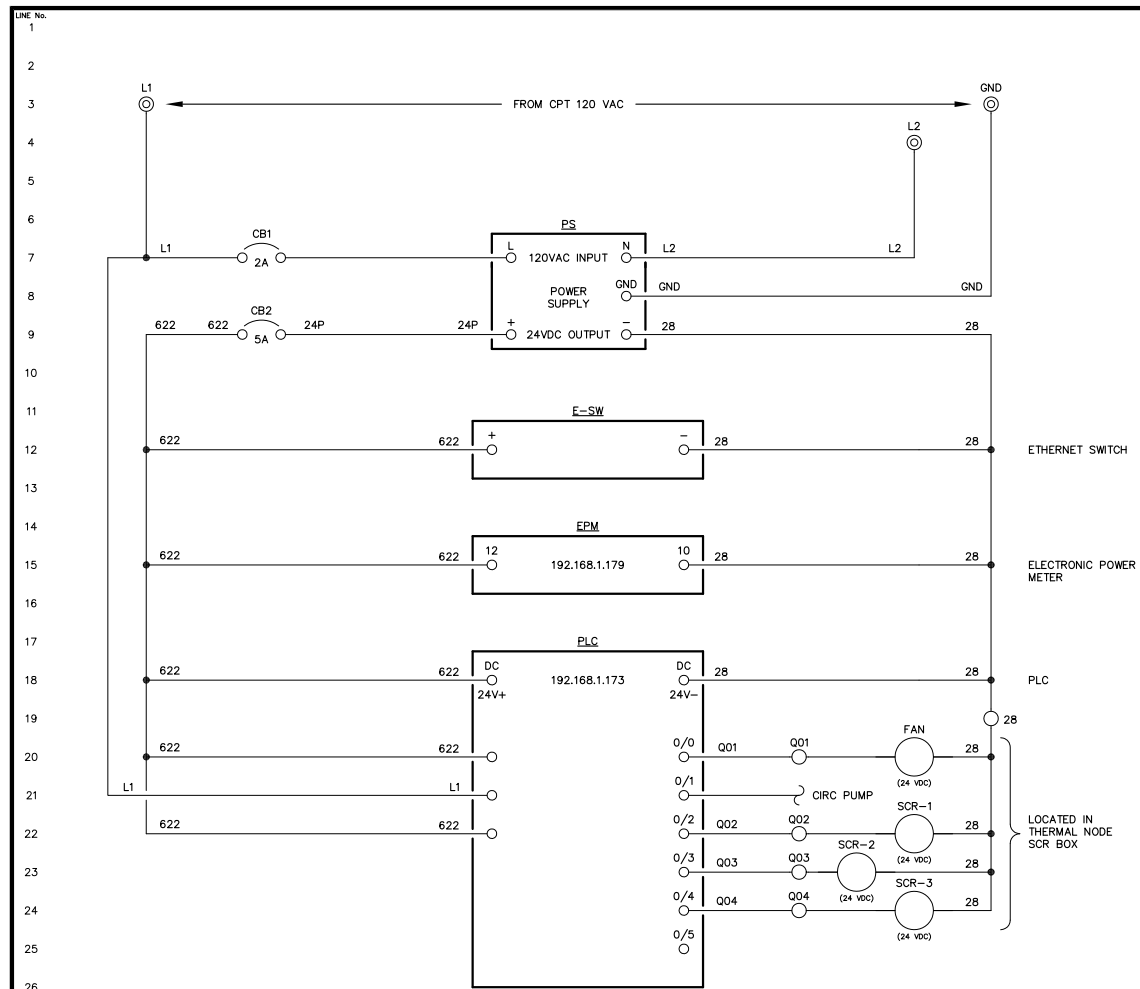

NOTE:



1. FOR GENERAL WIRING & CONSTRUCTION NOTES, SEE DRAWING No. 8555-3101-D.

A	03-24-17	FIELD REVISION	GN
REV.	DATE	DESCRIPTION	BY
AEA PURCHASE ORDER No. PREPAID		CONTROLLED POWER JOB No. 8555	
TITLE: AC & DC CONTROL, SCHEMATIC DIAGRAM THERMAL NODE 2 (LOADGE)			
SCALE: NONE		DATE: 03-14-17	DWN. BY: GN
DWG. No: 8555-5316-D		SHEET: 1 OF 1	CKD. BY: RTH
JOB: NIKOLSKI UPGRADE			



ENGINEERED & MANUFACTURED BY
Controlled Power, Inc.
BOTHELL, WASHINGTON USA
(425)-485-1778 www.controlledpowerinc.com

NOTICE
THE DRAWINGS, INFORMATION AND SUBJECT MATTER HEREOF
ARE THE CONFIDENTIAL, SOLE AND EXCLUSIVE PROPERTY
OF CONTROLLED POWER, INC., AND ARE NOT TO BE COPIED,
REPRODUCED OR USED IN ANY MANNER FOR ANY PURPOSE
WHATSOEVER WITHOUT WRITTEN CONSENT OR DIRECTION.

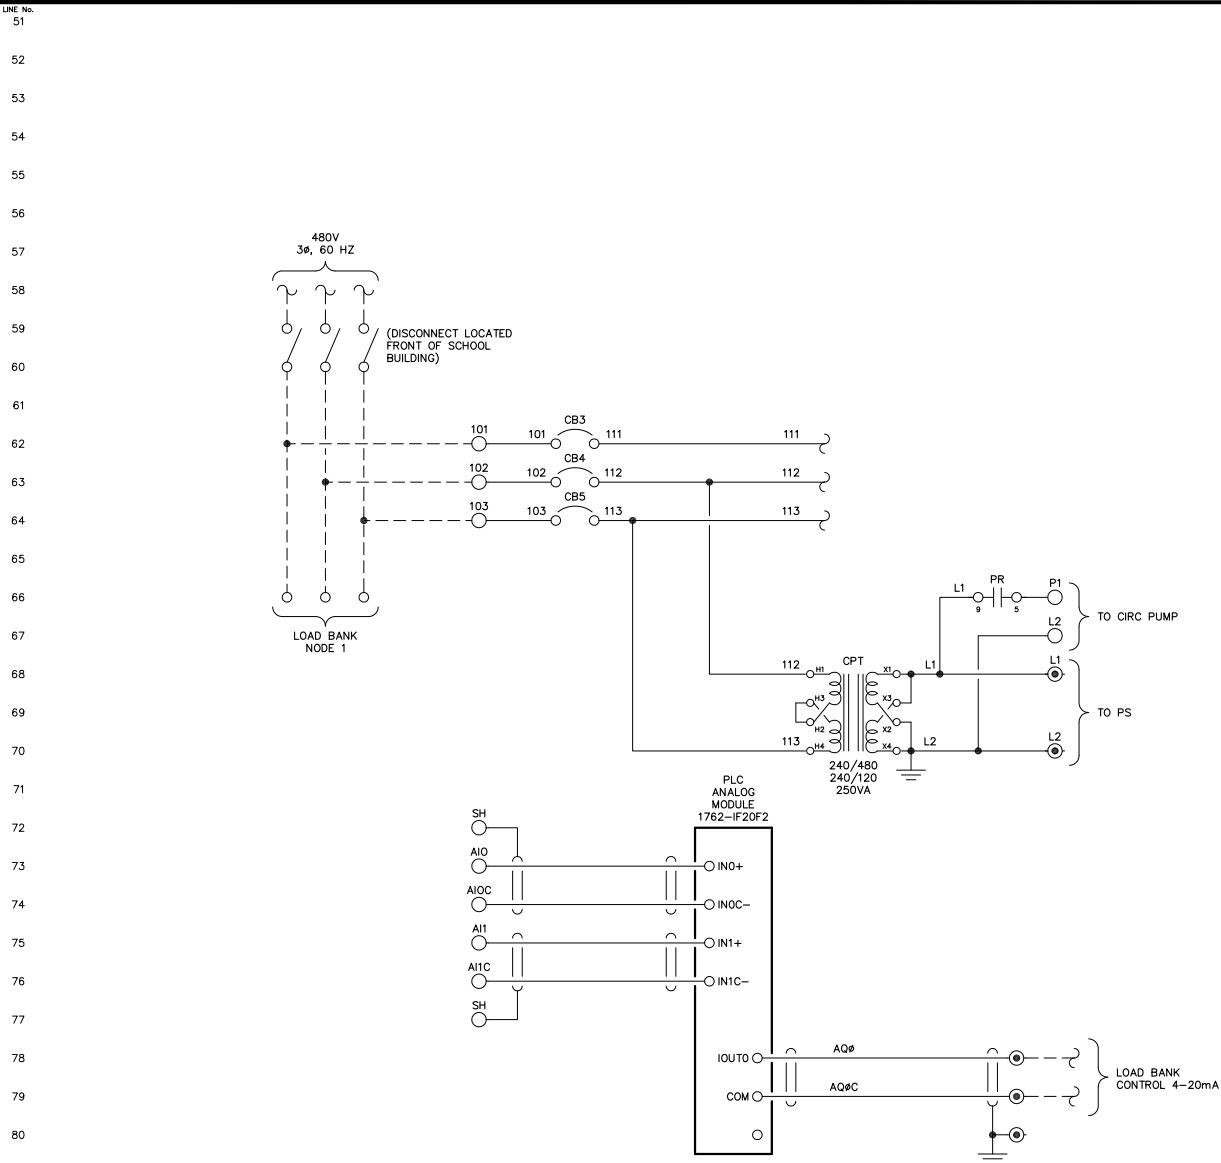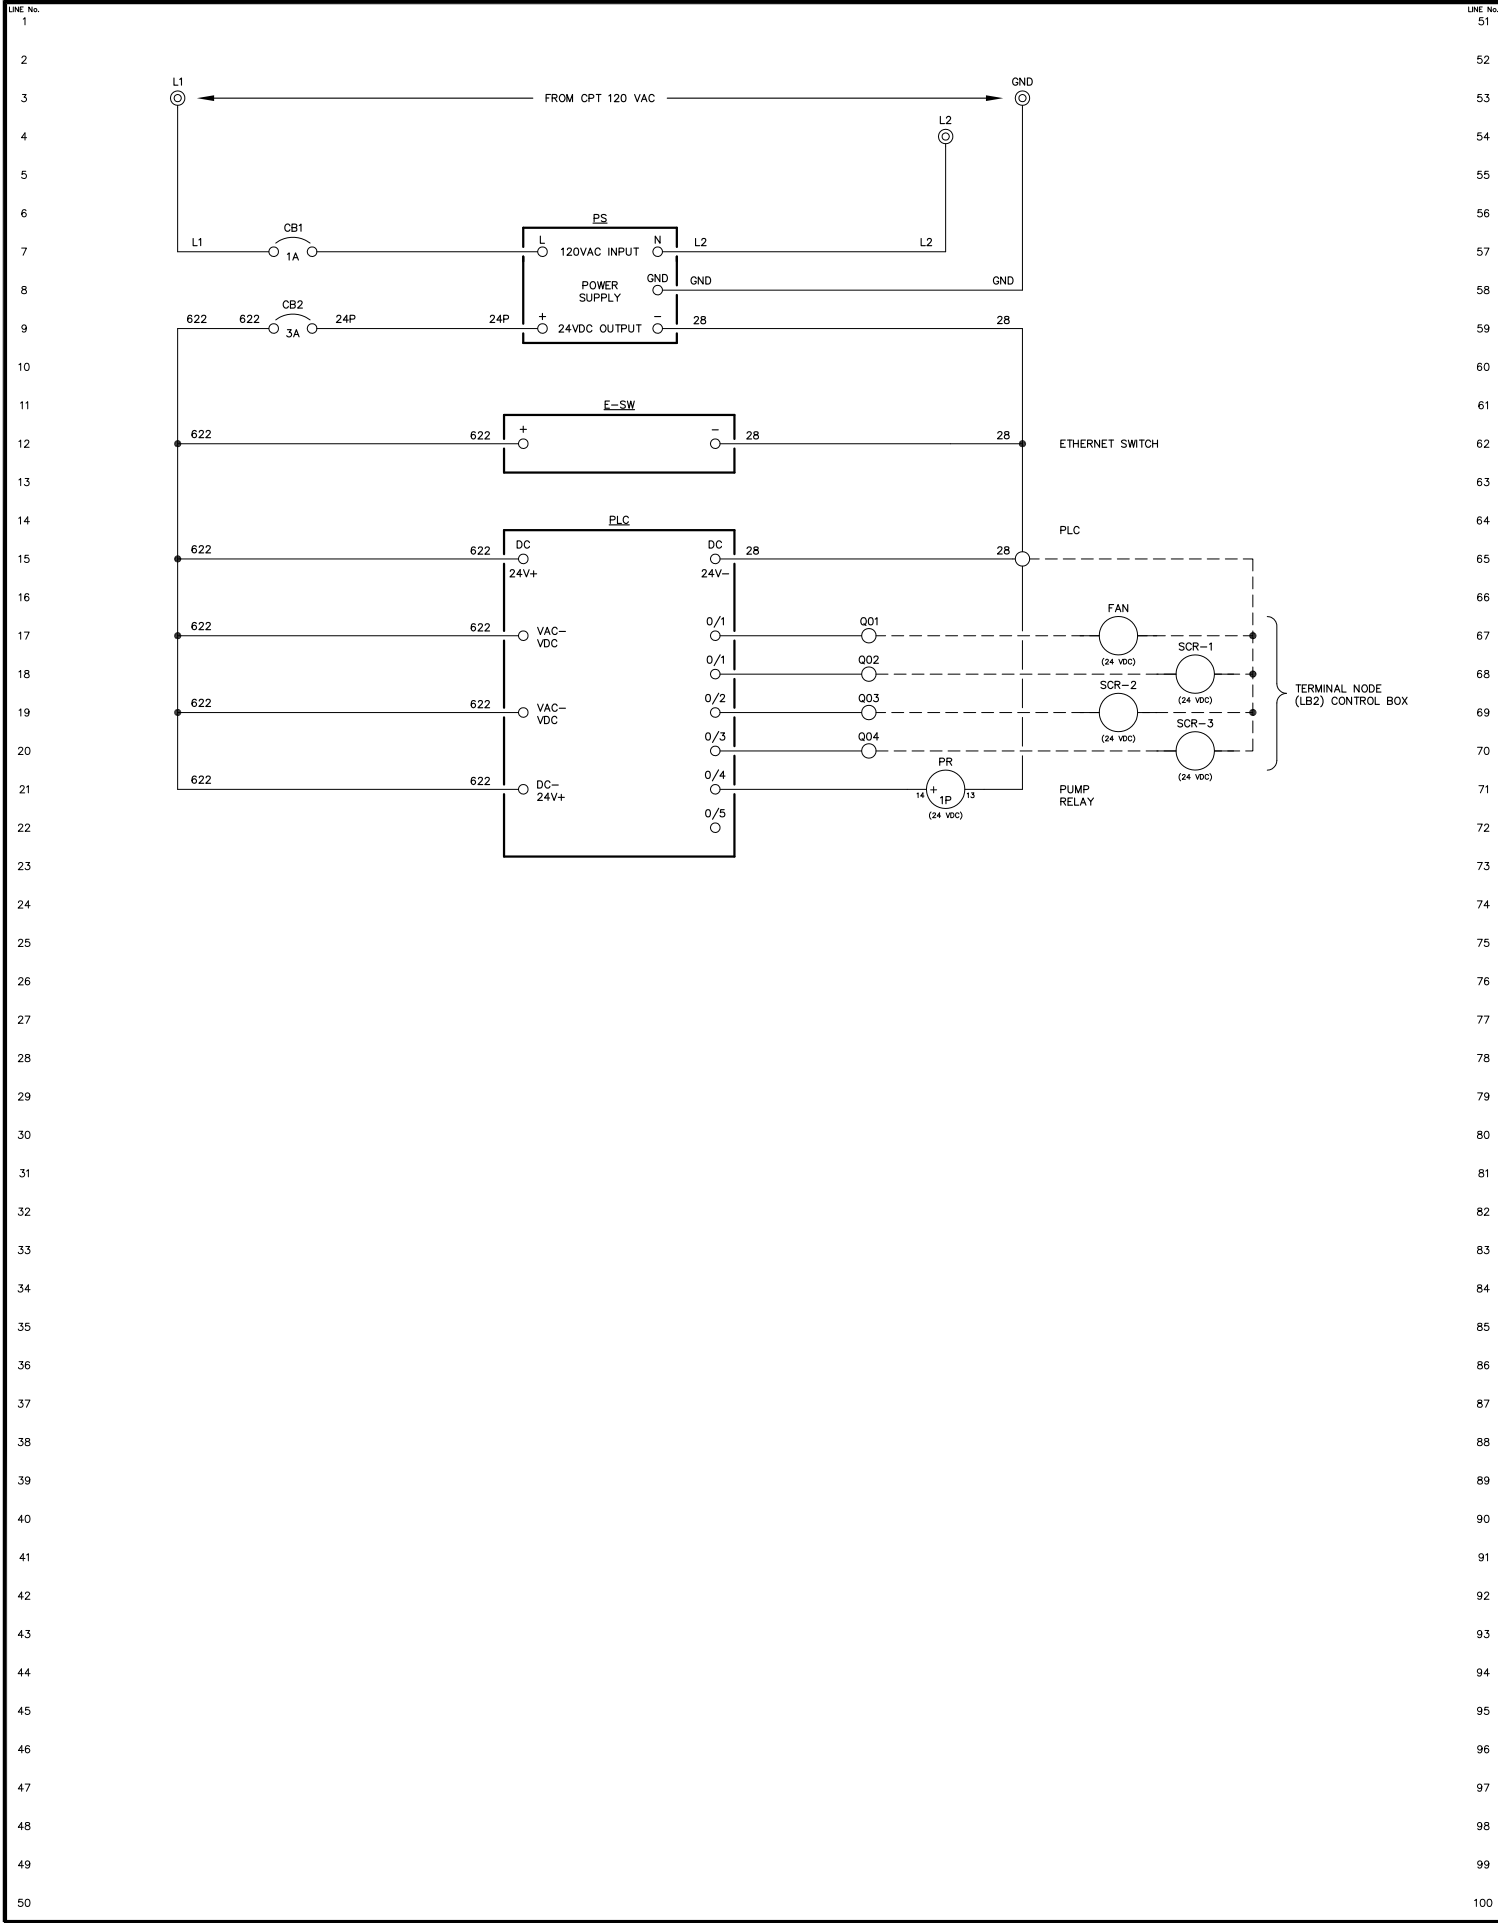

NOTE:
1. FOR GENERAL WIRING & CONSTRUCTION NOTES, SEE DRAWING No. 8555-3101-D.

REV.	DATE	DESCRIPTION	BY
A	03-24-17	FIELD REVISION	GPN
AEA PURCHASE ORDER No. PREPAID CONTROLLED POWER JOB No. 8555			
TITLE: AC & DC CONTROL, SCHEMATIC DIAGRAM INTERNAL NODE 1 (SCHOOL)			
SCALE: NONE		DATE: 03-14-17	DWN. BY: GPN
DWG. No: 8555-5317-D		SHEET: 1 OF 1	CKD. BY: RTH
JOB: NIKOLSKI UPGRADE			

ALASKA
ENERGY AUTHORITY

RURAL ENERGY GROUP
813 W. NORTHERN LIGHTS BLVD.
ANCHORAGE, ALASKA 99503
HTTP://WWW.AIDEA.ORG




ENGINEERED & MANUFACTURED BY
Controlled Power, Inc.
BOTHELL, WASHINGTON USA
(425)-485-1778 www.controlledpowerinc.com

NOTICE
THE DRAWINGS, INFORMATION AND SUBJECT MATTER HEREOF
ARE THE CONFIDENTIAL, SOLE AND EXCLUSIVE PROPERTY
OF CONTROLLED POWER, INC. AND ARE NOT TO BE COPIED,
REPRODUCED OR USED IN ANY MANNER FOR ANY PURPOSE
WHATSOEVER WITHOUT WRITTEN CONSENT OR DIRECTION.

LINE No.
1
2
LINE No.
51
52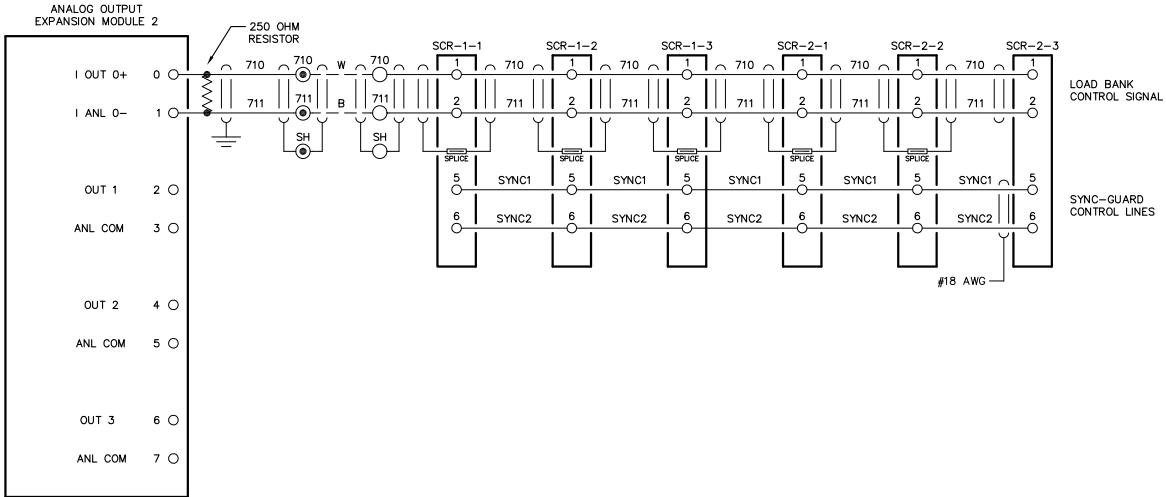
NOTE:
1. FOR GENERAL WIRING & CONSTRUCTION NOTES, SEE DRAWING No. 8555-3101-D.

A	03-24-17	FIELD REVISION	GPN
REV.	DATE	DESCRIPTION	BY
AEA PURCHASE ORDER No. PREPAID CONTROLLED POWER JOB No. 8555			
TITLE: ANALOG OUTPUTS, SCHEMATIC DIAGRAM			
SCALE: NONE		DATE: 03-14-17	DWN. BY: GPN
DWG. No: 8555-5318-D		SHEET: 1 OF 1	CKD. BY: RTH
JOB: NIKOLSKI UPGRADE			
		RURAL ENERGY GROUP 813 W. NORTHERN LIGHTS BLVD. ANCHORAGE, ALASKA 99503 HTTP://WWW.AIDEA.ORG	
		ENGINEERED & MANUFACTURED BY Controlled Power, Inc. BOTHHELL, WASHINGTON USA (425)-485-1778 www.controlledpowerinc.com	

NOTICE
THE DRAWINGS, INFORMATION AND SUBJECT MATTER HEREOF ARE THE CONFIDENTIAL, SOLE AND EXCLUSIVE PROPERTY OF CONTROLLED POWER, INC. AND ARE NOT TO BE COPIED, REPRODUCED OR USED IN ANY MANNER FOR ANY PURPOSE WHATSOEVER WITHOUT WRITTEN CONSENT OR DIRECTION.

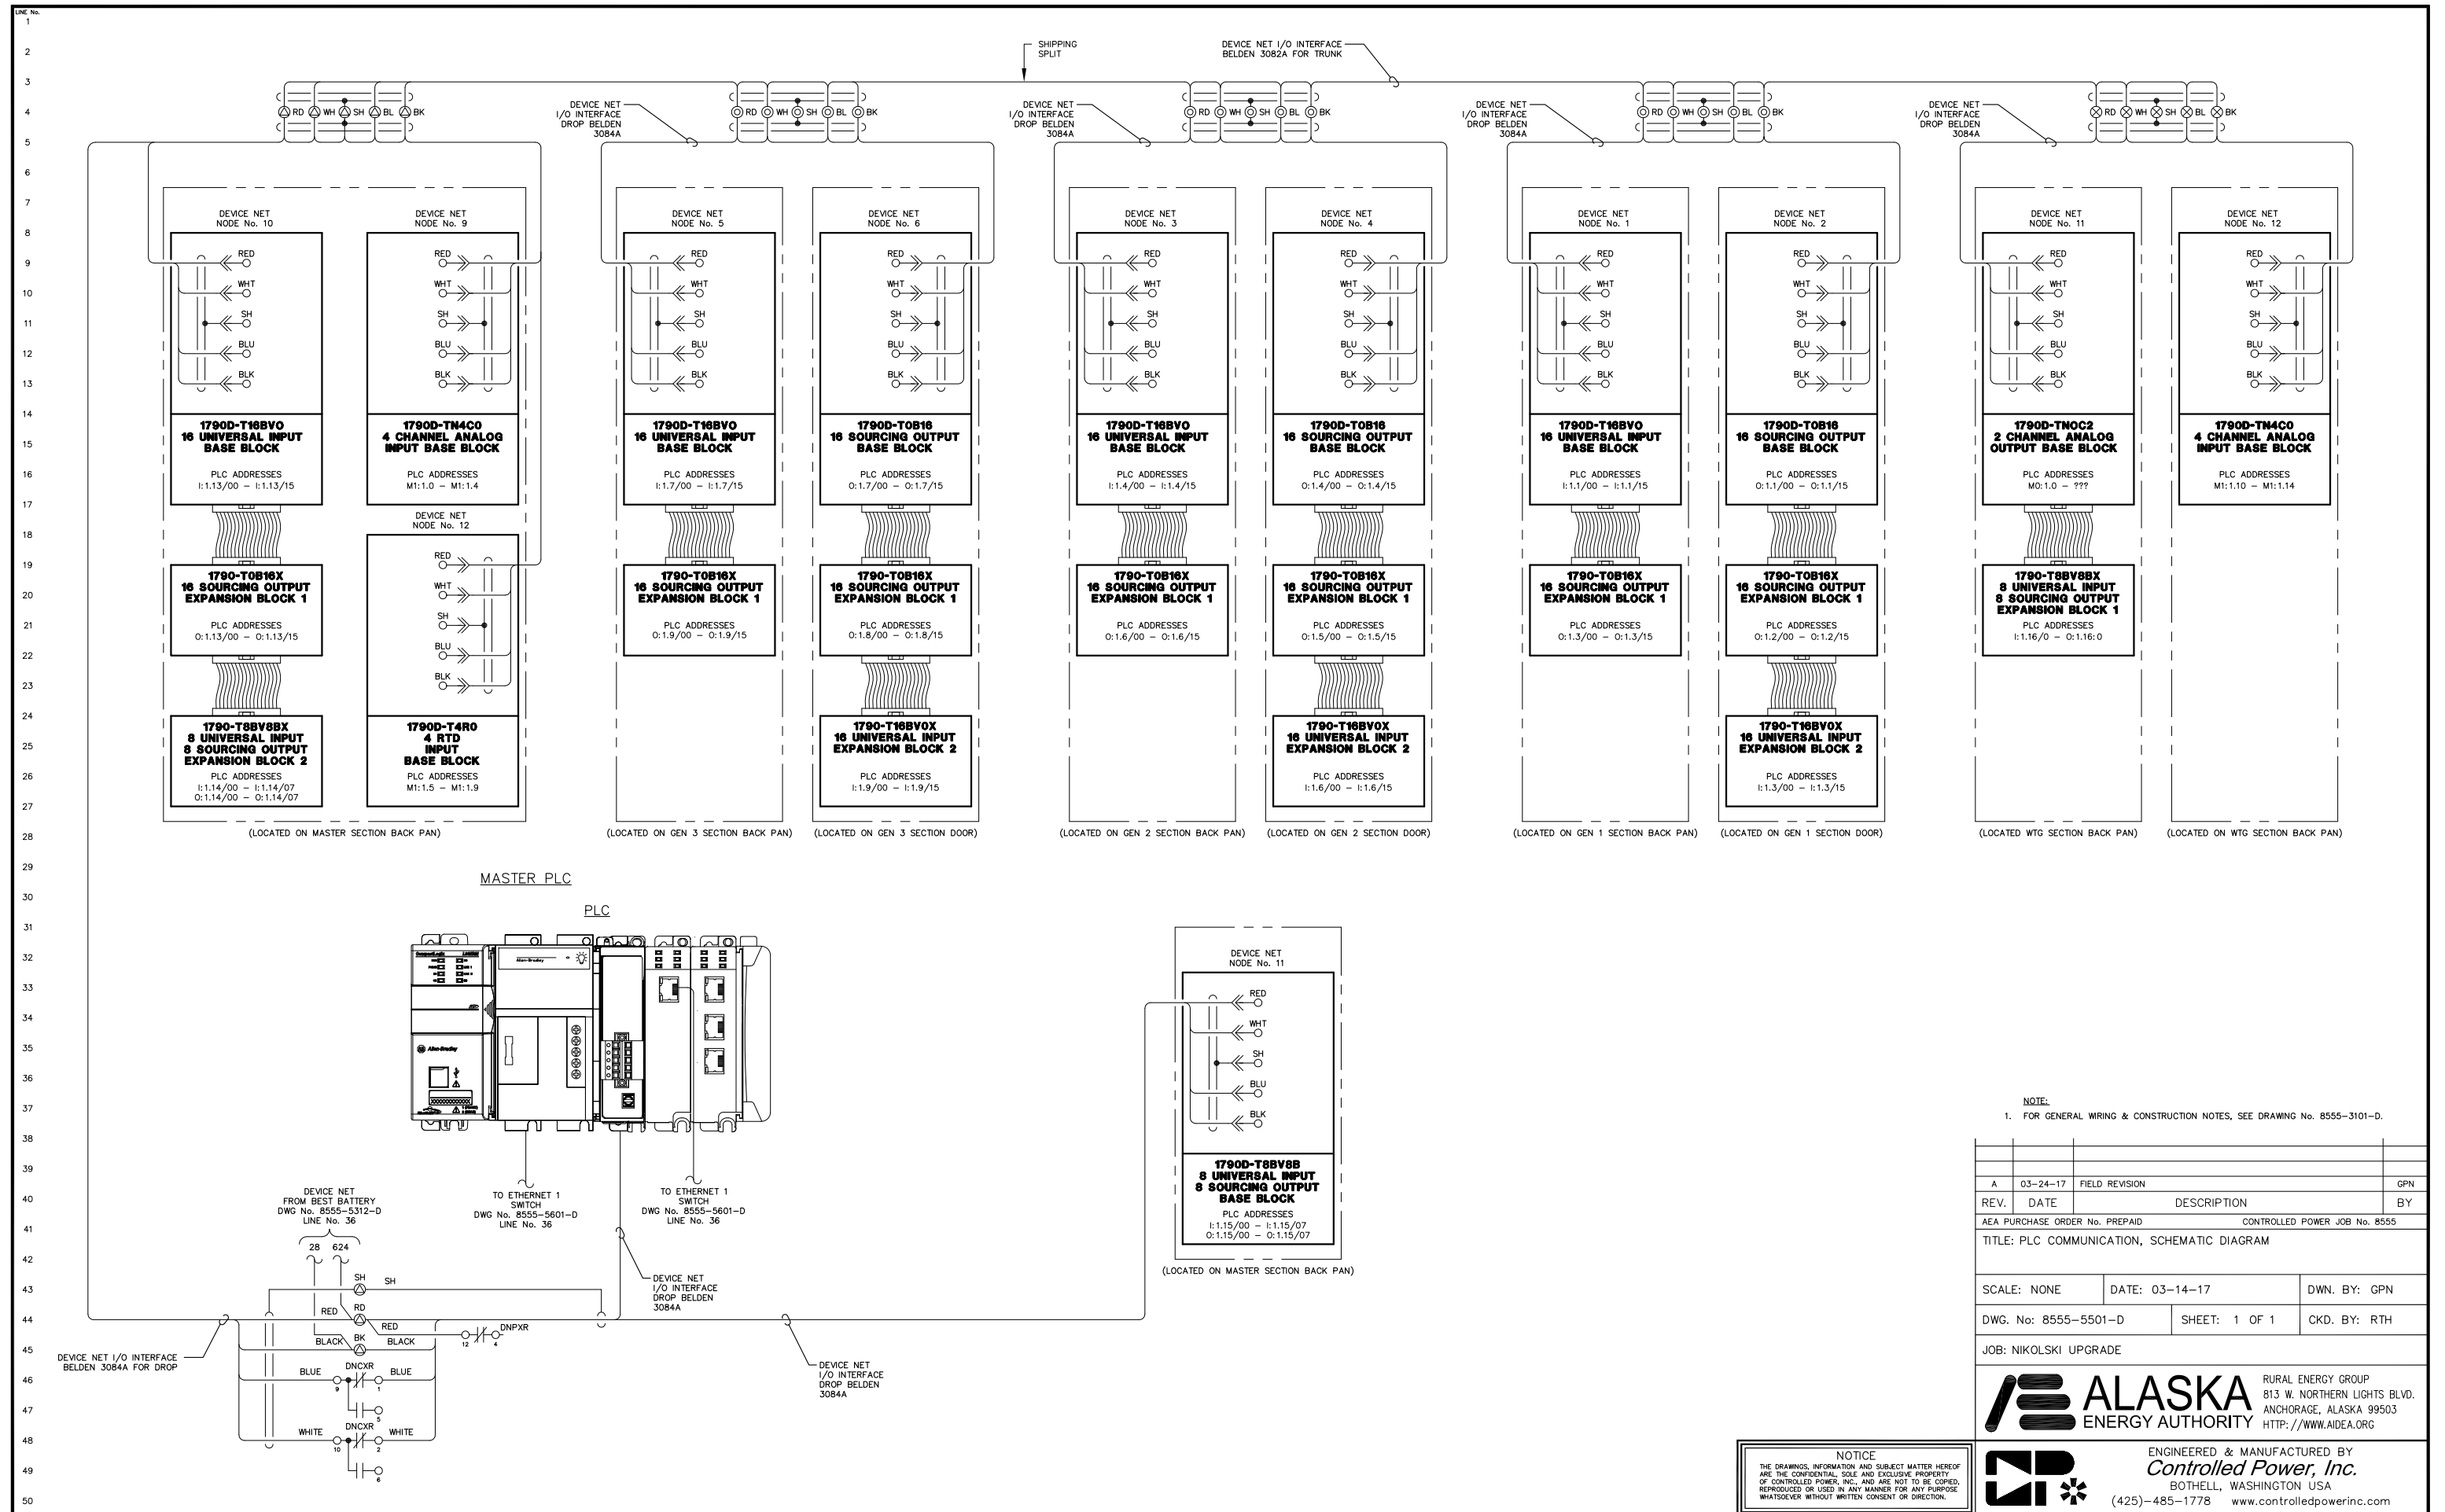

LINE No.
1
2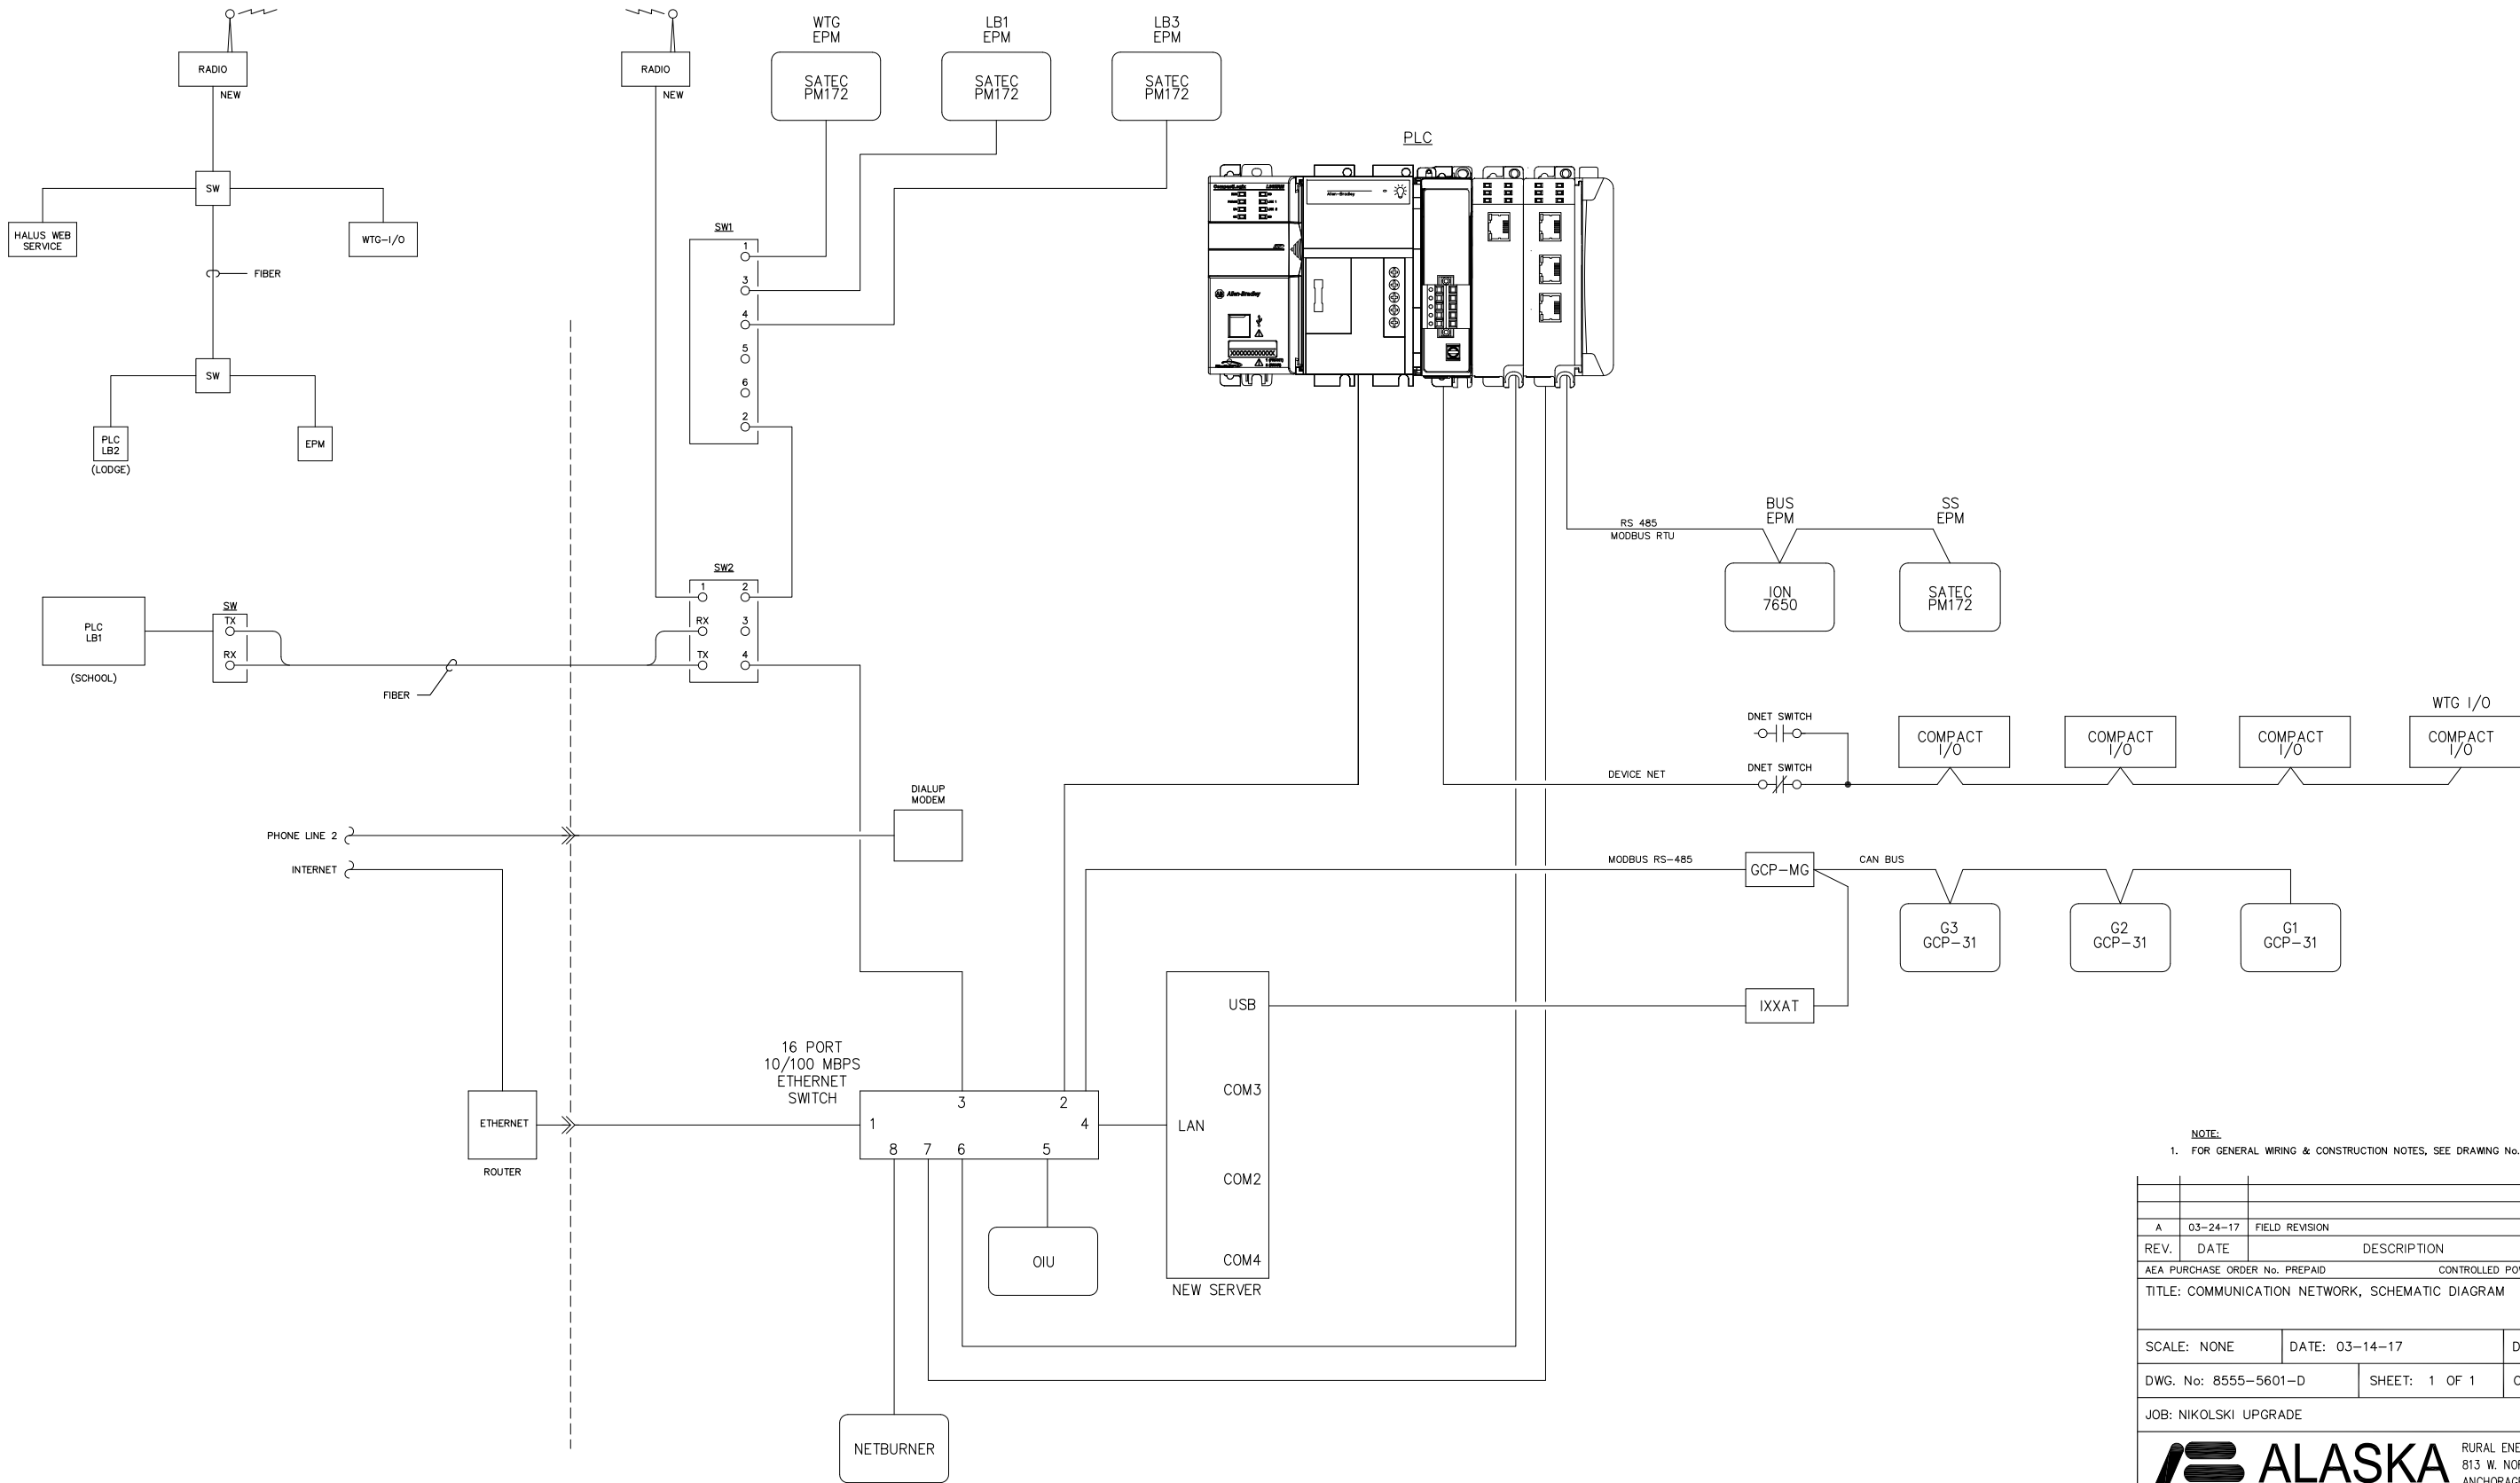
NOTE:
1. FOR GENERAL WIRING & CONSTRUCTION NOTES, SEE DRAWING No. 8555-3101-D.

A	03-24-17	FIELD REVISION	GPN
REV.	DATE	DESCRIPTION	BY
AEA PURCHASE ORDER No. PREPAID		CONTROLLED POWER JOB No. 8555	
TITLE: COMMUNICATION NETWORK, SCHEMATIC DIAGRAM			
SCALE: NONE		DATE: 03-14-17	DWN. BY: GPN
DWG. No: 8555-5601-D		SHEET: 1 OF 1	CKD. BY: RTH
JOB: NIKOLSKI UPGRADE			
		RURAL ENERGY GROUP 813 W. NORTHERN LIGHTS BLVD. ANCHORAGE, ALASKA 99503 HTTP://WWW.AIDEA.ORG	

NOTICE
THE DRAWINGS, INFORMATION AND SUBJECT MATTER HEREOF ARE THE CONFIDENTIAL, SOLE AND EXCLUSIVE PROPERTY OF CONTROLLED POWER, INC. AND ARE NOT TO BE COPIED, REPRODUCED OR USED IN ANY MANNER FOR ANY PURPOSE WHATSOEVER WITHOUT WRITTEN CONSENT OR DIRECTION.


ENGINEERED & MANUFACTURED BY
Controlled Power, Inc.
BOTHELL, WASHINGTON USA
(425)-485-1778 www.controlledpowerinc.com

LINE No.
1
2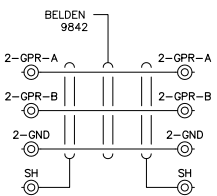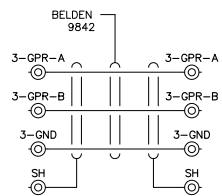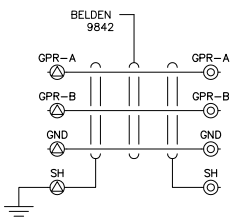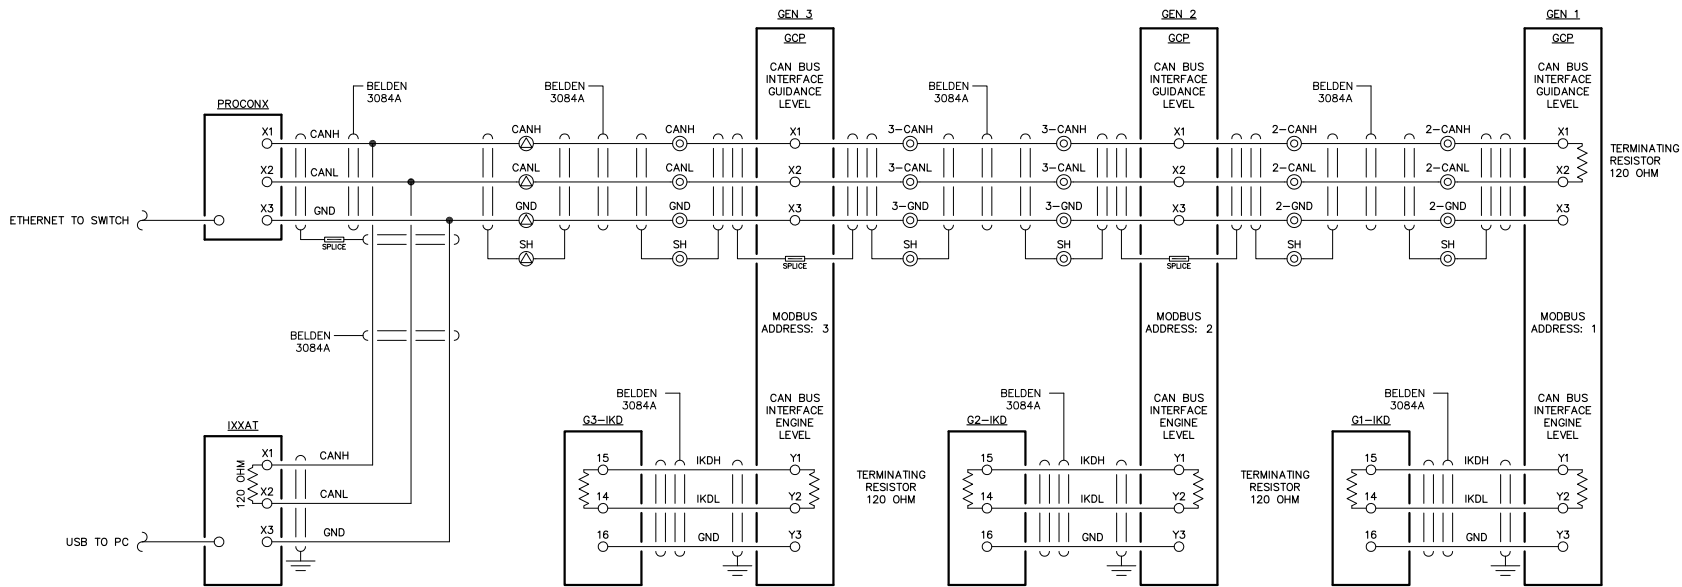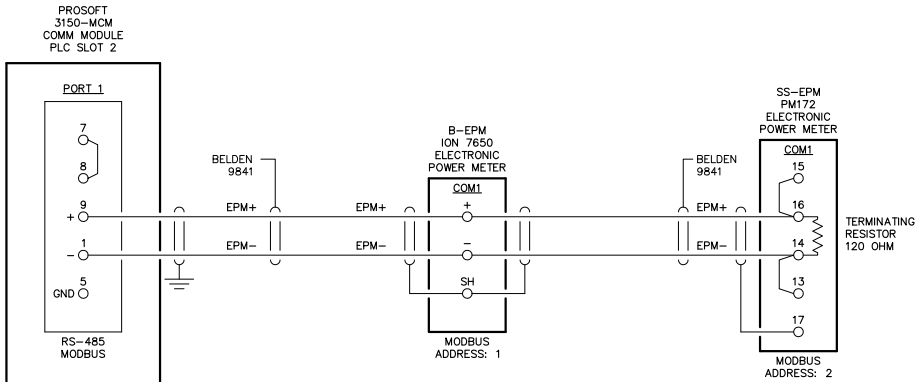
NOTE:

1. FOR GENERAL WIRING & CONSTRUCTION NOTES, SEE DRAWING No. 8555-3101-D.

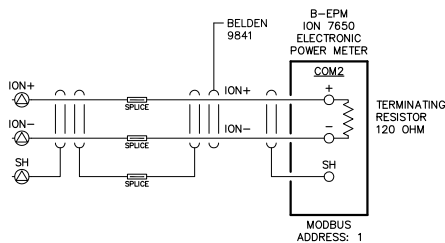


NOTICE

THE DRAWINGS, INFORMATION AND SUBJECT MATTER HEREOF ARE THE CONFIDENTIAL, SOLE AND EXCLUSIVE PROPERTY OF CONTROLLED POWER, INC. AND ARE NOT TO BE COPIED, REPRODUCED OR USED IN ANY MANNER FOR ANY PURPOSE WHATSOEVER WITHOUT WRITTEN CONSENT OR DIRECTION.

A	03-24-17	FIELD REVISION	GPN
REV.	DATE	DESCRIPTION	BY
AEA PURCHASE ORDER No. PREPAID		CONTROLLED POWER JOB No. 8555	
TITLE: EPM MONITORING & SYSTEM COMMUNICATION, SCHEMATIC DIAGRAM			
SCALE: NONE		DATE: 03-14-17	DWN. BY: GPN
DWG. No: 8555-5602-D		SHEET: 1 OF 1	CKD. BY: RTH
JOB: NIKOLSKI UPGRADE			
		RURAL ENERGY GROUP 813 W. NORTHERN LIGHTS BLVD. ANCHORAGE, ALASKA 99503 HTTP://WWW.AIDEA.ORG	
		ENGINEERED & MANUFACTURED BY <i>Controlled Power, Inc.</i> BOTHELL, WASHINGTON USA (425)-485-1778 www.controlledpowerinc.com	

LINE No.
1
2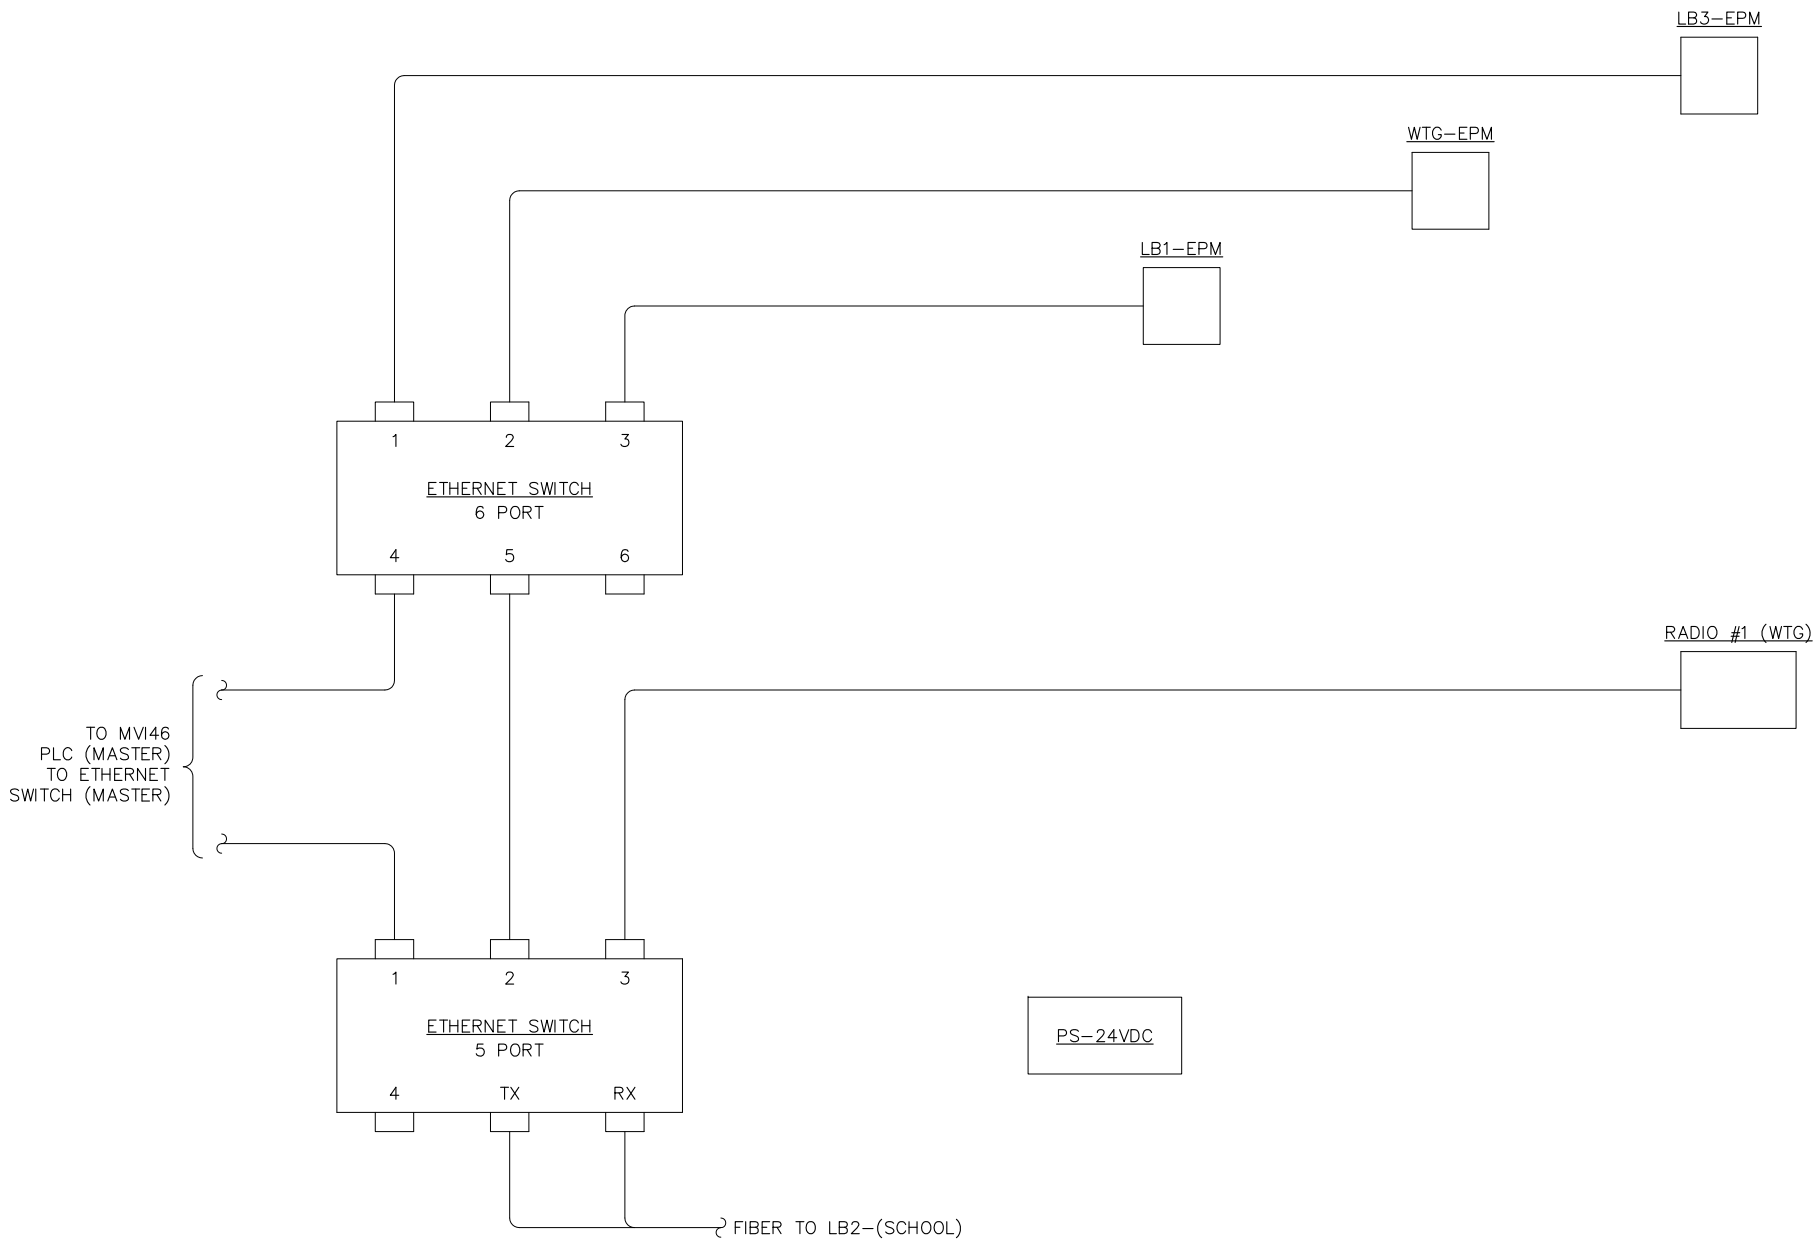
NIKOLSKI ETHERNET NETWORK, JOB No. 8555.		
DEVICE	I/P ADDRESS	LOCATION
PLC PRIMARY	192.168.1.183	GEN SWITCHGEAR
SERVER / SCADA	192.168.1.242	POWERHOUSE
OIU	192.168.1.182	GEN SWITCHGEAR
SERIAL GATEWAY	192.168.1.164	GEN SWITCHGEAR
MVI46 PROSOFT ® PLC	192.168.1.170	GEN SWITCHGEAR
RADIO 1, ACCESS POINT SN 402915, SUBNET ID=WTG-1	192.168.1.161	GEN SWITCHGEAR
WTG CONTROLLER I/O MODULE	192.168.1.189	WIND TURBINE
RADIO 2, REMOTE SN 403032, SUBNET ID=WTG-1	192.168.1.163	WIND TURBINE
PLC LOAD BANK 2	192.168.1.173	LODGE
PLC LOAD BANK 1	192.168.1.171	SCHOOL
EPM - WTG	192.168.1.175	GEN SWITCHGEAR
EPM - LB1	192.168.1.177	GEN SWITCHGEAR
EPM - LB2	192.168.1.179	LODGE
EPM - LB3	192.168.1.181	GEN SWITCHGEAR
WTG WEB SERVER, UN & PW = SERVIC OR ADMINI	192.168.1.201	WIND TURBINE
ROUTER	?	POWERHOUSE
WEB CAM	?	POWERHOUSE

NOTE:
1. FOR GENERAL WIRING & CONSTRUCTION NOTES, SEE DRAWING No. 8555-3101-D.


A	03-24-17	FIELD REVISION	GPN
REV.	DATE	DESCRIPTION	BY
AEA PURCHASE ORDER No. PREPAID CONTROLLED POWER JOB No. 8555			
TITLE: ETHERNET NETWORK, SCHEMATIC DIAGRAM			
SCALE: NONE		DATE: 03-14-17	DWN. BY: GPN
DWG. No: 8555-5603-D		SHEET: 1 OF 1	CKD. BY: RTH
JOB: NIKOLSKI UPGRADE			
 RURAL ENERGY GROUP 813 W. NORTHERN LIGHTS BLVD. ANCHORAGE, ALASKA 99503 HTTP://WWW.AIDEA.ORG			

NOTICE
THE DRAWINGS, INFORMATION AND SUBJECT MATTER HEREOF
ARE THE CONFIDENTIAL, SOLE AND EXCLUSIVE PROPERTY
OF CONTROLLED POWER, INC., AND ARE NOT TO BE COPIED,
REPRODUCED OR USED IN ANY MANNER FOR ANY PURPOSE
WHATSOEVER WITHOUT WRITTEN CONSENT OR DIRECTION.



ENGINEERED & MANUFACTURED BY
Controlled Power, Inc.
BOTHELL, WASHINGTON USA
(425)-485-1778 www.controlledpowerinc.com

LINE No.
1
2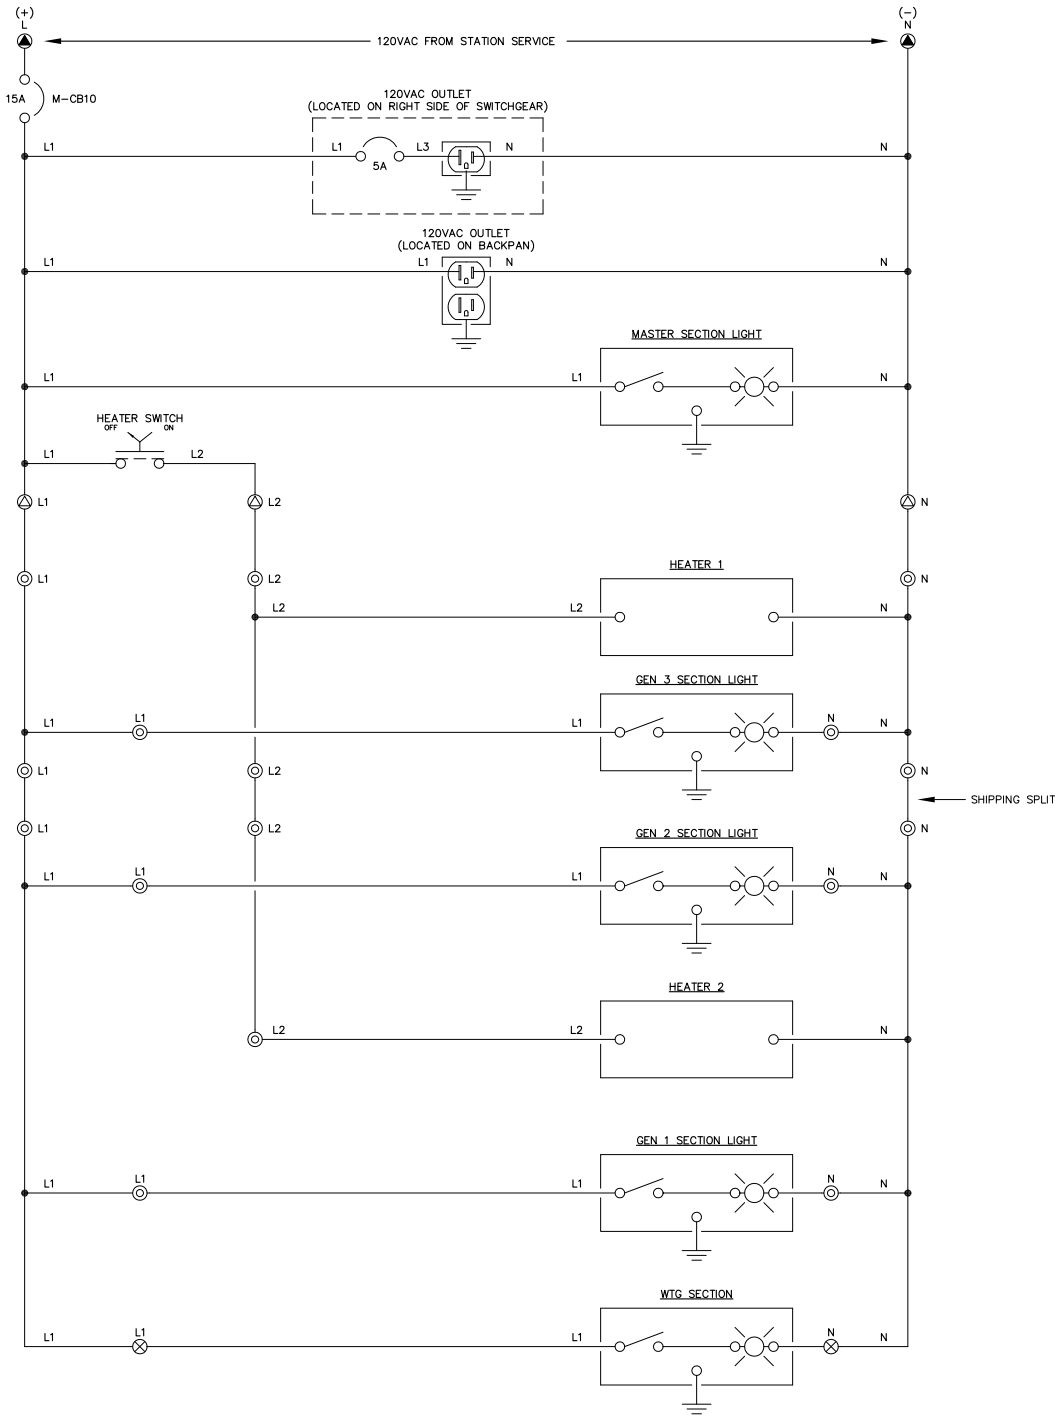
LINE No.
51
52
NOTE:
1. FOR GENERAL WIRING & CONSTRUCTION NOTES, SEE DRAWING No. 8555-3101-D.

A	03-24-17	FIELD REVISION	GPN
REV.	DATE	DESCRIPTION	BY
AEA PURCHASE ORDER No. PREPAID		CONTROLLED POWER JOB No. 8555	
TITLE: HEATER & LIGHTING CONTROL, SCHEMATIC DIAGRAM			
SCALE: NONE		DATE: 03-14-17	DWN. BY: GPN
DWG. No: 8555-5701-D		SHEET: 1 OF 1	CKD. BY: RTH
JOB: NIKOLSKI UPGRADE			


ALASKA ENERGY AUTHORITY
RURAL ENERGY GROUP
813 W. NORTHERN LIGHTS BLVD.
ANCHORAGE, ALASKA 99503
HTTP://WWW.AIDEA.ORG

NOTICE
THE DRAWINGS, INFORMATION AND SUBJECT MATTER HEREOF
ARE THE CONFIDENTIAL, SOLE AND EXCLUSIVE PROPERTY
OF CONTROLLED POWER, INC., AND ARE NOT TO BE COPIED,
REPRODUCED OR USED IN ANY MANNER FOR ANY PURPOSE
WHATSOEVER WITHOUT WRITTEN CONSENT OR DIRECTION.



ENGINEERED & MANUFACTURED BY
Controlled Power, Inc.
BOTHELL, WASHINGTON USA
(425)-485-1778 www.controlledpowerinc.com


SYSTEM MODE SWITCH – SMS

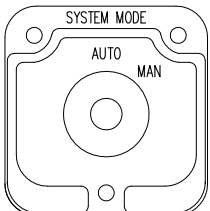

(ELECTROSWITCH 24201C)
KNURLED HANDLE
QTY 1

DECK	CONTACTS	POS.
1	12	11
	13	15
	16	17


BREAKER CONTROL SWITCH – 52CS

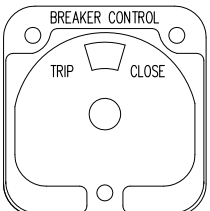

(ELECTROSWITCH 2438D)
PISTOL GRIP HANDLE
SPRING RETURN TO CENTER
QTY 1

DECK	CONTACTS	POS.
1	11	18
	16	17

GOVERNOR MODE SWITCH – GMS

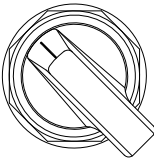


(MAINTAINED)
LOCATED ON BACK PAN

POS.
IDL.
RATED



HEATER CONTROL SWITCH – HCS

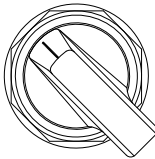


(MAINTAINED)
LOCATED ON MASTER BACK PAN

POS.
OFF
ON



ENGINE CONTROL SWITCH – ECS

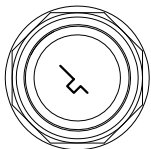

(MAINTAINED)

POS.
OFF
RUN



NOTE:










1. FOR GENERAL WIRING & CONSTRUCTION NOTES, SEE DRAWING No. 8555–3101–D.

A	03—24—17	FIELD REVISION	GPN
REV.	DATE	DESCRIPTION	BY
AEA PURCHASE ORDER No. PREPAID		CONTROLLED POWER JOB No. 8555	
TITLE: CONTROL SWITCH TARGET DIAGRAM			
SCALE: NONE		DATE: 03—14—17	DWN. BY: GPN
DWG. No: 8555—6101—D		SHEET: 1 OF 1	CKD. BY: RTH
JOB: NIKOLSKI UPGRADE			
		RURAL ENERGY GROUP 813 W. NORTHERN LIGHTS BLVD. ANCHORAGE, ALASKA 99503 HTTP://WWW.AIDEA.ORG	

NOTICE
THE DRAWINGS, INFORMATION AND SUBJECT MATTER HEREOF
ARE THE CONFIDENTIAL, SOLE AND EXCLUSIVE PROPERTY
OF CONTROLLED POWER, INC., AND ARE NOT TO BE COPIED,
REPRODUCED OR USED IN ANY MANNER FOR ANY PURPOSE
WHATSOEVER WITHOUT WRITTEN CONSENT OR DIRECTION.



ENGINEERED & MANUFACTURED BY
Controlled Power, Inc.
BOTHELL, WASHINGTON USA
(425)–485–1778 www.controlledpowerinc.com

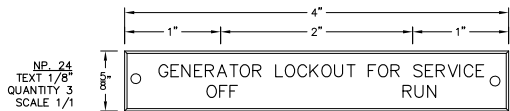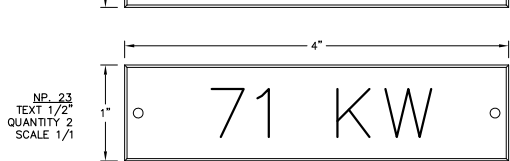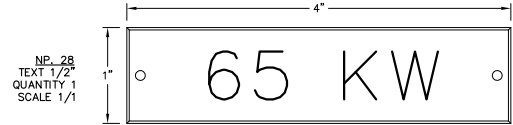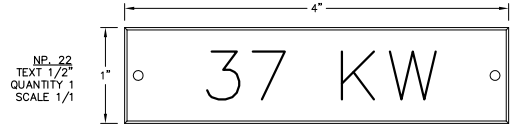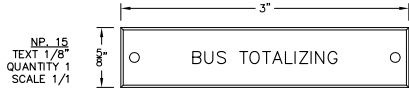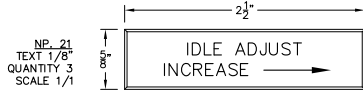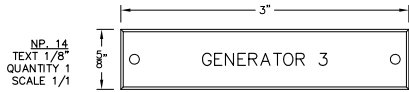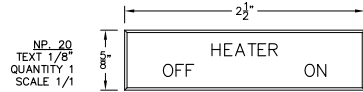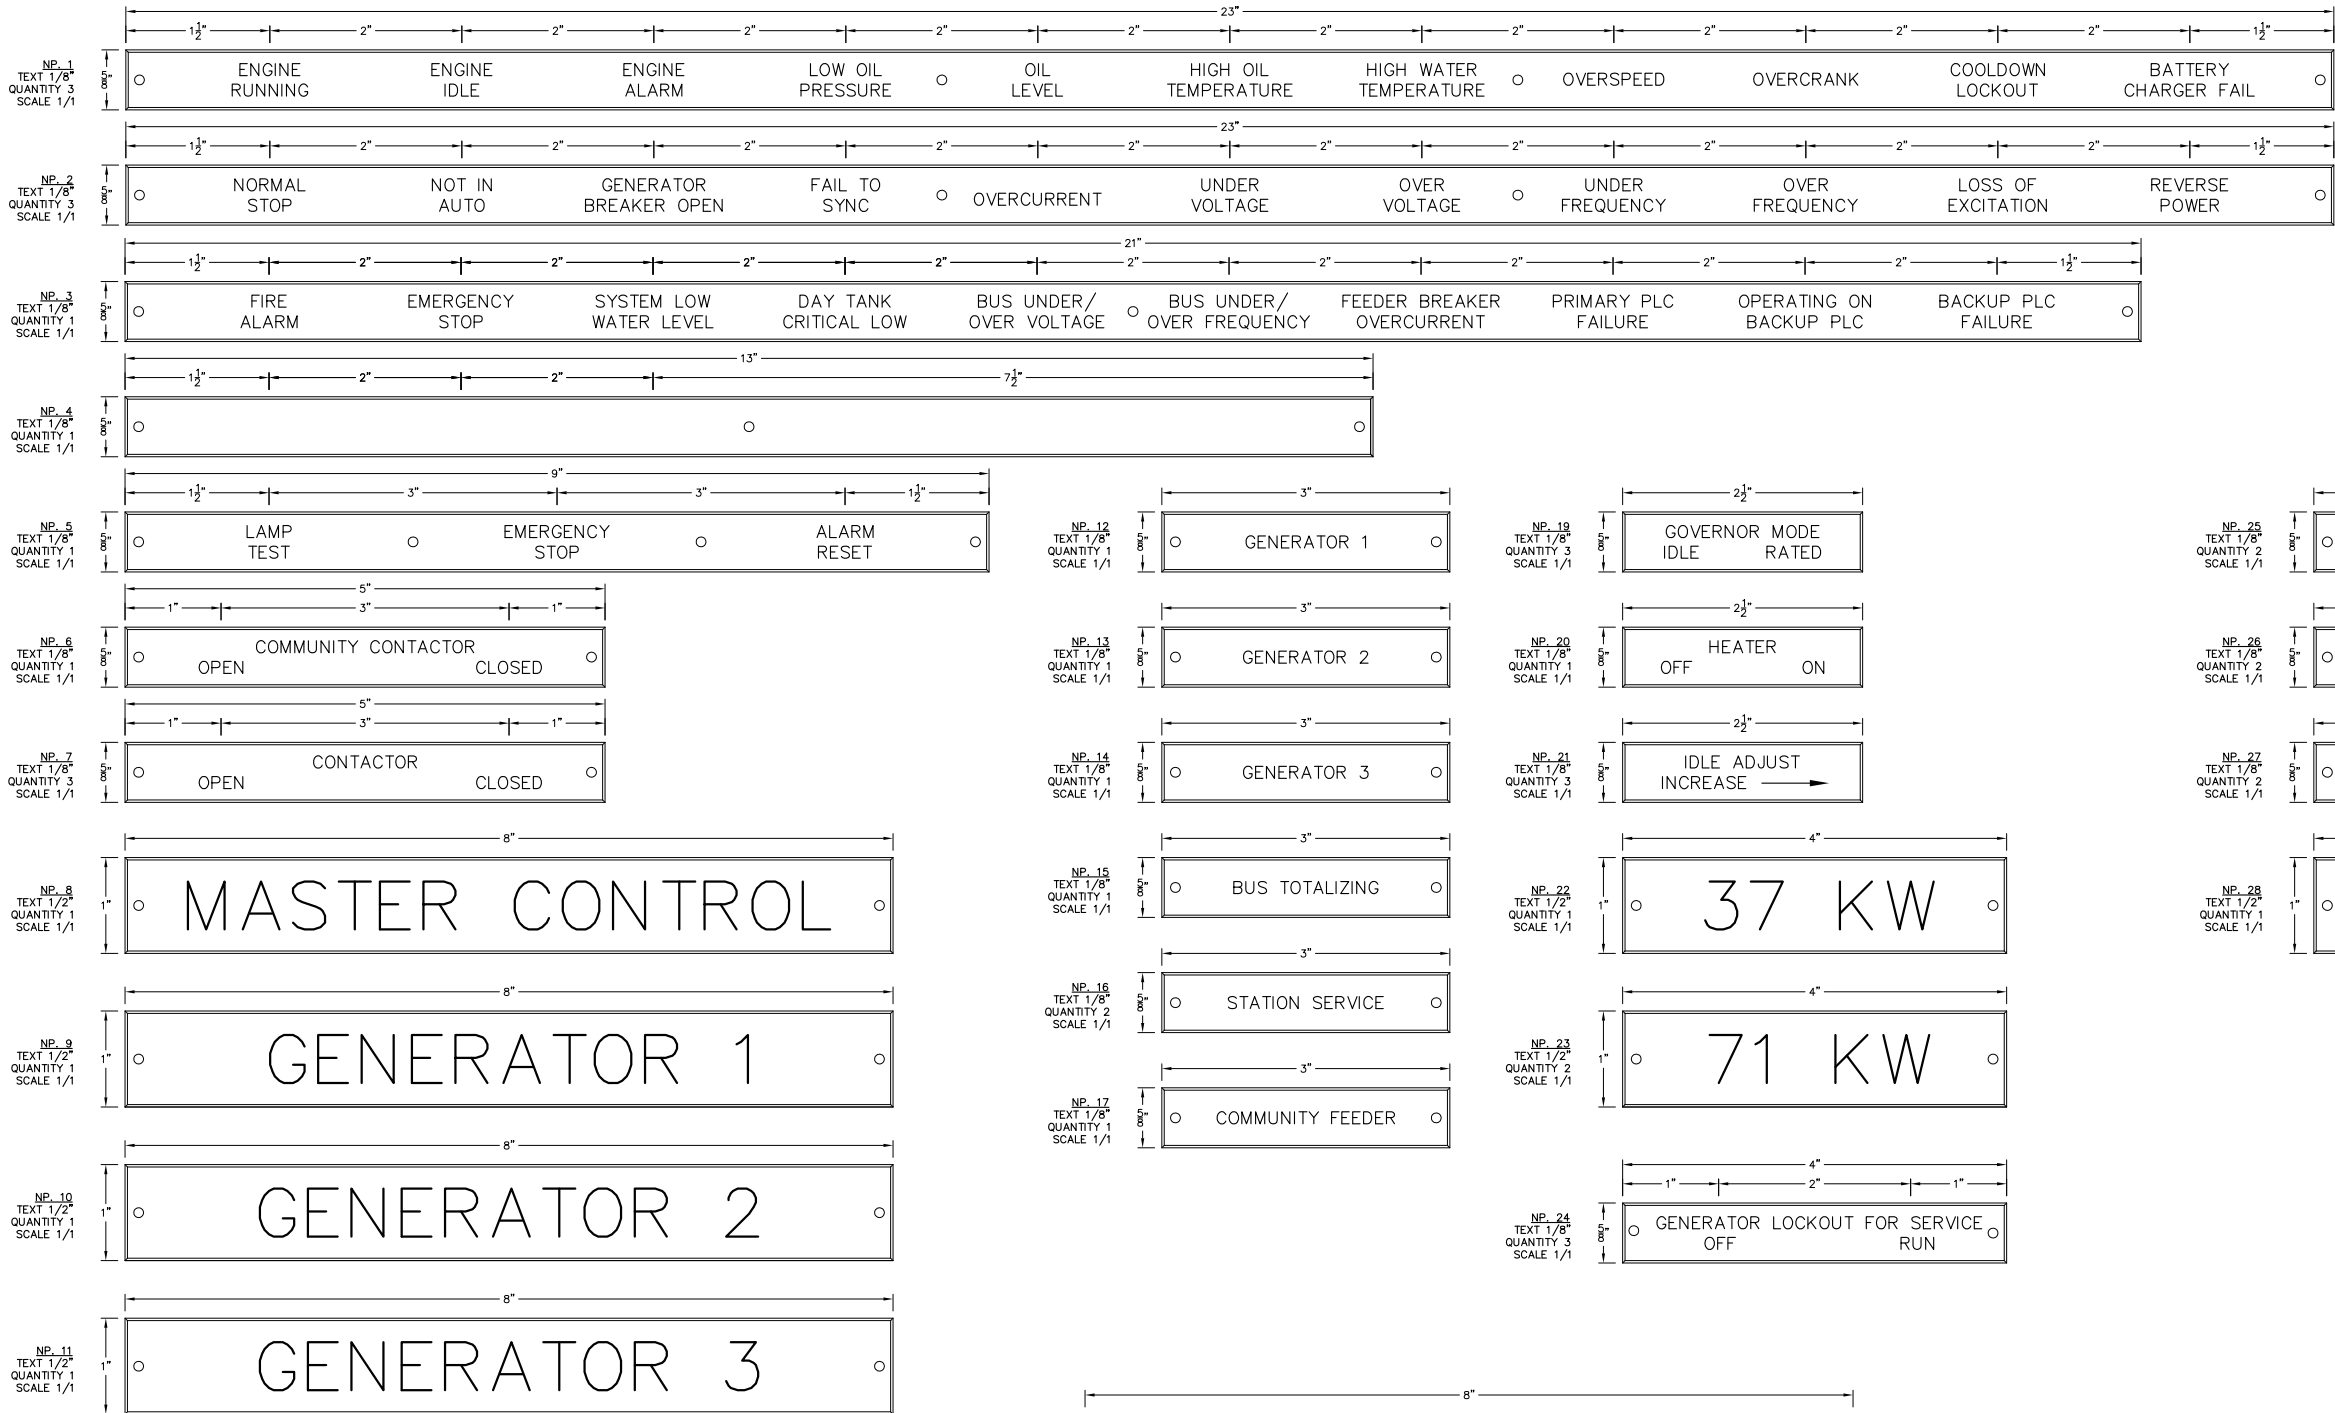

- NOTES:
- ALL NAMEPLATES SHALL BE BLACK FACE WITH WHITE LETTERS EXCEPT AS NOTED.
 - ALL NAMEPLATES SHALL HAVE PRESSURE SENSITIVE ADHESIVE ON BACK, 100 % COVERAGE.
 - ALL NAMEPLATES SHALL HAVE MOUNTING HOLES DRILLED, (1) EACH END.
- INDICATES THAT NAMEPLATE SHALL BE BRUSHED ALUMINUM WITH BLACK ENGRAVED LETTERS.

NP_18
TEXT 1/4"
QUANTITY 1
SCALE 1/1
SEE NOTE 4

MANUFACTURED BY:
CONTROLLED POWER, INC.
17909 BOTHELL EVERETT HWY., S.E. #102
BOTHELL, WA. 98012
(425)-485-1778
SERIAL NUMBER: 8555


1" 0" 1" 2"
SCALE: 1"= 1"

NOTICE
THE DRAWINGS, INFORMATION AND SUBJECT MATTER HEREOF ARE THE CONFIDENTIAL, SOLE AND EXCLUSIVE PROPERTY OF CONTROLLED POWER, INC. AND ARE NOT TO BE COPIED, REPRODUCED OR USED IN ANY MANNER FOR ANY PURPOSE WHATSOEVER WITHOUT WRITTEN CONSENT OR DIRECTION.


NOTE:
1. FOR GENERAL WIRING & CONSTRUCTION NOTES, SEE DRAWING No. 8555-3101-D.

A	03-24-17	FIELD REVISION	GPN
REV.	DATE	DESCRIPTION	BY
AEA PURCHASE ORDER No. PREPAID CONTROLLED POWER JOB No. 8555			
TITLE: NAMEPLATE ENGRAVING SCHEDULE, FABRICATION DIAGRAM			
SCALE: NONE	DATE: 03-14-17	DWN. BY: GPN	
DWG. No: 8555-6201-D	SHEET: 1 OF 1	CKD. BY: RTH	
JOB: NIKOLSKI UPGRADE			
		RURAL ENERGY GROUP 813 W. NORTHERN LIGHTS BLVD. ANCHORAGE, ALASKA 99503 HTTP://WWW.AIDEA.ORG	
ENGINEERED & MANUFACTURED BY Controlled Power, Inc. BOTHELL, WASHINGTON USA (425)-485-1778 www.controlledpowerinc.com			


MASTER CONTROL

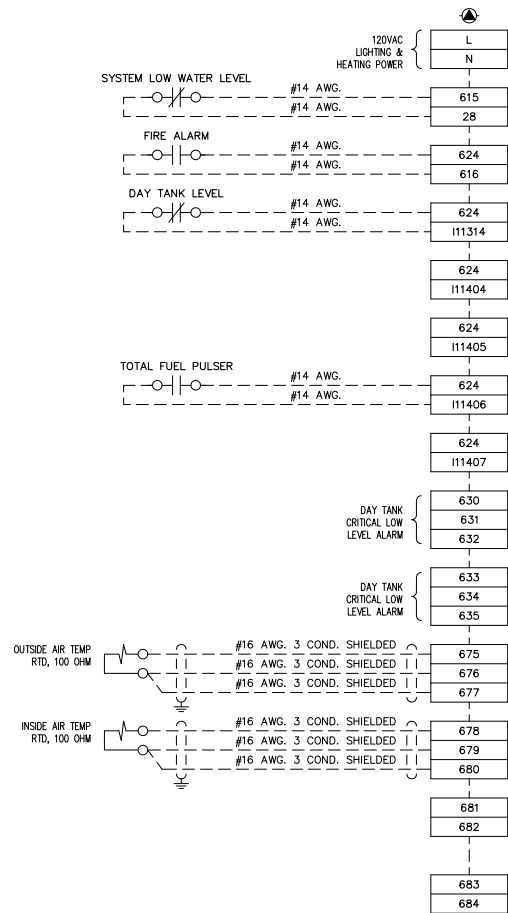


GENERATOR 3

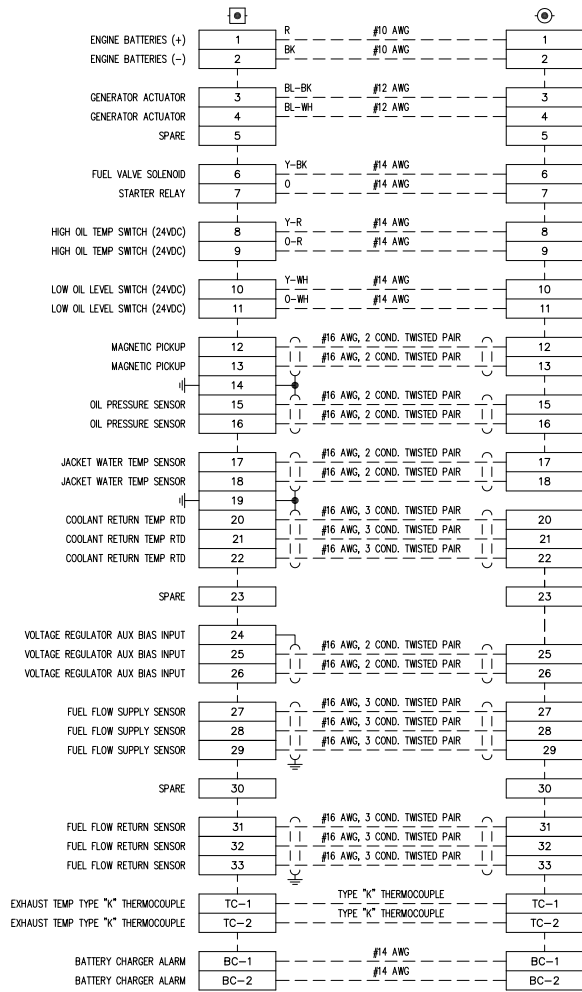

GENERATOR 2

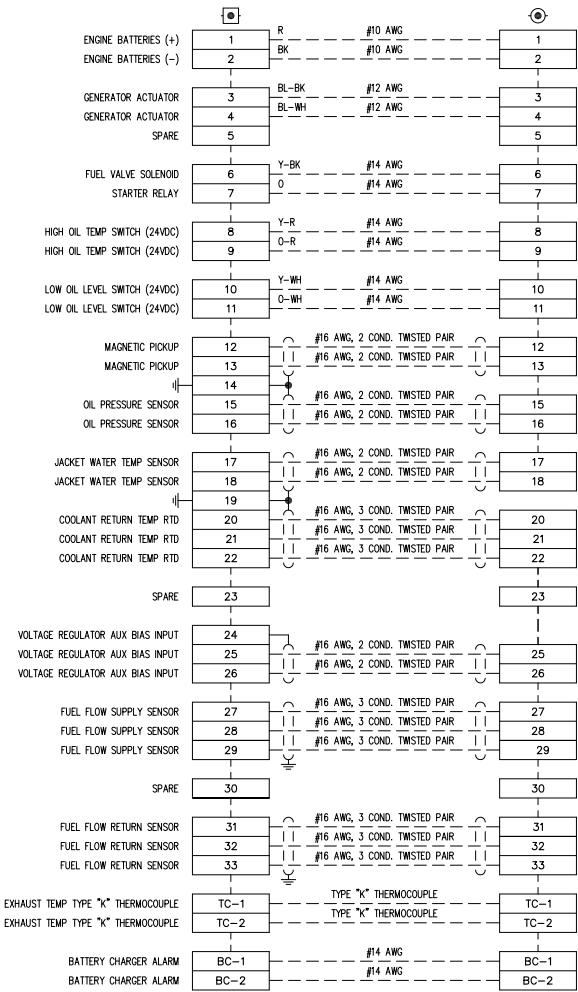

GENERATOR 1

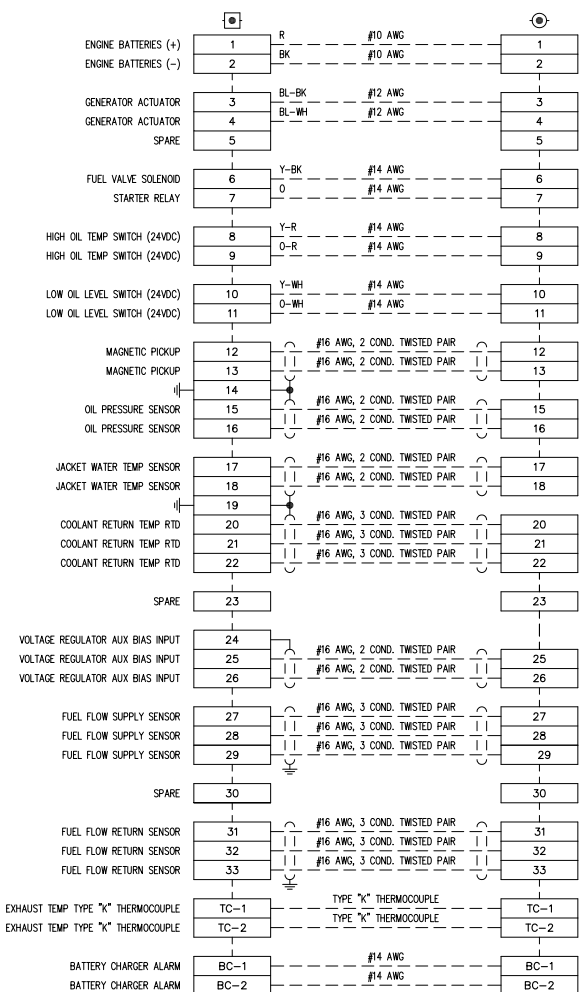

NOTE:

1. FOR GENERAL WIRING & CONSTRUCTION NOTES, SEE DRAWING No. 8555-3101-D.

A	03-24-17	FIELD REVISION	GPN
REV.	DATE	DESCRIPTION	BY
AEA PURCHASE ORDER No. PREPAID		CONTROLLED POWER JOB No. 8555	
TITLE: INTERCONNECTION DIAGRAM			
SCALE: NONE		DATE: 03-14-17	DWN. BY: GPN
DWG. No: 8555-7101-D		SHEET: 1 OF 1	CKD. BY: RTH
JOB: NIKOLSKI UPGRADE			
		RURAL ENERGY GROUP 813 W. NORTHERN LIGHTS BLVD. ANCHORAGE, ALASKA 99503 HTTP://WWW.AIDEA.ORG	

NOTICE
THE DRAWINGS, INFORMATION AND SUBJECT MATTER HEREOF
ARE THE CONFIDENTIAL, SOLE AND EXCLUSIVE PROPERTY
OF CONTROLLED POWER, INC. AND ARE NOT TO BE COPIED,
REPRODUCED OR USED IN ANY MANNER FOR ANY PURPOSE
WHATSOEVER WITHOUT WRITTEN CONSENT OR DIRECTION.





ENGINEERED & MANUFACTURED BY
Controlled Power, Inc.
BOTHELL, WASHINGTON USA
(425)-485-1778 www.controlledpowerinc.com



RURAL ENERGY GROUP
813 W. NORTHERN LIGHTS BLVD.
ANCHORAGE, ALASKA 99503
HTTP://WWW.AIDEA.ORG

RUBY GENERATOR SWITCHGEAR
ALASKA ENERGY AUTHORITY PURCHASE ORDER No. REG-11-044
CONTROLLED POWER, INC. JOB No. 7146

<u>DRAWING No.</u>	<u>DRAWING TITLE</u>
7146-2101-D	COVER SHEET
7146-3101-D	SCHEMATIC LEGEND AND NOTES
7146-4101-D	GENERATOR SWITCHGEAR ELEVATION VIEW, OUTLINE DIAGRAM
7146-4201-D	GENERATOR SWITCHGEAR PLAN VIEW, OUTLINE DIAGRAM
7146-5101-D	GENERATOR SINGLE LINE, SCHEMATIC DIAGRAM
7146-5201-D	GENERATOR 1 AC THREE LINE, SCHEMATIC DIAGRAM
7146-5202-D	GENERATOR 2 AC THREE LINE, SCHEMATIC DIAGRAM
7146-5203-D	GENERATOR 3 AC THREE LINE, SCHEMATIC DIAGRAM
7146-5204-D	MASTER AC THREE LINE, SCHEMATIC DIAGRAM
7146-5205-D	VFD AC THREE LINE, SCHEMATIC DIAGRAM
7146-5301-D	GENERATOR 1 DC CONTROL, SCHEMATIC DIAGRAM
7146-5302-D	GENERATOR 1 DC CONTROL, SCHEMATIC DIAGRAM
7146-5303-D	GENERATOR 1 DC CONTROL, SCHEMATIC DIAGRAM
7146-5304-D	GENERATOR 2 DC CONTROL, SCHEMATIC DIAGRAM
7146-5305-D	GENERATOR 2 DC CONTROL, SCHEMATIC DIAGRAM
7146-5306-D	GENERATOR 2 DC CONTROL, SCHEMATIC DIAGRAM
7146-5307-D	GENERATOR 3 DC CONTROL, SCHEMATIC DIAGRAM
7146-5308-D	GENERATOR 3 DC CONTROL, SCHEMATIC DIAGRAM
7146-5309-D	GENERATOR 3 DC CONTROL, SCHEMATIC DIAGRAM
7146-5310-D	MASTER DC CONTROL, SCHEMATIC DIAGRAM
7146-5311-D	MASTER DC CONTROL, SCHEMATIC DIAGRAM
7146-5312-D	MASTER DC CONTROL, SCHEMATIC DIAGRAM
7146-5313-D	MASTER DC CONTROL, SCHEMATIC DIAGRAM
7146-5314-D	MASTER DC CONTROL, SCHEMATIC DIAGRAM
7146-5315-D	VFD DC CONTROL, SCHEMATIC DIAGRAM
7146-5316-D	VFD DC CONTROL, SCHEMATIC DIAGRAM
7146-5317-D	VFD DC CONTROL, SCHEMATIC DIAGRAM
7146-5318-D	VFD/DISTRIBUTION DC CONTROL, SCHEMATIC DIAGRAM
7146-5401-D	FEEDER BREAKER CONTROL, SCHEMATIC DIAGRAM
7146-5501-D	PLC COMMUNICATION, SCHEMATIC DIAGRAM
7146-5502-D	PLC COMMUNICATION, SCHEMATIC DIAGRAM
7146-5601-D	COMMUNICATION NETWORK DIAGRAM
7146-5602-D	COMMUNICATION NETWORK DIAGRAM
7146-5701-D	HEATER, LIGHTING & FAN CONTROL, SCHEMATIC DIAGRAM
7146-6101-D	CONTROL SWITCH TARGET DIAGRAM
7146-6201-D	NAMEPLATE ENGRAVING SCHEDULE, FABRICATION DIAGRAM
7146-6202-D	ANNUNCIATOR WINDOWS, FABRICATION DIAGRAM
7146-7101-D	INTERCONNECTION DIAGRAM

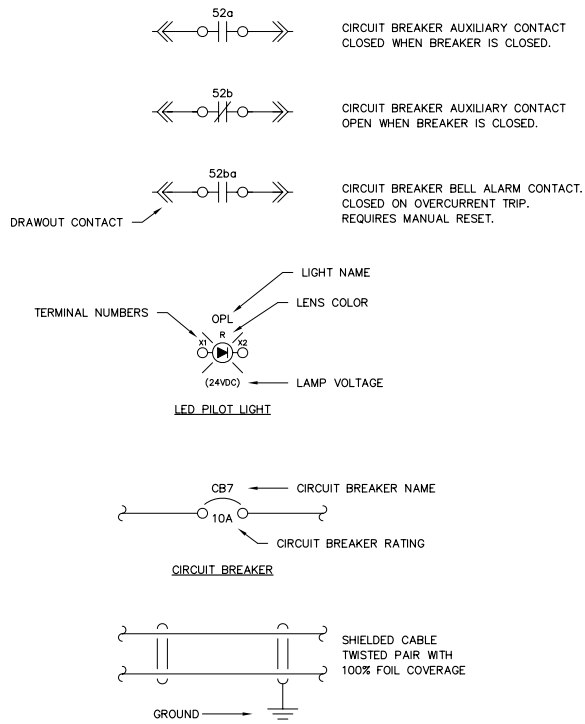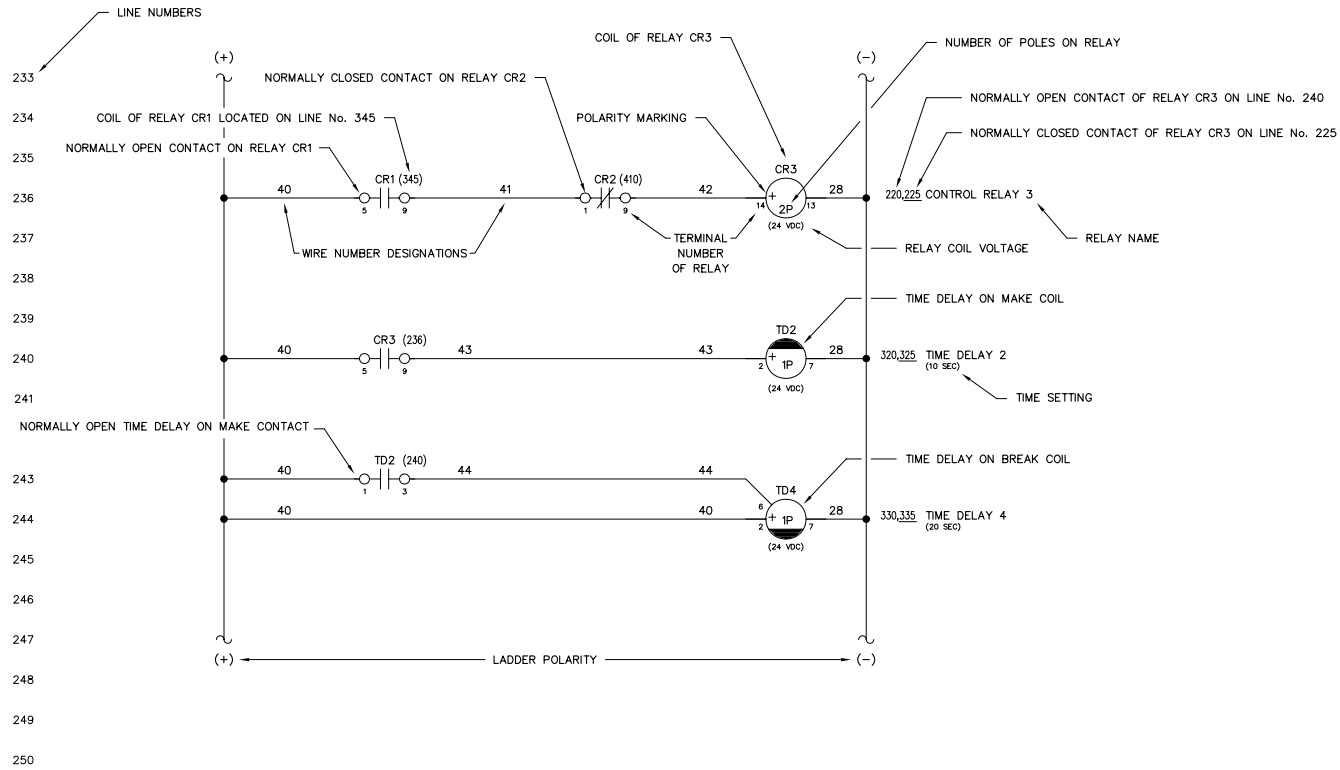

NOTES:

1. SCHEMATIC IS SHOWN AS FOLLOWS:
 - ALL AC AND DC POWER REMOVED
 - ALL RELAY CONTACTS DE-ENERGIZED
 - ALL CIRCUIT BREAKERS IN THE OPEN/RESET POSITION
 - ALL MODE SWITCHES IN THE "OFF" POSITION
 - ALL EMERGENCY STOP SWITCHES IN THE "NORMAL" POSITION
 - ALL PRESSURE SWITCHES SHOWN WITHOUT PRESSURE PRESENT
 - ALL LEVEL SWITCHES SHOWN WITHOUT FLUID PRESENT
 - ALL TEMPERATURE SWITCHES SHOWN AT AMBIENT
2.  INDICATES FIELD TERMINALS IN GENERATOR CONTROL SECTION.
3.  INDICATES TERMINALS AT ENGINE/GENERATOR.
4.  INDICATES INTERCONNECT TERMINALS IN MASTER SECTION.
5.  INDICATES FIELD TERMINALS IN MASTER SECTION.
6.  INDICATES INTERCONNECT TERMINALS IN GENERATOR CONTROL SECTION.
7.  INDICATES INTERCONNECT TERMINALS IN VFD/DIST SECTION.
8.  INDICATES FIELD TERMINALS IN VFD/DIST SECTION.
9. - INDICATES FIELD WIRING BY OTHERS
 - ALL CONTROL WIRING TO BE No. 14 AWG, 600 VOLT, TYPE SIS EXCEPT AS NOTED
10. SHIELDED WIRING TO BE No. 18 AWG, 300 VOLT, TWISTED LINE WITH 100% FOIL COVERAGE
11. ALL DIODES ARE 1N4007 EXCEPT AS NOTED


NOTICE

THE DRAWINGS, INFORMATION AND SUBJECT MATTER HEREOF ARE THE CONFIDENTIAL, SOLE AND EXCLUSIVE PROPERTY OF CONTROLLED POWER, INC. AND ARE NOT TO BE COPIED, REPRODUCED OR USED IN ANY MANNER FOR ANY PURPOSE WHATSOEVER WITHOUT WRITTEN CONSENT OR DIRECTION.


ALASKA
ENERGY AUTHORITY

RURAL ENERGY GROUP
813 W. NORTHERN LIGHTS BLVD.
ANCHORAGE, ALASKA 99503
HTTP://WWW.AIDEA.ORG

A	05-04-11	SHOP AS BUILT	GPN
REV.	DATE	DESCRIPTION	BY
AEA PURCHASE ORDER No. REG-11-044			
CONTROLLED POWER JOB No. 7146			
TITLE: SCHEMATIC LEGEND & NOTES			
SCALE: NONE		DATE: 03-01-11	DWN. BY: GPN
DWG. No: 7146-3101-D		SHEET: 1 OF 1	CKD. BY: JMD
JOB: RUBY GENERATOR SWITCHGEAR			

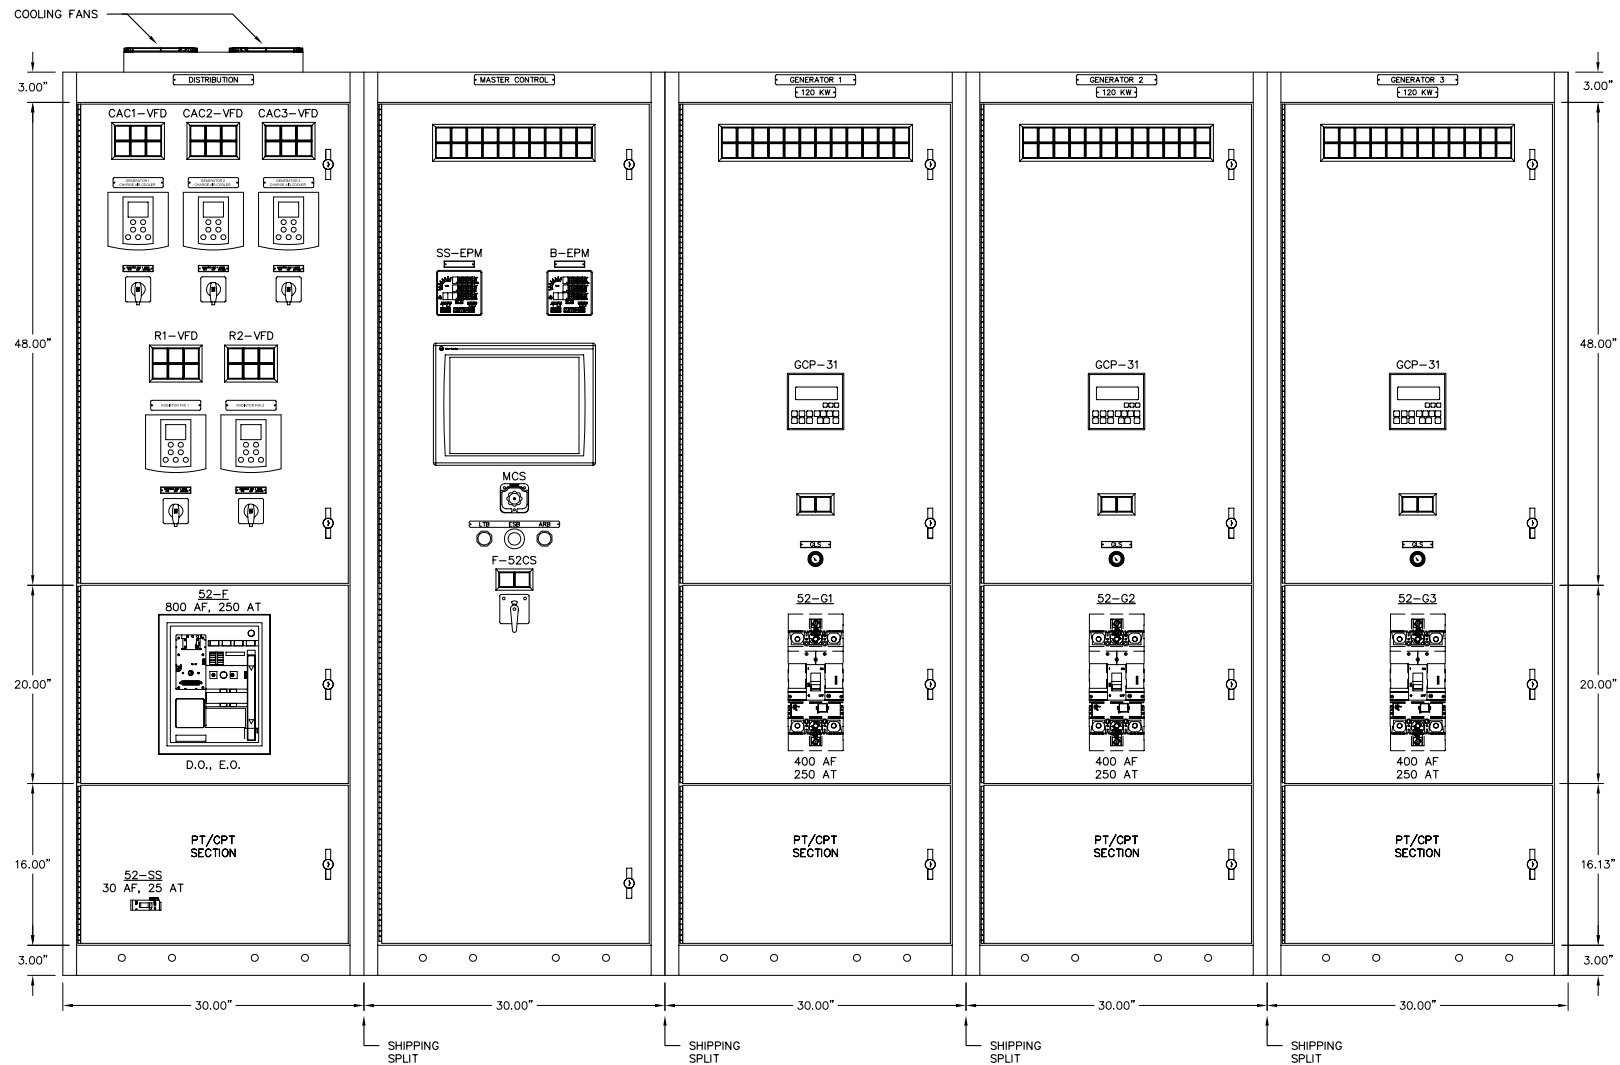

GENERATOR SWITCHGEAR — FRONT VIEW
277/480V, 1600A, COPPER BUS, 3Ø, 4W 65 KAIC

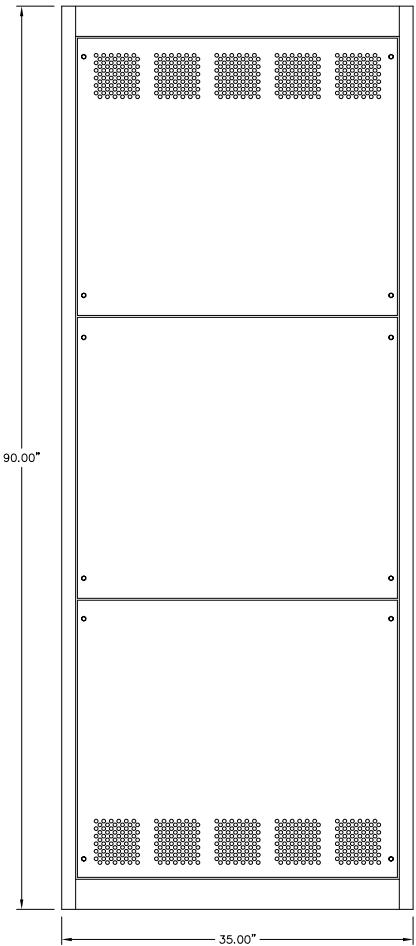

SIDE VIEW

- NOTES:
1. EACH SECTION SHIPPED INDIVIDUALLY.

A	05-04-11	SHOP AS BUILT	GPN
REV.	DATE	DESCRIPTION	BY
AEA PURCHASE ORDER No. REG-11-044 CONTROLLED POWER JOB No. 7146			
TITLE: GENERATOR SWITCHGEAR ELEVATION VIEW, OUTLINE DIAGRAM			
SCALE: 1/10		DATE: 02-09-11	DWN. BY: GPN
DWG. No: 7146-4101-D		SHEET: 1 OF 1	CKD. BY: JMD
JOB: RUBY GENERATOR SWITCHGEAR			


NOTICE

THE DRAWINGS, INFORMATION AND SUBJECT MATTER HEREOF ARE THE CONFIDENTIAL, SOLE AND EXCLUSIVE PROPERTY OF CONTROLLED POWER, INC. AND ARE NOT TO BE COPIED, REPRODUCED OR USED IN ANY MANNER FOR ANY PURPOSE WHATSOEVER WITHOUT WRITTEN CONSENT OR DIRECTION.

ALASKA

ENERGY AUTHORITY

RURAL ENERGY GROUP
813 W. NORTHERN LIGHTS BLVD.
ANCHORAGE, ALASKA 99503
HTTP://WWW.AIDEA.ORG

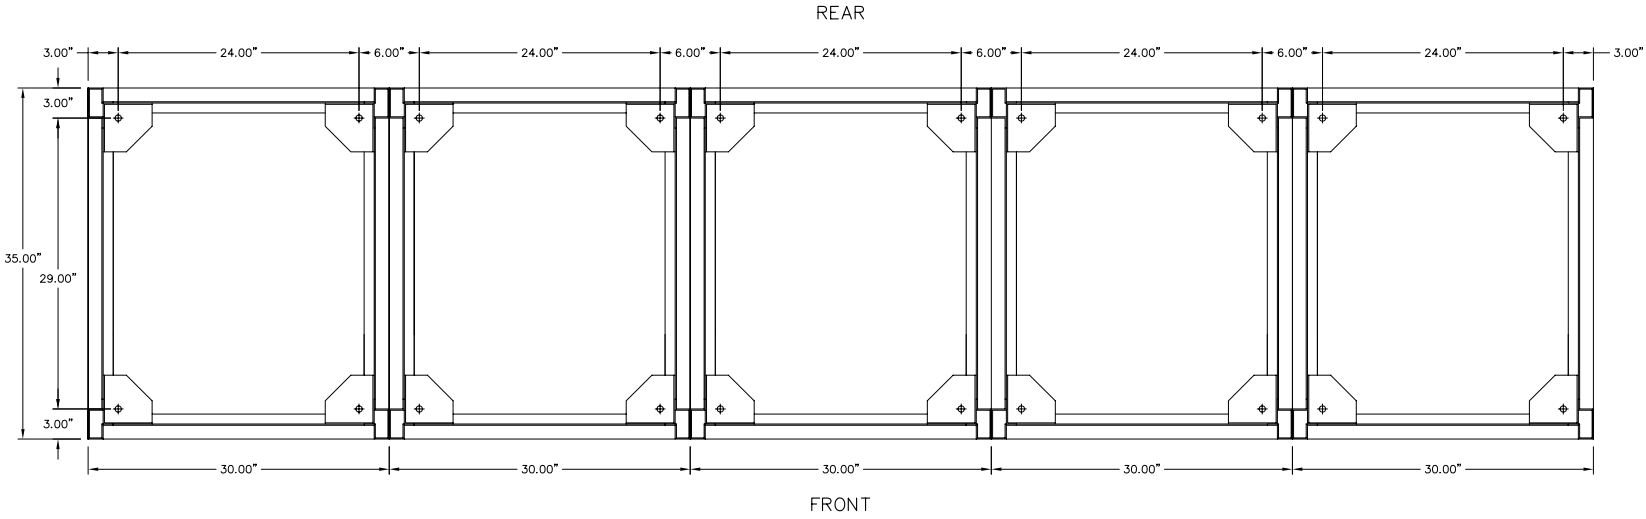

GENERATOR SWITCHGEAR — PLAN VIEW

- NOTES:
1. EACH SECTION SHIPPED INDIVIDUALLY.

A	05-04-11	SHOP AS BUILT	GPN
REV.	DATE	DESCRIPTION	BY
AEA PURCHASE ORDER No. REG-11-044		CONTROLLED POWER JOB No. 7146	
TITLE: GENERATOR SWITCHGEAR PLAN VIEW, OUTLINE DIAGRAM			
SCALE: 1/10		DATE: 03-01-11	DWN. BY: GPN
DWG. No: 7146-4201-D		SHEET: 1 OF 1	CKD. BY: JMD
JOB: RUBY GENERATOR SWITCHGEAR			


NOTICE
THE DRAWINGS, INFORMATION AND SUBJECT MATTER HEREOF ARE THE CONFIDENTIAL, SOLE AND EXCLUSIVE PROPERTY OF CONTROLLED POWER, INC. AND ARE NOT TO BE COPIED, REPRODUCED OR USED IN ANY MANNER FOR ANY PURPOSE WHATSOEVER WITHOUT WRITTEN CONSENT OR DIRECTION.




ALASKA
ENERGY AUTHORITY

RURAL ENERGY GROUP
813 W. NORTHERN LIGHTS BLVD.
ANCHORAGE, ALASKA 99503
[HTTP://WWW.AIDEA.ORG](http://www.aidea.org)

LINE No.
1
2
3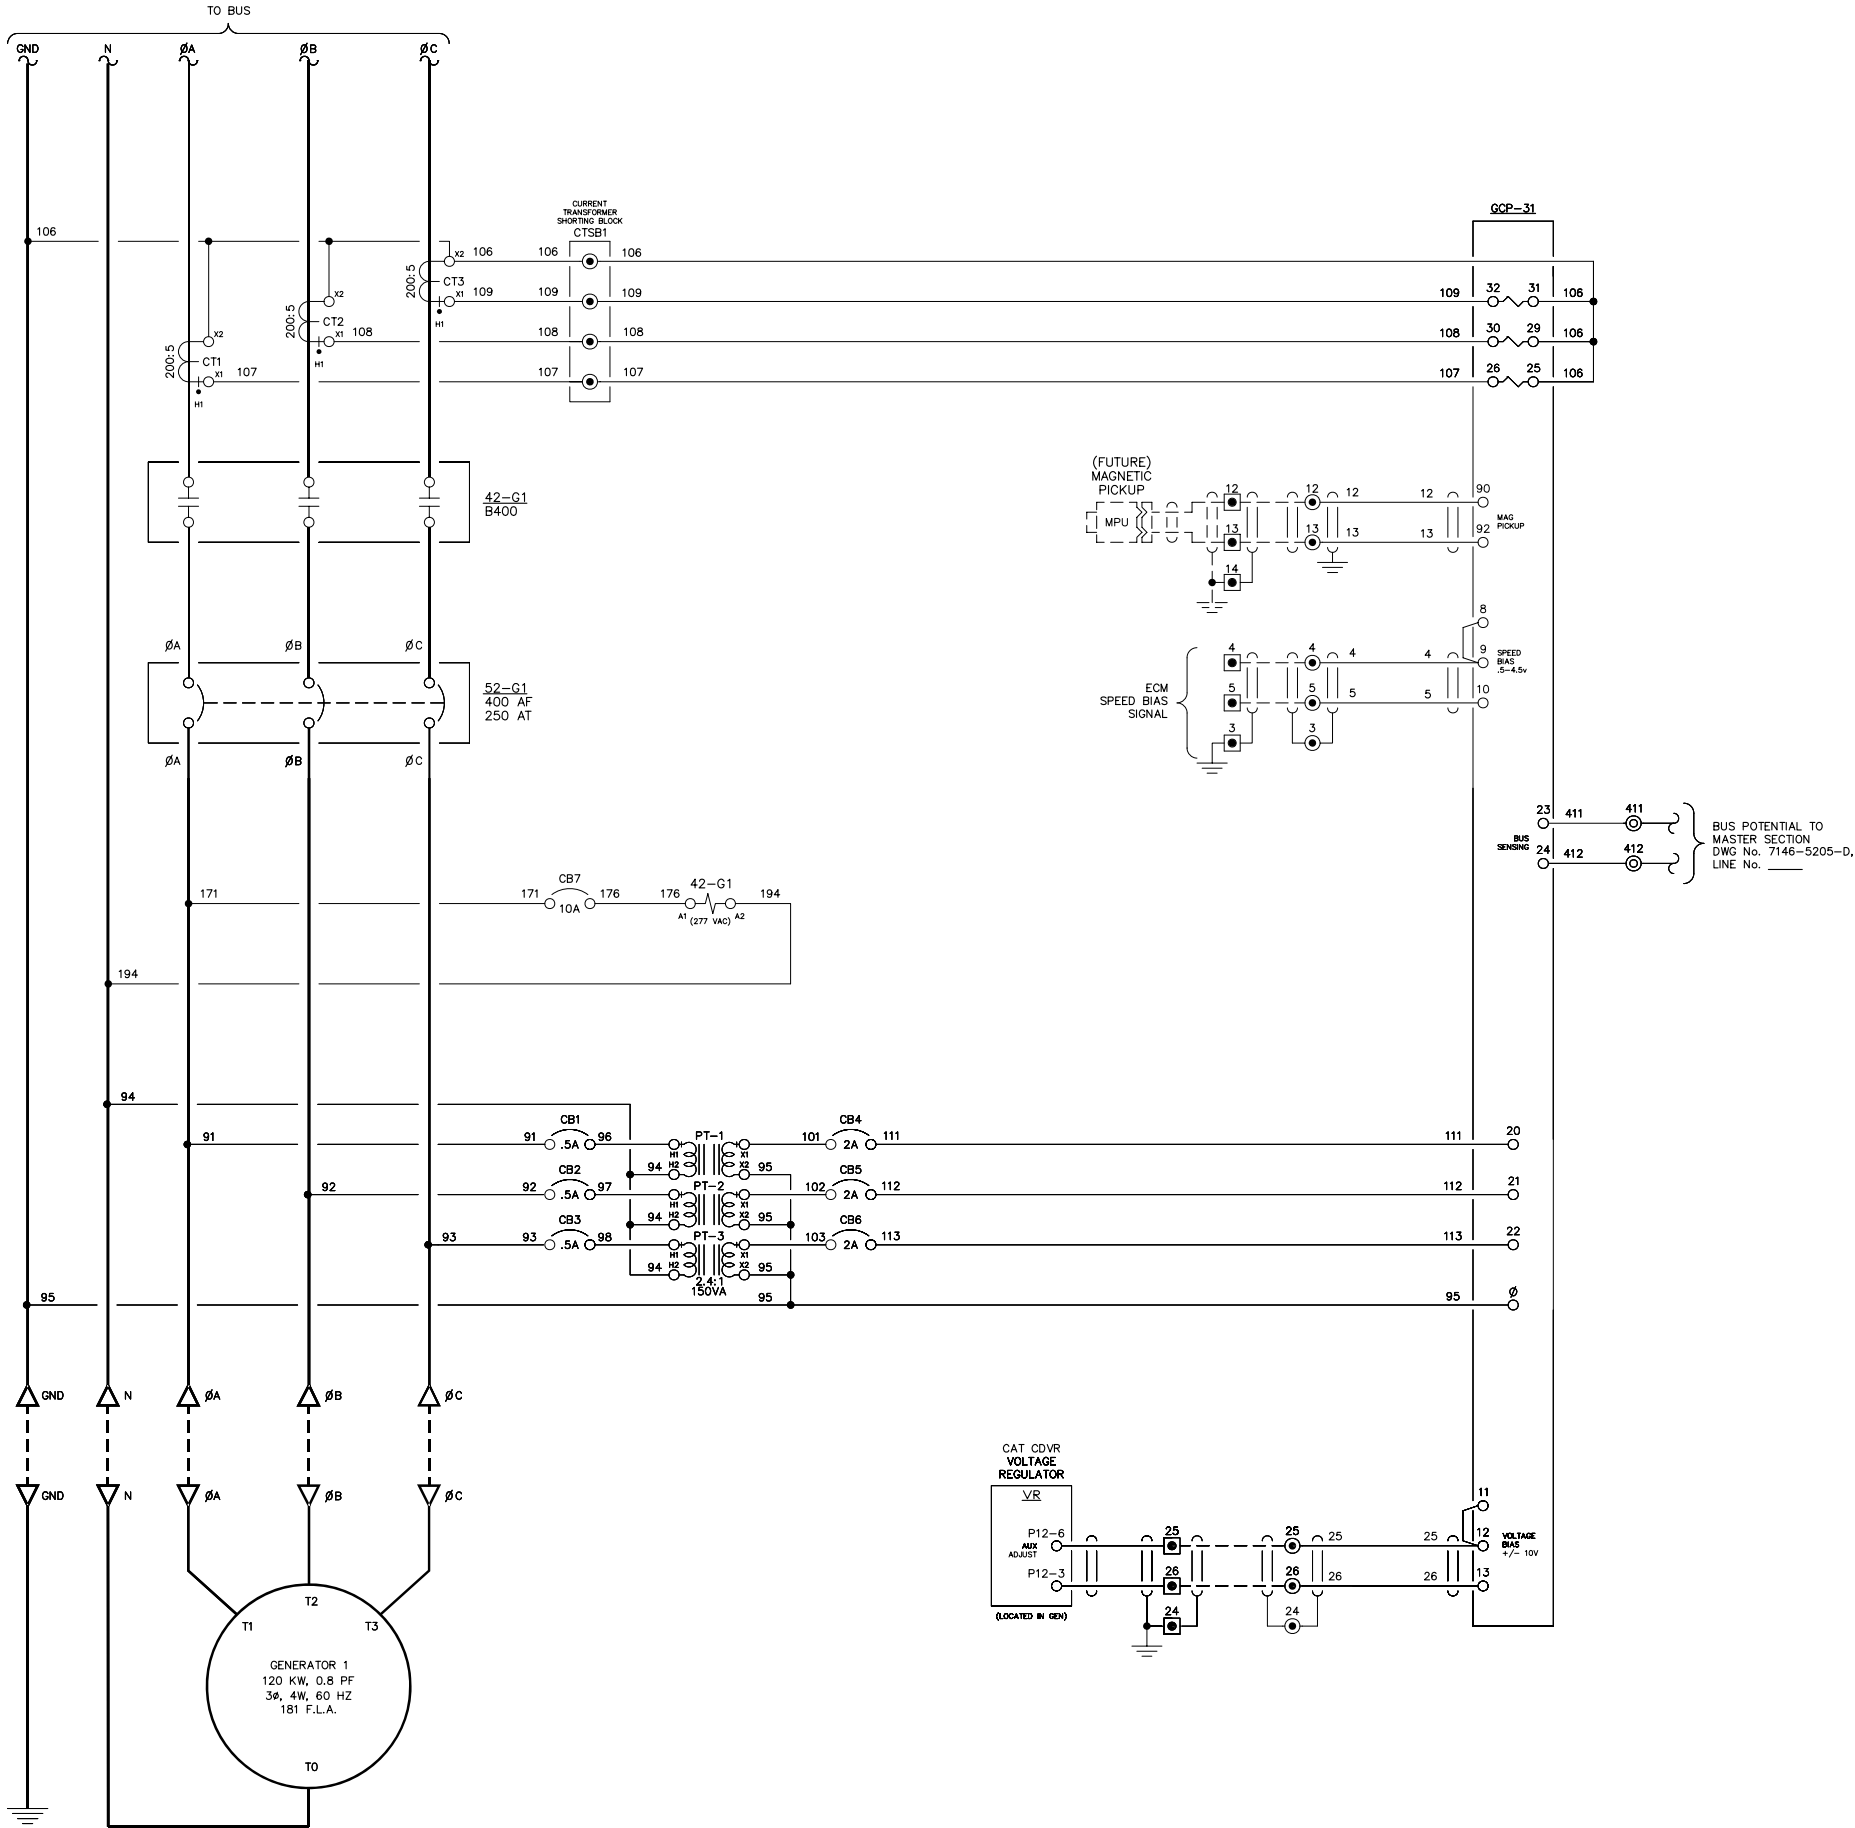
LINE No.
51
52
53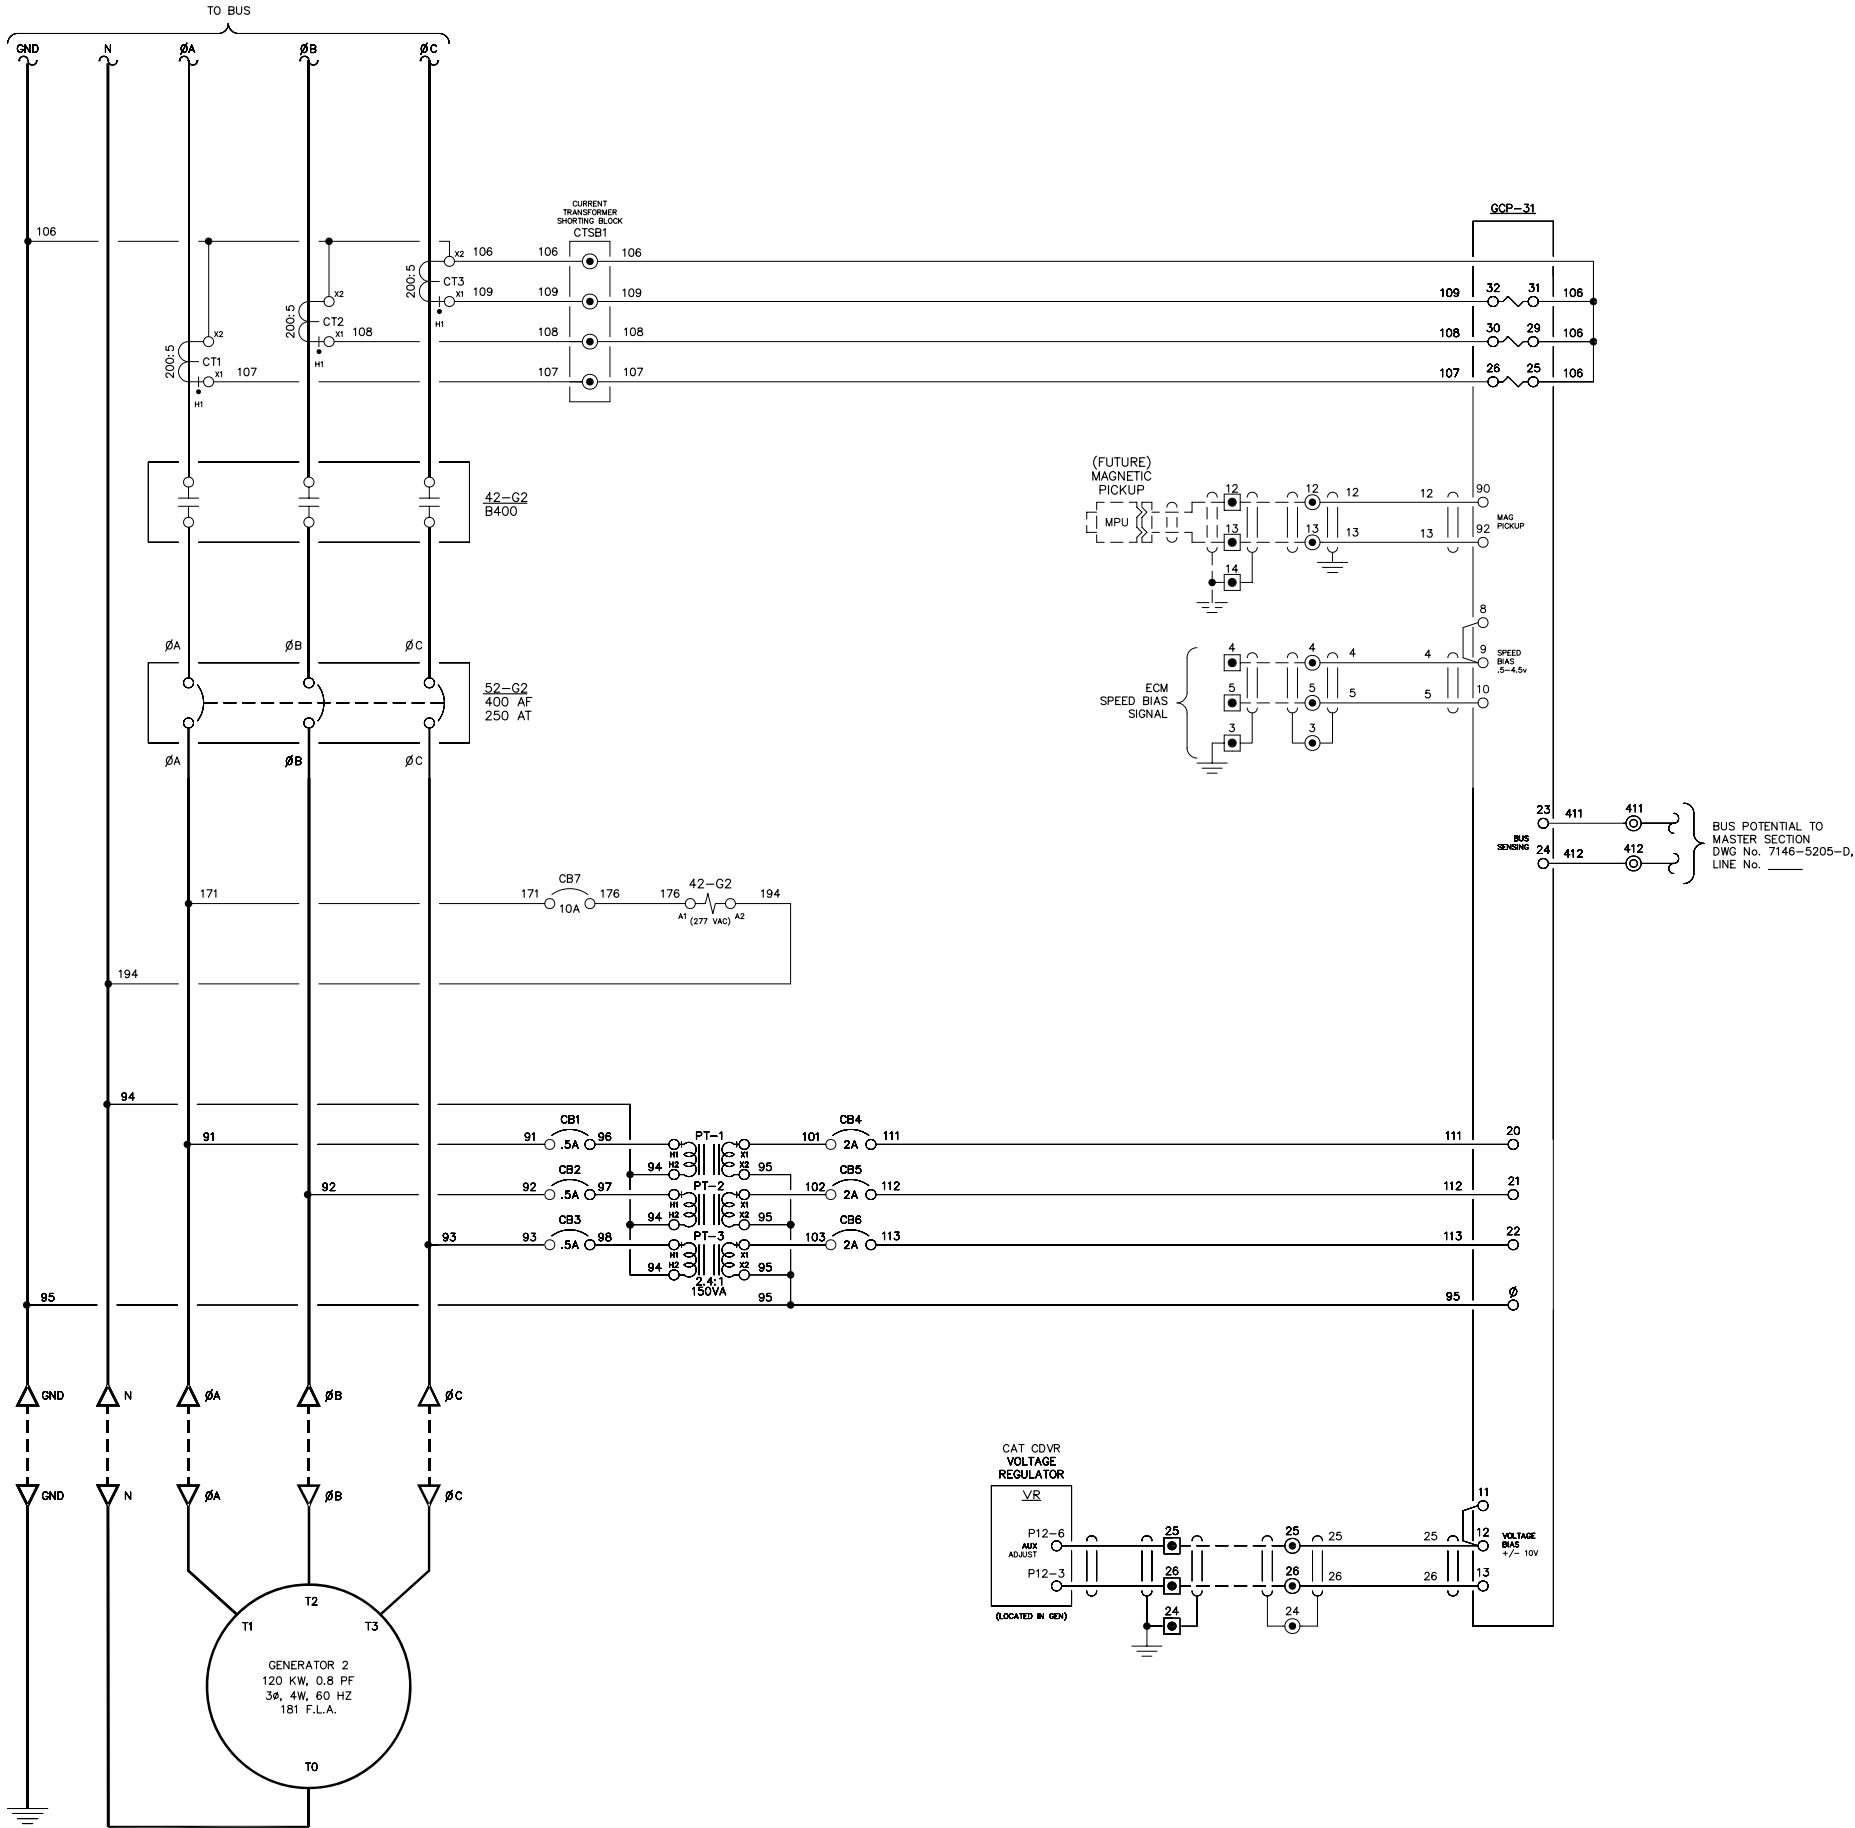
NOTE:
1. FOR GENERAL WIRING & CONSTRUCTION NOTES, SEE DRAWING No. 7146-3101-D.

A	05-04-11	SHOP AS BUILT	GPN
REV.	DATE	DESCRIPTION	BY
AEA PURCHASE ORDER No. REG-11-044 CONTROLLED POWER JOB No. 7146			
TITLE: GENERATOR 2 AC THREE LINE, SCHEMATIC DIAGRAM			
SCALE: NONE		DATE: 03-01-11	DWN. BY: GPN
DWG. No: 7146-5202-D		SHEET: 1 OF 1	CKD. BY: JMD
JOB: RUBY GENERATOR SWITCHGEAR			

NOTICE
THE DRAWINGS, INFORMATION AND SUBJECT MATTER HEREOF ARE THE CONFIDENTIAL, SOLE AND EXCLUSIVE PROPERTY OF CONTROLLED POWER, INC. AND ARE NOT TO BE COPIED, REPRODUCED OR USED IN ANY MANNER FOR ANY PURPOSE WHATSOEVER WITHOUT WRITTEN CONSENT OR DIRECTION.

RURAL ENERGY GROUP
813 W. NORTHERN LIGHTS BLVD.
ANCHORAGE, ALASKA 99503
HTTP://WWW.AIDEA.ORG

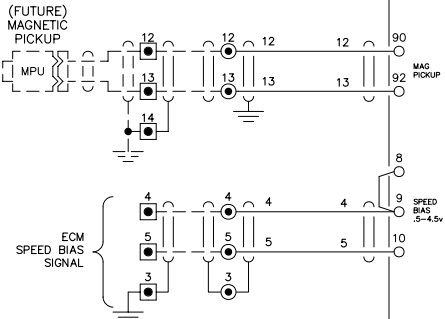


ALASKA
ENERGY AUTHORITY

RURAL ENERGY GROUP
813 W. NORTHERN LIGHTS BLVD.
ANCHORAGE, ALASKA 99503
HTTP://WWW.AIDEA.ORG

Plot date: 2011/4/27 - 9:5

201
202
203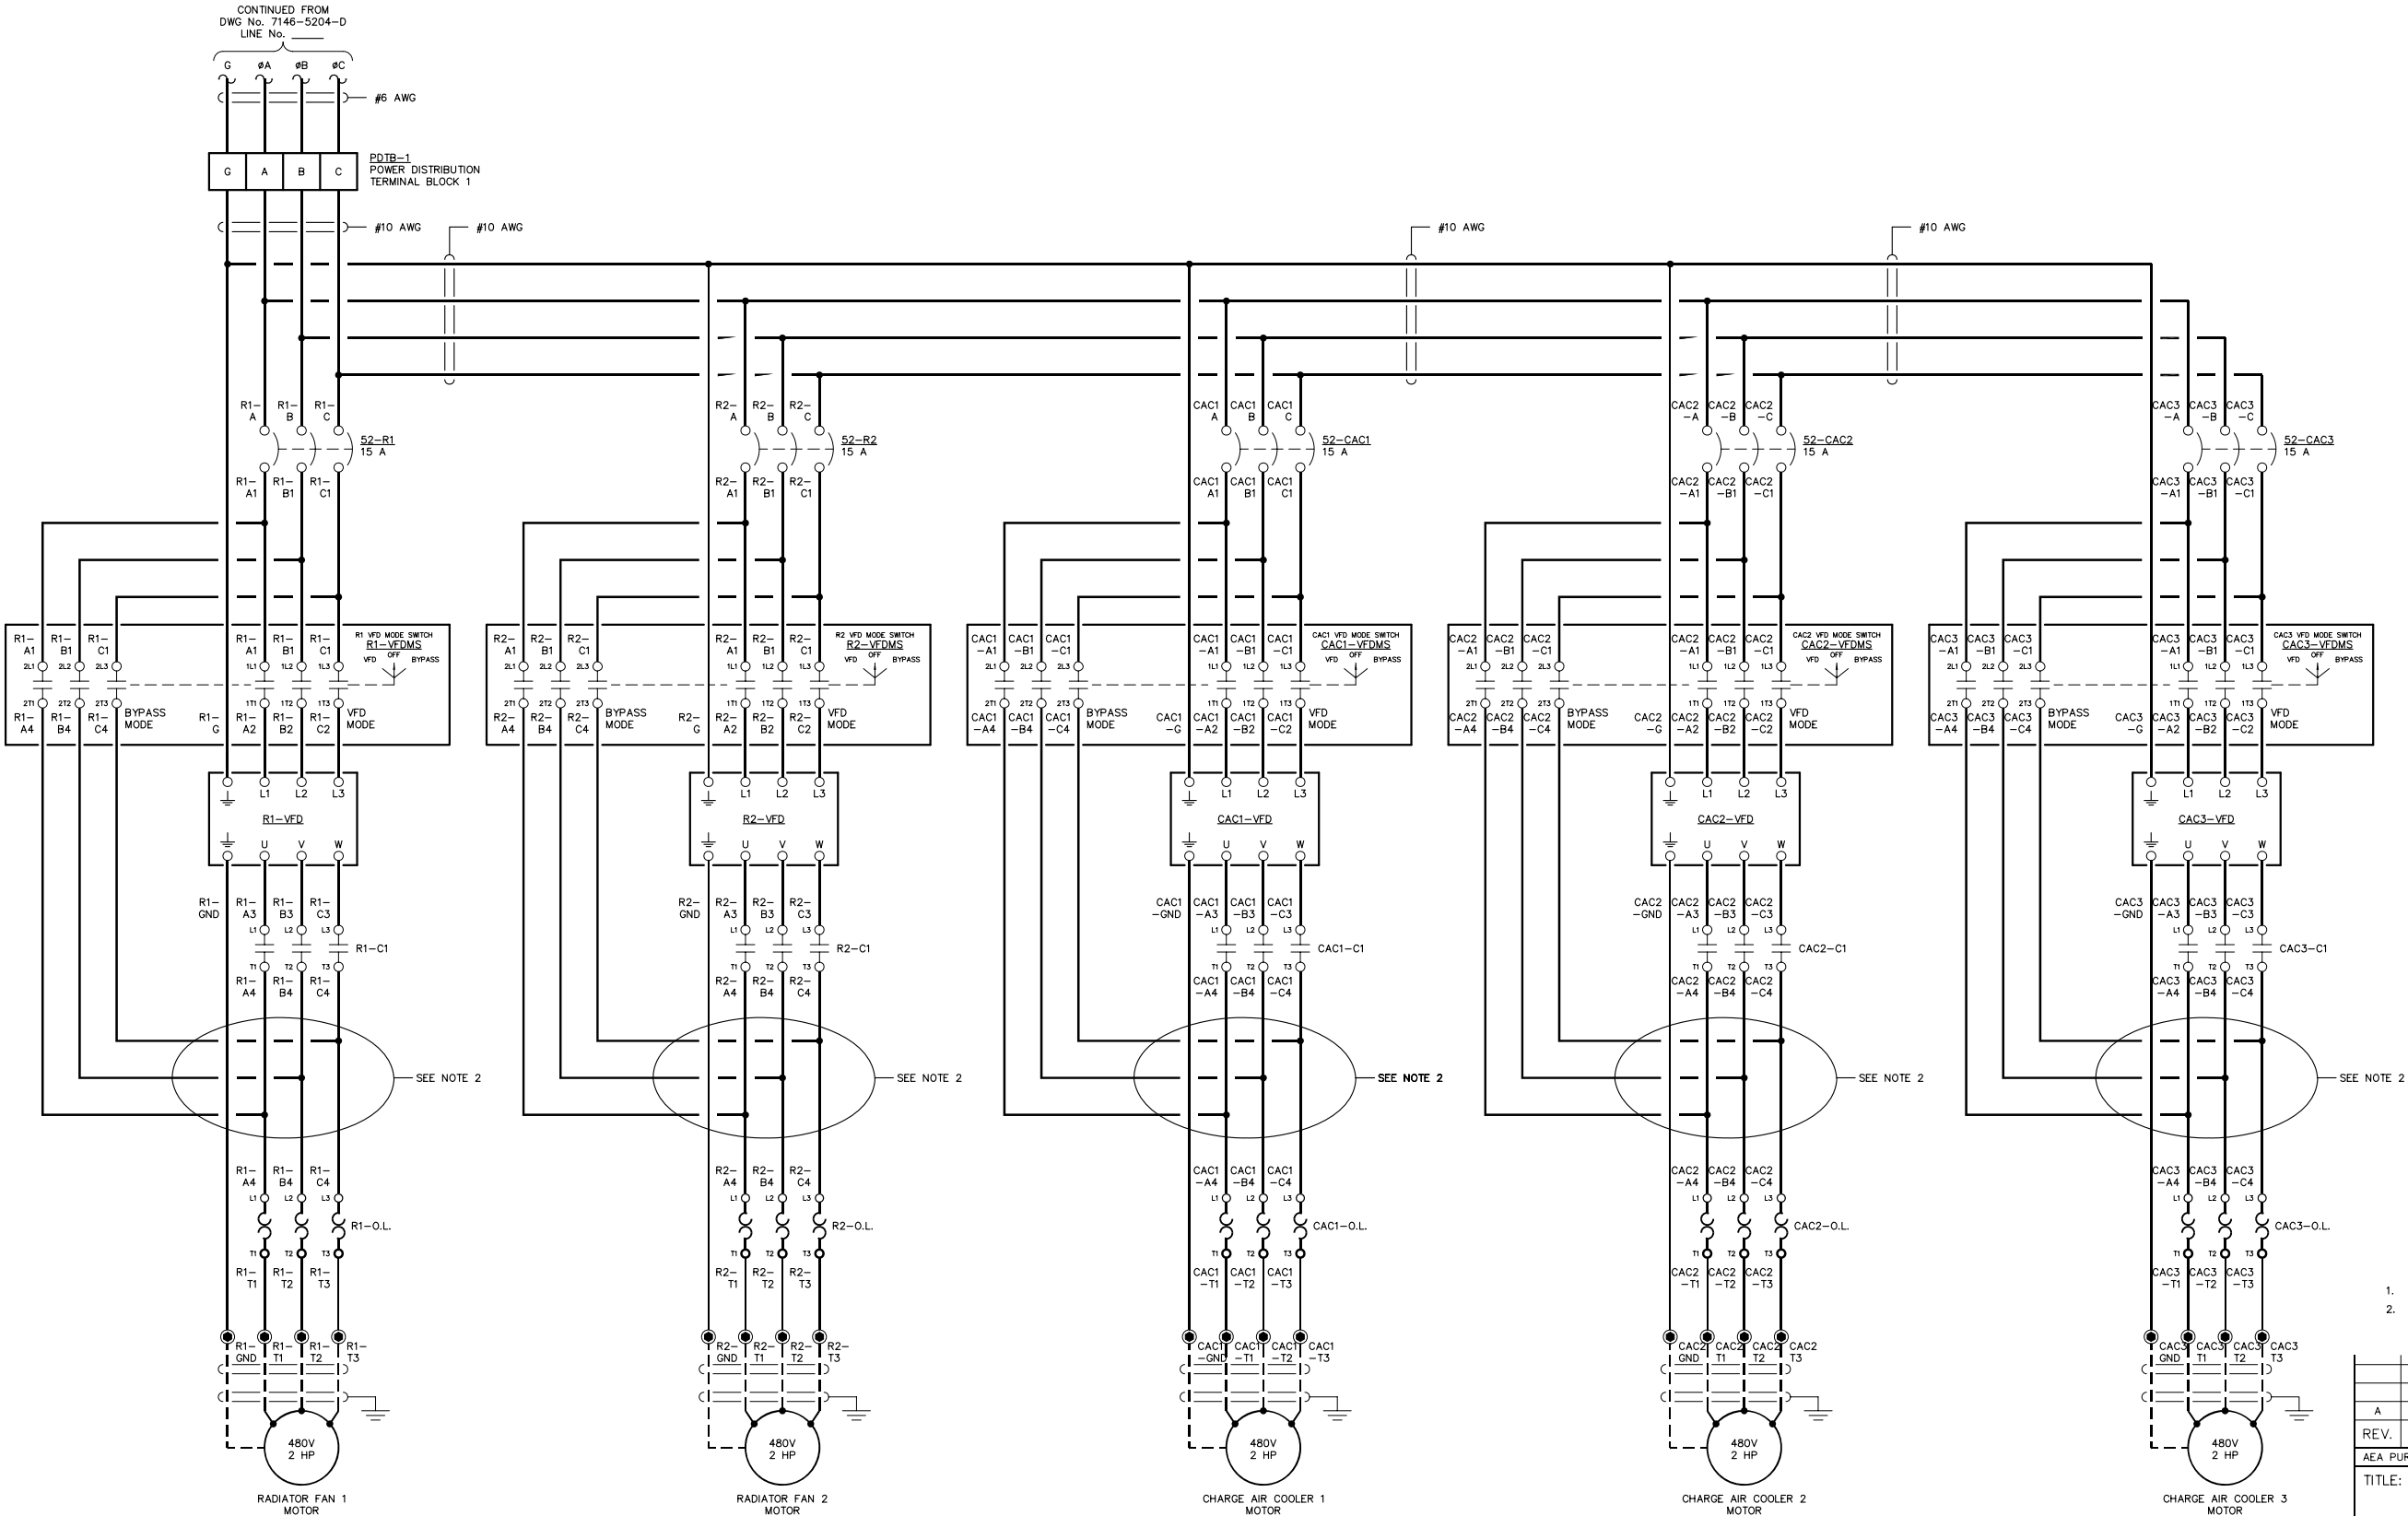
- NOTE:
- FOR GENERAL WIRING & CONSTRUCTION NOTES, SEE DRAWING No. 7146-3101-D.
 - VFD LOAD WIRES SHALL BE ROUTED SEPARATE FROM ALL OTHER WIRING OR SHIELDED TO AVOID RF INTERFERENCE.



A	05-04-11	SHOP AS BUILT	GPN
REV.	DATE	DESCRIPTION	BY
AEA PURCHASE ORDER No. REG-11-044			
CONTROLLED POWER JOB No. 7146			
TITLE: VFD THREE LINE, SCHEMATIC DIAGRAM			
SCALE: NONE		DATE: 03-01-11	DWN. BY: GPN
DWG. No: 7146-5205-D		SHEET: 1 OF 1	CKD. BY: JMD
JOB: RUBY GENERATOR SWITCHGEAR			

NOTICE

THE DRAWINGS, INFORMATION AND SUBJECT MATTER HEREOF ARE THE CONFIDENTIAL, SOLE AND EXCLUSIVE PROPERTY OF CONTROLLED POWER, INC. AND ARE NOT TO BE COPIED, REPRODUCED OR USED IN ANY MANNER FOR ANY PURPOSE WHATSOEVER WITHOUT WRITTEN CONSENT OR DIRECTION.



RURAL ENERGY GROUP
813 W. NORTHERN LIGHTS BLVD.
ANCHORAGE, ALASKA 99503
HTTP://WWW.AIDEA.ORG

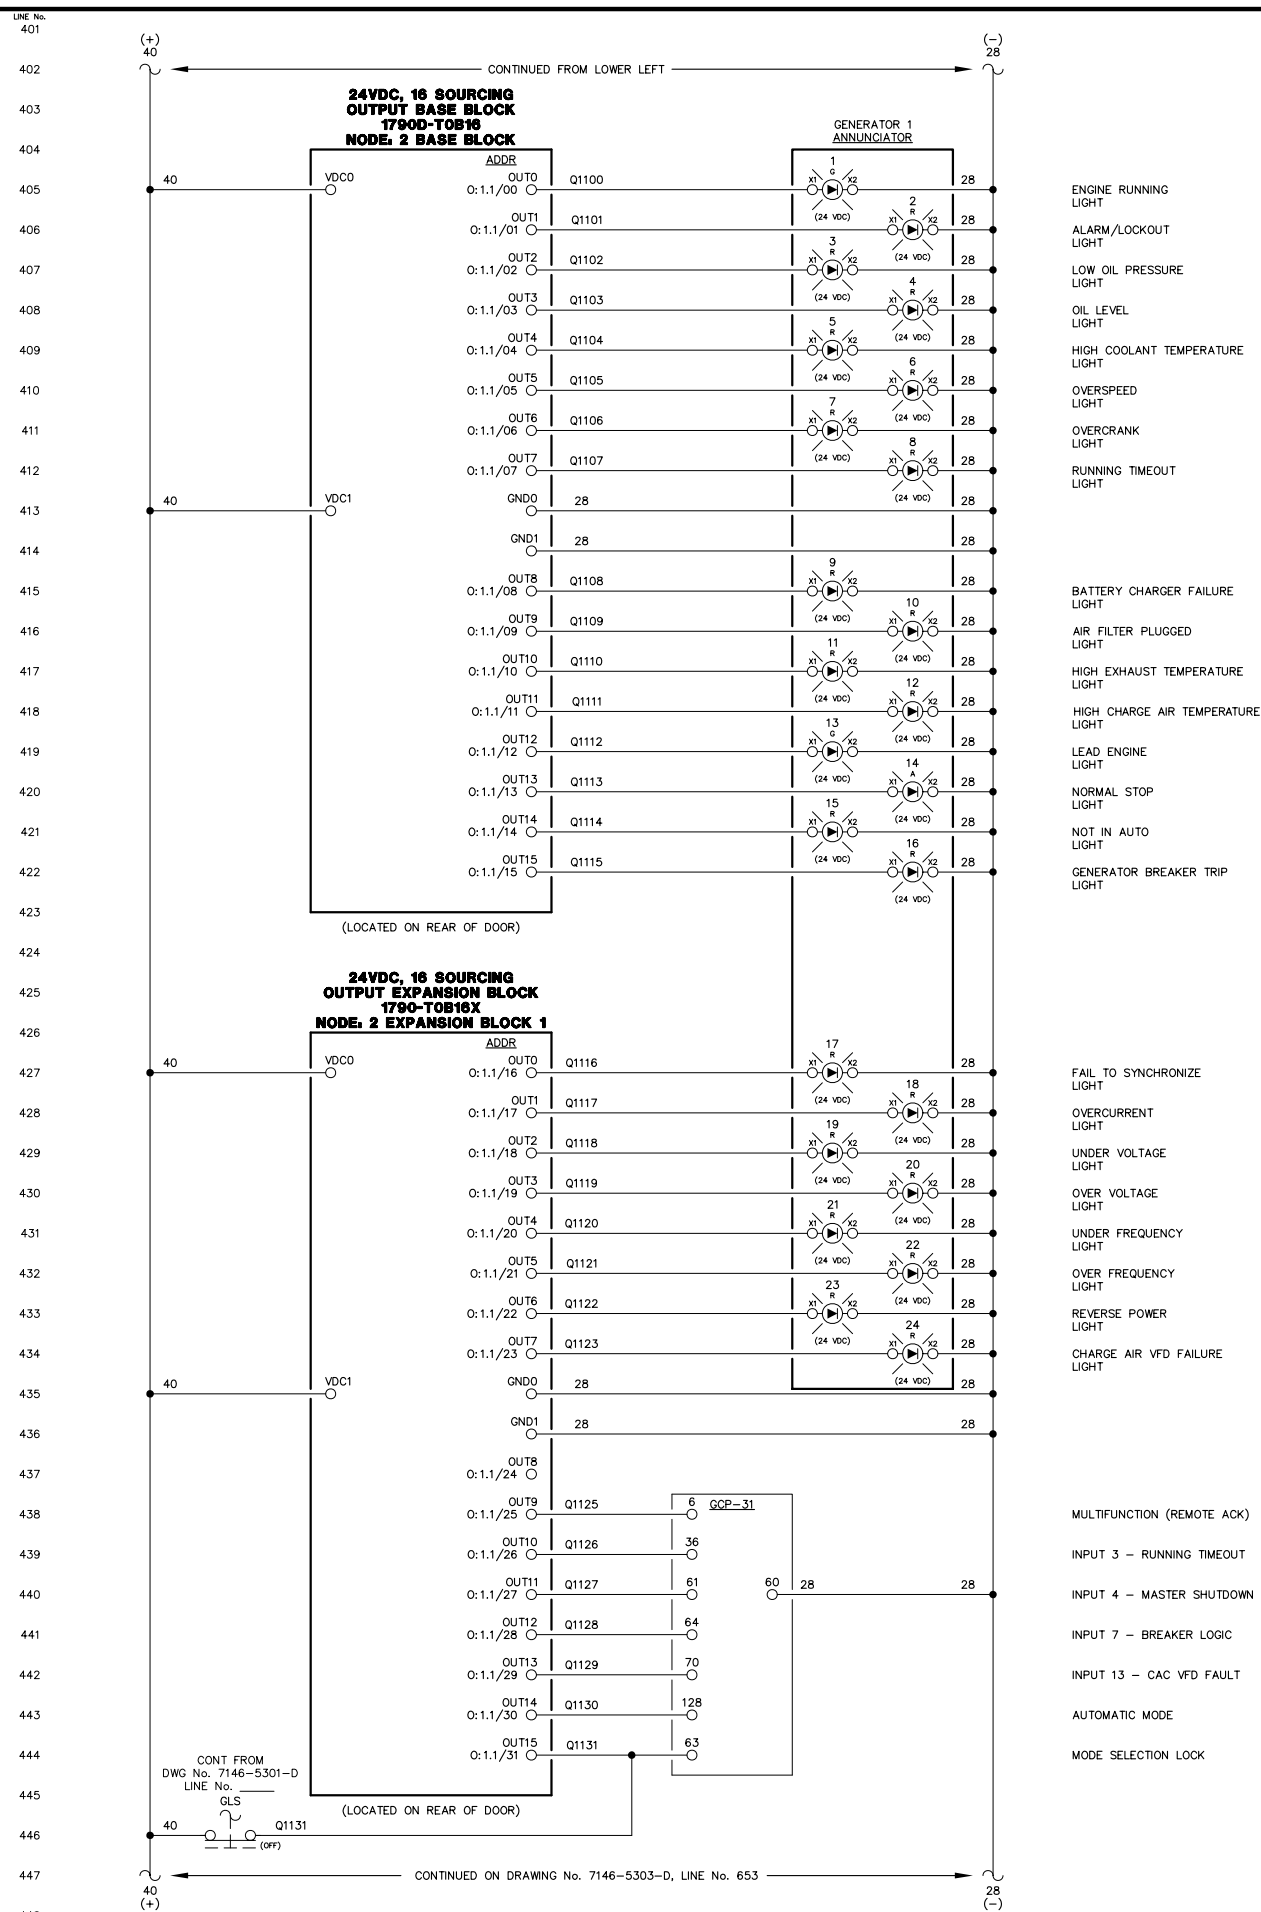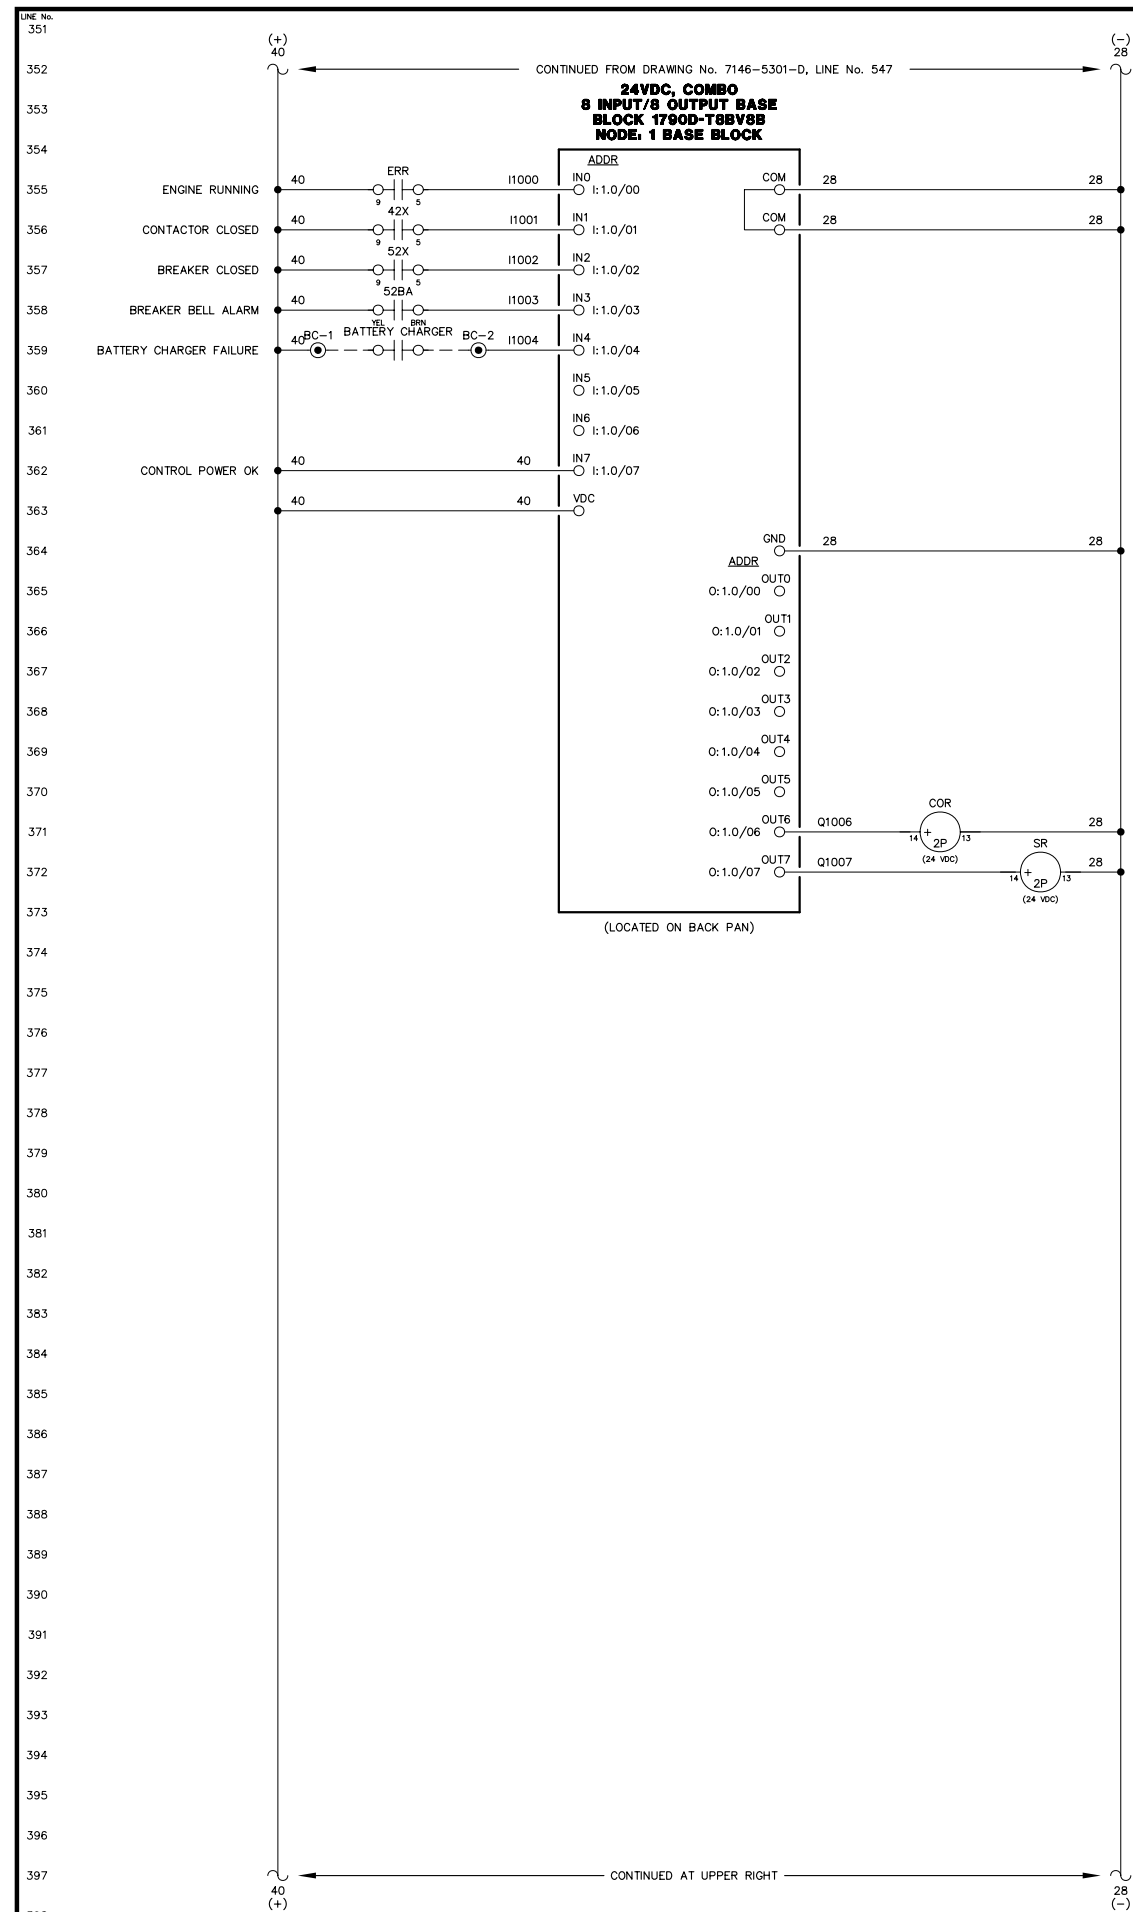


NOTICE

THE DRAWINGS, INFORMATION AND SUBJECT MATTER HEREOF ARE THE CONFIDENTIAL, SOLE AND EXCLUSIVE PROPERTY OF CONTROLLED POWER, INC., AND ARE NOT TO BE COPIED, REPRODUCED OR USED IN ANY MANNER FOR ANY PURPOSE WHATSOEVER WITHOUT WRITTEN CONSENT OR DIRECTION.



RURAL ENERGY GROUP
813 W. NORTHERN LIGHTS BLVD.
ANCHORAGE, ALASKA 99503
HTTP://WWW.AIDEA.ORG

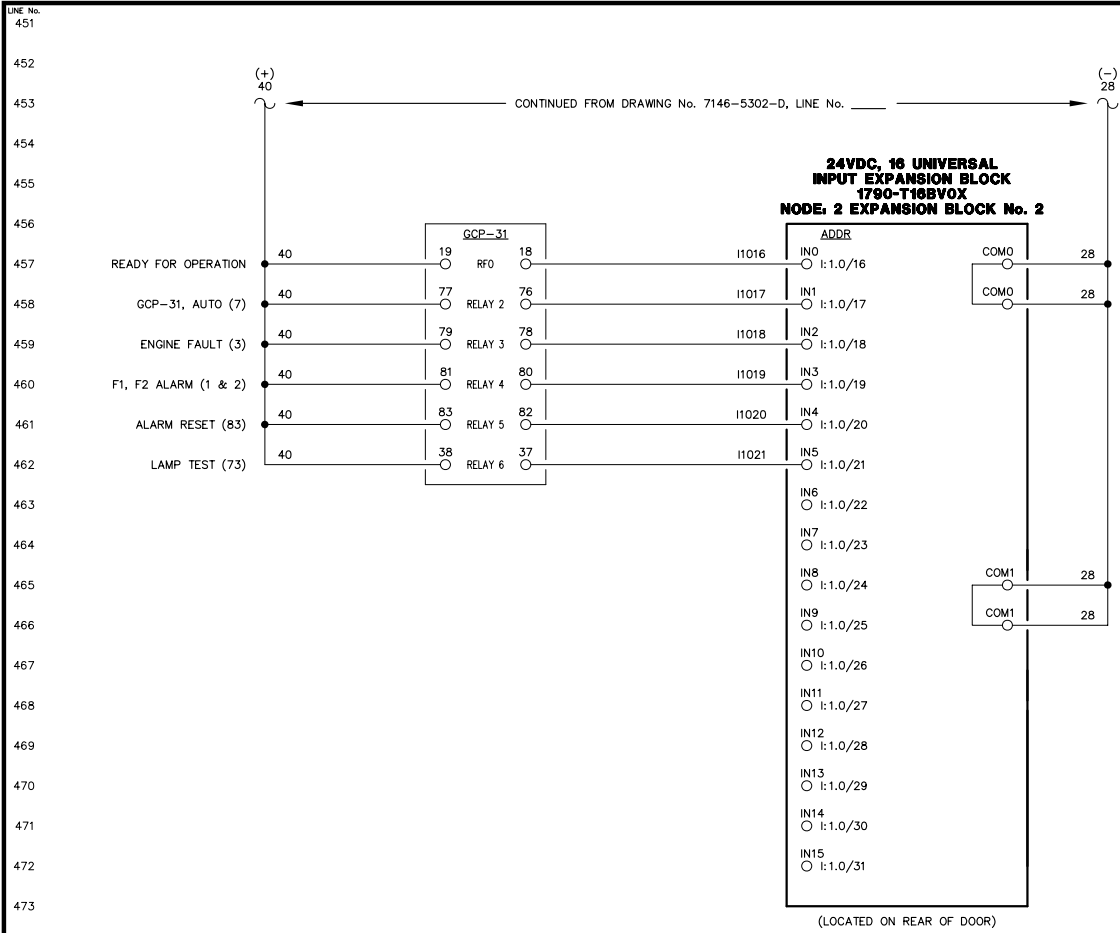

LINE No. 501

502

503

504

NOTE:

1. FOR GENERAL WIRING & CONSTRUCTION NOTES, SEE DRAWING No. 7146-3101-D.

A	05-04-11	SHOP AS BUILT	GPN
REV.	DATE	DESCRIPTION	BY
AEA PURCHASE ORDER No. REG-11-044		CONTROLLED POWER JOB No. 7146	
TITLE: GENERATOR 1 DC CONTROL, SCHEMATIC DIAGRAM			
SCALE: NONE		DATE: 03-01-11	DWN. BY: GPN
DWG. No: 7146-5303-D		SHEET: 1 OF 1	CKD. BY: JMD
JOB: RUBY GENERATOR SWITCHGEAR			

NOTICE

THE DRAWINGS, INFORMATION AND SUBJECT MATTER HEREOF ARE THE CONFIDENTIAL, SOLE AND EXCLUSIVE PROPERTY OF CONTROLLED POWER, INC. AND ARE NOT TO BE COPIED, REPRODUCED OR USED IN ANY MANNER FOR ANY PURPOSE WHATSOEVER WITHOUT WRITTEN CONSENT OR DIRECTION.



RURAL ENERGY GROUP

813 W. NORTHERN LIGHTS BLVD.

ANCHORAGE, ALASKA 99503

HTTP://WWW.AIDEA.ORG

Plot date: 2011/4/27 - 9:53

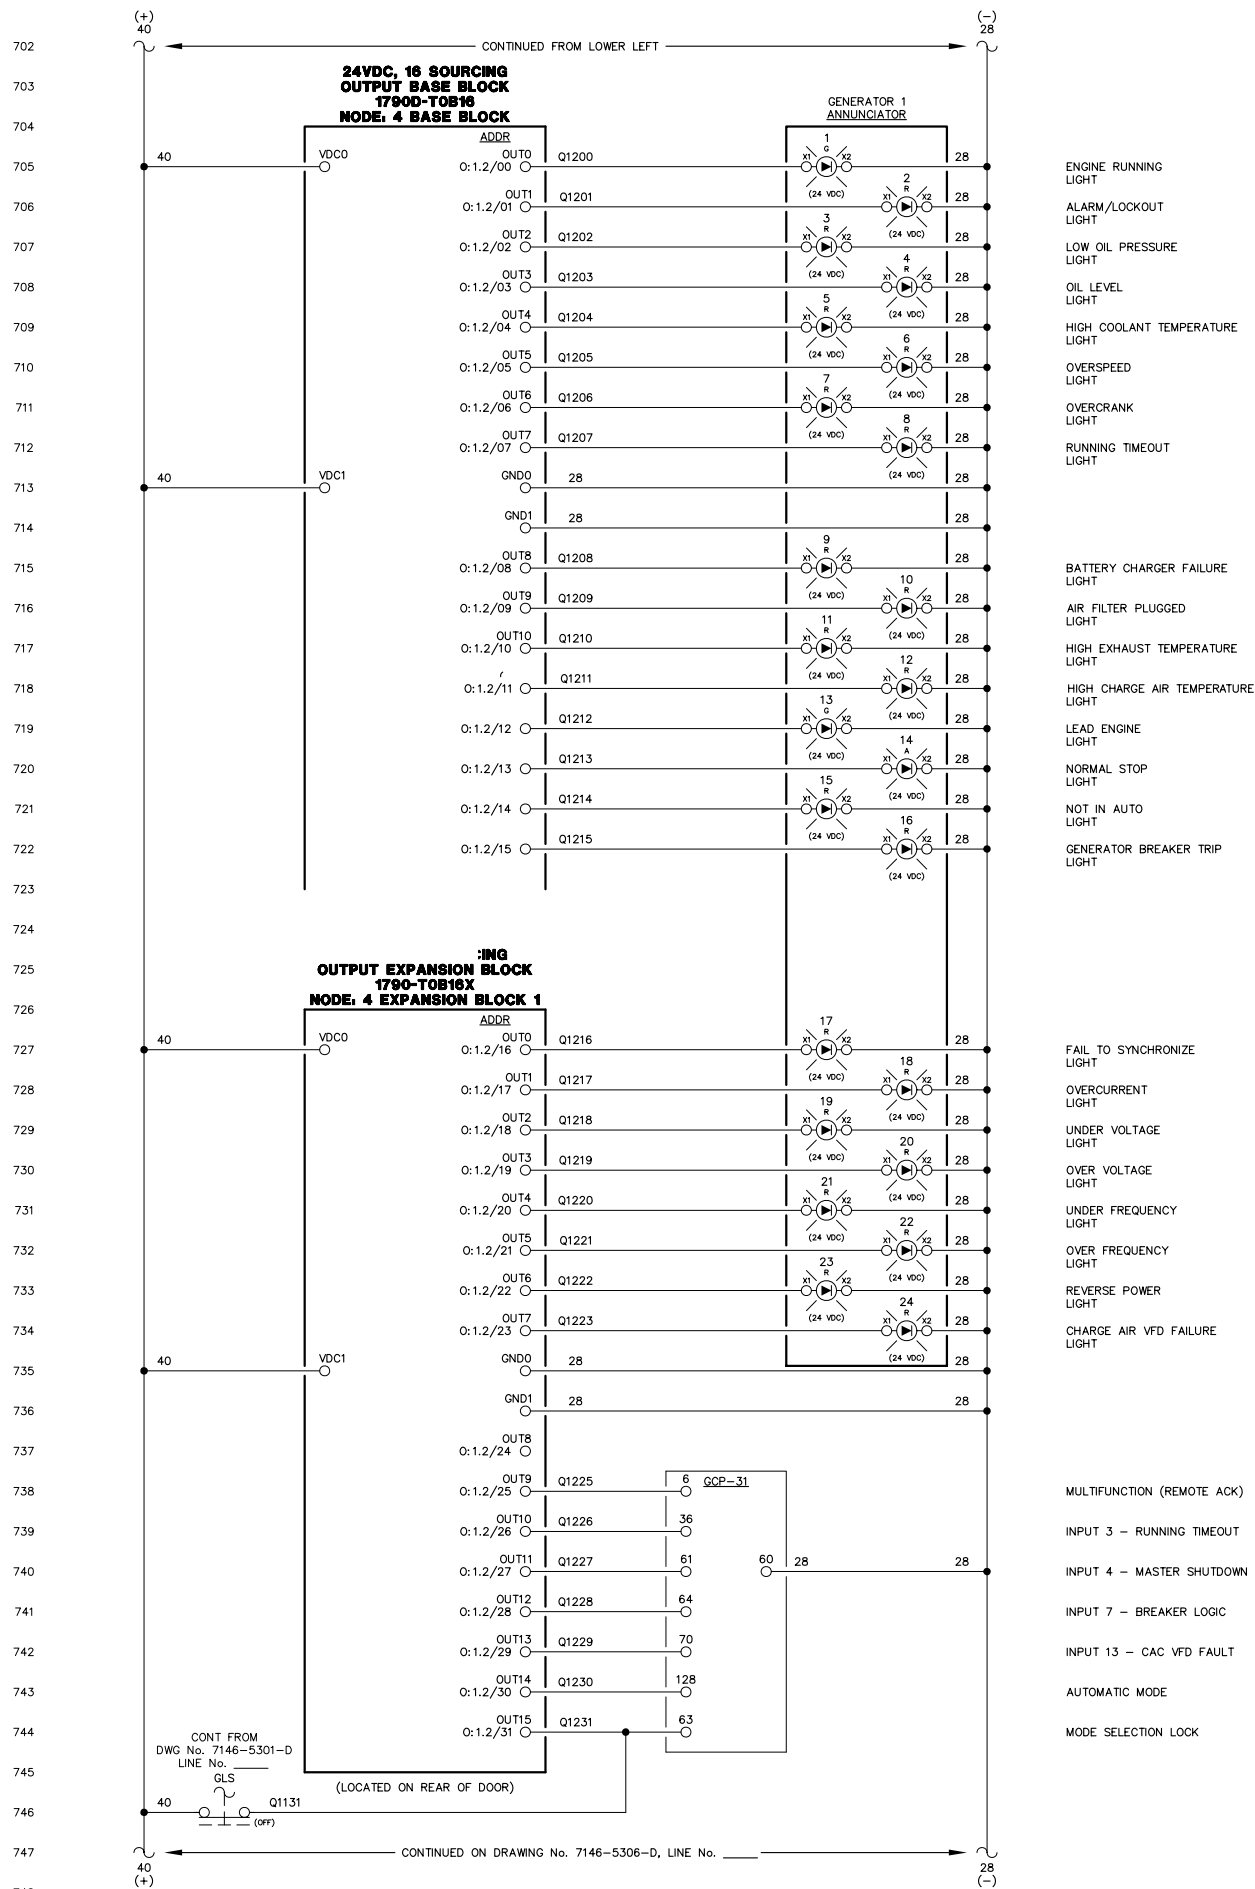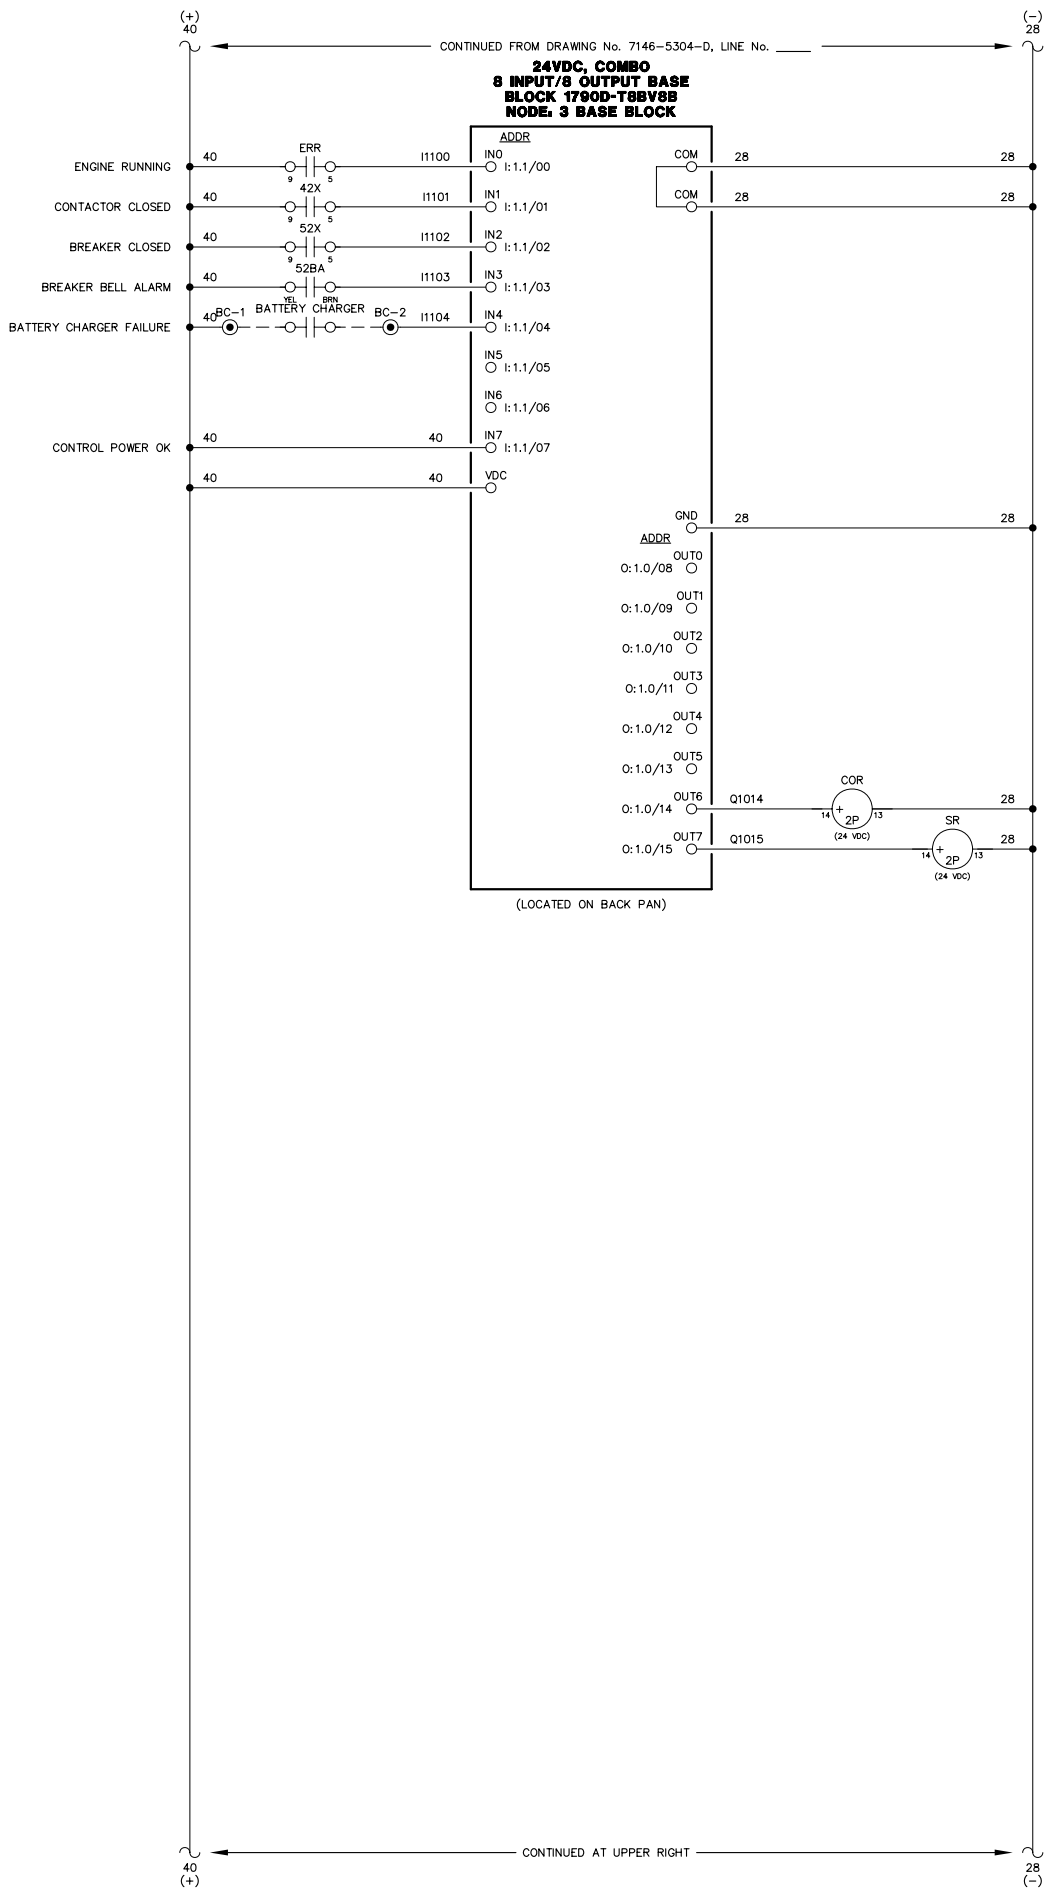


NOTICE

THE DRAWINGS, INFORMATION AND SUBJECT MATTER HEREOF ARE THE CONFIDENTIAL, SOLE AND EXCLUSIVE PROPERTY OF CONTROLLED POWER, INC. AND ARE NOT TO BE COPIED, REPRODUCED OR USED IN ANY MANNER FOR ANY PURPOSE WHATSOEVER WITHOUT WRITTEN CONSENT OR DIRECTION.



RURAL ENERGY GROUP
813 W. NORTHERN LIGHTS BLVD.
ANCHORAGE, ALASKA 99503
HTTP://WWW.AIDEA.ORG



751
752
753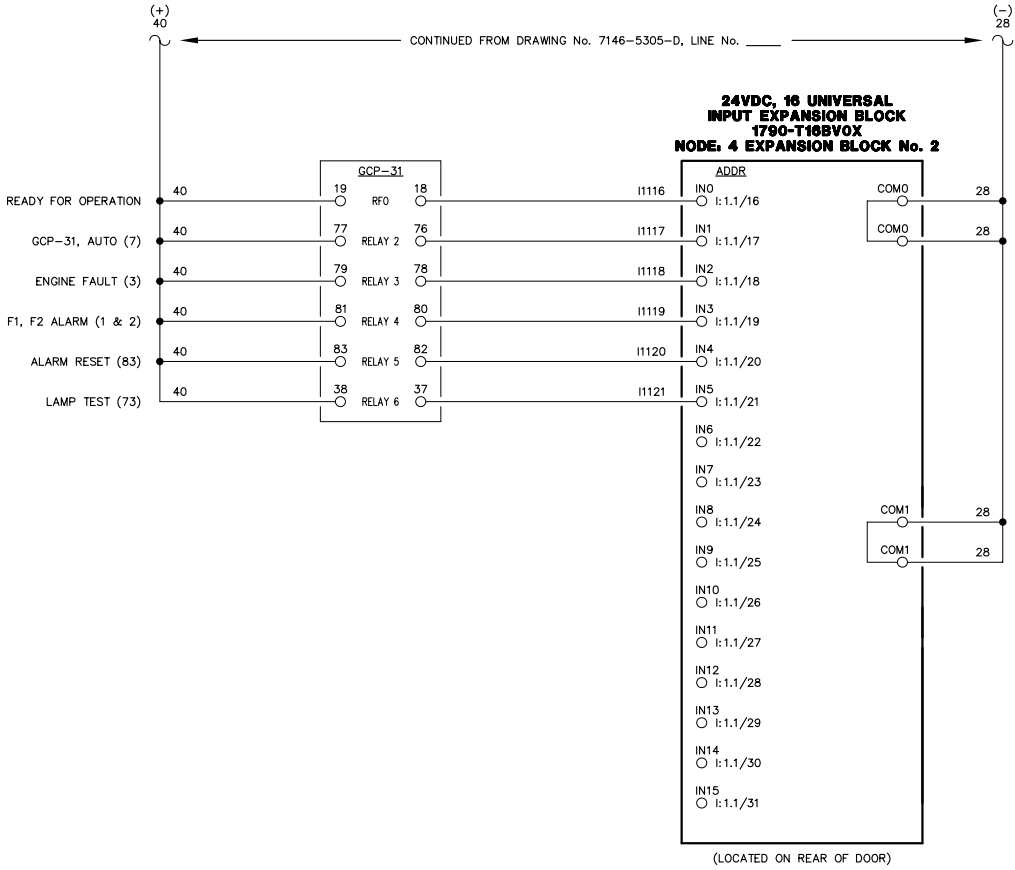
NOTE:
1. FOR GENERAL WIRING & CONSTRUCTION NOTES, SEE DRAWING No. 7146-3101-D.



A	05-04-11	SHOP AS BUILT	GPN
REV.	DATE	DESCRIPTION	BY
AEA PURCHASE ORDER No. REG-11-044		CONTROLLED POWER JOB No. 7146	
TITLE: GENERATOR 2 DC CONTROL, SCHEMATIC DIAGRAM			
SCALE: NONE		DATE: 03-01-11	DWN. BY: GPN
DWG. No: 7146-5306-D		SHEET: 1 OF 1	CKD. BY: JMD
JOB: RUBY GENERATOR SWITCHGEAR			
		RURAL ENERGY GROUP 813 W. NORTHERN LIGHTS BLVD. ANCHORAGE, ALASKA 99503 HTTP: //WWW.AIDEA.ORG	

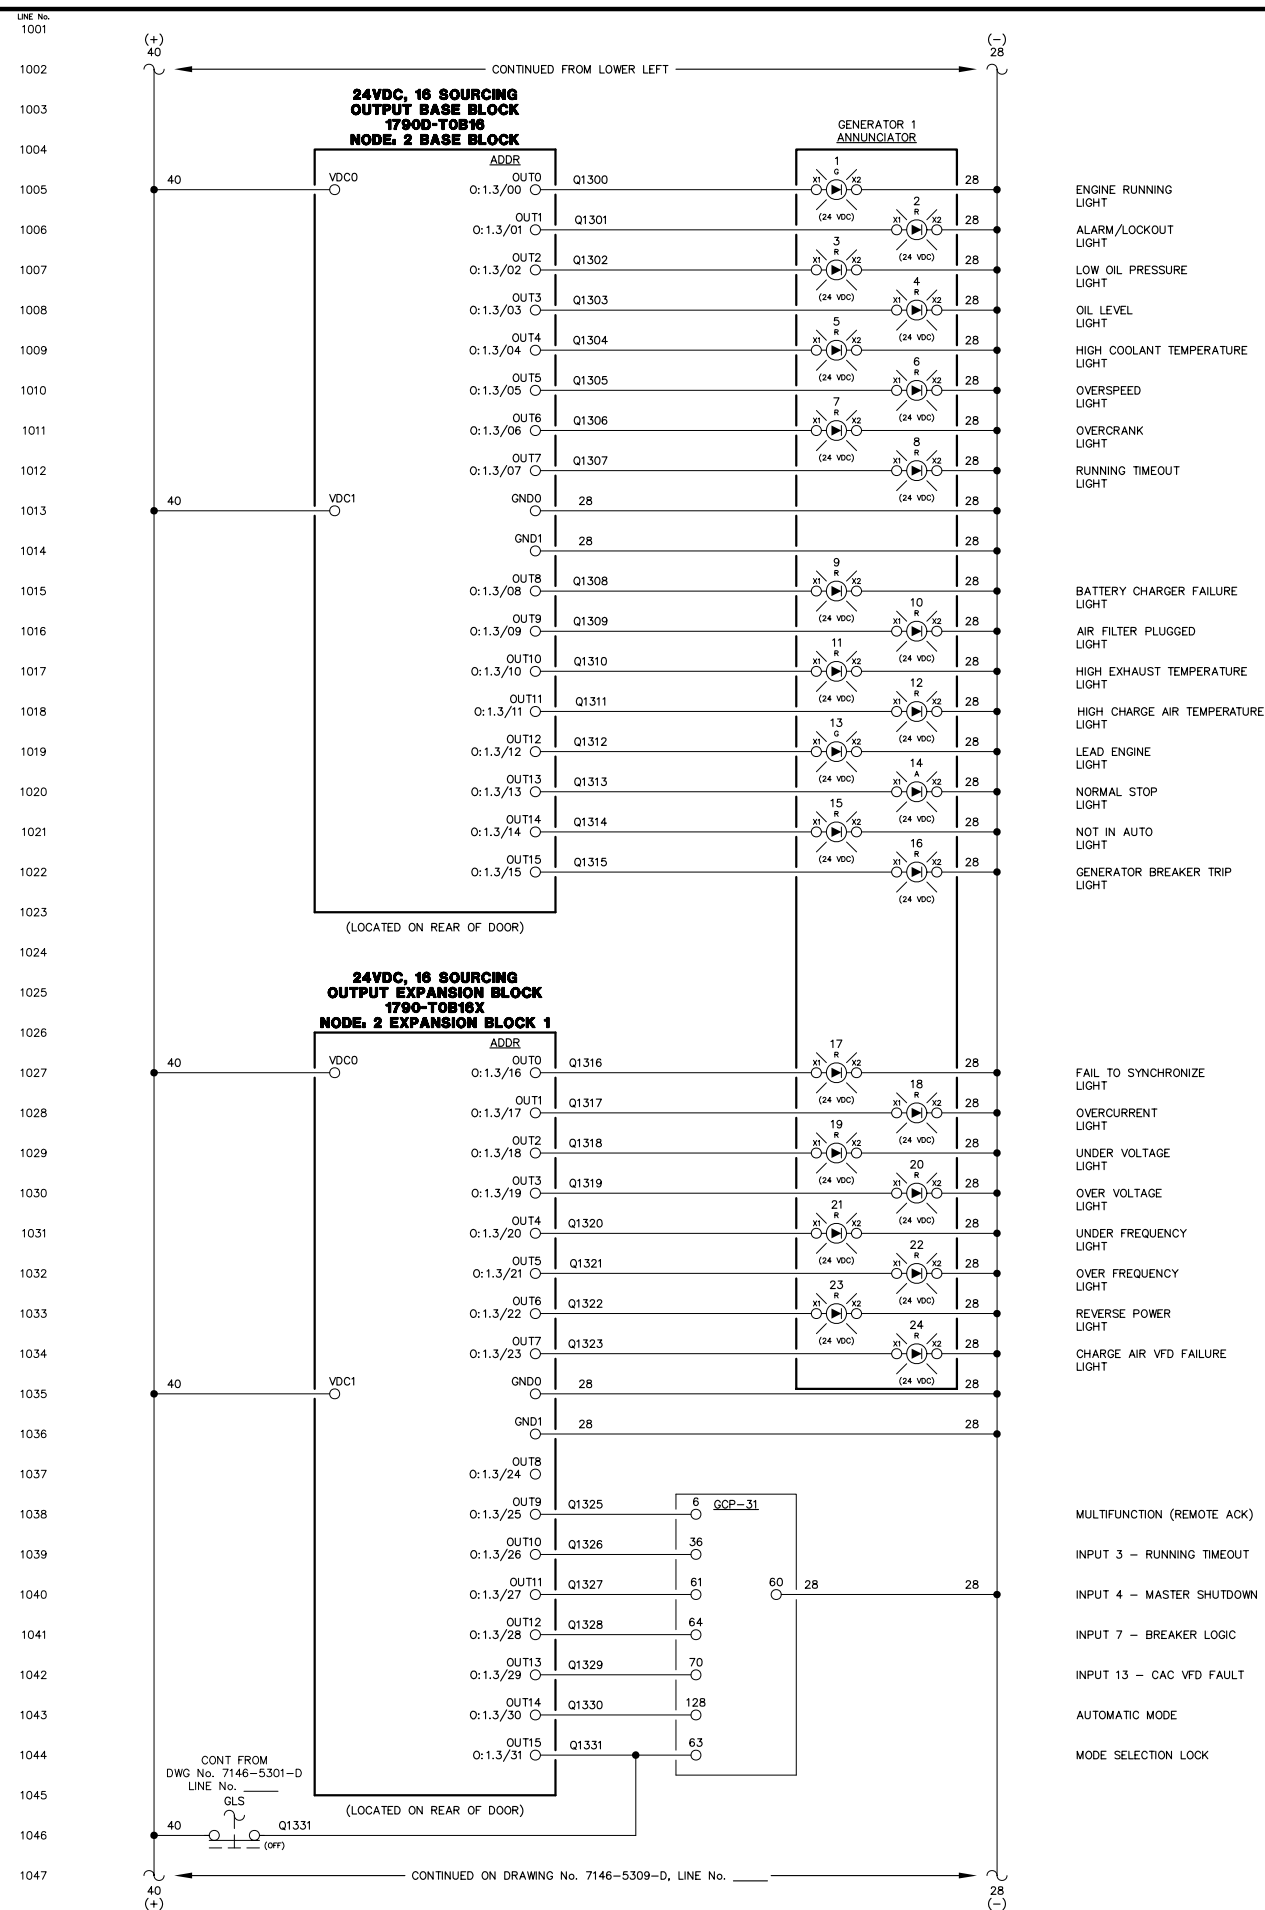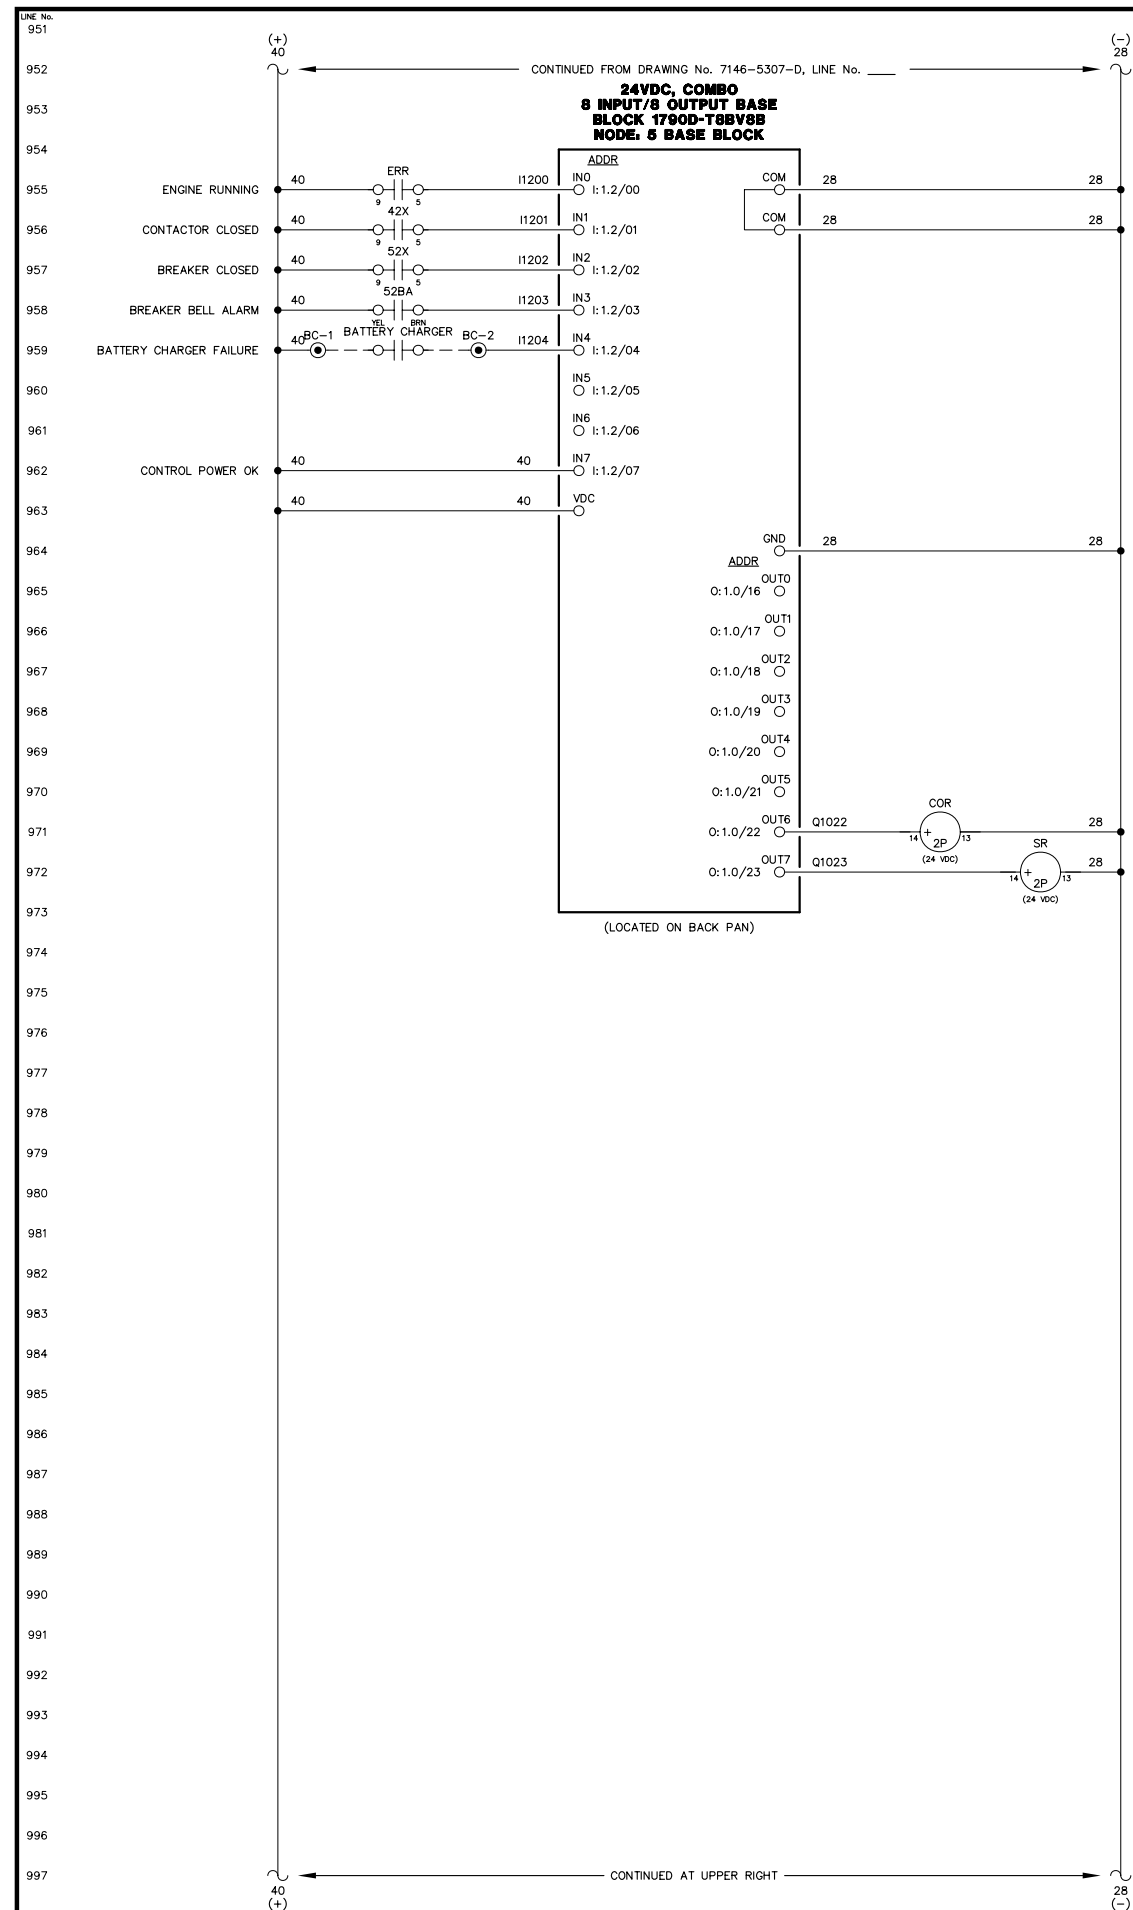

NOTICE
THE DRAWINGS, INFORMATION AND SUBJECT MATTER HEREOF
ARE THE CONFIDENTIAL, SOLE AND EXCLUSIVE PROPERTY
OF CONTROLLED POWER, INC., AND ARE NOT TO BE COPIED,
REPRODUCED OR USED IN ANY MANNER FOR ANY PURPOSE
WHATSOEVER WITHOUT WRITTEN CONSENT OR DIRECTION.




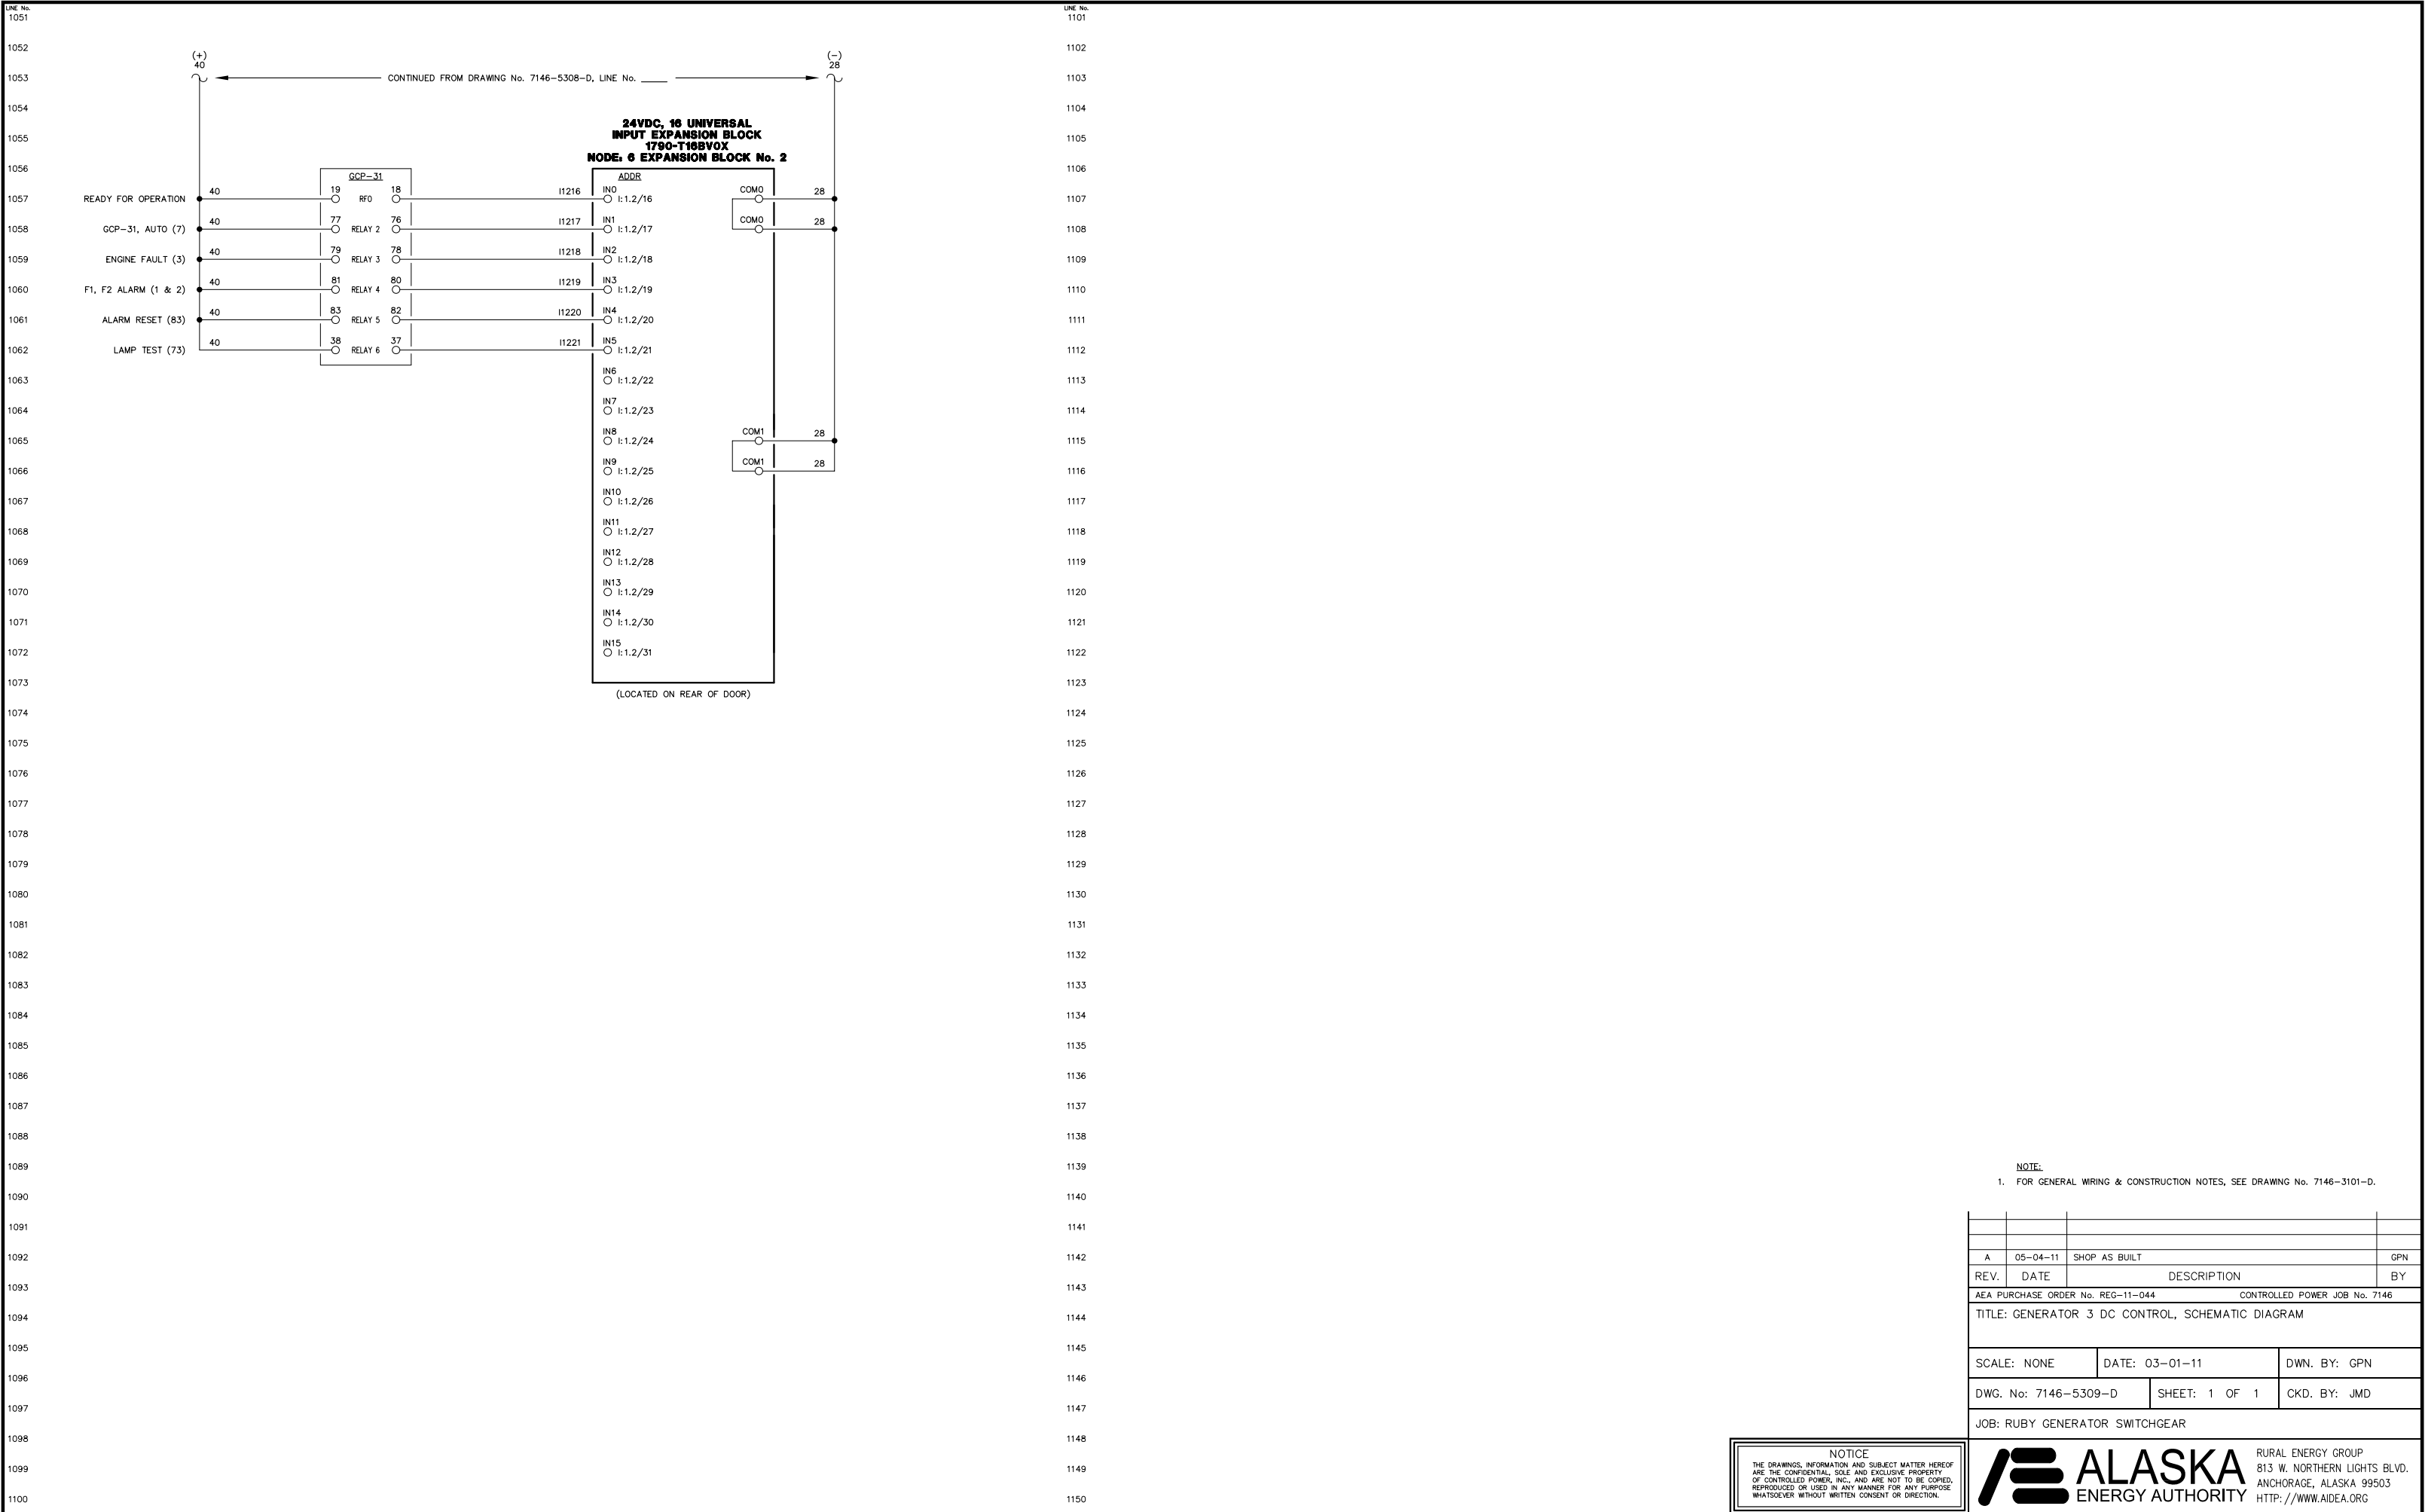


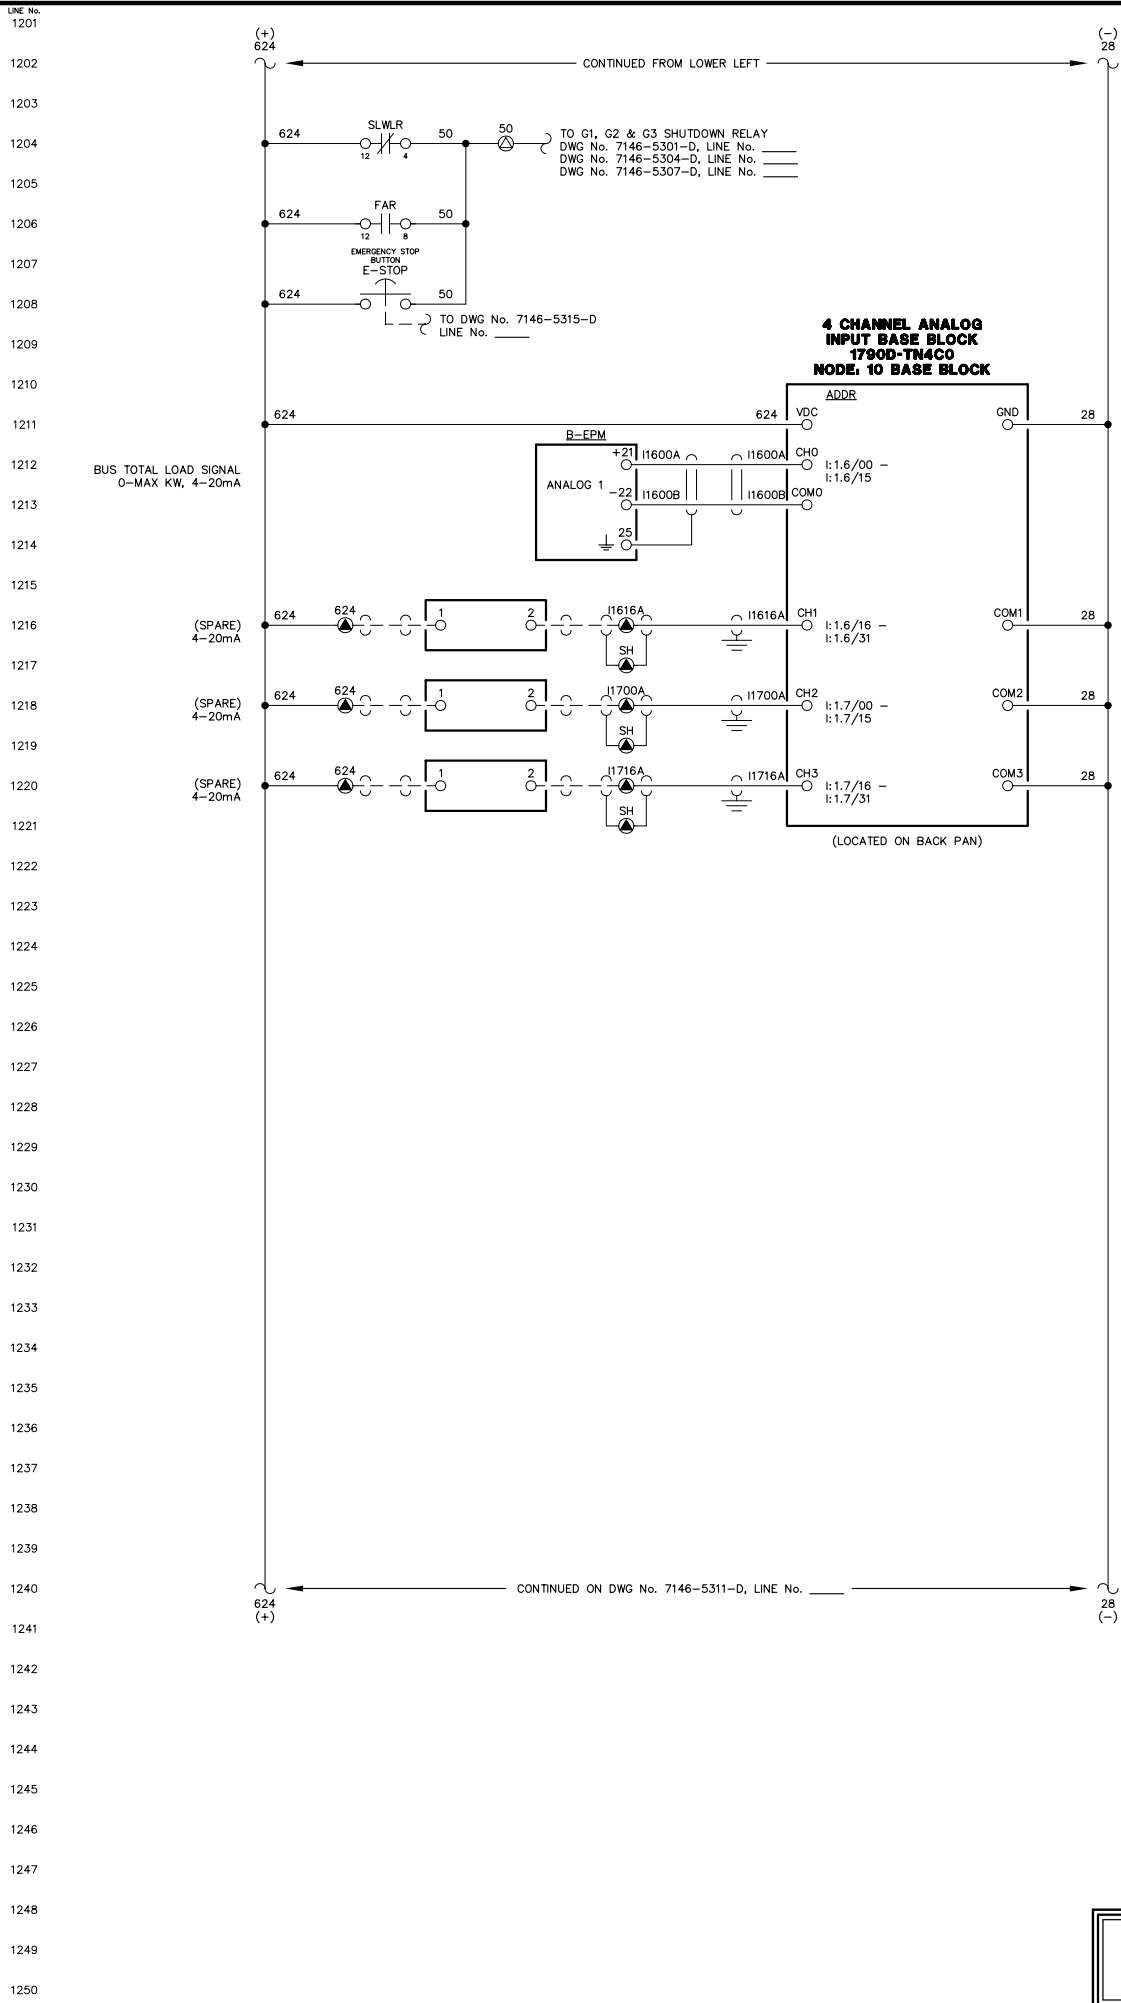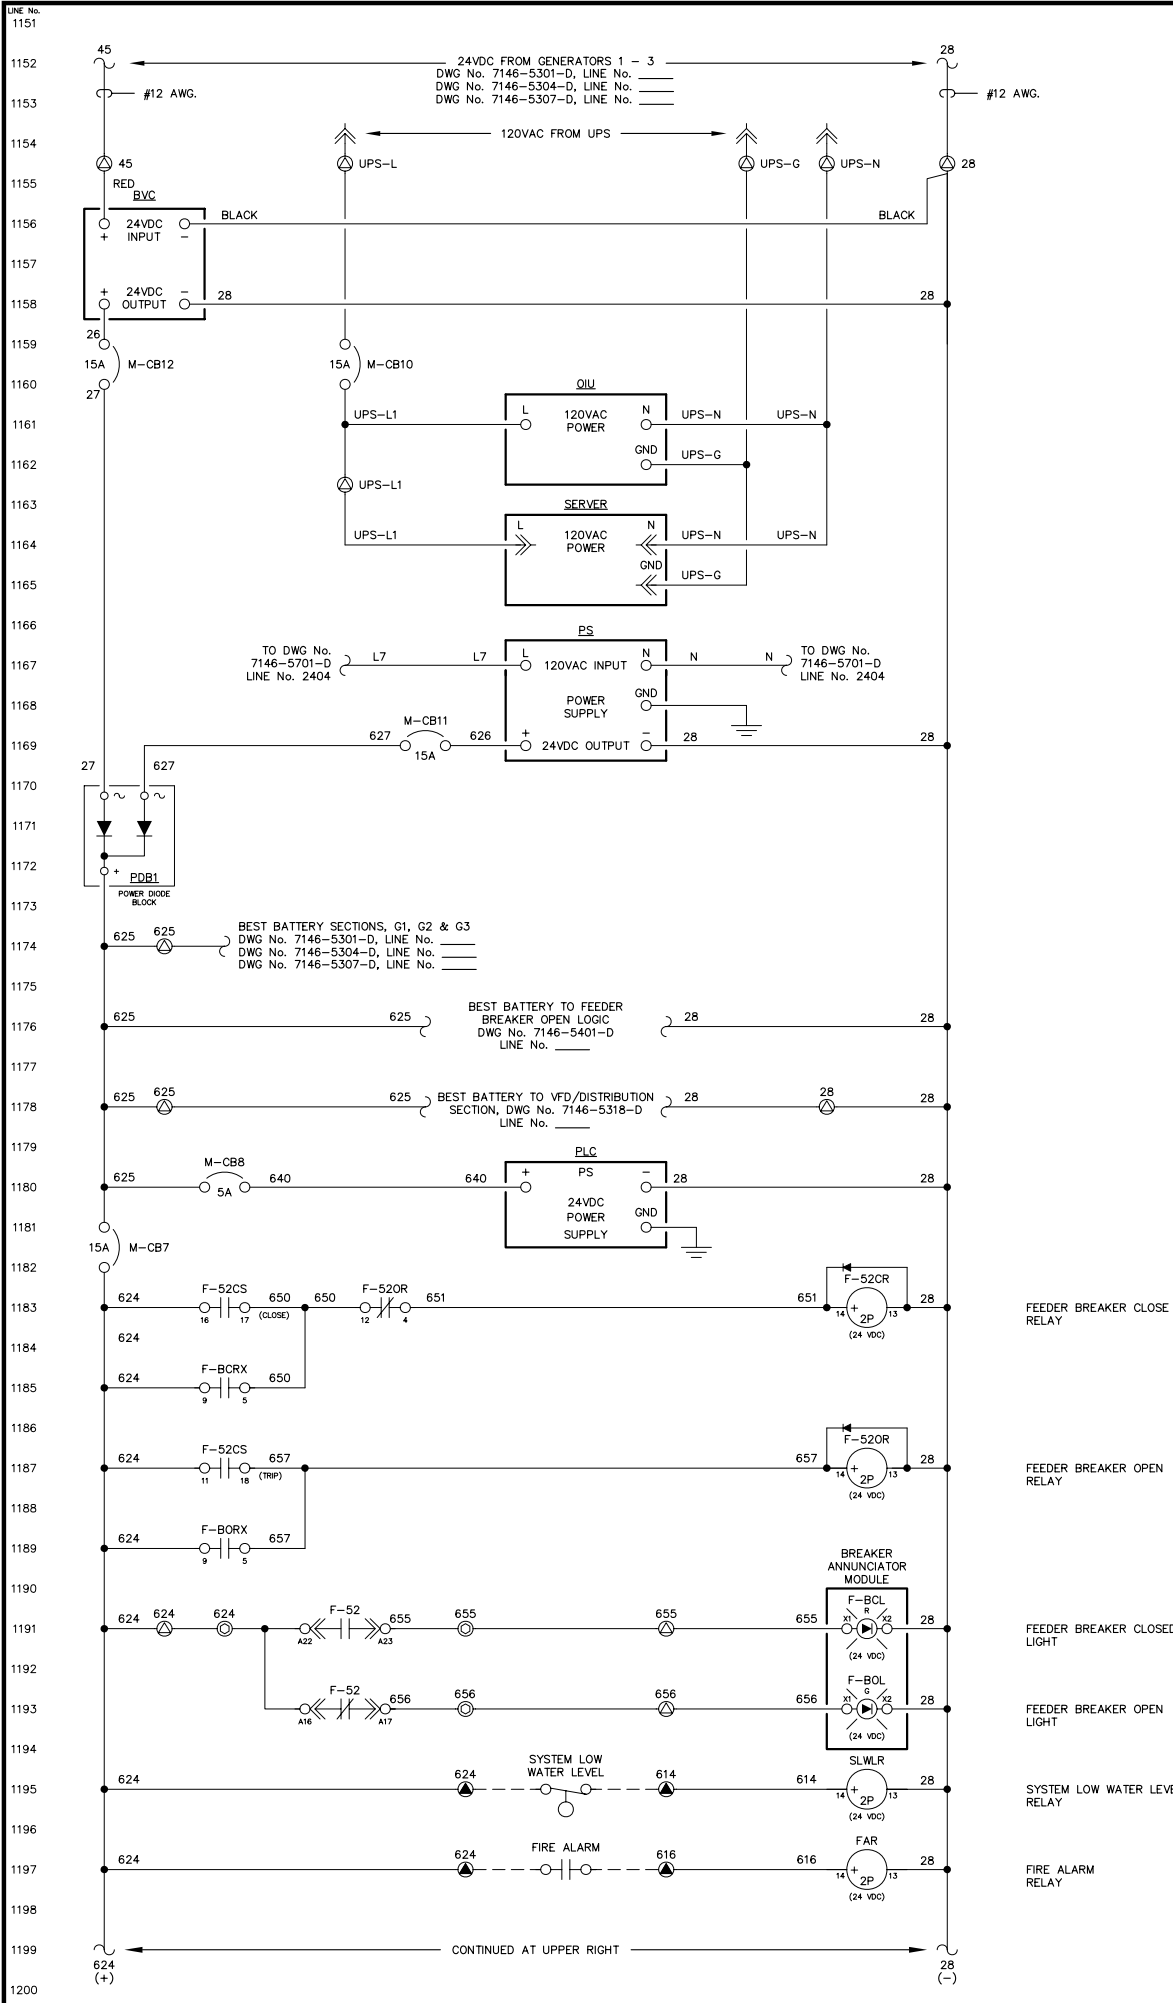

NOTICE

THE DRAWINGS, INFORMATION AND SUBJECT MATTER HEREOF ARE THE CONFIDENTIAL, SOLE AND EXCLUSIVE PROPERTY OF CONTROLLED POWER, INC. AND ARE NOT TO BE COPIED, REPRODUCED OR USED IN ANY MANNER FOR ANY PURPOSE WHATSOEVER WITHOUT WRITTEN CONSENT OR DIRECTION.

NOTE:			
1. FOR GENERAL WIRING & CONSTRUCTION NOTES, SEE DRAWING No. 7146-3101-D.			
A	05-04-11	SHOP AS BUILT	GPN
REV.	DATE	DESCRIPTION	BY
AEA PURCHASE ORDER No. REC-11-044			
CONTROLLED POWER JOB No. 7146			
TITLE: MASTER DC CONTROL, SCHEMATIC DIAGRAM			
SCALE: NONE		DATE: 03-01-11	DWN. BY: GPN
DWG. No: 7146-5310-D		SHEET: 1 OF 1	CKD. BY: JMD
JOB: RUBY GENERATOR SWITCHGEAR			
		RURAL ENERGY GROUP 813 W. NORTHERN LIGHTS BLVD. ANCHORAGE, ALASKA 99503 HTTP://WWW.AIDEA.ORG	

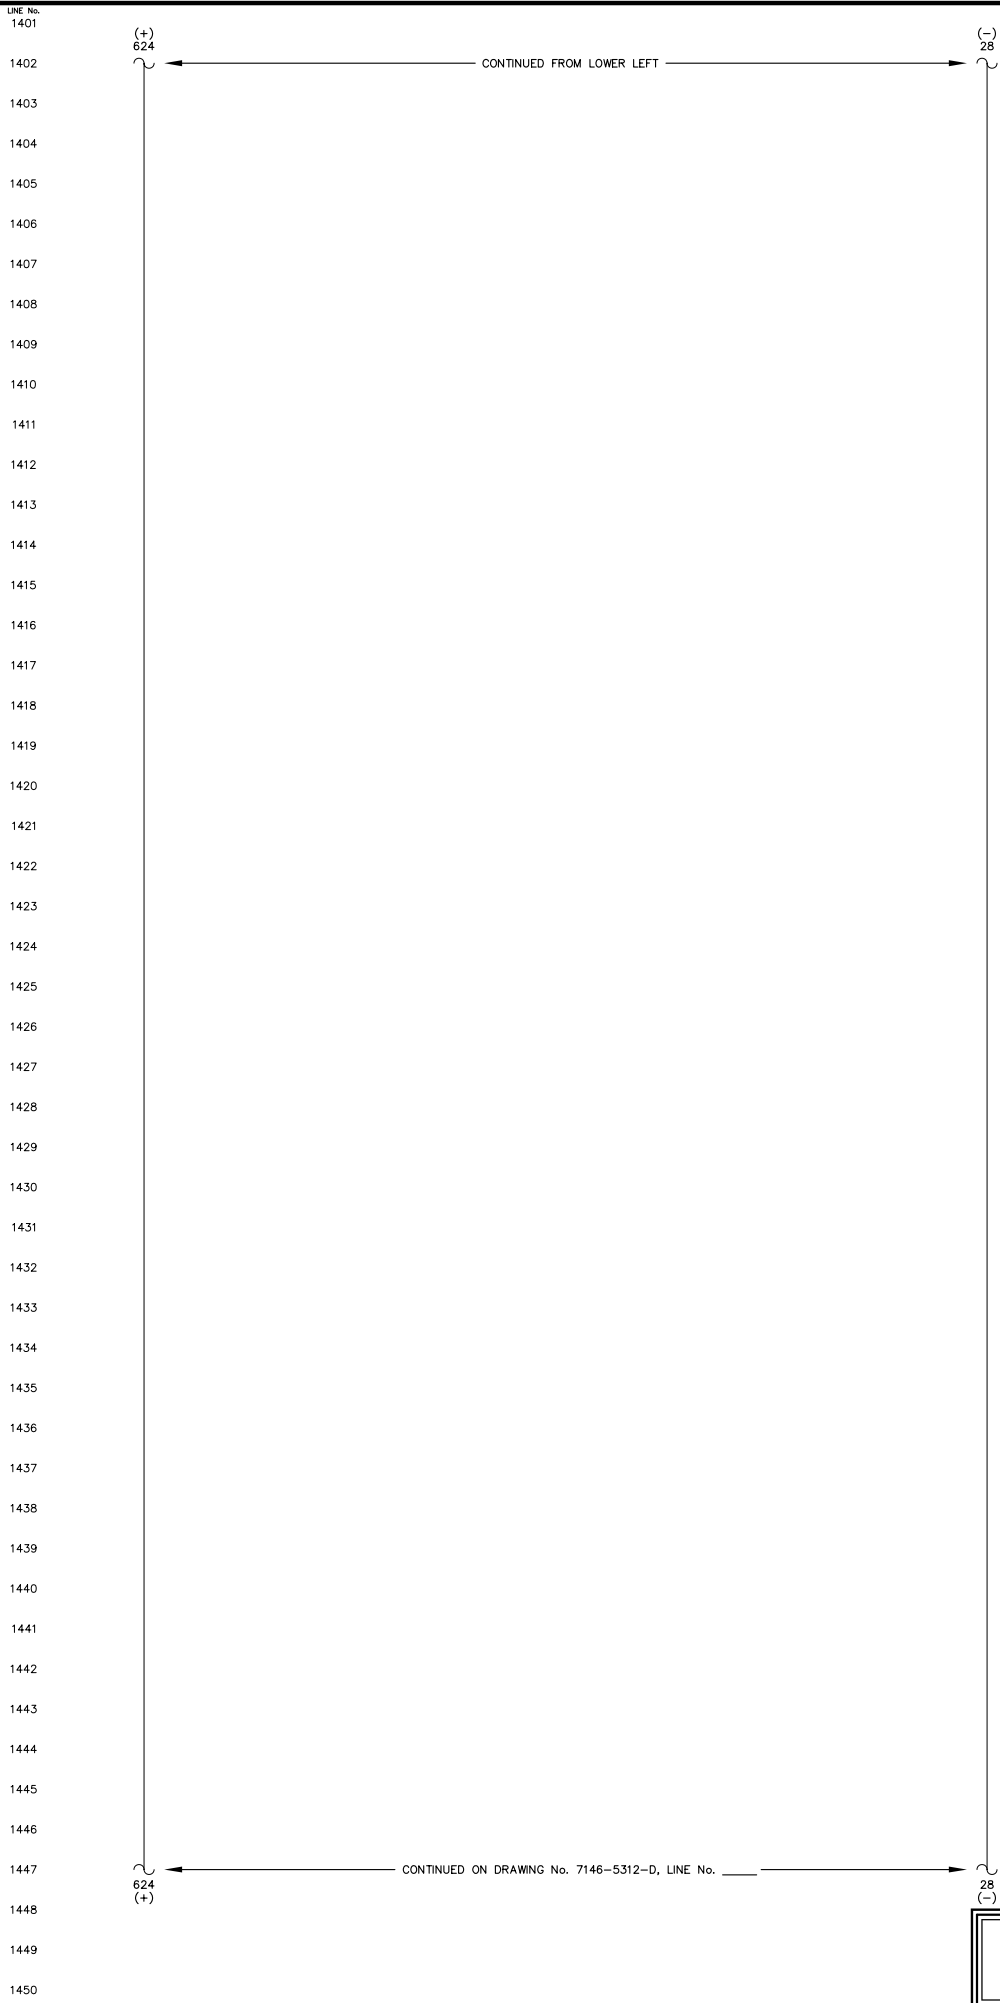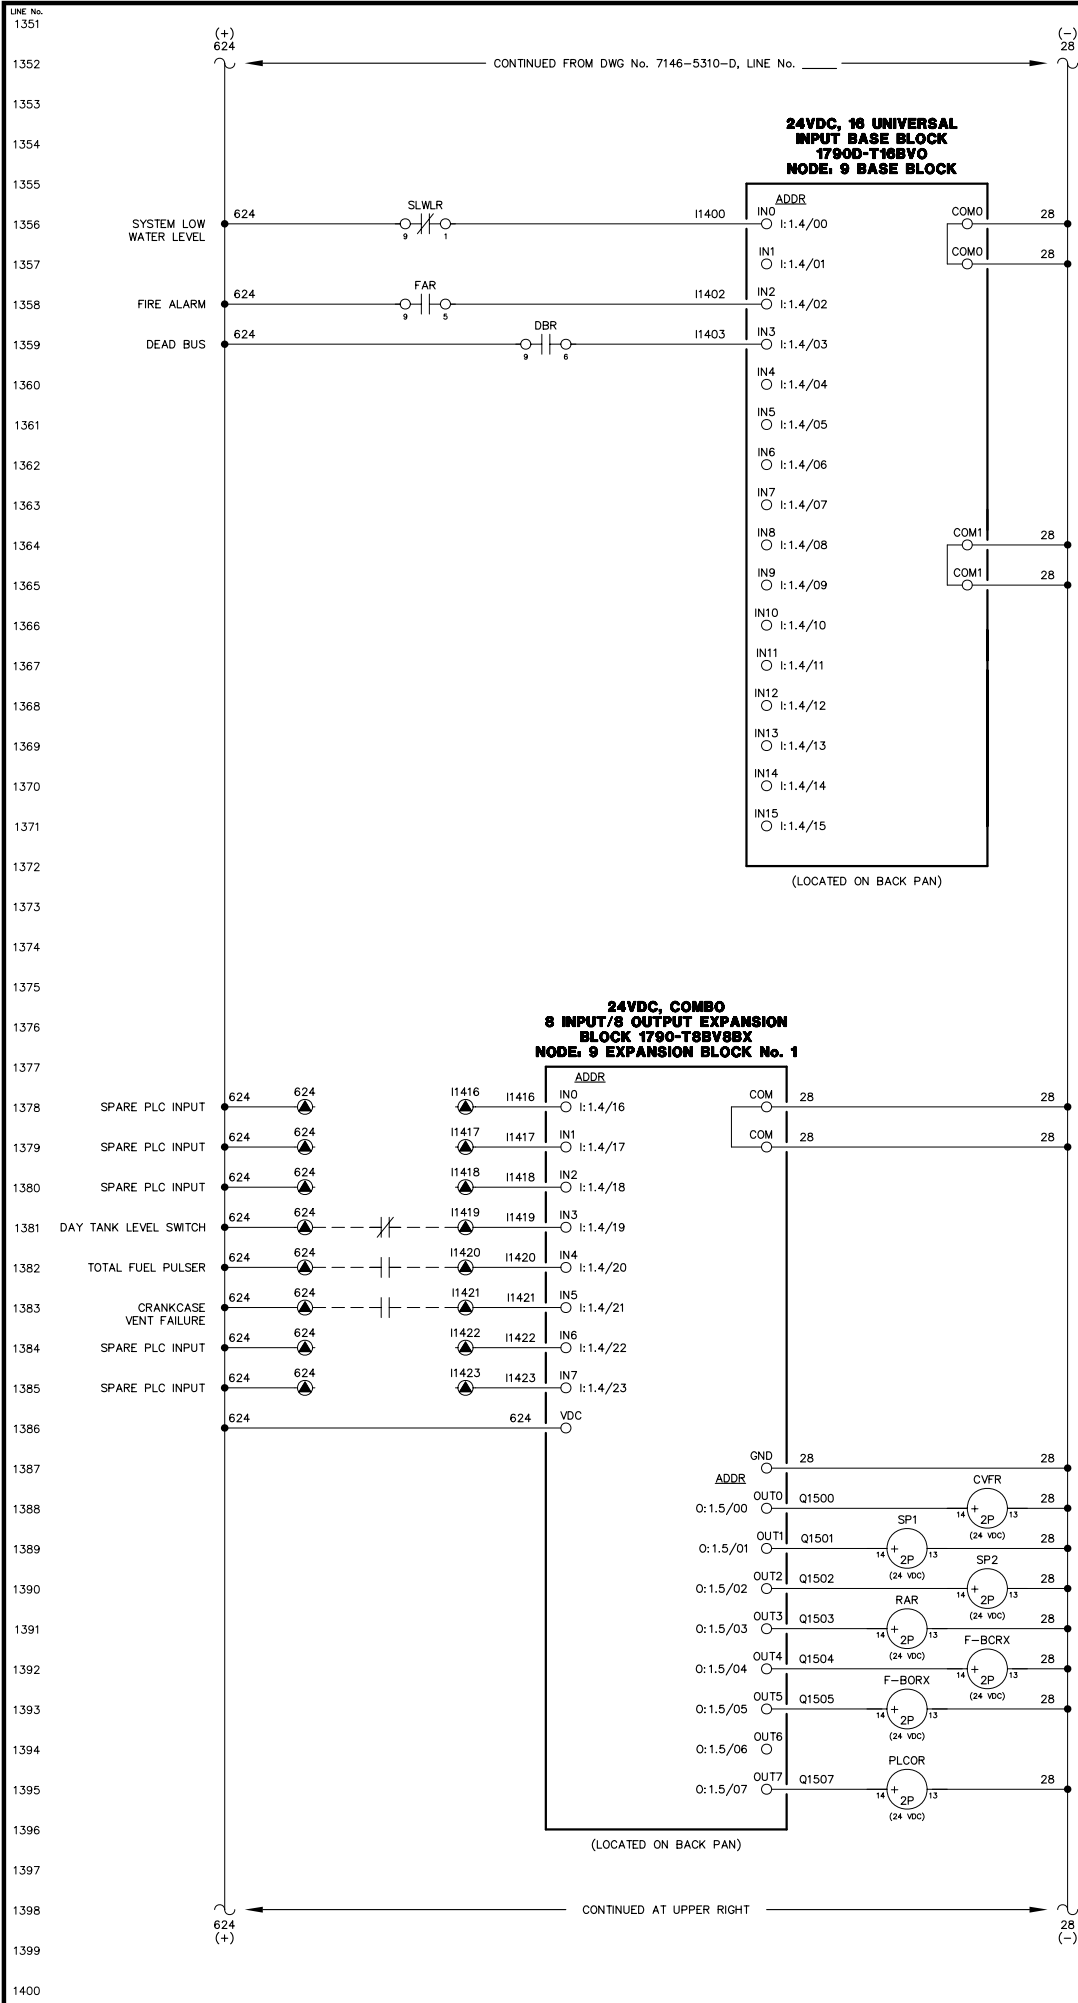



NOTE:
1. FOR GENERAL WIRING & CONSTRUCTION NOTES, SEE DRAWING No. 7146-3101-D.

A	05-04-11	SHOP AS BUILT	GPN
REV.	DATE	DESCRIPTION	BY
AEA PURCHASE ORDER No. REG-10-042 CONTROLLED POWER JOB No. 7146			
TITLE: MASTER DC CONTROL, SCHEMATIC DIAGRAM			
SCALE: NONE		DATE: 03-01-11	DWN. BY: GPN
DWG. No: 7146-5311-D		SHEET: 1 OF 1	CKD. BY: JMD
JOB: RUBY GENERATOR SWITCHGEAR			

NOTICE
THE DRAWINGS, INFORMATION AND SUBJECT MATTER HEREOF ARE THE CONFIDENTIAL, SOLE AND EXCLUSIVE PROPERTY OF CONTROLLED POWER, INC. AND ARE NOT TO BE COPIED, REPRODUCED OR USED IN ANY MANNER FOR ANY PURPOSE WHATSOEVER WITHOUT WRITTEN CONSENT OR DIRECTION.

ALASKA
ENERGY AUTHORITY

RURAL ENERGY GROUP
813 W. NORTHERN LIGHTS BLVD.
ANCHORAGE, ALASKA 99503
HTTP://WWW.AIDEA.ORG

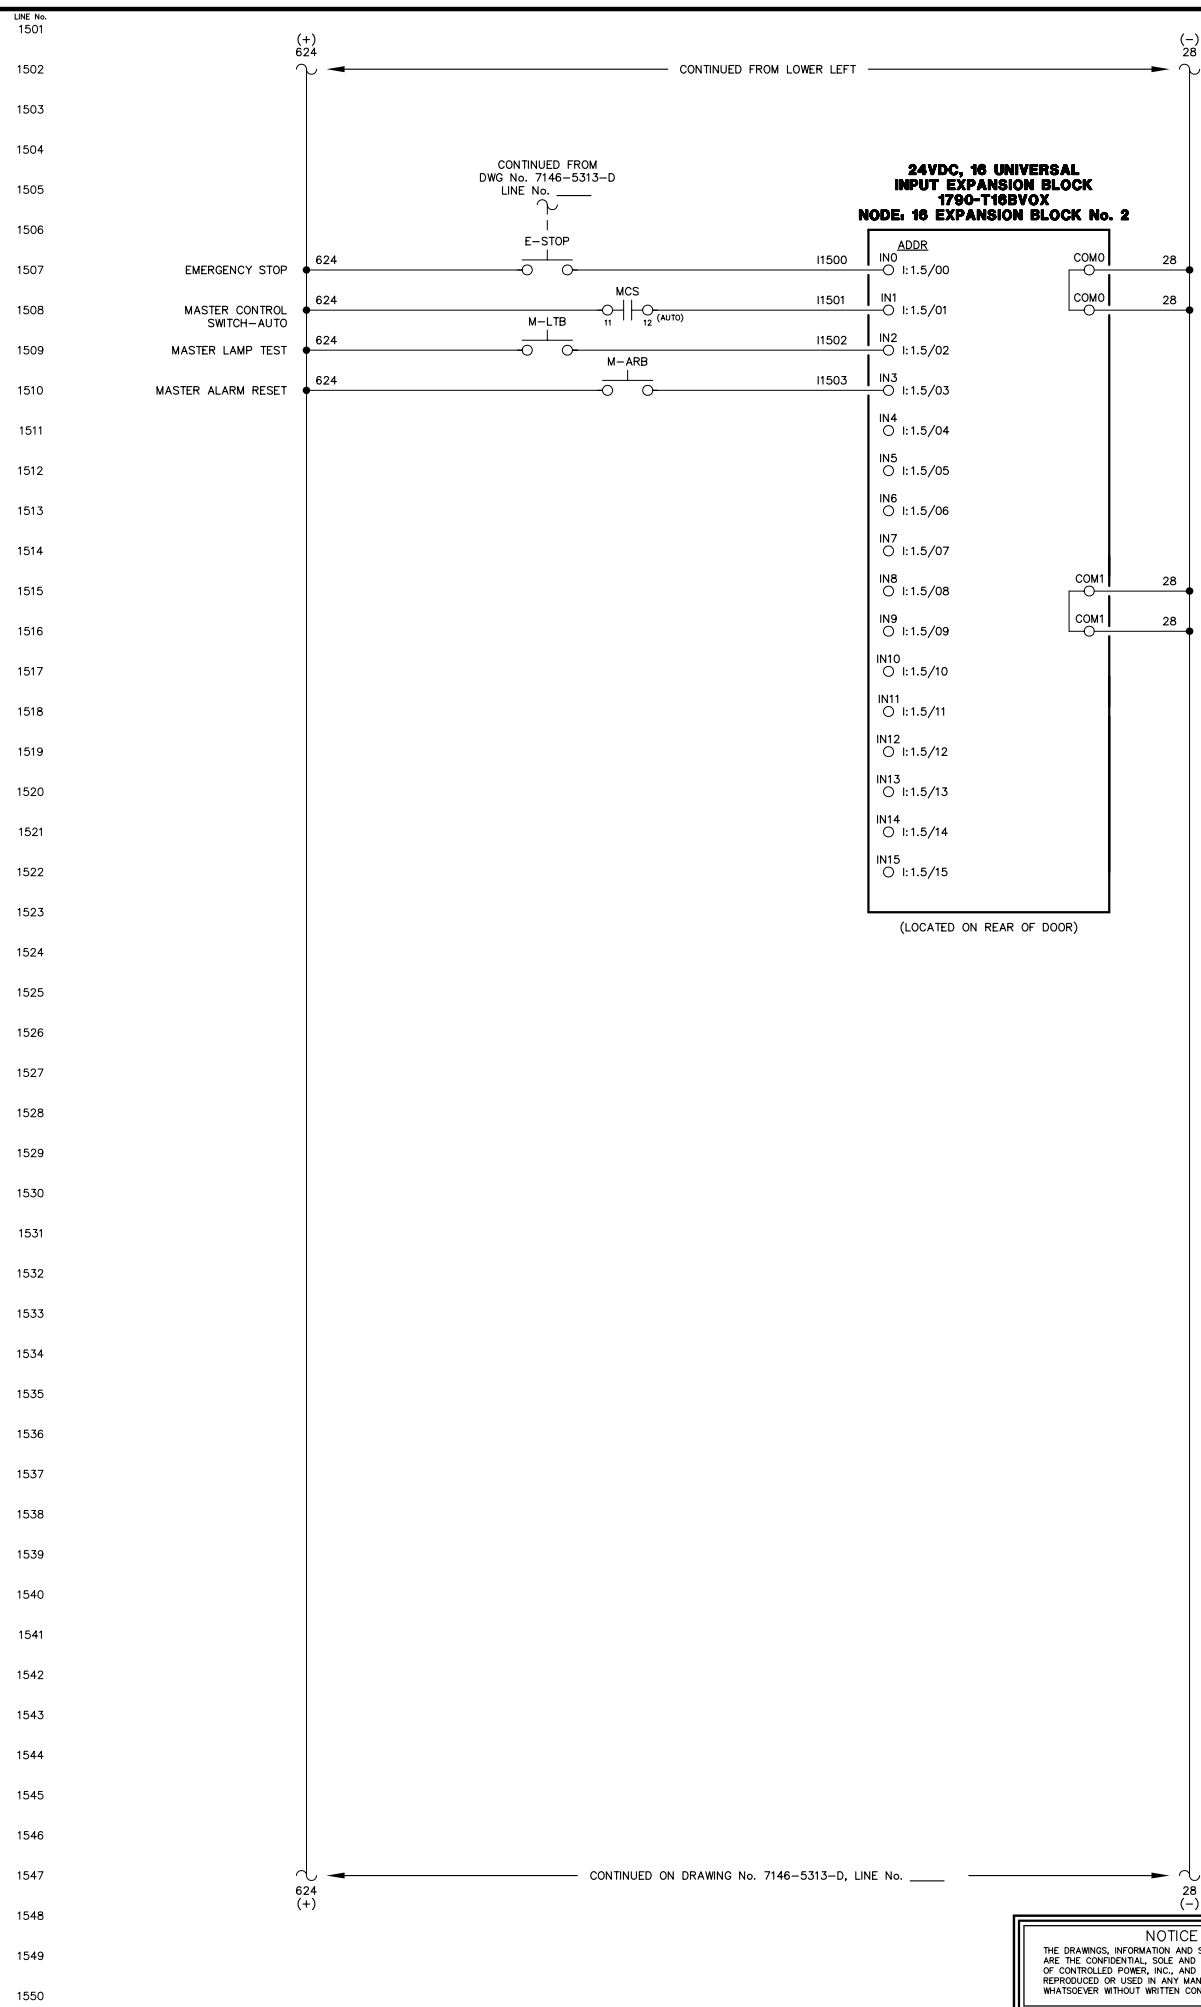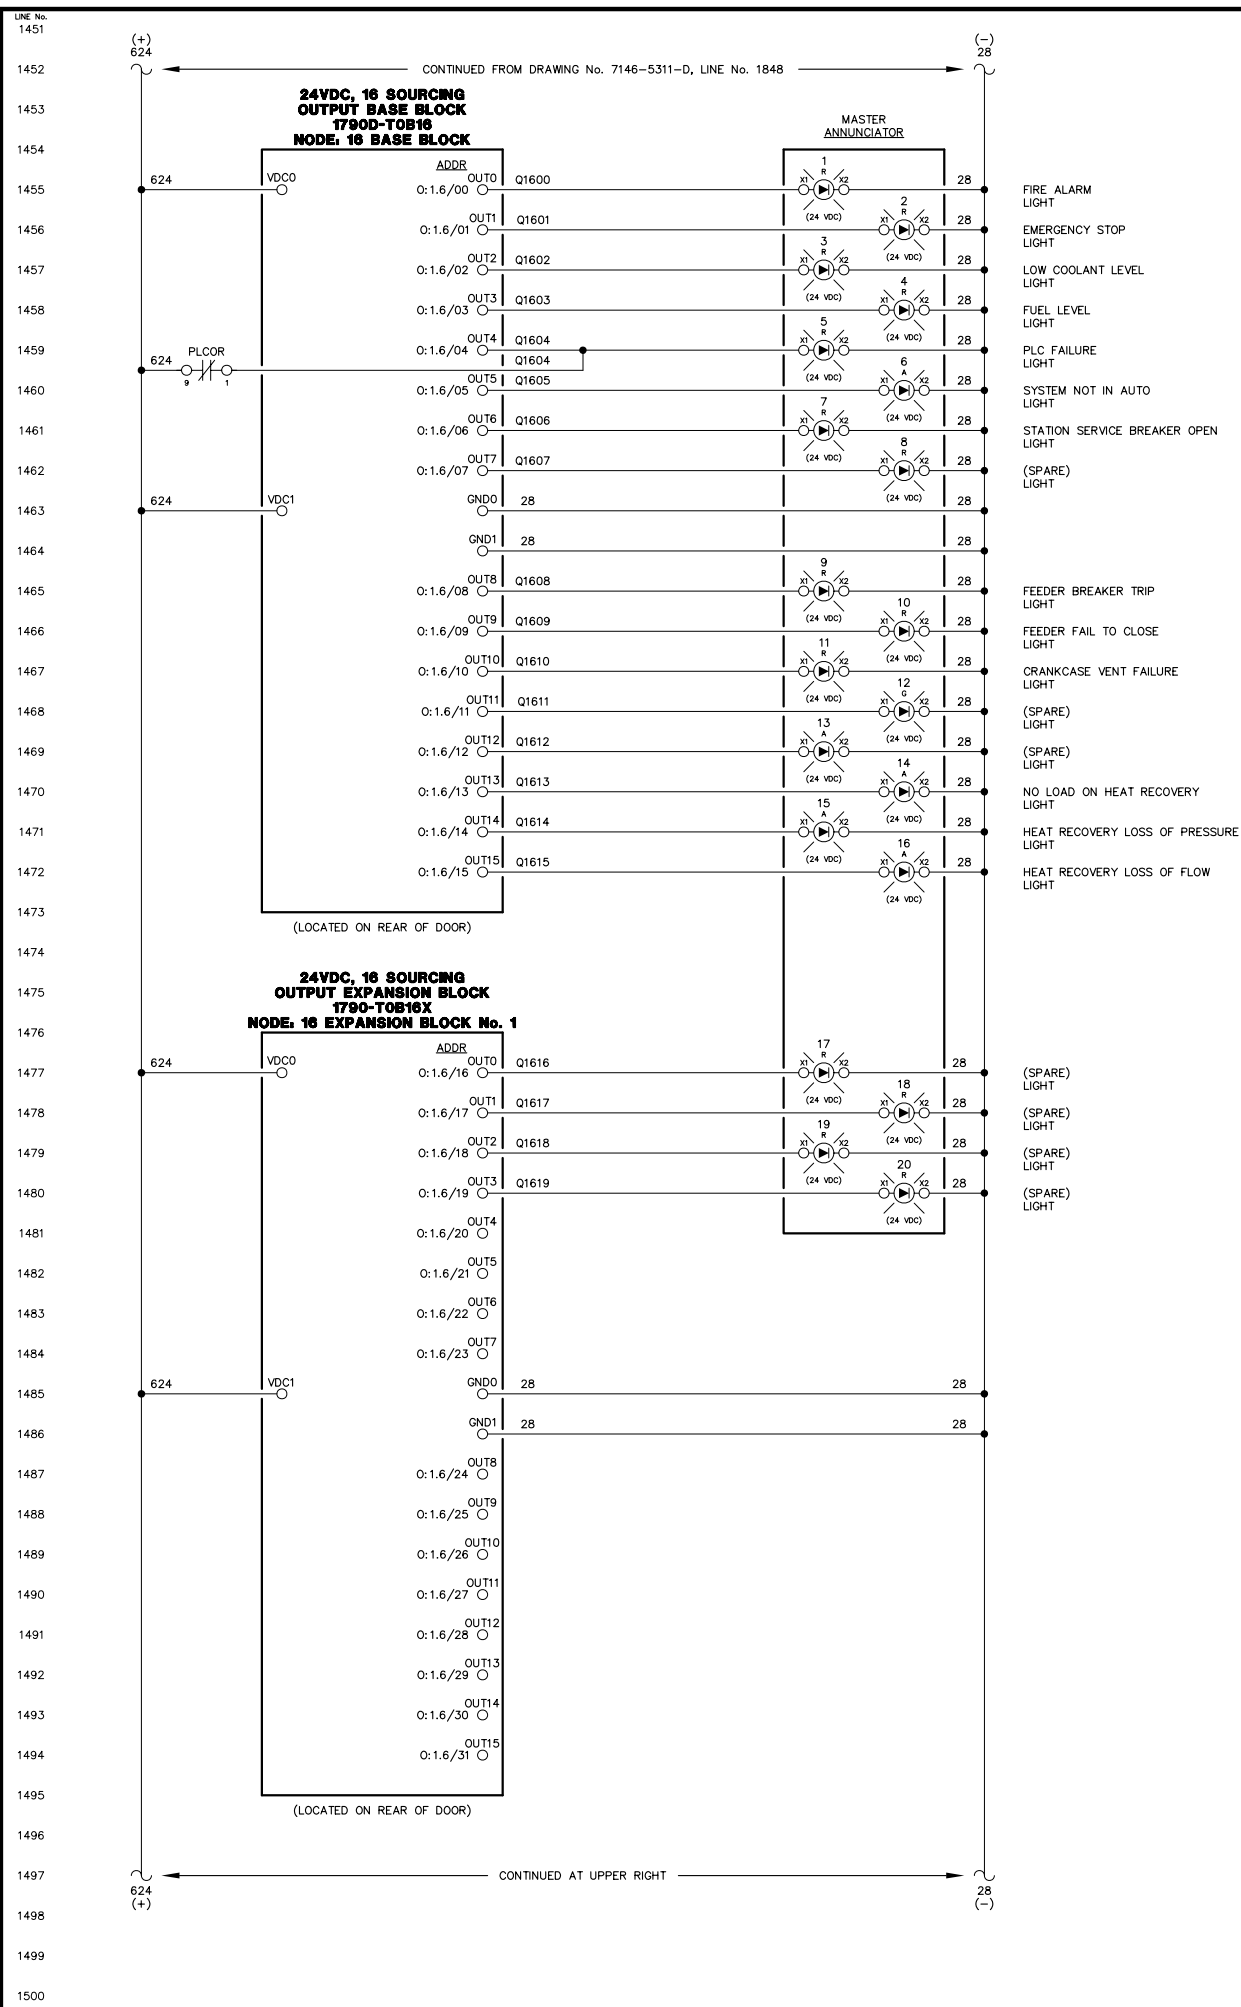

NOTE:
FOR GENERAL WIRING & CONSTRUCTION NOTES, SEE DRAWING No. 7146-3101-D.

A	05-04-11	SHOP AS BUILT	GN
REV.	DATE	DESCRIPTION	BY
AEA PURCHASE ORDER No. REG-11-044		CONTROLLED POWER JOB No. 7146	
TITLE: MASTER DC CONTROL, SCHEMATIC DIAGRAM			
SCALE: NONE		DATE: 03-01-11	DWN. BY: GN
DWG. No: 7146-5312-D		SHEET: 1 OF 1	CKD. BY: JMD
JOB: RUBY GENERATOR SWITCHGEAR			


NOTICE

THE DRAWINGS, INFORMATION AND SUBJECT MATTER HEREOF ARE THE CONFIDENTIAL, SOLE AND EXCLUSIVE PROPERTY OF CONTROLLED POWER, INC., AND ARE NOT TO BE COPIED, REPRODUCED OR USED IN ANY MANNER FOR ANY PURPOSE WHATSOEVER WITHOUT WRITTEN CONSENT OR DIRECTION.




RURAL ENERGY GROUP
813 W. NORTHERN LIGHTS BLVD.
ANCHORAGE, ALASKA 99503
HTTP://WWW.AIDEA.ORG

LINE No.
1551

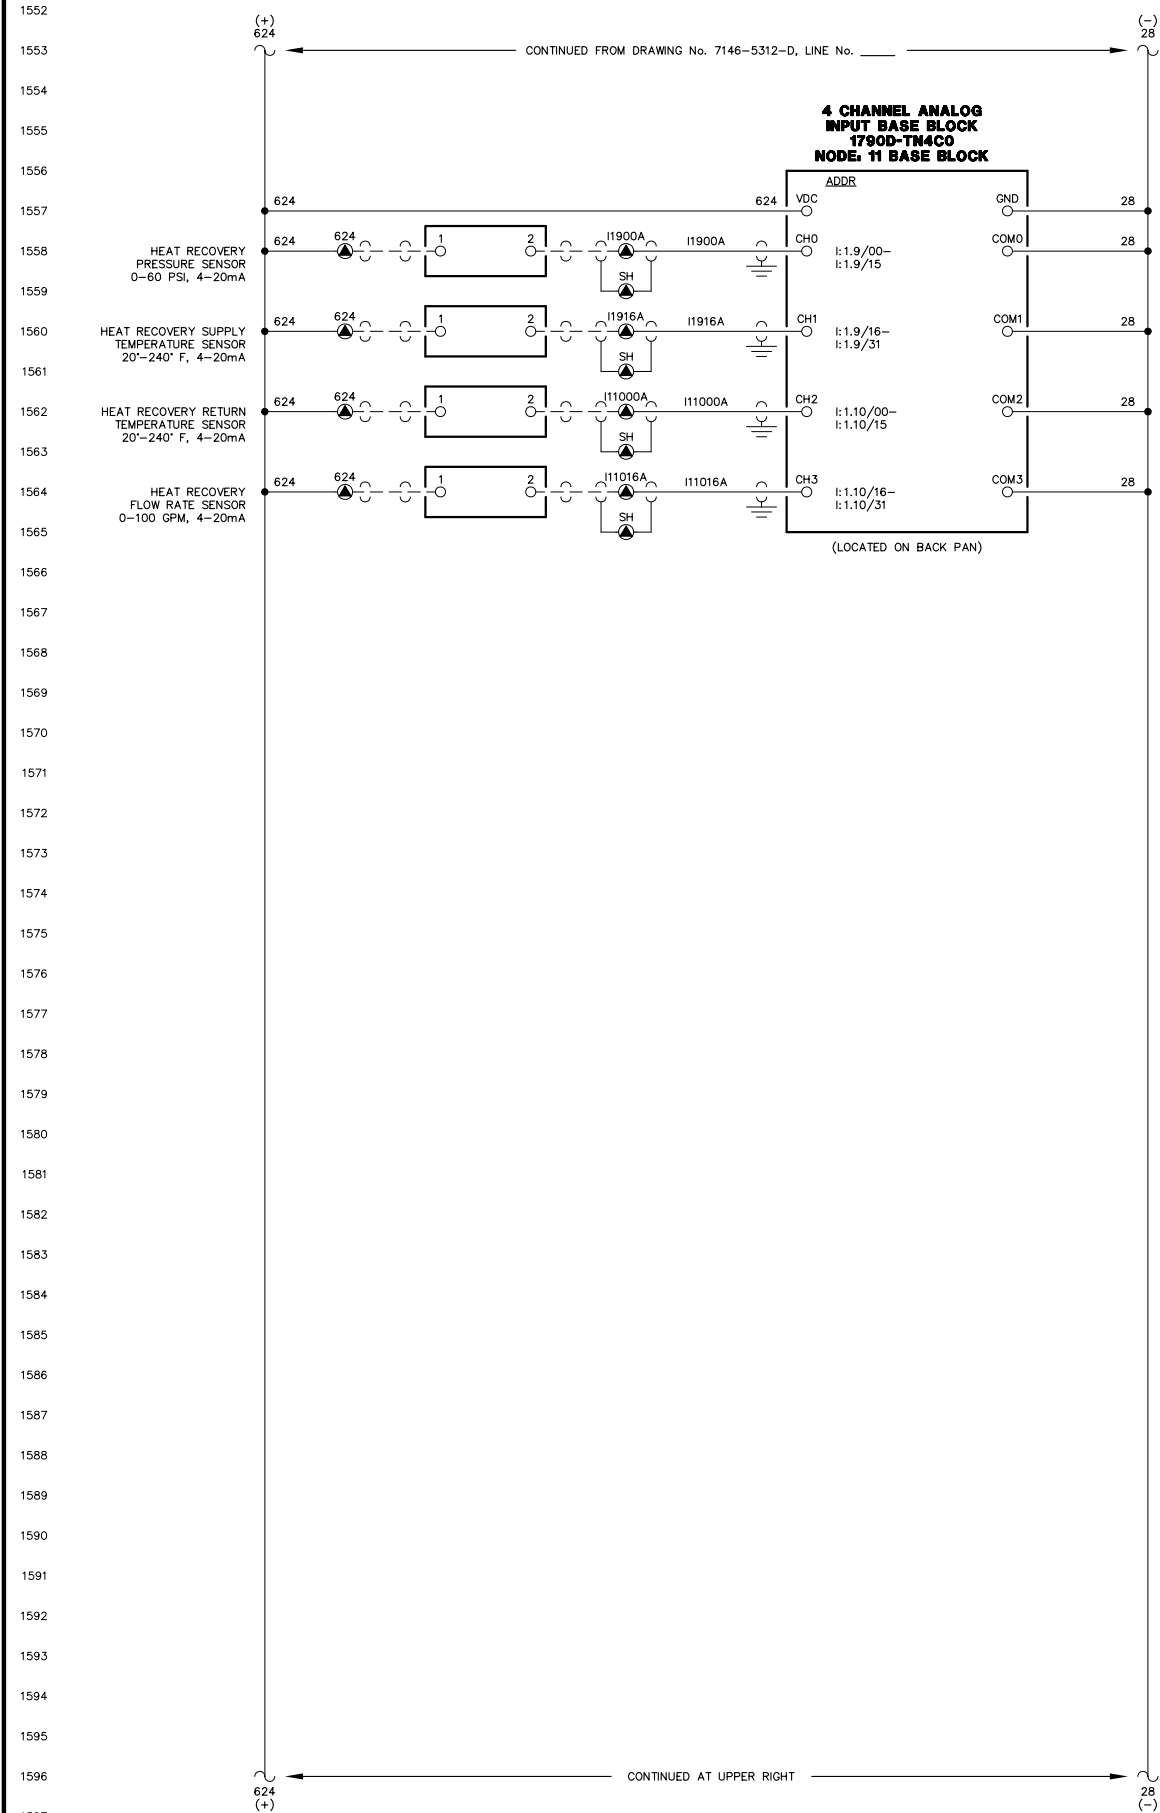

LINE No.
1601

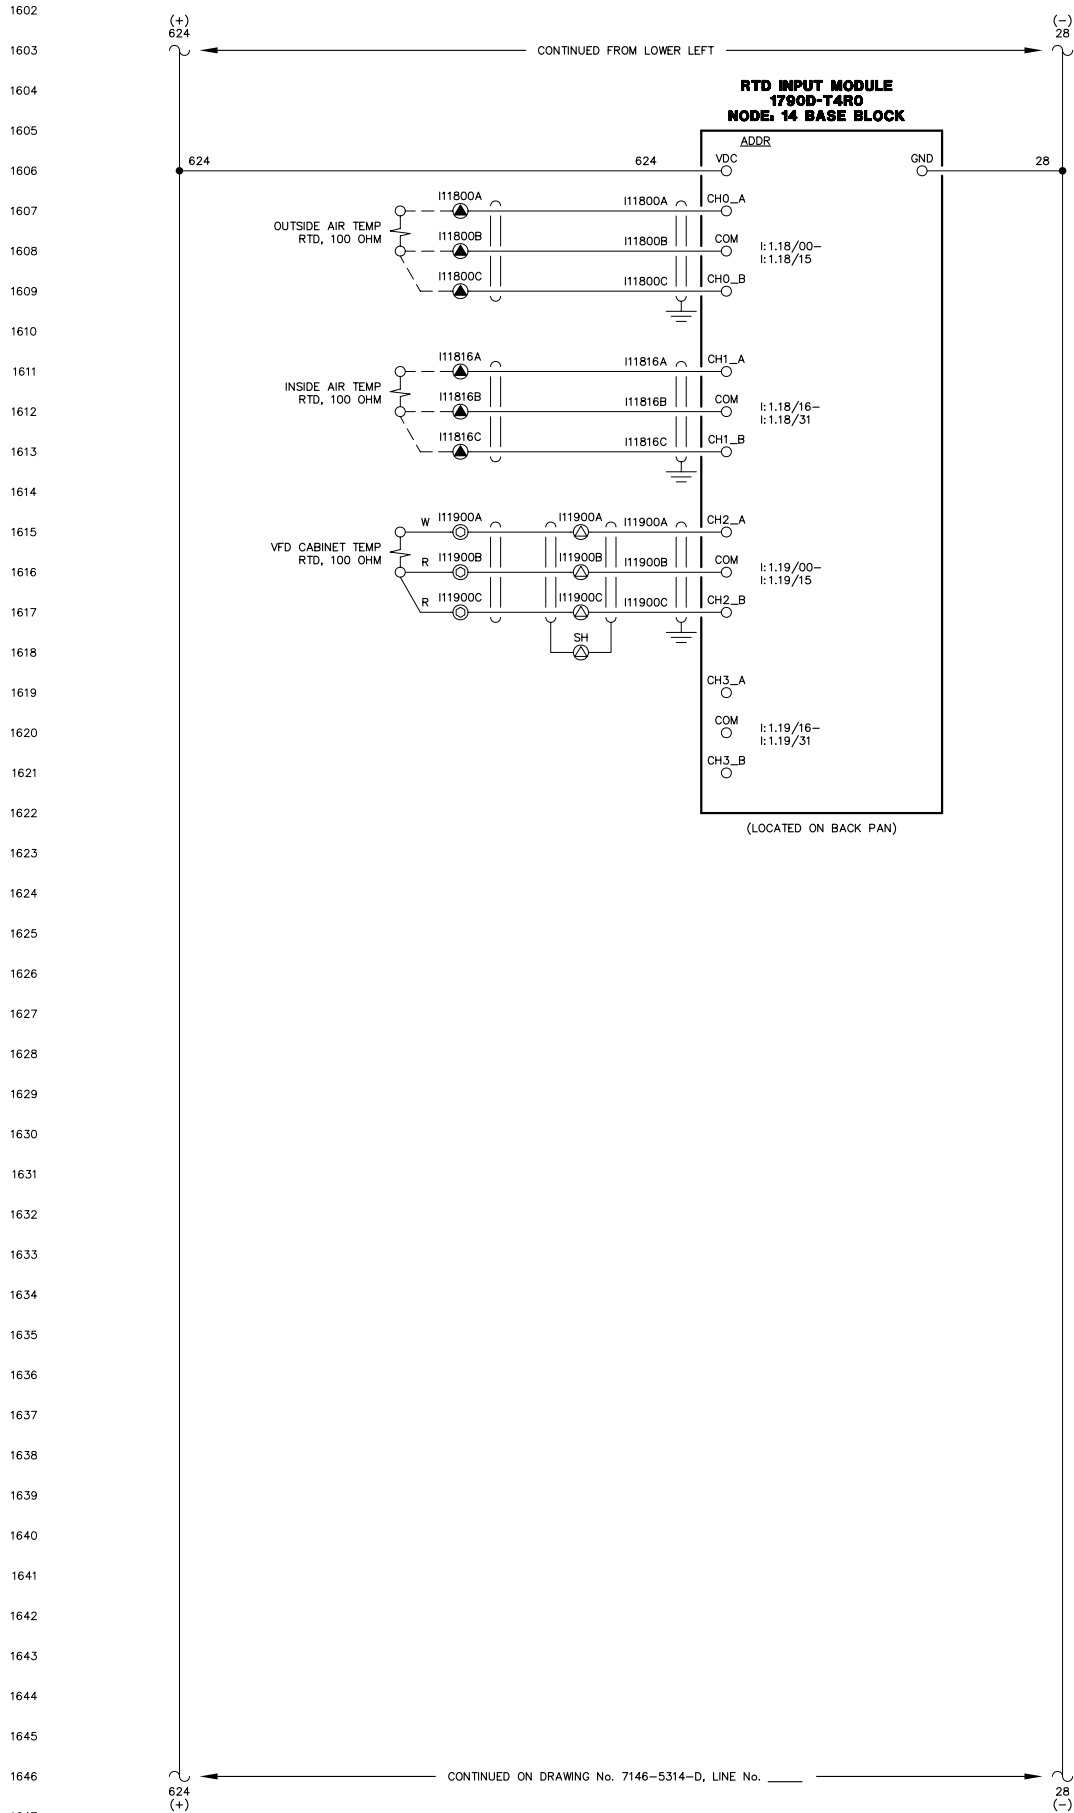


NOTE:
1. FOR GENERAL WIRING & CONSTRUCTION NOTES, SEE DRAWING No. 7146-3101-D.

A	05-04-11	SHOP AS BUILT	GPN
REV.	DATE	DESCRIPTION	BY
AEA PURCHASE ORDER No. REG-11-044 CONTROLLED POWER JOB No. 7146			
TITLE: MASTER DC CONTROL, SCHEMATIC DIAGRAM			
SCALE: NONE		DATE: 03-01-11	DWN. BY: GPN
DWG. No: 7146-5313-D		SHEET: 1 OF 1	CKD. BY: JMD
JOB: RUBY GENERATOR SWITCHGEAR			


NOTICE
THE DRAWINGS, INFORMATION AND SUBJECT MATTER HEREOF
ARE THE CONFIDENTIAL, SOLE AND EXCLUSIVE PROPERTY
OF CONTROLLED POWER, INC. AND ARE NOT TO BE COPIED,
REPRODUCED OR USED IN ANY MANNER FOR ANY PURPOSE
WHATSOEVER WITHOUT WRITTEN CONSENT OR DIRECTION.




RURAL ENERGY GROUP
813 W. NORTHERN LIGHTS BLVD.
ANCHORAGE, ALASKA 99503
HTTP://WWW.AIDEA.ORG

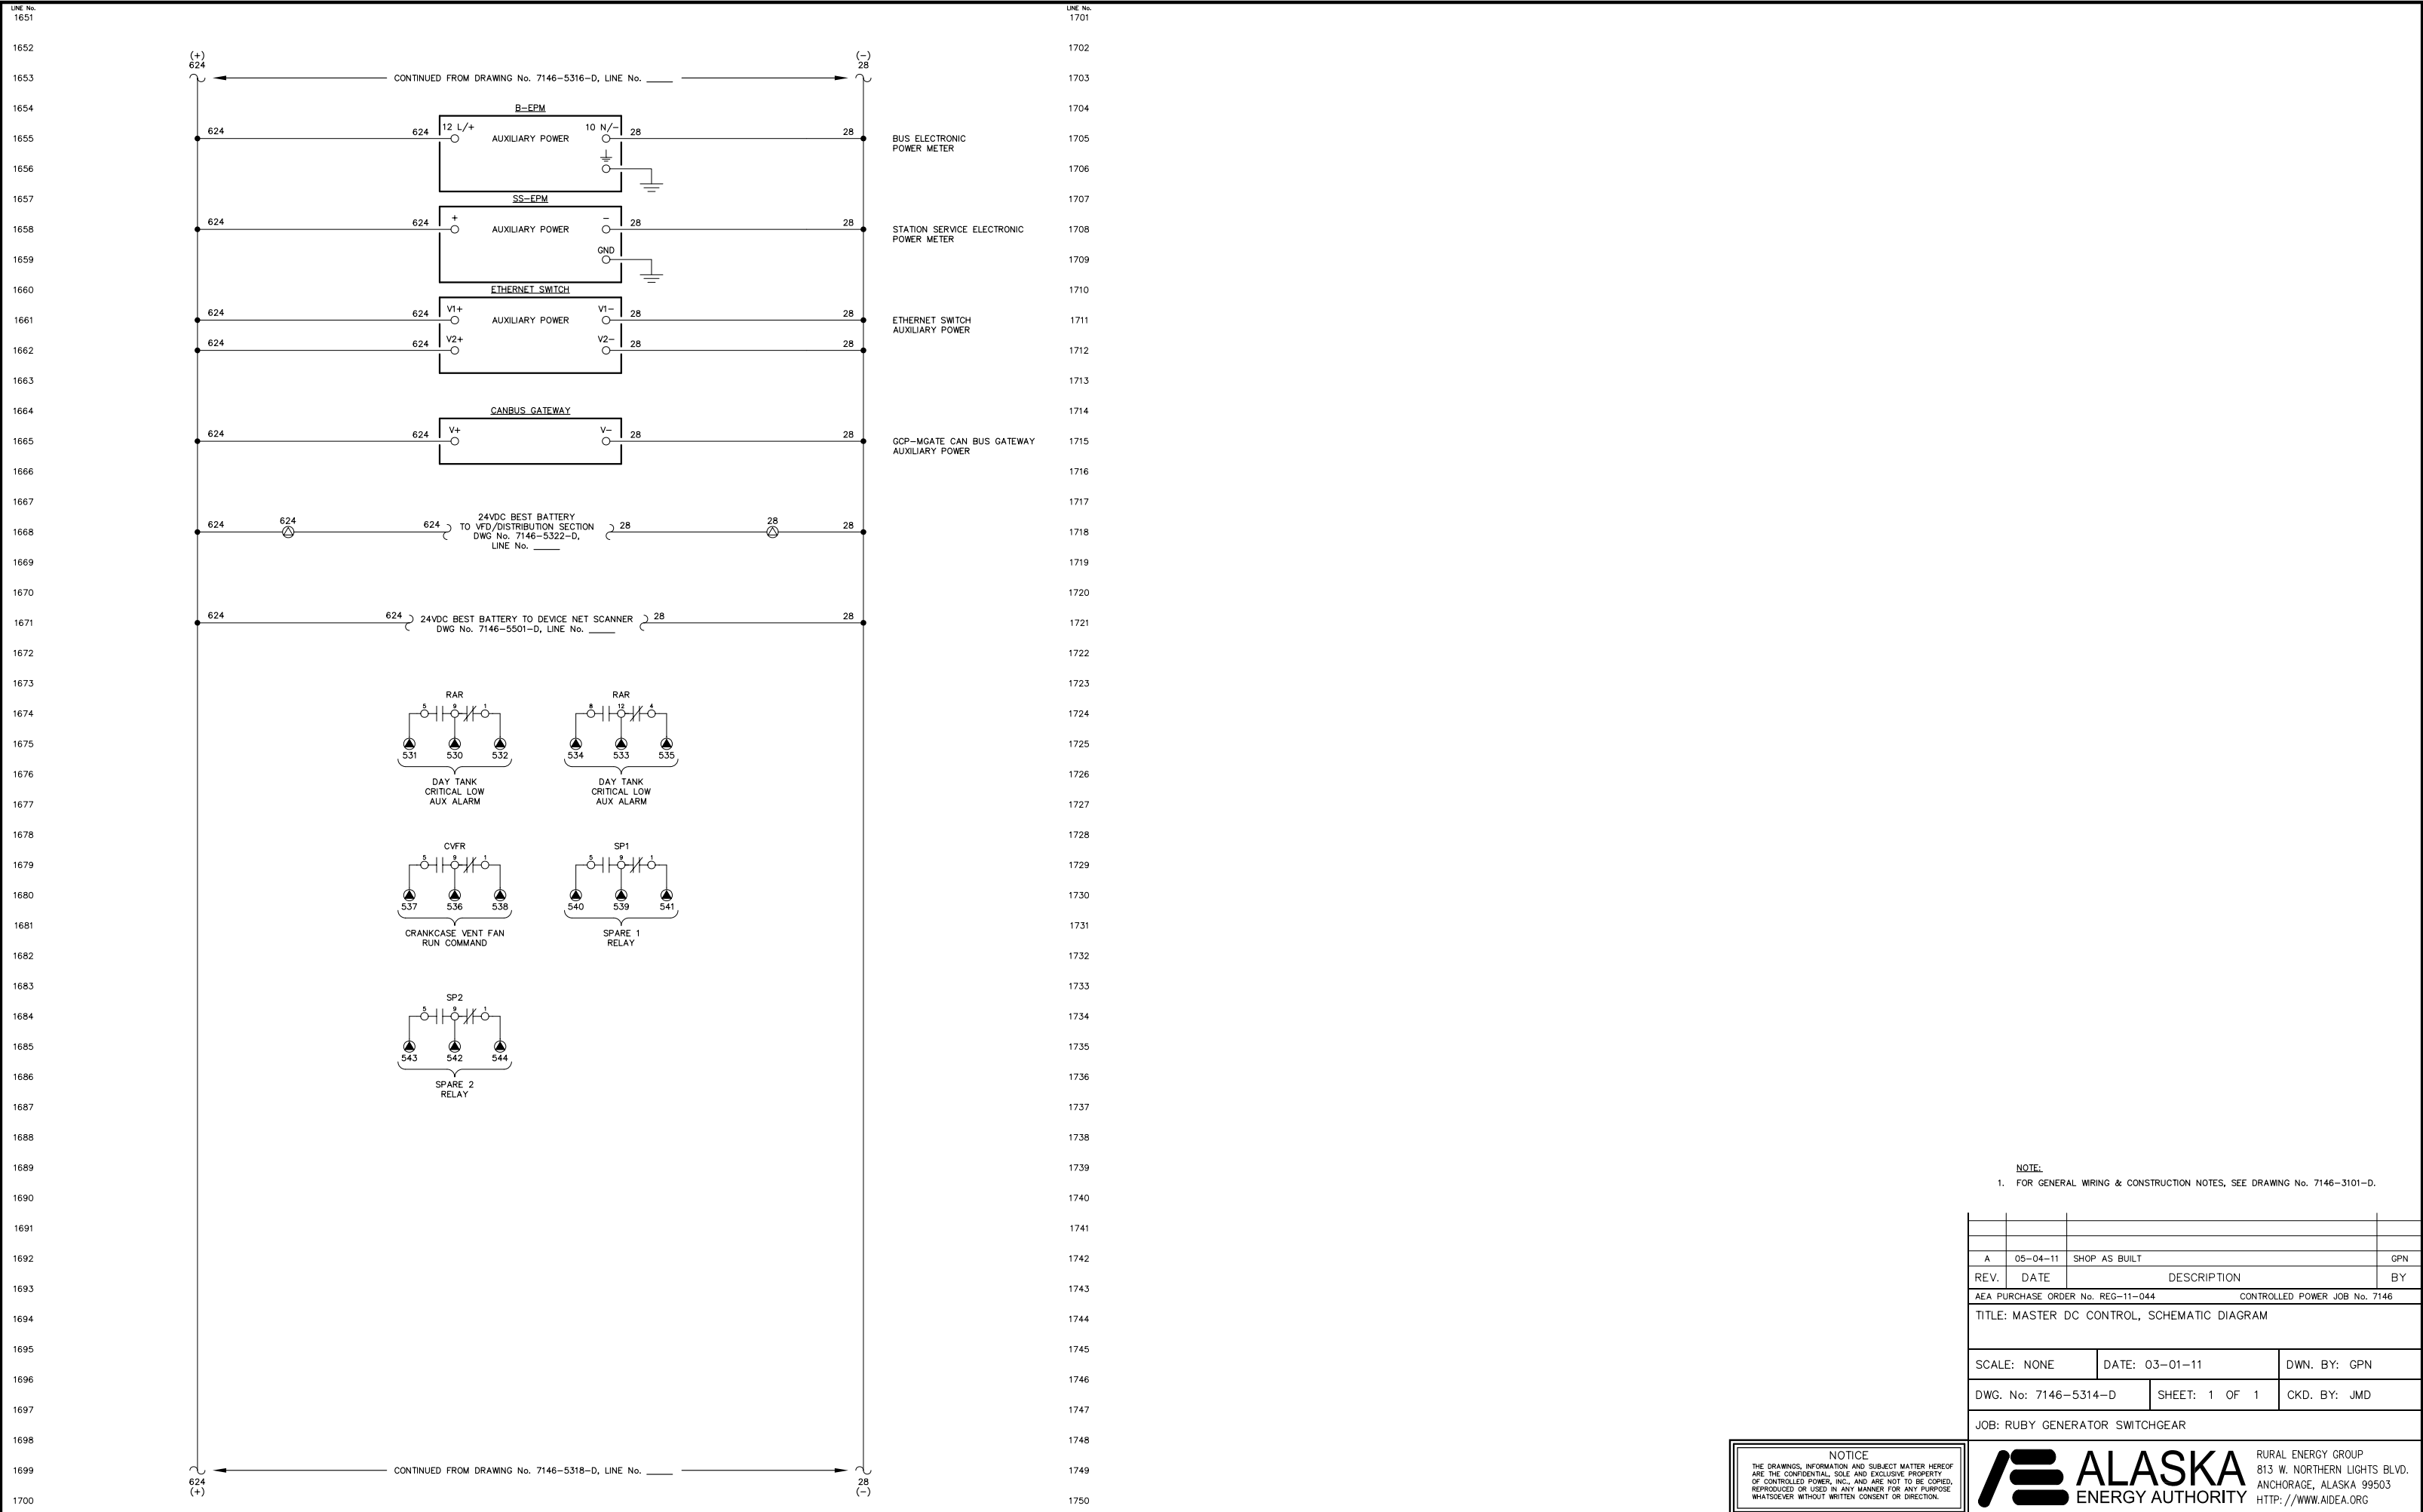

1751
1752
1753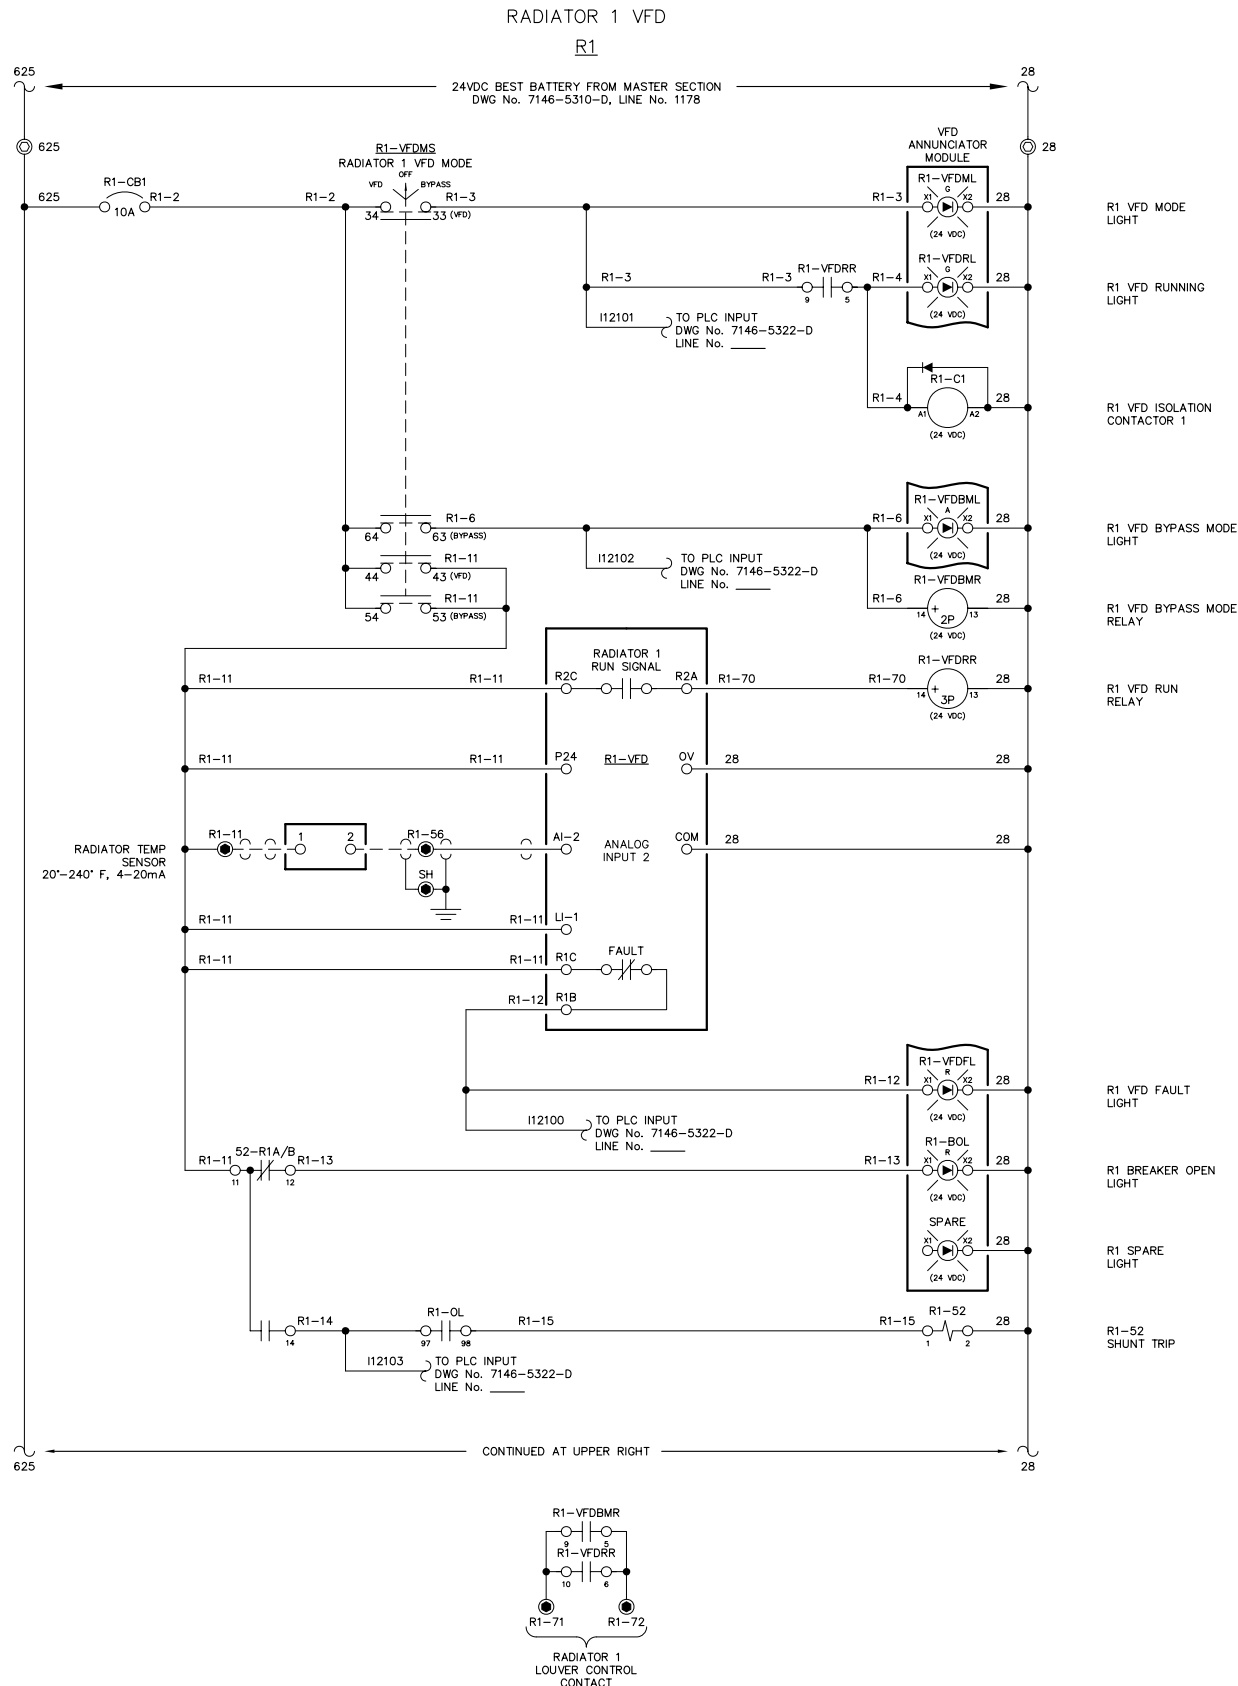
1801
1802
1803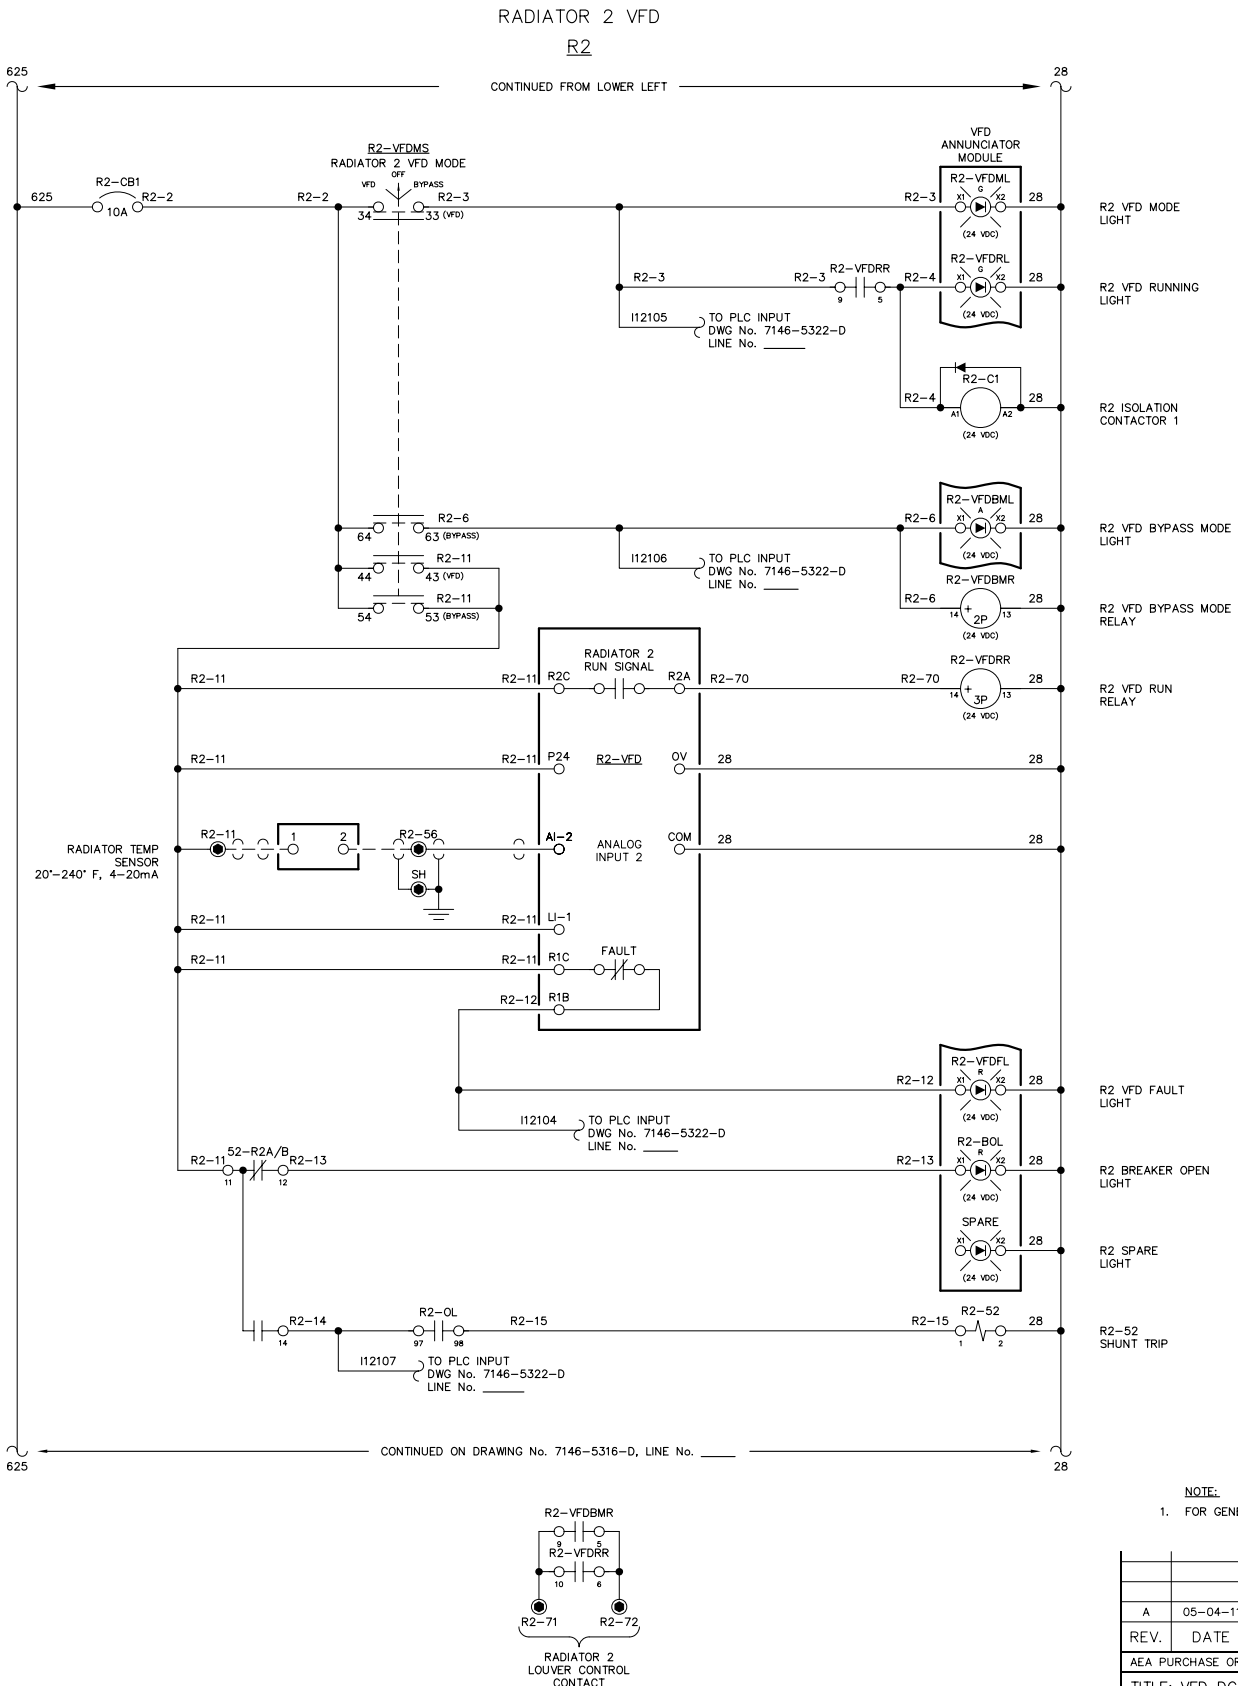
NOTE:
1. FOR GENERAL WIRING & CONSTRUCTION NOTES, SEE DRAWING No. 7146-3101-D.

A	05-04-11	SHOP AS BUILT	GPN
REV.	DATE	DESCRIPTION	BY
AEA PURCHASE ORDER No. REG-11-044 CONTROLLED POWER JOB No. 7146			
TITLE: VFD DC CONTROL, SCHEMATIC DIAGRAM			
SCALE: NONE		DATE: 03-01-11	DWN. BY: GPN
DWG. No: 7146-5315-D		SHEET: 1 OF 1	CKD. BY: JMD
JOB: RUBY GENERATOR SWITCHGEAR			

NOTICE
THE DRAWINGS, INFORMATION AND SUBJECT MATTER HEREOF ARE THE CONFIDENTIAL, SOLE AND EXCLUSIVE PROPERTY OF CONTROLLED POWER, INC. AND ARE NOT TO BE COPIED, REPRODUCED OR USED IN ANY MANNER FOR ANY PURPOSE WHATSOEVER WITHOUT WRITTEN CONSENT OR DIRECTION.

ALASKA
ENERGY AUTHORITY
RURAL ENERGY GROUP
813 W. NORTHERN LIGHTS BLVD.
ANCHORAGE, ALASKA 99503
HTTP://WWW.AIDEA.ORG

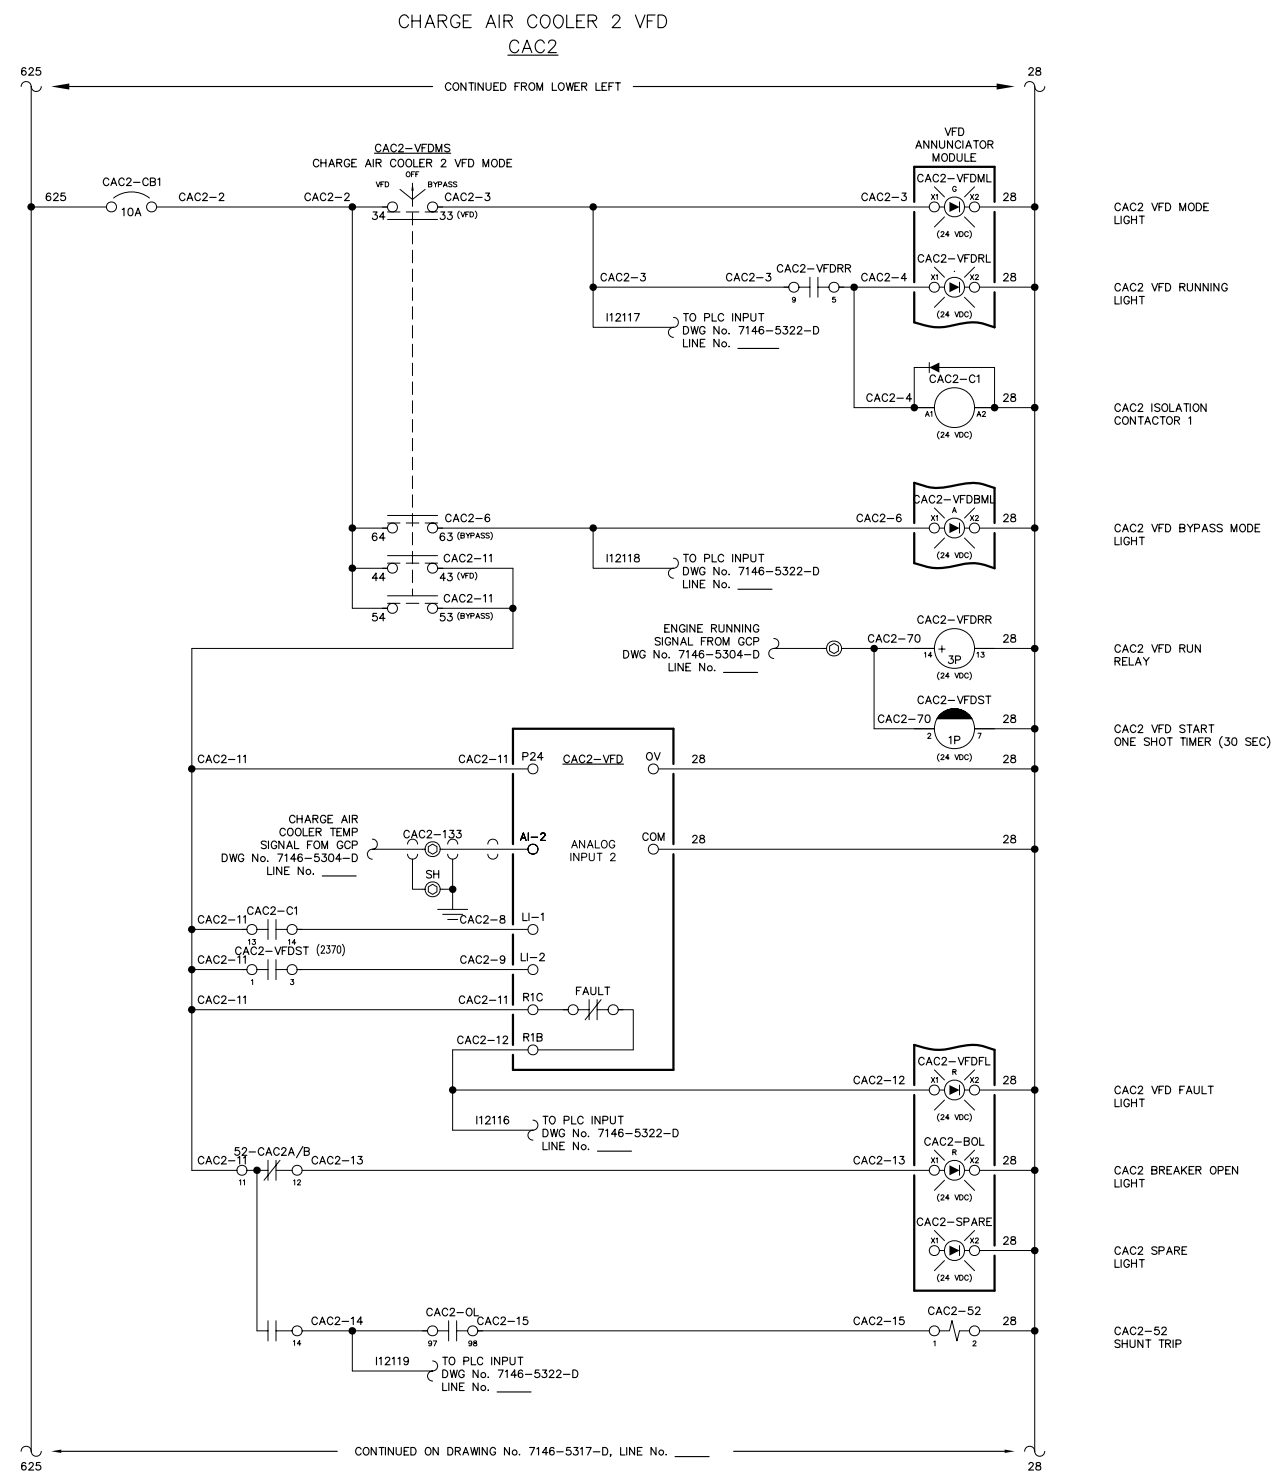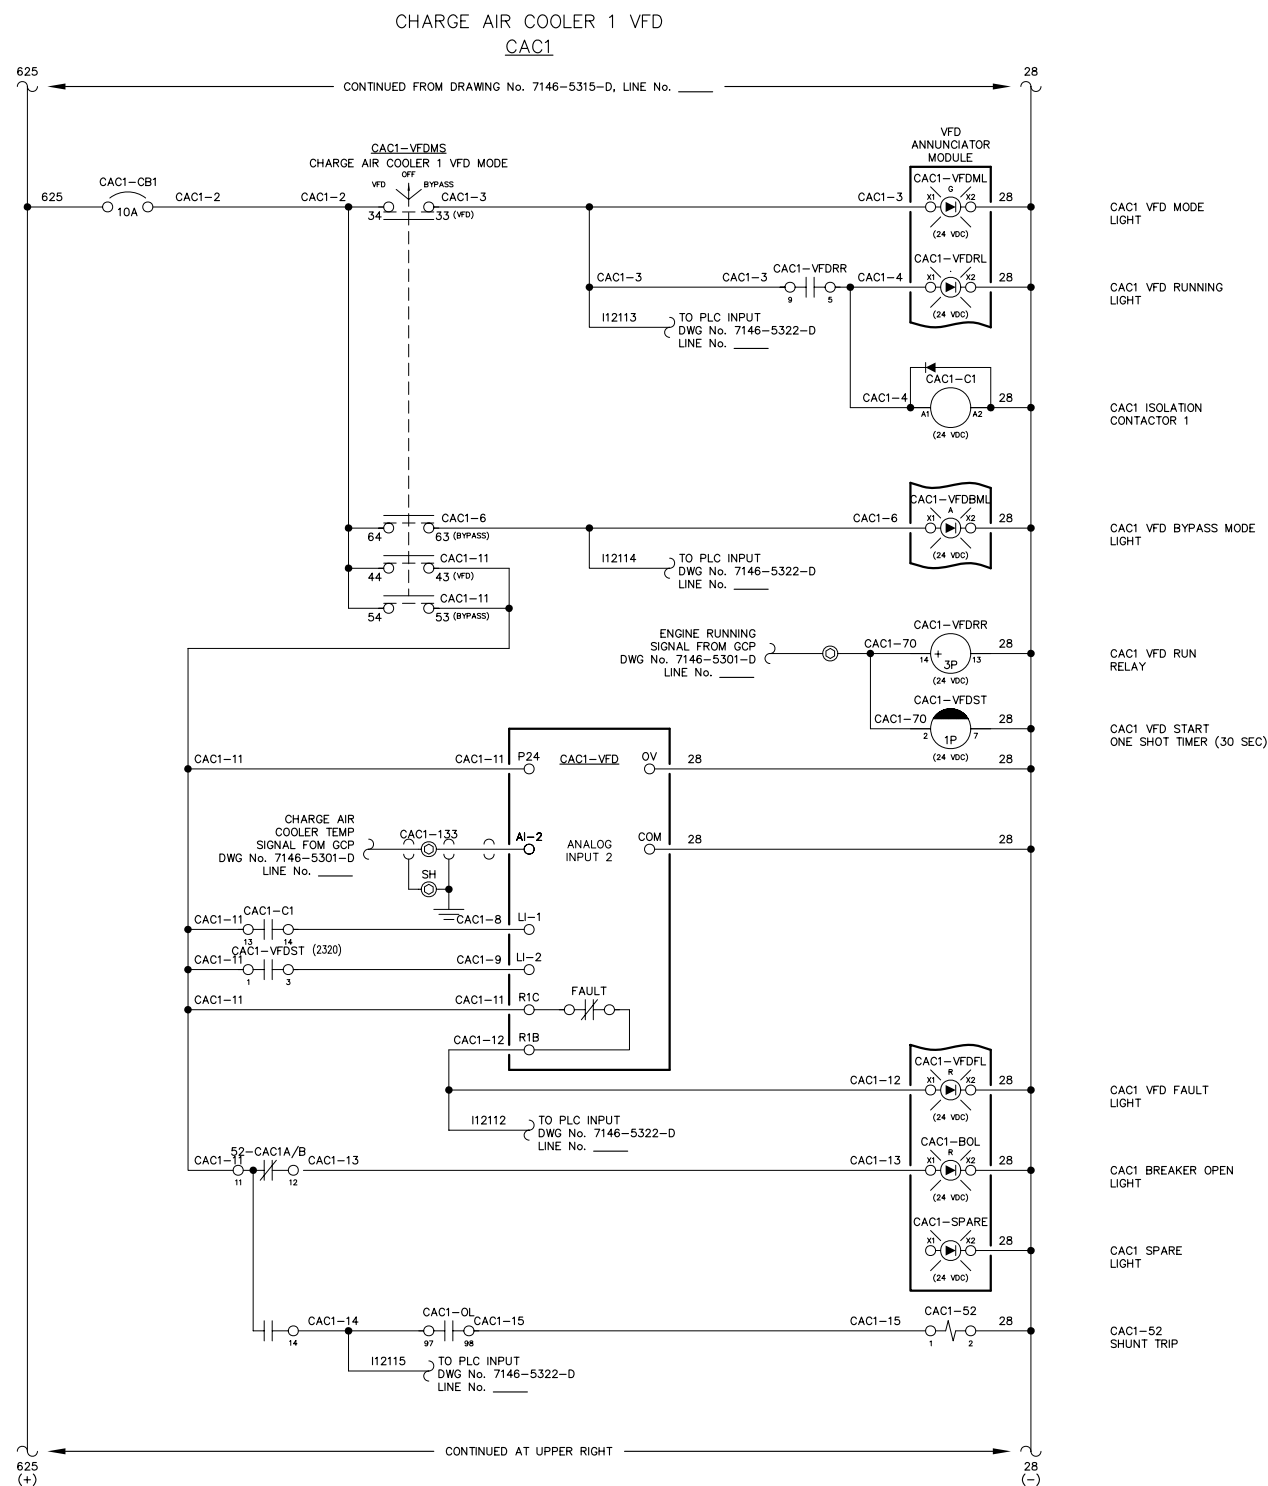

NOTE:



1. FOR GENERAL WIRING & CONSTRUCTION NOTES, SEE DRAWING No. 7146-3101-D.

A	05-04-11	SHOP AS BUILT			GPN
REV.	DATE	DESCRIPTION			BY
AEA PURCHASE ORDER No. REG-11-044				CONTROLLED POWER JOB No. 7146	
TITLE: VFD DC CONTROL, SCHEMATIC DIAGRAM					
SCALE: NONE		DATE: 03-01-11		DWN. BY: GPN	
DWG. No: 7146-5316-D		SHEET: 1 OF 1		CKD. BY: JMD	
JOB: RUBY GENERATOR SWITCHGEAR					

NOTICE

THE DRAWINGS, INFORMATION AND SUBJECT MATTER HEREON ARE THE CONFIDENTIAL, SOLE AND EXCLUSIVE PROPERTY OF CONTROLLED POWER, INC., AND ARE NOT TO BE COPIED, REPRODUCED OR USED IN ANY MANNER FOR ANY PURPOSE WHATSOEVER WITHOUT WRITTEN CONSENT OR DIRECTION.



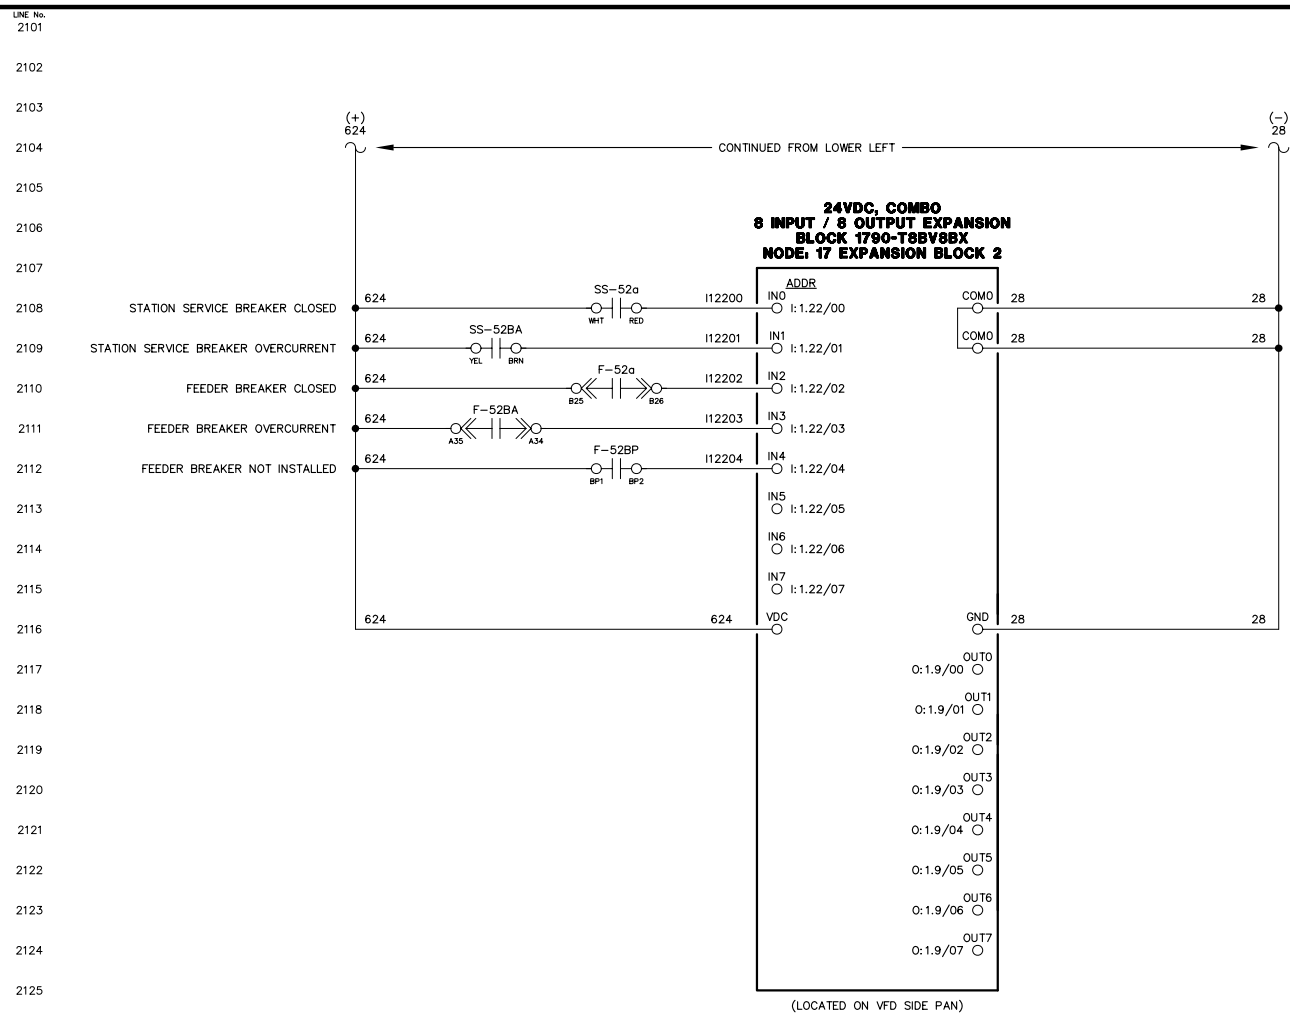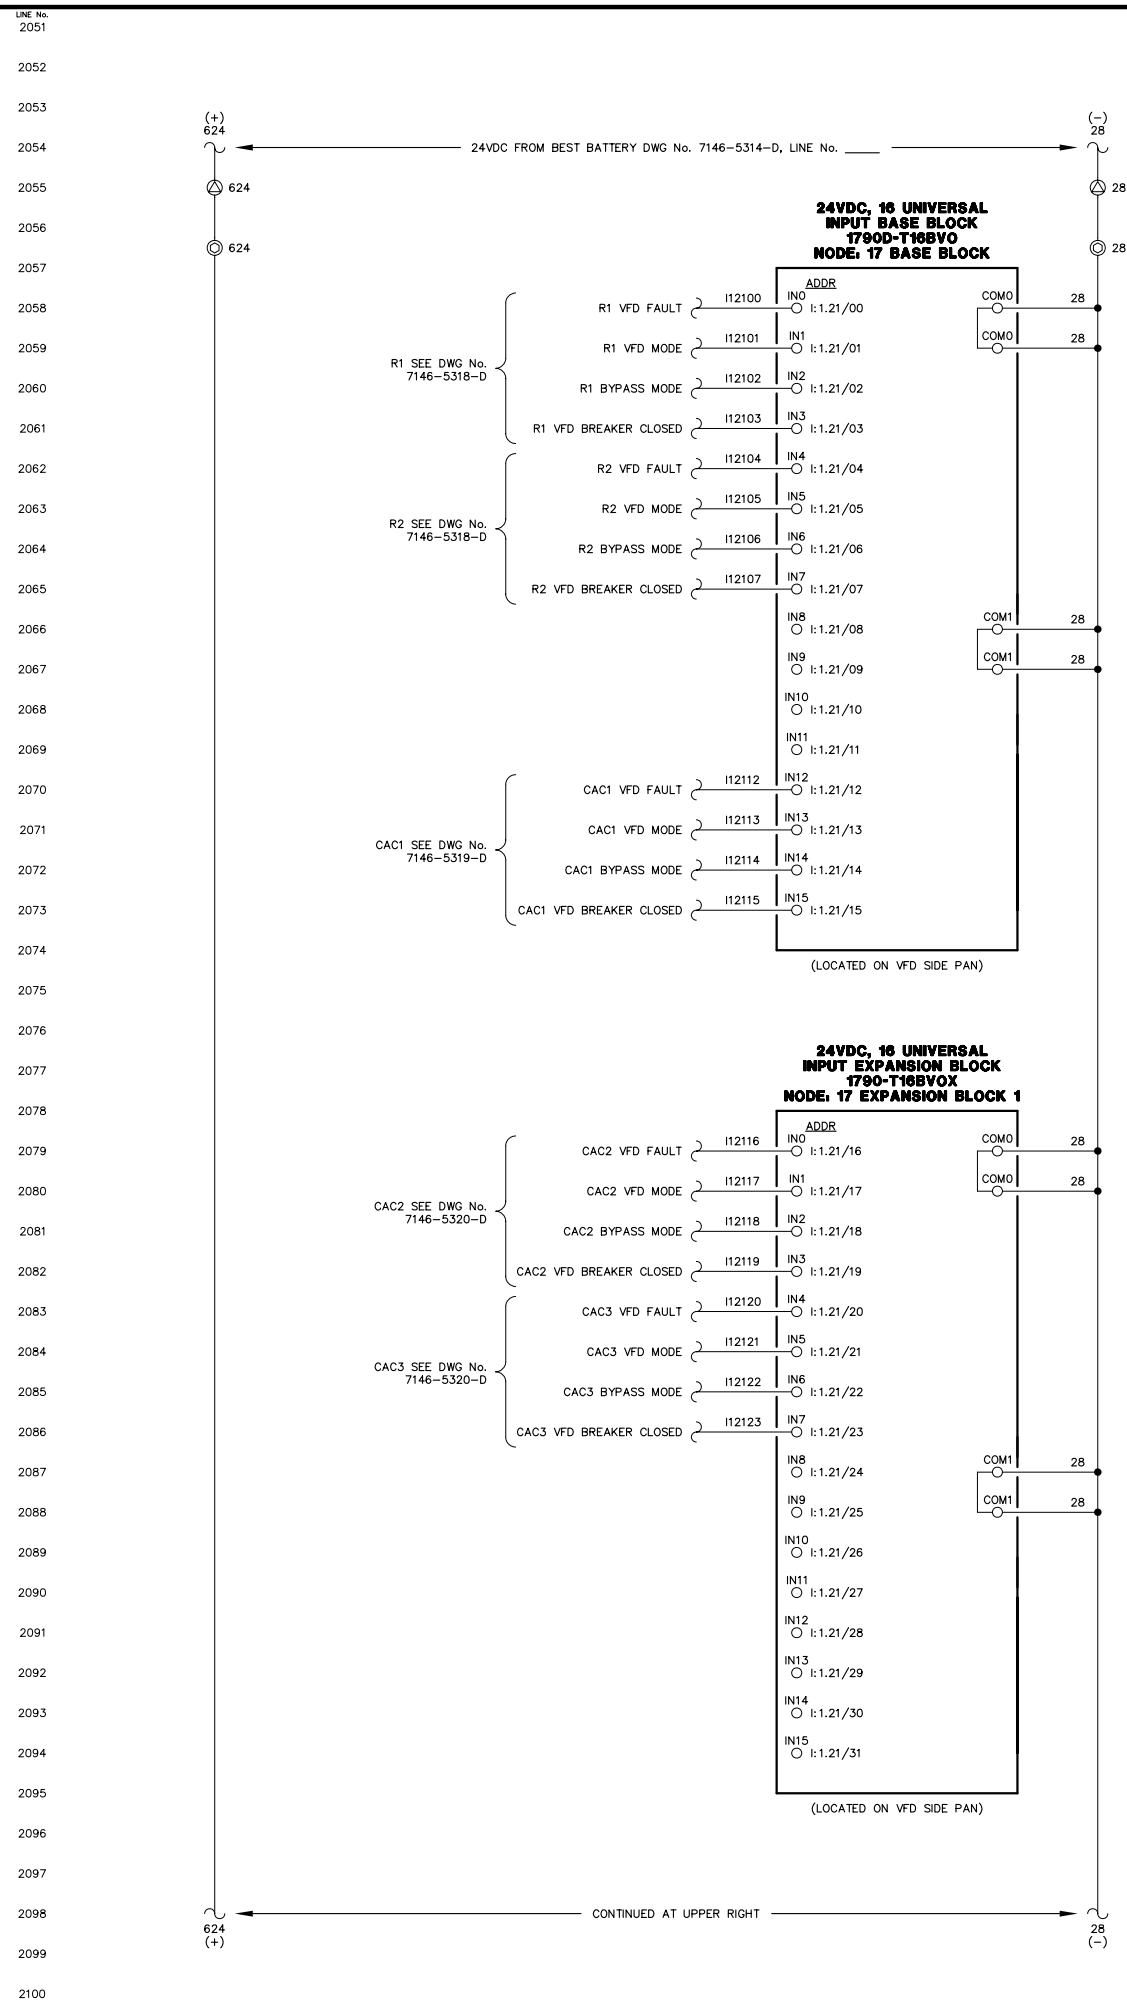

NOTE:
FOR GENERAL WIRING & CONSTRUCTION NOTES, SEE DRAWING No. 7146-3101-D.



A	05-04-11	SHOP AS BUILT			GN
REV.	DATE	DESCRIPTION			BY
AEA PURCHASE ORDER No. REC-10-042		CONTROLLED POWER JOB No. 7146			
TITLE: VFD/DISTRIBUTION DC CONTROL, SCHEMATIC DIAGRAM					
SCALE: NONE		DATE: 04-06-10		DWN. BY: GPN	
DWG. No: 7146-5318-D		SHEET: 1 OF 1		CKD. BY: JMD	
JOB: RUBY GENERATOR SWITCHGEAR					

NOTICE

THE DRAWINGS, INFORMATION AND SUBJECT MATTER HEREOF ARE THE CONFIDENTIAL, SOLE AND EXCLUSIVE PROPERTY OF CONTROLLED POWER, INC., AND ARE NOT TO BE COPIED, REPRODUCED OR USED IN ANY MANNER FOR ANY PURPOSE WHATSOEVER WITHOUT WRITTEN CONSENT OR DIRECTION.



RURAL ENERGY GROUP
813 W. NORTHERN LIGHTS BLVD.
ANCHORAGE, ALASKA 99503
HTTP://WWW.AIDEA.ORG

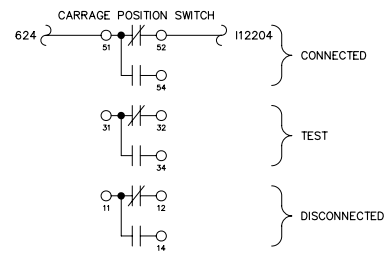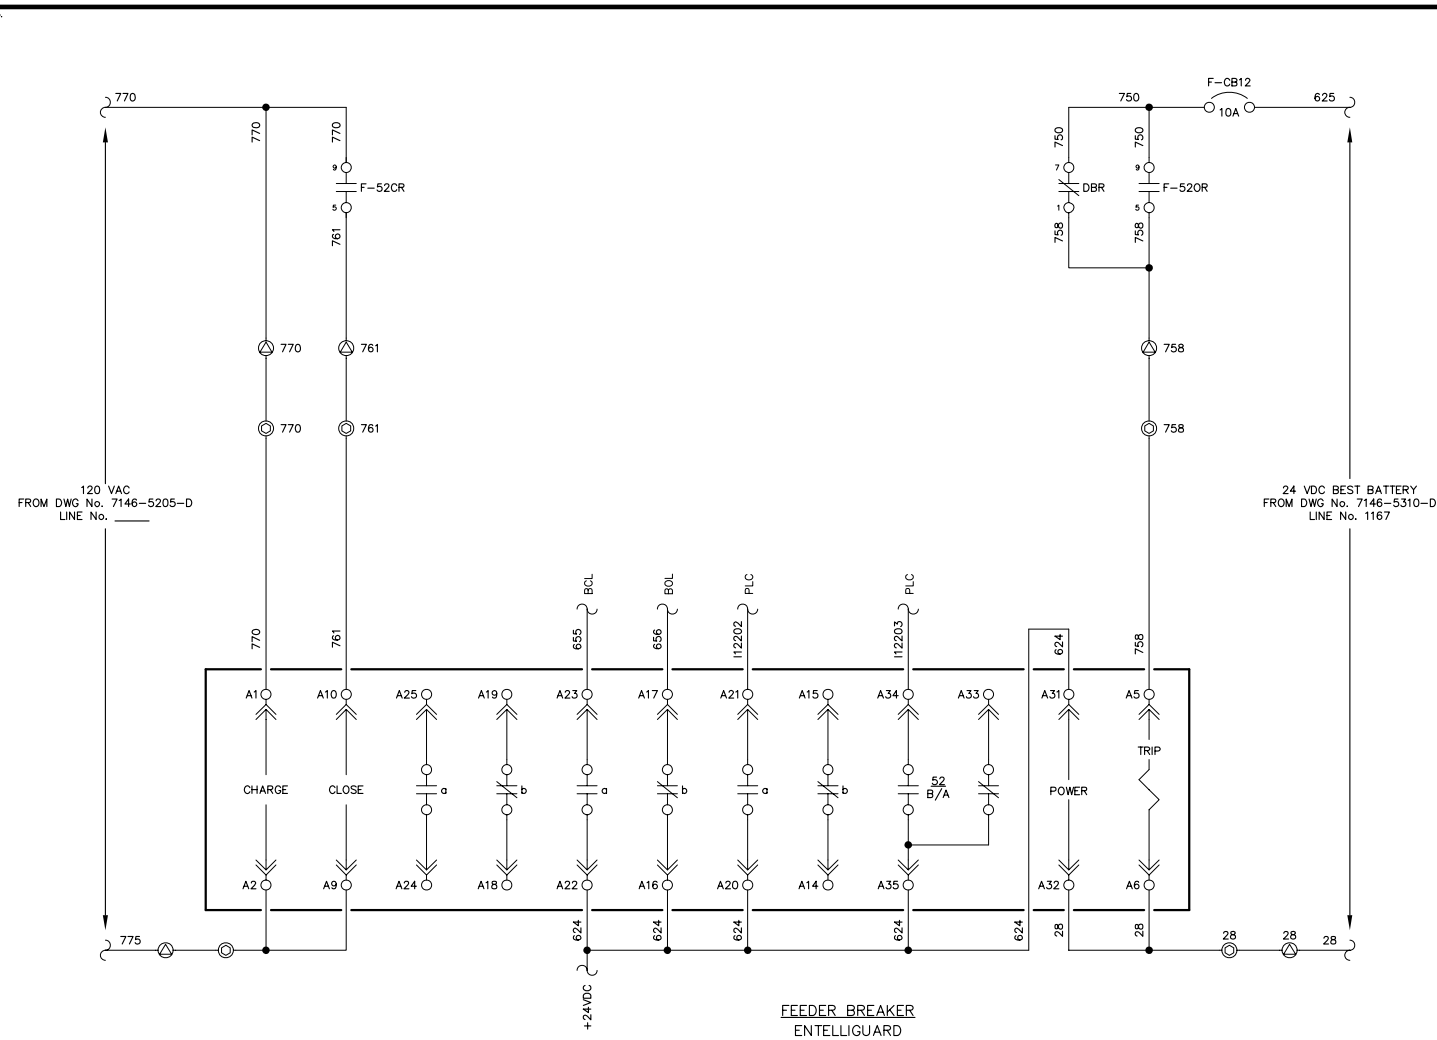

NOTE:

1. FOR GENERAL WIRING & CONSTRUCTION NOTES, SEE DRAWING No. 7146-3101-D.

A	05-04-11	SHOP AS BUILT	GPN
REV.	DATE	DESCRIPTION	BY
AEA PURCHASE ORDER No. REG-11-044		CONTROLLED POWER JOB No. 7146	
TITLE: FEEDER BREAKER CONTROL, SCHEMATIC DIAGRAM			
SCALE: NONE		DATE: 03-01-11	DWN. BY: GPN
DWG. No: 7146-5401-D		SHEET: 1 OF 1	CKD. BY: JMD
JOB: RUBY GENERATOR SWITCHGEAR			

NOTICE

THE DRAWINGS, INFORMATION AND SUBJECT MATTER HEREON ARE THE CONFIDENTIAL, SOLE AND EXCLUSIVE PROPERTY OF CONTROLLED POWER, INC., AND ARE NOT TO BE COPIED, REPRODUCED OR USED IN ANY MANNER FOR ANY PURPOSE WHATSOEVER WITHOUT WRITTEN CONSENT OR DIRECTION.



RURAL ENERGY GROUP
813 W. NORTHERN LIGHTS BLVD.
ANCHORAGE, ALASKA 99503
HTTP://WWW.AIDEA.ORG

LINE No.
2201

2202

2203



2246

2247

2248

2249

2250

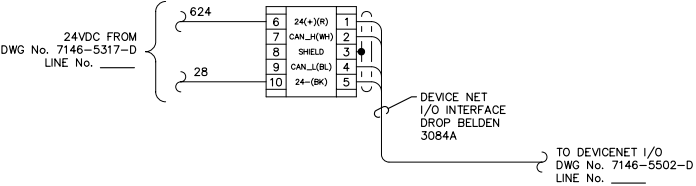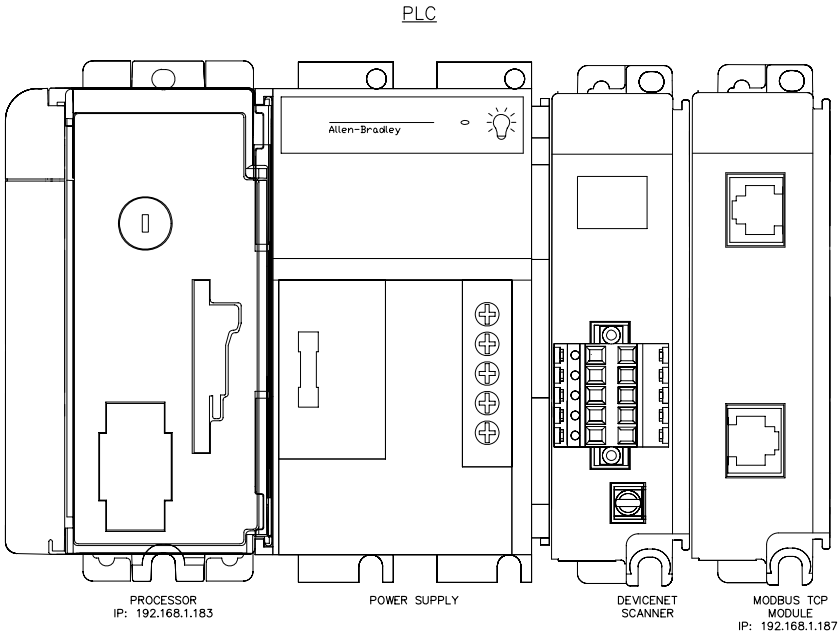

NOTE:
1. FOR GENERAL WIRING & CONSTRUCTION NOTES, SEE DRAWING No. 7146-3101-D.

A	05-04-11	SHOP AS BUILT	GPN
REV.	DATE	DESCRIPTION	BY
AEA PURCHASE ORDER No. REG-11-044 CONTROLLED POWER JOB No. 7146			
TITLE: PLC COMMUNICATION, SCHEMATIC DIAGRAM			
SCALE: NONE		DATE: 03-01-11	DWN. BY: GPN
DWG. No: 7146-5501-D		SHEET: 1 OF 1	CKD. BY: JMD
JOB: RUBY GENERATOR SWITCHGEAR			


NOTICE

THE DRAWINGS, INFORMATION AND SUBJECT MATTER HEREOF ARE THE CONFIDENTIAL, SOLE AND EXCLUSIVE PROPERTY OF CONTROLLED POWER, INC. AND ARE NOT TO BE COPIED, REPRODUCED OR USED IN ANY MANNER FOR ANY PURPOSE WHATSOEVER WITHOUT WRITTEN CONSENT OR DIRECTION.

ALASKA
ENERGY AUTHORITY

RURAL ENERGY GROUP
813 W. NORTHERN LIGHTS BLVD.
ANCHORAGE, ALASKA 99503
HTTP://WWW.AIDEA.ORG

2251
2252
2253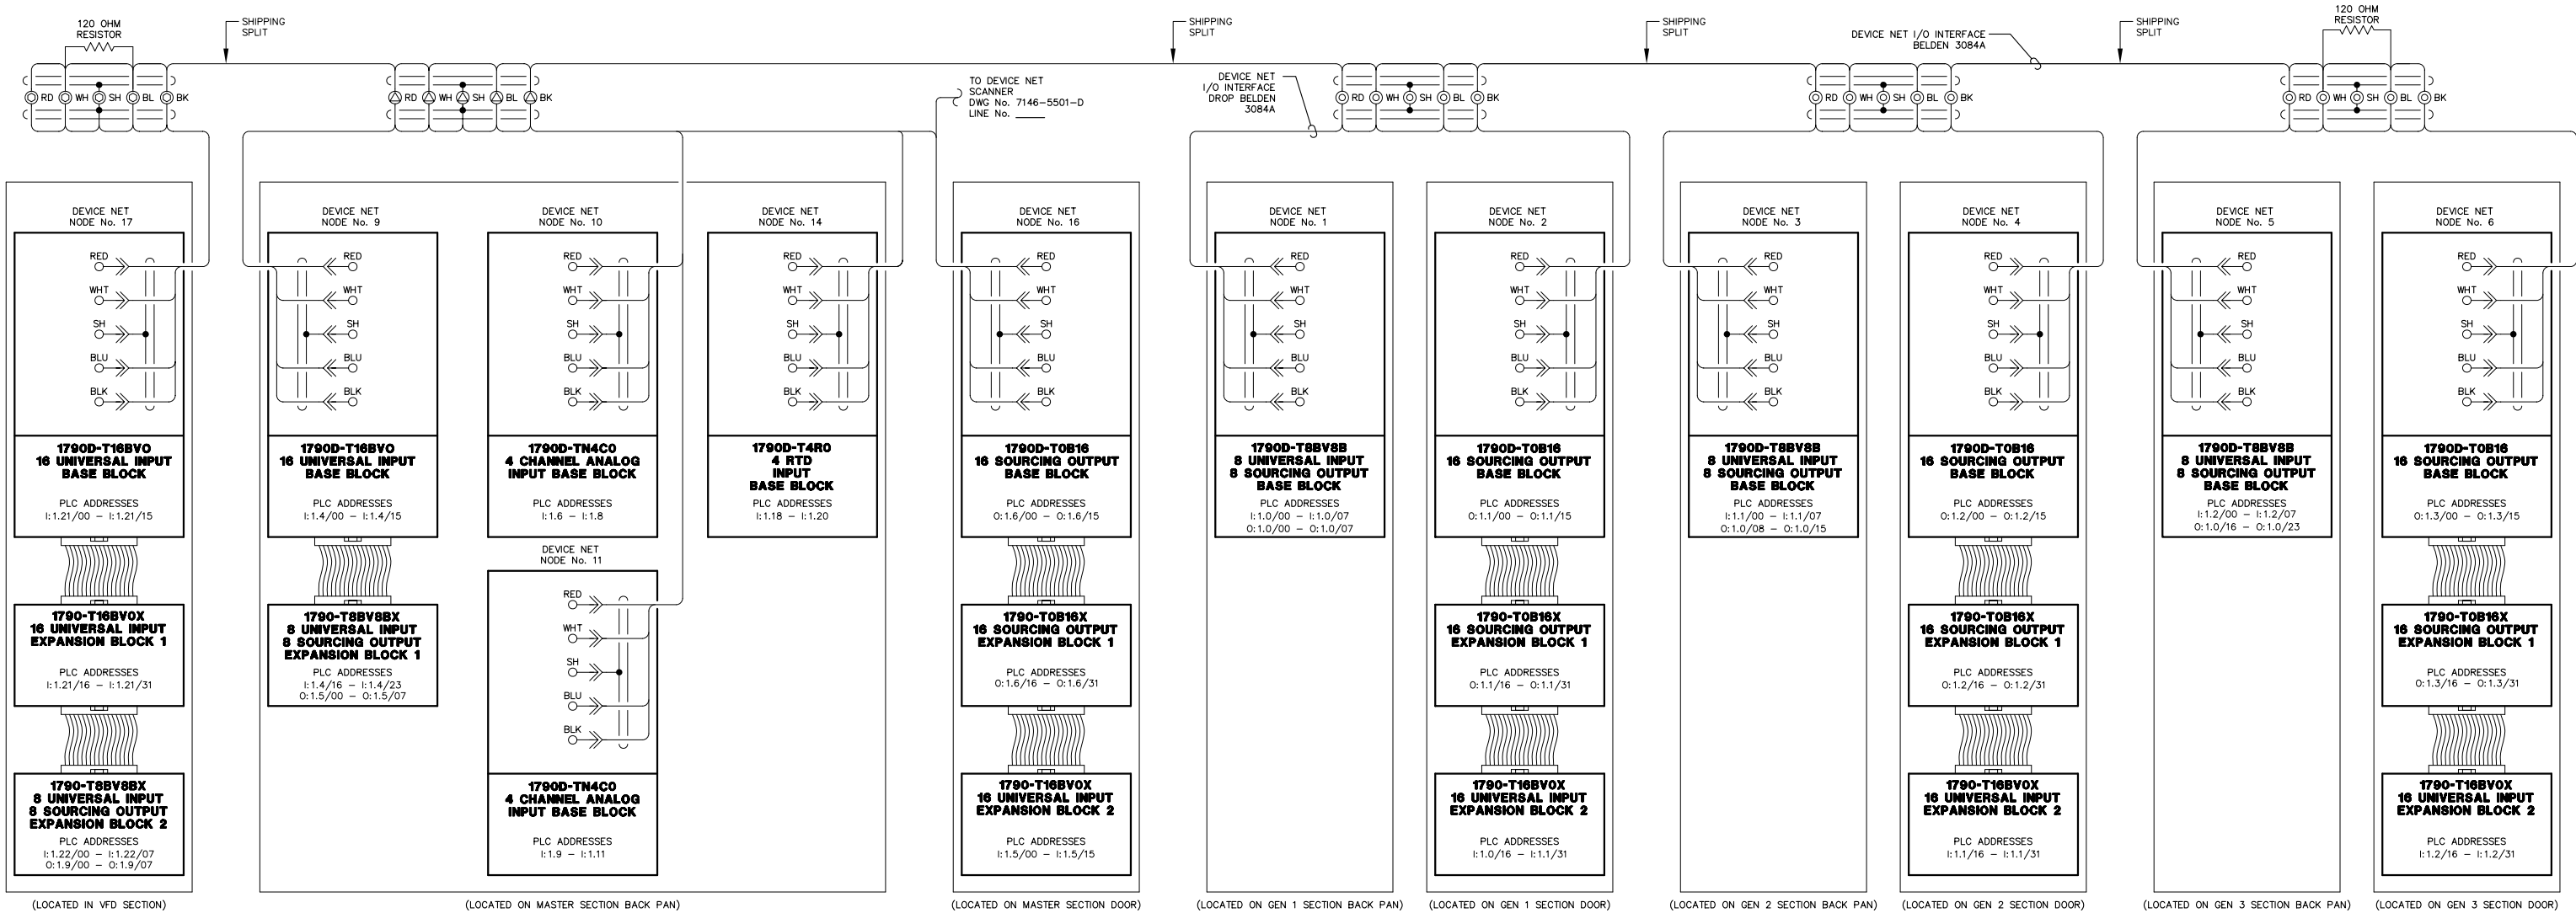
NOTE:
1. FOR GENERAL WIRING & CONSTRUCTION NOTES, SEE DRAWING No. 7146-3101-D.

A	05-04-11	SHOP AS BUILT	GPN
REV.	DATE	DESCRIPTION	BY
AEA PURCHASE ORDER No. REG-11-044			
CONTROLLED POWER JOB No. 7146			
TITLE: PLC COMMUNICATION, SCHEMATIC DIAGRAM			
SCALE: NONE		DATE: 03-01-11	DWN. BY: GPN
DWG. No: 7146-5502-D		SHEET: 1 OF 1	CKD. BY: JMD
JOB: RUBY GENERATOR SWITCHGEAR			

NOTICE


THE DRAWINGS, INFORMATION AND SUBJECT MATTER HEREOF ARE THE CONFIDENTIAL, SOLE AND EXCLUSIVE PROPERTY OF CONTROLLED POWER, INC. AND ARE NOT TO BE COPIED, REPRODUCED OR USED IN ANY MANNER FOR ANY PURPOSE WHATSOEVER WITHOUT WRITTEN CONSENT OR DIRECTION.

ALASKA

ENERGY AUTHORITY

RURAL ENERGY GROUP
813 W. NORTHERN LIGHTS BLVD.
ANCHORAGE, ALASKA 99503
HTTP://WWW.AIDEA.ORG

LINE No.
2301
2302
2303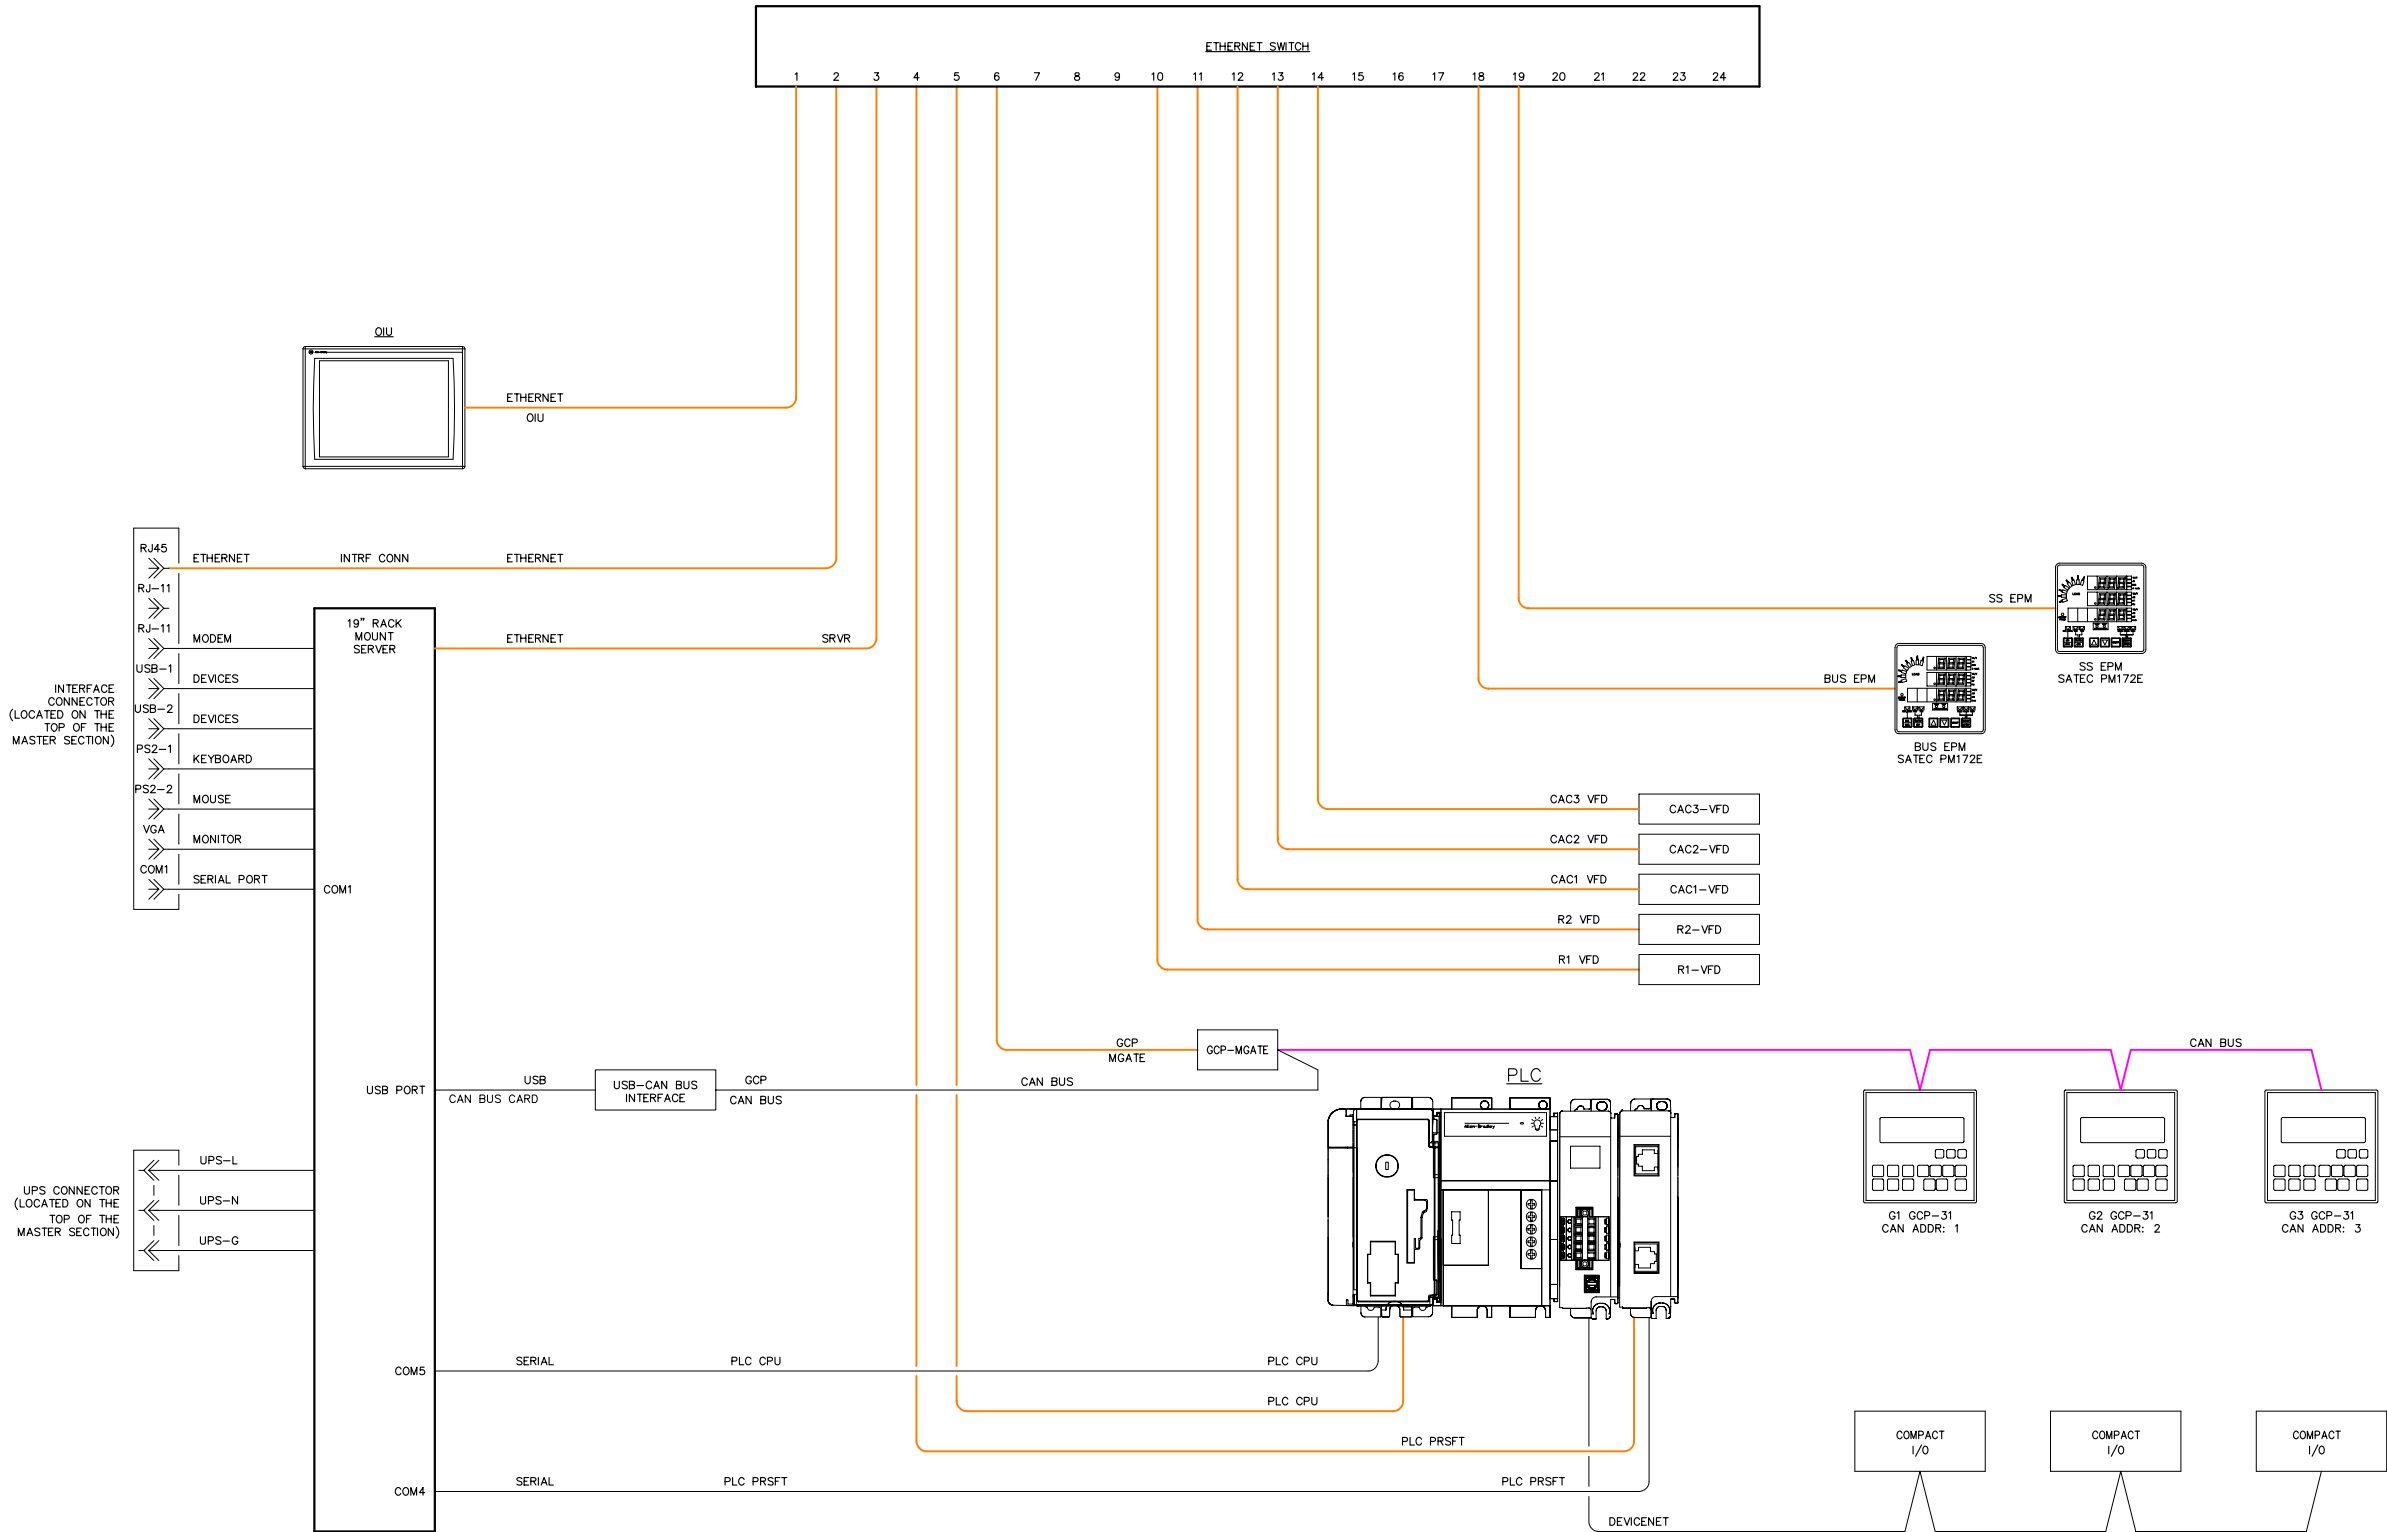
DEVICE	IP ADDRESS
PLC CPU	192.168.1.183
MNET	192.168.1.187
R1 VFD	192.168.1.171
R2 VFD	192.168.1.172
CAC1 VFD	192.168.1.174
CAC2 VFD	192.168.1.175
CAC3 VFD	192.168.1.176

DEVICE	IP ADDRESS
BUS EPM	192.168.1.190
SS EPM	192.168.1.191
SERVER	192.168.1.142
OIU	192.168.1.182
GCP MGATE	192.168.1.186

NOTE:
1. FOR GENERAL WIRING & CONSTRUCTION NOTES, SEE DRAWING No. 7146-3101-D.

A	05-04-11	SHOP AS BUILT	GPN
REV.	DATE	DESCRIPTION	BY
AEA PURCHASE ORDER No.		CONTROLLED POWER JOB No. 7146	
TITLE: COMMUNICATION NETWORK DIAGRAM			
SCALE: NONE		DATE: 03-01-11	DWN. BY: GPN
DWG. No: 7146-5601-D		SHEET: 1 OF 1	CKD. BY: JMD
JOB: RUBY GENERATOR SWITCHGEAR			

NOTICE
THE DRAWINGS, INFORMATION AND SUBJECT MATTER HEREOF ARE THE CONFIDENTIAL, SOLE AND EXCLUSIVE PROPERTY OF CONTROLLED POWER, INC. AND ARE NOT TO BE COPIED, REPRODUCED OR USED IN ANY MANNER FOR ANY PURPOSE WHATSOEVER WITHOUT WRITTEN CONSENT OR DIRECTION.



RURAL ENERGY GROUP
813 W. NORTHERN LIGHTS BLVD.
ANCHORAGE, ALASKA 99503
HTTP://WWW.AIDEA.ORG

LINE No.
2401

2402

2403


2446

2447

2448

2449

2450

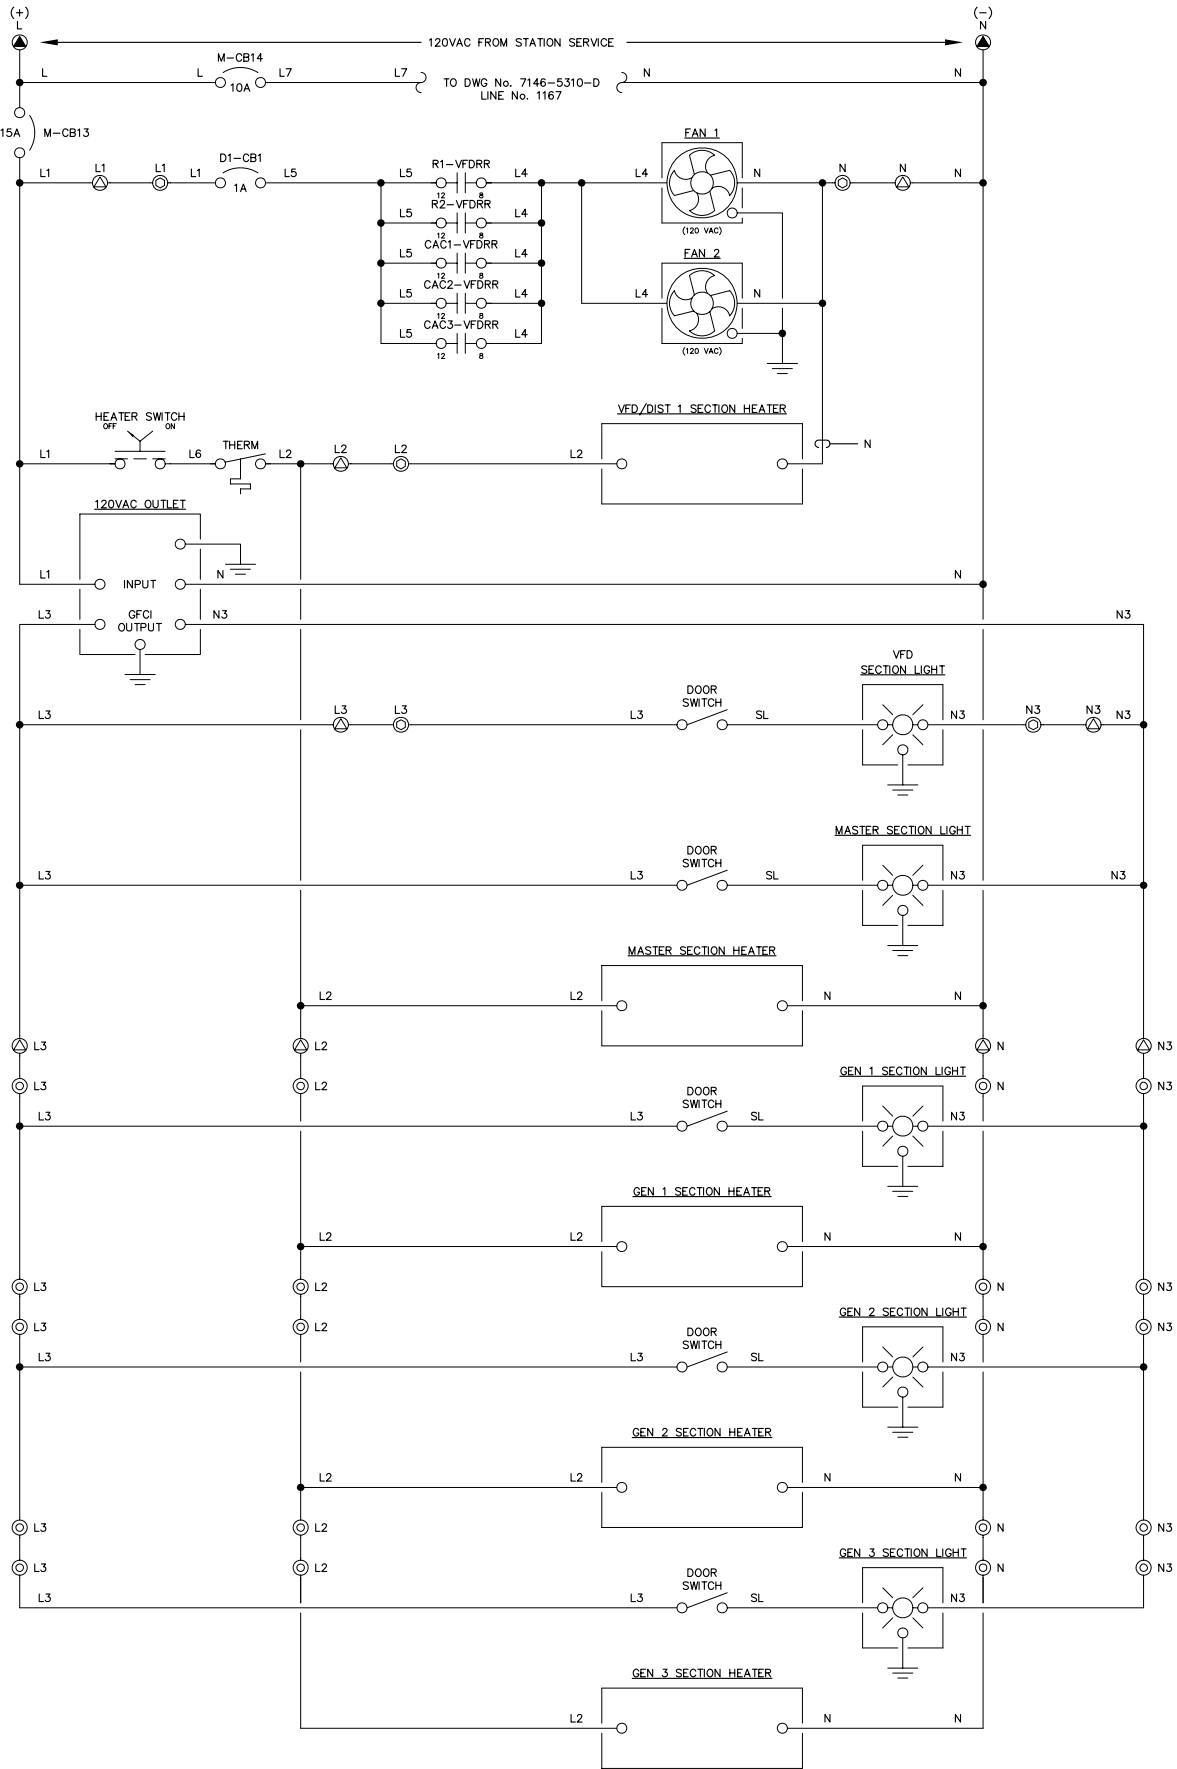


NOTE:
1. FOR GENERAL WIRING & CONSTRUCTION NOTES, SEE DRAWING No. 7146-3101-D.

A	05-04-11	SHOP AS BUILT	GPN
REV.	DATE	DESCRIPTION	BY
AEA PURCHASE ORDER No. REG-11-044		CONTROLLED POWER JOB No. 7146	
TITLE: HEATER, LIGHTING & FAN CONTROL, SCHEMATIC DIAGRAM			
SCALE: NONE		DATE: 03-01-11	DWN. BY: GPN
DWG. No: 7146-5701-D		SHEET: 1 OF 1	CKD. BY: JMD
JOB: RUBY GENERATOR SWITCHGEAR			

NOTICE
THE DRAWINGS, INFORMATION AND SUBJECT MATTER HEREOF ARE THE CONFIDENTIAL, SOLE AND EXCLUSIVE PROPERTY OF CONTROLLED POWER, INC. AND ARE NOT TO BE COPIED, REPRODUCED OR USED IN ANY MANNER FOR ANY PURPOSE WHATSOEVER WITHOUT WRITTEN CONSENT OR DIRECTION.




SYSTEM MODE SWITCH – SMS

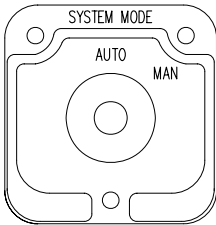

(ELECTROSWITCH 24201C)
KNURLED HANDLE
QTY 1

DECK	CONTACTS		POS.	
			AUTO	MAN
1	12	11	X	
		13		X
	16	15	X	
		17		X
	11	18	X	
		12		X
		14		X
	15	16	X	



BREAKER CONTROL SWITCH – 52CS

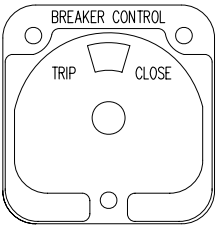

(ELECTROSWITCH 2438D)
PISTOL GRIP HANDLE
SPRING RETURN TO CENTER
QTY 1

DECK	CONTACTS		POS.	
			TRIP	CLOSE
1	11	18	X	
	16	17		X

GENERATOR LOCKOUT SWITCH – GLS

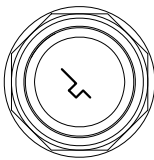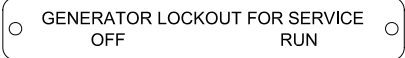


KEY OPERATED
2 POS MAINTAINED
QTY 3

POS		
	OFF	RUN
	X	
		X
	X	X



HEATER CONTROL SWITCH – HCS

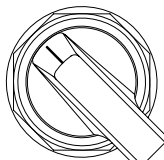


MAINTAINED
LOCATED ON MASTER
BACK PAN

POS		
	OFF	ON
	X	
		X
	X	X




VARIABLE FREQUENCY DRIVE SWITCH – VFDS

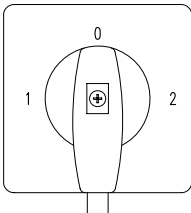

3 POS MAINTAINED

71322		44	34	1L1	1L2	1L3	2L1	2L2	2L3	53	63
		POSITION									
		43	33	1T1	1T2	1T3	2T1	2T2	2T3	54	64
SMD	1	MD		71300						ME	2


VARIABLE FREQUENCY DRIVE SWITCH – VFDS

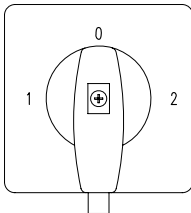

3 POS MAINTAINED

71322		44	34	1L1	1L2	1L3	2L1	2L2	2L3	53	63
		POSITION									
		43	33	1T1	1T2	1T3	2T1	2T2	2T3	54	64
SMD	1	MD		71300						ME	2


VARIABLE FREQUENCY DRIVE SWITCH – VFDS

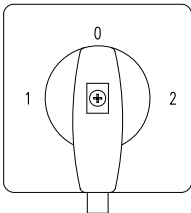

3 POS MAINTAINED

71322		44	34	1L1	1L2	1L3	2L1	2L2	2L3	53	63
		POSITION									
		43	33	1T1	1T2	1T3	2T1	2T2	2T3	54	64
SMD	1	MD		71300						ME	2


VARIABLE FREQUENCY DRIVE SWITCH – VFDS

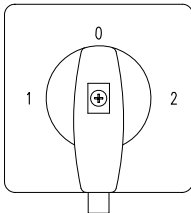

3 POS MAINTAINED

71322		44	34	1L1	1L2	1L3	2L1	2L2	2L3	53	63
		POSITION									
		43	33	1T1	1T2	1T3	2T1	2T2	2T3	54	64
SMD	1	MD		71300						ME	2

VARIABLE FREQUENCY DRIVE SWITCH – VFDS

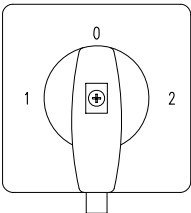

3 POS MAINTAINED

71322		44	34	1L1	1L2	1L3	2L1	2L2	2L3	53	63
		POSITION									
		43	33	1T1	1T2	1T3	2T1	2T2	2T3	54	64
SMD	1	MD		71300						ME	2

NOTE:


1. FOR GENERAL WIRING & CONSTRUCTION NOTES, SEE DRAWING No. 7146-3101-D.


A	05-04-11	SHOP AS BUILT	GPN
REV.	DATE	DESCRIPTION	BY
AEA PURCHASE ORDER No. REG-11-044		CONTROLLED POWER JOB No. 7146	
TITLE: CONTROL SWITCH TARGET DIAGRAM			
SCALE: NONE		DATE: 03-01-11	DWN. BY: GPN
DWG. No: 7146-6101-D		SHEET: 1 OF 1	CKD. BY: JMD
JOB: RUBY GENERATOR SWITCHGEAR			

NOTICE
THE DRAWINGS, INFORMATION AND SUBJECT MATTER HEREOF ARE THE CONFIDENTIAL, SOLE AND EXCLUSIVE PROPERTY OF CONTROLLED POWER, INC. AND ARE NOT TO BE COPIED, REPRODUCED OR USED IN ANY MANNER FOR ANY PURPOSE WHATSOEVER WITHOUT WRITTEN CONSENT OR DIRECTION.




RURAL ENERGY GROUP
813 W. NORTHERN LIGHTS BLVD.
ANCHORAGE, ALASKA 99503
HTTP://WWW.AIDEA.ORG

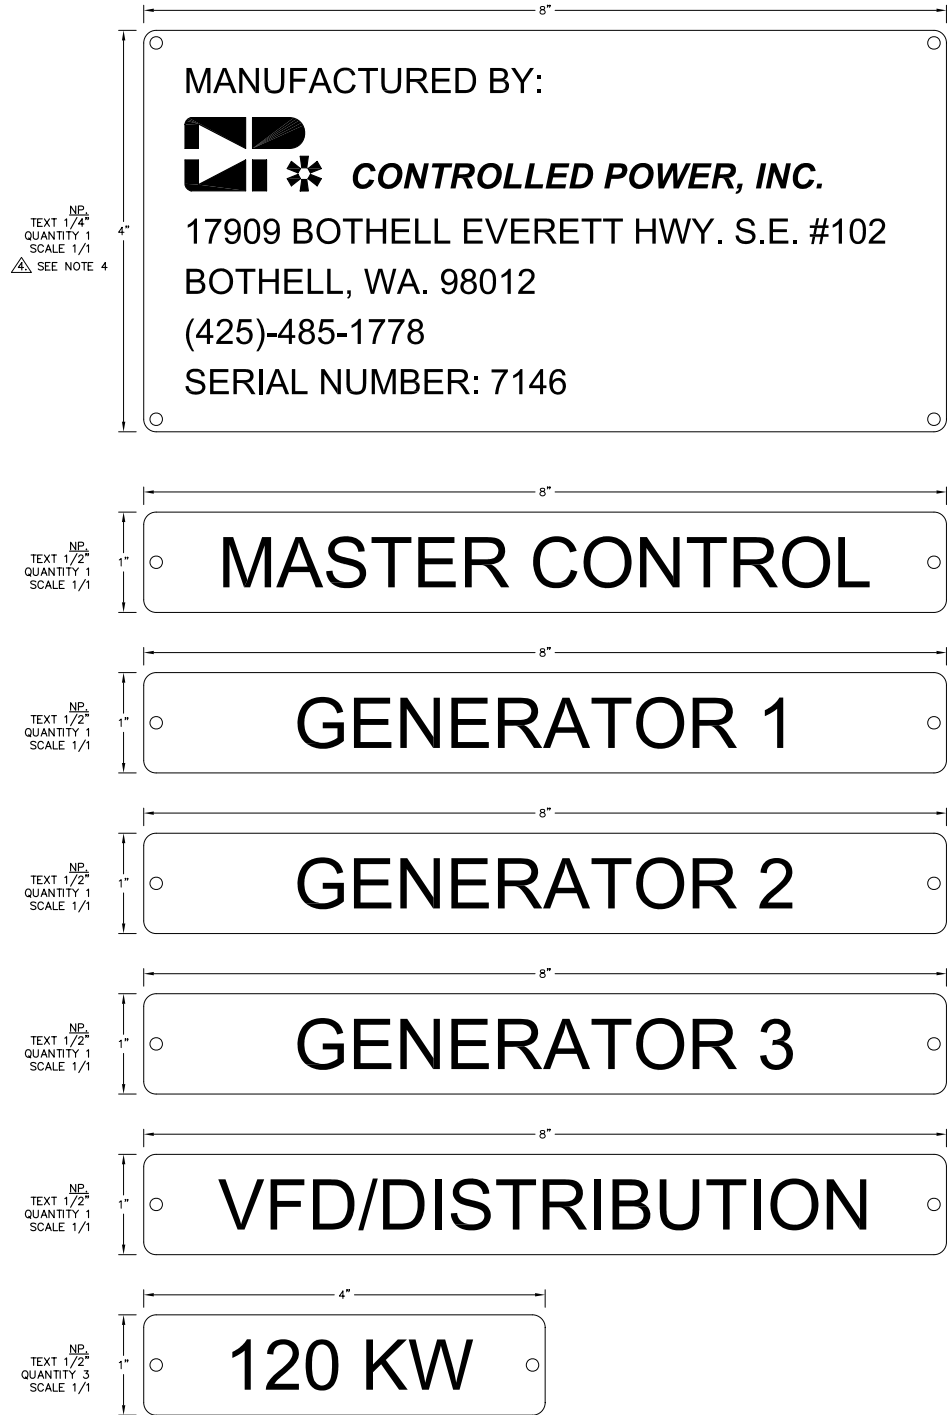


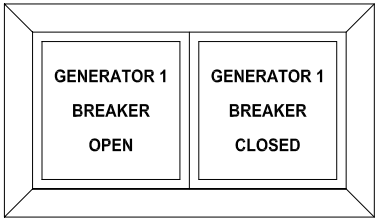


GEN 1 BREAKER ANNUNCIATOR
QTY 1

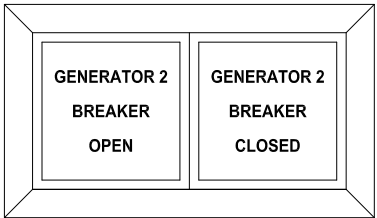


GEN 2 BREAKER ANNUNCIATOR
QTY 1

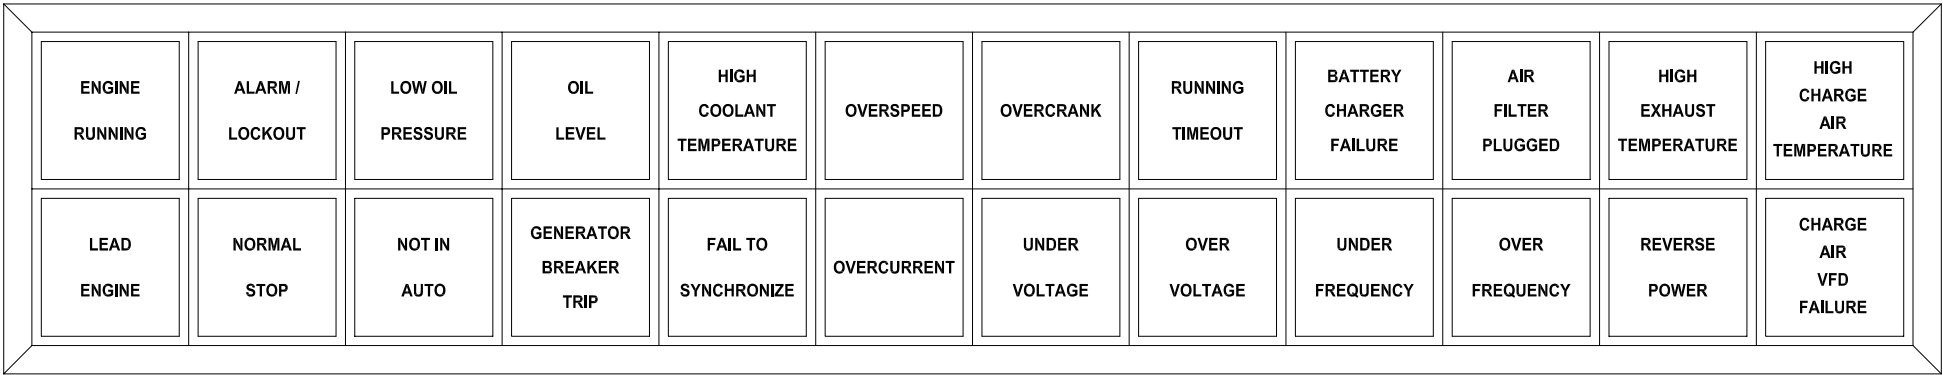


GENERATOR ANNUNCIATOR
QTY 3

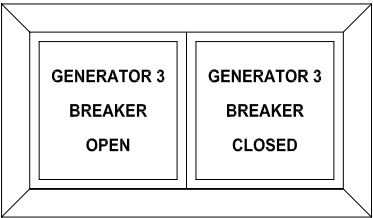


GEN 3 BREAKER ANNUNCIATOR
QTY 1

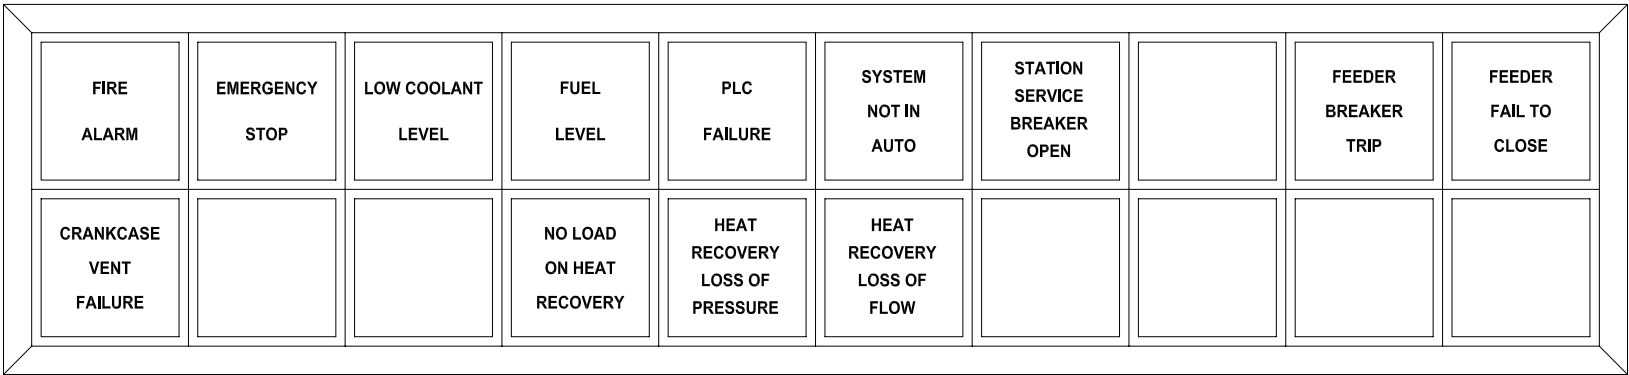

MASTER ANNUNCIATOR
QTY 1

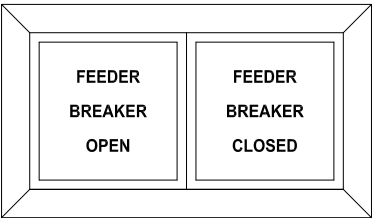


FEEDER BREAKER ANNUNCIATOR
QTY 1

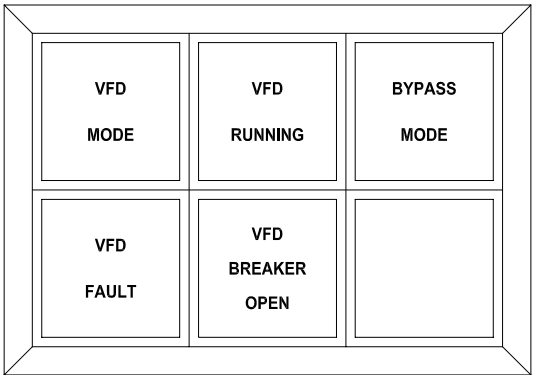

VFD ANNUNCIATOR
QTY 5

REV.	DATE	DESCRIPTION	BY
AEA PURCHASE ORDER No. REG-11-044		CONTROLLED POWER JOB No. 7146	
TITLE: ANNUNCIATOR WINDOWS, FABRICATION DIAGRAM			
SCALE: NONE		DATE: 04-13-11	DWN. BY: GPN
DWG. No: 7146-6202-D		SHEET: 1 OF 1	CKD. BY: JMD
JOB: RUBY GENERATOR SWITCHGEAR			
		RURAL ENERGY GROUP 813 W. NORTHERN LIGHTS BLVD. ANCHORAGE, ALASKA 99503 HTTP: //WWW.AIDEA.ORG	

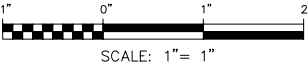

NOTICE
THE DRAWINGS, INFORMATION AND SUBJECT MATTER HEREOF
ARE THE CONFIDENTIAL, SOLE AND EXCLUSIVE PROPERTY
OF CONTROLLED POWER, INC., AND ARE NOT TO BE COPIED,
REPRODUCED OR USED IN ANY MANNER FOR ANY PURPOSE
WHATSOEVER WITHOUT WRITTEN CONSENT OR DIRECTION.

