

STATE OF ALASKA

Department of Health
Division of Finance and Management Services



Sitka Janitorial Services

ITB 2025-1600-0182/1624-084

Amendment No. Two

December 9, 2024

This amendment is being issued to answer an inquiry and correct two administrative errors.

There is no change to the deadline for receipt of bids.

Important Note to Offerors: You must sign and return this page of the amendment document with your proposal. Failure to do so may result in the rejection of your proposal. Only the ITB terms and conditions referenced in this amendment are changed. All other terms and conditions of the ITB remain the same.

Anneliese Zlitni, Procurement Officer

Email: anneliese.zlitni@alaska.gov

COMPANY SUBMITTING PROPOSAL

AUTHORIZED SIGNATURE

DATE

The following question is here presented and answered:

Question: Could you please provide information regarding the square footage of cleanable space and/or floor plans for the facilities covered under this bid?

Answer: Please see floor plan on the following page.

The following administrative errors in ITB Amendment No. One are here corrected:

1. On cover page and file title in place of “ITB 2024-1600-0345/1624-084,”

substitute the following number:


“ITB 2025-1600-0182/1624-084.”

2. On cover page in place of, “**Important Note to Offerors:** You must sign and return this page of the amendment document with your proposal. Failure to do so may result in the rejection of your proposal. Only the RFP terms and conditions referenced in this amendment are being changed. All other terms and conditions of the RFP remain the same[,]”

substitute the following:

“**Important Note to Offerors:** You must sign and return this page of the amendment document with your proposal. Failure to do so may result in the rejection of your proposal. Only the ITB terms and conditions referenced in this amendment are being changed. All other terms and conditions of the ITB remain the same.”

End of Amendment

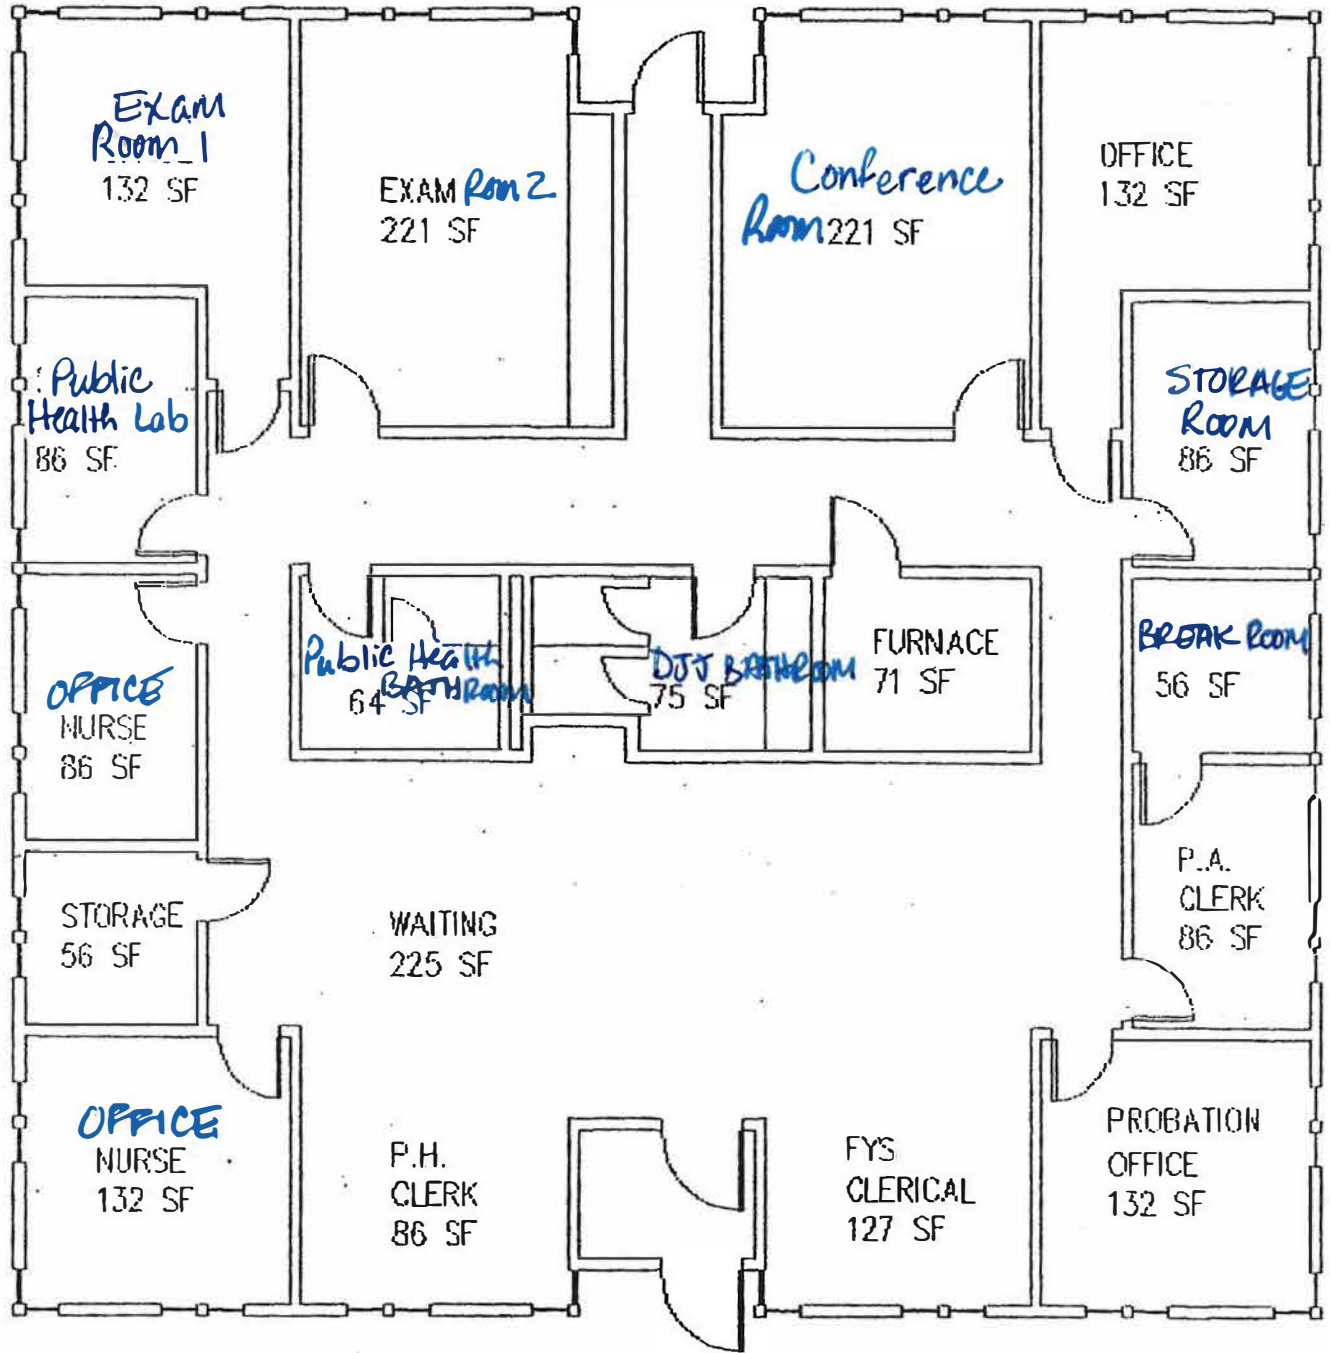

EXISTING FLOOR PLAN

Scale: 1/8" = 1'-0"



EXISTING FLOOR PLAN

SITKA HEALTH CENTER

File: 0001/01/01/01/01

SCALE: 1/8" = 1'-0"
DATE: 6/26/90

