

Alaska Department of Military and Veterans Affairs  
Division of Administrative Services

Invitation for Quotes # 09-005-25

Repair Parachute Hoist Switches

Addendum 1

Date of Issue: April 16, 2025

Addendum 1 is being issued to answer questions from interested offerors. This Addendum 1 is hereby made part of the IFQ and is a total of 7 pages.

Issued by:

Jannah Cayetano

Procurement Officer

Email: [MvaDasProcurement@alaska.gov](mailto:MvaDasProcurement@alaska.gov)

Phone: 907-428-7222

**Questions submitted by potential offerors and answers from the state:**

**Question 1:** Will there be a pre-proposal site visit scheduled for this project?

**Answer:** A site visit is scheduled on Thursday, April 17 @ 12:30 p.m. Attendees for the site required to contact Jannah Cayetano via email at [MvaDasProcurement@alaska.gov](mailto:MvaDasProcurement@alaska.gov) or at 907-428-7222 one (1) day prior to the scheduled site visit so arrangements may be made for a base pass.

---

**Question 2:** Are there any as-builts or specifications on the existing winch system?

**Answer:** Yes, these attachments are incorporated as part of this Addendum. Please refer to pages 3–7 for the relevant information



---

**Question 3:** The RFP says that Davis-Bacon Wages are not required for this project. Can you confirm this is accurate?


**Answer:** If the quote exceeds the \$25,000.00 threshold, Davis-Bacon wages will be required for this project.

---




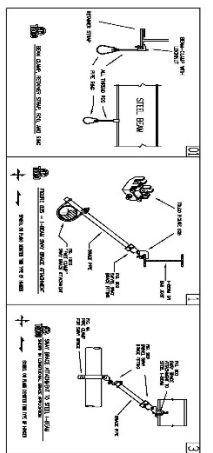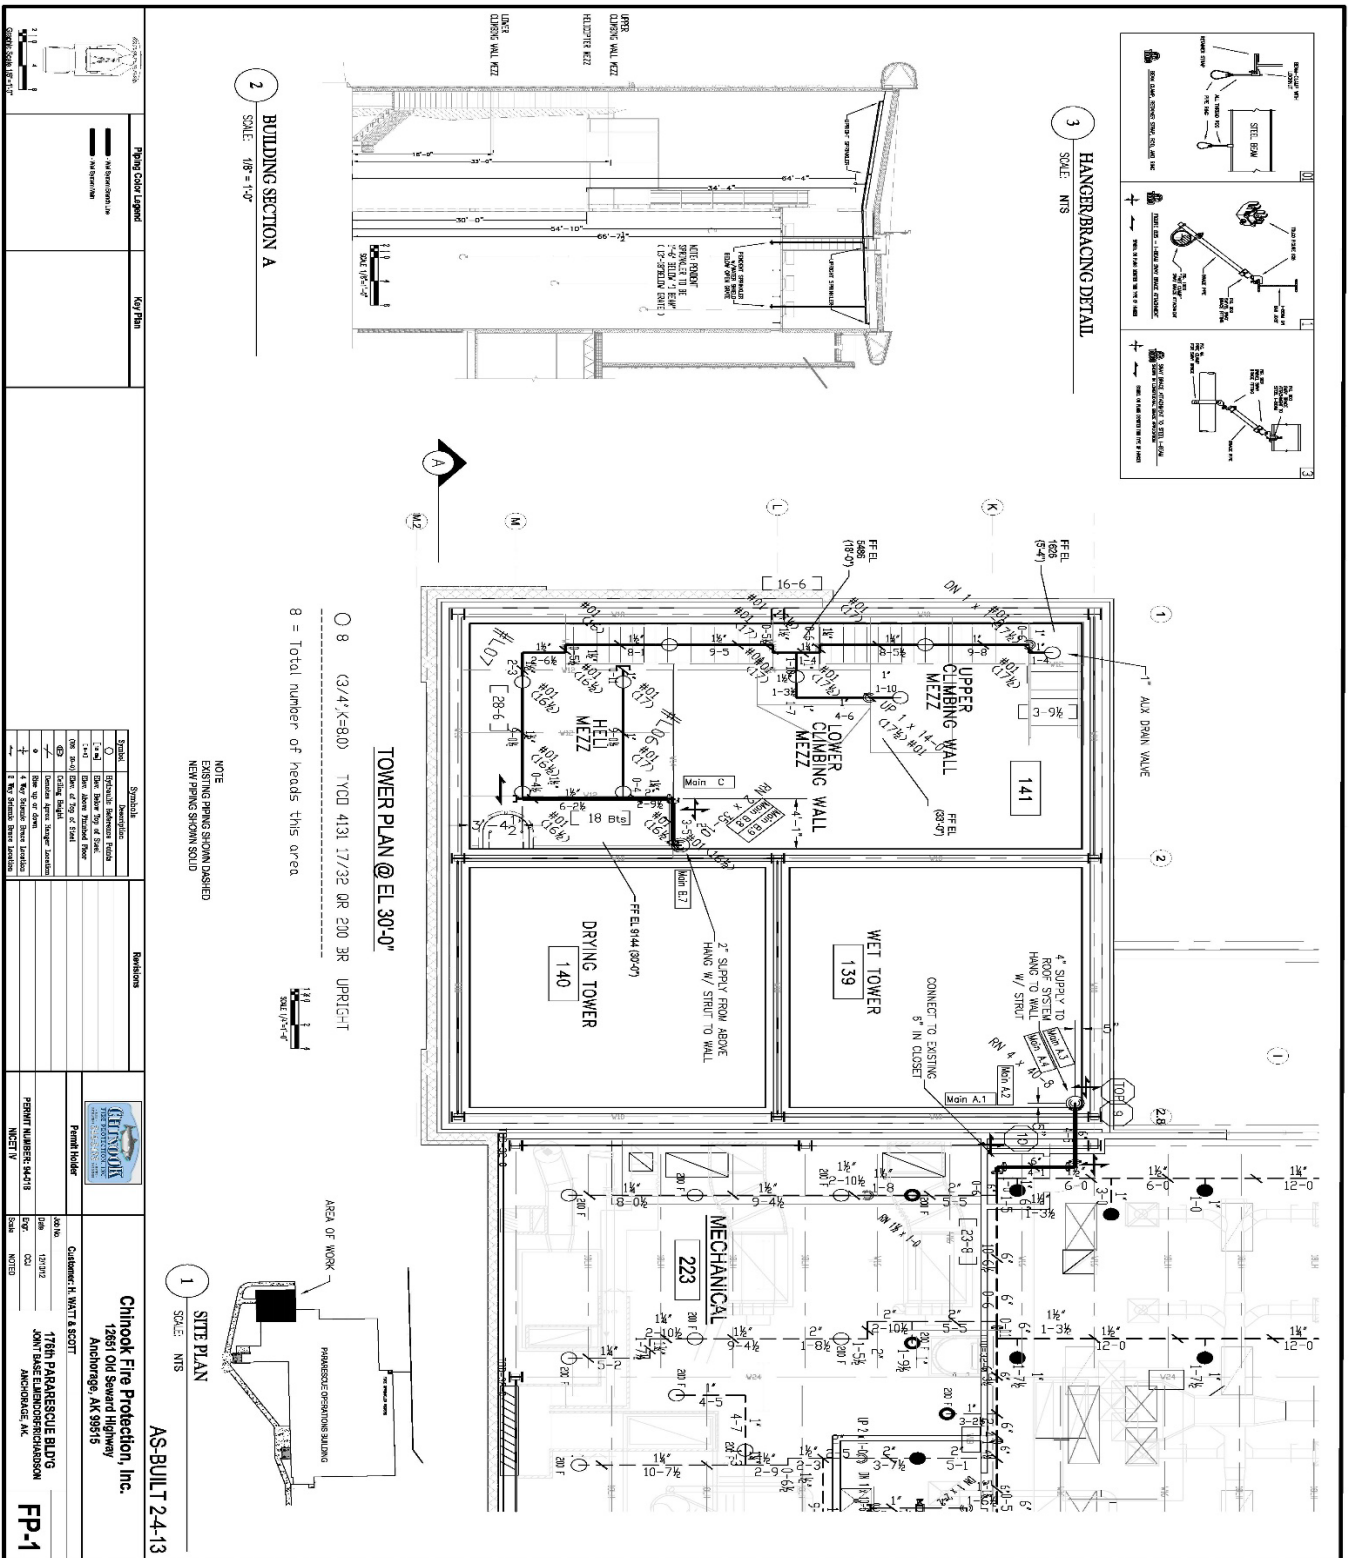

3 HANGER/BRACING DETAIL  
SCALE: NIS

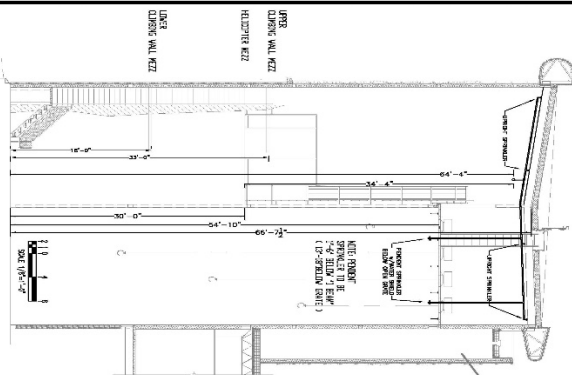


2 BUILDING SECTION A  
SCALE: 1/8" = 1'-0"

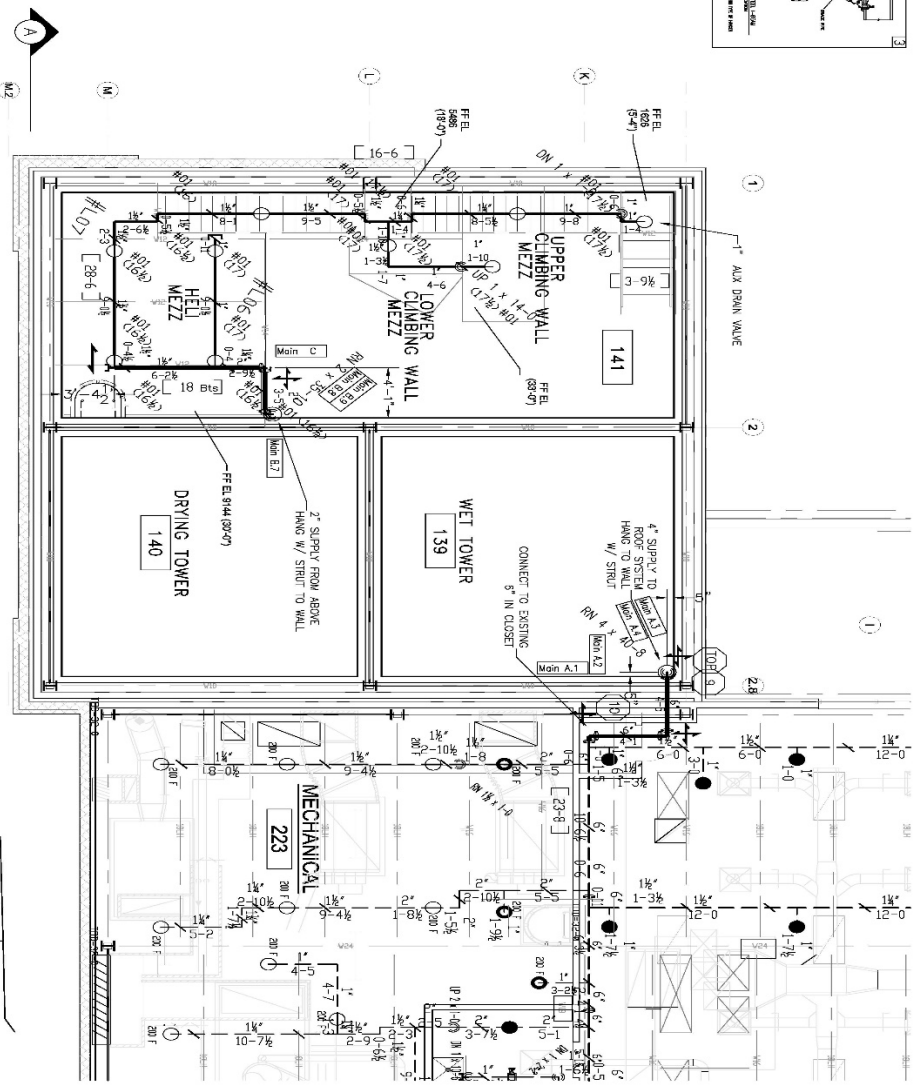

TOWER PLAN @ EL. 30'-0"


8 (3/4" X 8-0) TYCD 4131 17/32 OR 200 3R UPRIGHT  
8 = Total number of heads this area

NOTE  
EXISTING PIPING SHOWN DASHED  
NEW PIPING SHOWN SOLID

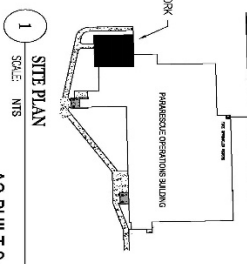

1 SITE PLAN  
SCALE: NIS

Legend	Key Plan	Specifications	Revisions	Permit Holder	Customer: H. WATT & SCOTT																										
<p>1/4" = 1'-0" OVERALL SCALE 1/8" = 1'-0"</p> <p> </p>		<table border="1"> <thead> <tr> <th>Symbol</th> <th>Description</th> </tr> </thead> <tbody> <tr> <td>○</td> <td>Structural Reinforcing Rods</td> </tr> <tr> <td>○</td> <td>Reinforcing Bars</td> </tr> <tr> <td>○</td> <td>Reinforcing Bars @ 2' Spacing</td> </tr> <tr> <td>○</td> <td>Reinforcing Bars @ 10' Spacing</td> </tr> <tr> <td>○</td> <td>Existing Mezzanines</td> </tr> <tr> <td>○</td> <td>Existing Stairs</td> </tr> <tr> <td>○</td> <td>Existing Stairs</td> </tr> <tr> <td>○</td> <td>Existing Stairs</td> </tr> <tr> <td>○</td> <td>Existing Stairs</td> </tr> <tr> <td>○</td> <td>Existing Stairs</td> </tr> </tbody> </table>	Symbol	Description	○	Structural Reinforcing Rods	○	Reinforcing Bars	○	Reinforcing Bars @ 2' Spacing	○	Reinforcing Bars @ 10' Spacing	○	Existing Mezzanines	○	Existing Stairs	○	Existing Stairs	○	Existing Stairs	○	Existing Stairs	○	Existing Stairs	<table border="1"> <thead> <tr> <th>Revision</th> <th>Description</th> </tr> </thead> <tbody> <tr> <td>1</td> <td>As-Built</td> </tr> </tbody> </table>	Revision	Description	1	As-Built		<p>17th PARASCQUE BLDG 12651 Old Seward Highway ANCHORAGE, AK</p>
Symbol	Description																														
○	Structural Reinforcing Rods																														
○	Reinforcing Bars																														
○	Reinforcing Bars @ 2' Spacing																														
○	Reinforcing Bars @ 10' Spacing																														
○	Existing Mezzanines																														
○	Existing Stairs																														
○	Existing Stairs																														
Revision	Description																														
1	As-Built																														
<p>AS-BUILT 2-4-13</p>																															
<p>FP-1</p>																															

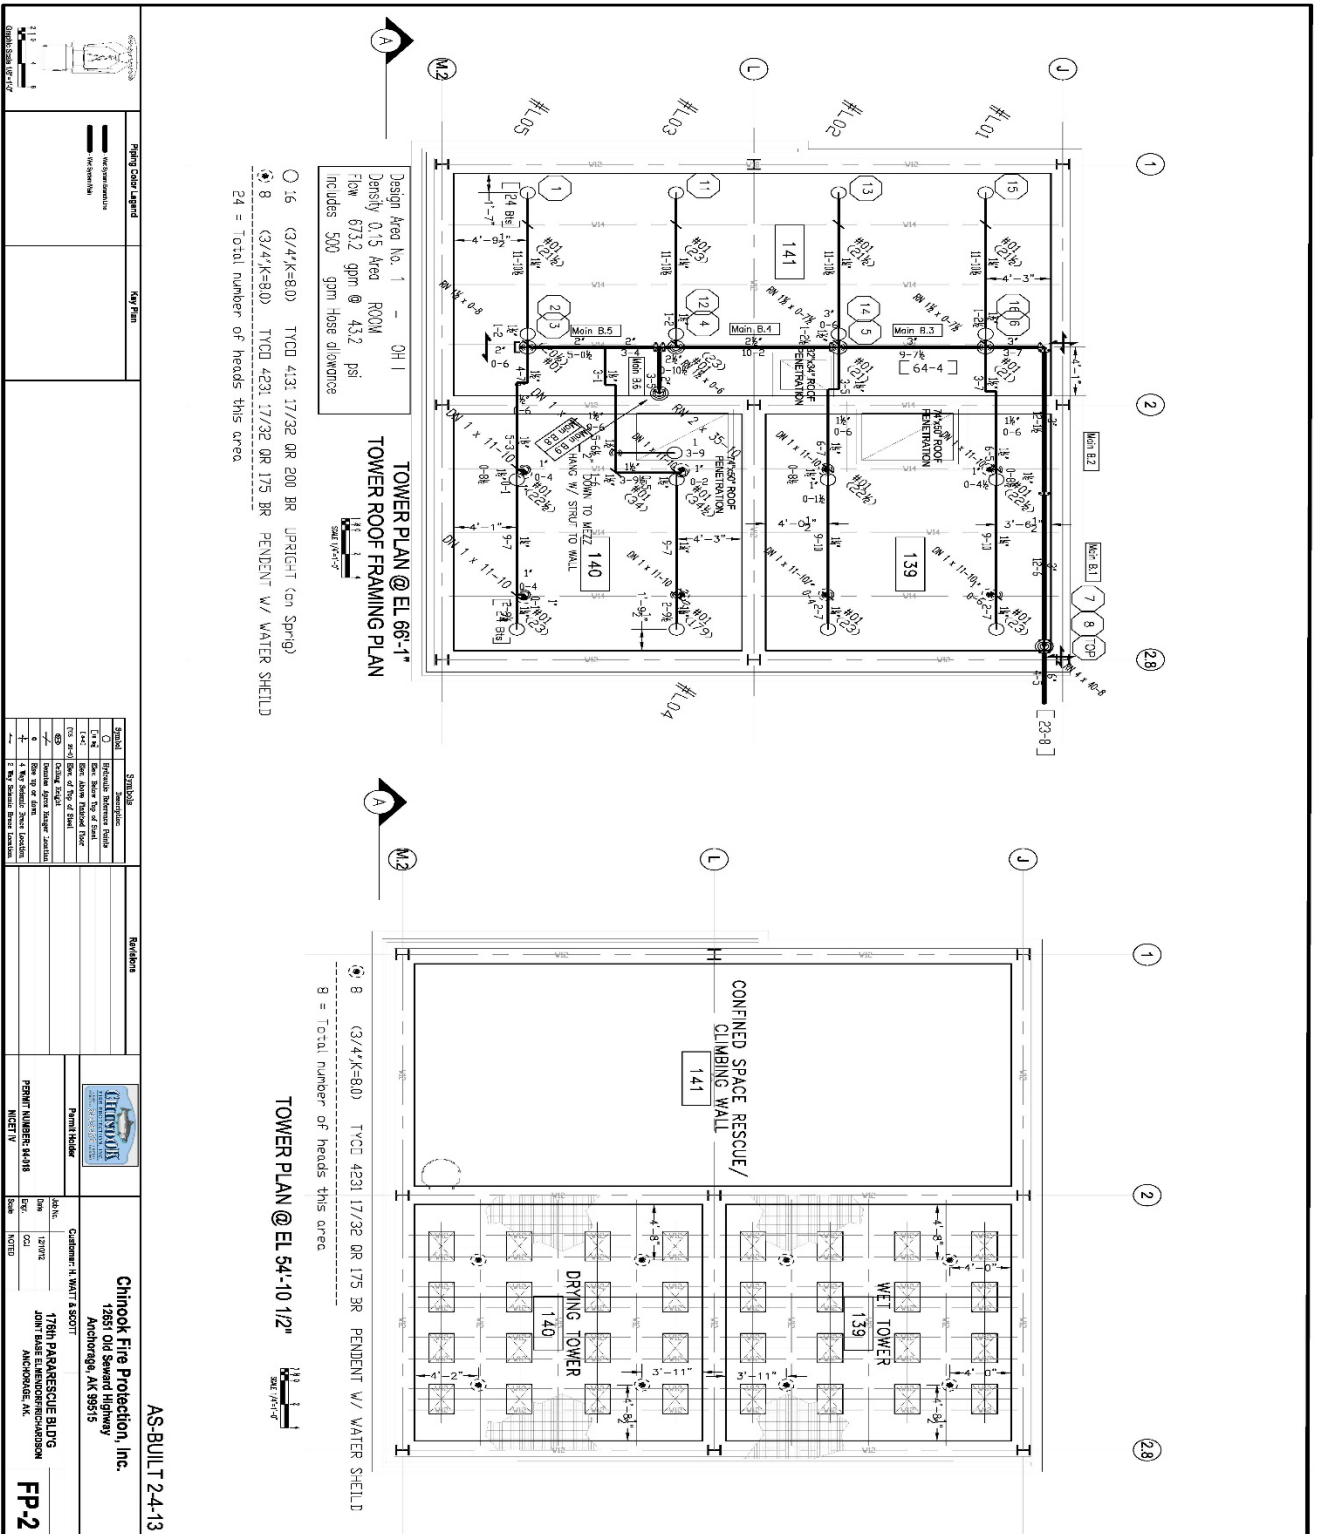





End of Addendum 1