
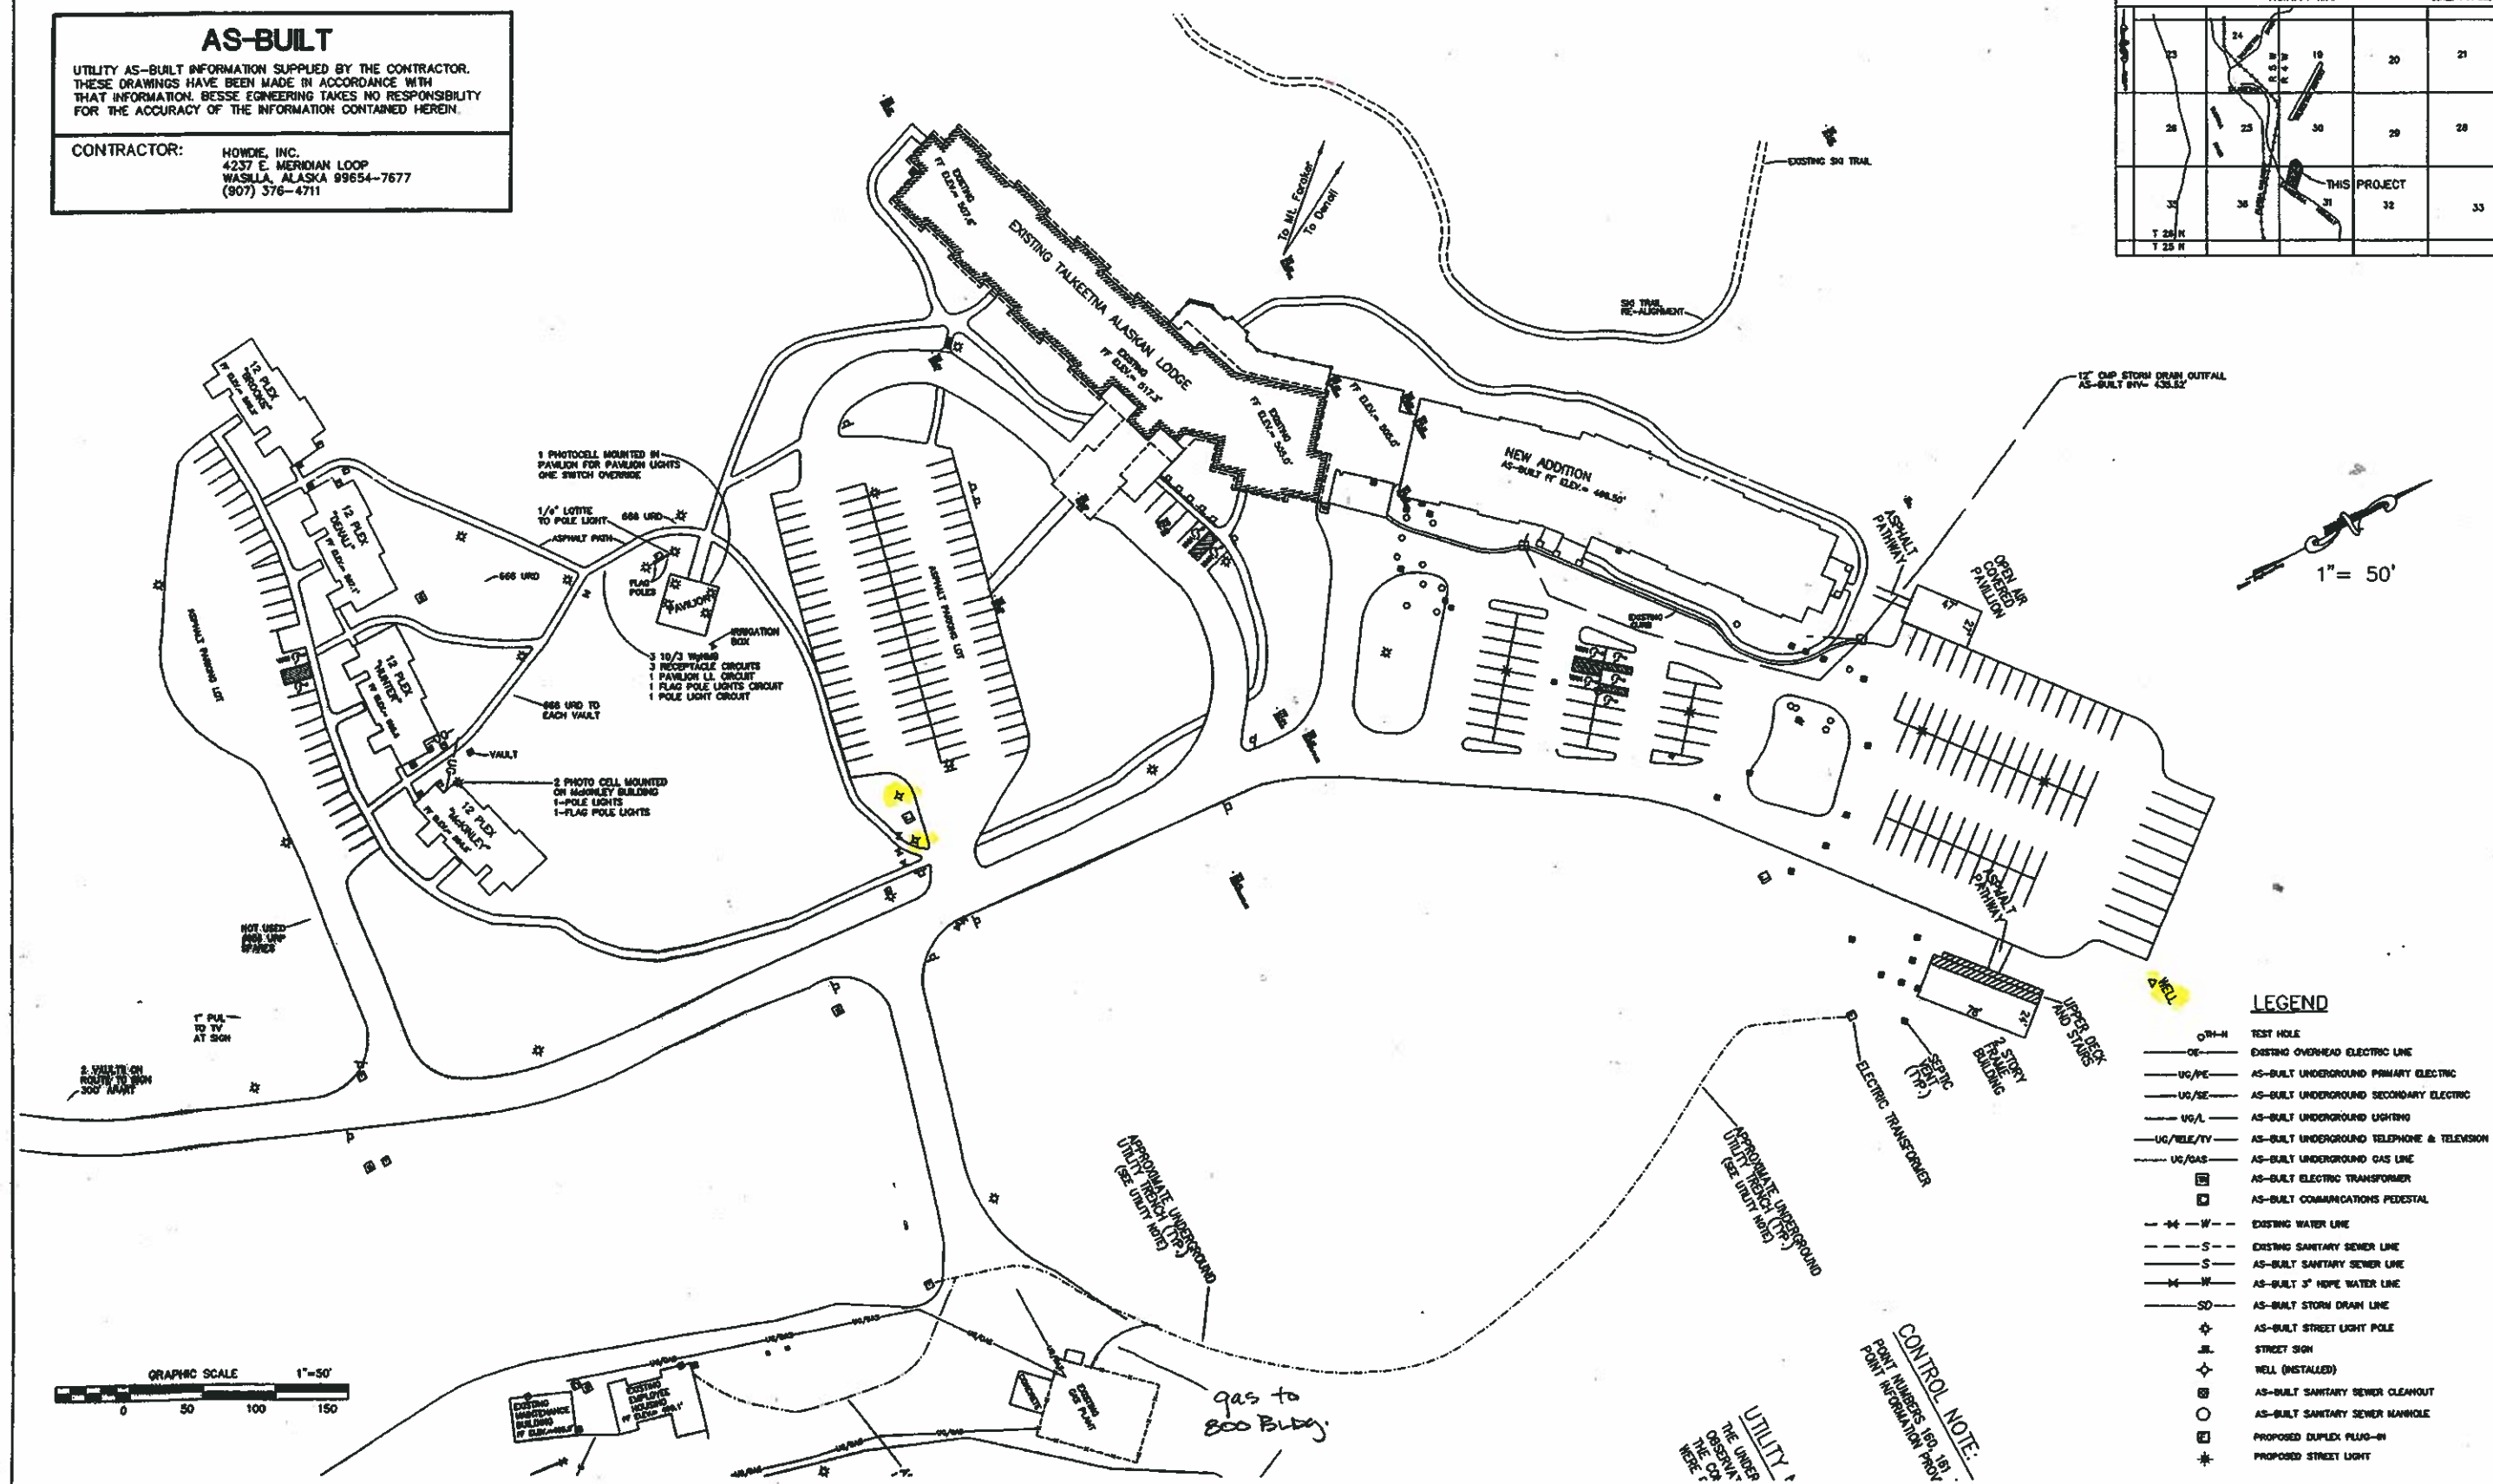


UTILITY AS-BUILT INFORMATION SUPPLIED BY THE CONTRACTOR.
THESE DRAWINGS HAVE BEEN MADE IN ACCORDANCE WITH
THAT INFORMATION. BESSE ENGINEERING TAKES NO RESPONSIBILITY
FOR THE ACCURACY OF THE INFORMATION CONTAINED HEREIN.

CONTRACTOR: HOWDIE, INC.
4237 E. MERIDIAN LOOP
WASILLA, ALASKA 99654-7677
(907) 376-4711

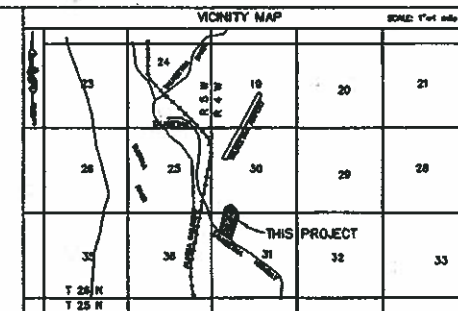

FIELD BOOKS	TBM	LOCATION	ELEV.	DATA	DATE	REV	DESCRIPTION	BY
DESIGN 890-12, 899-20	TALKEETNA	SPIKE IN TREE @ STA 646.5, 30.57'	476.37	N/A	R/LD	1	REMOVED CURBS, SIDEWALK, FIRE LANE GRADES, STRUCTURE, SWALE, HANDICAP	R/LD
	CLEAR CROWN	SPIKE IN TREE @ STA 1044.0, 31.57'	502.95	N/A	R/LD	2	PARKING SPACES, ADDED STREET LIGHTS, PLUMB-SIS, COMPACTOR SLAB	R/LD
ITAMUK	CHULITNA	SPIKE IN TREE @ STA 1744.0, 32.17'	526.75	N/A	R/LD	3	REMOVED SIGNAGE, ADDED DUPLEX PLUMB-SIS	R/LD
				N/A	R/LD	4	AS-BUILT AS PER CONTRACTOR'S RESUBMITTALS	R/LD
				N/A	R/LD	5	ADDED PAVEMENT, ASPHALT TRAILS & PARKING LOTS, LIGHTS, FLAG POLES	R/LD
				N/A	R/LD	6	AS-BUILT AS PER CONTRACTOR'S RESUBMITTALS	R/LD
ASBUILT CONTRACTOR INSPECTOR	BEOCHIARK D 100	S.S. MONUMENT 1.8 MILES SOUTH OF TALKEETNA, HWY OF THE JURISTION OF THE TALKEETNA ROAD AND THE F.A.A. BLIND TOWER ACCESS ROAD	470.48	N/A	R/LD			R/LD
CONSTRUCTION RECORD	VERTICAL DATUM IS U.S.C.G., 1988 NAVD.	PLAN CHECK	REVISIONS	OWNER	ENGINEER	SCALE: 1" = 50'	DATE: 9/06/02 CONTROLLER INT: 2" DWG: TLDDXEXP.DWG	SHEET C