



Issue Date: August 5, 2025

ATTN: Vendors

**RE: Project Name:** CC - 57226 Barracks Remodel  
**Project Number:** 02A7823017  
**Project Location(s):** Camp Carroll, Joint Base Elmendorf-Richardson, Alaska

**Mandatory Return Addendum # One (1)**

This addendum forms a part of the contract documents and modifies the original drawings and/or specifications for the subject work. In case of conflicts between this addendum and previously issued documents, this addendum shall take precedence. This addendum WILL be submitted with the contractors bid package.

The following administrative changes have been made to this ITB:

1. This addendum is being issued to correct incorrect labeling for the following documents:
  - EEO-1 Certification (25A-304, pg. 31 of the ITB) – VETERNAS was corrected to VETERANS
  - CONTACT REPORT (25A-321A, pg. 32 of the ITB) – VETERNAS was corrected to VETERANS; signature block at bottom of page was corrected from *DOT&PF Reviewer* to *DMVA Reviewer*
  - PRIME CONTRACTOR'S WRITTEN DBE COMMITMENT (25A-326, pg. 34 of the ITB) – DOT&PF logo updated to SOA logo
  - SUMMARY OF GOOD FAITH EFFORT DOCUMENTATION (25A-332A, pg. 35 of the ITB) – DOT&PF logo updated to SOA logo
  - BUY AMERICAN REQUEST FOR TYPE 3 WAIVER (25D-153, pg. 37 of the ITB) – DOT&PF logo updated to SOA logo; FAA references were removed
  - Buy American Percentage (25D-155, pg. 39 of the ITB) – FAA references were removed
  - Buy American Preferences – Final Assembly Questionnaire (25D-156, pg. 40 of the ITB) – FAA references were removed and updated to reflect DMVA
  - CERTIFICATION OF OFFEROR/BIDDER REGARDING TAX DELINQUENCY AND FELONY CONVICTIONS (25D-159, pg. 41 of the ITB) – DOT&PF logo updated to SOA logo; FAA references were removed and updated to reflect DMVA
  - BUY AMERICAN CERTIFICATE (25D-61, pg. 48 of the ITB) – FAA references were removed and updated to reflect DMVA
  - CERTIFICATE OF BUY AMERICAN COMPLIANCE FOR TOTAL FACILITY (25D-151, pg. 51 and 52 of the ITB) - FAA references were removed and updated to reflect DMVA
  - Certificate of Buy American Compliance for Manufactured Products (25D-152, pg. 53 and 54 of the ITB) - FAA references were removed and updated to reflect DMVA
  - DOCUMENT 00700 (pg. 66 of the ITB) – Header updated to reflect Department of Military and Veterans Affairs
  - DEPARTMENT (pg. 72 of the ITB) – Section updated to reflect Department of Military and Veterans Affairs



2. This addendum is being issued to reschedule the walkthrough date from Monday August 18, 2025 to Tuesday August 19, 2025 at 10:00am Alaska Time.

Questions and Answers:

1. Can any available as-builts be provided for this project in both PDF & CAD?  
A. We do not have CAD as-builts available. Please see attached .pdf as-builts.
2. Can you tell me if there will be a need for new furnishings for these barracks remodel projects? If so, will that be part of this ITB or will it be procured under a separate contract?  
A. No, contractor shall remove, store and reinstall existing furniture once the project has been completed.
3. This is a good time to mention that these two ITBs appear to be missing the Disadvantaged Business Enterprise form 25A-325C.  
A. This has been noted. As stated on page 21 of the ITB, Preferences WILL NOT be used in this solicitation as it is one hundred percent (100%) federally funded and thus the form will not be provided as it is not applicable under this solicitation.
4. How do we register for the walkthrough as it is on base? What is the procedure?  
A. Interested bidders shall provide the project manager with the first and last name of the individual(s) attending the pre-bid walkthrough no later than 48 hours before the walkthrough. Bidders will be required to pick up their passes at the FT Rich Visitor Center on August 19, 2025. The Visitor Center is open between 9:00am and 4:30pm.  
(please note: each company interested in the walkthrough shall be limited to 3 participants due to the number of passes allowed to be issued at any given time)

Please contact me if you have any questions.

Sincerely,

Gavin M. Fairbanks  
Building Management Specialist  
(907) 428-7187

Name of Company: \_\_\_\_\_

Signature: \_\_\_\_\_

Date: \_\_\_\_\_



STATE OF ALASKA  
DEPARTMENT OF MILITARY AND VETERANS AFFAIRS

**EEO-1 CERTIFICATION**  
Federal-Aid Contracts

CC - 57226 Barracks Remodel  
02A7823017

This certification is required by the Equal Employment Opportunity Regulations of the Secretary of Labor [41 CFR 60-1.7 (b) (1)] and must be completed by the successful Bidder and each proposed Subcontractor participating in this contract.

**PLEASE CHECK APPROPRIATE BOXES**

The  Bidder  Proposed Subcontractor hereby CERTIFIES:

**PART A.** Bidders and proposed Subcontractors with 50 or more year-round employees and a federal contract amounting to \$50,000 or more are required to submit one federal Standard Report Form 100 during each year that the two conditions exist (50 employees and a \$50,000 federal contract).

The company named below (Part C) is exempt from the requirements of submitting the Standard Report Form 100 this year.

[ ] NO (go to PART B) [ ] YES (go to PART C)

Instructions and blank Standard Report Form 100 may be obtained by contacting:

EEOC - Surveys Division  
131 M Street, NE - Room 4SW22G  
Washington, D.C. 20507  
Telephone number: (877)392-4647 or (866)286-6440

**PART B.** The company named below has submitted the Standard Report Form 100 this year.

[ ] NO [ ] YES

**Note:** Bidders and proposed Subcontractors who have not filed the required Standard Report Form 100 and are not exempt from filing requirements will not be awarded this contract or subcontract until Form 100 has been filed for the current year ending June 30.

**PART C.**

\_\_\_\_\_  
Signature of Authorized Company Representative

\_\_\_\_\_  
Title

\_\_\_\_\_  
Company Name

\_\_\_\_\_  
Company Address (Street or PO Box, City, State, Zip)

\_\_\_\_\_  
Date

( )  
\_\_\_\_\_  
Phone Number



STATE OF ALASKA
DEPARTMENT OF MILITARY AND VETERANS AFFAIRS

CONTACT REPORT

Federal-Aid Contracts
CC - 57226 Barracks Remodel
02A7823017

Project Name and Number

Specific Work or Materials (by pay Item):

DBE Firm Contacted:

Name Address Phone Number

A. INITIAL CONTACT: (See important contact information on instruction sheet)

Method:

Phone Publication Email FAX Other

1. Date

2. Person Contacted Name Title

3. DBE's Response: Date: Method: Phone Email FAX Other

- Submitted an acceptable sub-bid. (If sub-bid accepted, skip to Section D)
Not interested: Indicate Reason(s)
Needs more information: Date Prime provided requested information
Will provide quote by: Date
Received unacceptable sub-bid (complete Section C)

B. FOLLOW-UP CONTACT:

Method:

Phone Publication Email FAX Other

1. Date

2. Person Contacted Name Title

3. DBE's Response: Date: Method: Phone Email FAX Other

- Submitted an acceptable sub-bid. (If sub-bid accepted, skip to Section D)
Received unacceptable sub-bid (complete Section C)
Other result:

C. EXPLANATION OF FAILURE TO ACHIEVE AN ACCEPTABLE SUB-BID:

1. Were the following required efforts made?

- Yes No Identified specific items of work, products, materials, etc. when asking for quote(s).
Yes No Offered assistance in acquiring necessary bonding, insurance, and business development related assistance.
Yes No Provided all appropriate information concerning the specific work items or materials.

2. Was the DBE's quote non-competitive? Yes No

3. Was the DBE unable to perform in some capacity? Yes No If "Yes", explain:

D. CERTIFICATION: I certify that the information provided above is accurate and that efforts to solicit sub-bids were made in good faith.

Signature of Company Representative Title Date

Name of DMVA Reviewer Title Date



STATE OF ALASKA  
DEPARTMENT OF MILITARY AND VETERANS AFFAIRS  
Civil Rights Office – DBE Program

**PRIME CONTRACTOR’S WRITTEN DBE COMMITMENT**

Federal-Aid Contracts

CC - 57226 Barracks Remodel

02A7823017

**Project Name and Number**

All firms bidding on Alaska Department of Military and Veterans Affairs projects must have a written commitment from each DBE firm to be subcontracted. Please complete this form for each DBE firm and submit to the DMVA Compliance Officer.

If you have any questions, please call (907) 428-7187.

Name of DBE Firm: \_\_\_\_\_

Street Address: \_\_\_\_\_

Mailing Address: \_\_\_\_\_ City: \_\_\_\_\_

State: \_\_\_\_\_ Zip Code: \_\_\_\_\_

Telephone Number: \_\_\_\_\_ Fax number: \_\_\_\_\_

Description of the work that DBE firm will perform: \_\_\_\_\_

\_\_\_\_\_

\_\_\_\_\_

\_\_\_\_\_

\_\_\_\_\_

Please provide additional information on a separate sheet of paper.

The dollar amount of participation by the DBE firm: \$ \_\_\_\_\_

Signatures of Authorized representatives of the Prime Contractor and the DBE firm below represent the written commitment by the Prime Contractor to subcontract with the DBE firm as described above and a written commitment by the DBE firm to subcontract for the work described above:

Prime Contractor Signature \_\_\_\_\_ Date \_\_\_\_\_ DBE Firm Signature \_\_\_\_\_ Date \_\_\_\_\_

Prime Contractor Firm: \_\_\_\_\_

Address: \_\_\_\_\_

\_\_\_\_\_

\_\_\_\_\_

Telephone Number: \_\_\_\_\_ Fax number: \_\_\_\_\_



STATE OF ALASKA  
DEPARTMENT OF MILITARY AND VETERANS AFFAIRS

**SUMMARY OF GOOD FAITH EFFORT DOCUMENTATION**

Federal-Aid Contracts

CC - 57226 Barracks Remodel

02A7823017

Project Name and Number

Contractor: \_\_\_\_\_

List all items considered for DBE utilization. GFE requires at a minimum that the Contractor consider all items identified on Form 25A-324.

a. MATERIAL OR SPECIFIC ITEM OF WORK (SPECIFY PAY ITEM)	b. ACCEPTABLE DBE QUOTE RECEIVED <sup>1</sup>	c. # OF DBEs CONTACTED IN DBE DIRECTORY	d. # OF DBEs THAT RESPONDED <sup>2</sup>	e. # OF DBE QUOTES RECEIVED
1.				
2.				
3.				
4.				
5.				
6.				
7.				
8.				

- 1. Check if acceptable DBE quote was received (if so, skip c, d, and e)
- 2. Attach completed Contact Reports, Form 25A-321A

LIST ADDITIONAL ITEMS ON REVERSE SIDE

a. MATERIAL OR SPECIFIC ITEM OF WORK (SPECIFY PAY ITEM)	b. ACCEPTABLE DBE QUOTE RECEIVED <sup>1</sup>	c. # OF DBEs CONTACTED IN DBE DIRECTORY	d. # OF DBEs THAT RESPONDED <sup>2</sup>	e. # OF DBE QUOTES RECEIVED
9.				
10.				
11.				
12.				
13.				
14.				
15.				

- 1. Check if acceptable DBE quote was received (if so, skip c, d, and e)
- 2. Attach completed Contact Reports, Form 25A-321A

Comments:



**Form Instructions:**

1. Select Type 3 Waiver to request waiver of 100% Buy American Preferences if the cost of components and subcomponents produced in the United States is more than 60 percent of the cost of all components of the facility or equipment, and final assembly of the facility or equipment has occurred in the United States.
  - a. List all product components and subcomponents that are not comprised of 100% US domestic content (Exclude products listed on the DMVA Nationwide Buy American Waivers Issued listing and products excepted by Federal Acquisition Regulation Subpart 25.108; products of unknown origin must be considered as non-domestic products in their entirety).
  - b. Cost of non-domestic components and subcomponents, excluding labor costs associated with final assembly at place of manufacture (Department Form 25D-155).
  - c. Percentage of non-domestic component and subcomponent cost as compared to total "item" component and subcomponent costs, excluding labor costs associated with final assembly at place of manufacture (Department and Form 25D-156).
2. All waiver requests must be submitted to DMVA within 5 working days after date of notification of apparent low bidder, or as directed by the Contracting Officer.



# Buy American Preferences - Final Assembly Questionnaire

Federal-Aid Contracts

To assist the Department of Military and Veterans Affairs (DMVA) in making the determination of whether final assembly of the product occurs in the United States, please complete and submit this questionnaire when requesting a Buy American Waiver under 49 U.S.C. 50101(b)(3)(A).

**1. Describe the assembly process occurring at the specified final location in the United States.**

*Please describe the final assembly process and its various operations.*

*How long does the final assembly process take to complete?*

**2. Describe the resources used to conduct the assembly of the product at the specified location in the United States.**

*How many employees are involved in the final assembly process and what is the general skill level of those employees?*

*What type of equipment is used during the final assembly process?*

*What is a rough estimate of the associated cost to conduct final assembly of the product at the specified location in the United States?*



STATE OF ALASKA
DEPARTMENT OF MILITARY AND VETERANS AFFAIRS

CERTIFICATION OF OFFERER/BIDDER REGARDING TAX DELINQUENCY AND
FELONY CONVICTIONS

Region

Project Name: CC - 57226 Barracks Remodel

As a condition of bid responsiveness on Federal funded projects, the bidder must complete, sign, date, and submit this certification statement with their proposal. As a condition of approval of Subcontracts on Federal funded projects, the Subcontractor or Lower Tier Subcontractor must complete, sign, and date the certification statements and the Contractor must submit the certifications with the subcontracts for approval.

The Applicant must complete the following two certification statements. The Applicant must indicate its current status as it relates to tax delinquency and felony conviction by inserting a checkmark (✓) in the space following the applicable response. If the Contract is awarded, the Applicant agrees it will incorporate this provision for certification in all subcontracts and lower tier subcontracts.

Certifications

- a) The Applicant represents that it is [ ] is not [ ] a corporation that has any Federal Tax Delinquency, for which all judicial and administrative remedies have been exhausted or have lapsed, and that is not being paid in a timely manner pursuant to an agreement with the authority responsible for collecting the tax liability.
b) The Applicant represents that it is [ ] is not [ ] a corporation that has a Felony Conviction under any Federal law within the preceding 24 months.

Note

If an Applicant responds in the affirmative to either of the above representations, the Applicant is ineligible to receive an award (or a proposed subcontract award, as applicable) unless the Department has received notification from the DMVA suspension and debarment official (SDO) that the SDO has considered suspension or debarment and determined that further action is not required to protect the Government's interests. The applicant therefore must provide information to the Department about its tax liability or conviction to the Department.

Definitions

Applicant: The Bidder before award of contract. The Contractor, Subcontractor, and Lower Tier Subcontractor after award.

Suspension and Debarment Official (SDO): An official in the DMVA Office that has authority to determine whether an Applicant is suspended or debarred from performing the federally funded work.

Felony conviction: Felony conviction means a conviction within the preceding twenty four (24) months of a felony criminal violation under any Federal law and includes conviction of an offense defined in a section of the U.S. code that specifically classifies the offense as a felony and conviction of an offense that is classified as a felony under 18 U.S.C. § 3559.

Tax Delinquency: A tax delinquency is any unpaid Federal tax liability that has been assessed, for which all judicial and administrative remedies have been exhausted, or have lapsed, and that is not being paid in a timely manner pursuant to an agreement with the authority responsible for collecting the tax liability.

False Statements: Per 49 USC § 47126, this certification concerns a matter within the jurisdiction of the Department of Military and Veterans Affairs and the making of a false, fictitious or fraudulent certification may render the maker subject to prosecution under Title 18, United States Code.

Date

Signature

Company Name

Title





**STATE OF ALASKA  
DEPARTMENT OF MILITARY AND VETERANS AFFAIRS**

**CERTIFICATE OF BUY AMERICAN COMPLIANCE FOR TOTAL FACILITY**

CC - 57226 Barracks Remodel

02A7823017

As a matter of bid responsiveness, the bidder or offeror must complete, sign, date, and submit this certification statement with its proposal. The bidder or offeror must indicate how it intends to comply with 49 USC § 50101 by selecting one of the following certification statements. These statements are mutually exclusive. Bidder must select one or the other (i.e. not both) by inserting a checkmark (✓) or the letter "X".

Bidder or offeror hereby certifies that it will comply with 49 USC § 50101 by:

- a) Only installing steel and manufactured products produced in the United States;
- b) Installing manufactured products for which the Department of Military and Veterans Affairs has issued a waiver as indicated by inclusion on the current DMVA Nationwide Buy American Waivers Issued listing; or
- c) Installing products listed as an Excepted Article, Material or Supply in Federal Acquisition Regulation Subpart 25.108.

By selecting this certification statement, the bidder or offeror agrees:

- d) To provide to the Department evidence that documents the source and origin of the steel and manufactured product (accompanied by Department Form 25D-154).
- e) To faithfully comply with providing U.S. domestic products.
- f) To refrain from seeking a waiver request after establishment of the contract, unless extenuating circumstances emerge that the DMVA determines justified.

The bidder or offeror hereby certifies it cannot comply with the 100 percent Buy American Preferences of 49 USC § 50101(a) but may qualify for a Type 3 waiver under 49 USC § 50101(b). By selecting this certification statement, the apparent bidder or offeror with the apparent low bid agrees:

- a) To submit to the Department within 5 working days after date of notification of apparent low bidder, a formal waiver request (using Department Form 25D-153) and required documentation that supports the type of waiver being requested.
- b) That failure to submit the required documentation within the specified timeframe is cause for a nonresponsible determination that may result in rejection of the proposal.
- c) To faithfully comply with providing U.S. domestic products at or above the approved U.S. domestic content percentage as approved by the DMVA.
- d) To furnish U.S. domestic product for any waiver request that the DMVA rejects.
- e) To refrain from seeking a waiver request after establishment of the contract, unless extenuating circumstances emerge that the DMVA determines justified.

**Required Documentation**

**Type 3 Waiver** - The cost of components and subcomponents produced in the United States is more than 60 percent of the cost of all components and subcomponents of the “facility”. Use Department Forms 25D-153, 25D-155 and 25D-156 to summarize product data. The required documentation for a Type 3 waiver is:

- a) Listing of all manufactured products that are not comprised of 100 percent U.S. domestic content (excludes products listed on the DMVA Nationwide Buy American Waivers Issued listing and products excluded by Federal Acquisition Regulation Subpart 25.108; products of unknown origin must be considered as non-domestic products in their entirety).
- b) Cost of non-domestic components and subcomponents, excluding labor costs associated with final assembly and installation at project location.
- c) Percentage of non-domestic component and subcomponent cost as compared to total “facility” component and subcomponent costs, excluding labor costs associated with final assembly and installation at project location.

**False Statements:** Per USC § 47126, this certification concerns a matter within the jurisdiction of the Department of Military and Veterans Affairs and the making of a false, fictitious or fraudulent certification may render the maker subject to prosecution under Title 18, United States Code.

\_\_\_\_\_

Date

\_\_\_\_\_

Signature

\_\_\_\_\_

Company Name

\_\_\_\_\_

Title



**STATE OF ALASKA  
DEPARTMENT OF MILITARY AND VETERANS AFFAIRS**

**Certificate of Buy American Compliance for Manufactured Products**

CC - 57226 Barracks Remodel

02A7823017

As a matter of bid responsiveness, the bidder or offeror must complete, sign, date, and submit this certification statement with their proposal. The bidder or offeror must indicate how they intend to comply with 49 USC § 50101 by selecting one on the following certification statements. These statements are mutually exclusive. Bidder must select one or the other (not both) by inserting a checkmark (✓) or the letter "X".

- Bidder or offeror hereby certifies that it will comply with 49 USC § 50101 by:
- a) Only installing steel and manufactured products produced in the United States;
  - b) Installing manufactured products for which the Department of Military and Veterans Affairs has issued a waiver as indicated by inclusion on the current DMVA Nationwide Buy American Waivers Issued listing; or
  - c) Installing products listed as an Excepted Article, Material or Supply in Federal Acquisition Regulation Subpart 25.108.

By selecting this certification statement, the bidder or offeror agrees:

- d) To provide to the Department evidence that documents the source and origin of the steel and manufactured product (accompanied by Department Form 25D-154);
  - e) To faithfully comply with providing U.S. domestic product;
  - f) To furnish U.S. domestic product for any waiver request that the DMVA rejects; and
  - g) To refrain from seeking a waiver request after establishment of the contract, unless extenuating circumstances emerge that the DMVA determines justified.
- The bidder or offeror hereby certifies it cannot comply with the 100 percent Buy American Preferences of 49 USC § 50101(a) but may qualify for a Type 3 waiver under 49 USC § 50101(b). By selecting this certification statement, the apparent bidder or offeror with the apparent low bid agrees:
- a) To submit to the Department within 5 working days after date of notification of apparent low bidder, a formal waiver request (using Department Form 25D-153) and required documentation that supports the type of waiver being requested.
  - b) That failure to submit the required documentation within the specified timeframe is cause for a nonresponsible determination that may result in rejection of the proposal.
  - c) To faithfully comply with providing U.S. domestic products at or above the approved U.S. domestic content percentage as approved by the DMVA.
  - d) To refrain from seeking a waiver request after establishment of the contract, unless extenuating circumstances emerge that the DMVA determines justified.

**Required Documentation**

**Type 3 Waiver** - The cost of the item components and subcomponents produced in the United States is more than 60 percent of the cost of all components and subcomponents of the “item”. Use Department Forms 25D-153, 25D-155 and 25D-156 to summarize product data. The required documentation for a Type 3 waiver is:

- a) Listing of all product components and subcomponents that are not comprised of 100 percent U.S. domestic content (Excludes products listed on the DMVA Nationwide Buy American Waivers Issued listing and products excluded by Federal Acquisition Regulation Subpart 25.108; products of unknown origin must be considered as non-domestic products in their entirety).
- b) Cost of non-domestic components and subcomponents, excluding labor costs associated with final assembly at place of manufacture.
- c) Percentage of non-domestic component and subcomponent cost as compared to total “item” component and subcomponent costs, excluding labor costs associated with final assembly at place of manufacture.

**False Statements:** Per USC § 47126, this certification concerns a matter within the jurisdiction of the Department of Military and Veterans Affairs and the making of a false, fictitious or fraudulent certification may render the maker subject to prosecution under Title 18, United States Code.

\_\_\_\_\_  
Date

\_\_\_\_\_  
Signature

\_\_\_\_\_  
Company Name

\_\_\_\_\_  
Title

**STATE OF ALASKA  
DEPARTMENT OF MILITARY AND VETERANS AFFAIRS  
DOCUMENT 00700 - ISSUED DECEMBER 2011**

**GENERAL CONDITIONS OF THE CONSTRUCTION CONTRACT FOR BUILDINGS**

**ARTICLE 1 - DEFINITIONS**

**ARTICLE 2 - AUTHORITIES AND LIMITATIONS**

- 2.1 Authorities and Limitations
- 2.2 Evaluations by Contracting Officer
- 2.3 Means and Methods
- 2.4 Visits to Site

**ARTICLE 3 - CONTRACT DOCUMENTS: INTENT, AMENDING, REUSE**

- 3.1 Incomplete Contract Documents
- 3.2 Copies of Contract Documents
- 3.3 Scope of Work
- 3.4 Intent of Contract Documents
- 3.5 Discrepancy in Contract Documents
- 3.6 Clarifications and Interpretations
- 3.7 Reuse of Documents

**ARTICLE 4 - LANDS AND PHYSICAL CONDITIONS**

- 4.1 Availability of Lands
- 4.2 Visit to Site/Place of Business
- 4.3 Explorations and Reports
- 4.4 Utilities
- 4.5 Damaged Utilities
- 4.6 Utilities Not Shown or Indicated
- 4.7 Survey Control

**ARTICLE 5 - BONDS AND INSURANCE**

- 5.1 Delivery of Bonds
- 5.2 Bonds
- 5.3 Replacement of Bond and Surety
- 5.4 Insurance Requirements
- 5.5 Indemnification

**ARTICLE 6 - CONTRACTOR'S RESPONSIBILITIES**

- 6.1 Supervision of Work
- 6.2 Superintendence by CONTRACTOR
- 6.3 Character of Workers
- 6.4 CONTRACTOR to Furnish
- 6.5 Materials and Equipment
- 6.6 Anticipated Schedules
- 6.7 Finalizing Schedules
- 6.8 Adjusting Schedules
- 6.9 Substitutes or "Or-Equal" Items
- 6.10 Substitute Means and Methods
- 6.11 Evaluation of Substitution
- 6.12 Dividing the Work
- 6.13 Subcontractors
- 6.14 Use of Premises
- 6.15 Structural Loading
- 6.16 Record Documents

**Contract Documents** - The Contract form, Addenda, the bidding requirements and CONTRACTOR's bid (including all appropriate bid tender forms), the bonds, the Conditions of the Contract and all other Contract requirements, the Specifications, and the Drawings furnished by the DEPARTMENT to the CONTRACTOR, together with all Change Orders and documents approved by the Contracting Officer, for inclusion, modifications and supplements issued on or after the Effective Date of the Contract.

**Contracting Officer** - The person authorized by the Commissioner to enter into and administer the Contract on behalf of the DEPARTMENT. He has authority to make findings, determinations and decisions with respect to the Contract and, when necessary, to modify or terminate the Contract. The Contracting Officer is identified on the construction Contract.

**CONTRACTOR** - The individual, firm, corporation or any acceptable combination thereof, contracting with the DEPARTMENT for performance of the Work.

**Contract Price** - The total moneys payable by the DEPARTMENT to the CONTRACTOR under the terms of the Contract Documents.

**Contract Time** - The number of Calendar Days following issuance of Notice-to-Proceed in which the project shall be rendered Substantially Complete, or if specified as a calendar date, the Substantial Completion date specified in the Contract Documents

**Controlling Item** - Any feature of the Work on the critical path of a network schedule.

**Defective** - Work that is unsatisfactory, faulty or deficient, or does not conform to the Contract Documents.

**DEPARTMENT** - The Alaska Department of Military and Veterans Affairs. References to "Owner", "State", "Contracting Agency", mean the DEPARTMENT.

**Directive** - A written communication to the CONTRACTOR from the Contracting Officer interpreting or enforcing a Contract requirement or ordering commencement of an item of Work.

**Drawings** - The Drawings which show the character and scope of the Work to be performed and which have been furnished by the DEPARTMENT or the DEPARTMENT's Consultant and are by reference made a part of the Contract Documents.

**ENGINEER** - The DEPARTMENT'S authorized representative of the Contracting Officer, as defined in the DEPARTMENT'S *delegation of authority letter* to be issued after notice-to-proceed, who is responsible for administration of the contract.

**Equipment** - All machinery together with the necessary supplies for upkeep and maintenance, and also tools and apparatus necessary for the proper construction and acceptable completion of the work.

**Final Acceptance** - The DEPARTMENT's written acceptance of the Work following Final Completion and the performance of all Contract requirements by the CONTRACTOR.

**Final Completion** - The Project (or specified part thereof) has progressed to the point that all required Work is complete as determined by the Contracting Officer.

**Furnish** - To procure, transport, and deliver to the project site materials, labor, or equipment, for installation or use on the project.

**General Requirements** - Sections of Division 1 of the Specifications which contain administrative and procedural requirements as well as requirements for temporary facilities which apply to Specification Divisions 2 through 16.

# BUILDING #57226 ADDITION

CONTRACT # W91ZRU-10-D-0006-0010

ALASKA ARMY NATIONAL GUARD  
CAMP CARROLL, JBER, ALASKA

## RECORD DRAWINGS

### PROJECT TEAM

#### PROJECT MANAGEMENT & GENERAL CONSTRUCTION

H. WATT & SCOTT INC.  
10360 Nigh Road  
Anchorage, Alaska 99515  
Project Mgr: Craig Watts

TEL: 1907 344-6628  
FAX: 1907 344-5360  
EMAIL: cwatt@hwsc.com

#### ARCHITECTURE

GDM, INC.  
4600 Buena Vista Park Blvd., Suite 24  
Anchorage, Alaska 99503-7152

TEL: 1907 562-0422  
FAX: 1907 562-0448  
EMAIL: gdmhinc@ak.net

#### STRUCTURAL ENGINEERING

OJEN ASSOCIATES, INC.  
16922 Hanson Drive  
Eagle River, Alaska 99577

TEL: 1907 694-0507  
FAX: 1907 694-0508  
EMAIL: bob@ojen.com

#### MECHANICAL & ELECTRICAL ENGINEERING

RSA ENGINEERING, INC.  
181 Swanson Avenue, Suite 101  
Wasilla, AK 99654

TEL: 1907 357-1521  
FAX: 1907 257-1751

#### FIRE PROTECTION

CHINDOK FIRE PROTECTION, INC.  
12651 Old Seward Highway  
Anchorage, Alaska 99515


TEL: 1866 616-9909  
FAX: 1907 344-3411  
EMAIL: jef@chindokfire.com

#### FIRE ALARM

GMW FIRE PROTECTION, INC.  
6108 Mackay Street  
Anchorage, AK 99518

TEL: 1907 336-5000  
FAX: 1907 336-5050

### LOCATION MAP

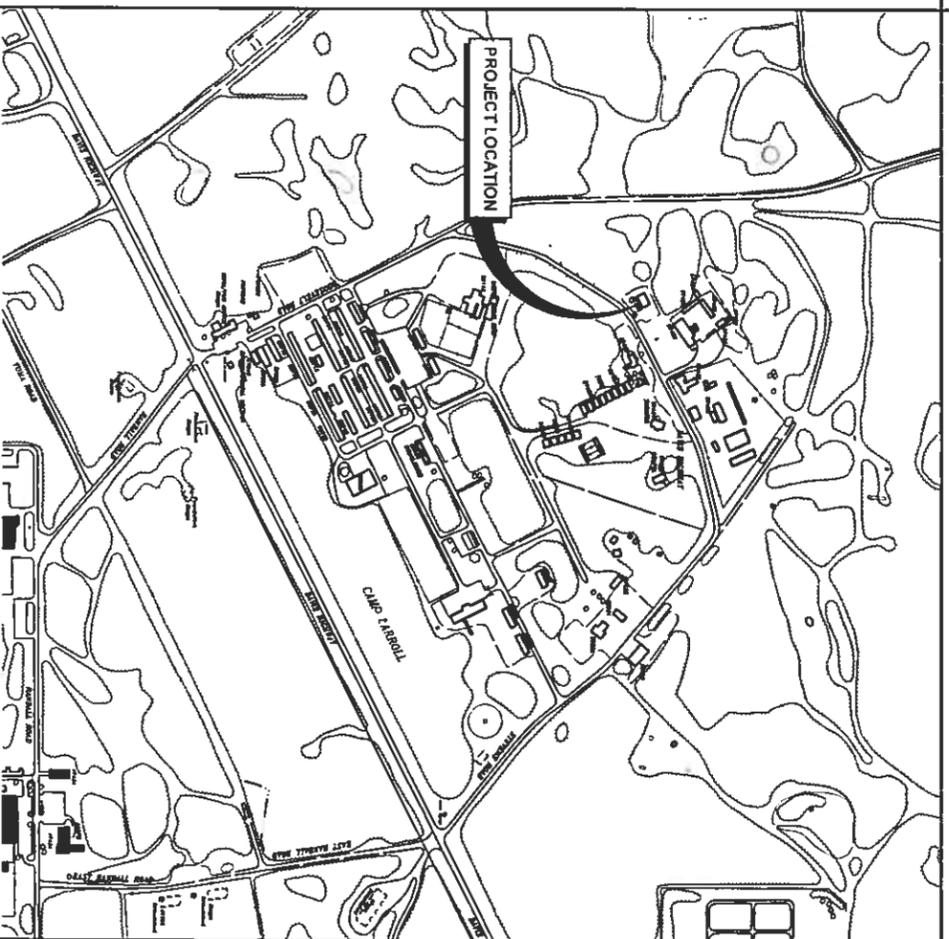

### DRAWING INDEX

GENERAL	MECHANICAL
G1 COVER SHEET	M0.1 MECHANICAL LEGEND AND SCHEDULES
	M0.2 MECHANICAL SPECIFICATIONS
	M1.1 UNDER FLOOR PLUMBING PLAN
	M1.2 ABOVE FLOOR PLUMBING PLAN
	M2.1 VENTILATION PLAN
	M3.1 MECHANICAL DETAILS
ARCHITECTURAL	ELECTRICAL
A1.1 SPECIFICATIONS	E0.1 ELECTRICAL LEGEND, SCHEDULE, SITE PLAN AND DETAILS
A1.2 SPECIFICATIONS	E0.2 ELECTRICAL SPECIFICATIONS AND SCHEDULE
A2.1 SITE PLAN	E.1.1 LIGHTING PLAN
A2.2 FLOOR PLAN	E2.1 POWER PLAN
A2.3 ENLARGED FLOOR PLAN AND DETAILS	
A3 EXTERIOR ELEVATIONS AND SECTIONS	
A4 SCHEDULES, DOOR AND WINDOW TYPES	

### STRUCTURAL

- S0.1 STRUCTURAL NOTES
- S1.1 FOUNDATION PLAN, INSULATION PLAN
- S2.1 FOUNDATION DETAILS

### FIRE ALARM

- FA-1 57226 FLOOR PLAN
- FA-2 DETAIL PAGE A
- FA-3 DETAIL PAGE B

### CODE DATA

#### BUILDING CODE ANALYSIS

- A. OCCUPANCY CLASSIFICATION: RESIDENTIAL GROUP R-1
- B. OCCUPANCY SEPARATIONS: PER IBC 2009 PAR. 420.2 FIRE PARTITIONS REQUIRED BETWEEN SLEEPING UNITS
- C. ALLOWABLE FLOOR AREA FOR NON-SPRINKLERED BUILDING (TABLE 503.3): 7,000 SF
- D. AREA INCREASE FOR SPRINKLERED BUILDING (506.3): 21,000 SF (1 STORY)
- E. ALLOWABLE NO. OF STORES: (TABLE 503) 2
- F. ALLOWABLE HEIGHT: TYPE V B CONSTRUCTION ALLOWABLE: 40 FT. AVERAGE ROOF HEIGHT = 13'-7" THE AVERAGE HEIGHT CALCULATION ESTIMATED FROM DESIGN DRAWINGS FOR NEW STRUCTURE (SLIGHTLY HIGHER THAN EXISTING) BETWEEN GRADE PLANE AND THE AVERAGE HEIGHT OF SLOPING ROOF.

#### CODES AND STANDARDS

UNIFORM PLUMBING CODE (UPMC) 2009 EDITION WITH STATE OF ALASKA DEPARTMENT OF LABOR AMENDMENTS  
NATIONAL ELECTRICAL CODE (NEC) 2009 WITH STATE OF ALASKA DEPARTMENT OF LABOR AMENDMENTS  
ARCHITECTURAL BARRIERS ACT (ALASKA STATUTE 35.10.015)  
TITLE 17 ALASKA ADMINISTRATIVE CODE 50.010  
18 AAC 30, ALASKA DEPARTMENT OF ENVIRONMENTAL CONSERVATION  
APPLICABLE FEDERAL LAWS, REGULATIONS AND OTHER NATIONAL ASSOCIATION STANDARDS:  
AMERICANS WITH DISABILITIES ACT (PUBLIC LAW 101-538) 2010 STANDARDS FOR ACCESSIBILITY DESIGN  
NATIONAL FIRE PREVENTION ASSOCIATION (NFPA) STANDARDS AS REFERENCED IN THE TECHNICAL SPECIFICATION SECTIONS OR IN THE DRAWINGS  
OSHA GENERAL INDUSTRY SAFETY AND HEALTH STANDARDS (29 CFR, 1910) PUBLICATION 42206  
NATIONAL EMISSION STANDARDS FOR HAZARDOUS AIR POLLUTANTS (40 CFR, PART 61)  
ENVIRONMENTAL PROTECTION AGENCY (EPA) FINAL RULE (40 CFR, PART 761)

#### UNIFIED FACILITIES CRITERIA (UFC):

- 3-600-01 FIRE PROTECTION ENGINEERING FOR FACILITIES 4-010-01 000 MINIMUM ANTI-TERRORISM STANDARDS FOR BUILDINGS
- 3-530-01 DESIGN: INTERIOR AND EXTERIOR LIGHTING AND CONTROLS
- 3-310-04 SEISMIC DESIGN FOR BUILDINGS
- 3-301-01 STRUCTURAL ENGINEERING
- AR-190-51 SECURITY OF ARMY PROPERTY (SENSITIVE AND NONSENSITIVE)
- AND PAM 415-5 ARMY NATIONAL GUARD GENERAL FACILITIES INFORMATION DESIGN GUIDE
- AND PAM 415-12 ARMY NATIONAL GUARD FACILITIES ALLOWANCES

#### C. FIRE RESISTANCE RATING REQUIREMENTS PER TABLE 601:

- TYPE V B - CONSTRUCTION STRUCTURAL FRAME 0 HR
- BEARING WALLS (EXT.) 1 HR (TABLE 602 - SEPARATION 6 FT.)
- BEARING WALLS (INT.) 0 HR
- NON-BEARING EXT. WALLS 1 HR (TABLE 602 FIRE SEPARATION 6 FT.)
- NON-BEARING INT. WALLS 30 MIN. (PER 420.2 WITH SPRINKLER SYSTEM PER NFPA 13)
- FLOOR CONSTRUCTION 0 HR
- ROOF CONSTRUCTION 0 HR

#### CODES AND STANDARDS

BUILDING CODES & STANDARDS ADOPTED BY THE STATE OF ALASKA AS ADOPTED AND AMENDED.  
INTERNATIONAL BUILDING CODE (IBC) 2009 EDITION WITH STATE OF ALASKA AMENDMENTS, 13 AAC 50.010  
(www.dps.state.ak.us/files)  
INTERNATIONAL FIRE CODE (IFC) 2009  
INTERNATIONAL FUEL GAS CODE 2009  
INTERNATIONAL MECHANICAL CODE (IMC) 2009

### RECORD DRAWINGS

THIS RECORD DRAWING HAS BEEN PREPARED FROM THE INFORMATION FURNISHED TO GDM INC. DOES NOT CONFIRM THE ACCURACY OF THIS INFORMATION AND ASSUMES NO LIABILITY FOR ERRORS OR OMISSIONS IN THIS DRAWING.



CAMP CARROLL, JBER  
BUILDING #57226  
ADDITION

COVER SHEET

JOB NO. 13015

G1

DATE: 13 OCT 2014

**SECTION 05 40 00**  
**COLD-FORMED METAL FRAMING**

STEEL STUDS, JOISTS, TRACKS, BRACING AND ACCESSORIES

Framing components shall comply with ASTM C 955 and the following:

- Studs and joists of 16 Gauge 10.0x98 Inch and heavier
- Galvanized steel, ASTM A 653/A 653M or carbon steel, ASTM A 1011/A 1011M, Grade 50, painted.
- Studs and joists of 18 Gauge 10.0x118 Inch and lighter

Studs and joists of 18 Gauge 10.0x118 Inch and lighter, Track, and Accessories shall comply with ASTM A 653/A 653M, G601 or carbon steel, ASTM A 1008/A 1008M, Grade C, painted.

Silica, Gages, Section Modulus, and Other Structural Properties

Size and gauge as indicated.

**CONNECTIONS**

Screws for steel-to-steel connections shall be self-drilling tapping in compliance with SAE J78 of the type, size, and location as shown on the drawings. Electroplated screws shall have a Type 11 coating in accordance with ASTM B 633. Screws, bolts, and anchors shall be hot-dipped galvanized in accordance with ASTM A 123/A 123M or ASTM A 153/A 153M as appropriate. Screws bolts, and anchors shall be hot dipped galvanized in accordance with ASTM A 123/A 123M or ASTM A 153/A 153M as appropriate.

**FASTENING**

Fasten framing members together by using self-drilling or self-tapping screws.

**Screws**

Screws shall be self-drilling self-tapping type, size, and location shown on the drawings or specified. Screw penetration through joined materials shall not be less than three exposed threads. Minimum spacing and edge distances for screws shall be as specified in AISI S502-1. Screws covered by sheathing materials shall have low profile heads.

**SECTION 07 21 00**  
**LOOSE FILL INSULATION**

**INSULATION**

Climate Pro Joose 211 fiberglass insulation having a flame spread rating of 25 or less and a smoke developed rating of 150 or less when tested in accordance with ASTM E 84. Insulation to be installed in existing attic over existing batt insulation.

Thermal Resistance Value (R-VALUE)

R-30 in addition to existing fiberglass batt!

Prohibited Materials

Do not provide asbestos-containing materials.

**BATTLES**

Eave battles constructed of plastic, cardboard, or other approved materials. Use only non-combustible materials meeting the requirements of ASTM E 136 for blocking around chimneys and heat producing devices.

**SECTION 07 22 00**  
**FOAMATION INSULATION**

**INSULATION**

Insulfoam R-Tech Expanded Polystyrene Board with polymeric laminate facers: ASTM C 578, Type I, 1.0 density.

INSULATION THICKNESS

Thickness shall be 2".

**SECTION 07 19 00**  
**SEALING VAPOR RETARDER**

**VAPOR RETARDER**

Polyethylene sheeting, 6.0 mil, complying with ASTM D-4391-84E. Vapor rating of 0.10 perms or less (ASTM E96). Ten-foot minimum X continuous roll length.

Accessories: Primers, adhesives, solvents, battens, squeegees, clips, trim and other accessories recommended by vapor retarder manufacturer and necessary for a complete installation.

**EXAMINATION**

Examine Drawing details and field conditions to receive work for defects that will adversely affect the completed installation, and for deviations beyond allowable tolerances.

Substrate surfaces shall be free of sharp projections or holes over which the vapor retarder sheet can be applied without tearing or puncturing.

**INSTALLATION**

Installation shall be continuous, without gaps, holes or tears. Installation may be beneath a layer of sand for V.R. protection and curing of concrete.

**PROTECTION**

The Contractor shall protect installed retarder in all areas so that construction activities and traffic across the retarder will not result in punctures or other forms of damage and deterioration. The continuity and vapor resistance integrity of the vapor retarder is an extremely important element of the project construction.

**SECTION 07 46 30**  
**STEEL ROOFING**

**MANUFACTURER**

Vanco Proden

**ROOFING PANELS**

SRP, standing seam 22 or 24 gauge zinc aluminum coated steel.

**MATERIALS**

Finish to be manufacturer's standard coating. Color to be selected from Manufacturer's standard colors.

**TRIM**

Provide trim pieces as detailed on Drawings and per manufacturer's installation instructions as required for complete, weather tight, functional installation.

**SECTION 07 41 00**  
**INSULATED METAL WALL PANELS**

**MANUFACTURER**

Kingspan.

**INSULATED METAL WALL PANELS**

Finished metal skins, polyurethane insulation, 4" thick, R-30

**TRIM**

Provide trim pieces as detailed on Drawings and per manufacturer's installation instructions as required for complete, weather tight, functional installation.

**SECTION 07 60 00**  
**FLASHING AND SHEET METAL**

Materials shall conform to the requirements specified below and to the thickness and configurations established in SMACNA Arch. Manual

Exposed Sheet Metal Items, Zinc-Coated Galvanized

Shall be of the same material. Minimum 24 ga.

Steel Sheet, Zinc-Coated Galvanized

ASTM A 653/A 653M, Minimum 24 ga.

**Finish**

Factory finished to match adjacent building material color.

**Fasteners**

Use the same metal or a metal compatible with the item fastened. Use stainless steel fasteners to fasten dissimilar materials.

**SECTION 07 92 00**  
**JOINT SEALANTS**

Materials shall conform to the requirements specified below. Provide sealants that are tested and suitable for the substrate. All sealants shall be low V.O.C.

For joints in vertical surfaces, provide ASTM C 920, Type S or M, Grade NS, Class 25, Use N. For joints in horizontal surfaces, provide ASTM C 920, Type S or M, Grade P, Class 25, Use T. Localization and color(s) of sealant shall be as follows:

**LOCATION/**

**COLOR**

- a. Joints and recesses formed where frames and subsills of windows, doors, louvers, and vents adjoin metal frames. Use sealant at both exterior and interior surfaces of exterior wall penetrations. Match adjacent primary surface color
- b. Voids at penetrations where items pass through exterior walls and ceilings. Match adjacent primary surface color
- c. Metal-to-metal joints where sealant is indicated or specified. Match adjacent primary surface color
- d. Joints between ends of gravel stops, fascias, copings, and adjacent walls. Match adjacent primary surface color

**SECTION 08 11 13**  
**STEEL DOORS AND FRAMES**

**Steel Door Systems**

Exterior Steel doors shall have a core of polyurethane insulation; face sheets, edges, and frames of galvanized steel not lighter than 23 gauge, 16 gauge, and 16 gauge respectively; weather stripping; nonremovable-pin hinges; aluminum thresholds; and door bottom. Door and frames shall be galvanized. Doors shall have been tested in accordance with SDI/DOOR A250.4 and shall meet the requirements for Level C. Prepare doors to receive specified hardware. Doors shall be 1-3/4 inch thick.

**Steel Frames**

SDI/DOOR A250.8, Level 3, 16 gauge, except as otherwise specified. Form frames to size and shape indicated, with welded corners. Provide steel frames for all doors.

**Anchors**

Provide anchors to secure the frame to adjoining construction. Provide steel anchors, zinc-coated or painted with rust-inhibitive paint, not lighter than 18 gauge. Provide 3 jamb anchors and 1 base anchor or 4 jamb anchors on both sides of frame.

**SECTION 08 14 00**  
**WOOD DOORS**

**DOORS**

Provide doors of the type, size and design indicated.

Interior Flush Doors

Provide particleboard core, Type II flush doors conforming to KDFI 1.5. 1-4 with faces of sound grade red oak hardwood for natural finish.

**Finishes**

Field Painting: Factory prime or seal doors and field paint.

**Color**

Provide door finish color as selected by the Contracting Officer's representative.

**SECTION 08 51 13**  
**ALUMINUM WINDOWS**

**SCOPE**

Replace existing windows to meet egress requirements of sleeping rooms and UFC 4-010-01 and UFC 4-010-02. Existing exterior walls are 2x6 load bearing wood studs with plywood sheathing. Building occupancy: Blasting Level of Protection: low. Project is within a controlled perimeter.

**PERFORMANCE REQUIREMENTS**

- A. Testing standards for air infiltration, water penetration and structural performance: AAMA/NWFA/CSA 102/1.5.2/440 for each window type.
- B. Air Infiltration: Maximum 0.06 CFM per square foot of sash fixed area at a test pressure differential of 6.24 psf, ASTM E 283.
- C. Water penetration: No water penetration at a pressure of 8 psf of fixed area, ASTM E 331.
- D. Structural performance: Design all frames for static loads per ASTM F 1642. Members shall withstand design wind load and requirements of UFC 4-010-01 with Change 1.
- E. Wind Requirements: 110 MPH 13 sec gust wind speed. Wind Pressure: 50 psf. Exposure: C.
- F. Provide manufacturer's standard 10 year warranty on finish.

**PRODUCTS**

A. Duro Dark Bronze Anodized.

B. Solarban 60 tempered glass over 1/4" laminated.

**MATERIALS**

A. Mullions and Cover Plates: Shall be extruded aluminum of 6063-T5 alloy and temper of profile and dimensions indicated on the drawings.

B. Thermal Barrier: Neoprene, rigid vinyl or polyurethane conforming to AAMA 101.

**GLASS AND GLAZING**

A. Glass thickness and type shall be in accordance with manufacturer's recommendations for prescribed design pressure. Factory glazing shall be in accordance with manufacturer's standard requirements.

B. Factory glazed except where field glazing is required due to large window unit dimensions. Units shall be replaceable without dismantling sash framing.

**C.**

Insulating Glass: ASTM E114, NWH/IGCC, CDA Rated, Dual-Seal or Single-Seal as selected. Provide the window manufacturer's sealed insulating glazing material at least 1" overall in thickness.

Glass Characteristics: Manufacturer's standard clear float glass.

**ACCESSORIES**

A. Fasteners: Where exposed, shall be 300 Series, Stainless Steel.

B. Reclaimer Anchors: Aluminum. When steel anchors are used, provide insulation between steel material and aluminum to prevent galvanic action.

**RECORD DRAWINGS**

THIS RECORD DRAWING HAS BEEN PREPARED FROM THE INFORMATION PROVIDED TO GDM INC. DOES NOT CONFIRM THE ACCURACY OF THIS INFORMATION AND ASSUMES NO LIABILITY FOR ERRORS OR OMISSIONS IN THIS DRAWING.



**CAMP CARROLL, JBER**  
BUILDING #57226  
ADDITION

**SPECIFICATIONS**

JOB NO. 13015

**A.1.1**

DATE: 13 OCT 2014

**SECTION 08 11 10**

**DOOR HARDWARE**

**DOOR HARDWARE**

General: Provide door hardware for each door to comply with requirements in this Section, and the Door Hardware Schedule.

Designations: Requirements for design, grade, function, finish, size, and other distinctive qualities of each type of door hardware are indicated by using door hardware designations, as follows:

1. Named Manufacturer's Products: Product designation and manufacturer are listed for each door hardware type required for the purpose of establishing minimum requirements. Manufacturer names are abbreviated in the Door Hardware Schedule.

**HINGES AND PIVOTS**

Available Manufacturers: Subject to compliance with requirements, manufacturers offering products that may be incorporated into the work include, but are not limited to, the following:

1. Hinges:
  - a. Baldwin Hardware Corporation 10H1.
  - b. Hager Companies 1HAG1.
  - c. Laverne Brothers, Inc. 1L81.
  - d. McKinley Products Company; Div. of ESSEX Industries, Inc. 1MCK1.
  - e. Sargent Manufacturing Company; Div. of ESSEX Industries, Inc. 1SGT1.
  - f. Stanley Commercial Hardware; Div. of The Stanley Works 1STH1.

**LOCKS AND LATCHES**

Available Manufacturers: Subject to compliance with requirements, manufacturers offering products that may be incorporated into the work include, but are not limited to, the following:

1. Mechanical Locks and Latches:
  - a. Best Lock Corporation 1BLC1.
  - b. Corbin Russwin Architectural Hardware; Div. of Yale Security Inc. 1CRI.
  - c. Hager Companies 1HAG1.
  - d. McKinley Products Company; Div. of ESSEX Industries, Inc. 1MCK1.
  - e. Sargent Manufacturing Company; Div. of ESSEX Industries, Inc. 1SGT1.
  - f. Schlage Lock Company an Ingersoll-Rand Company 1SCH1.
  - g. Weiser Lock; Div. of Masco Building Products Corporation 1WEI1.

Backset: 2-3/4 inches 110 mm, unless otherwise indicated.

**CYLINDERS AND KEYS**

Available Manufacturers: Subject to compliance with requirements, manufacturers offering products that may be incorporated into the work include, but are not limited to, the following:

1. Cylinders: Same manufacturer as for locks and latches.
2. Key Control System: Best.
3. Interchangeable Cores: Core insert, removable by use of a special key, and usable with other manufacturers' cylinders.

Strikes: Provide manufacturer's standard strike with strike box for each latch or lock bolt, with rured lip extended to protect frame, finished to match door hardware set, unless otherwise indicated, and as follows:

1. Extra-Long-Lip Strikes: For locks used on frames with applied wood casing trim.

**CLOSERS**

Available Manufacturers: Subject to compliance with requirements, manufacturers offering products that may be incorporated into the work include, but are not limited to, the following:

1. Surface-Mounted Closers:
  - a. Corbin Russwin Architectural Hardware; Div. of Yale Security Inc. 1CRI.
  - b. DORR Door Controls Inc.; Member of The DORR Group 1DC1.
  - c. LCN Closers; an Ingersoll-Rand Company 1LCN1.
  - d. Norton Door Controls; Div. of Yale Security Inc. 1NDC1.
  - e. Sargent Manufacturing Company; Div. of ESSEX Industries, Inc. 1SGT1.

**PROTECTIVE TRIM UNITS**

Available Manufacturers: Subject to compliance with requirements, manufacturers offering products that may be incorporated into the work include, but are not limited to, the following:

1. Metal Protective Trim Units:
  - a. Baldwin Hardware Corporation 1BH1.
  - b. IPC Door and Wall Protection Systems, Inc. 1IPC1.
  - c. Ives; H. B. Ives 1IVI1.
  - d. NY Quality Hardware; an Ingersoll-Rand Company 1NYQ1.
  - e. Triangle Brass Manufacturing Company, Inc. 1TBM1.
  - f. Wilkinson Company, Inc. 1WIL1.

Materials: Fabricate protection plates from the following:

1. Stainless Steel: 0.050 inch 1.3 mm thick; beveled top and 2 sides.

Fasteners: Provide manufacturer's standard exposed fasteners for door trim units consisting of either machine or self-tapping screws.

Finish: Provide protection plates sized 1-1/2 inches 38 mm less than door width on push side and 1/2 inch 13 mm less than door width on pull side, by height specified in Door Hardware Schedule.

**DOOR CASING**

Available Manufacturers: Subject to compliance with requirements, manufacturers offering products that may be incorporated into the work include, but are not limited to, the following:

1. Door Casings:
  - a. National Guard Products, Inc. 1NGP1.
  - b. Pemco Manufacturing Co., Inc. 1PEM1.
  - c. Reese Enterprises, Inc. 1REI1.
  - d. Seabee Corporation 1SEL1.
  - e. Zero International, Inc. 1ZRO1.
2. Door Bottoms:
  - a. National Guard Products, Inc. 1NGP1.
  - b. Pemco Manufacturing Co., Inc. 1PEM1.
  - c. Reese Enterprises, Inc. 1REI1.
  - d. Zero International, Inc. 1ZRO1.

**THRESHOLDS**

Available Manufacturers: Subject to compliance with requirements, manufacturers offering products that may be incorporated into the work include, but are not limited to, the following:

1. National Guard Products, Inc. 1NGP1.
2. Pemco Manufacturing Co., Inc. 1PEM1.
3. Reese Enterprises, Inc. 1REI1.
4. Zero International, Inc. 1ZRO1.

**MISCELLANEOUS DOOR HARDWARE**

Available Manufacturers: Subject to compliance with requirements, manufacturers offering products that may be incorporated into the work include, but are not limited to, the following:

1. Baldwin Hardware Corporation 1BH1.
2. Hager Companies 1HAG1.
3. Ives; H. B. Ives 1IVI1.
4. Triangle Brass Manufacturing Company, Inc. 1TBM1.

**FINISHES**

Standard: Comply with BIMA 156.18, and match existing building hardware finishes.

**DOOR HARDWARE SCHEDULE**

**801 - DOORS, 116A AND 116B**

Hardware by pre-engineered metal building manufacturer.

802 - DOOR KIT	
3ea Hinges	HA
1ea Lockset	BE
1ea Kickplate	RW
1ea Wall Stop	RW
1ea Sound Seal	PE

**SECTION 09 29 00**

**GYPSON BOARD**

**Gypsum Board**

ASTM C 36/C 36M and ASTM C 1396/C 1396M.

Moist and mildew resistant. ASTM D 3213 panel score of 8, 5/8 inch Type X.

**Finish**

Tape and finish gypsum board in accordance with ASTM C 840, GA 214 and GA 215. All gypsum board walls, partitions and ceilings shall be an orange peel texture. Provide joint, fastener depression, and corner treatment.

**Fire-Resistant Assemblies**

Wherever fire-rated construction is indicated, provide materials and application methods, including types and spacing of fasteners, wall and ceiling framing in accordance with the specifications contained in UL Fire Resist Dir. or NFPA Fire Resist Dir. for the Design Number(s) indicated, or GA 600 for the Fire Resistance(s) indicated. Joints of fire-rated gypsum board enclosures shall be lapped and sealed in accordance with UL test requirements, NFPA test requirements, or GA requirements. Penetrations through rated partitions and ceilings shall be sealed tight in accordance with tested systems. Fire ratings shall be as indicated in the drawings.

**SECTION 09 65 30**

**RESILIENT WALL BASE AND ACCESSORIES**

**RESILIENT WALL BASE**

A. Manufacturer: Ductile.

B. Type: Rubber.

C. Group: Type 2E or 2F.

D. Style: Cove with top-rail tool.

E. Minimum Thickness: 0.125 inch.

F. Height: 4 inches

G. Lengths: Cut lengths 48 inches long or coils 10 manufacturer's standard length.

H. Outside Corners: Job formed or pre-molded.

I. Inside Corners: Job formed or pre-molded.

J. Surface: Smooth.

K. Color: to be determined.

**INSTALLATION MATERIALS**

Trimable leveling and Parting Compounds: Latex-modified, Portland cement based or blended hydraulic cement based formulation provided or approved by resilient product manufacturers for applications indicated.

Adhesives: Water-resistant type recommended by manufacturer to suit resilient products and substrate conditions indicated.

All installation materials shall be low V.O.C.

**SECTION 09 90 00**

**PAINTS AND COATINGS**

**INTERIOR PAINT TABLES**

**DIVISION 5: INTERIOR METAL, FERROUS AND NON-FERROUS PAINT TABLE**

**INTERIOR STEEL / FERROUS SURFACES**

**A. Door Frames -**

1. Latex (Semi-gloss)
  - Primer: Sherwin Williams Poetry Primer (omit if factory primed)
  - Intermediate: Sherwin Williams Industrial Acrylic Semi-Gloss Topcoat: Sherwin Williams Industrial Acrylic Semi-Gloss
- B. Miscellaneous non-ferrous metal items not otherwise specified except floors, hot metal surfaces, and new prefabricated equipment. Match surrounding finish.
  1. Latex (Semi-gloss)
    - Primer: N/A
    - Intermediate: Sherwin Williams Industrial Acrylic Semi-Gloss Topcoat: Sherwin Williams Industrial Acrylic Semi-Gloss

**DIVISION 9: INTERIOR GYPSUM BOARD, TEXTURED SURFACES PAINT TABLE**

**A. New Wallboard not otherwise specified:**

1. Latex (Eggshell)
  - Primer: Sherwin Williams Prokor 200 Primer
  - Intermediate: Sherwin Williams Prokor 400 Eggshell Topcoat: Sherwin Williams Prokor 400 Eggshell

**SECTION 10801**

**TOILET ACCESSORIES**

**MANUFACTURERS AND PRODUCTS**

Manufacturers and products are limited to those indicated in the Toilet Accessory Schedule.

**INSTALLATION**

Coordinate accessory locations with other work for anchor blocking installation, to prevent interference with door and fixture clearances, adding required clearances proper installation, operation, cleaning and servicing of accessories. Install accessories according to manufacturer's written instructions, using fasteners appropriate to substrate. Install units level, plumb, and firmly anchored in locations and at heights indicated. Adjust mechanisms for untroubled, smooth operation and verify that mechanisms function properly. Remove temporary labels and protective coatings. Clean and polish exposed surfaces according to manufacturer's written recommendations. Turn keys over to Owner.

**TOILET ACCESSORY SCHEDULE**

Toilet Tissue Dispenser:

- A. Basis of Design: Georgia Pacific Model 5909.
- B. Type: Jumbo Double-roll dispenser, Surface mounted.

Towel Dispenser:

- A. Basis of Design: Georgia Pacific Model 5960.
- B. Type: Automated Roll Towel Dispenser, Touchless, Hands Free, Battery Operated, Surface Mounted.

Soap Dispenser:

- A. Basis of Design: GOJO Model 5150.
- B. Type: Vertical-Tank Type, Push Operation, Surface-mounted.

Grab Bar:

- A. Basis of Design: Bobrick B-606 Series.
- B. Type: Stainless-Steel 1 1/2" o.d. Tubing with satin finish.
- C. Mounting: Concealed flange and anchors with manufacturer's snap flange cover.

Mirror Unit:

- A. Basis of Design: Bobrick B-165 Series. Size: 24" w x 16" h.
- B. Type: Stainless-Steel, Channel-Framed Mirror.

THIS RECORD DRAWING HAS BEEN PREPARED FROM THE RECORD DRAWING. GDM INC. DOES NOT CONFIRM THE ACCURACY AND ASSUMES NO LIABILITY FOR ERRORS OR OMISSIONS IN THIS DRAWING.




**CAMP CARROLL, JBER**  
BUILDING #57226  
ADDITION

SPECIFICATIONS

JOB NO. 13015  
**A1.2**

DATE 13 OCT 2014

RECORD DRAWINGS

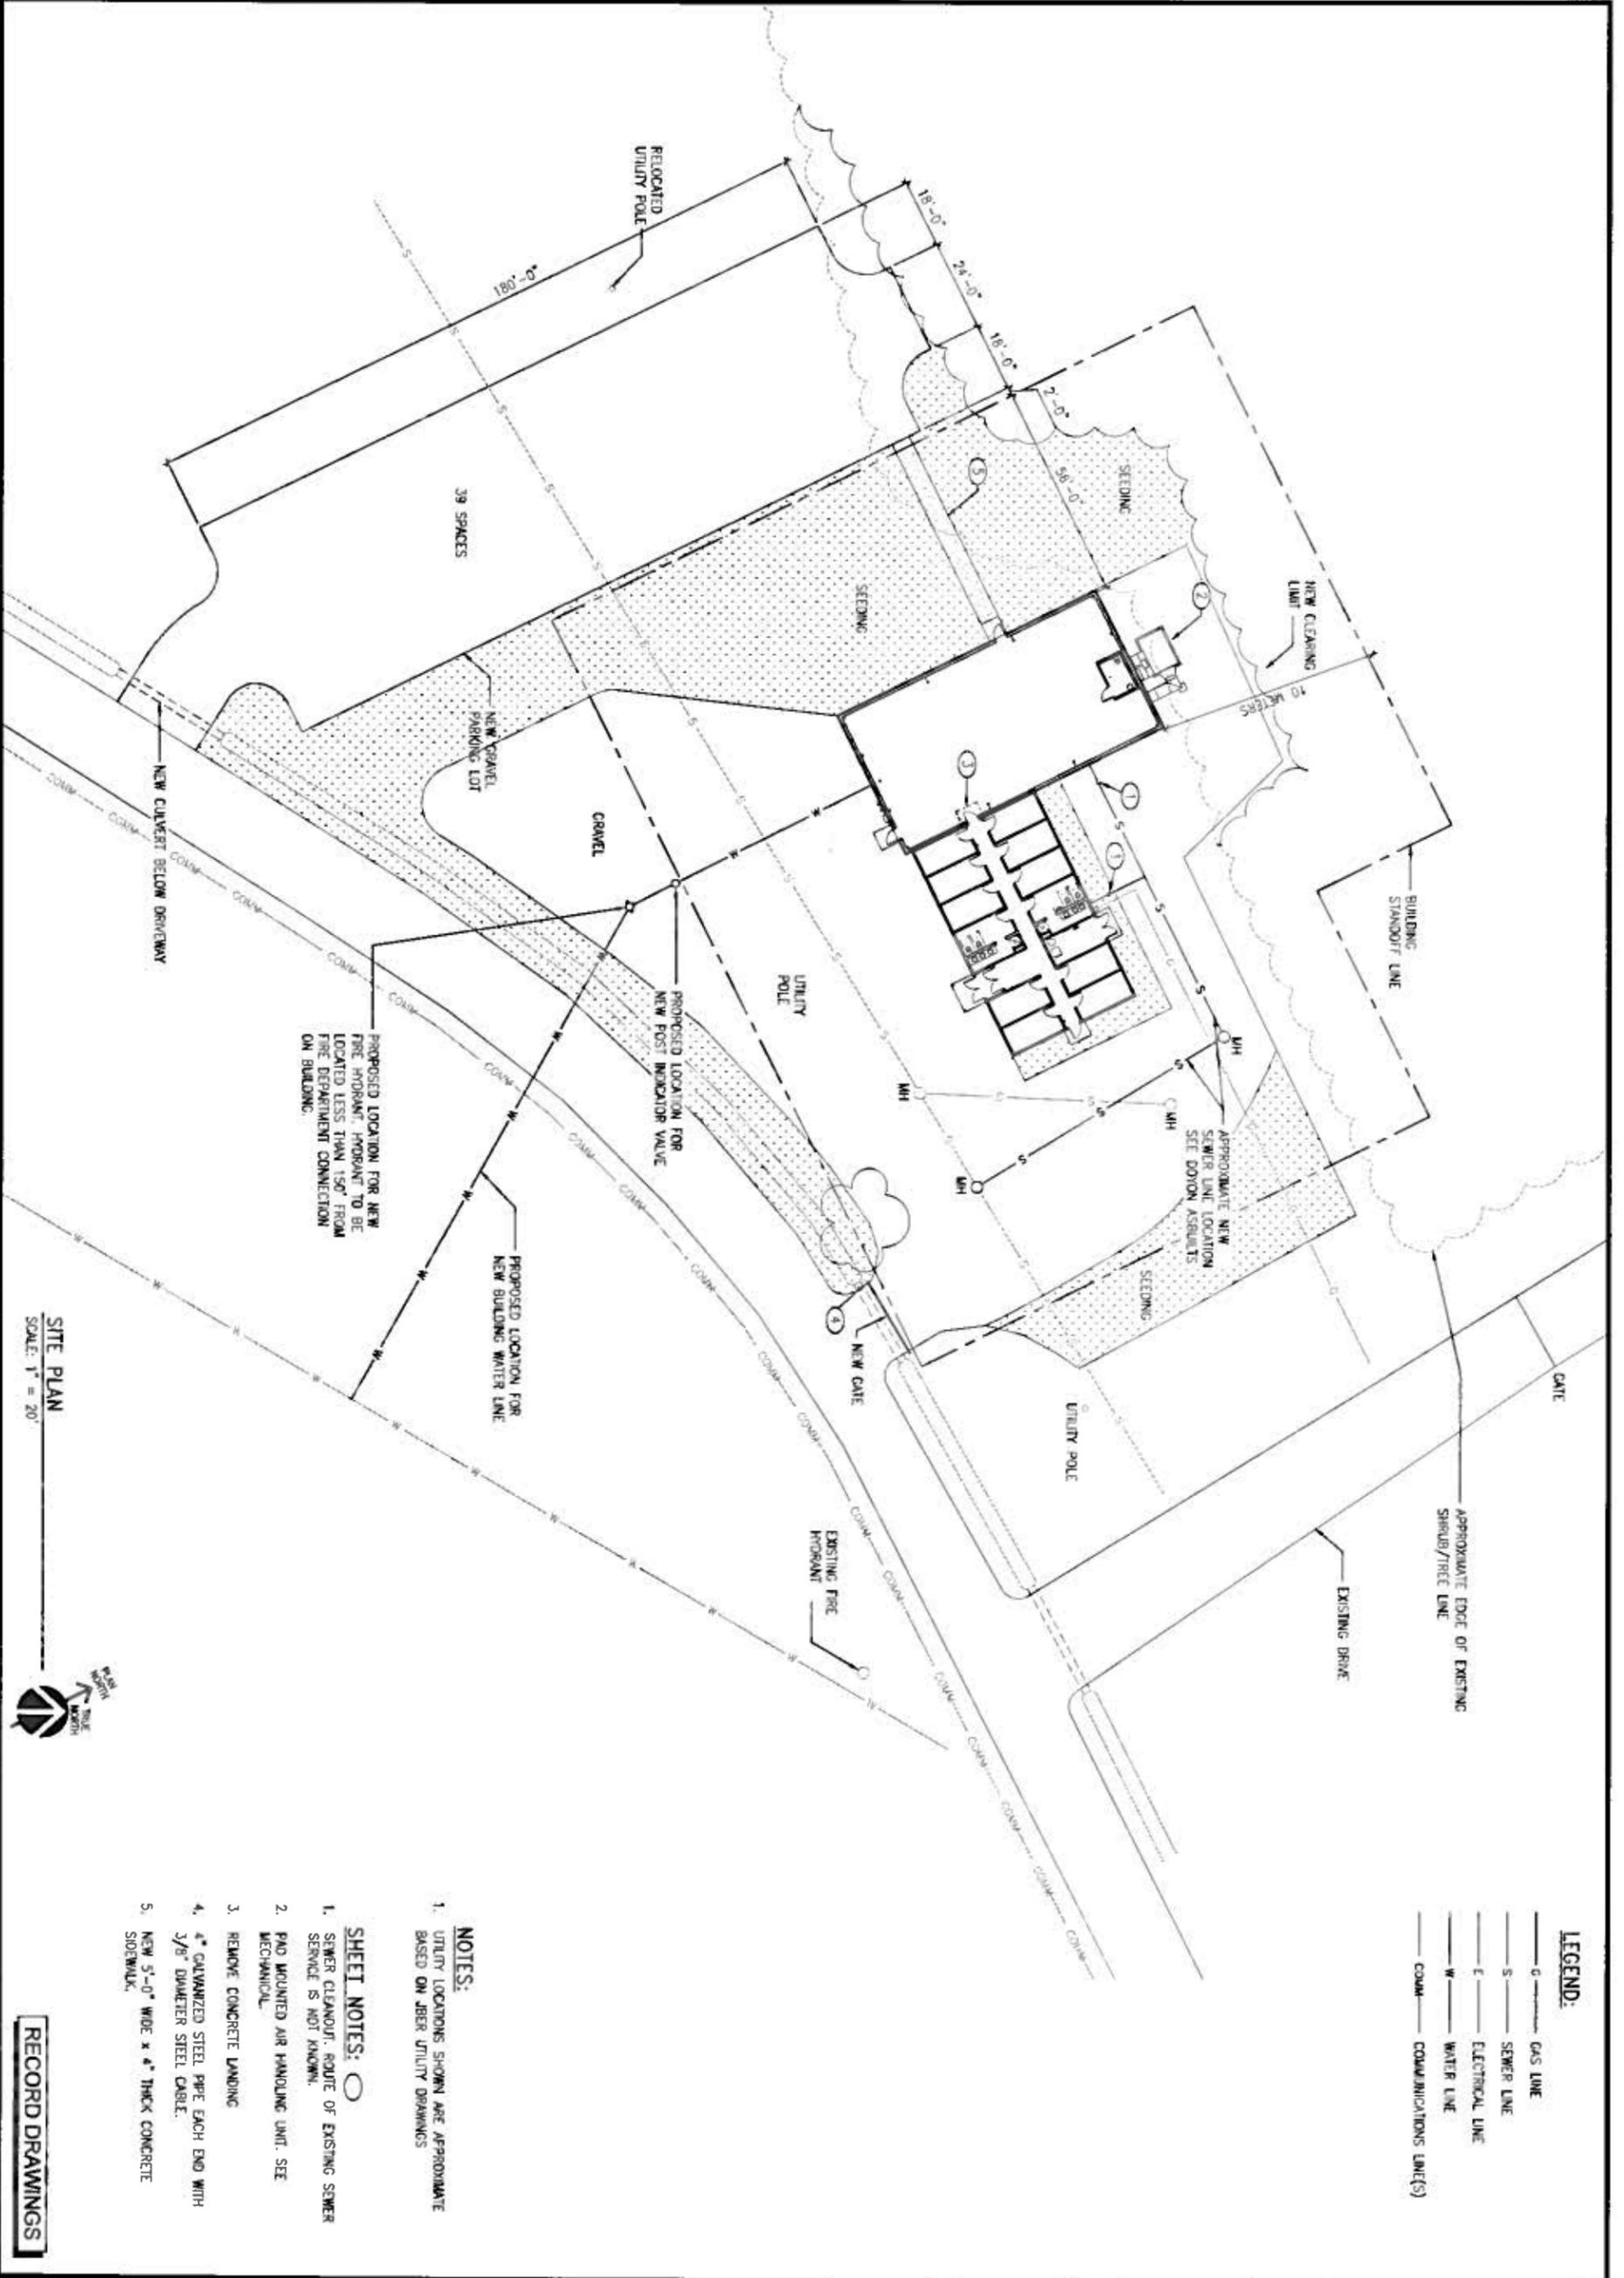

SITE PLAN  
SCALE: 1" = 20'




- LEGEND:**
- G — GAS LINE
  - S — SEWER LINE
  - E — ELECTRICAL LINE
  - W — WATER LINE
  - COMM — COMMUNICATIONS LINE(S)

- NOTES:**
1. UTILITY LOCATIONS SHOWN ARE APPROXIMATE BASED ON JBER UTILITY DRAWINGS
- SHEET NOTES:**
1. SEWER CLEANOUT: ROUTE OF EXISTING SEWER SERVICE IS NOT KNOWN.
  2. PAD MOUNTED AIR HANDLING UNIT. SEE MECHANICAL.
  3. REMOVE CONCRETE LANDING
  4. 4" GALVANIZED STEEL PIPE EACH END WITH 3/8" DIAMETER STEEL CABLE.
  5. NEW 5'-0" WIDE x 4" THICK CONCRETE SIDEWALK.


**RECORD DRAWINGS**

JOB NO. 13075  <b>A2.1</b> DATE: 13 OCT 2014	SITE PLAN	CAMP CARROLL, JBER  BUILDING #57226 ADDITION			THIS RECORD DRAWING HAS BEEN PREPARED FROM INFORMATION FURNISHED BY THE CLIENT. GDM INC. DOES NOT CONFIRM THE ACCURACY OF THIS INFORMATION AND ASSUMES NO LIABILITY FOR ERRORS OR OMISSIONS IN THIS DRAWING.
---	-----------	---	--	--	--

THIS DRAWING MEASURES 34"x22" AT FULL SCALE

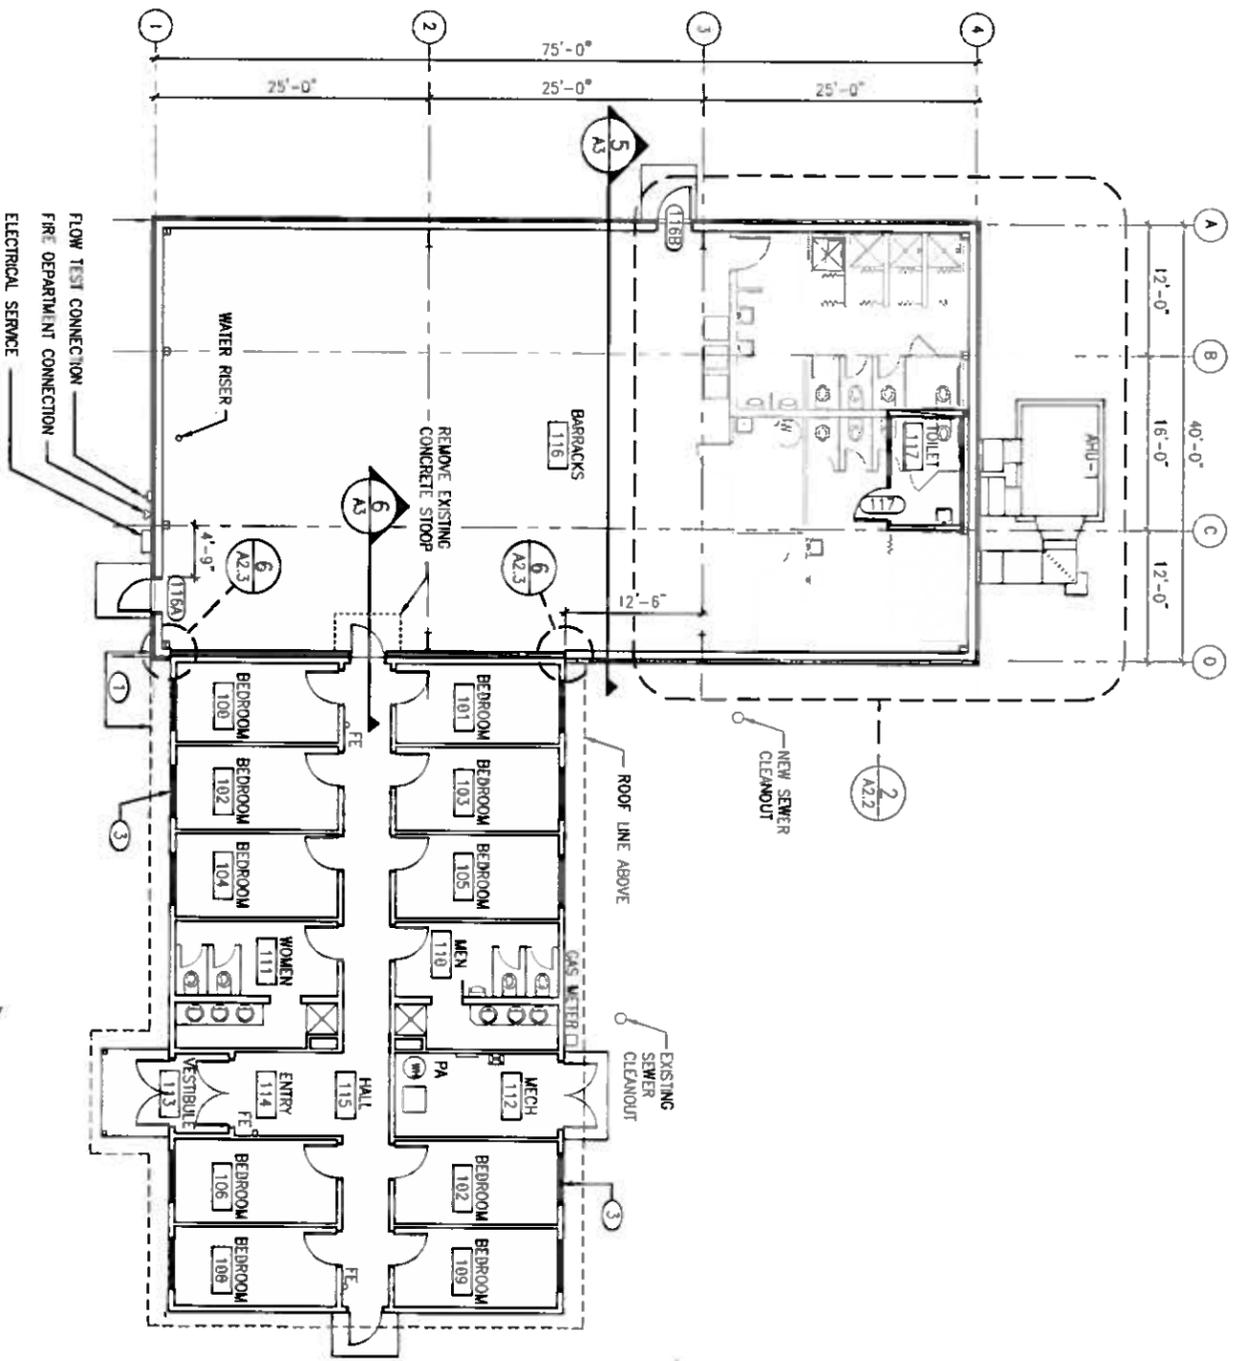

1 FLOOR PLAN  
A2.2 1/8" = 1'-0"

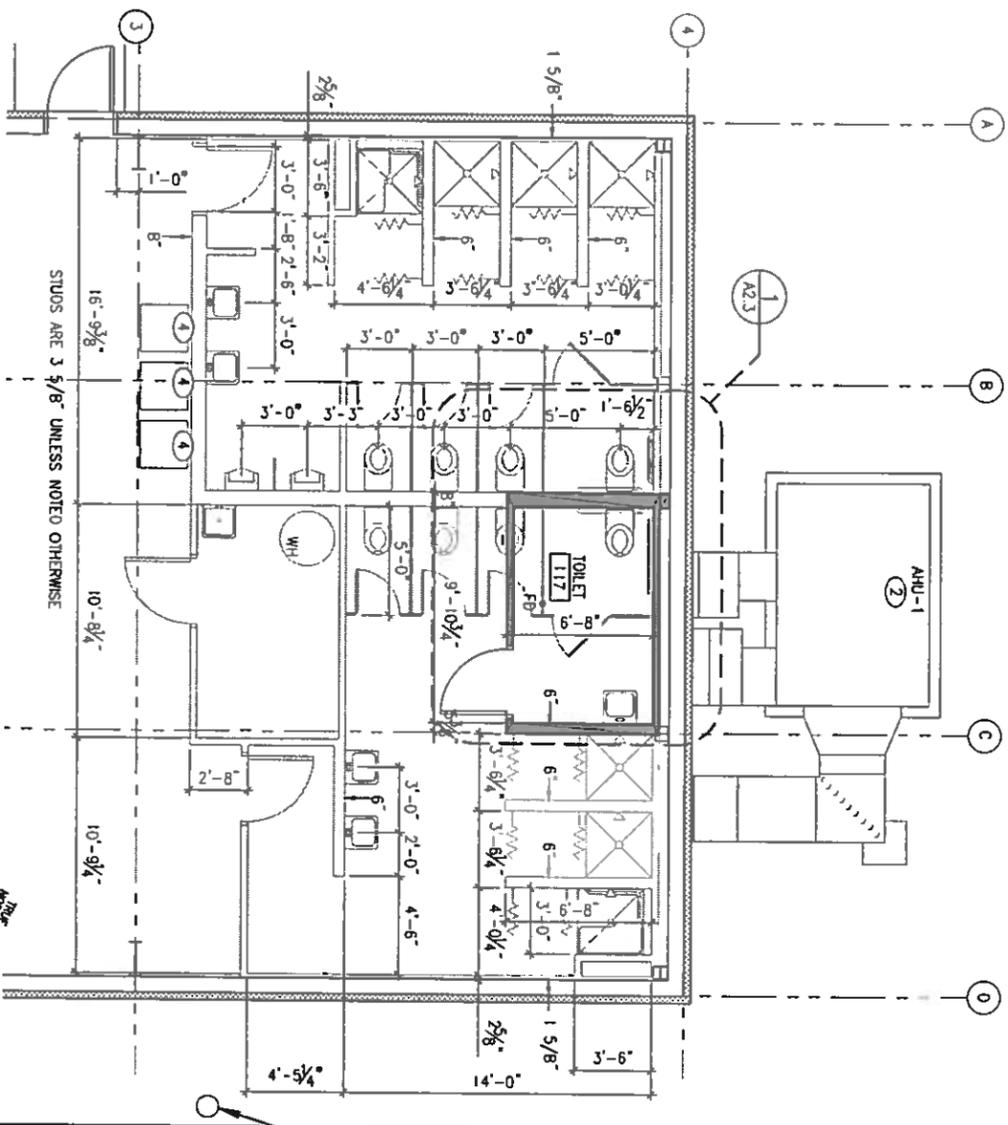


2 LARGE SCALE PLAN  
A2.2 1/4" = 1'-0"

- NOTES:**
1. ALL DIMENSIONS ARE TO FACE OF PANEL, FACE OF STEEL OR FACE OF STUD.
  2. CONSTRUCT NEW TOILET 117 PARTITIONS FULL HEIGHT TO BOTTOM OF ROOF PANELS ABOVE.
  3. SCREENED WALLS AND FIXTURES IN NEW BUILDING ADDITION ARE FUTURE CONSTRUCTION.


- SHEET NOTES:**
1. ALIGN FACE OF SILING ON NEW ADDITION WITH FACE OF EAVE ON EXISTING BUILDING.
  2. PAD MOUNTED AIR HANDLING UNIT. SEE MECHANICAL FOR GAS LINE AND OUTWORK CONNECTIONS TO BUILDING.
  3. REPLACE EXISTING WINDOWS TO MEET SLEEPING ROOM EGRESS REQUIREMENTS AS WELL AS UFC 4-010-01 AND UFC 4-010-02.
  4. FUTURE STACKING WASHER/DRYER

RECORD DRAWINGS


FLOOR PLAN	<b>CAMP CARROLL, JBER</b> BUILDING #57226 ADDITION		
JOB NO. 13015 DATE 13 OCT 2014 <b>A2.2</b>	THIS RECORD DRAWING HAS BEEN PREPARED FROM CONTRACTOR FURNISHED INFORMATION. GDM INC. DOES NOT ASSUME RESPONSIBILITY FOR ERRORS OR OMISSIONS IN THIS DRAWING.		

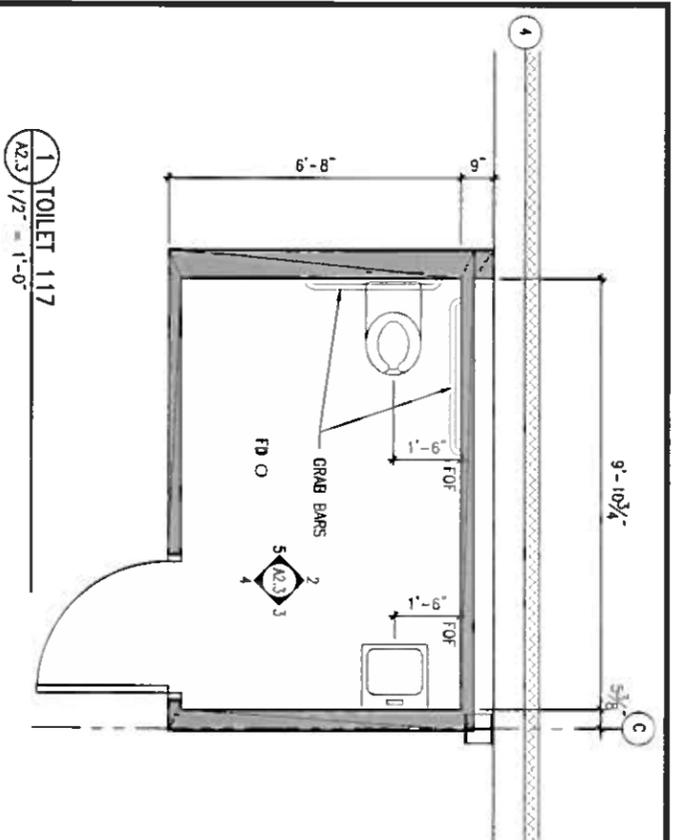


1 TOILET 117  
A2.3 1/2" = 1'-0"

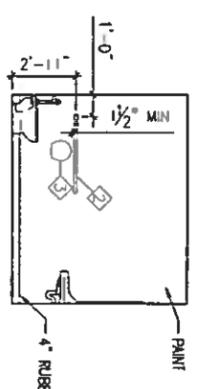


2 INTERIOR ELEVATION NORTH  
A2.3 1/4" = 1'-0"

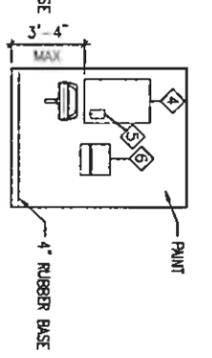

3 INTERIOR ELEVATION EAST  
A2.3 1/4" = 1'-0"

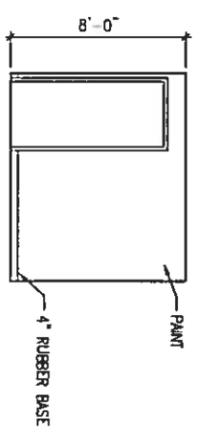

4 INTERIOR ELEVATION SOUTH  
A2.3 1/4" = 1'-0"

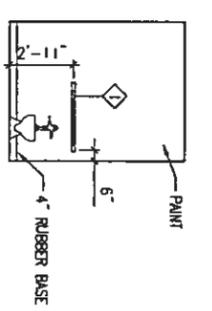


5 INTERIOR ELEVATION WEST  
A2.3 1/4" = 1'-0"

**FIGURE NOTES:**

1. PROVIDE 2x BLOCKING FOR ALL PLUMBING FIXTURES & ACCESSORIES.
2. COORDINATE FINAL LOCATION AND MOUNTING HEIGHT OF ALL TOILET ROOM FIXTURES AND ACCESSORIES WITH OWNERS REPRESENTATIVE.
3. PROVIDE HOT WATER AND DRAIN PIPE INSULATION ON ALL LAUNDREY COORDINATE INSULATION TYPE AND WASHABLE COVER WITH MECHANICAL.

**FIGURE SCHEDULE**

- 1 GRAB BAR 36"
- 2 GRAB BAR 42"
- 3 TOILET PAPER HOLDER (24" MIN. FROM FLOOR TO BOTTOM)
- 4 MIRROR 24" W. x 36" H.
- 5 SOAP DISPENSER
- 6 PAPER TOWEL DISPENSER

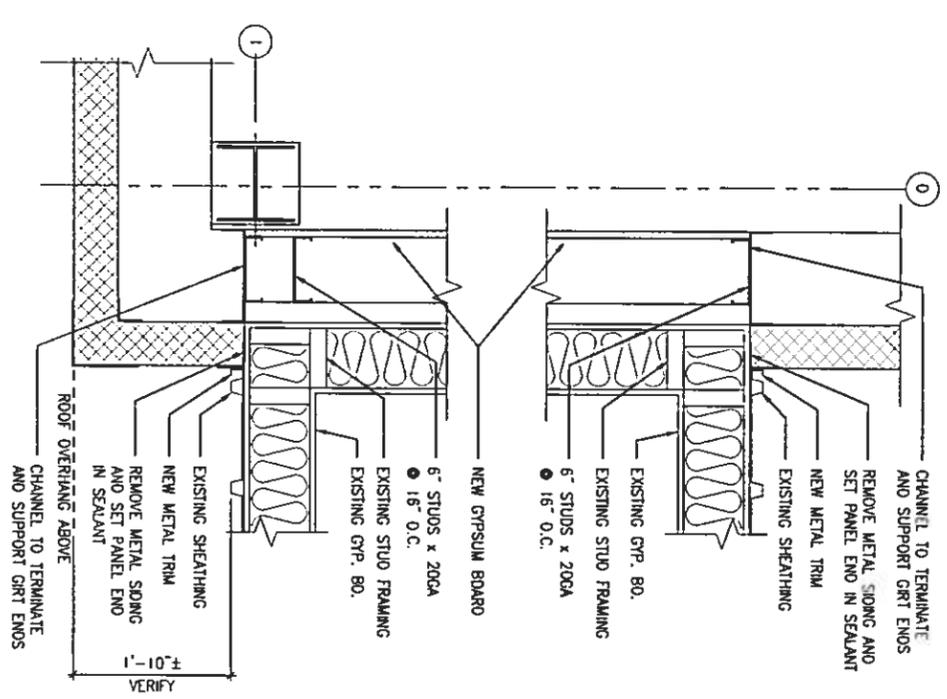

6 EXTERIOR CORNERS  
A2.3 1 1/2" = 1'-0"

RECORD DRAWINGS

THIS RECORD DRAWING HAS BEEN PREPARED FROM CONTRACTOR PROVIDED INFORMATION. GDM INC. DOES NOT GUARANTEE THE ACCURACY OF THIS INFORMATION AND ASSUMES NO LIABILITY FOR ERRORS OR OMISSIONS IN THESE DRAWINGS.

**GDM inc.**  
ARCHITECTURE • PLANNING










CAMP CARROLL, JBER  
BUILDING #57226  
ADDITION

ENLARGED FLOOR PLAN  
AND DETAILS

JOB NO. 13015  
**A2.3**  
DATE: 13 OCT 2014

THIS DRAWING MEASURES 34"x22" AT FULL SCALE

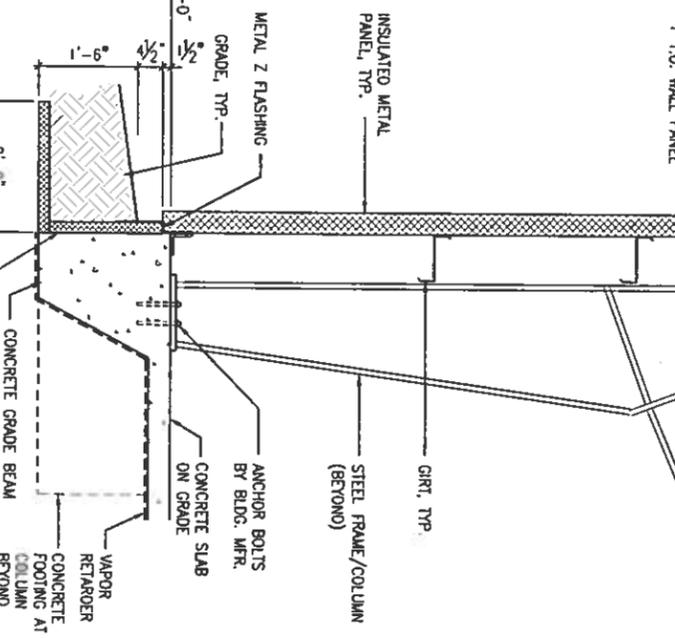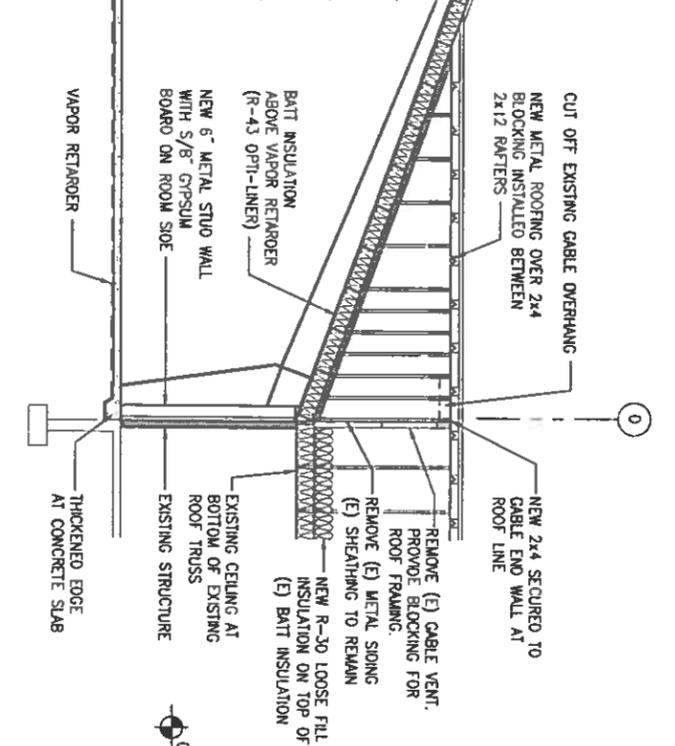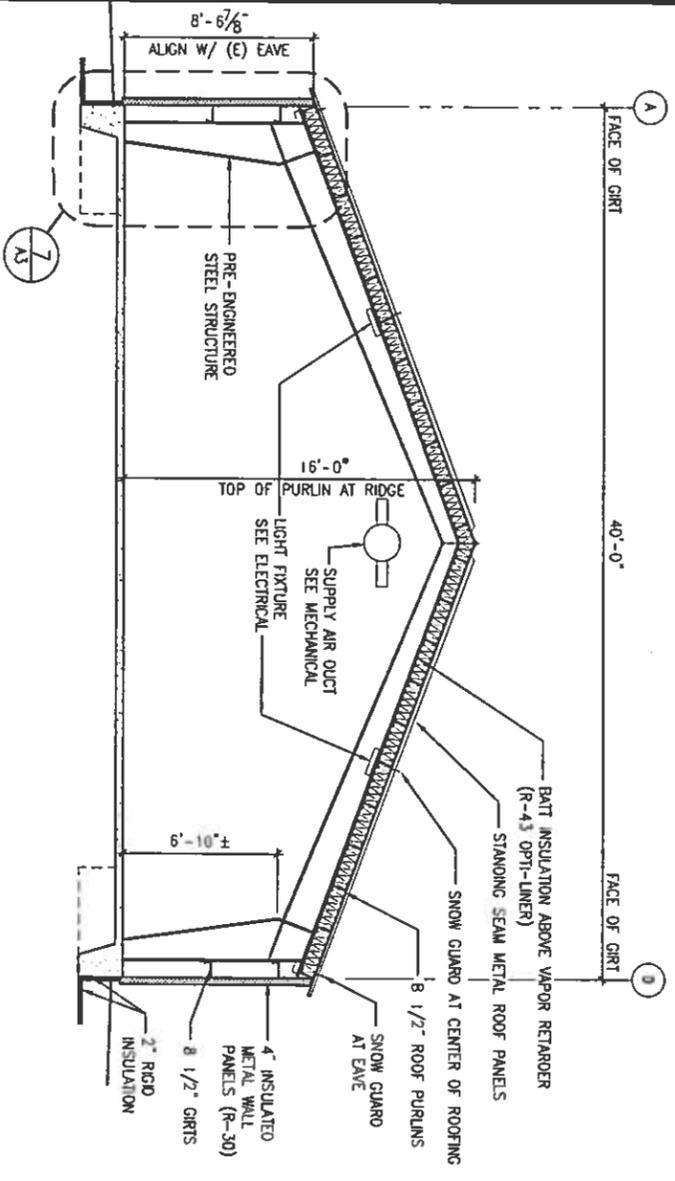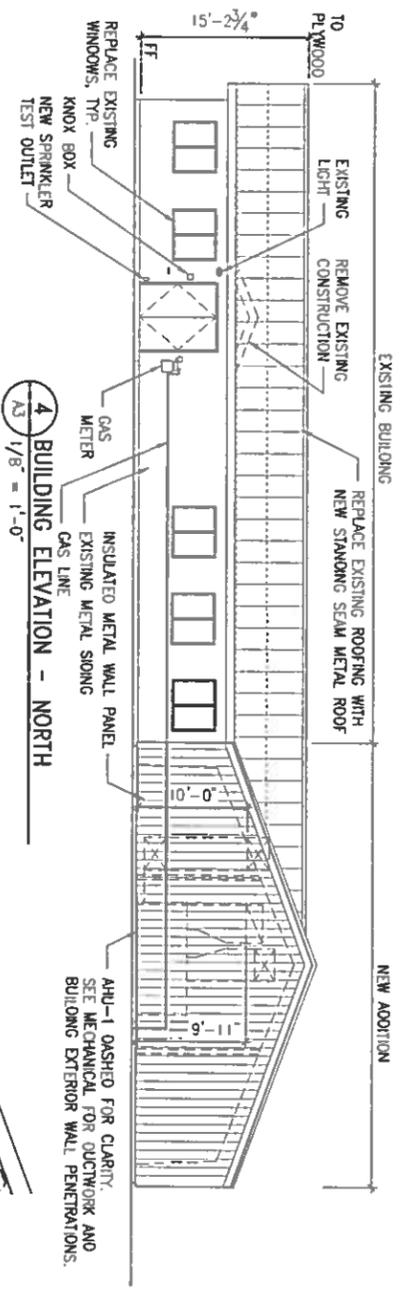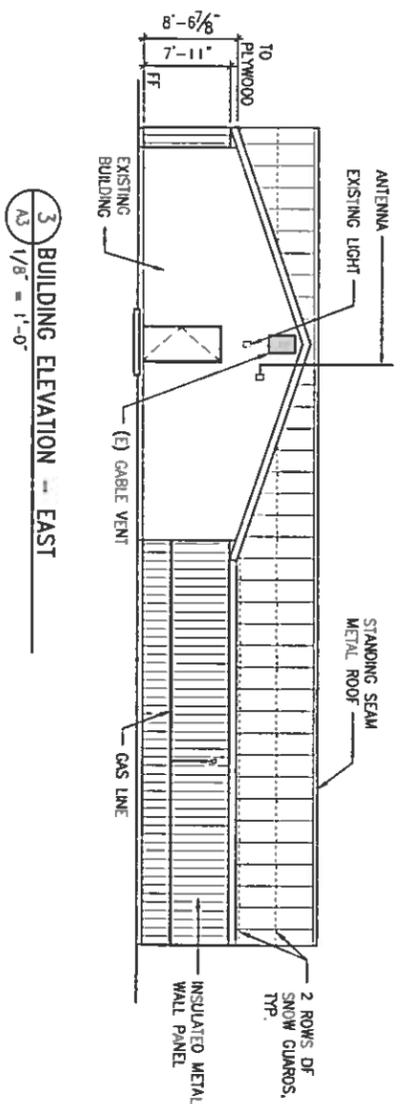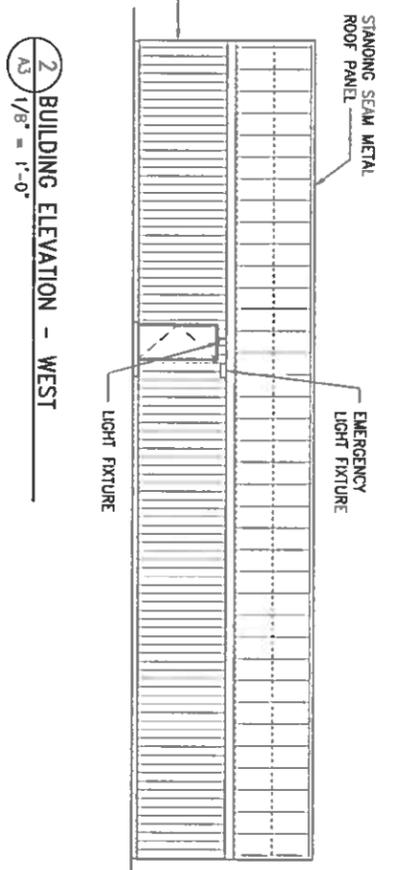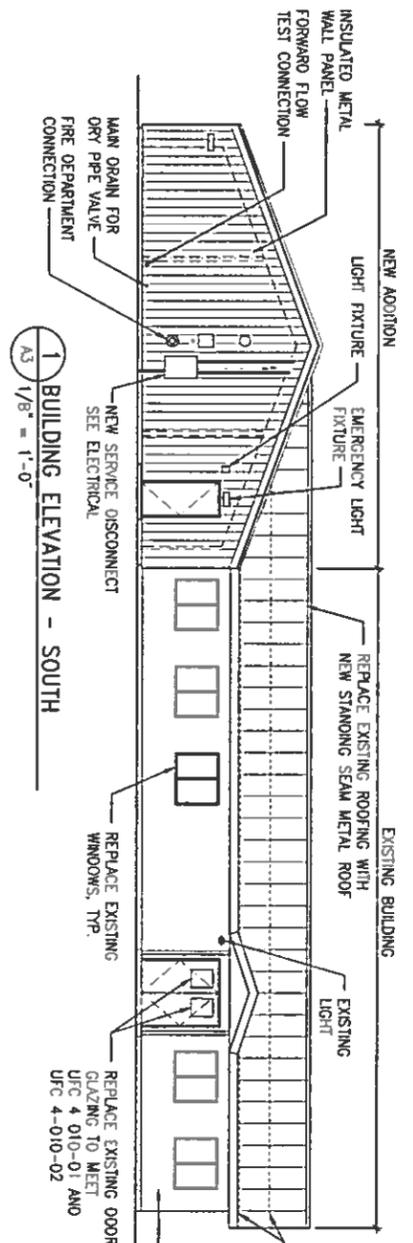

5 BUILDING SECTION  
A3 1/4" = 1'-0"

6 PARTIAL BUILDING SECTION  
A3 1/4" = 1'-0"

7 WALL SECTION  
A3 3/4" = 1'-0"

RECORD DRAWINGS

DATE 13 OCT 2014 <b>A3</b> JOB NO. 13015	<b>EXTERIOR ELEVATIONS AND SECTIONS</b>	<b>CAMP CARROLL, JBER</b> BUILDING #57226 ADDITION			THIS RECORD DRAWING HAS BEEN PREPARED FROM CONTRACTOR FURNISHED INFORMATION. GDM INC. DOES NOT ASSUME LIABILITY FOR ERRORS OR OMISSIONS IN THIS DRAWING.
--	---	--	--	--	--

**ROOM FINISH SCHEDULE**

ROOM NO.	ROOM NAME	FLOOR	BASE	WALLS				CEILING HEIGHT	CEILING	REMARKS
				NORTH	EAST	SOUTH	WEST			
100	BEDROOM	CP	RB	GB/PT	GB/PT	GB/PT	GB/PT	8'-0"	GB/PT	
101	BEDROOM	CP	RB	GB/PT	GB/PT	GB/PT	GB/PT	8'-0"	GB/PT	
102	BEDROOM	CP	RB	GB/PT	GB/PT	GB/PT	GB/PT	8'-0"	GB/PT	
103	BEDROOM	CP	RB	GB/PT	GB/PT	GB/PT	GB/PT	8'-0"	GB/PT	
104	BEDROOM	CP	RB	GB/PT	GB/PT	GB/PT	GB/PT	8'-0"	GB/PT	
105	BEDROOM	CP	RB	GB/PT	GB/PT	GB/PT	GB/PT	8'-0"	GB/PT	
106	BEDROOM	CP	RB	GB/PT	GB/PT	GB/PT	GB/PT	8'-0"	GB/PT	
107	BEDROOM	CP	RB	GB/PT	GB/PT	GB/PT	GB/PT	8'-0"	GB/PT	
108	BEDROOM	CP	RB	GB/PT	GB/PT	GB/PT	GB/PT	8'-0"	GB/PT	
109	BEDROOM	CP	RB	GB/PT	GB/PT	GB/PT	GB/PT	8'-0"	GB/PT	
110	WEN	SV	RB	GB/PT	GB/PT	GB/PT	GB/PT	8'-0"	GB/PT	
111	WOMEN	SV	RB	GB/PT	GB/PT	GB/PT	GB/PT	8'-0"	GB/PT	
112	MECH	EX	-	EX	EX	EX	EX	8'-0"	GB	
113	VESTIBULE	SV	RB	GB/PT	GB/PT	GB/PT	GB/PT	8'-0"	GB/PT	
114	ENTRY	SV	RB	GB/PT	GB/PT	GB/PT	GB/PT	8'-0"	GB/PT	
115	HALL	CP	RB	GB/PT	GB/PT	GB/PT	GB/PT	8'-0"	GB/PT	

**NEW ADDITION**

ROOM NO.	ROOM NAME	FLOOR	BASE	WALLS				CEILING HEIGHT	CEILING	REMARKS
				NORTH	EAST	SOUTH	WEST			
116	BARRACKS	SC	-	-	-	-	-	VARIES	-	
117	TOILET	SC	RB	GB/PT	GB/PT	GB/PT	GB/PT	8'-0"	GB/PT	

**LEGEND:**

- CP CARPET
- PT PAINT
- GB GYPSUM BOARD
- RB RUBBER BASE
- SC SEALED CONCRETE
- SV SHEET VINYL
- EX EXISTING
- (E) NO FINISH

**MATERIALS / COLORS**

- ANTERIOR OODORS: EXISTING
- PT-1: TO MATCH ICI WHITE WHISPER
- CARPET: MILIKEN CARPET TILES, COLOR - TO BE SELECTED
- BASE: BURKE - COLOR TO BE SELECTED
- SHEET VINYL: MANUFACTURER - COLOR TO BE SELECTED
- EXTERIOR METAL PANELS: KINGSPAN 4" INSULATED WALL PANELS  
COLOR: BEIGE TO MATCH EXISTING BUILDING
- METAL ROOFING: VARCO PRUDEN STANDING SEAM SSR - DARK BROWN
- METAL FLASHING: MATCH NEW ROOFING COLOR
- EXTERIOR OODORS: PAINT OUTSIDE OF DOOR TO MATCH EXISTING  
EXTERIOR OODORS. PAINT INTERIOR OODOR FACES TO MATCH PT-1.
- EXTERIOR OODOR FRAMES: PAINT EXTERIOR SIDE OF FRAME TO MATCH EXISTING.  
PAINT INTERIOR FACE OF FRAME TO MATCH PT-1.


**NOTES:**

1. GYPSUM BOARD (GB) CALLED OUT IN THE SCHEDULE IS EXISTING EXCEPT WHERE PATCHING IS REQUIRED.
2. ALL INTERIOR FINISHES ARE NEW.

**DOOR SCHEDULE**

DOOR NO.	SIZE	DOOR TYPE	DOOR FINISH	FRAME TYPE	FRAME FINISH	HDW.	U.L.	HEAD	JAMB	THRESHOLD	REMARKS
116A	3'-0"x7'-0"	1	PAINT	A	PAINT	H01	-	-	-	-	BY METAL BUILDING MANUFACTURER
116B	3'-0"x7'-0"	1	PAINT	A	PAINT	H01	-	-	-	-	BY METAL BUILDING MANUFACTURER
117	3'-0"x7'-0"	2	CLEAR	B	PAINT	H02	-	-	-	-	BY METAL BUILDING MANUFACTURER

**DOOR TYPES**

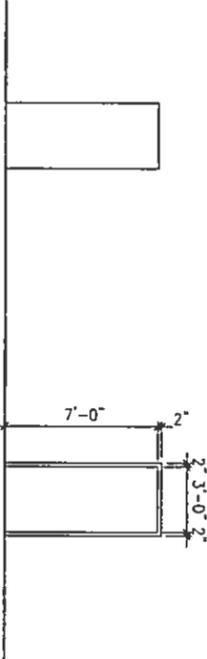

1. INSULATED HOLLOW METAL, BLAST RESISTANT
2. SOLID CORE WOOD


**FRAME TYPES**

- A. INSULATED HOLLOW METAL FRAME
- B. HOLLOW METAL FRAME

**NOTES**

1. ALL EXTERIOR DOOR FRAMES SHALL BE FIELD INSULATED.
2. ALL EXTERIOR DOORS SHALL BE PROVIDED WITH THRESHOLDS.

**WINDOW TYPES**

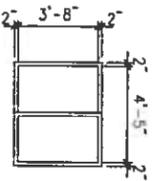

1. REPLACEMENT ALUMINUM FRAME OPERABLE WINDOW TO MEET SLEEPING ROOM EGRESS REQUIREMENTS

ISSUED FOR CONSTRUCTION



**GDM inc.**  
ARCHITECTURE • PLANNING



**CAMP CARROLL, JBER**  
BUILDING #57226  
ADDITION

SCHEDULES  
DOOR & WINDOW TYPES



JOB NO. 13015

**A4**


DATE: 14 APRIL 2014








1 CONTROL JOINT DETAIL  
Scale: 1/2" = 1'-0"

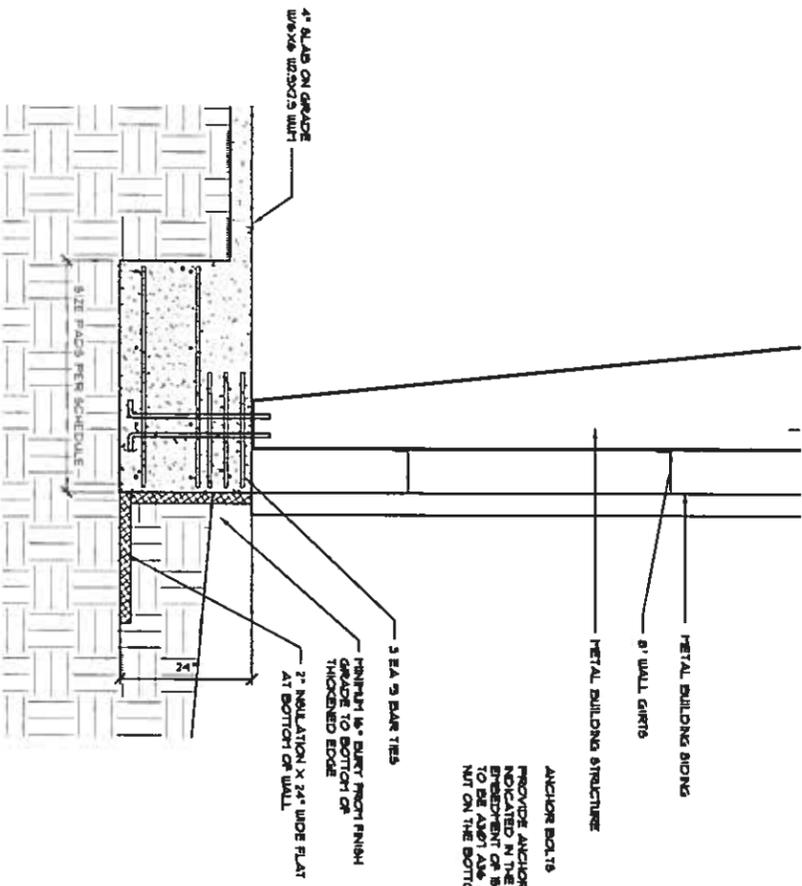

2 Typical Pilaster Detail  
Scale: 1/2" = 1'-0"

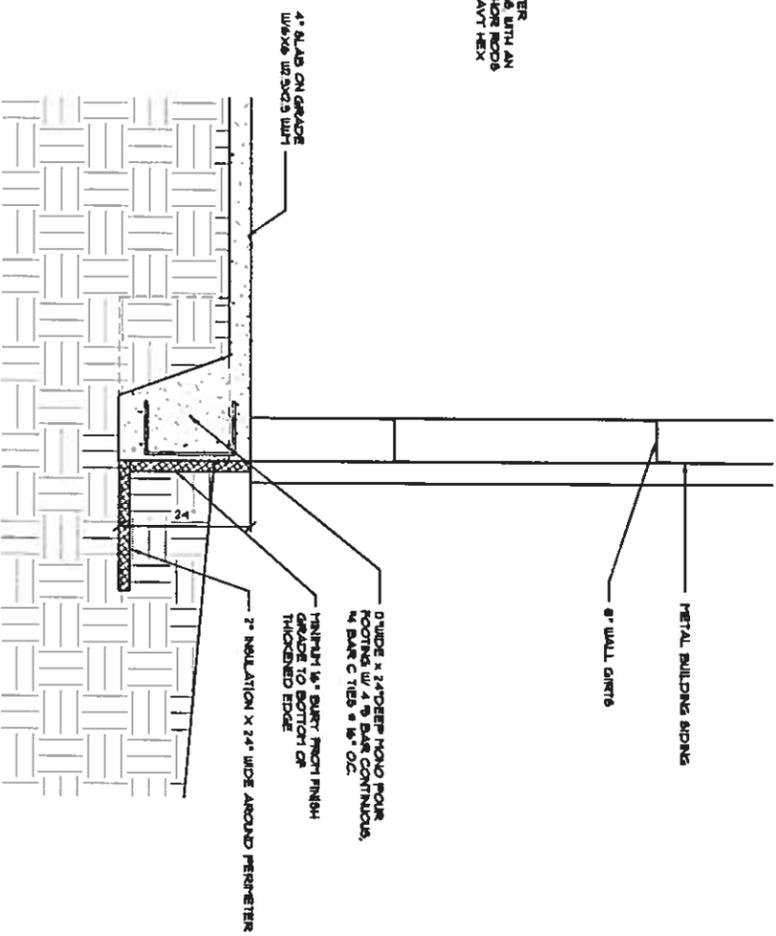

3 Typical Endwall/Grade Beam Detail  
Scale: 1/2" = 1'-0"

ANCHOR BOLTS  
PROVIDE ANCHOR BOLTS IN THE DIAMETER  
INDICATED IN THE FOUNDATION DRAWINGS WITH AN  
ELECTROLYTICALLY APPLIED ZINC RICH PAINT TO BE  
APPLIED TO ALL TREADS WITH A BAYT HEX  
NUT ON THE BOTTOM.

**AS-BUILT**  
THESE AS-BUILT DRAWINGS WERE PRODUCED  
FROM INFORMATION PROVIDED BY THE  
CONTRACTOR. OIEN ASSOCIATES INC. HAS NO  
RESPONSIBILITY FOR THE ACCURACY OF  
THESE AS-BUILTS

JOB NO. 32523  
**S2.1**  
DATE: 10 OCT 2014

FOUNDATION DETAILS

CAMP CARROLL, JBER  
BUILDING #57226  
ADDITION

Oien Associates, Inc.  
Construction Management Engineering Inspections  
1627 Henson Drive Eagle River, AK 99571  
Phone: (907) 694-0907  
Fax: (907) 694-0908  
email: bolting@oien.com

**GDM inc.**  
ARCHITECTURE • PLANNING

LEGEND	DUCTWORK LEGEND	LOGIC	ABBREVIATIONS	DIA	MFG	MANUFACTURER
WASTE VENT PIPING COLD WATER HOT WATER SEE ABBREVIATIONS FOR MEDIA PIPE UP PIPE DOWN TEE UP TEE DOWN CAP UNION DIRECTION OF FLOW BALL VALVE CHECK VALVE GAS SHUT-OFF VALVE PRESSURE/TEMPERATURE RELIEF VALVE CLEANOUT FLOOR CLEANOUT FLOOR DRAIN	EXHAUST AIR UP & DOWN SUPPLY AIR UP & DOWN RETURN AIR UP & DOWN ROUND DUCT UP & DOWN VOLUME DAMPER TURNING VANES DUCT SIZE (1ST FIGURE - SIDE SHOWN) (2ND FIGURE - SIDE NOT SHOWN) FLEXIBLE DUCT THERMOSTAT	3 5 W2 TAG CONNECTION - NECK SIZE CFM DIEFFUSER OR GRILLE TYPE	ADA AMERICAN WITH DISABILITIES ACT GUIDELINES AFG ABOVE FINISHED GRADE AAPS APERTURES AHL-X AIR HANDLING UNIT DESIGNATOR ARCH ARCHITECTURAL BDD BACKDRAFT DAMPER BTUH BRITISH THERMAL UNIT/HOUR C/A COMBUSTION AIR CFM CUBIC FEET PER MINUTE CU COPPER CW COLD WATER DEG DEGREE	DWG DRAWING DIA DIAMETER E/A EXHAUST AIR EAT ENTERING AIR TEMPERATURE EIT ENTERING GYODL TEMPERATURE EF-X EXHAUST FAN DESIGNATOR ESP EXTERNAL STATIC PRESSURE EZH EXHAUST F FAN/HEMET FOD FLOOR CLEAN OUT FD-X FIRE DAMPER FPM FEET PER MINUTE FT FEET G GALLONS GAL GALLONS PER HOUR GPH GALLONS PER HOUR HD HEAD HP HORSEPOWER HW HOT WATER IBC INTERNATIONAL BUILDING CODE IN INCHES LAI LEAVING AIR TEMPERATURE	MFG MANUFACTURER MTH THOUSAND BTUH NC NOISE CRITERIA NIS NOT TO SCALE D/A OUTSIDE AIR P-X PLUMBING FIXTURE DESIGNATOR PO PHASE PSI POUNDS PER SQUARE INCH RPM ROTATIONS PER MINUTE S/A SUPPLY AIR SP STATIC PRESSURE TSP TOTAL STATIC PRESSURE TYP TYPICAL UNIFORM PLUMBING CODE V VELOCITY VEL VELOCITY VTR VENT THRU ROOF W WASTE WCD WATER COLUMN WCD WALL CLEAN OUT WC WATER GAUGE WPA WATER HAMMER ARRESTOR WPD WATER PRESSURE DROP YCO YARD CLEAN OUT	

WHA SCHEDULE	
SYMBOL	SIZE
WHA-A	1/2"
WHA-B	3/4"
WHA-C	1"
	FIXTURE UNITS
	1-11
	12-32
	33-60

**PLUMBING FIXTURE SCHEDULE**

SYMBOL	FIXTURE	LOCATION	CM	HM/TW	WASTE	VENT	TRAP	BASE	OF DESIGN	MODEL	COLOR	TRIM/REMARKS
P-1	WATER CLOSET-ADA	FLOOR	1	---	3	2	---	KOHLER	K-368	HIGHCLIFF	WHITE	KOHLER K-4670-C ELONGATED OPEN FRONT SEAT, TOP INLET, SLOAN ROYAL 111-L-6 FLUSH VALVE, 1.6 GPF.
P-1A	WATER CLOSET-ADA	FLOOR	---	---	3	---	---	KOHLER	K-368	HIGHCLIFF	WHITE	ROUGH IN UNDERFLOOR WASTE PIPING AS INDICATED ON PLANS.
P-2	WATER CLOSET	FLOOR	---	---	3	---	---	FUTURE	---	---	---	ROUGH IN UNDERFLOOR WASTE PIPING AS INDICATED ON PLANS.
P-2A	LAVATORY-ADA	WALL	1/2	1/2	2	1-1/2	1-1/4	KOHLER	K-2005-K	INSTON	WHITE	DELTA FACET MODEL # 22C01 WITH METAL GRID STRAINER, 0.5 GPM FLOW RATE, TRU-BRO LAVATORY SHIELD, OFFSET P-TRAP FOR ADA COMPLIANCE. PROVIDE POINT OF USE TEMPERING VALVE.
P-3	URINAL	WALL	---	---	2	---	---	FUTURE	---	---	---	ROUGH IN UNDERFLOOR WASTE PIPING AS INDICATED ON PLANS.
P-4	SHOWER	FLOOR	---	---	2	---	---	FUTURE	---	---	---	ROUGH IN UNDERFLOOR WASTE PIPING AS INDICATED ON PLANS.
P-4A	SHOWER	FLOOR	---	---	2	---	---	FUTURE	---	---	---	ROUGH IN UNDERFLOOR WASTE PIPING AS INDICATED ON PLANS.
P-5	SERVICE SINK	FLOOR	---	---	3	---	---	FUTURE	---	---	---	ROUGH IN UNDERFLOOR WASTE PIPING AS INDICATED ON PLANS.
WB-1	WASHER BOX	WALL	---	---	2	---	---	FUTURE	---	---	---	ROUGH IN UNDERFLOOR WASTE PIPING AS INDICATED ON PLANS.
FD-1	FLOOR DRAIN	FLOOR	---	---	2	---	---	J.R. SMITH	2005-A	---	---	ROUND TOP TRAP PRIOR CONNECTION.
FD-1A	FLOOR DRAIN	FLOOR	---	---	2	---	---	J.R. SMITH	2005-A	---	---	ROUGH IN UNDERFLOOR WASTE PIPING AS INDICATED ON PLANS.

**ELECTRIC WATER HEATER SCHEDULE**

SYMBOL	MFG/MODEL	TYPE	POWER DATA	REMARKS
EMH-1	EEMAX/SP2412	ELEC	VOLTS 2400 AMP/PH 12.4	POINT OF USE WATER HEATER, HARDWARE CONNECTION.

**GAS FIRED PACKAGED UNIT SCHEDULE**

SYMBOL	MFG/MODEL	TONNAGE	LOCATION	AREA SERVED	EER (IEER)	COOLING CAPACITY (EMB EDB TOTAL MBH)	HEATING INPUT (MBH)	HEATING CFM	BLOWER ESP (IN. WC)	FAN RPM	INDOOR HP (LBS)	WEIGHT (LBS)	ELECTRICAL MCA	VOLTS	PHASE	REMARKS
AHL-1	TRANE/VSC092F	7.5	GROUND	BUILDING	13.00	62 75 93	200	3000	1.0	903	1.0	47.0	45.10	208	3	PROVIDE 7-DAY PROGRAMMABLE T-STAT W/ ECONOMIZER CONTROL. STANDARD EFFICIENCY UNIT. SEE NOTES BELOW. PROVIDE SINGLE POINT ELECTRICAL CONNECTION.

NOTES:  
 1. PROVIDE WITH HIGH GAS HEAT OPTION.  
 2. PROVIDE WITH ECONOMIZER, FREESTAT, CIRCUIT BREAKER, RETURN AIR SMOKE DETECTOR, THRU THE BASE ELECTRICAL.  
 3. UNITS OVER 2000 CFM SHALL INCLUDE SMOKE DETECTOR AND AUDIO VISUAL ALARM IN OCCUPIED SPACE. DETECTOR AND ALARM TO BE PROVIDED AND INSTALLED BY ELECTRICAL CONTRACTOR AND WIRING BY ELECTRICAL CONTRACTOR. MECHANICAL CONTRACTOR TO COORDINATE SMOKE DETECTOR AND AUDIO VISUAL ALARM LOCATION WITH ELECTRICAL CONTRACTOR PRIOR TO INSTALLATION.

**FAN SCHEDULE**

SYMBOL	MFG/MODEL	TYPE	SERVICE	CFM	ESP (IN. WC)	RPM	WATTAGE (W)	ORIVE	REMARKS
ET-1	COOK/DC-720	CENTING	RESTROOMS	350	0.50	1085	136	120/1	DIRECT FAN SPEED CONTROLLER. PROVIDE GOOSENECK TERMINATION.

**AIR INLET/OUTLET SCHEDULE**

SYMBOL	MFG/MODEL	TYPE	USE	MATERIAL	FINISH	CFM	FACE SIZE (IN)	HC	TROW	REMARKS
A	111US/DL-	DRUM LOUVER	S/A	STEEL	---	PER PLANS	18x6	<20	33 FT	DUCT MOUNTED EXPOSED DRUM LOUVER.
B	111US/300RL	SIDEWALL	S/A	STEEL	---	PER PLANS	---	<20	---	---
C	111US/350RL	SIDEWALL	R/A	STEEL	---	PER PLANS	38x14	<20	---	---

**PROJECT RECORD DRAWINGS**  
 THESE DRAWINGS HAVE BEEN PREPARED FROM INFORMATION FURNISHED BY THE GENERAL CONTRACTOR. THERE IS ABSOLUTELY NO GUARANTEE AS TO THE ACCURACY OF THE INFORMATION CONTAINED HEREIN, EITHER EXPRESSED OR IMPLIED.

**CAMP CARROLL, JBER**  
 BUILDING #57226  
 ADDITION

**MECHANICAL LEGEND AND SCHEDULES**

**RSA Engineering, Inc.**  
 MECHANICAL AND ELECTRICAL CONSULTING ENGINEERS  
 2024 South 20th Street, Suite 200, Las Vegas, NV 89102  
 Phone: (702) 735-7700 Fax: (702) 735-7701

**H. WATT AND SCOTT CONTRACTORS**

JOB NO. 13238  
 OR: SR  
 CK: JAB  
**MO.1**  
 DATE: 15 APR 2014

**GENERAL NOTES**

PLANS - THE CONTRACTOR SHALL PROVIDE ALL MATERIALS AND LABOR NECESSARY FOR A COMPLETE AND OPERABLE SYSTEM. THE DRAWINGS ARE PARTLY DIAGRAMMATIC, NOT NECESSARILY SHOWING ALL CONTRACTOR TO COORDINATE EQUIPMENT LOCATION WITH ELECTRICAL PLANS TO AVOID CONFLICT.

COMPLETE PROJECT - THE INTENT OF THIS PROJECT IS TO LET ONE CONTRACT WHICH INCLUDES ALL WORK REQUIRED FOR A COMPLETE JOB. THIS INCLUDES ALL ELECTRICAL, CARPENTRY, PLUMBING, SHEET METAL, PAINTING, CLEAN UP, ETC. AS REQUIRED.

CODE - ALL WORK SHALL BE DONE IN ACCORDANCE WITH THE LATEST ADOPTED EDITION OF THE INTERNATIONAL BUILDING CODE (IBC), INTERNATIONAL MECHANICAL CODE (IMC), INTERNATIONAL PLUMBING CODE (IPC) AND NATIONAL ELECTRICAL CODE (NEC) CODE (IBC), AS AMENDED BY THE STATE OF ALASKA.

WARRANTY - ALL WORK PERFORMED UNDER THIS CONTRACT TO BE FREE FROM DEFECTS IN MATERIALS OR WORKMANSHIP FOR A PERIOD OF ONE YEAR FROM ACCEPTANCE. ANY FAULTY MATERIALS OR WORKMANSHIP SHALL BE REPAIRED OR REPLACED TO THE SATISFACTION OF THE OWNER DURING THE GUARANTEE PERIOD.

ELECTRICAL WORK - ALL ELECTRICAL WORK IS TO BE PERFORMED BY A LICENSED ELECTRICIAN.

EQUIPMENT SUBSTITUTIONS - ALL EQUIPMENT LISTED IS REPRESENTATIVE OF THE STANDARD SIZE, WEIGHT AND QUALITY OF EQUAL. SUBSTITUTIONS WILL BE CONSIDERED IF THE SUBSTITUTES ARE SHOWN TO BE EQUAL OR BETTER QUALITY, INCLUDING EFFICIENCY OF PERFORMANCE, AS ACCEPTED BY THE OWNER.

MATERIALS - ALL MATERIALS SHALL BE NEW AND UNUSED, INSTALLED IN ACCORDANCE WITH THE MANUFACTURER'S DIRECTIONS AND IN THE BEST PRACTICE OF THE CRAFT. OBTAIN OWNER'S APPROVAL OF ALL PRODUCTS PRIOR TO ORDERING OR INSTALLING ANY PART OF ANY SYSTEM.

OPERATION AND MAINTENANCE MANUAL - PROVIDE THE OWNER WITH AN OPERATING AND MAINTENANCE MANUAL. TO INCLUDE MANUFACTURER'S SPECIFICATIONS, OPERATING AND MAINTENANCE INSTRUCTIONS, WARRANTY INFORMATION ON EACH PIECE OF EQUIPMENT, AND MECHANICAL DIAGRAMS OF CONTROL SYSTEMS AS-BUILT, AS WELL AS A SOURCE OF SUPPLY FOR SPARE PARTS AND SERVICE.

ACCESS - PROVIDE WORKABLE ACCESS TO ALL SERVICEABLE AND/OR OPERABLE EQUIPMENT.

EQUIPMENT INSTALLATION: INSTALL ALL EQUIPMENT WHERE NOTED ON THE DRAWINGS IN ACCORDANCE WITH THE MANUFACTURER'S INSTRUCTIONS. PROVIDE MISCELLANEOUS APPURTENANCES, ACCESSORIES, SUPPORTS AND CONTROL CONNECTIONS REQUIRED FOR COMPLETE AND OPERATING SYSTEMS. MAINTAIN MANUFACTURER'S RECOMMENDED SERVICE CLEARANCES.

BALANCE - THE CONTRACTOR SHALL BALANCE THE AIR SYSTEM TO THE SATISFACTION OF THE OWNER. AIRFLOWS ARE TO BE BALANCED TO WITHIN 10% OF INDICATED FLOWS PER AISC RECOMMENDED METHODS.

SEISMIC RESTRAINT - ALL EQUIPMENT INSTALLED UNDER THIS PROJECT SHALL BE BRACED FOR A SEISMIC EVENT IN ACCORDANCE WITH THE 2009 EDITION OF THE INTERNATIONAL BUILDING CODE. CONTRACTOR TO PROVIDE SEISMIC CALCULATIONS AND SHOP DRAWINGS PREPARED AND SEALED BY A STRUCTURAL ENGINEER TO THE AUTHORITY HAVING JURISDICTION FOR REVIEW AND APPROVAL.

**PIPING**

BURIED WASTE AND VENT PIPING - ABS PIPE: ASTM D2751. FITTINGS: ABS. JOINTS: ASTM D2225, SOLVENT WELD.

ABOVE GRADE WASTE AND VENT PIPING: ABS PIPE: ASTM D2751. FITTINGS: ABS. JOINTS: ASTM D2225. SOLVENT WELD WHERE LOCATED IN A RETURN AIR PLENUM UTILIZE CAST IRON OR COPPER DWY MATERIAL.

DOMESTIC WATER PIPING BURIED - COPPER TUBING: ASTM B42, TYPE K ANNEALED. FITTINGS: ASME B16.22, WROUGHT COPPER. JOINTS: ASTM B32, SOLDER, GRADE 951A; FLUX: ASTM B813.

DOMESTIC WATER PIPING EXPOSED ABOVE GROUND - COPPER TUBING: ASTM B88, TYPE L, HARD DRAWN. FITTINGS: ASME B16.18 CAST BRONZE OR ASME B16.22 WROUGHT COPPER. JOINTS: ASTM B32, LEAD FREE SOLDER, WATER SOLUBLE FLUX.

NATURAL GAS PIPING ABOVE GRADE - STEEL PIPE: ASTM A53, SCHEDULE 40 BLACK. FITTINGS: ASME B16. MALLEABLE IRON, OR ASTM A 234/A234M, FORGED STEEL WELDING TYPE JOINTS: NFPA 54, SCREWED FOR PIPE 2 INCHES AND UNDER AND IF LOW PRESSURE. DR IF MEDIUM PRESSURE AND OUTSIDE BUILDING: ANSI B31.1, WELDED FOR PIPE OVER 2 INCHES.

PIPING SUPPORTS AND HANGERS - SIZED AND SPACED IN ACCORDANCE WITH THE UPC. INSTALLED AS PER THE MANUFACTURER'S INSTRUCTIONS.

**VALVES AND UNIONS ETC.**

BALL VALVES - UP TO 2 INCHES: CLASS 150, BRONZE TWO PIECE BODY, FULL PORT, FORGED BRASS CHROME PLATED BALL, TEFLON SEALS AND STUFFING BOX RING, BLOW-OUT PROOF STEM, LEVER HANDLE, SOLDER OR THREADED ENDS.

SPRING LOADED CHECK VALVES - IRON BODY, BRONZE TRIM, STAINLESS STEEL SPRING, REMOVABLE COMPRESSOR DISC, SCREWED, WATER OR FLANGED ENDS.

DELECTRIC CONNECTIONS: UNION WITH GALVANIZED OR PLATED STEEL THREADED END, COPPER SOLDER END, WATER IMPERVIOUS ISOLATION BARBER CLEAR FLOW PRODUCTS ALLOWED.

FLANGES, UNIONS, AND COUPLINGS - 150 PSIG MALLEABLE IRON UNIONS FOR THREADED FERROUS PIPING, BRONZE UNIONS FOR COPPER PIPE, SOLDERED JOINTS.

GAS ISOLATION VALVE - UP TO 2 INCHES: BRONZE TWO PIECE BODY, FULL PORT, FORGED BRASS, CHROME PLATED BALL, TEFLON SEALS AND STUFFING BOX RING, LEVER HANDLE, THREADED ENDS, AGA LISTED.

**INSULATION**

PIPING: TYPE A: GLASS FIBER, RIGID, MOULED, NON-COMBUSTIBLE INSULATION; ANSI/ASTM C547. 'K' VALUE OF 0.24 AT 750 DEG F, RATED TO 950 DEG F, VAPOR BARRIER JACKET OF KRAFT PAPER BONDED TO ALUMINUM FOL. JOHNS-MANVILLE "MICRO-LOW" OR EQUAL.

PIPE	TYPE	SIZE, IN	INSULATION THICKNESS, IN
DOMESTIC WATER	A	ALL SIZES	1"
PLUMBING VENT THROUGH ROOF	A	ALL SIZES	1"
PIPING EXPOSED TO FREEZING	A	ALL SIZES	2"
BURIED PIPING	A	ALL SIZES	1"

VAPOR BARRIER JACKETS - KRAFT REINFORCED FOL VAPOR BARRIER WITH SELF SEALING ADHESIVE JOINTS.

DUCT INSULATION: TYPE B: EXTERIOR FSK DUCT WRAP; FLEXIBLE GLASS FIBER; ANSI/ASTM/C552; COMMERCIAL GRADE; K-VALUE OF 0.27 AT 75 DEG F; RIGID FIBER BOARD; ANSI/ASTM C612. K VALUE OF 0.24 AT 75 DEG F; 0.00035 INCH FOL SCRM FACING; JOHNS-MANVILLE "MICROULITE" CERTAINATED 7# BOARD OR EQUAL.

TYPE C: DUCT UNER; FLEXIBLE GLASS FIBER; ANSI/ASTM C1071. 'K' VALUE OF 0.24 AT 75 F. COATED AIR SIDE FOR MAXIMUM 5,000 FT/MIN. AIR VELOCITY. UL LISTED ADHESIVE GALVANIZED STEEL FMS; JOHNS-MANVILLE "PERMACOTE UNACOUSTIC" OR APPROVED EQUAL.

DUCTWORK	TYPE	FINISH	INSULATION THICKNESS, IN
EXHAUST AND RELIEF DUCTS	B	FSK	2"
SUPPLY AND RETURN PLenums	C		2"

**IDENTIFICATION**

IDENTIFICATION - LABEL ALL EQUIPMENT WITH HEAT RESISTANT LAMINATED PLASTIC LABELS HAVING ENGRAVED LETTERING 1/2" HIGH. IF ITEMS ARE NOT SPECIFICALLY LISTED ON THE SCHEDULES, CONSULT THE ENGINEER CONCERNING DESIGNATION TO USE. SETON ENGRAVED SETON-PLY NAMEPLATES OR EQUAL. IDENTIFY PIPING TO INDICATE CONTENTS AND FLOW DIRECTION OF EACH PIPE EXPOSED TO VIEW BY A LABELED SLEEVE OR PIPE MARKER IN LETTERS READABLE FROM FLOOR AT LEAST ONCE IN EACH ROOM AND AT INTERVALS OF NOT MORE THAN 20' APART AND ON EACH SIDE OF PARTITION. PENETRATIONS: COLORING SCHEME IN ACCORDANCE WITH ANSI A13.1-1991, SETON OPTI-CODE OR EQUAL.

**DUCTWORK**

LOW PRESSURE DUCTWORK - FABRICATE AND SUPPORT IN ACCORDANCE WITH SMACNA HVAC DUCT CONSTRUCTION STANDARDS AND ASHRAE HANDBOOKS, EXCEPT AS INDICATED. PROVIDE DUCT MATERIAL, GAUGES, REINFORCING, AND SEALING FOR OPERATING PRESSURES INDICATED.

DUCTWORK - PROVIDE GALVANIZED SHEET METAL RECTANGULAR OR ROUND DUCT WHERE CALLED OUT ON THE PLANS. SEAL ALL DUCT SEAMS AND JOINTS AIRTIGHT. USE TURNING VANES IN ALL SQUARE ELBOWS AND FLAT OVAL ELBOWS. INSTALL VOLUME DAMPERS WHERE SHOWN ON THE DRAWINGS. ALL SHEET METAL WORK TO BE CONSTRUCTED, INSTALLED, TESTED AND BALANCED IN ACCORDANCE WITH SMACNA STANDARDS. SUPPORT LOW AND MEDIUM PRESSURE DUCTWORK PER SMACNA GUIDELINES. VOLUME DAMPER - FABRICATE IN ACCORDANCE WITH SMACNA HVAC DUCT CONSTRUCTION STANDARDS.

**SEQUENCE OF OPERATION**

ALL-1: DAY AND NIGHT MODE OF OPERATION WILL BE CONTROLLED BY SEVEN (7) DAY PROGRAMMABLE THERMOSTATS. THE SUPPLY FAN SHALL RUN ANYTIME THE UNIT IS COMMANDED TO RUN, UNLESS SHUTDOWN ON SAFETIES.

EE-1: FAN SHALL OPERATE BY MEANS OF A WALL MOUNTED FAN SPEED CONTROLLER.

**PROJECT RECORD DRAWINGS**

THESE DRAWINGS HAVE BEEN PREPARED FROM INFORMATION FURNISHED BY THE GENERAL CONTRACTOR. THERE IS ABSOLUTELY NO GUARANTEE AS TO THE ACCURACY OF THE INFORMATION CONTAINED HEREIN, EITHER EXPRESSED OR IMPLIED.

OR: SR  
 CK: JAB

MECHANICAL SPECIFICATIONS

CAMP CARROLL, JBER  
 BUILDING #57226  
 ADDITION




**RSA Engineering, Inc.**  
 MECHANICAL AND ELECTRICAL CONSULTING ENGINEERS  
 202 Acad Building, Suite 202  
 Anchorage, Alaska 99501 (907) 274-0271

DATE: 15 APR 2014

JOB NO. 13236


**M0.2**

**1** UNDER FLOOR PLUMBING PLAN  
1/8" = 1'-0"

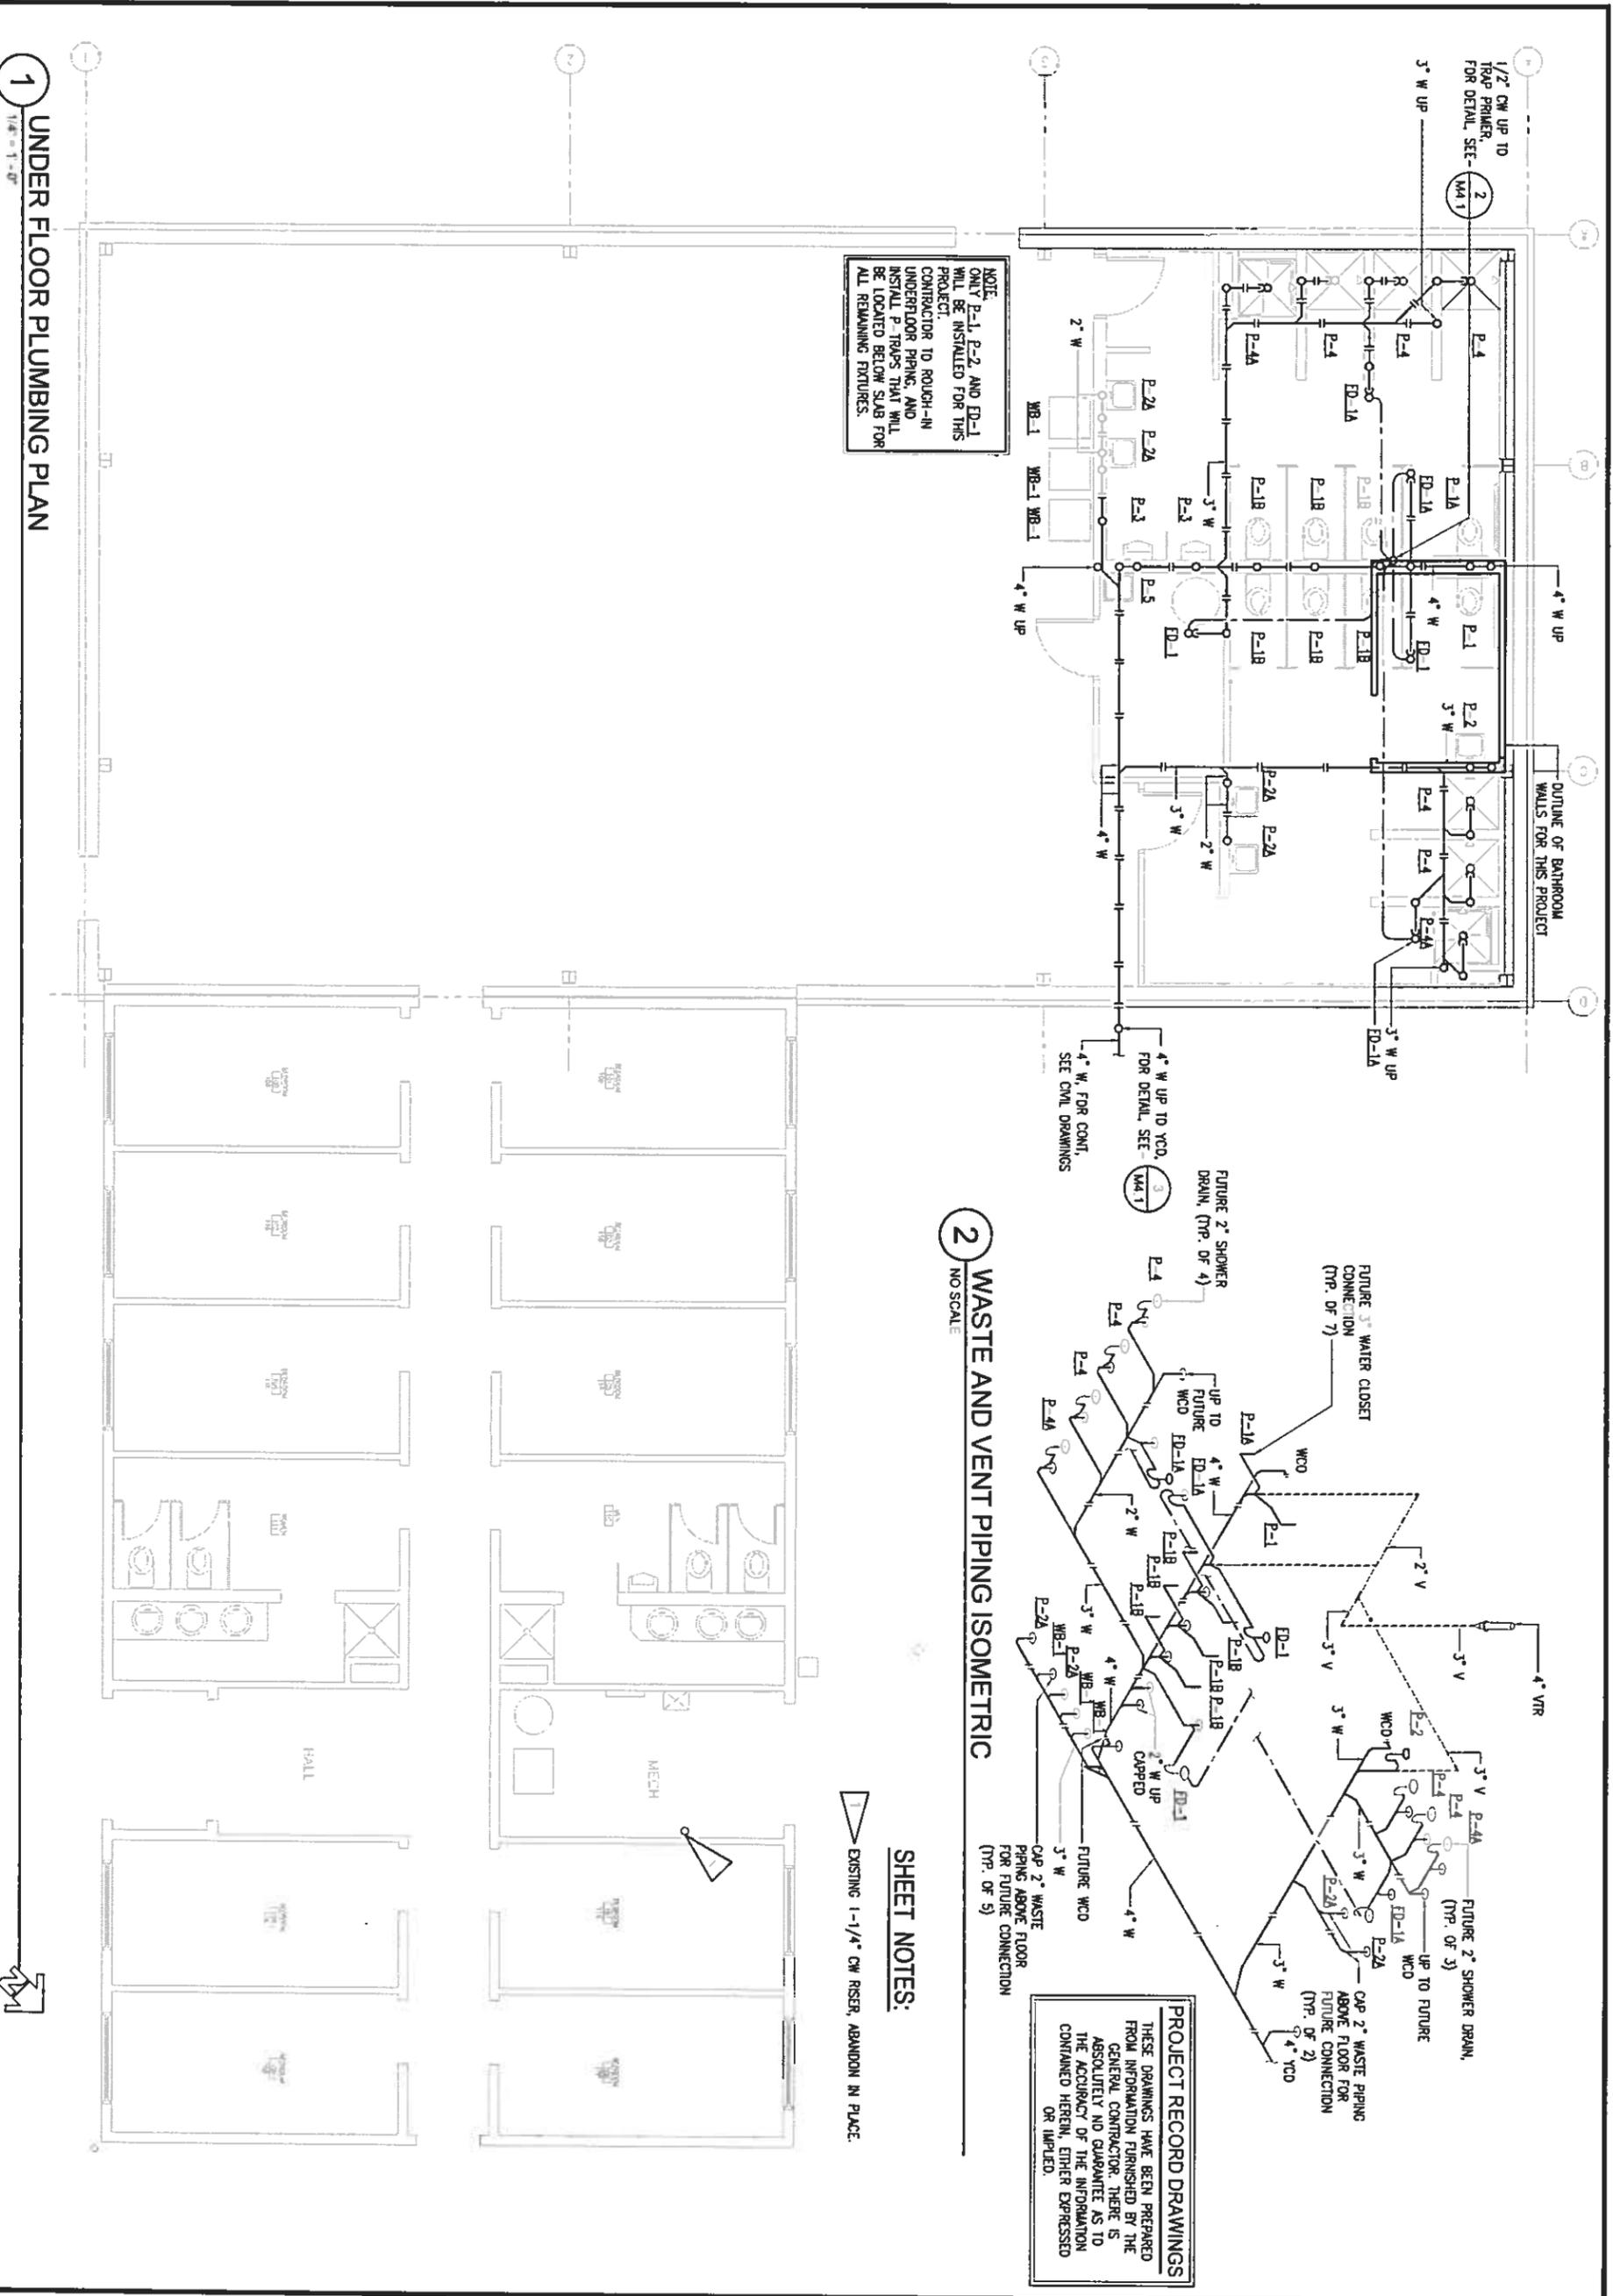

**NOTE:** ONLY P-1, P-2, AND ED-1 WILL BE INSTALLED FOR THIS PROJECT. CONTRACTOR TO ROUGH-IN UNDERFLOOR PIPING, AND INSTALL P-TRAPS THAT WILL BE LOCATED BELOW SLAB FOR ALL REMAINING FIXTURES.


**2** WASTE AND VENT PIPING ISOMETRIC  
NO SCALE

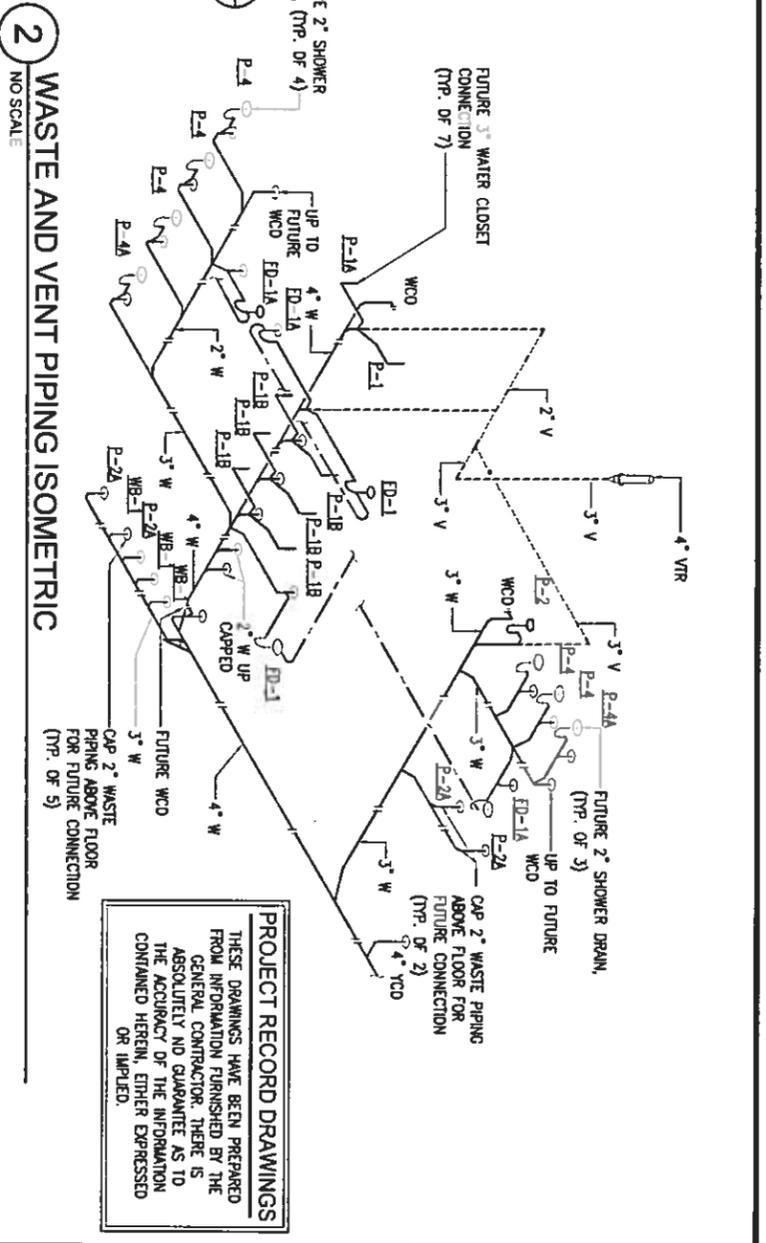

**SHEET NOTES:**

1 EXISTING 1-1/4" CW RISER, ABANDON IN PLACE.

**PROJECT RECORD DRAWINGS**  
THESE DRAWINGS HAVE BEEN PREPARED FROM INFORMATION FURNISHED BY THE GENERAL CONTRACTOR. THERE IS ABSOLUTELY NO GUARANTEE AS TO THE ACCURACY OF THE INFORMATION CONTAINED HEREIN, EITHER EXPRESSED OR IMPLIED.

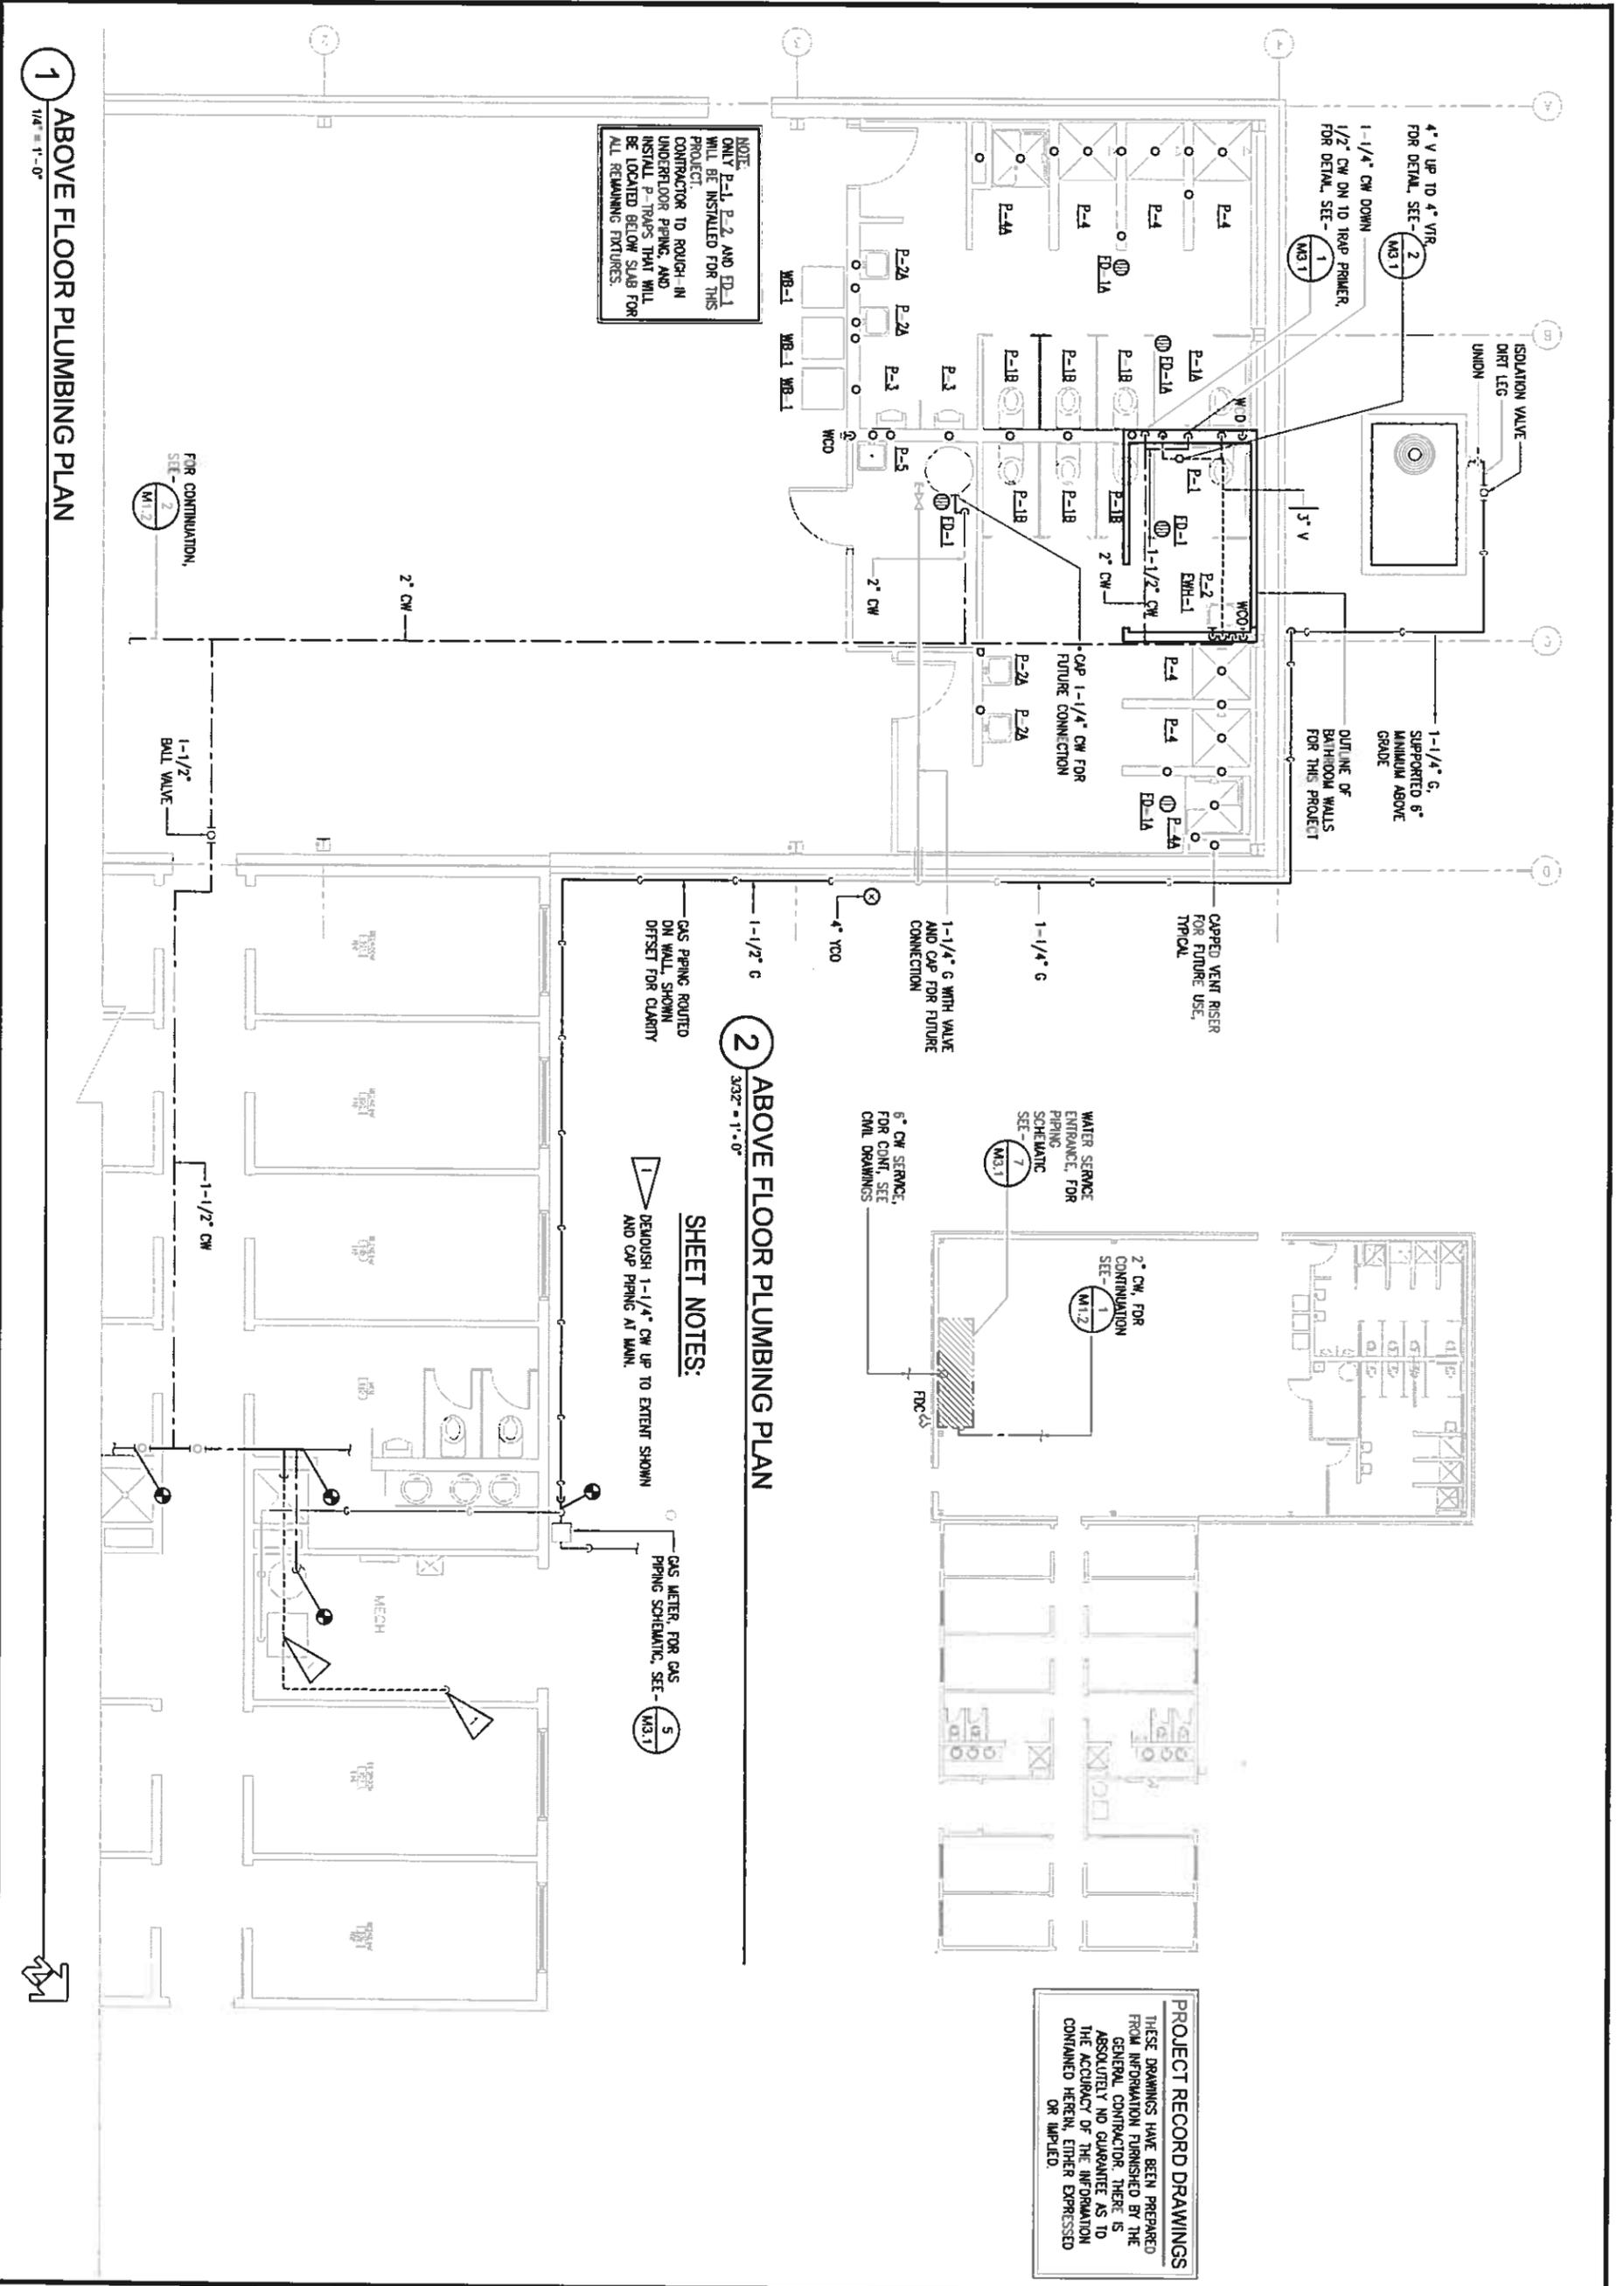

**NOTE:**  
 ONLY P-1, P-2, AND ED-1  
 WILL BE INSTALLED FOR THIS  
 PROJECT.  
 CONTRACTOR TO ROUGH-IN  
 UNDERFLOOR PIPING, AND  
 INSTALL P-TRAPS THAT WILL  
 BE LOCATED BELOW SLAB FOR  
 ALL REMAINING FIXTURES.

**1** ABOVE FLOOR PLUMBING PLAN  
 1/4" = 1'-0"

**2** ABOVE FLOOR PLUMBING PLAN  
 3/32" = 1'-0"

**SHEET NOTES:**

1 DEMOLISH 1-1/4" CW UP TO EXTENT SHOWN  
 AND CAP PIPING AT MAIN.

5 GAS METER FOR GAS  
 PIPING SCHEMATIC, SEE-  
 M3.1

**PROJECT RECORD DRAWINGS**  
 THESE DRAWINGS HAVE BEEN PREPARED  
 FROM INFORMATION FURNISHED BY THE  
 GENERAL CONTRACTOR. THERE IS  
 ABSOLUTELY NO GUARANTEE AS TO  
 THE ACCURACY OF THE INFORMATION  
 CONTAINED HEREIN, EITHER EXPRESSED  
 OR IMPLIED.

DATE: 15 APR 2014  
**M1.2**  
 JOB NO. 1.13238  
 OR: SR  
 CK: JAB


ABOVE FLOOR PLUMBING  
 PLAN

CAMP CARROLL, JBER  
 BUILDING #57226  
 ADDITION




**RSA Engineering, Inc.**  
 MECHANICAL AND ELECTRICAL CONSULTING ENGINEERS  
 1521 Acacia Boulevard, Suite 300  
 Norfolk, VA 23503 (800) 776-6821  
 101 E. Franklin Avenue, Suite 105  
 Norfolk, Virginia 23510 (800) 776-6821




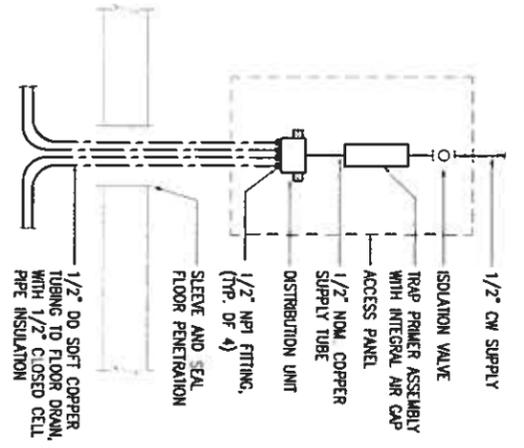


1 TRAP PRIMER DETAIL  
NO SCALE

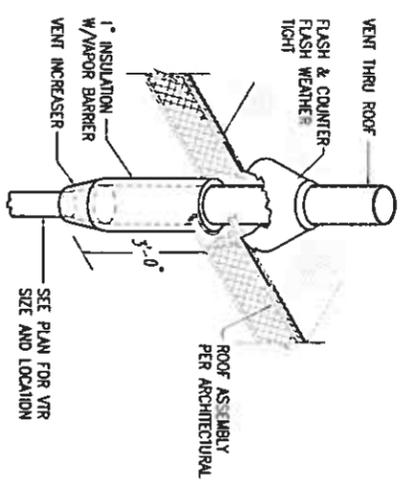


2 VENT THRU ROOF DETAIL  
NO SCALE

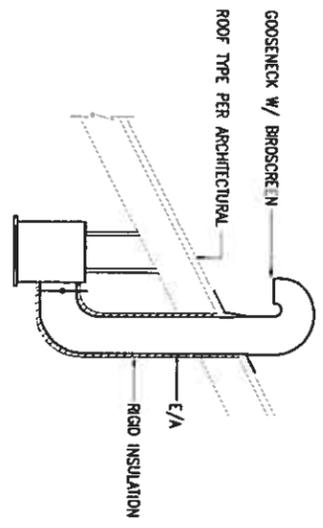

3 EXHAUST FAN DETAIL (TYP.)  
NO SCALE

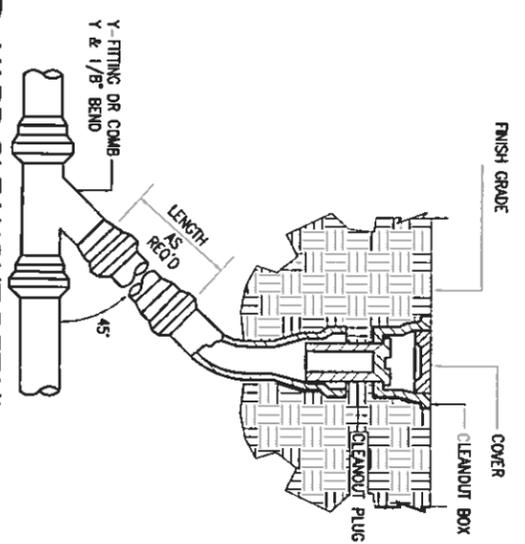


4 YARD CLEANOUT DETAIL  
NO SCALE

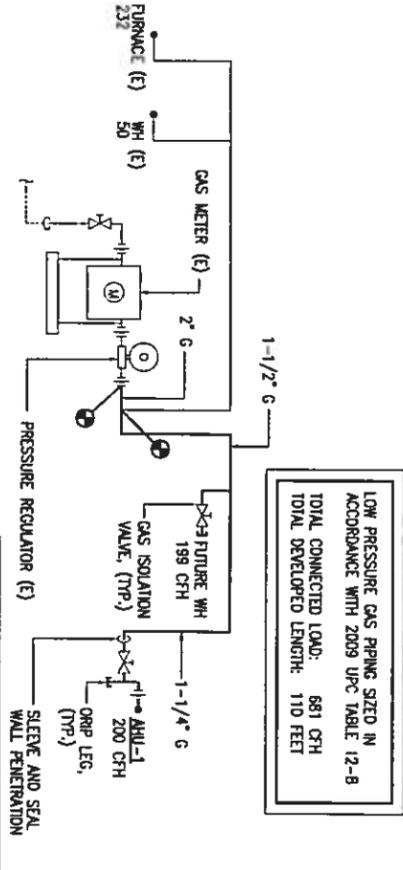


5 GAS PIPING SCHEMATIC  
NO SCALE

NOTE:  
VERIFY WITH DORON UTILITY THAT EXISTING GAS METER CAN ACCOMMODATE REVERSED GAS LOAD REQUIREMENT.

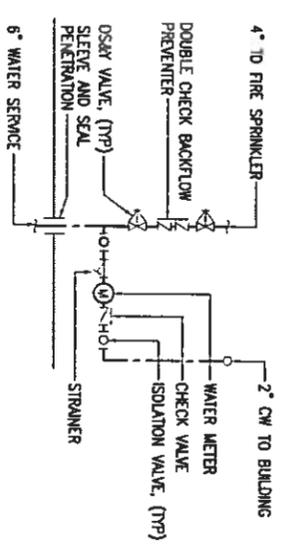

7 WATER SERVICE SCHEMATIC  
NO SCALE

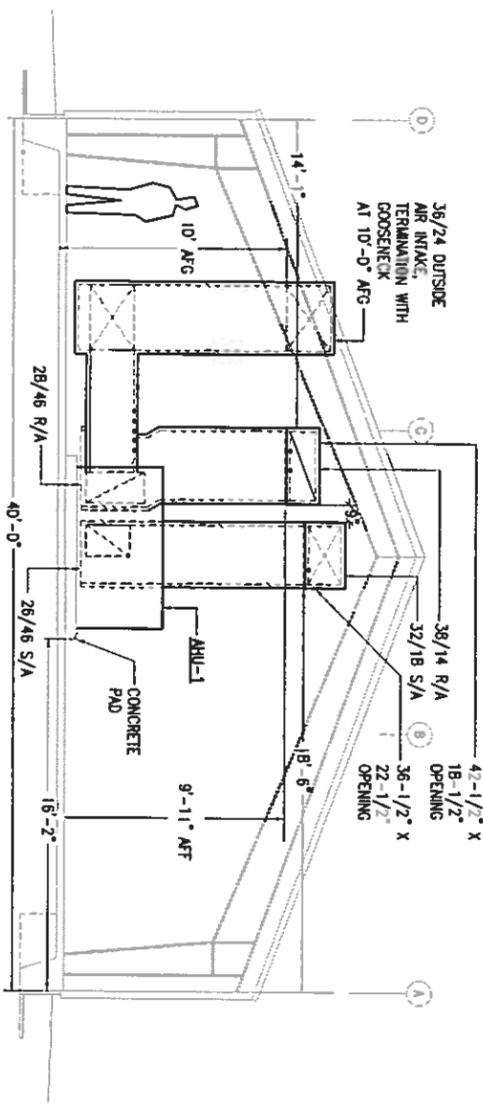

6 MECHANICAL ELEVATION  
NO SCALE

PROJECT RECORD DRAWINGS  
THESE DRAWINGS HAVE BEEN PREPARED FROM INFORMATION FURNISHED BY THE GENERAL CONTRACTOR. THERE IS ABSOLUTELY NO GUARANTEE AS TO THE ACCURACY OF THE INFORMATION CONTAINED HEREIN, EITHER EXPRESSED OR IMPLIED.

DR: SR  
CK: JAB

JOB NO. 13238  
M3.1  
DATE: 15 APR 2014

MECHANICAL DETAILS

CAMP CARROLL, JBER  
BUILDING #57226  
ADDITION



RSA Engineering, Inc.  
MECHANICAL AND ELECTRICAL CONSULTING ENGINEERS  
101 E. Business Avenue, Suite 101  
Pueblo, Colorado 81001 (303) 797-8271



SECTION 16010  
SCOPE OF WORK - FURNISH AND INSTALL ALL MATERIAL AND EQUIPMENT FOR A COMPLETE AND WORKABLE ELECTRICAL SYSTEM AS INDICATED ON THE DRAWINGS AND IN THESE SPECIFICATIONS.

STANDARDS, CODES AND REGULATIONS - COMPLY WITH THE LATEST ADOPTED EDITION OF THE NATIONAL ELECTRICAL CODE, INTERNATIONAL BUILDING CODE, AND INTERNATIONAL FIRE CODE INCLUDING ALL STATE AND LOCAL AMENDMENTS TO THESE CODES.

DRAWINGS - THE DRAWINGS ARE DIAGRAMATIC, NOT NECESSARILY SHOWING ALL DETAILS OR EXACT LOCATIONS OF FIXTURES, EQUIPMENT, ETC. UNLESS SPECIFICALLY DIMENSIONED, REVIEW THE DRAWINGS AND SPECIFICATIONS FOR EQUIPMENT FURNISHED BY OTHER GRANTS BUT INSTALLED IN ACCORDANCE WITH THIS SECTION. BRING QUESTIONABLE OR OBTUSE ITEMS, APPARENT CONFLICTS BETWEEN PLANS AND SPECIFICATIONS, CONVENING CODES OR UTILITIES REGULATIONS TO THE ATTENTION OF THE ARCHITECT, CODES, ORDINANCES, REGULATIONS, MANUFACTURER'S INSTRUCTIONS OR STANDARDS TAKE PRECEDENCE WHEN THEY ARE MORE STRINGENT OR CONFLICT WITH THE DRAWINGS AND SPECIFICATIONS.

RECORD DRAWINGS - MARK UP A CLEAN SET OF DRAWINGS AS THE WORK PROGRESSES TO SHOW THE DIMENSIONED LOCATION AND ROUTING OF ALL ELECTRICAL WORK WHICH WILL BECOME PERMANENTLY CONCEALED. SHOW ROUTING OF WORK IN PERMANENTLY CONCEALED BUND SPACES WITHIN THE BUILDING. SHOW COMPLETE ROUTING AND SIZING OF ANY SIGNIFICANT REVISIONS TO THE SYSTEMS SHOWN.

WORKMANSHIP - INSTALLATION OF ALL WORK SHALL BE MADE SO THAT ITS SEVERAL COMPONENT PARTS SHALL FUNCTION AS A WORKABLE SYSTEM COMPLETE WITH ALL ACCESSORIES NECESSARY FOR ITS OPERATION. ALL MATERIAL AND/OR INSTALLATION DRAWINGS AND IN ACCORDANCE WITH THE MANUFACTURER'S RECOMMENDATIONS, INSTRUCTIONS AND/OR INSTALLATION DRAWINGS AND IN ACCORDANCE WITH NECA STANDARDS, MATERIALS AND EQUIPMENT SHALL BE NEW AND SHALL CONFORM WITH APPLICABLE INDUSTRY STANDARDS, NECA STANDARDS AND UNDERWRITERS LABORATORIES STANDARDS WHERE APPLICABLE.

OPERATION AND MAINTENANCE MANUALS - PROVIDE OPERATION AND MAINTENANCE MANUALS FOR TRAINING OF THE OWNER'S PERSONNEL. DESCRIBE THE PROCEDURES NECESSARY TO OPERATE THE SYSTEM INCLUDING START-UP, OPERATION, EMERGENCY OPERATION AND SHUTDOWN. PROVIDE INSTRUCTIONS AND A SCHEDULE OF PREVENTIVE MAINTENANCE IN TABULAR FORM FOR ALL ROUTINE CLEANING, INSPECTION AND LUBRICATION WITH RECOMMENDED LUBRICANTS. PROVIDE INSTRUCTIONS FOR MINOR REPAIR OR ADJUSTMENTS REQUIRED FOR PREVENTIVE MAINTENANCE ROUTINES. PROVIDE MANUFACTURER'S DESCRIPTIVE LITERATURE INCLUDING APPROVED SHOP DRAWINGS COVERING DEVICES USED IN ANY CONTRACTOR-PROVIDED EQUIPMENT OR SYSTEMS WITH ILLUSTRATION, EXPLODED VIEWS, ETC.

WARRANTY - THE CONTRACTOR SHALL GUARANTEE ALL WORK EXECUTED UNDER THIS CONTRACT TO BE FREE FROM DEFECTS IN MATERIALS AND WORKMANSHIP FOR A PERIOD OF ONE YEAR FROM BENEFICIAL OCCUPANCY. ANY FAULTY MATERIALS OR WORKMANSHIP SHALL BE REPAIRED OR REPLACED TO THE SATISFACTION OF THE OWNER DURING THE GUARANTEE PERIOD.

PERMITS - SECURE AND PAY FOR ALL FEES, PERMITS, ETC. REQUIRED BY LOCAL AND STATE AGENCIES AND ALL LOCAL UTILITY COMPANIES. COSTS OF ONE EXTENSION TO THE METER ARE TO BE PAID BY THE OWNER. REFERENCE SYMBOLS - THE ELECTRICAL "LEGEND" ON THE DRAWINGS IS A STANDARDIZED VERSION, AND ALL SYMBOLS SHOWN MAY NOT BE USED. USE THE "LEGEND" AS A REFERENCE FOR THE SYMBOLS USED ON THE DRAWINGS.

IDENTIFICATION - PROVIDE PRINTED ADHESIVE TAPE LABELS WITH BLACK LETTERS ON A CLEAR BACKGROUND TO IDENTIFY ALL ELECTRICAL DISTRIBUTION AND CONTROL EQUIPMENT, LOADS SERVED AND AS NOTED ON THE DRAWINGS. ALL LETTER HEIGHTS SHALL BE 1/8" HIGH FOR INDIVIDUAL SWITCHES, MOTOR STARTERS AND LOADS SERVED AND 1/4" HIGH ON PANELBOARDS.

CONDUITS: MARK ALL CONDUITS ENTERING OR LEAVING PANELBOARDS WITH INDELEBILE BLACK MARKER WITH THE CIRCUIT NUMBERS OF THE CIRCUITS CONTAINED INSIDE.  
JUNCTION BOXES: MARK ALL CIRCUIT NUMBERS OF WIRING ON ALL JUNCTION BOXES WITH SHEET STEEL COVERS. MARK WITH INDELEBILE BLACK MARKER ON EXPOSED JUNCTION BOXES IN PUBLIC AREAS. MARK ON INSIDE OF COVER. MARK ALL FIRE ALARM SYSTEM JUNCTION BOXES WITH SHEET STEEL COVERS WITH "A" MARK WITH INDELEBILE RED MARKER. MARK ALL OTHER SPECIAL SYSTEM JUNCTION BOXES WITH SHEET STEEL COVERS.

WIRE IDENTIFICATION: PROVIDE WIRE MARKERS ON EACH CONDUCTOR IN PANELBOARD GUTTERS. PULL BOXES, OUTLET AND JUNCTION BOXES AND AT LOAD CONNECTION. MARKERS SHALL BE LOCATED WITHIN ONE INCH OF EACH CABLE END EXCEPT AT PANELBOARDS, WHERE MARKERS FOR BRANCH CIRCUIT CONDUCTORS SHALL BE VISIBLE WITHOUT REMOVING PANEL DEPARTMENT.

DEVICE PLATES: LABEL EACH RECEPTACLE DEVICE PLATE OR POINT OF CONNECTION DENOTING THE PANELBOARD NAME AND CIRCUIT NUMBER. INSTALL LABEL ON THE TOP OF EACH PLATE.

EQUIPMENT CONNECTIONS - PROVIDE WIRING AND CONNECTION OF EQUIPMENT REQUIRING ELECTRICAL POWER BUT SPECIFIED UNDER OTHER DIVISIONS OF THE SPECIFICATIONS. EQUIPMENT SHALL INCLUDE BUT IS NOT LIMITED TO MOTORS, PUMPS, HVAC EQUIPMENT, ETC. REVIEW EQUIPMENT SUBMITTALS PRIOR TO INSTALLATION AND ELECTRICAL RIGGING. VERIFY LOCATION, SIZE, TYPE OF CONNECTIONS, AND THAT EQUIPMENT IS READY FOR ELECTRICAL CONNECTION. MAKE WIRING CONNECTIONS IN CONTROL PANEL OR IN WIRING COMPARTMENT OF PREWIRED EQUIPMENT IN ACCORDANCE WITH THE MANUFACTURER'S INSTRUCTIONS. PROVIDE INTERCONNECTING WIRING AND DISCONNECTS WHERE REQUIRED.

ARC-FLASH SIGNAGE - ALL MOTOR STARTERS, PANELBOARDS AND DISCONNECTS SHALL HAVE SIGNAGE FOR ARC HAZARD INSTALLED. THE MARKING SHALL BE CLEARLY VISIBLE TO QUALIFIED PERSONNEL BEFORE EXAMINATION, ADJUSTMENT, SERVICING OR MAINTENANCE OF THE EQUIPMENT. AT A MINIMUM THE 3-1/2" SIGNAGE SHALL STATE THE FOLLOWING: WARNING - ARC FLASH AND SHOCK HAZARD - APPROPRIATE PPE REQUIRED.

PENETRATIONS OF FIRE BARRIERS - ALL ELECTRICAL PENETRATIONS THROUGH FIRE RATED BARRIERS SHALL BE SEALED IN ACCORDANCE WITH NEC ARTICLE 300-21 AND THE FOLLOWING:

ALL HOLES OR VOIDS CREATED TO EXTEND ELECTRICAL SYSTEMS THROUGH FIRE RATED FLOORS, WALLS OR CEILING SHALL BE SEALED WITH AN ASBESTOS-FREE INTUMESCENT FIRE STOPPING MATERIAL CAPABLE OF EXPANDING 8 TO 10 TIMES WHEN EXPOSED TO TEMPERATURES 250 DEGREES F OR HIGHER.

MATERIALS SHALL BE SUITABLE FOR THE FIRE STOPPING OF PENETRATIONS MADE BY STEEL, GLASS, PLASTIC AND SHALL BE CAPABLE OF MAINTAINING AN EFFECTIVE BARRIER AGAINST FLAME, SMOKE AND GASES IN COMPLIANCE WITH THE REQUIREMENTS OF ASTM E814, UL 1479 AND THE UL FIRE RESISTANCE DIRECTORY REQUIREMENTS FOR THROUGH-PENETRATION FIRESTOP DEVICES (TRSP).

THE GATING OF THE FIRE STOPS SHALL BE THE SAME AS THE TIME-RATED FLOOR, WALL OR CEILING ASSEMBLY.

UNLESS PROTECTED FROM POSSIBLE LOADING OR TRAFFIC, INSTALL FIRE STOPPING MATERIALS IN FLOORS HAVING VOID OPENINGS OF FOUR (4) INCHES OR MORE TO SUPPORT THE SAME FLOOR LOAD REQUIREMENTS AS THE SURROUNDING FLOOR.

SECTION 16111

GROUNDING - ALL WIRING SHALL BE INSTALLED IN METALLIC RACEWAY. INSTALL AN INSULATED EQUIPMENT GROUNDING CONDUCTOR IN ALL RACEWAYS. UTILIZE GALVANIZED RIGID STEEL OR INTERMEDIATE METAL CONDUIT FOR SERVICE ENTRANCE, FEEDERS, IN WET LOCATIONS, IN DIRECT CONTACT WITH CONCRETE OR BELOW SLAB ON GRADE. ELECTRICAL METALLIC TUBING MAY BE USED IN ALL CONCEALED, DRY, INTERIOR LOCATIONS. UTILIZE SHORT EXTENSIONS (36 INCHES MAXIMUM) OF FLEXIBLE CONDUIT FOR CONNECTION OF ALL MOTORS AND OTHER EQUIPMENT SUBJECT TO VIBRATION. UTILIZE LIQUIDTIGHT FLEXIBLE CONDUIT FOR MOTOR AND EQUIPMENT CONNECTIONS IN WET LOCATIONS. COMPLETELY AND THOROUGHLY SWAG RACEWAY SYSTEM BEFORE INSTALLING CONDUCTORS. PROVIDE MINIMUM "LET-LINE" OR APPROVED EQUAL PULL STRING IN ALL EMPTY CONDUITS, EXCEPT SLEEVES AND NEPLERS. PROVIDE LABELS ON BOTH ENDS OF ALL PULL STRINGS.

SECTION 16120

CONDUCTORS - ALL CONDUCTORS #6 AWG AND SMALLER SHALL BE COPPER WITH TYPE XHHW, THHN, THW OR THHN INSULATION. MINIMUM BRANCH CIRCUIT CONDUCTOR SHALL BE #12 AWG. MINIMUM CONTROL CIRCUIT CONDUCTOR SIZE SHALL BE #18 AWG. WIRING IN LIGHTING FIXTURE CHANNELS SHALL BE COPPER WITH TYPE XHHW OR OTHER INSULATION RATED 90 DEGREES C OR HIGHER, 600 VOLT. ALL CONDUCTORS ON EXTENSION OF BUILDING SHALL BE XHHW. PULL ALL CONDUCTORS INTO THE RACEWAY AT THE SAME TIME. USE UL LISTED WIRE PULLING LUBRICANT FOR PULLING #4 AWG AND LARGER WIRE. COLOR CODE CONDUCTORS AS FOLLOWS: 120/200 VOLT SYSTEMS: BLACK, RED, BLUE AND WHITE. USE PROPERLY TESTED INSULATED SPRING WIRE CONNECTORS WITH PLASTIC CAPS FOR ALL CONDUCTORS #6 AWG AND SMALLER. TERMINATE #6 AWG AND LARGER CONDUCTORS WITH CRAMP OR COMPRESSION TYPE CONNECTORS INSTALLED WITH TOOL RECOMMENDED BY CONNECTION MANUFACTURER AND INSULATE WITH PROPERLY SIZED 600 VOLT RATED HEAT SHRINK TUBING.

SECTION 16130

OUTLET BOXES - PROVIDE GALVANIZED OR COALUMIN PLATED, ONE PIECE PRESSED OR WELDED STEEL OUTLET BOXES 4 INCH SQUARE OR OCEANOLUM, 1 1/2 INCHES DEEP MINIMUM SIZE FOR USE IN INTERIOR AREAS. PROVIDE CAST ALUMINUM OR FIBERGLASS TYPE BOXES WITH GASKETED COVER, THREADED HUBS AND NECA 3R RATING FOR USE IN EXTERIOR OR WET LOCATIONS. PROVIDE FUTURE OUTLETS WITH 1/2 INCH WAVE FUTURE STUDS AS REQUIRED. PROVIDE OUTLET BOXES AS SHOWN ON THE DRAWINGS, AND AS REQUIRED FOR SPULGES, TAPS, WIRE PULLING, EQUIPMENT CONNECTIONS, DEVICE INSTALLATION AND CODE COMPLIANCE. DO NOT INSTALL BOXES BACK-TO-BACK IN WALLS. PROVIDE A MINIMUM 6 INCH SEPARATION FOR MINIMUM SOUND TRANSMISSION. USE MULTIPLE-GANG BOXES WHERE MORE THAN ONE DEVICE ARE MOUNTED TOGETHER. DO NOT USE SECTIONAL BOXES. SUPPORT BOXES INDEPENDENTLY OF CONDUIT. COORDINATE MOUNTING HEIGHTS AND LOCATIONS OF OUTLETS MOUNTED ABOVE COUNTERS, BENCHES AND BACKSPASHES.

SECTION 16141

RECEPTACLES - PROVIDE NECA 5-20R DUPLEX GROUNDING TYPE RECEPTACLES WITH WHITE FINISH, MEETING ALL REQUIREMENTS OF FEDERAL SPECIFICATION WC-598F, UL NO. 498 APPROVED, SELF-GROUNDING, CENTERED TO COMPLY WITH NECA WP-1-4.02 THROUGH 4.11, 1979 TESTS. SCREW TERMINAL OR SCREW CLAMP TYPE ONLY. SPRING CLAMPED TYPE TERMINATIONS ARE NOT ACCEPTABLE. PROVIDE DUPLEX COMMERCIAL RECEPTACLES WITH CLASS "A" INTERNAL GROUND FAULT CURRENT INTERRUPTER WITH INTERNAL LOCKOUT FUNCTION THAT MEETS UL 943 (2003) REQUIREMENTS. PROVIDE SPECIFIC-USE RECEPTACLES WHERE INDICATED ON THE DRAWINGS. UNLESS OTHERWISE NOTED ON THE DRAWINGS, INSTALL RECEPTACLES 18 INCHES ABOVE FINISH FLOOR, 4 INCHES ABOVE COUNTERS AND BACKSPASHES WITH GROUNDING POLE ON BOTTOM. UNLESS OTHERWISE NOTED DIMENSIONS ARE TO CENTERLINE OF OUTLET.

SWITCHES - PROVIDE NECA WP-1 20 AMPERE, 120/277 VOLT AC GENERAL-USE SWAP SWITCH, MEETING ALL REQUIREMENTS OF FEDERAL SPECIFICATION WS-696, UL NO. 20 LISTED SELF-GROUNDING BONDING SCREW TYPE TERMINALS WITH WHITE TOGGLE, SINGLE POLE, THREE WAY OR FOUR WAY AS INDICATED ON THE DRAWINGS. INSTALL SWITCHES 48 INCHES ABOVE FINISHED FLOOR, OFF POSITION DOWN.

DEVICE PLATES - PROVIDE UL LISTED ONE PIECE ROUNDED EDGE "STREAMLINE" DESIGN FLUSH DEVICE PLATES OF STAIN FINISH 430 OR 302 STAINLESS STEEL WITH METAL, COUNTER SINK SCREWS TO MATCH DEVICE PLATE. PROVIDE GALVANIZED DEVICE PLATES WHERE EXPOSED WIRING IS PERMITTED. PROVIDE UL LISTED, CAST ALUMINUM, HINGED OUTLET COVER/ENCLOSURE WITH GASKET BETWEEN THE ENCLOSURE AND THE MOUNTING SURFACE SUITABLE FOR WET LOCATION WHILE IN USE FOR ALL OUTLETS ON THE EXTERIOR OF THE BUILDING. PROVIDE 1/2 INCH RAISED SQUARE, GALVANIZED OR COALUMIN PLATED, PRESSED STEEL COVER PLATE SUPPORTING DEVICES INDEPENDENT OF THE OUTLET BOX FOR ALL EXPOSED WORK.

SECTION 16420

SERVICE ENTRANCE - COORDINATE WITH UTILITY COMPANY FOR PERMANENT ELECTRICAL SERVICE. INSTALL SERVICE ENTRANCE IN ACCORDANCE WITH UTILITY COMPANY'S RULES AND REGULATIONS. COORDINATE WITH LOCAL UTILITY COMPANY FOR METERING REQUIREMENTS. PROVIDE GROUNDING AND BONDING AT SERVICE ENTRANCE AS SHOWN ON THE DRAWINGS.

SECTION 16440

DISCONNECT SWITCHES - PROVIDE UL LISTED 250V, HEAVY DUTY NON-FUSIBLE QUICK-WAKE, QUICK BREAK, LOAD INTERRUPTER, ENCLOSED KNIFE SWITCHES WITH EXTERNALLY OPERABLE HANDLE INTERLOCKED TO PREVENT OPENING FRONT COVER WITH SWITCH IN ON POSITION, HANDLE LOCKABLE IN OFF POSITION. ENCLOSURES SHALL BE NECA 3R OR AS INDICATED ON THE DRAWINGS.

SECTION 16470

PANELBOARDS - PROVIDE DEAD-FRONT CIRCUIT BREAKER PANELBOARDS WITH BUS SIZE, SHORT CIRCUIT RATING, NUMBER AND SIZE OF BRANCH CIRCUITS AS SHOWN ON THE DRAWINGS. BUSING SHALL BE COPPER. CABINETS SHALL BE 6 INCHES DEEP BY 20 INCHES WIDE MINIMUM. PROVIDE WITH SURFACE FRONTS, WITH CONCEALED TRIM CLAMPS, CONCEALED HINGE AND FLUSH-LOCK WITH DOOR. FINISH IN MANUFACTURER'S STANDARD GRAY ENAMEL. MOUNTED CASE CIRCUIT BREAKERS SHALL BE 8011-ON THERMAL MAGNETIC TRIP TYPE

WITH COMMON TRIP HANDLE FOR ALL POLES. PROVIDE CIRCUIT BREAKERS UL LISTED AS TYPE SMD FOR LIGHTING CIRCUITS SWITCHED AT THE PANELBOARD AND AS TYPE HOUR FOR AIR HANDLING/CONTROLING CIRCUITS. PROVIDE UL CLASS A GROUND FAULT INTERRUPTER CIRCUIT BREAKERS FOR GFCI CIRCUITS AS INDICATED ON THE DRAWINGS. INSTALL PANELBOARDS FLUSH WITH TOP OF CABINET 6"-6" ABOVE FINISHED FLOOR UNLESS OTHERWISE NOTED ON THE DRAWINGS. PROVIDE TYPED CIRCUIT DIRECTORIES FOR EACH PANELBOARD. MEASURE STEADY STATE LOAD CURRENTS OF EACH PANELBOARD FEEDER AND REARRANGE BRANCH CIRCUITS AS REQUIRED TO MAINTAIN A MAXIMUM 20 PERCENT DIFFERENCE BETWEEN PHASES. REVERSE CIRCUIT DIRECTORY TO REFLECT CIRCUMSTANCES REQUIRED TO BALANCE PHASE LOADS.

SECTION 16480

MOTOR STARTERS - PROVIDE MAGNETIC MOTOR STARTERS, NECA ICS 2; AC GENERAL-PURPOSE CLASS A MAGNETIC CONTROLLER FOR INDUCTION MOTORS RATED IN HORSEPOWER. FULL VOLTAGE STARTING; NON-REVERSING TYPE. OVERLOAD RELAY SHALL BE THE MELTING ALLOY TYPE. COMBINE MOTOR STARTERS WITH MOTOR CIRCUIT PROTECTOR DISCONNECT IN COMMON ENCLOSURE. PROVIDE TWO FIELD CONNECTIBLE CONTACTS IN ADDITION TO SEAL-IN CONTACT. PROVIDE HAND/OFF/AUTO SELECTOR SWITCH AND A RED "RUN" LED INDICATOR LIGHT IN FRONT COVER. PROVIDE CONTROL POWER TRANSFORMERS AS REQUIRED. INSTALL MOTOR CONTROL EQUIPMENT IN ACCORDANCE WITH MANUFACTURER'S INSTRUCTIONS. SELECT AND INSTALL HEATER ELEMENTS IN MOTOR STARTERS TO MATCH INSTALLED MOTOR CHARACTERISTICS. MOTOR DATA: PROVIDE HEAVY TYPED LABEL INSIDE EACH MOTOR STARTER ENCLOSURE DOOR IDENTIFYING MOTOR SERVED, NAMEPLATE HORSEPOWER, FULL LOAD AMPERES, CODE LETTER, SERVICE FACTOR, AND VOLTAGE/PHASE RATING.

FRACTIONAL HORSEPOWER MANUAL STARTER - NECA ICS 2; AC GENERAL-PURPOSE CLASS A MANUALLY OPERATED, NUMBER OF POLES AS REQUIRED BY THE LOAD SERVED, FULL-VOLTAGE CONTROLLER FOR FRACTIONAL HORSEPOWER INDUCTION MOTORS, WITH THERMAL OVERLOAD UNIT, RED LED PILOT LIGHT, AND TOGGLE OPERATOR.

SECTION 16510

LIGHTING EQUIPMENT - PROVIDE AND INSTALL ALL LIGHTING EQUIPMENT OR APPROVED EQUAL AS SHOWN ON THE DRAWINGS AND DESCRIBED IN THE "LUMINAIRE SCHEDULE". PROVIDE LIGHTING EQUIPMENT COMPLETE, WIRED, ASSEMBLED, WITH PROPER FLANGES, MOUNTING SUPPORTS, HARDWARE, ETC. PROVIDE ENERGY SAVING LAMPS AND ELECTRONIC BALLASTS WITH A MINIMUM THD OF 20% AND A MINIMUM BALLAST FACTOR OF .88 FOR ALL FLUORESCENT FIXTURES. UNLESS OTHERWISE NOTED ON THE DRAWINGS, FLUORESCENT LAMPS SHALL BE T12P COMPLIANT, 3500 DEGREE K, TRI-PHOSPHOR TYPE WITH A MINIMUM CRI OF 82.

FLUORESCENT LUMINAIRE DISCONNECT: UL LISTED, "A" GENERAL-PURPOSE DISCONNECT WITH TN-PLATED BRASS CONTACTS, FINGER-SAFE POLYCARBONATE FEMALE HOUSING, 105° C TEMPERATURE RATING, AND TWO OR THREE-POLE CONFIGURATION TO MATCH LOAD SERVED. DEAL "POWERPLUS" SERIES OR APPROVED EQUAL.

PANEL 'A'


CIRCUIT NO.	SERVICES	TYPE	VOLTS: 120/208V/3PH/4W			ENCLOSURE: NECA 1			277V A				
			AMP	PHASE	WIRE	TYPE	AMP	PHASE	WIRE	TYPE	AMP	PHASE	WIRE
1	RECP	RECP	600	A	665	1/0	20	1	1	2	1	2	
2	RECP	RECP	720	B	70	1/0	20	1	1	2	1	2	
3	RECP	RECP	300	C	665	1/0	20	1	1	2	1	2	
4	RECP	RECP	720	B	70	1/0	20	1	1	2	1	2	
5	RECP	RECP	300	C	665	1/0	20	1	1	2	1	2	
6	RECP	RECP	300	C	665	1/0	20	1	1	2	1	2	
TOTAL			6048		6360		600		7600		24	201	VA
A.C. RATING: 0.000			67		72		64		67		A		
CONNECTED LOAD FROM PANEL 'A'			187		338		0.00		243		81	A	
CONNECTED LOAD FROM PANEL 'B'			187		338		0.00		243		81	A	
TOTAL CONNECTED LOAD FROM PANELS			374		676		0.00		486		162	A	
DEMAND LOAD FROM PANELS			230		588		0.00		240		72	A	

PANEL NOTES:  
 a PROVIDE RED HANDED BREAKER AND LOCK-ON DEVICE FOR CIRCUIT INDICATED  
 b PROVIDE HIGHER RATED CIRCUIT BREAKER FOR LOAD INDICATED  
 c PROVIDE SMD RATED CIRCUIT BREAKER FOR LOAD INDICATED  
 d UTILITY DEMAND HISTORY NOT AVAILABLE FOR EXISTING SERVICE  
 e HANDLE THE SHARED NEUTRAL

PROJECT RECORD DRAWINGS

THESE DRAWINGS HAVE BEEN PREPARED FROM INFORMATION FURNISHED BY THE GENERAL CONTRACTOR. THERE IS ABSOLUTELY NO GUARANTEE AS TO THE ACCURACY OF THE INFORMATION CONTAINED HEREIN, EITHER EXPRESSED OR IMPLIED.

**1 LIGHTING PLAN**  
SCALE 1/4" = 1'-0"

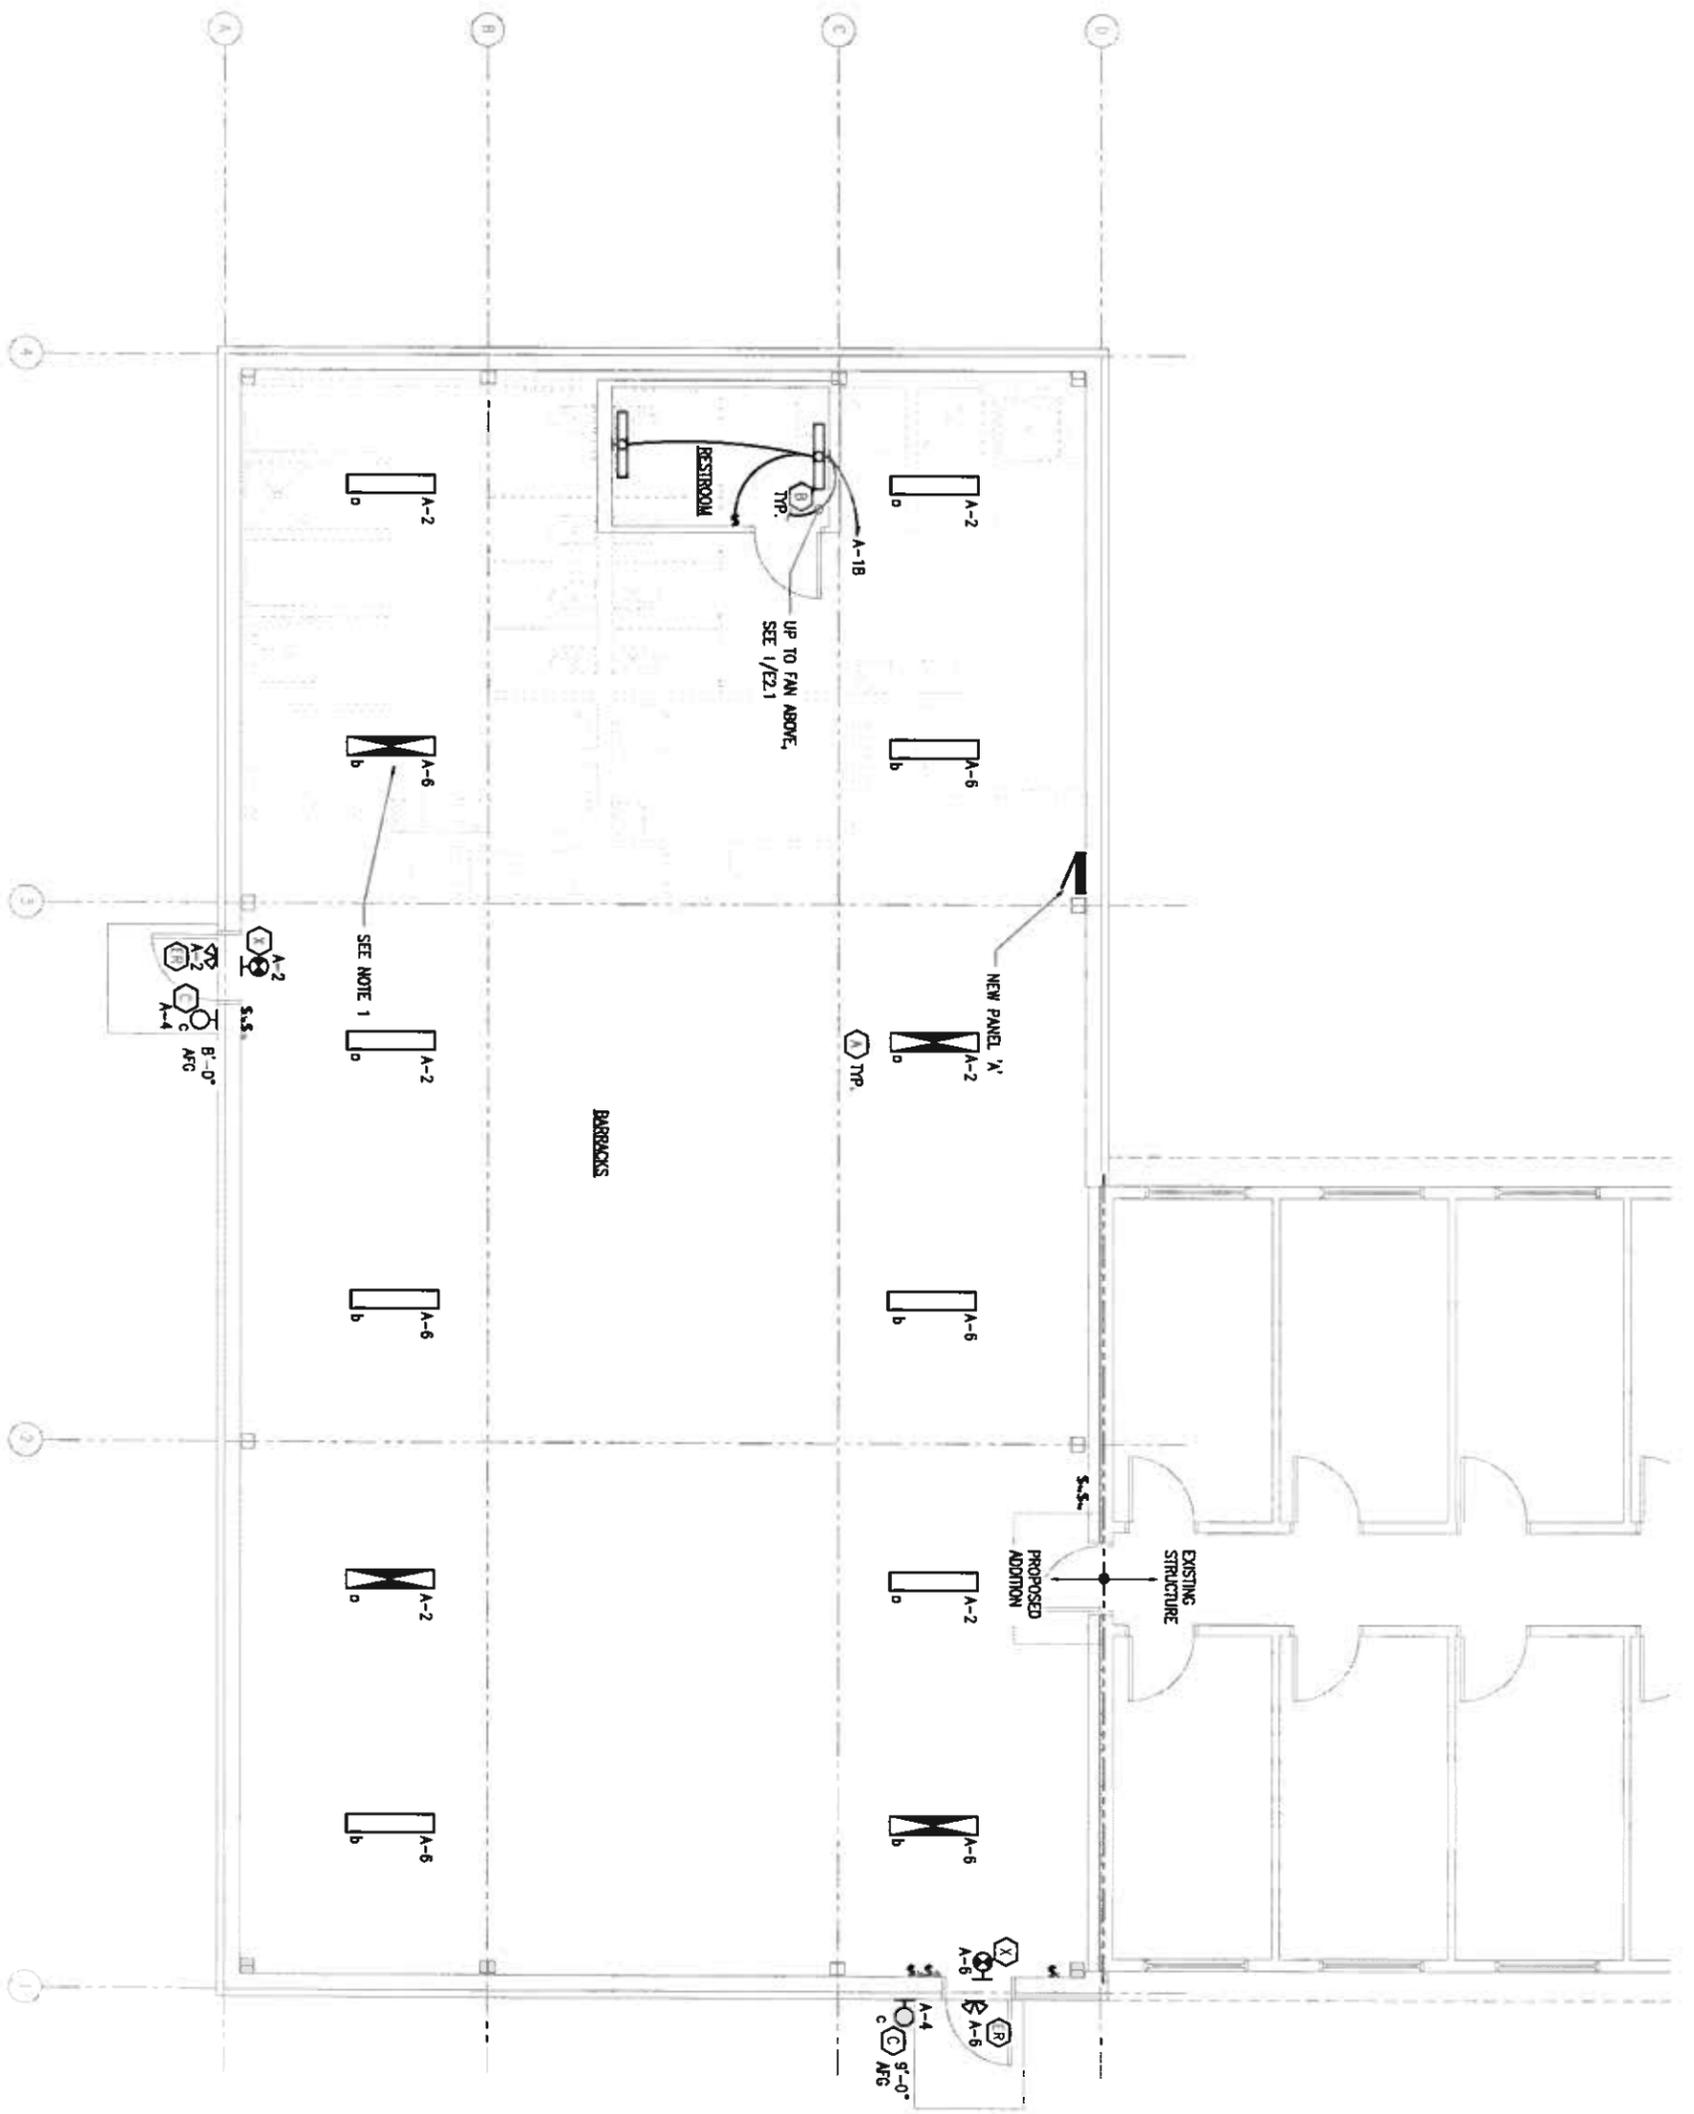

**GENERAL NOTES:**

- A. INTERIOR LIGHTING CONFIGURATION INDICATED ON PLAN HAS BEEN CALCULATED TO PROVIDE 22FC AVERAGE HORIZONTAL ILLUMINATION LEVEL, MINIMUM 13FC WITH A MAX./MIN. UNIFORMITY LEVEL OF 2:1. UFC 3-530-01 TARGET OF 5FC FOR HOUSING (BARACKS) IS ATTAINED WITHOUT THE AD OF TASK ILLUMINATION.
- B. CONNECT EMERGENCY EXIT LIGHT AND REMOVE EMERGENCY FIXTURE TO UNSWITCHED LEG OF LOCAL LIGHTING CIRCUIT.

**SHEET NOTES:**

- 1. PROVIDE EL141 EMERGENCY INVERTER BALLAST FOR TYPE 'A' LUMINAIRES SHOWN AS EMERGENCY AND CONNECT TO UNSWITCHED LEG OF LOCAL LIGHTING CIRCUIT.

**PROJECT RECORD DRAWINGS**  
THESE DRAWINGS HAVE BEEN PREPARED FROM INFORMATION FURNISHED BY THE GENERAL CONTRACTOR. THERE IS ABSOLUTELY NO GUARANTEE AS TO THE ACCURACY OF THE INFORMATION CONTAINED HEREIN, EITHER EXPRESSED OR IMPLIED.

**RSA Engineering, Inc.**  
MECHANICAL AND ELECTRICAL CONSULTING ENGINEERS  
202 2nd Street, Suite 200  
Annapolis, MD 21403 (410) 293-1700  
101 E. Douglas Avenue, Suite 102  
Farmingdale, NY 11737 (609) 687-1571



**CAMP CARROLL, JBER**  
BUILDING #57226  
ADDITION


LIGHTING PLAN

JOB NO. 13238

**E1.1**

DATE 14 APR 2014

- GENERAL NOTES:**
- A. SINGLE PHASE ELECTRICAL SERVICE TO EXISTING STRUCTURE IS TO BE RETIRED AND EXISTING PANEL TO BE RE-FED FROM NEW PANEL 'A'.
  - B. EXISTING MONACO FIRE ALARM PANEL TO BE EXPANDED UNDER THIS CONTRACT. SEE FIRE PROTECTION DRAWINGS.
  - C. AHU-1: PROVIDE DUCT DETECTOR AND WIRING CONNECTION TO FACP.

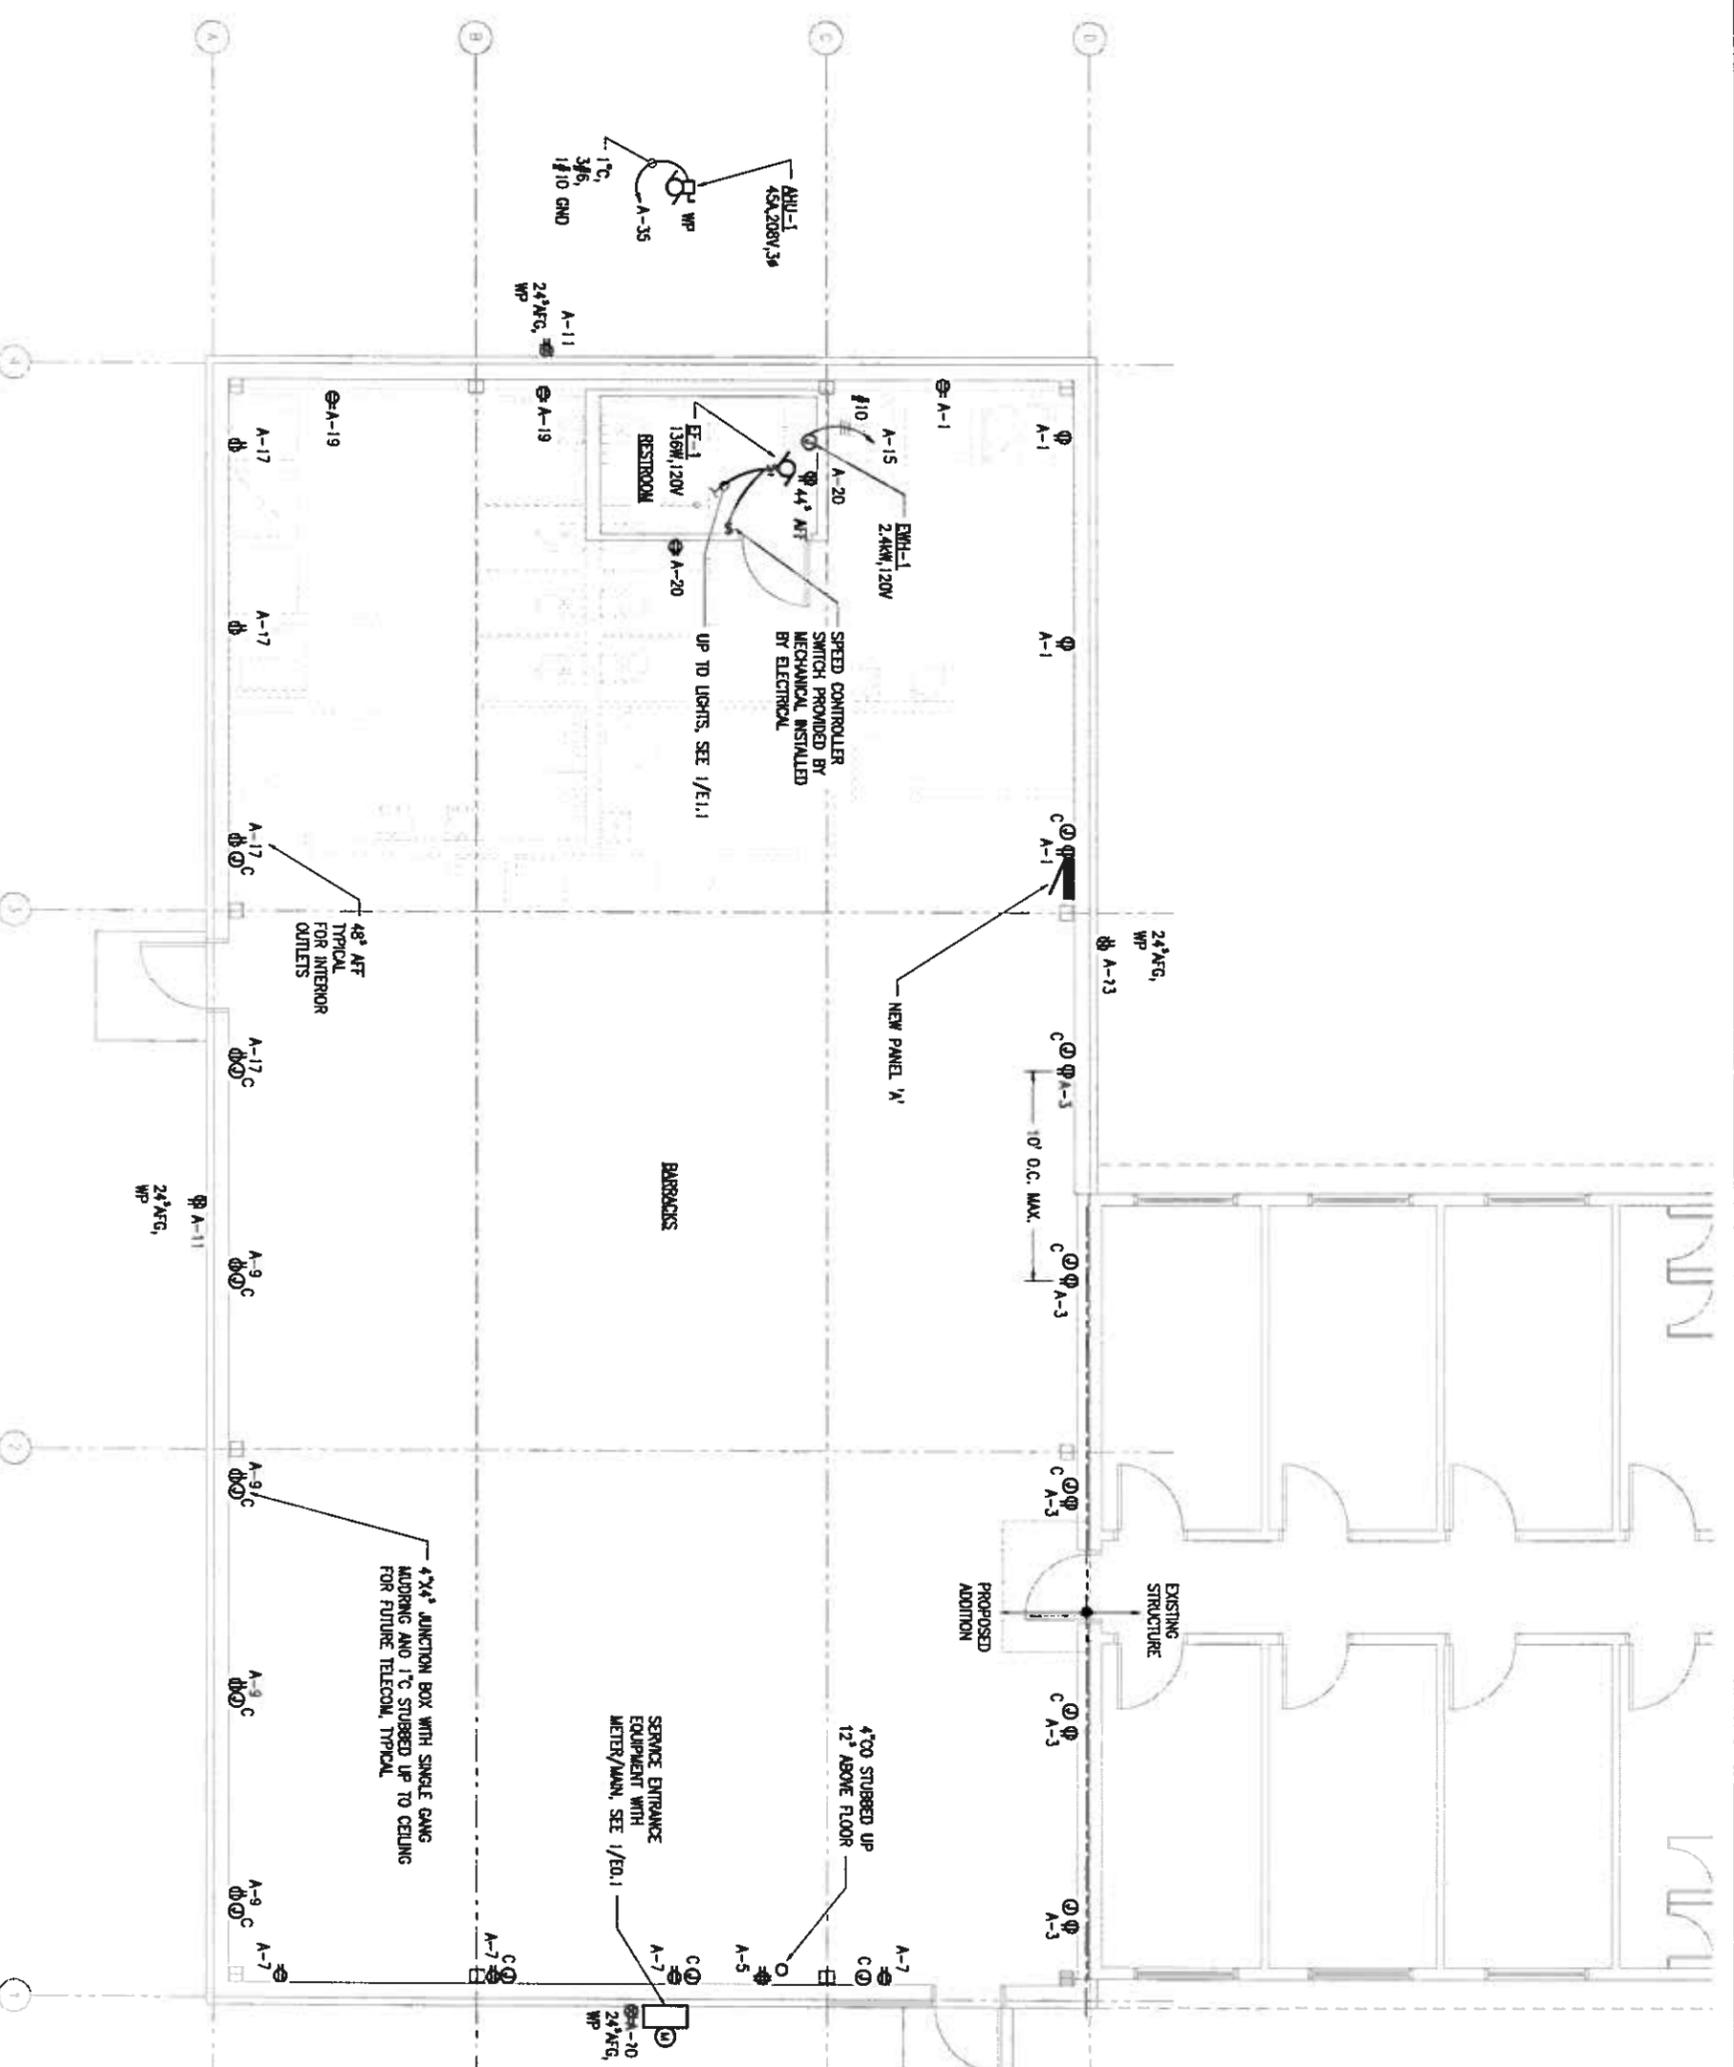

**PROJECT RECORD DRAWINGS**

THESE DRAWINGS HAVE BEEN PREPARED FROM INFORMATION FURNISHED BY THE GENERAL CONTRACTOR. THERE IS ABSOLUTELY NO GUARANTEE AS TO THE ACCURACY OF THE INFORMATION CONTAINED HEREIN, EITHER EXPRESSED OR IMPLIED.

**1 POWER PLAN**  
SCALE 1/4" = 1'-0"






NOTIFYING AGENCY	ADDRESS	PHONE	FAX
1 - VOLVEX GROUP	1100 5725E		
2 -			
3 -			
NOTIFYING AGENCY	ADDRESS	PHONE	FAX
1 - VOLVEX GROUP	1100 5725E		
2 -			
3 -			
NOTIFYING AGENCY	ADDRESS	PHONE	FAX
1 - VOLVEX GROUP	1100 5725E		
2 -			
3 -			
SYSTEM INPUTS	A	B	C	D	E	F	G	H	I	J	K	L	M	N
1 MANUAL FIRE ALARM PULL STATION	X	X	X	X	X	X	X	X	X	X	X	X	X	X
2 AMT SYSTEM SMOKE SENSOR	X	X	X	X	X	X	X	X	X	X	X	X	X	X
3 AMT HEAT SENSOR	X	X	X	X	X	X	X	X	X	X	X	X	X	X
4 AMT SMOKE ALARM	X	X	X	X	X	X	X	X	X	X	X	X	X	X
5 DUCT MOUNTED SMOKE DETECTOR	X	X	X	X	X	X	X	X	X	X	X	X	X	X
6 SPRINKLER SYSTEM ALARM PRESSURE SWITCH	X	X	X	X	X	X	X	X	X	X	X	X	X	X
7 SPRINKLER SYSTEM VALVES CLOSED	X	X	X	X	X	X	X	X	X	X	X	X	X	X
8 SPRINKLER SYSTEM LOW AIR PRESSURE	X	X	X	X	X	X	X	X	X	X	X	X	X	X
9 FIRE ALARM AC POWER FAIL	X	X	X	X	X	X	X	X	X	X	X	X	X	X
10 OPEN CIRCUIT	X	X	X	X	X	X	X	X	X	X	X	X	X	X
11 GROUND FAULT	X	X	X	X	X	X	X	X	X	X	X	X	X	X
12 NOTIFICATION APPLIANCE CIRCUIT(VAC) SHORT	X	X	X	X	X	X	X	X	X	X	X	X	X	X

SYSTEM OUTPUTS	A	B	C	D	E	F	G	H	I	J	K	L	M	N
ACTUATE COMMON ALARM SIGNAL INDICATOR	X	X	X	X	X	X	X	X	X	X	X	X	X	X
ACTUATE AUDIBLE ALARM SIGNAL INDICATOR	X	X	X	X	X	X	X	X	X	X	X	X	X	X
ACTUATE COMMON SUPERVISORY SIGNAL	X	X	X	X	X	X	X	X	X	X	X	X	X	X
ACTUATE AUDIBLE SUPERVISORY SIGNAL INDICATOR	X	X	X	X	X	X	X	X	X	X	X	X	X	X
ACTUATE COMMON TROUBLE SIGNAL	X	X	X	X	X	X	X	X	X	X	X	X	X	X
ACTUATE AUDIBLE TROUBLE SIGNAL INDICATOR	X	X	X	X	X	X	X	X	X	X	X	X	X	X
TRANSMIT FIRE ALARM SIGNALS	X	X	X	X	X	X	X	X	X	X	X	X	X	X
TRANSMIT SUPERVISORY SIGNAL TO SUPERVISORY STATION	X	X	X	X	X	X	X	X	X	X	X	X	X	X
LOCAL ALARM IN BEDROOM TO SUPERVISORY STATION	X	X	X	X	X	X	X	X	X	X	X	X	X	X
AIR HANDLING UNIT SHUTDOWN	X	X	X	X	X	X	X	X	X	X	X	X	X	X

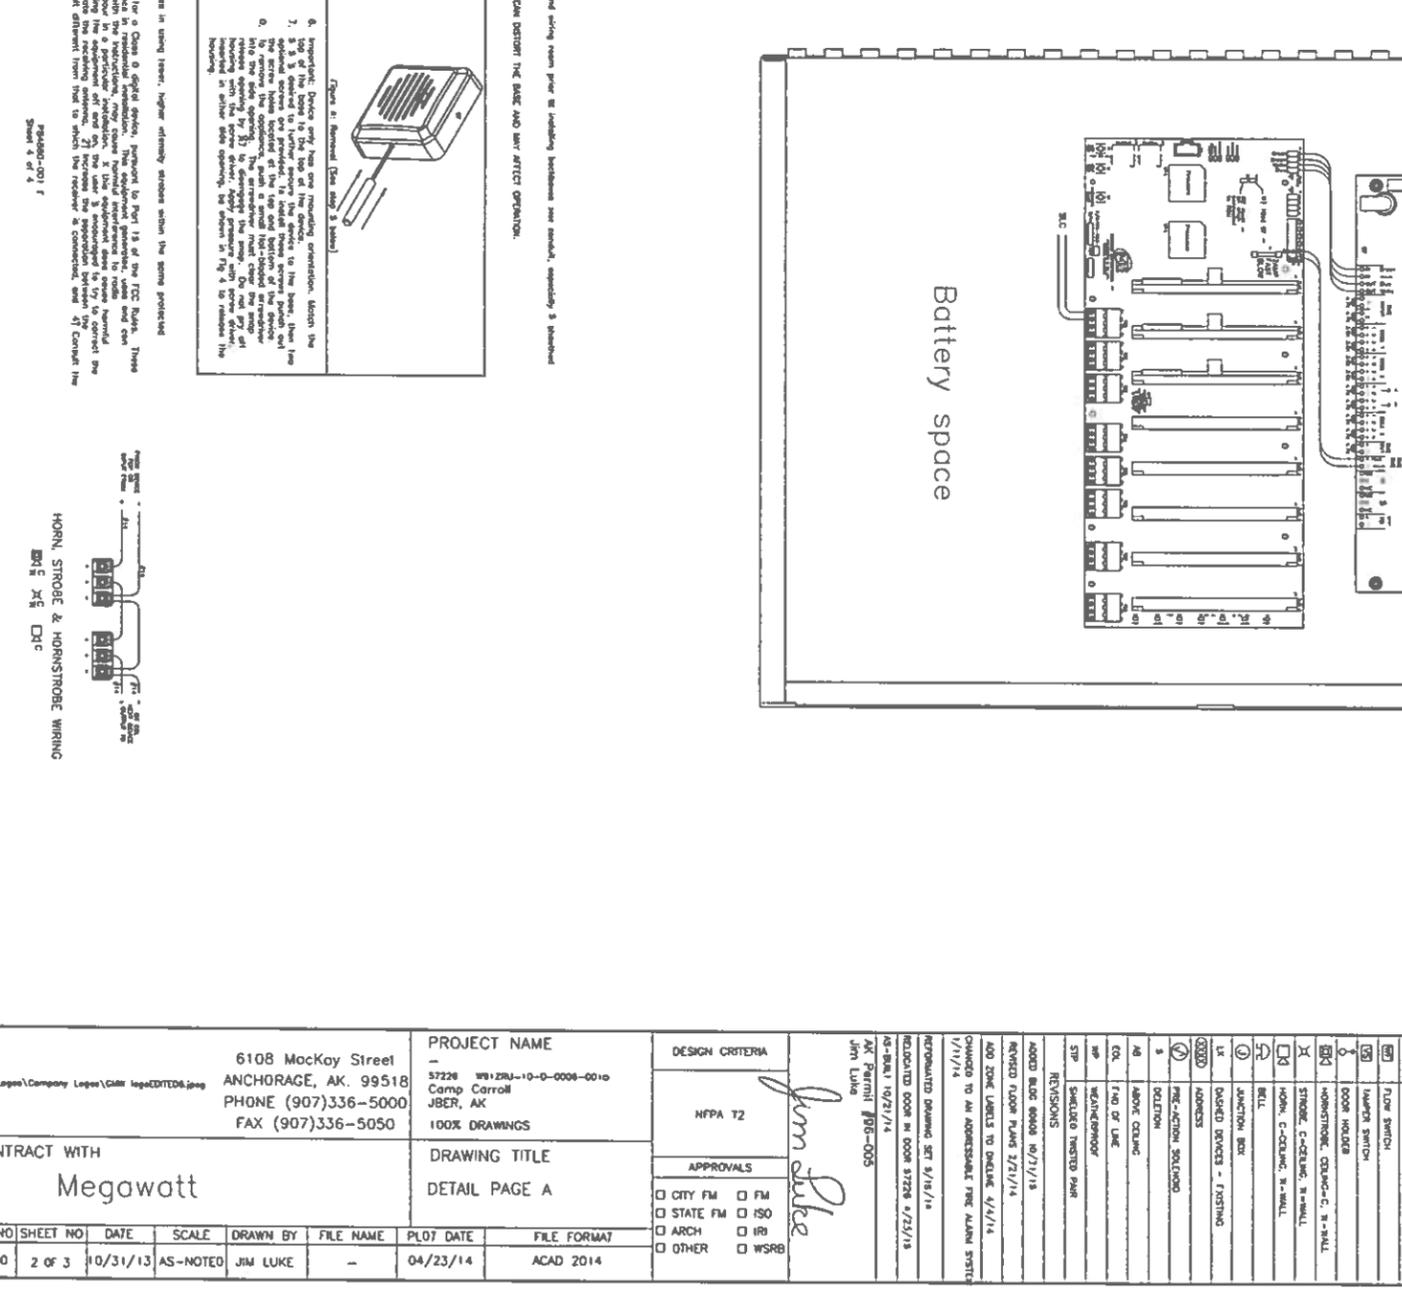


NOTE: This equipment has been listed and found to comply with the requirements for a Class 2 digital device, pursuant to Part 15 of the FCC Rules. These requirements provide for limited protection against harmful interference to certain licensed, mobile, radio frequency devices. This equipment generates, uses and can radiate radio frequency energy and, if not properly installed and used, may cause interference to radio communications. It is important that you follow the instructions in the manual to reduce the risk of such interference. If you are experiencing interference from this equipment, you may wish to consult the manufacturer's website for troubleshooting information. If you are unable to resolve the interference problem, you may wish to contact the manufacturer for assistance.

PROJECT NAME	ADDRESS	PHONE	FAX
5722E	1100 5725E		



CONTRACT WITH	MEGAWATT
JOB NO	13680
SHEET NO	2 of 3
DATE	10/31/13
SCALE	AS-NOTED
DRAWN BY	JIM LUKE
FILE NAME	-
PLOT DATE	04/23/14
FILE FORMAT	ACAD 2014

DESIGN CRITERIA	APPROVALS
HFPA T2	JIM LUKE

REVISIONS
1. REVISED DRAWING SET 8/16/14
2. REVISED DRAWING SET 8/16/14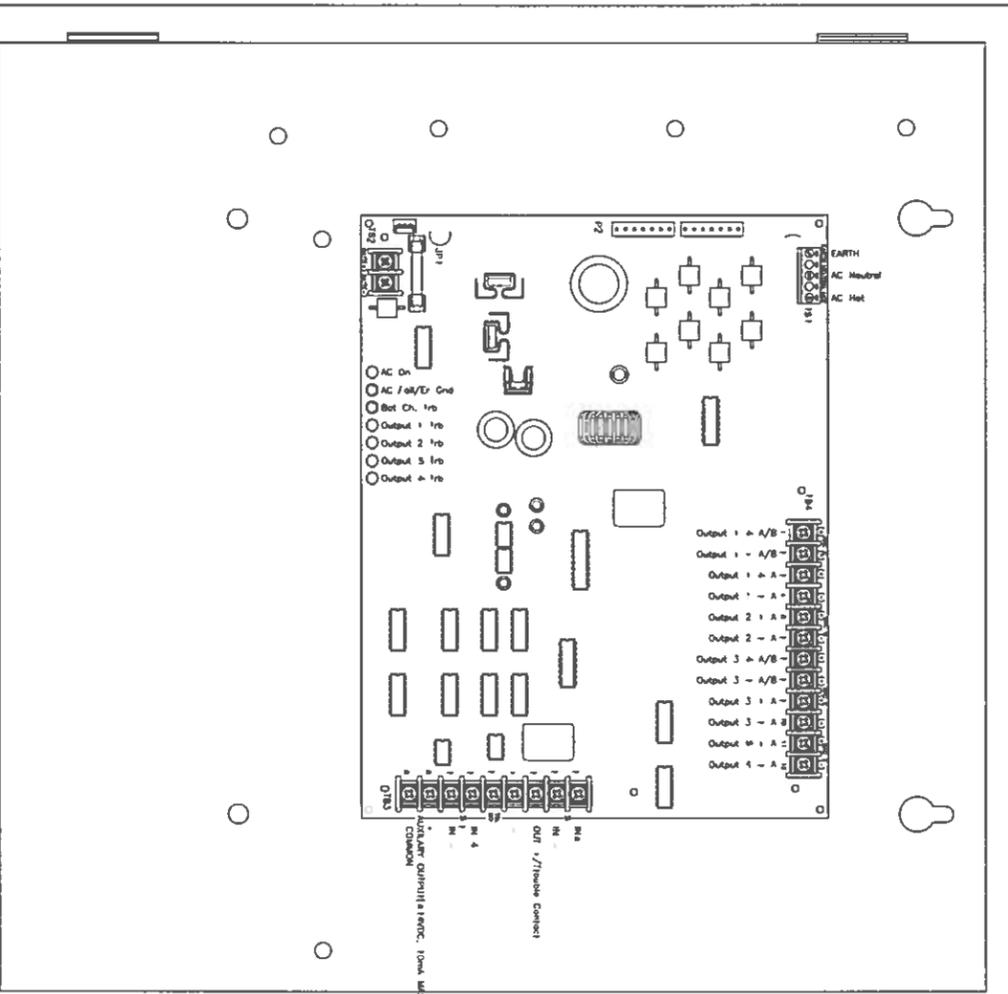
# FCPS-24FS Power Supplies

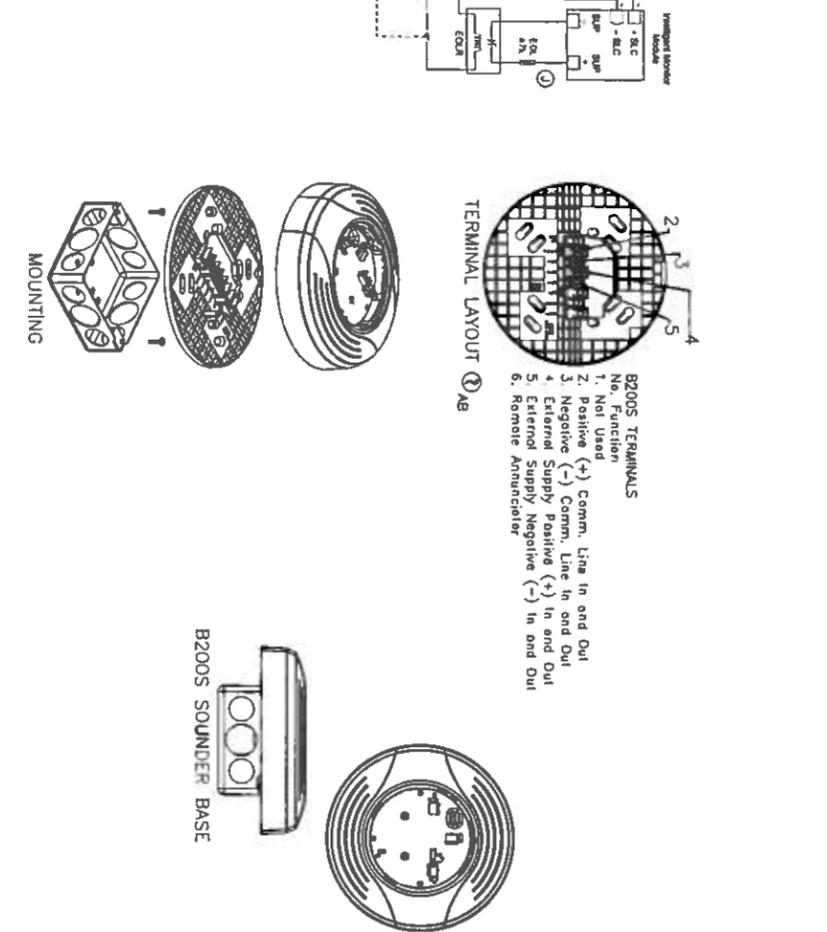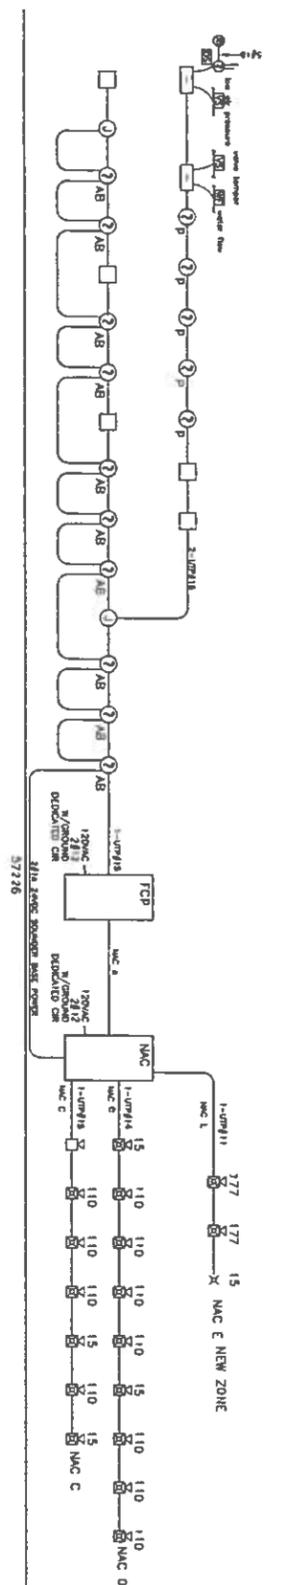

SYMBOL	LEGEND
1	FIELD CONTROL PANEL
2	FIELD MANIPULATOR
3	FIELD ADDRESS PANEL
4	POWER SUPPLY
5	SHOCK DETECTOR, PARALLEL W/ BOLD
6	SHOCK DETECTOR, SERIES W/ BATTERY
7	SHOCK DETECTOR, BUILT IN
8	SHOCK DETECTOR, BUILT IN
SECTION 15300 - FIRE SPRINKLER SYSTEM

PART 1 - GENERAL

- 3.1 References
  - A. Provide fire protection in accordance with the minimum provisions of the following codes and standards
    - 1. Latest UPC 2400-01 Fire Protection Engineering For Schools
    - 2. NFPA 117 Fire Sprinkler Systems 2010 Edition
- 1.2 System Description
  - A. New 7,000 Square Foot One Story Building Addition to Existing 2,180 Square Foot One Story Building.
- B. New 6" Underground Supply from existing water utility; see noted flow test information pertained by Odeon Utilities prior to RFP
- C. Dry Pipe System to protect the entire structure.

3.3 Submittals

- A. Product Data
  - 1. Submit product data for items specified in Part 2 and those products required by performance standards of this Section. Identify catalog designation and/or model number and clearly articulate each salient characteristic and design option of the product. Identify operation characteristics, performance curves and rated capacities of products and devices to show compliance with shop drawings and calculations.

- 2. Product data and shop drawings with calculations shall be jointly submitted for review.

B. Shop Drawings

- 1. Submit Fire Marshal approved sets of shop drawings and with calculations. Drawings and calculations shall include the NCCET certification and State of Alaska Permit (IC number and signature or stamp of a licensed professional engineer) and the fire protection contractor's Alaska specialty license number.
- 2. As a minimum, shop drawings shall include piping within the project back to the cold water source as indicated in the hydraulic calculations.

- 2. Shop drawings shall be submitted with information in compliance with NFPA 11 and other performance standards of this Section. Shop drawings shall include but not limited to the following (whether new or existing to be reused):

- a. Name of Contracting Agency, Occupant and Building Permit number.
- b. Permit number, including street address and permit description.
- c. Fire Department connections.
- d. Fire Department connections.
- e. Location of water source, type, routing, depth of bury, and size of supply piping, identify location and size of dry main and whether it is dead-end or dead-end at dead-end.
- f. Distribution system piping and controls, include pipe and fitting types.
- g. Reflected ceiling plan showing ceiling heights, construction type, proposed location and type of sprinkler heads, and other ceiling devices such as HVAC diffusers, loud speakers, type and location of light fixtures, etc.
- h. Inference control between sprinkler system and other tanks.
- i. Full height cross section, indicating basic building construction system, sprinkler piping arrangement, and elevation of highest sprinkler head.
- j. Locations of partitions. Identification of full height walls and draft stops.
- k. Location and size of unpermitted concealed spaces.
- l. Identification of unheated areas.
- m. Make, model, type, office, finish, and temperature rating of sprinklers and their respective locations. Clearly mark out the design remove area.
- n. The square footage area protected by each system.
- o. Hydraulic node points.
- p. The square footage area protected by each system.
- q. Hydraulic node points.
- r. Make, model, and size of the protection control valves, alarm valves, check valves, hose valves and related equipment.
- s. Identify low point drain and inspector test stations.
- t. Identify the type and location of piping hangers and equipment supports and seismic bracing.
- u. Make, model, size and location of pipe couplings, fittings, and fittings.
- v. Make, model, size, power requirement, and location of alarm bells, buzzers, detectors, and other alarm panels.
- w. Provide for flushing and backflow device system demand forward flow test and test discharge to safe location.
- x. Name, address, and telephone number of the Contractor. If design is by a separate firm, include the name, address, telephone number, and fax number of the design firm.
- y. Complete legend of abbreviations and symbols indicated.
- z. Complete schedule of room occupancies.
- aa. Make, model, and size of structural penetrations.
- bb. Make, model, and size of structural penetrations.
- cc. Location of fire rated walls.
- dd. Total number of sprinklers on each dry-pipe system.

C. Design Data

- 1. Submit complete hydraulic calculations @ 65% submittal which were used to prepare the design drawings.
- 2. Product data and shop drawings with calculations shall be jointly submitted for review @95% review.

- 3. Water flow information used for hydraulic calculations.

- a. Waterflow performed by Odeon Utilities and Chinoak Fire Protection [1]-30-17]. Results were as follows:
  - Static Pressure - 55 PSI
  - Residual Pressure - 47 PSI
  - GPM Flowing - 019
  - Hydrant # FC-6

- b. Hydraulic calculations shall be a completed in compliance with the procedures established in NFPA 11 in addition to minimum NFPA 11 standard, a minimum 10 percent pressure and flow buffers are required to be designed into the system.

O. Operation and Maintenance Manual

- 1. Include manufacturers' descriptive literature, operating instructions, installation instructions, maintenance and repair data, part listings, and spare parts list.

E. Maintenance Information and Planned Building Plan

- 3. Coordinate with Section 16721 Addressable Fire Alarm System and provide information like complete building floor plan showing system control valves, drain stations, alarm and control panels, test valves, and other primary fire protection devices, indicate sprinkler zones, sounders, and types of systems. Submit this plan prior to substantial completion for review by the Contracting Agency.

- 2. Provide three copies of the latest edition of NFPA 75

- 3. Include shop-by-shop procedures for required operations, water/hydraulic services and testing. Provide a complete report of field test operations and results prior to substantial completion.

F. Record Drawings

- 1. Maintain current and up-to-date As-Built prints of the protection system at the job site.
- 2. Approved full size As-built drawings and electronic copy shall be submitted with O&M manuals.

\*IX17 DRAWINGS ARE HALF THE INDICATED SCALE\*

PART 2 - PRODUCTS

- 2.1 General
  - A. Provide only products that are a standard product of a manufacturer regularly engaged in the manufacture of fire protection equipment.
- B. Dry-pipe systems for fire protection shall not be used.

- 2.2 Labels and Approvals for products
  - A. Products UL or FM listed, labeled and specifically approved for the fire protection application, whose files are used.

2.3 Manufacturers

- A. Sprinkler System Components:
  - 1. Reliable.
  - 2. Grinnell-Gem.
  - 3. Vaisky
  - 4. Kennedy.
  - 5. Milwaukee.
  - 6. Potter-Rohren
  - 7. Corlier.
  - 8. Dacalar.
  - 9. Power Electric.
  - 10. Telsco.

2.4 Pipe and Fittings

- A. Wet Pipe Sprinkler Systems
  - 1. Any steel piping system currently recognized by NFPA 11 might be used. It tested for no intended service by UL or FM.
  - 2. Whenever piping other than steel schedule 40 is utilized, submit a statement that the piping complies with NFPA 11 standards and that the piping strength is adequate for the application. Piping corrosion resistance rating (CCR) shall be equal or greater than 1.0, equivalent to schedule 40 pipe. Include the CCR data in product submittal.

2.5 Fittings

- A. Grooved Fittings, Couplings and Mechanical Tees
  - 1. Grooved Fittings: Victaulic, Grinnell, Sprink, cast iron, ductile iron or equal.
  - 2. Slip-Fit fittings and couplings utilized for joining branch piping to non main piping shall be "Victaulic" or "Grinnell" brand as required.

- B. Threaded Pipe Fittings: Cast iron 175 pound ANSI B16.4 or ductile iron 300 pound ANSI B16.3

- C. Pipe Flanges: Cast Iron Class 150 pound ANSI B16.5

- D. Welded Pipe Fittings: Limited to Weld-locks, Thread-locks, Groove-locks and welded flanges

2.6 Valves and Alarm Assemblies

- A. Valves: UL or FM listed and labeled and specifically approved for the fire protection application where they are used
- 1. Central Valves: Fire protection system control valves shall be supervised with switches compatible with the fire alarm system or other methods in full compliance with NFPA 11.
- a. OS&Y Gate Valve: Minimum working pressure 175 psi non-shock cold water, UL listed for the protection

- b. Provide supervision of each fire protection control valve, compatible with fire alarm system, Potel Electric Signal Co. Model OSYS-B or approved equal.
- c. Backflow Device: Backflow assemblies and devices shall have successfully passed the laboratory and field evaluation tests conducted by the University of Southern California Foundation for Cross-Connection Control and provided in accordance with the Uniform Plumbing Code requirements.

- B. Provide sprinkler alarm valve assemblies, appropriate to the system, complete with fittings and accessories for proper alarm initiation and interface with the alarm system. Include inlet and discharge pressure gauges, main drain, and inspector test connection.

C. Dry Pipe Automatic Sprinkler Systems:

- 1. Riser Dry Pipe Valve Assemblies:
  - a. Provide sprinkler Dry Pipe valve assembly, appropriate to the system, complete with fittings and accessories for proper alarm initiation and interface with the alarm system.
- b. Include inlet and outlet pressure gauges, and main drain with safe discharge to the outside.

2. Water Flow Detectors:

- a. Provide pressure type water flow detector installed at each system or zone control and for the main system header for multiple zone systems.
- b. Potel electric Model P 810A and P 810A or equal

- D. Provide electrical alarm and control wiring in accordance with Division 16.

2.8 Sprinkler Heads

- A. Fire sprinkler heads to be symmetrically laid out in each separate room or space
- B. Provide sprinklers as required by NFPA 11 standards. Sprinkler finish and style as follows:
  - 1. In areas with recessed lighting fixtures attached to finished suspended ceilings, provide standard spray pendant sprinklers, and as conditions to pass them the sprinkler detectors below the light fixture. Sprinklers and as conditions to be chrome finish.
  - 2. In areas with recessed lighting flush to the suspended ceiling finish, provide recessed standard spray pendant sprinklers. Sprinklers and as conditions to be chrome finish.

- 3. Sprinklers above ceilings and exposed ceiling areas shall be bronze finish, standard spray, upright or pendant type

- 4. Sidewall sprinklers shall be bronze finish in service areas, and chrome through out public areas.

- 5. Dry pendant sprinklers protecting entry vestibules and other areas susceptible to freezing temperatures shall be chrome finish.

- 6. Sprinklers of correct temperature rating shall be installed according to NFPA 11.

- 7. Provide sprinkler wrench for each type of sprinkler.

- 8. Spare sprinkler cabinet to be red brass steel manufactured by the sprinkler manufacturer. Size the cabinet in accordance with NFPA 13 standards. Provide sprinklers for the cabinet. Representative of the assemblies provided for the system. Mount cabinet on the wall within 60 inches of the sprinkler control room.

- 9. Provide additional sprinklers as required by NFPA 13.

2.9 Pipe and Equipment Anchors, Bracing, Hangers and Supports

- A. Provide seismic anchoring, bracing, supports, and clearance for equipment, piping and sprinkler heads per NFPA 11 and NFPA 240-01. Most conservative criteria shall govern.

2.10 Insulators and Connections

- A. Provide insulators (test connection for complete system testing)

- 2.11 Dry System Air Compressor
  - A. Provide tank mounted air compressor sized per dry pipe system capacity. GALT Model or approved equal.
  - B. Electrical connection is described in Division 18 work.

PART 3 - EXECUTION

3.1 Contractor Coordination

- A. The fire protection contractor shall coordinate his work with the work of other trades to assure timely installation and efficient use of mechanical areas.

3.2 Piping Installation

- A. Install in accordance with codes and recommended practices for the type of work. Follow manufacturer's installation instructions.

- B. Install piping to conserve building space and route piping around roof hatches, access panels and maintenance access.

- C. Install low point drain stations in accordance with NFPA 11. Identify the location of drain and test stations with signs on access panels, ceiling panels, or walls adjacent to the station, visible from the floor. Discharge test pipes, backflow systems demand flow tests and system main drain to safe location outside.

- D. Seismic protection for piping system shall be in accordance with NFPA 11 standards. Provide clearance at structural penetrations, structural elements, and equipment.

- E. Piping shall be concealed in areas with finished ceilings when possible. Coordinate with the other trades to take timely advantage of available space above ceilings.

- F. Provide penetrations where pipes pass through walls, floors, or ceilings. Penetrations shall be in accordance with UL Fire Resistance Directory or Through Penetration Firestop Systems (RHEZ)

3.3 Flushing and Testing

- A. Flush underground service piping and distribution piping before connecting underground piping to sprinkler system.
- B. Arrange for proper witnessing of tests as required by Authority Having Jurisdiction and as specified elsewhere
- C. Conduct tests in accordance with applicable codes. Test piping at minimum 200 psig hydrostatic for two hours

FIRE SPRINKLER LEGEND

	Pipe
	Fire Department Connection
	Grooved Coupling
	Grooved Cross
	Grooved Elbow
	Grooved Tee
	Threaded Cross
	Threaded Elbow
	Threaded Tee
	Flange
	Flex Drop
	Mechanical Tee
	Angle Valve
	Gate Valve
	OS&Y Valve
	Ball Valve
	Backflow (1 Bulb only)
	Check Valve
	Butterfly Valve
	Riser Manifold
	Dry Valve
	Pressure Reducing Valve
	Electric Bell
	Waterflow Detector
	Hanger
	Hose Valve
	Hydrant
	Pump
	Sprinkler (Upright)
	Sprinkler (Pendant)
	Sprinkler (Sidewall)
	Dry Ratchet Sprinkler
	Supply
	Swey Brace
	4-Way Swey Brace
	Remove Area
	Hydraulic Node

AS-BUILT  
9-17-14

CAMP CARROLL, JBER  
BUILDING #57226  
ADDITION

12651 Old Scoward Highway, Anchorage, AK 99511  
Phone: (907) 344-3473 (FIRE) Fax: (907) 344-3411  
chinookfire@gmail.com

GDM inc.  
ARCHITECTURE • PLANNING

JOB NO.: 130715  
FP-1  
DATE: 14 APRIL 2014

FIRE SPRINKLER SPECIFICATIONS



