

Alaska Department of Military and Veterans Affairs
Division of Administrative Services

Invitation for Quotes # 09-006-26

Replace Eyewash Station on 176th AGE Shop

Addendum 1

Date of Issue: 12/31/2025

Addendum 1 to answer questions from interested offerors and make changes to IFQ. This Addendum 1 is hereby made part of the IFQ and is a total of 3 pages.

Issued by:

Jannah Alagano

Procurement Specialist 3

Email: MvaDasProcurement@alaska.gov

Questions submitted by potential bidders and answers from the state:

Question 1: Please confirm that the contractor can utilize the nearest local circuit to power the alarm and that installation of a new dedicated circuit from the panel is not required?

Answer: Yes, nearby power sources are available, no new circuit required.

Question 2: Will heat trace be required on the water lines?

Answer: No, heat trace not required

Question 3: The drawing labeled “Figure 3-AGE EWS Location As-built” appears identify one of the EWS locations on the exterior of the building, can you confirm if this is accurate?

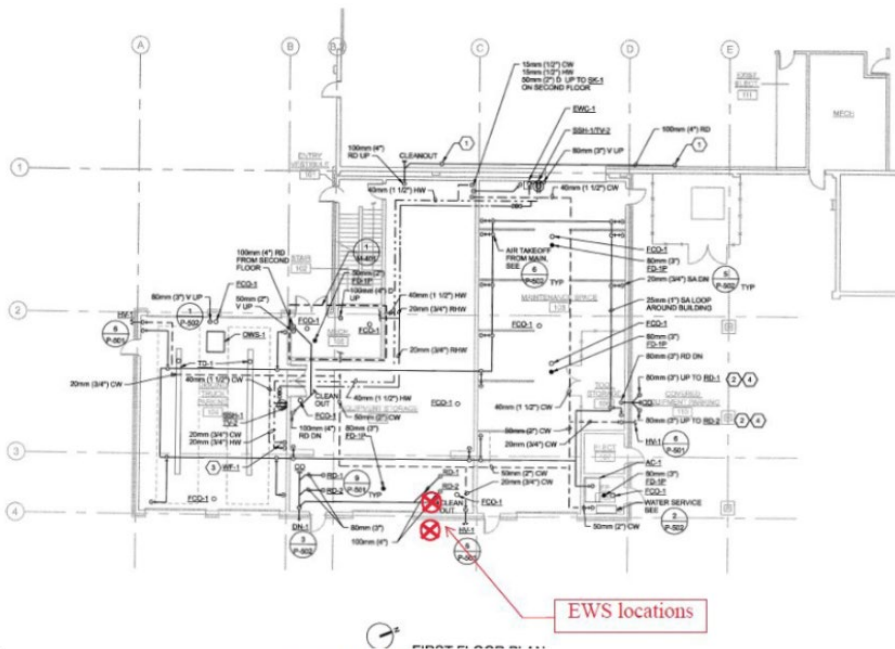


Figure 3- AGE EWS location as-built

Answer: A building addition was constructed on the other side of South wall in the as-built. Both EWS will be inside.

Changes to the IFQ:

Change 1: The deadline for receipt of quotes has been extended to **January 12, 2026, at 2:00 P.M. AKST.**

Change 2: A site visit is scheduled on **Thursday, January 8, 2026, at 10:00 A.M.** Attendees for the site visit are required to contact Ryan Nguyen by phone at 907-552-0085 or email at ryan.nguyen.7@us.af.mil one (1) day prior to the scheduled site visit so arrangements may be made for a base pass

End of Addendum 1