
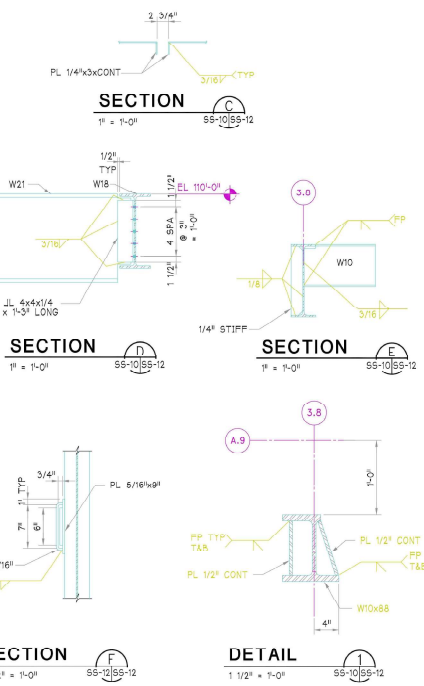
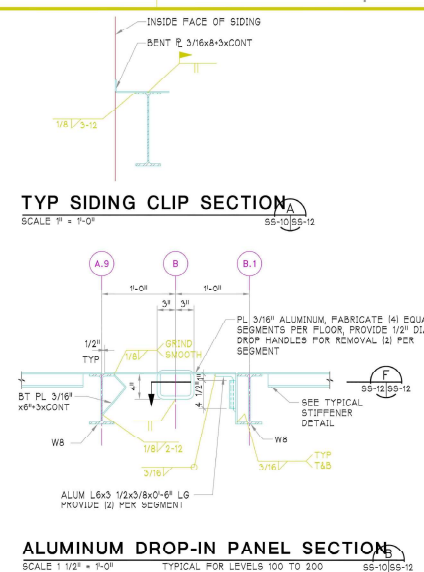


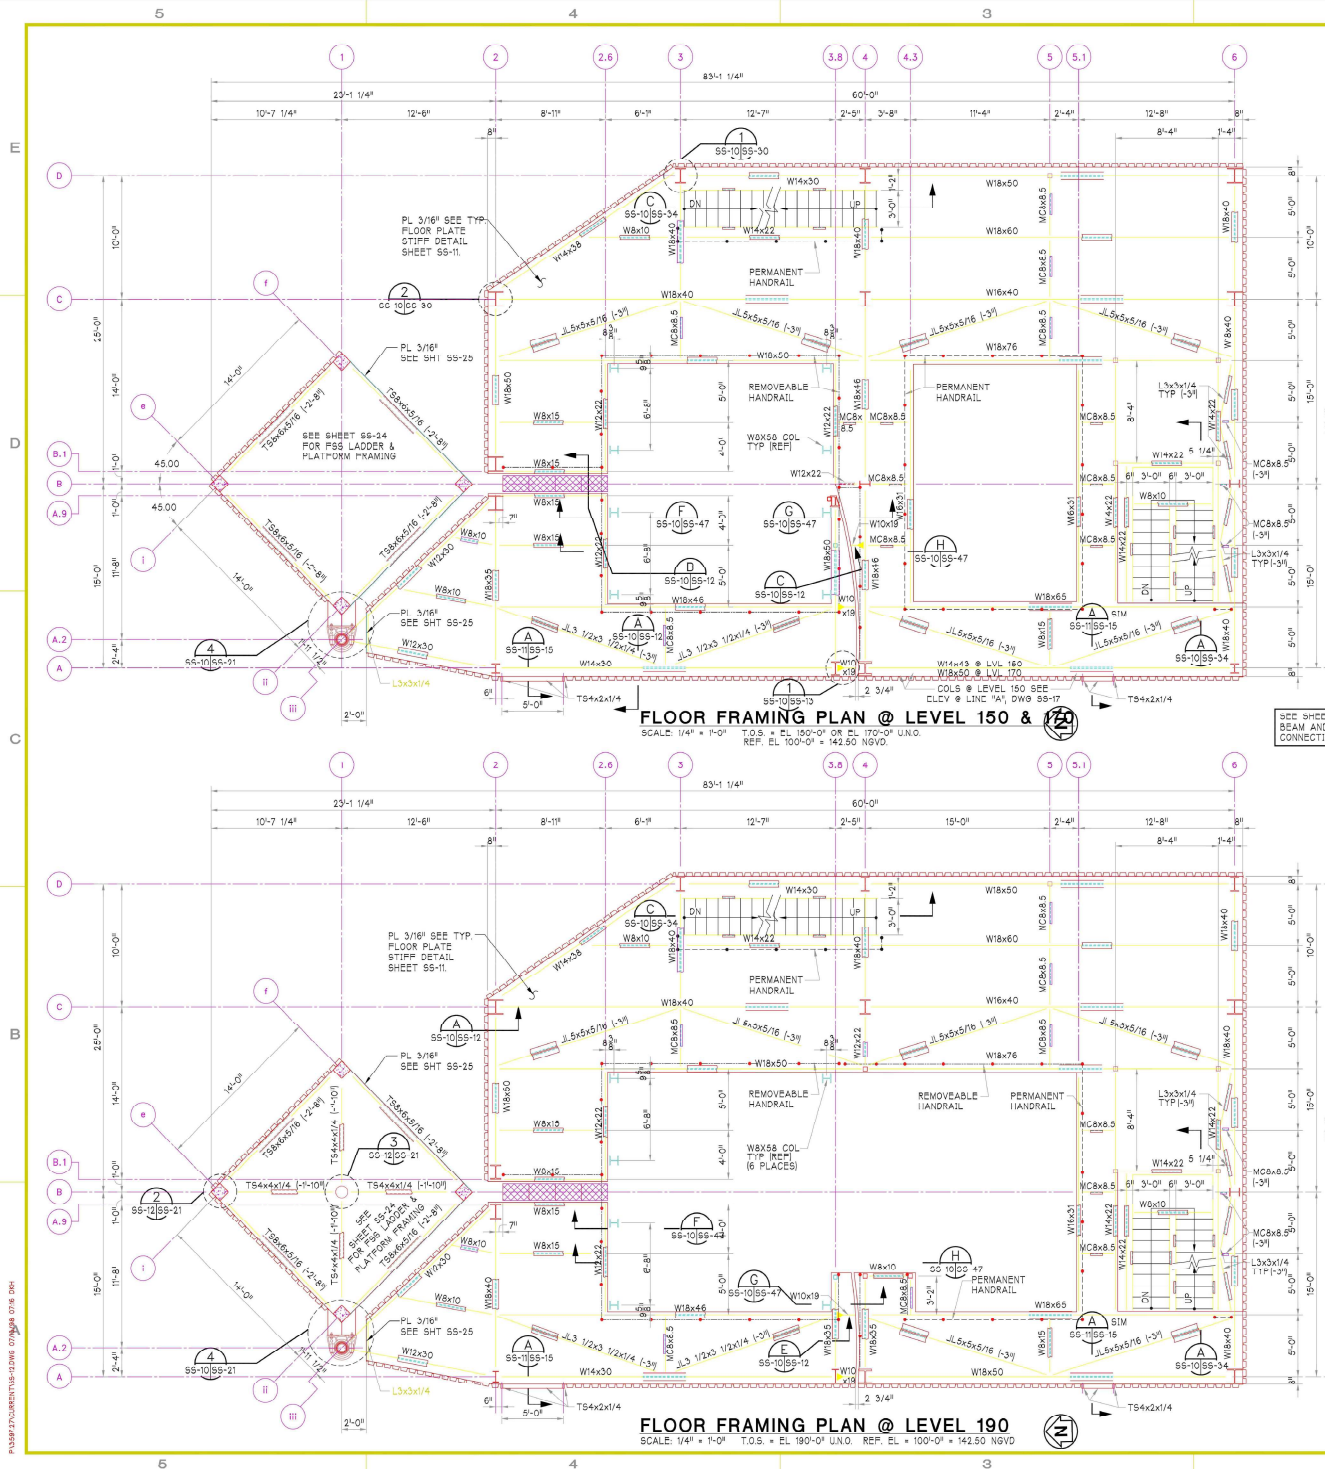

FLOOR FRAMING PLAN @ LEVEL 150 & 190
SCALE: 1/4" = 1'-0" T.O.S. = EL. 180'-0" UNO. REF. EL. 100'-0" = 142.50 NGVD.

FLOOR FRAMING PLAN @ LEVEL 190
SCALE: 1/4" = 1'-0" T.O.S. = EL. 180'-0" UNO. REF. EL. 100'-0" = 142.50 NGVD.

DATE	7-1-98
DESIGNED BY	ELI PRITTI
DRAWN BY	VANDERLAAR
CHECKED BY	WASTE
CAD CODE	34975766-15
PROJECT NO.	359727
DRAWING NO.	SS-12
SHEET	OF

ALASKA AEROSPACE DEVELOPMENT CORPORATION
KODIAK LAUNCH COMPLEX
NARROW CAPE, KODIAK ISLAND, ALASKA
LAUNCH STRUCTURE PHASE 3
FLR FRMG PLAN @ LVL 150, 170 & 190

BRPH ARCHITECTS - ENGINEERS, INC.
3274 SUTREE BOULEVARD
MELBOURNE, FLORIDA 32940
Copyright © 1998
Unauthorized use or reproduction is prohibited.

RECORD DRAWING