



REV. MK.	DESCRIPTION	BY	DATE	APPROV.
1	REVISED PANELS TO AS BUILT	B.T.		

42 CIRCUIT PANEL #1 IN ENG. ROOM

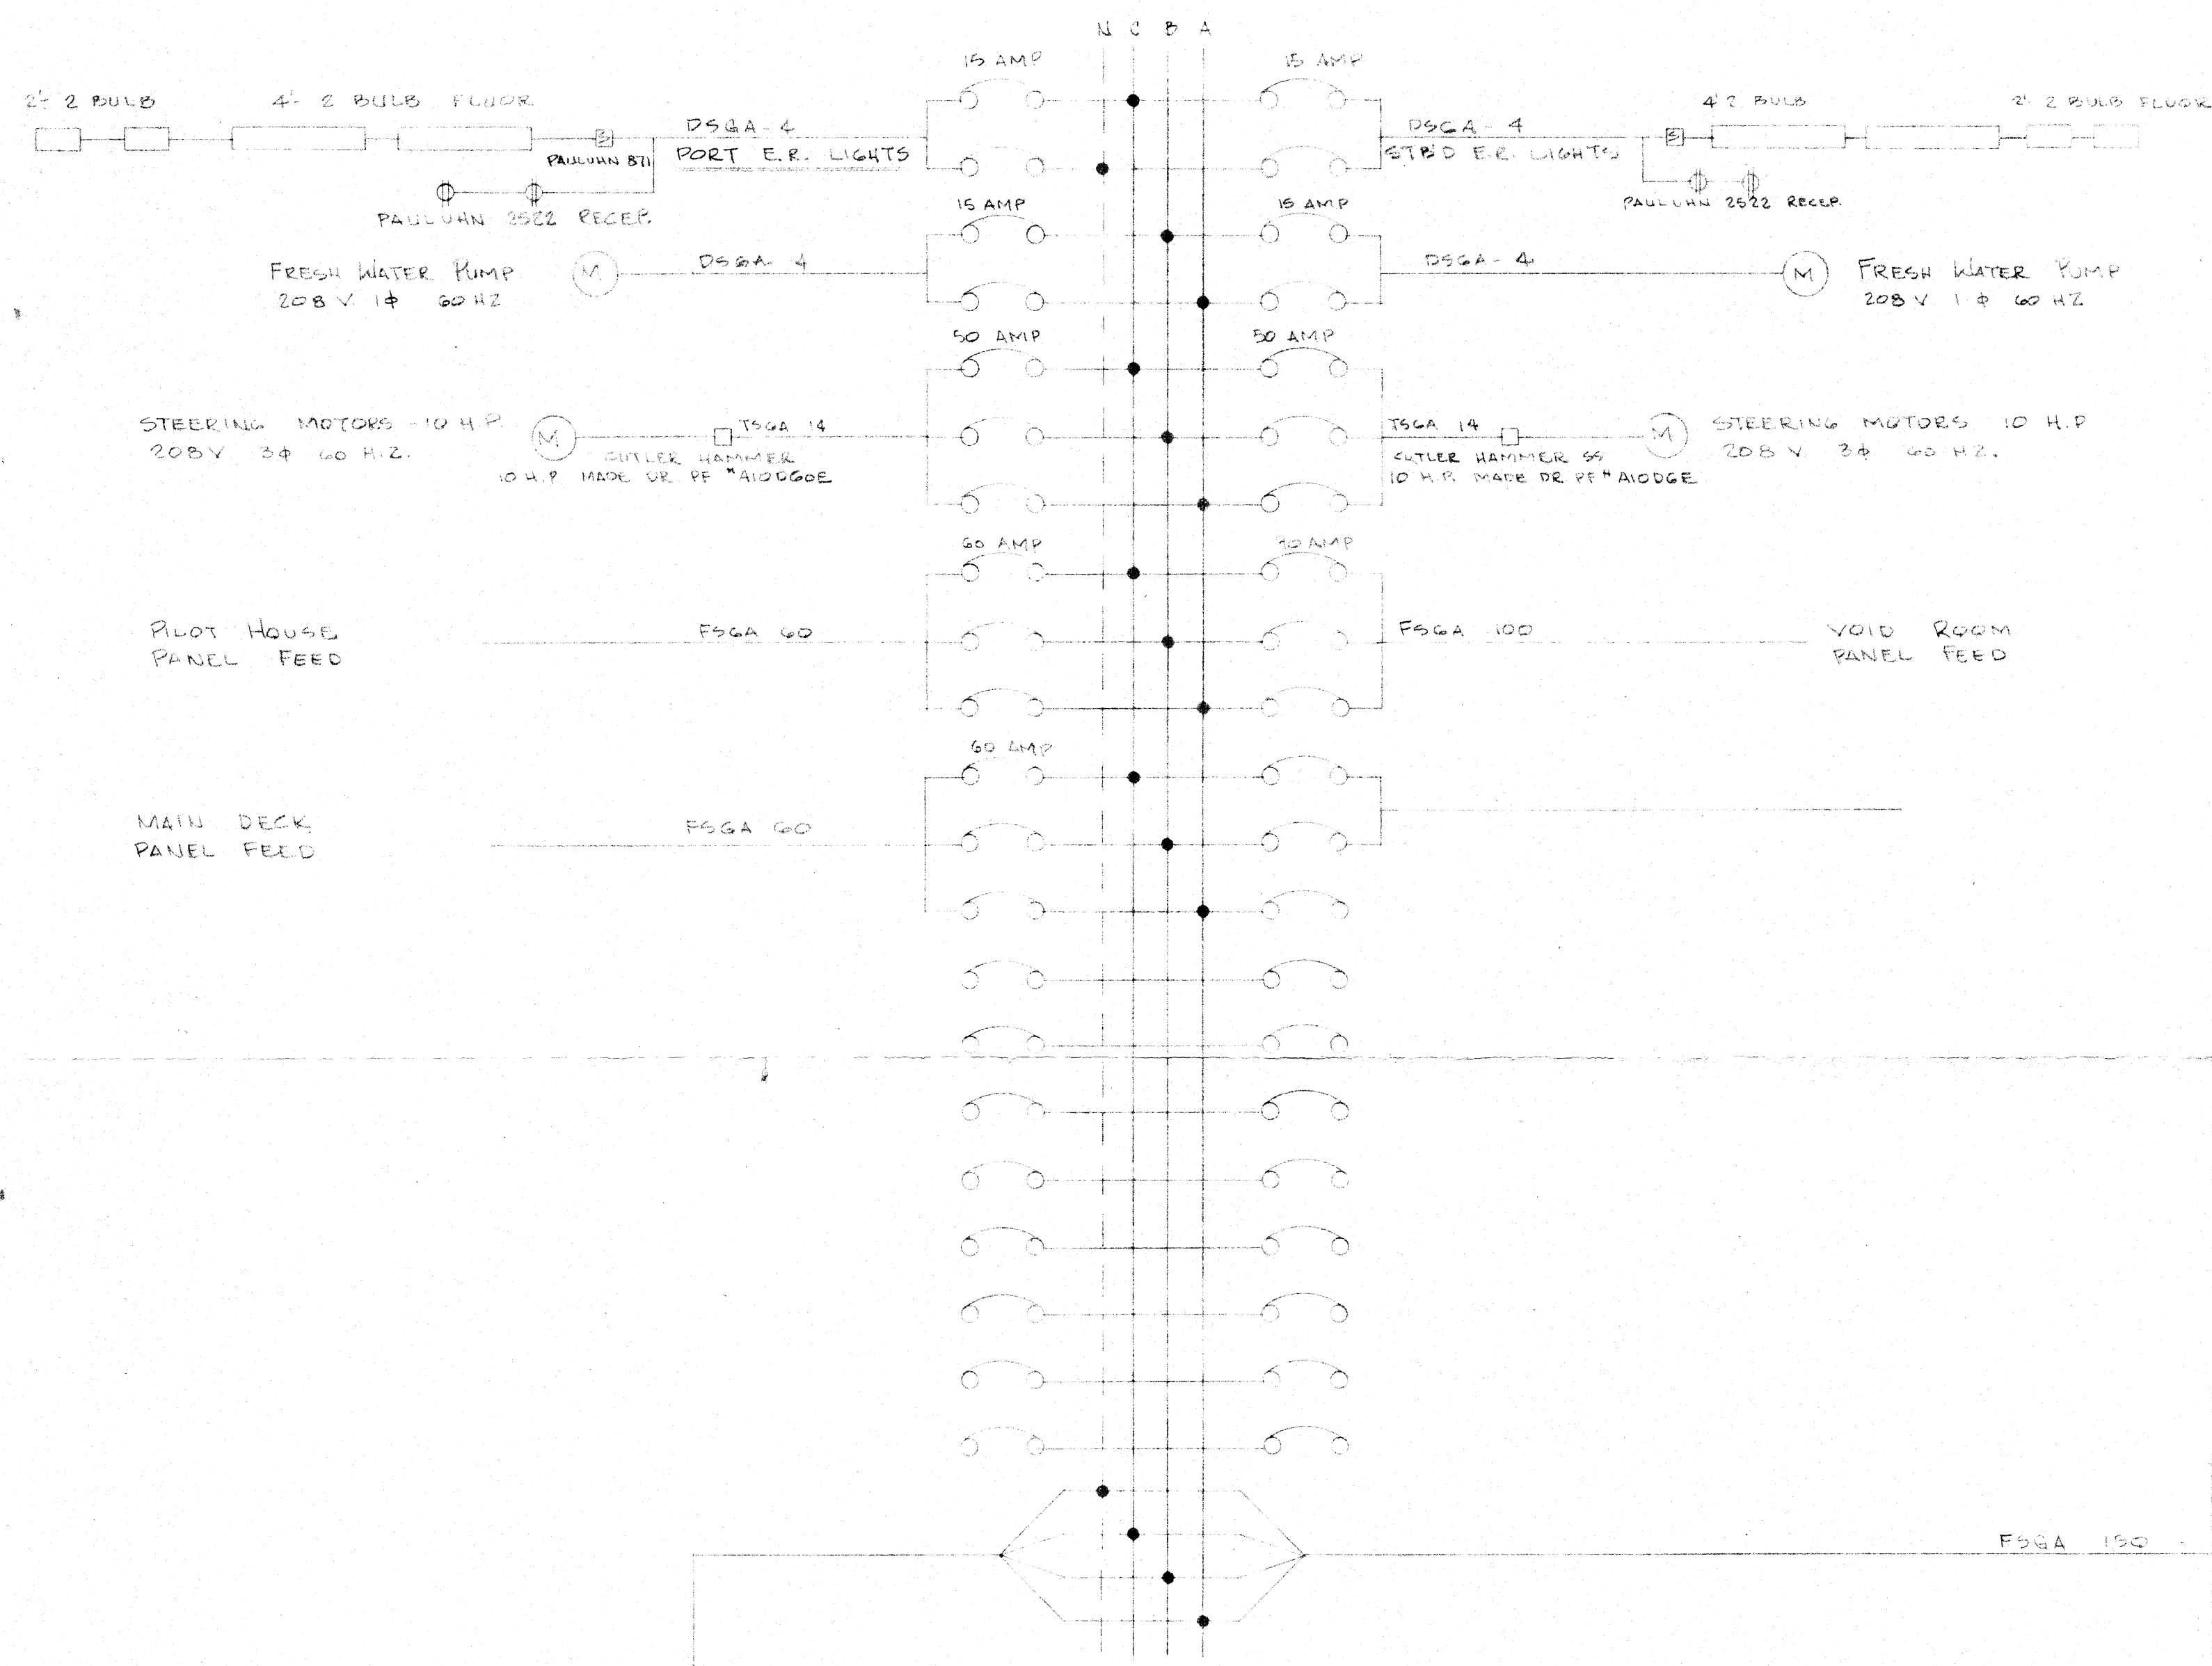

42 CIRCUIT PANEL #2 IN ENG. ROOM

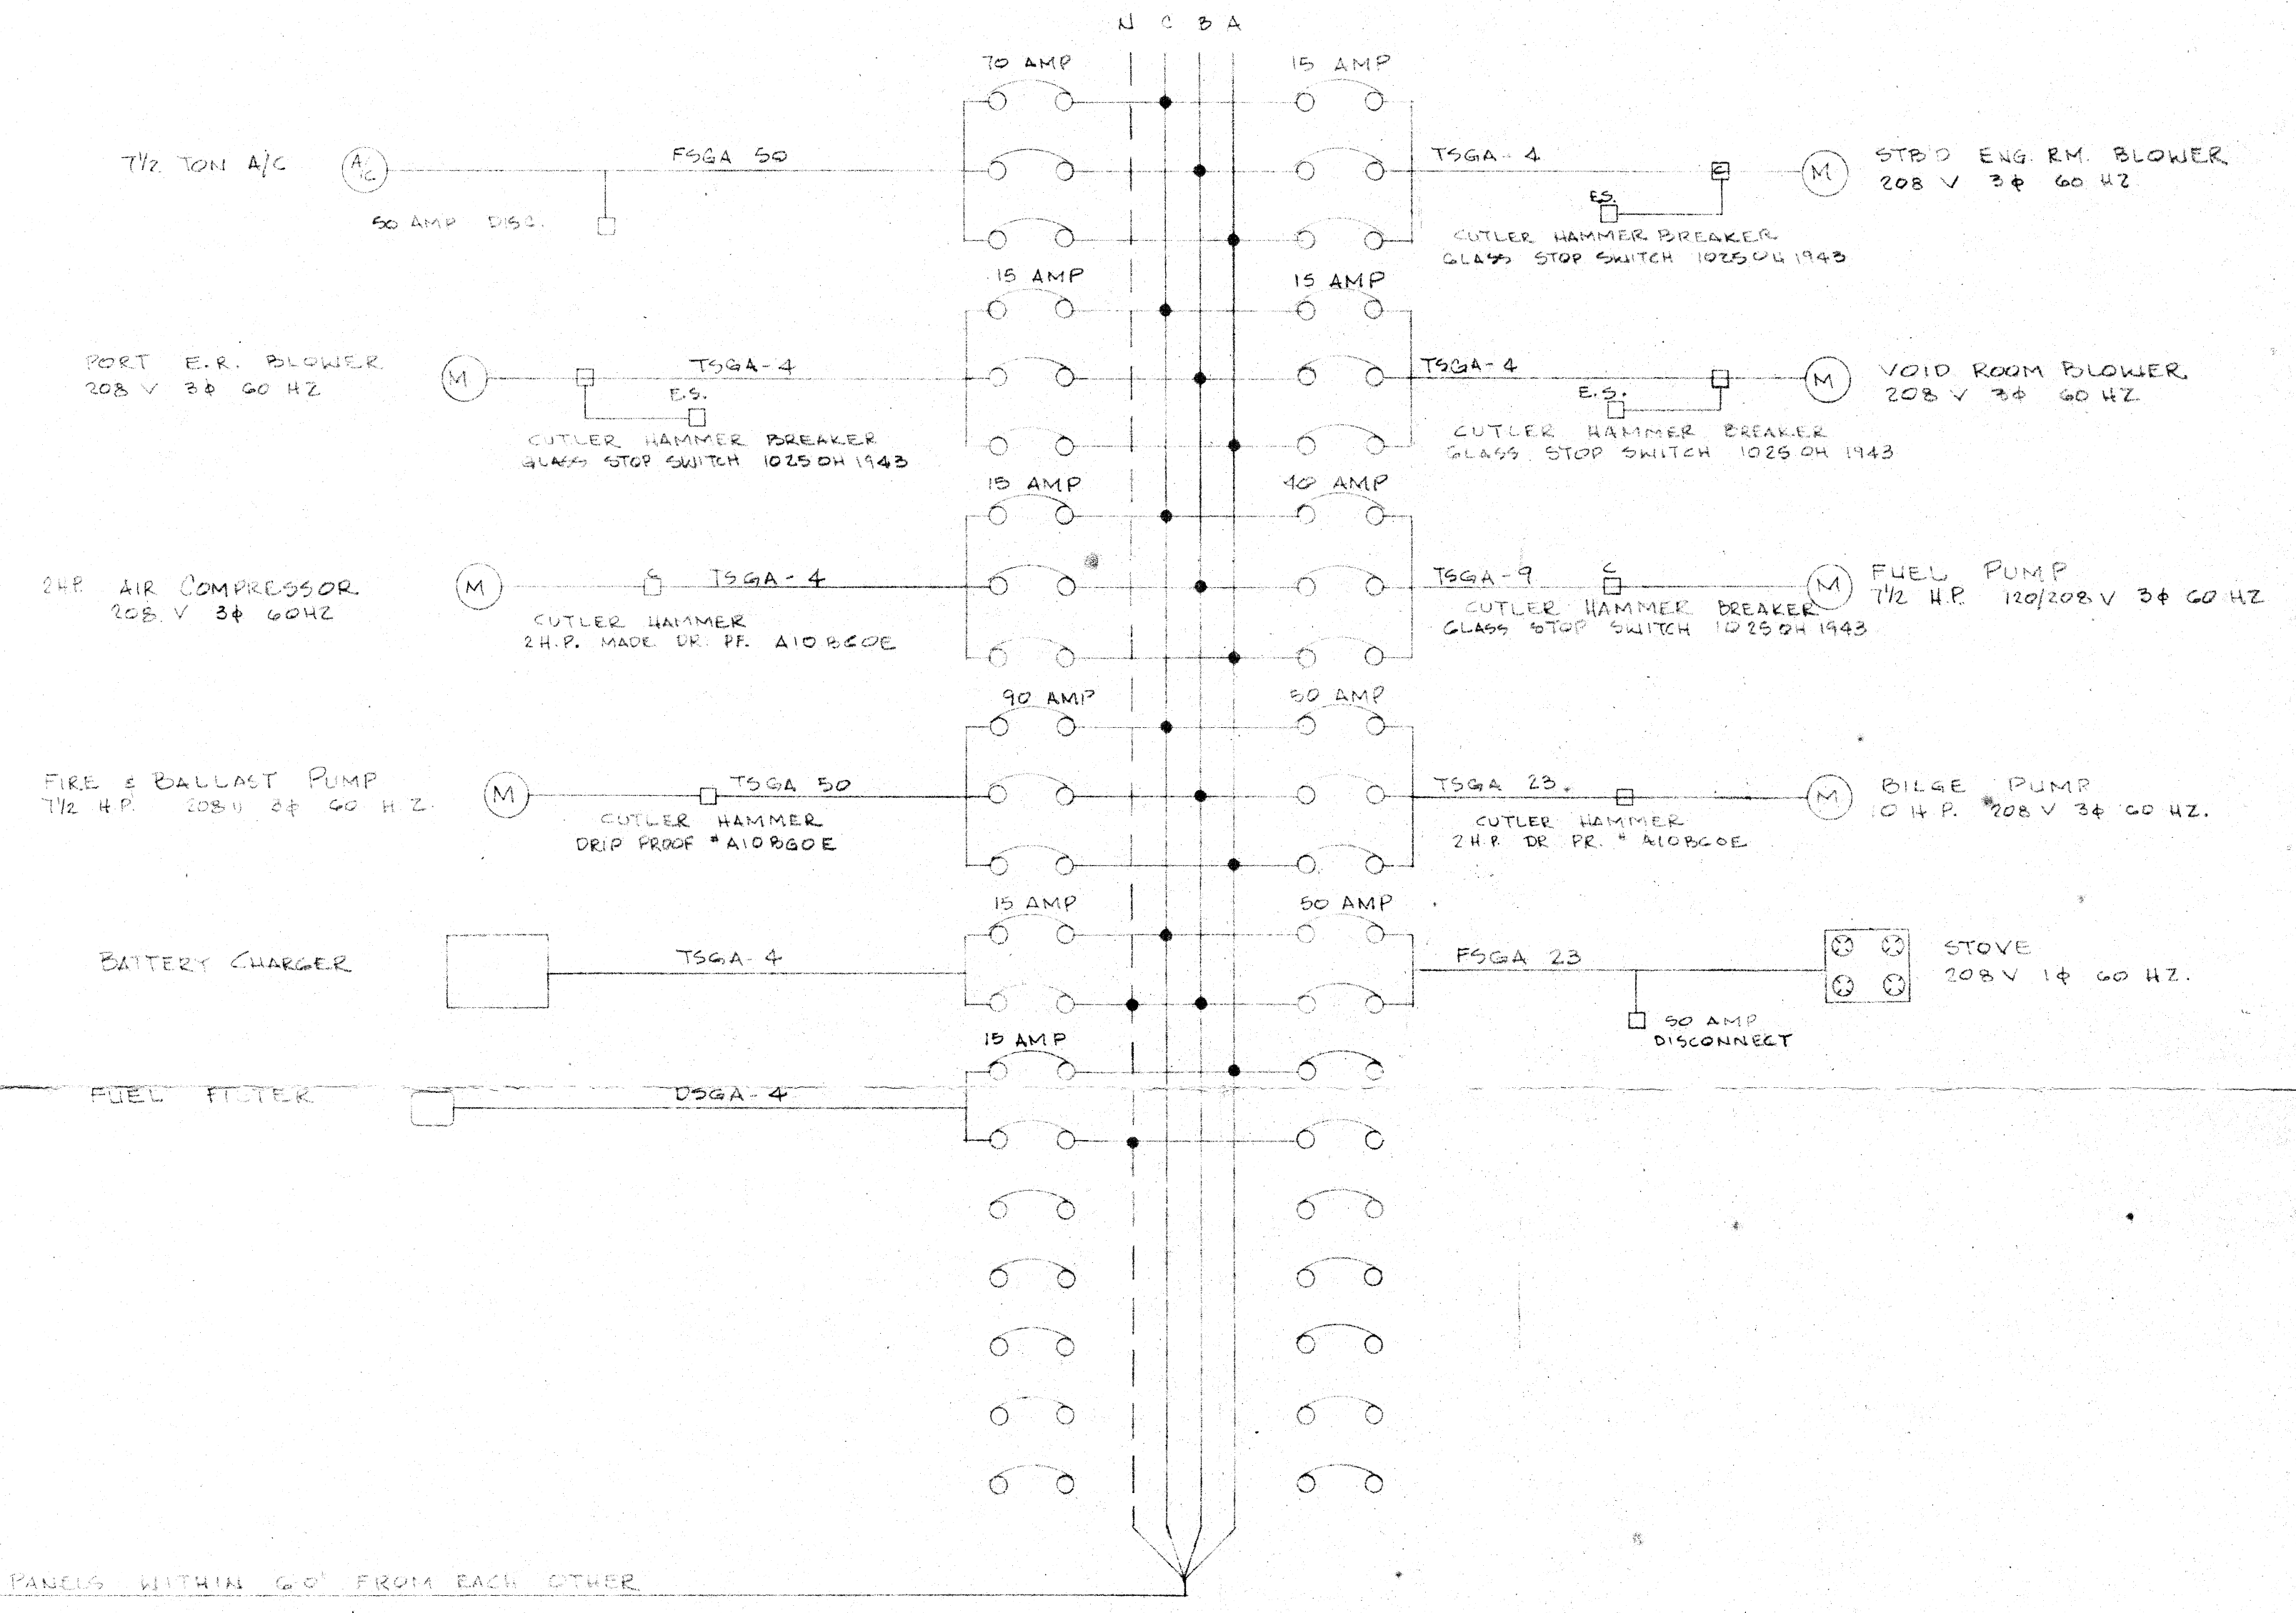


GENERATOR CONTROL PANEL
SEE POWER PANELS DRAWING NO'S
382-206-1 & 382-206-2

GEN #1
50 KW

GEN #2
50 KW

PANELS WITHIN 60' FROM EACH OTHER

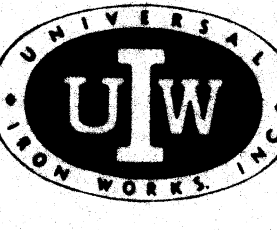

UNICO
IRON WORKS, INC.

P.O. BOX 9056
301 PROSPECT ST.
HOUMA, LA. 70361

PHONE
504-868-2575

110'-0" x 26'-0" x 12'-0" SMALL PASS VESSEL

42 CIRCUIT PANELS NO. 1 & 2

DR. B.T.	DATE 1-4-83	DWG. NO. U192-EL	REV.
CK.	SCALE NONE		