




REV. MK.	DESCRIPTION	BY	DATE	APPROV.
1	REVISED TO AS BUILT	BT	1-5-83	

42 CIRCUIT PANEL NO. 3 IN VOID ROOM

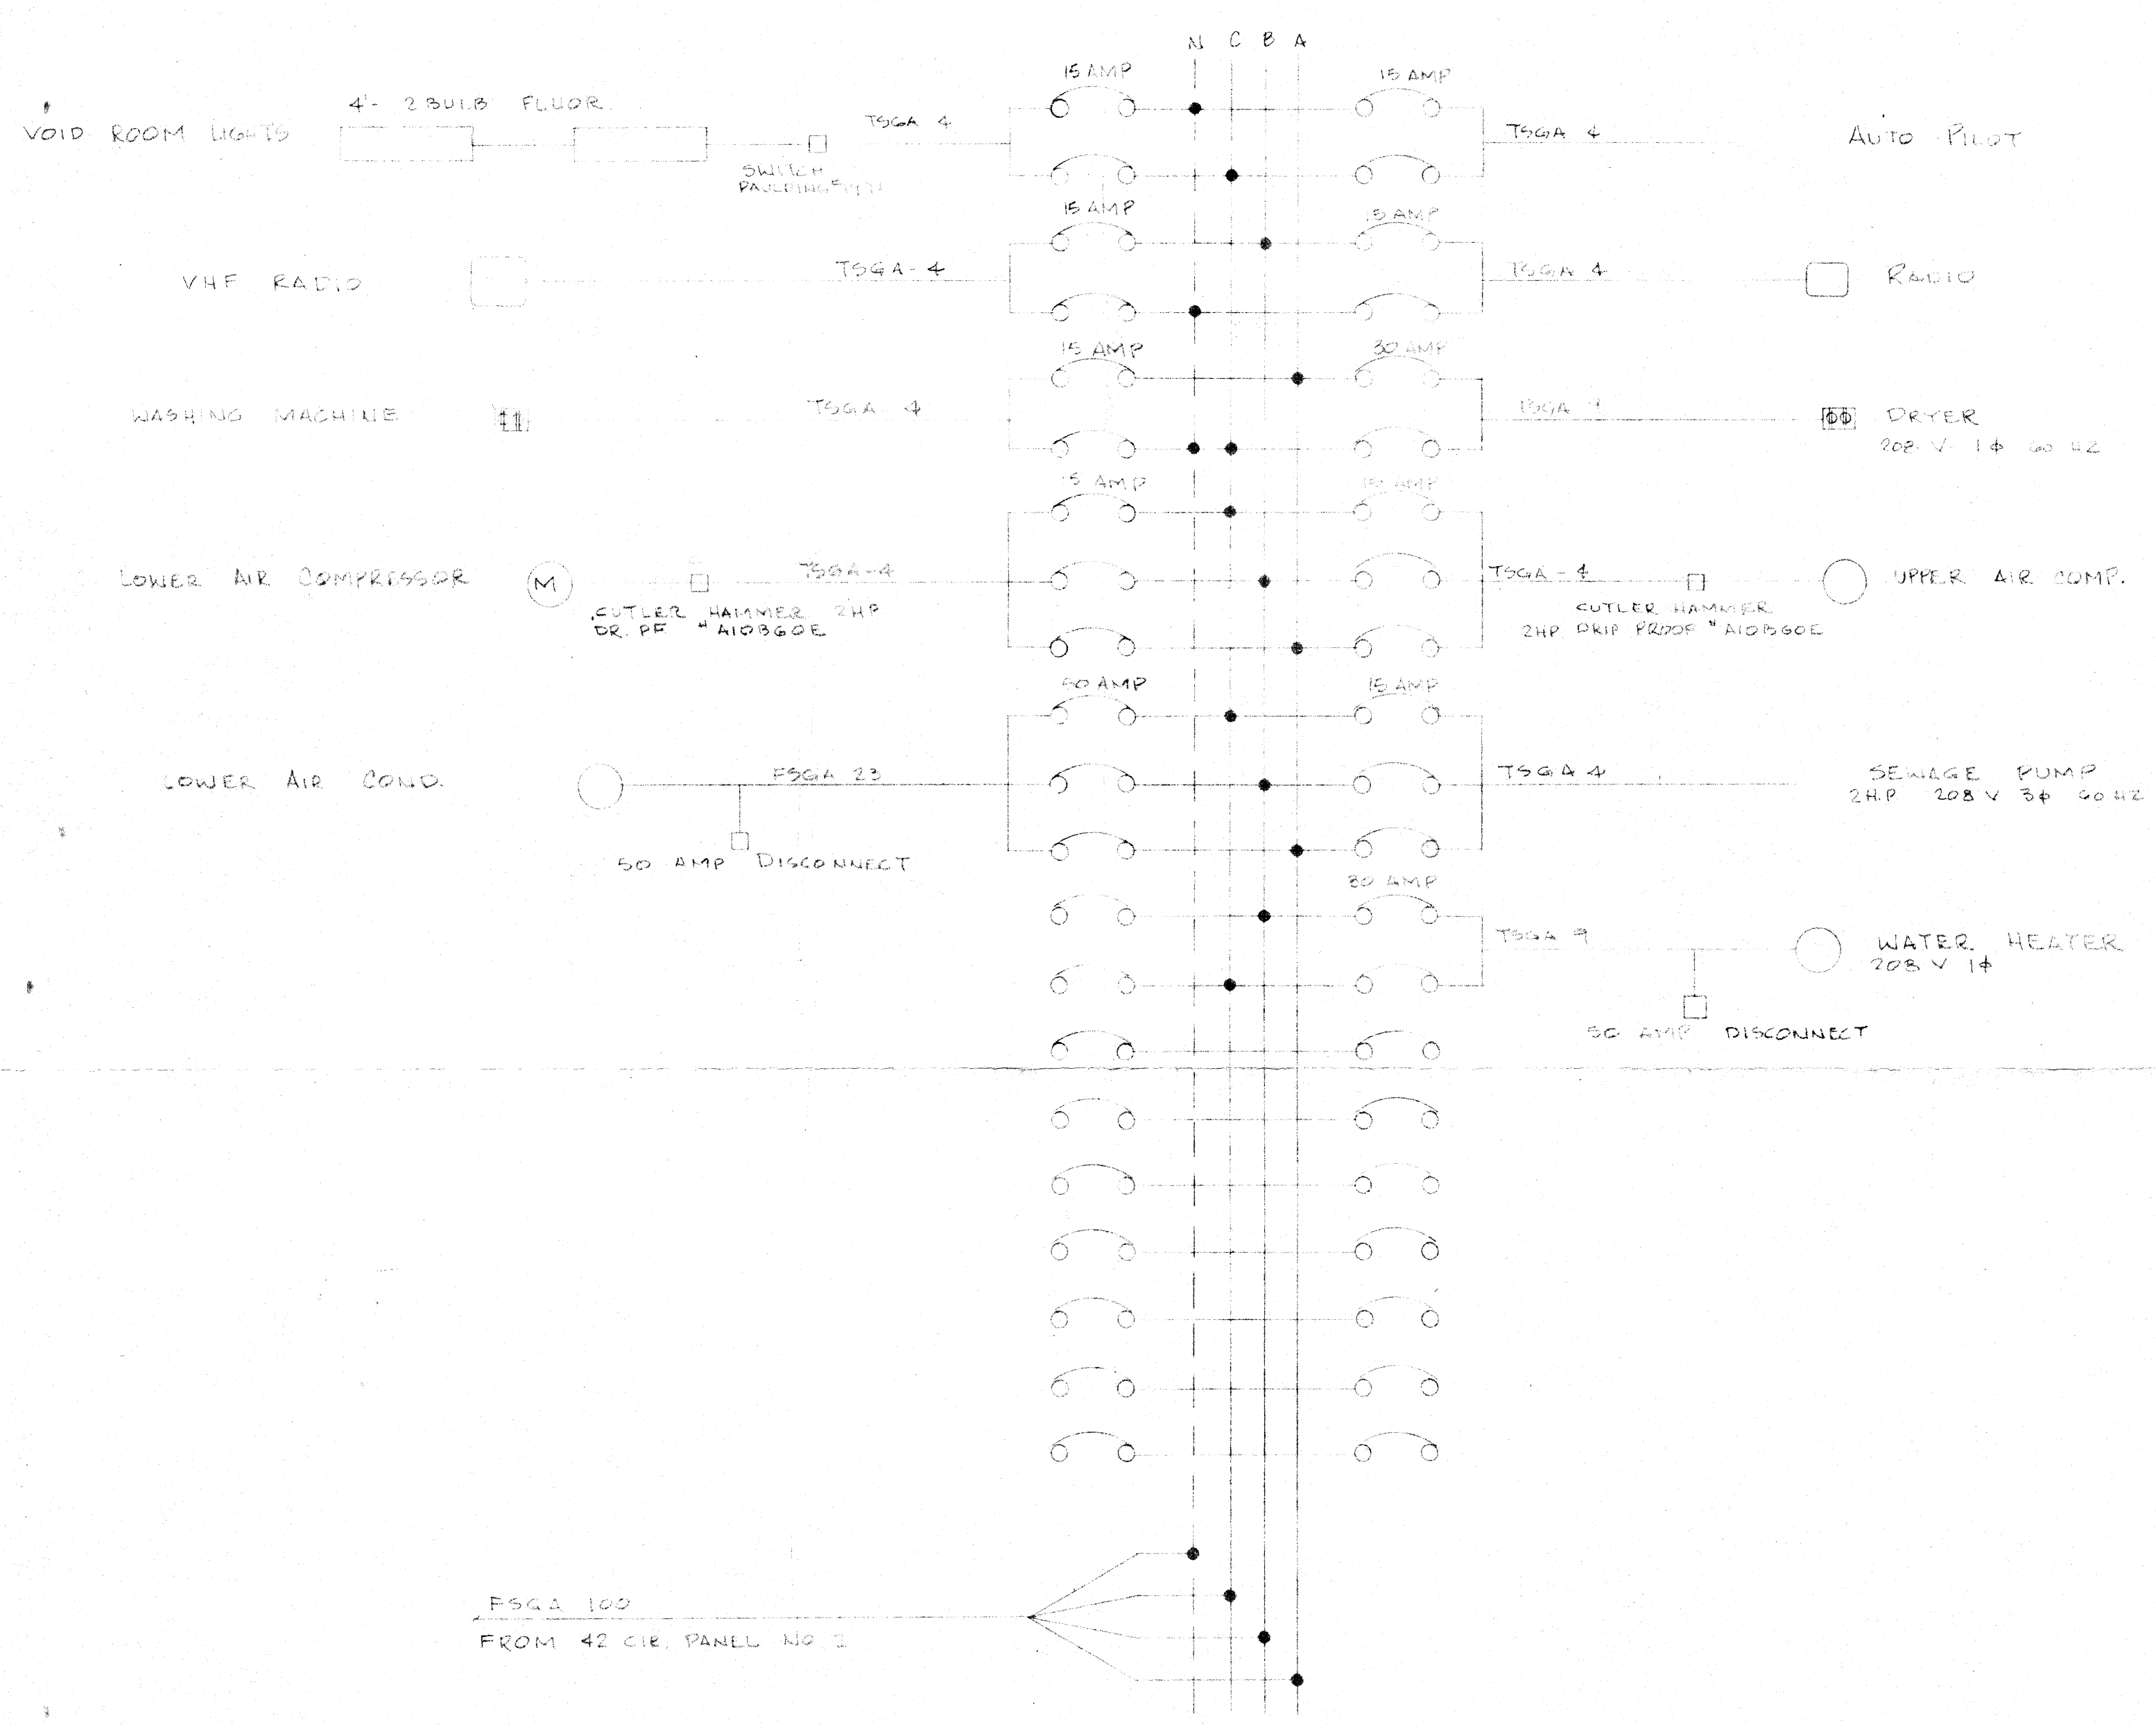

42 CIRCUIT PANEL LOCATED IN MESS AREA- NO. 4

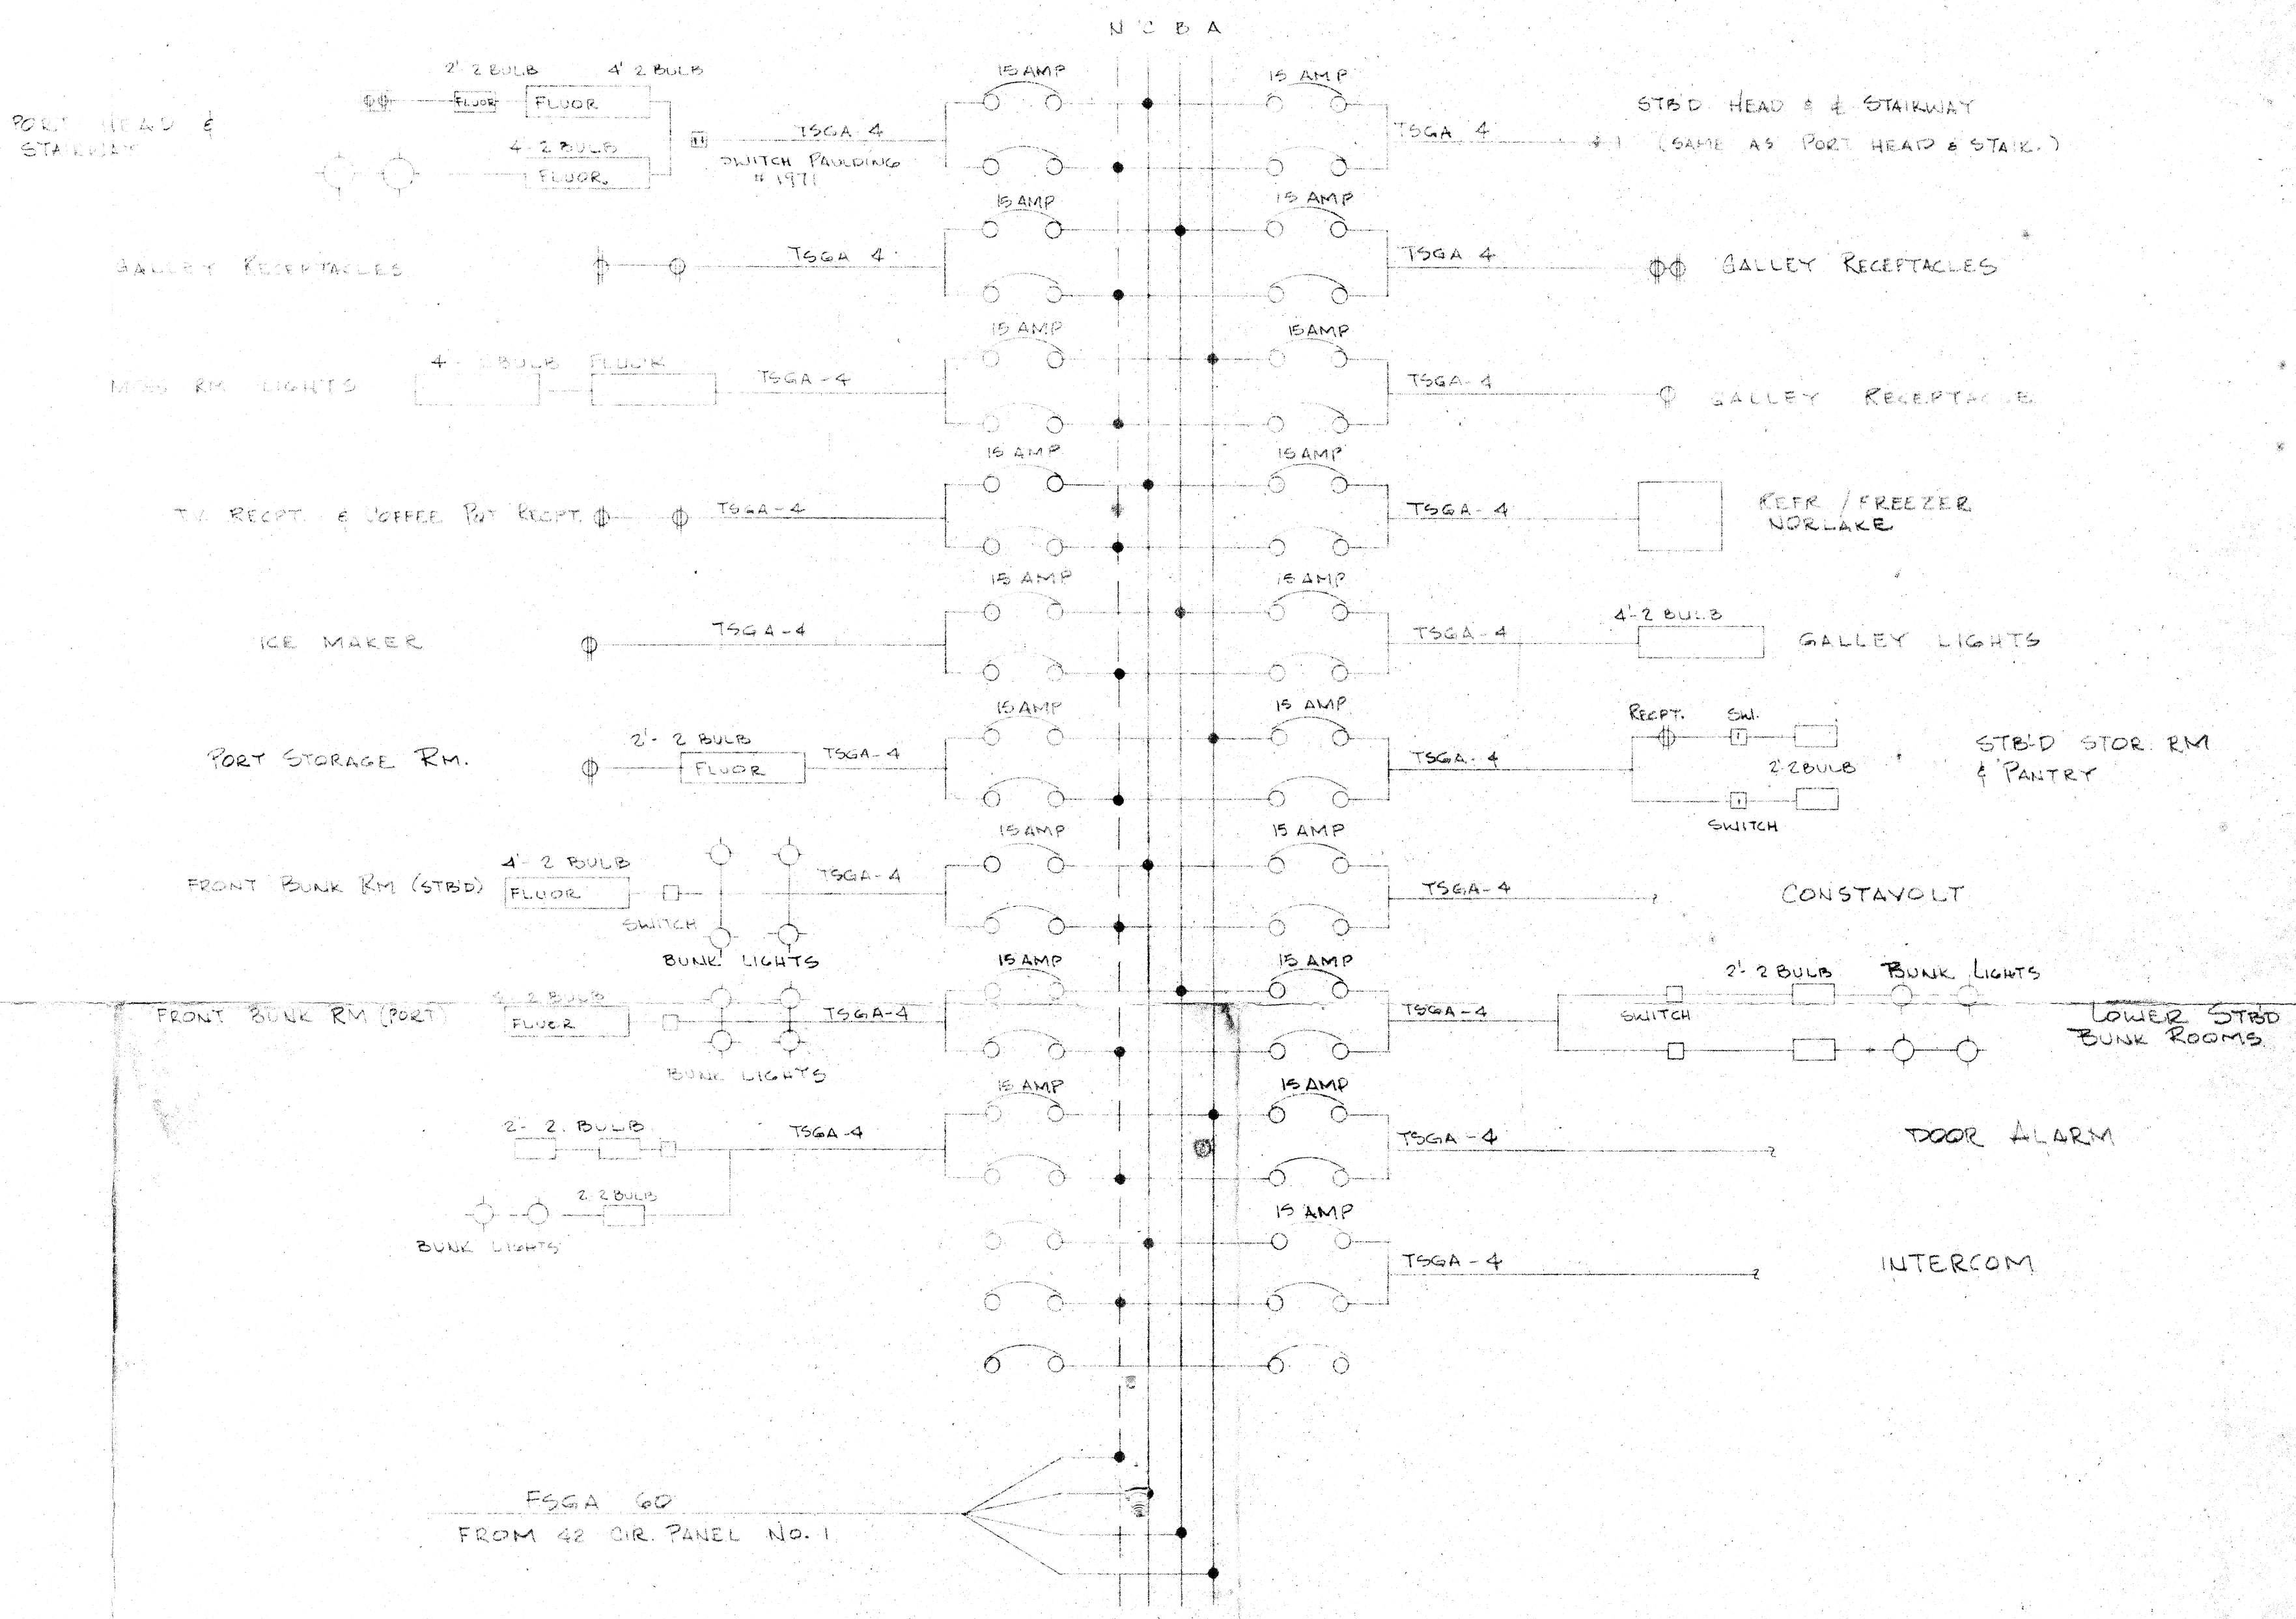

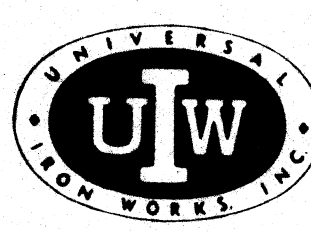


P.O. BOX 9056
301 PROSPECT ST.
HOUMA, LA. 70361

PHONE
504-868-2575

110'-9" x 26'-0" x 12'-0"
SMALL PASSENGER VESSEL
42 CIRCUIT PANELS NO 3 & 4

DR. BT	DATE 1-5-83	DWG. NO.	REV.
CK	SCALE NONE	0192-2	1

JUNING 40-22 31945-6