


REV. MK	DESCRIPTION	BY	DATE	APPVD.
1	REVISED TO AS BUILT	PST	11/02	

42 CIRCUIT PANEL NO 5 LOCATED IN PILOT HOUSE

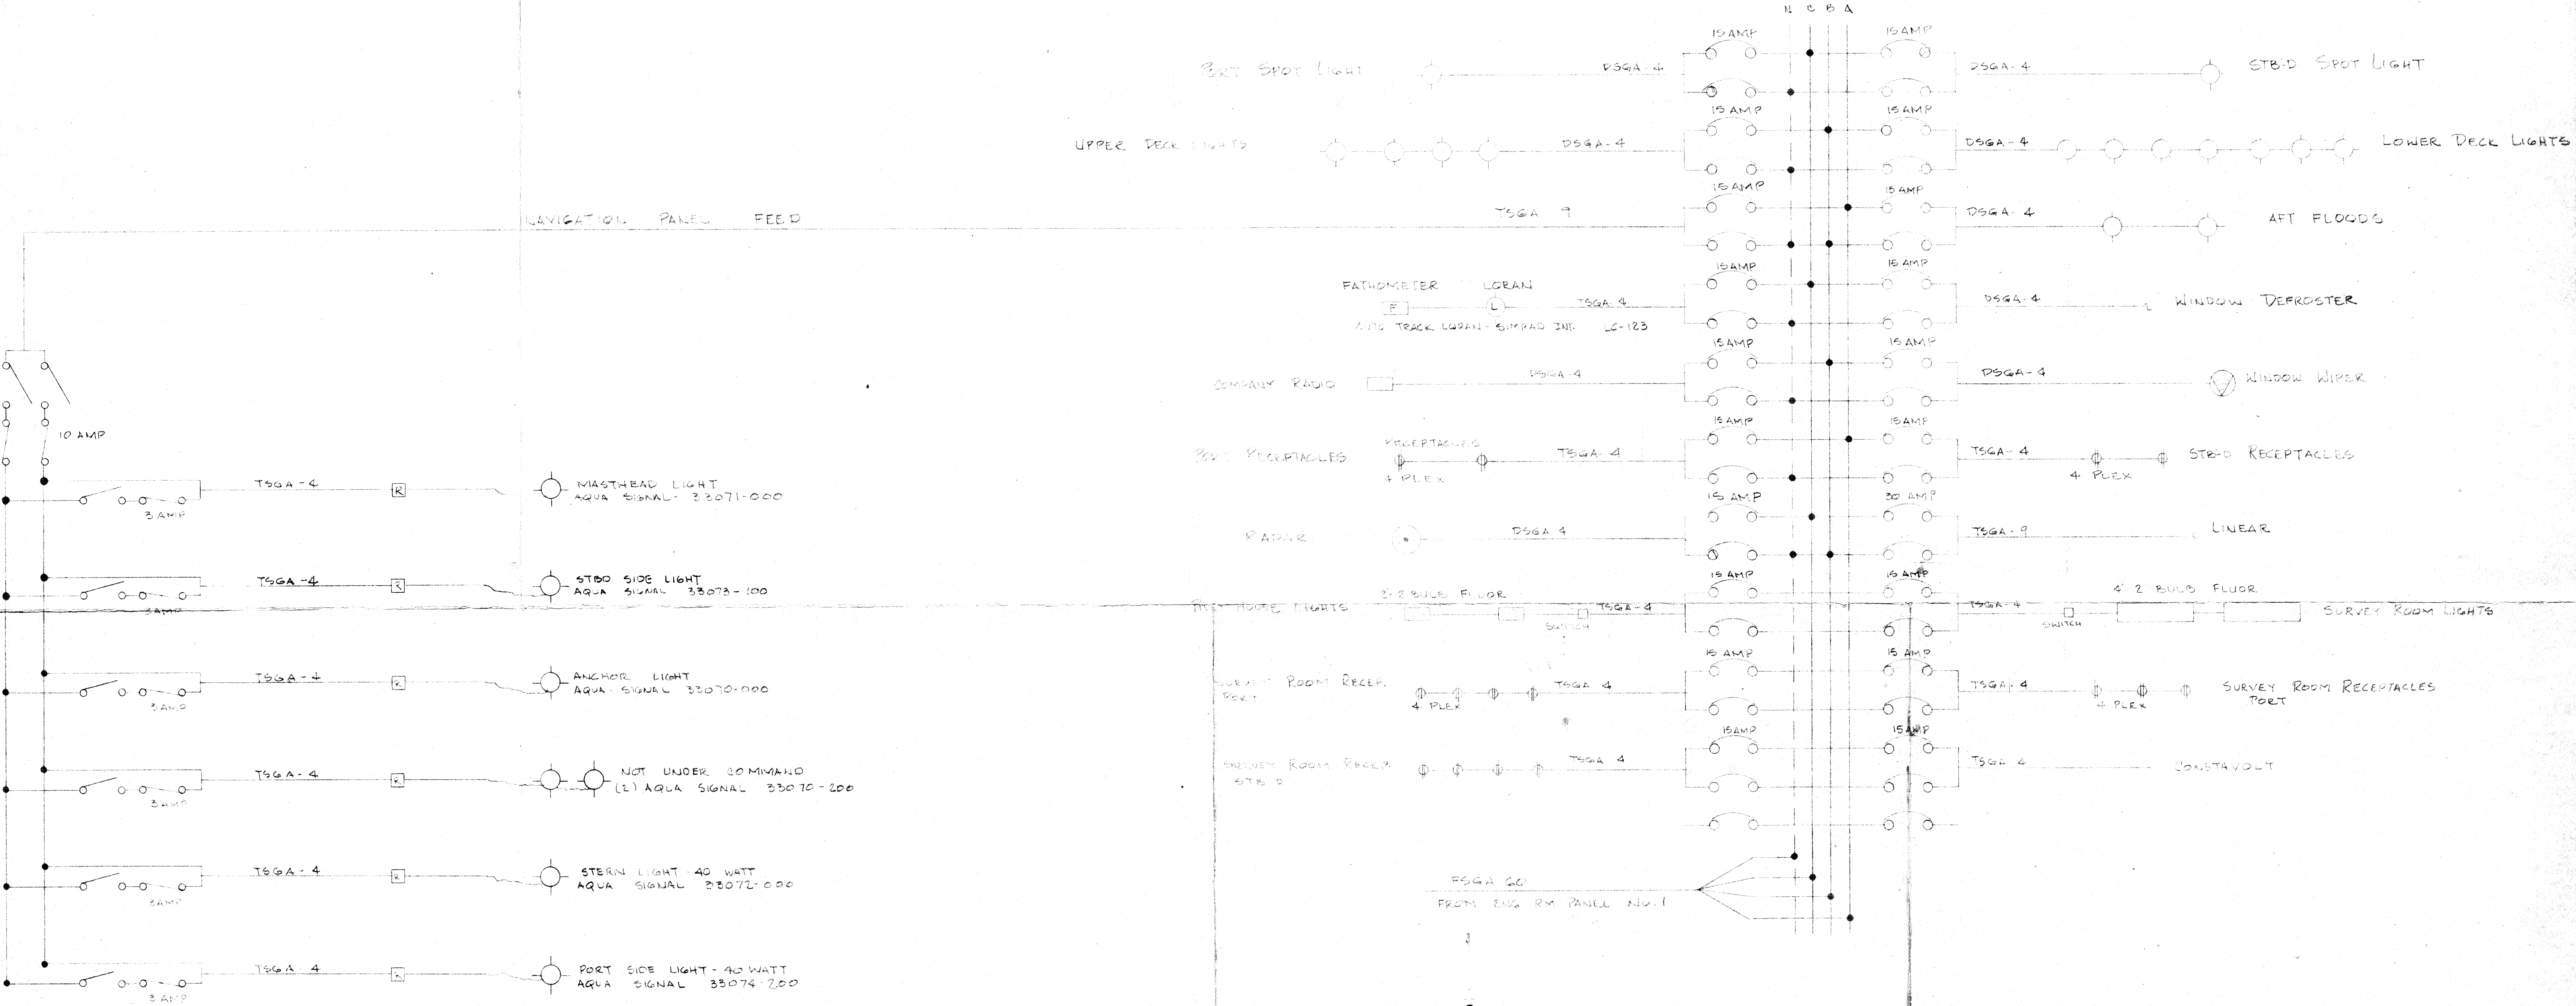

P.O. BOX 9056
301 PROSPECT ST.
HOUMA, LA. 70361

PHONE
504-868-2575

10'9" x 26'0" x 12'0"
SMALL PASSENGER VESSEL
ELECTRICAL PANEL

DR. ET	DATE 1-10-83	DWG. NO.	REV.
CK	SCALE NONE	1192-E3	1