


SECOND FLOOR PLAN

SCALE: 1/16" = 1'-0"

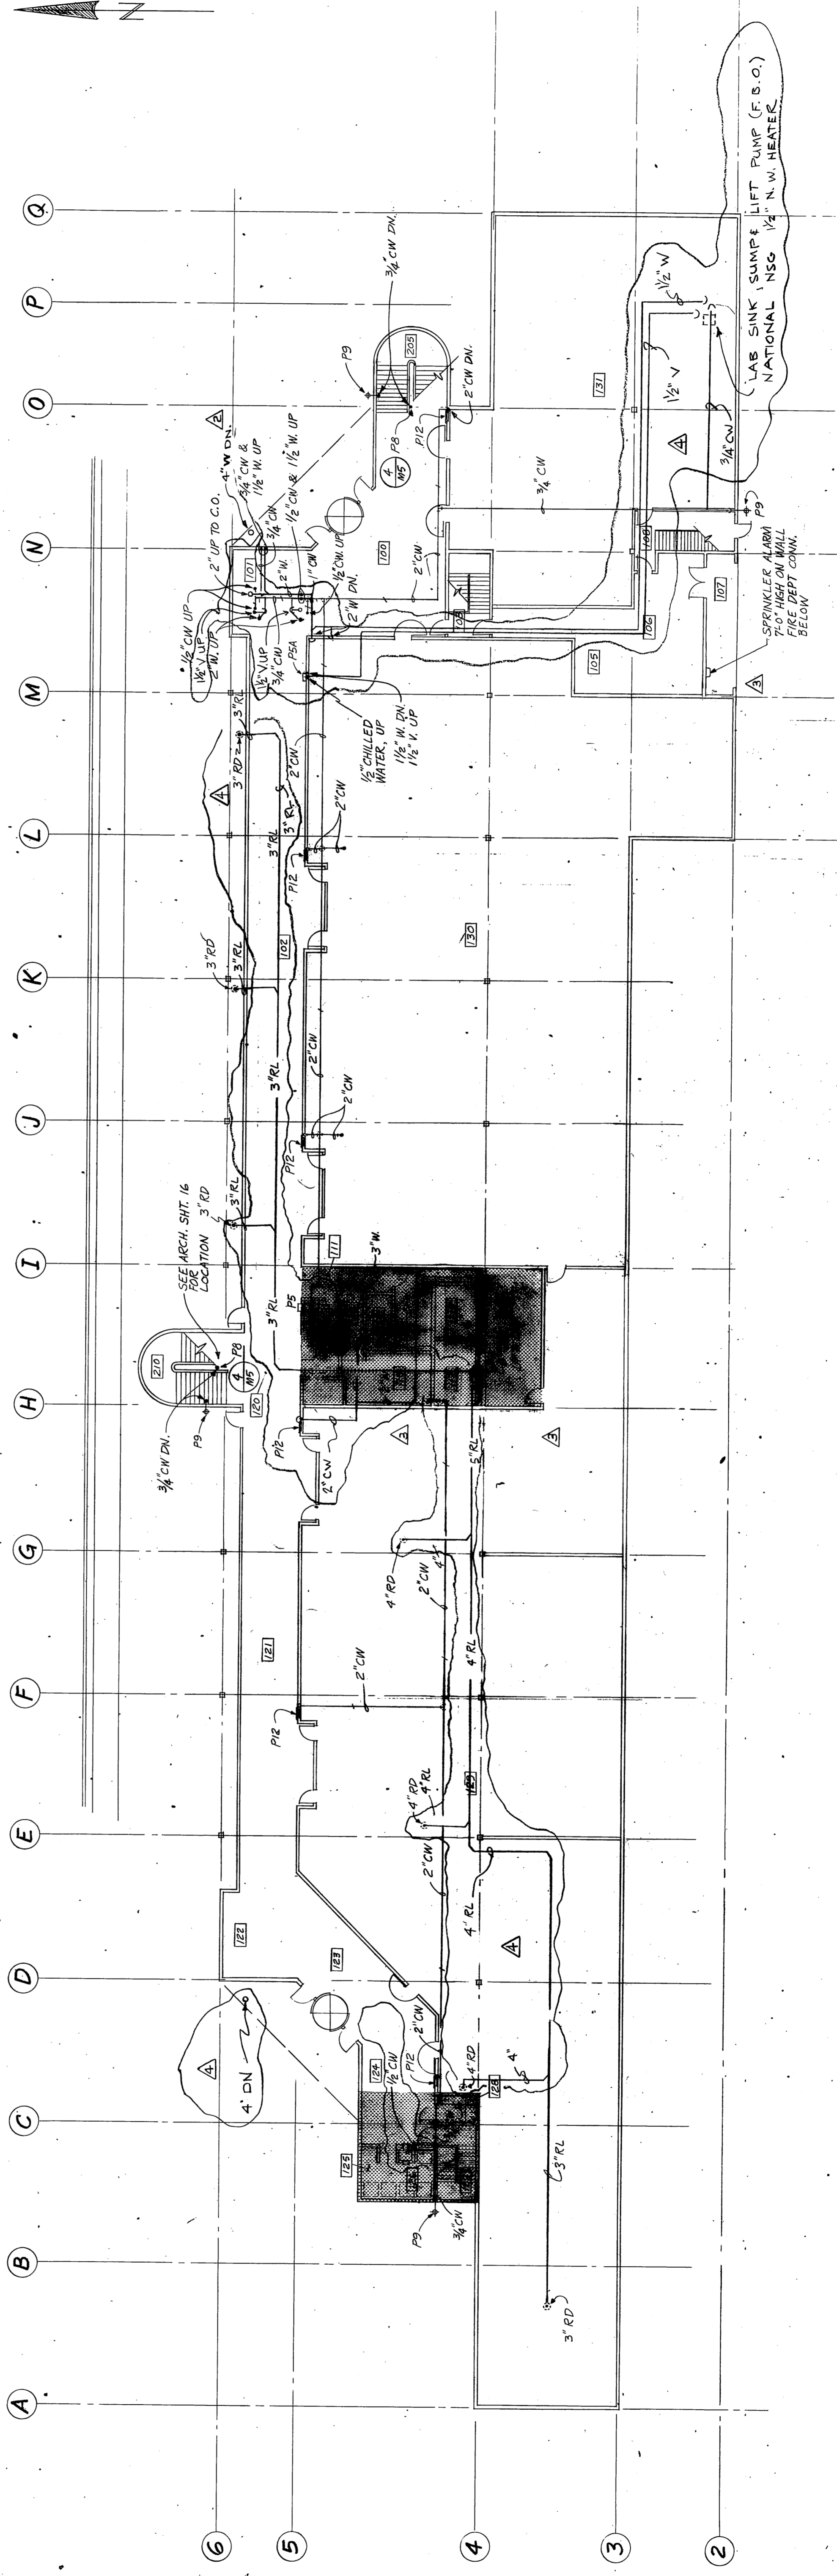

FIRST FLOOR PLAN

SCALE: 1/16" = 1'-0"

NOTE: SEE SHEETS M3, M4, M9 FOR 1/4" SCALE PLANS OF SHADED AREAS.

AS BUILT
 PRODUCED IN ACCORDANCE WITH CONTRACTOR
 SUBMITTED AS BUILT RECORDS AS APPROVED
 BY THE STATE OF ALASKA
 ADDENDA NO. 3
 ADDENDA NO. 2

FIRST & SECOND FLOOR PLANS

JOB NO. 7905-174
 DATE 10/12/17


ARCHITECTS - ENGINEERS - SURVEYORS
 601 COLLEGE ROAD, FAIRBANKS, ALASKA 99701, PHONE: 452-1241

STATE OF ALASKA
DEPARTMENT OF PUBLIC WORKS
DIVISION OF BUILDINGS

FAIRBANKS REGIONAL
OFFICE BUILDING
 AREA 5-010 - BLOCK 6A - FAIRBANKS, ALASKA



M2
 SHEET NO. OF 61

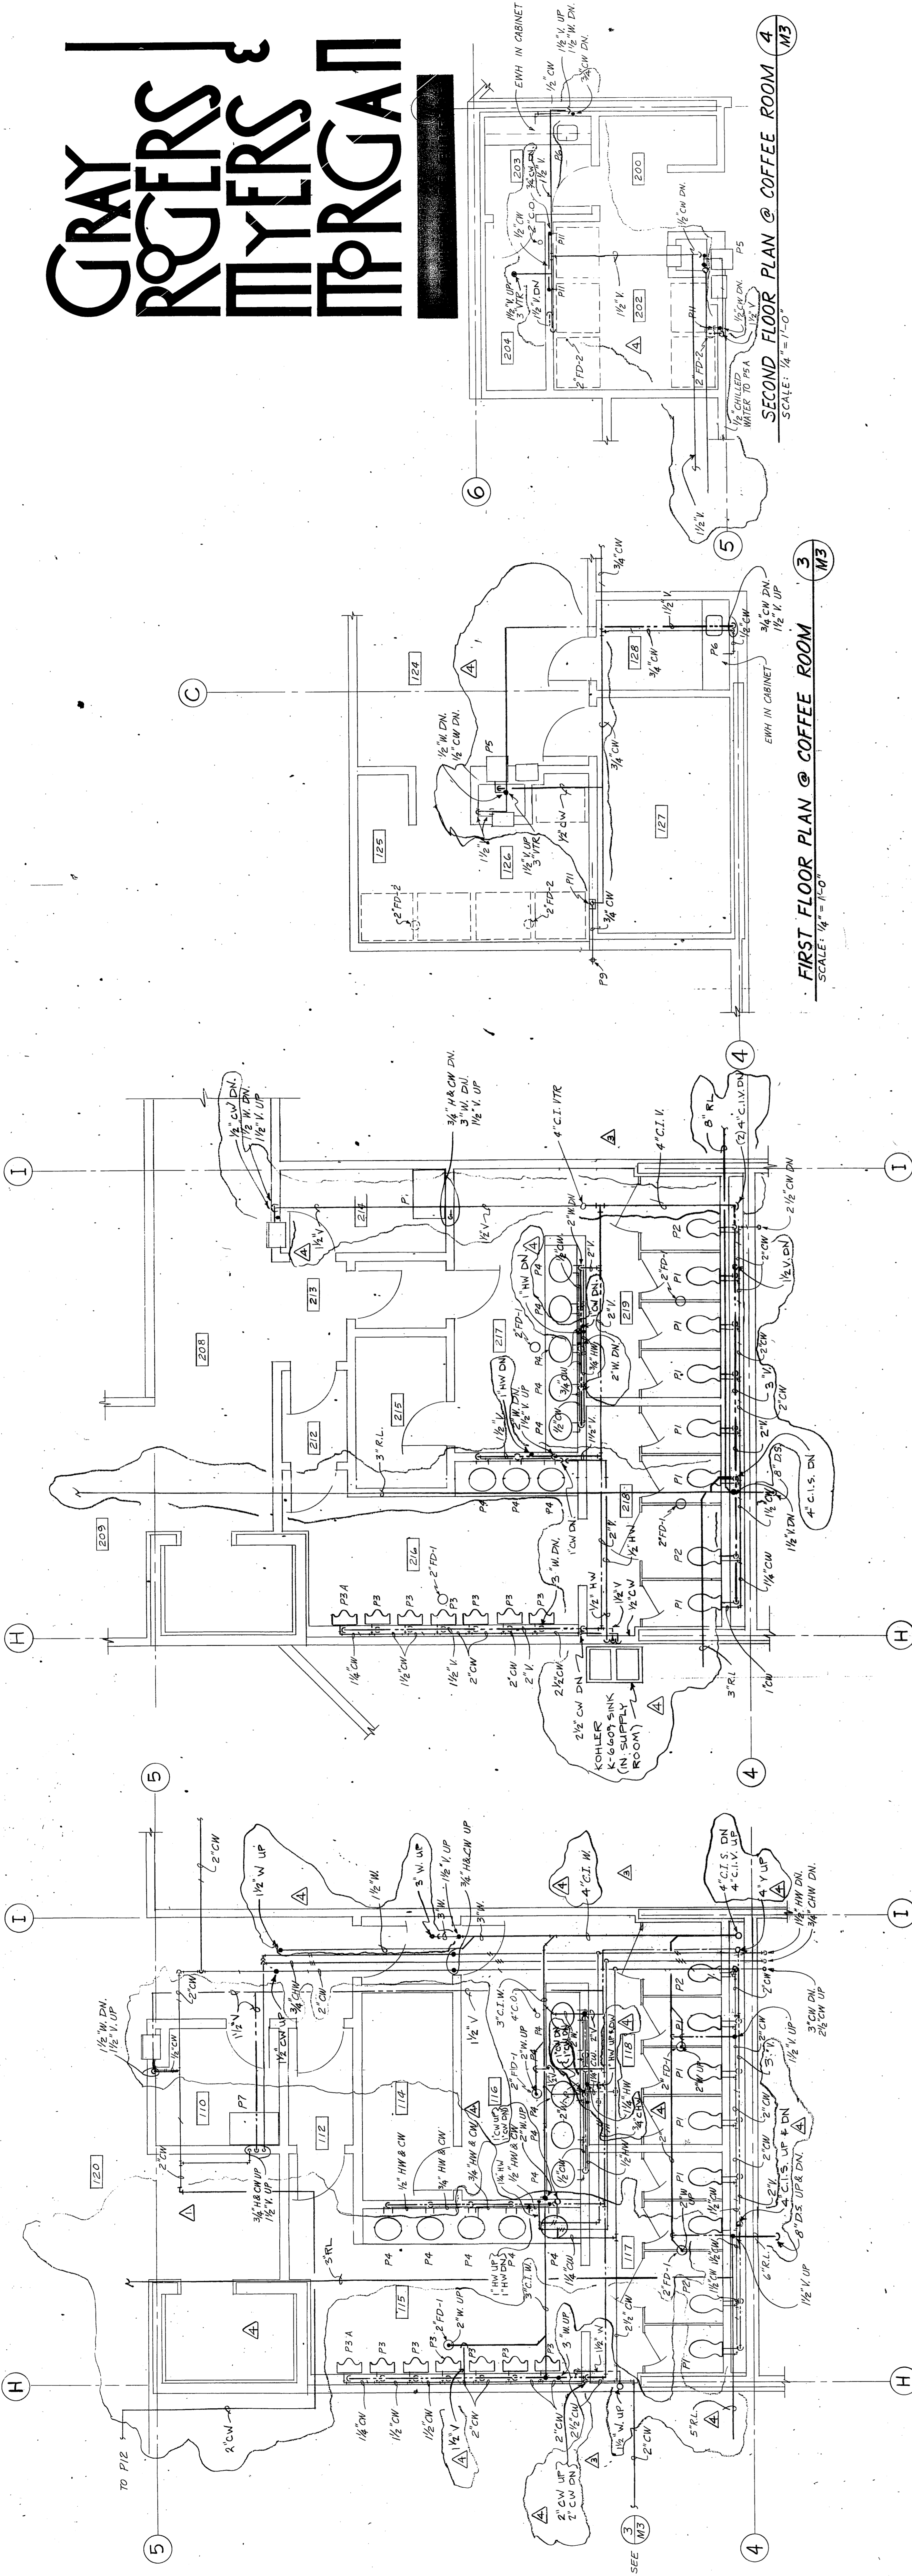


FIRST FLOOR PLAN @ TOILET ROOMS
SCALE: 1/4" = 1'-0"

SECOND FLOOR PLAN @ TOILET ROOMS
SCALE: 1/4" = 1'-0"

FIRST FLOOR PLAN @ COFFEE ROOM
SCALE: 1/4" = 1'-0"

SECOND FLOOR PLAN @ COFFEE ROOM
SCALE: 1/4" = 1'-0"

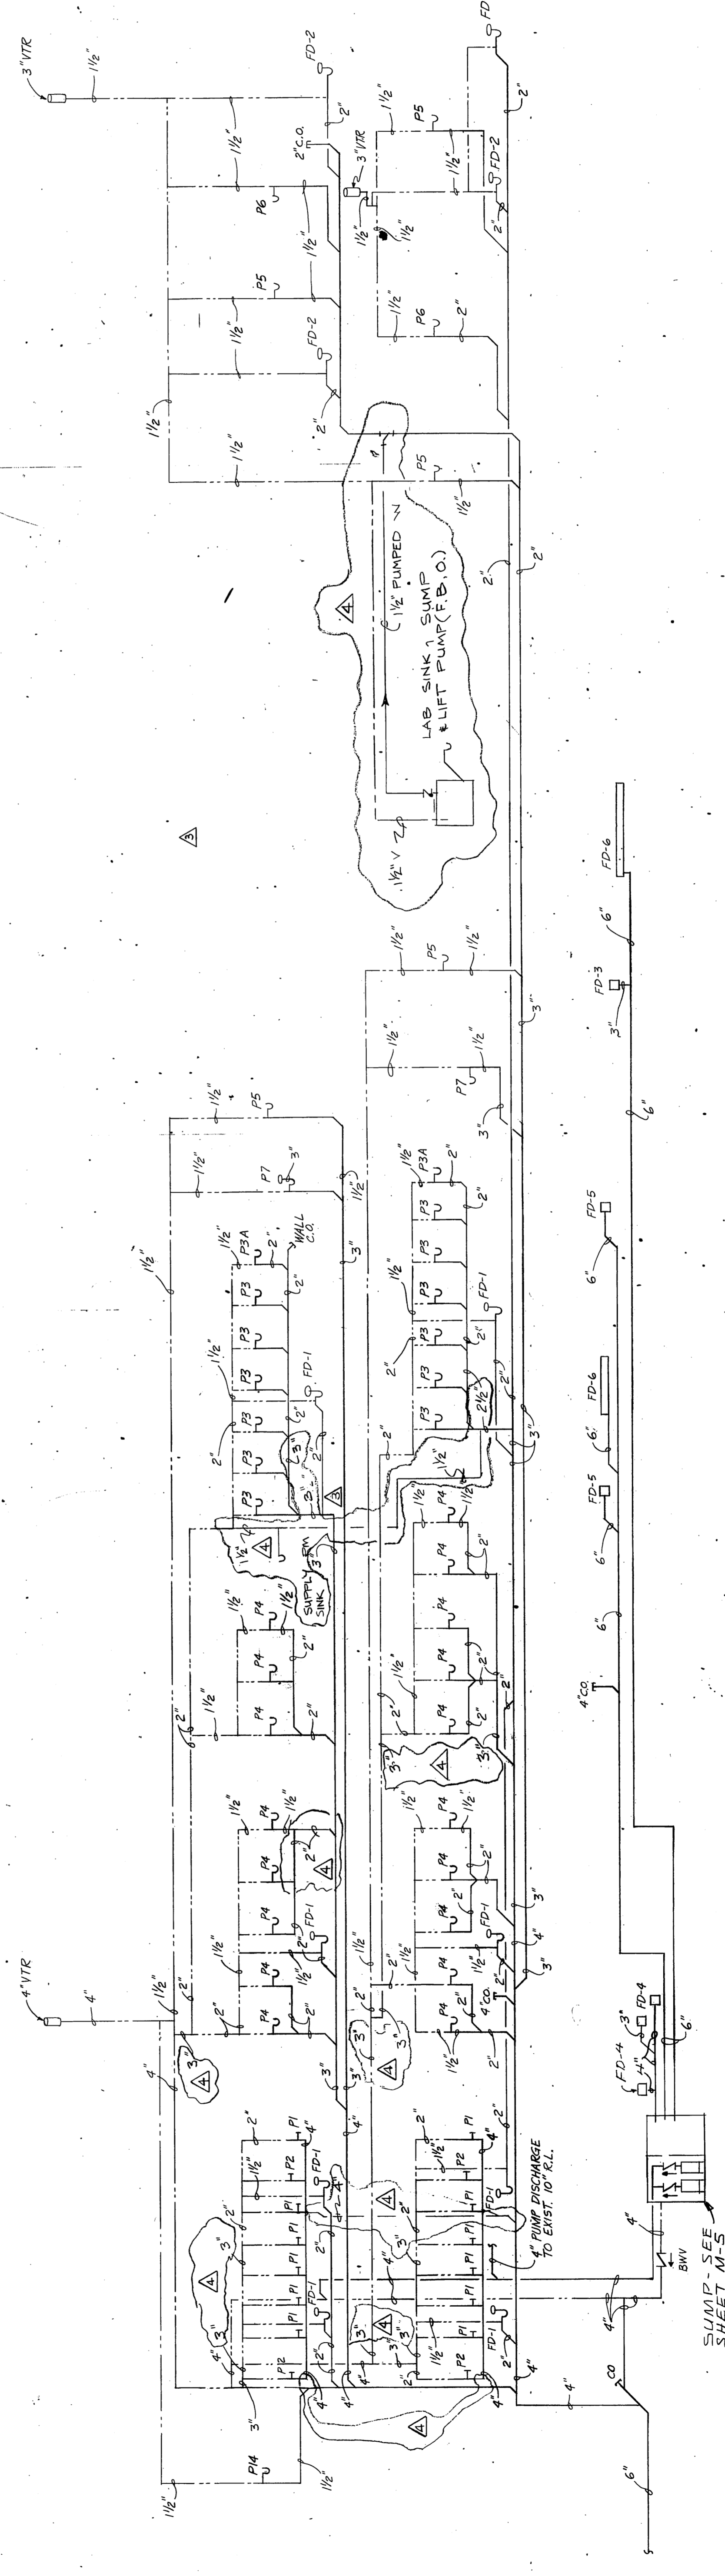

WASTE & VENT DIAGRAM
NO SCALE

AS BUILTS
PRODUCED IN ACCORDANCE WITH CONTRACTOR
SUBMITTED AS BUILT RECORDS AS APPROVED
BY THE STATE OF ALASKA.

AS BUILT DRAWING 3/4/75
ADDENDA NO. 3

PLUMBING PLANS & DETAILS




**FAIRBANKS REGIONAL
OFFICE
BUILDING**


**PHASE TWO
WORKS**

ARCHITECTS - ENGINEERS - SURVEYORS
601 COLLEGE ROAD, FAIRBANKS, ALASKA 99701, PHONE: 452-1241


JOB NO: 7905-124
DATE: 01/12/75

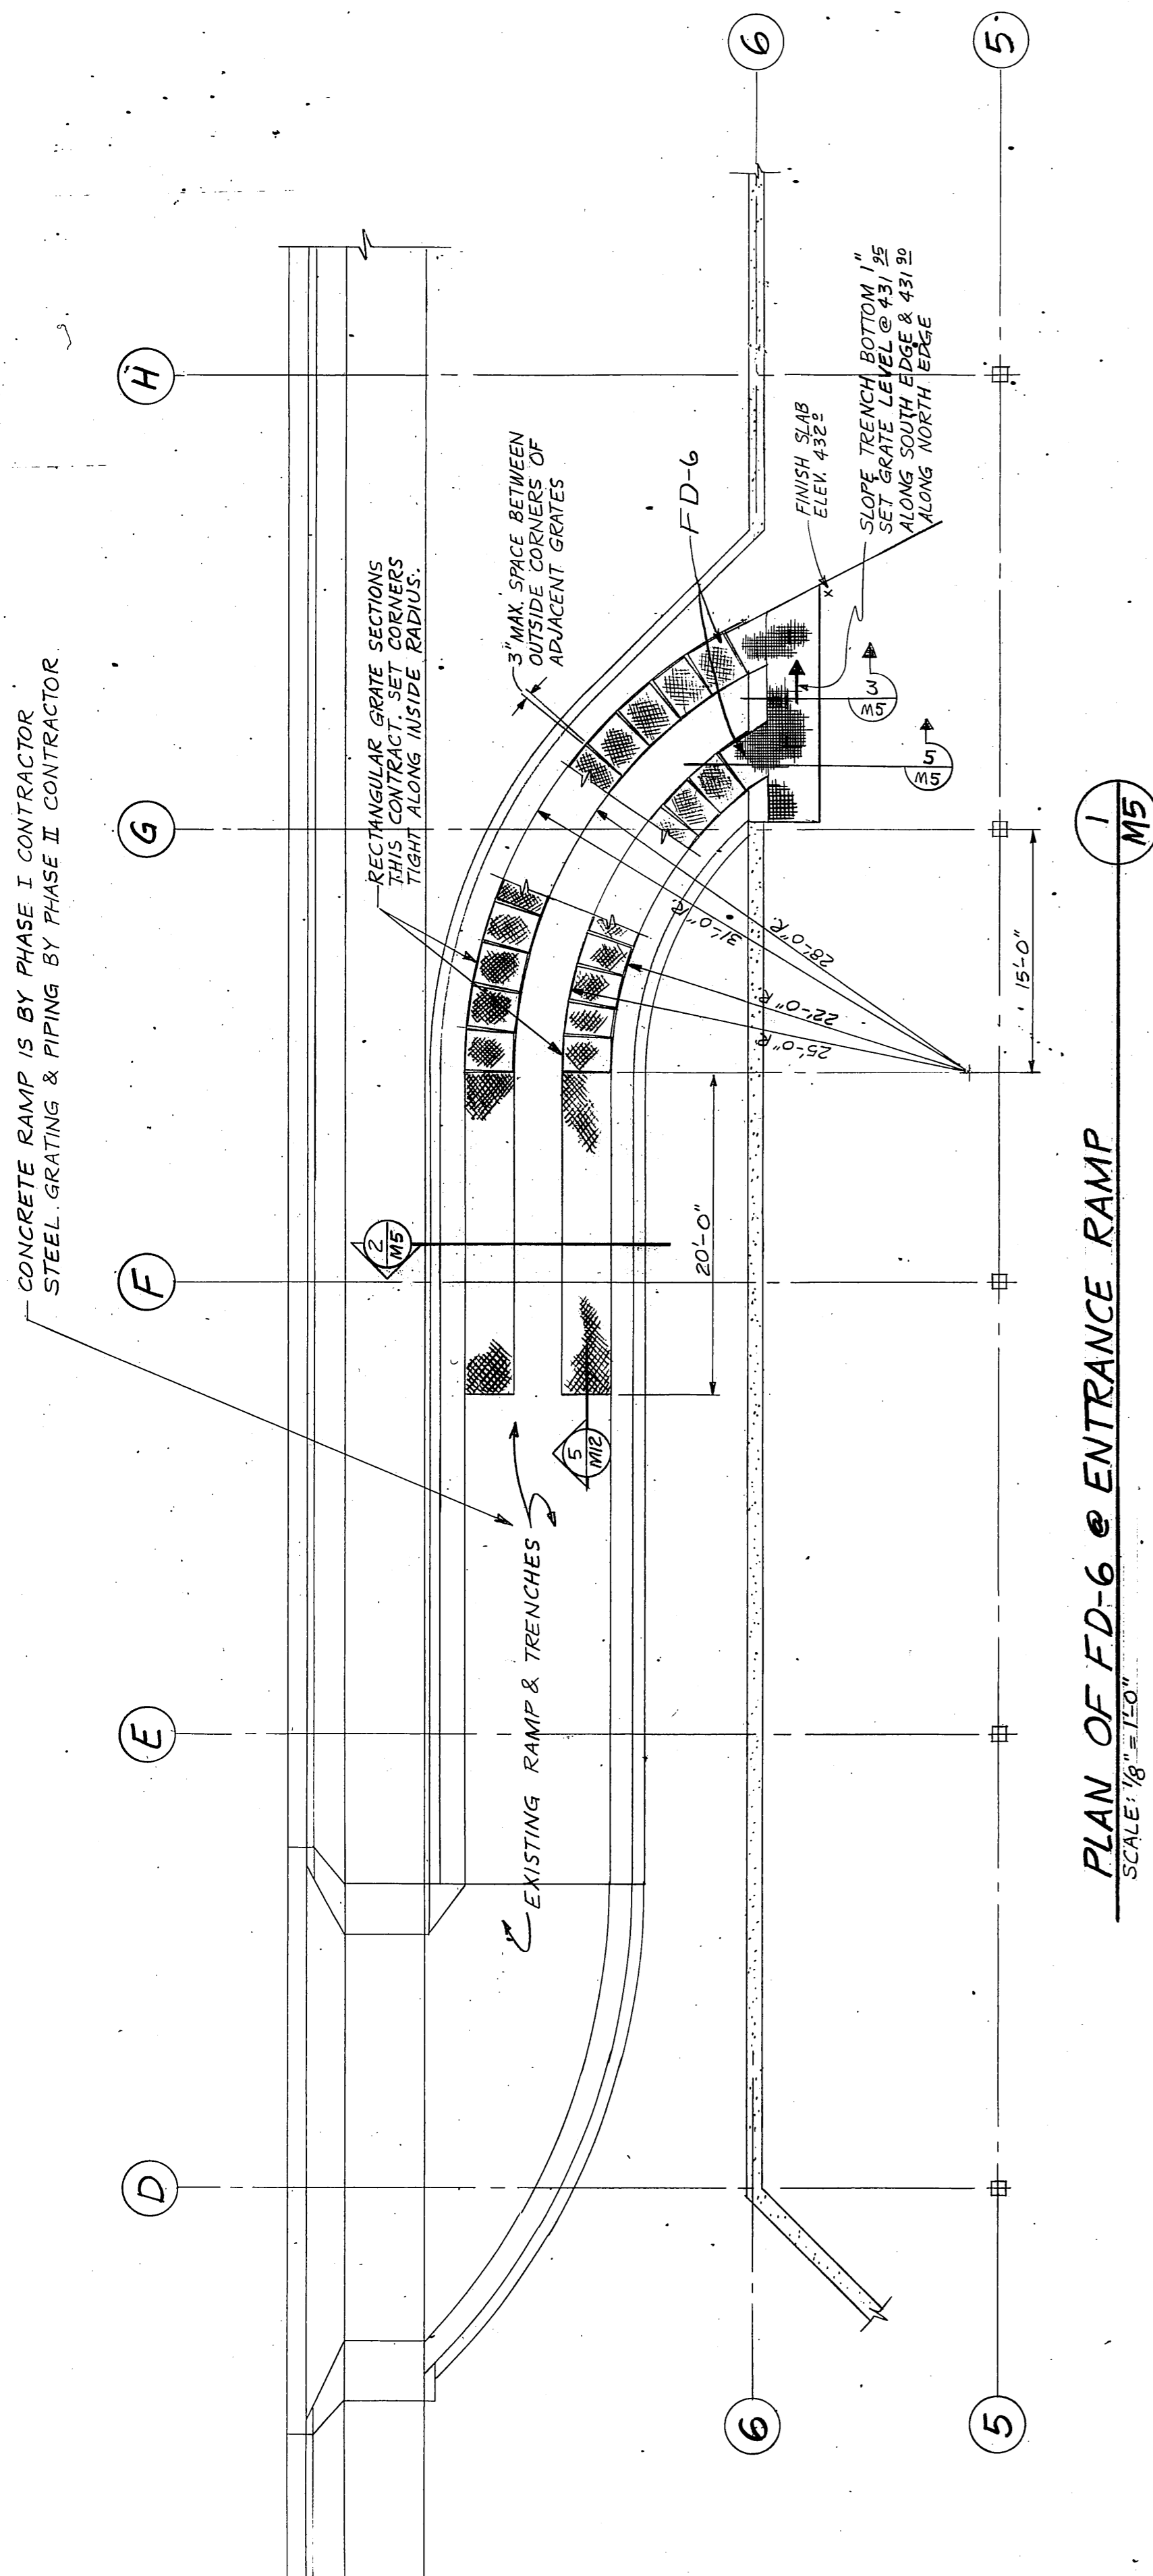


PLAN OF FD-6 @ ENTRANCE RAMP
SCALE: 1/8" = 1'-0"

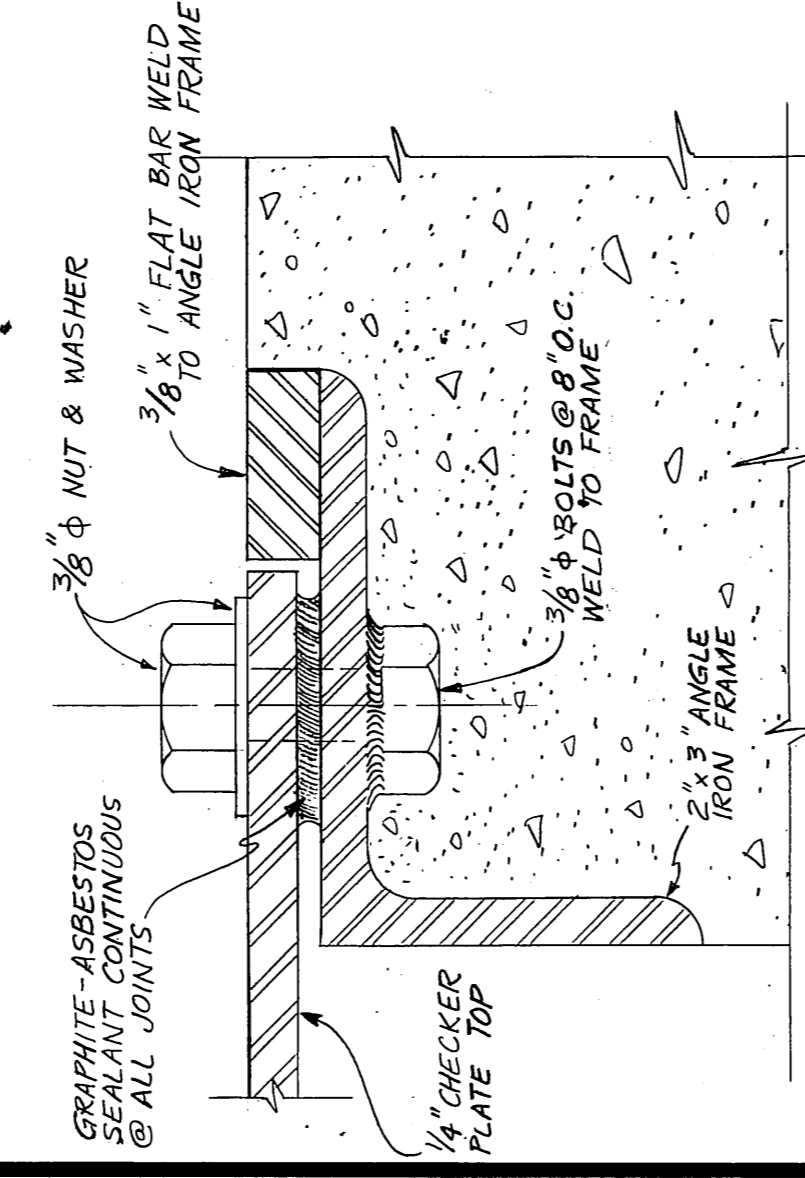

SUMP COVER
SCALE: 1" = 1'-0"

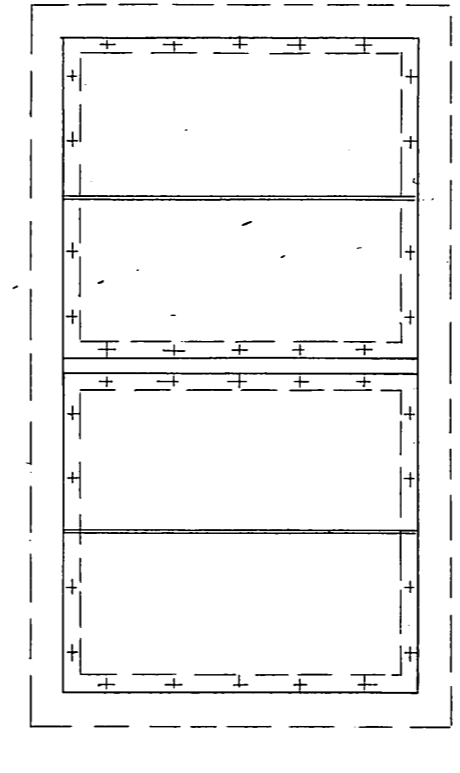


FLOOR PLAN

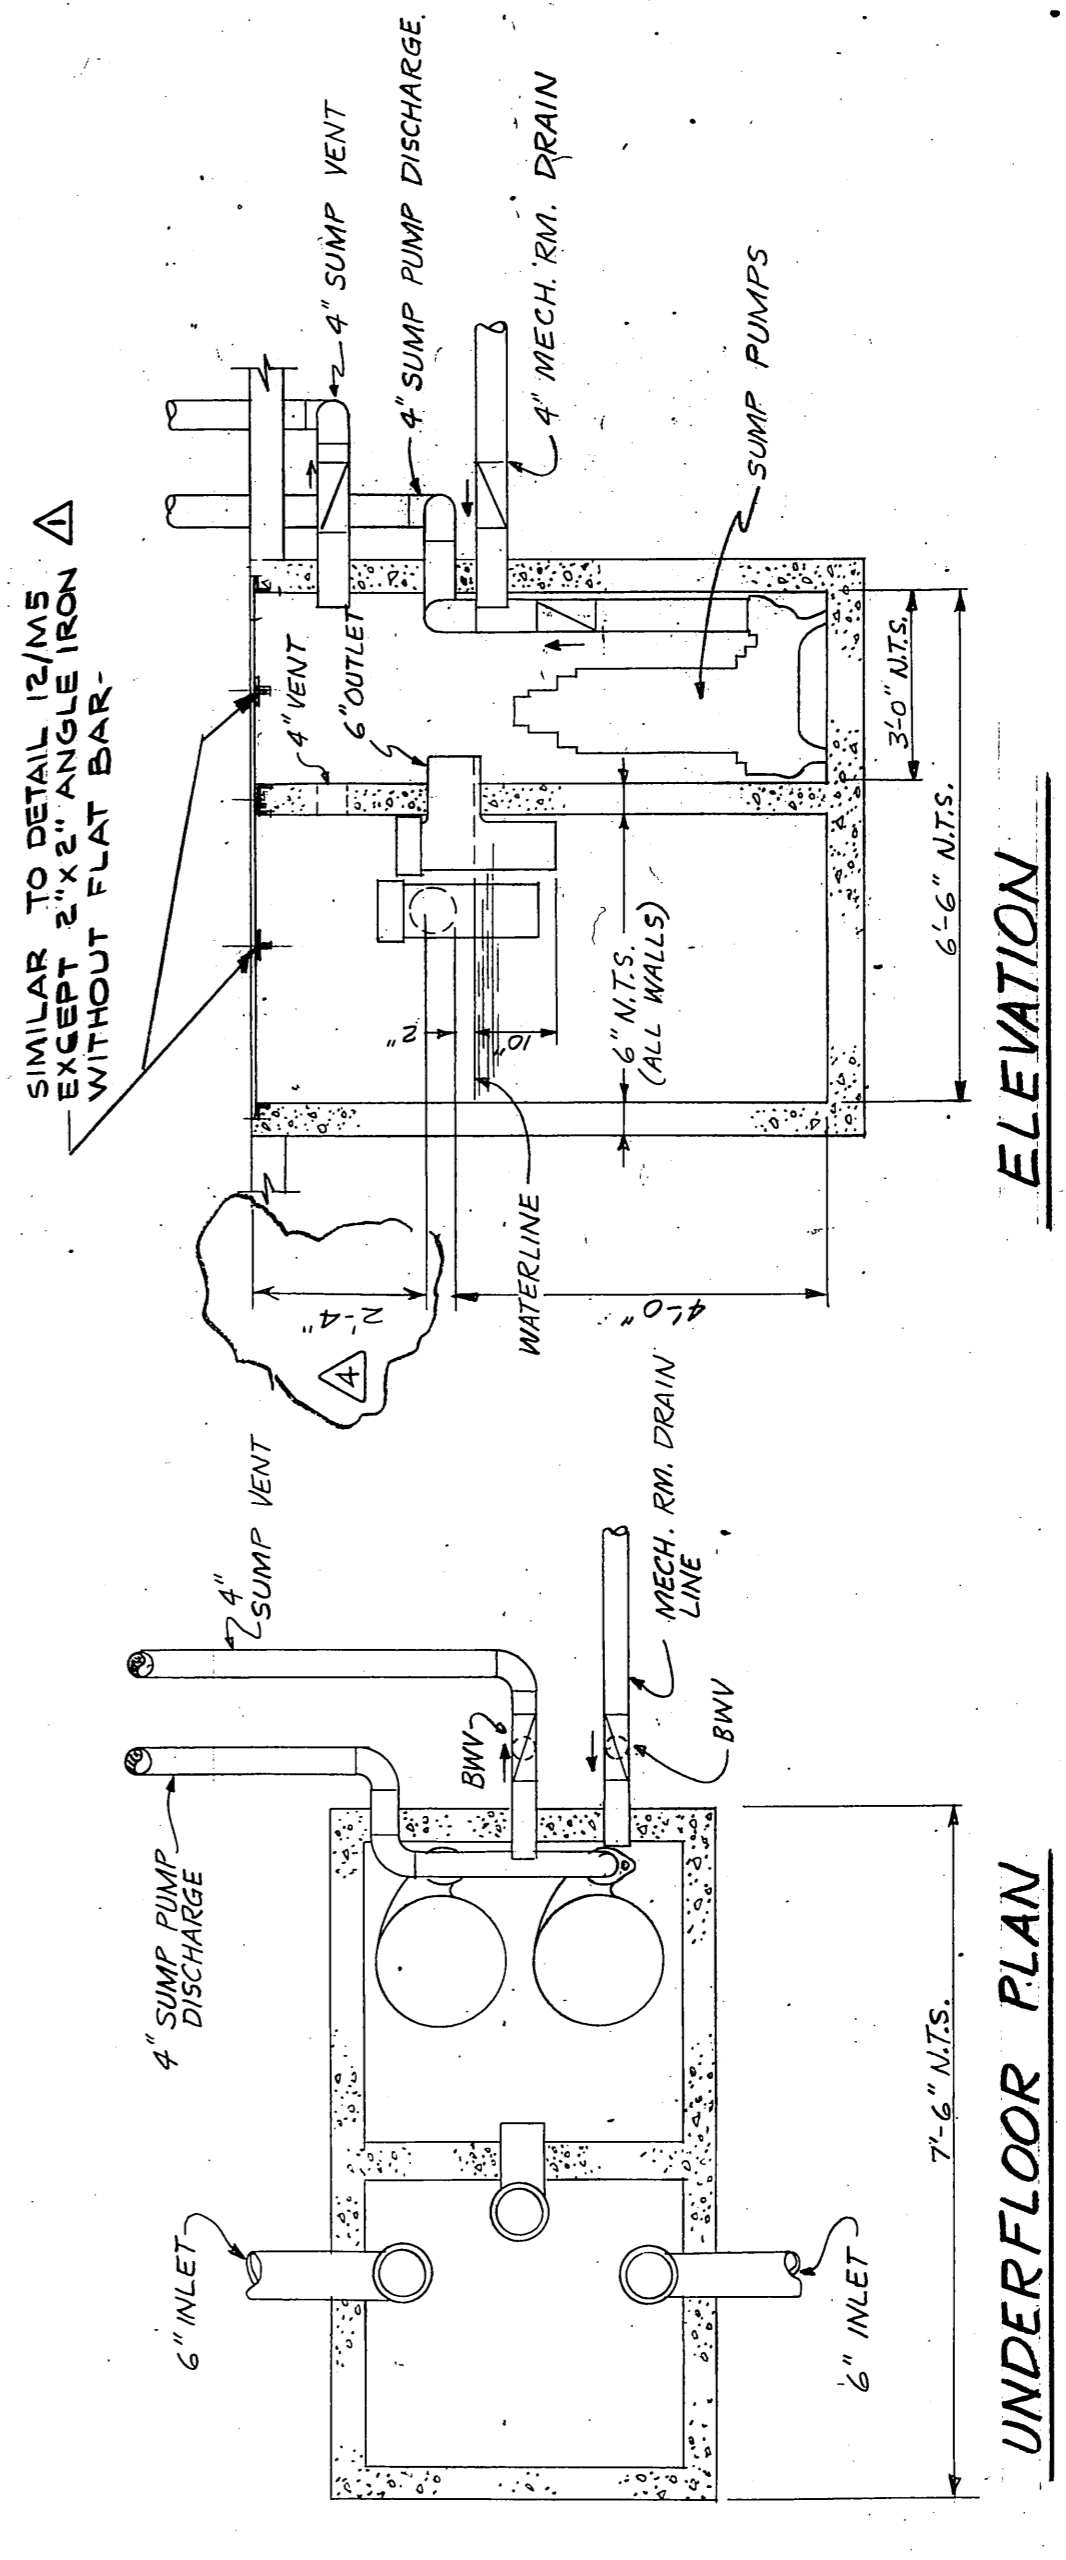


ELEVATION

GARAGE DRAINAGE SUMP
SCALE: 1/8" = 1'-0"

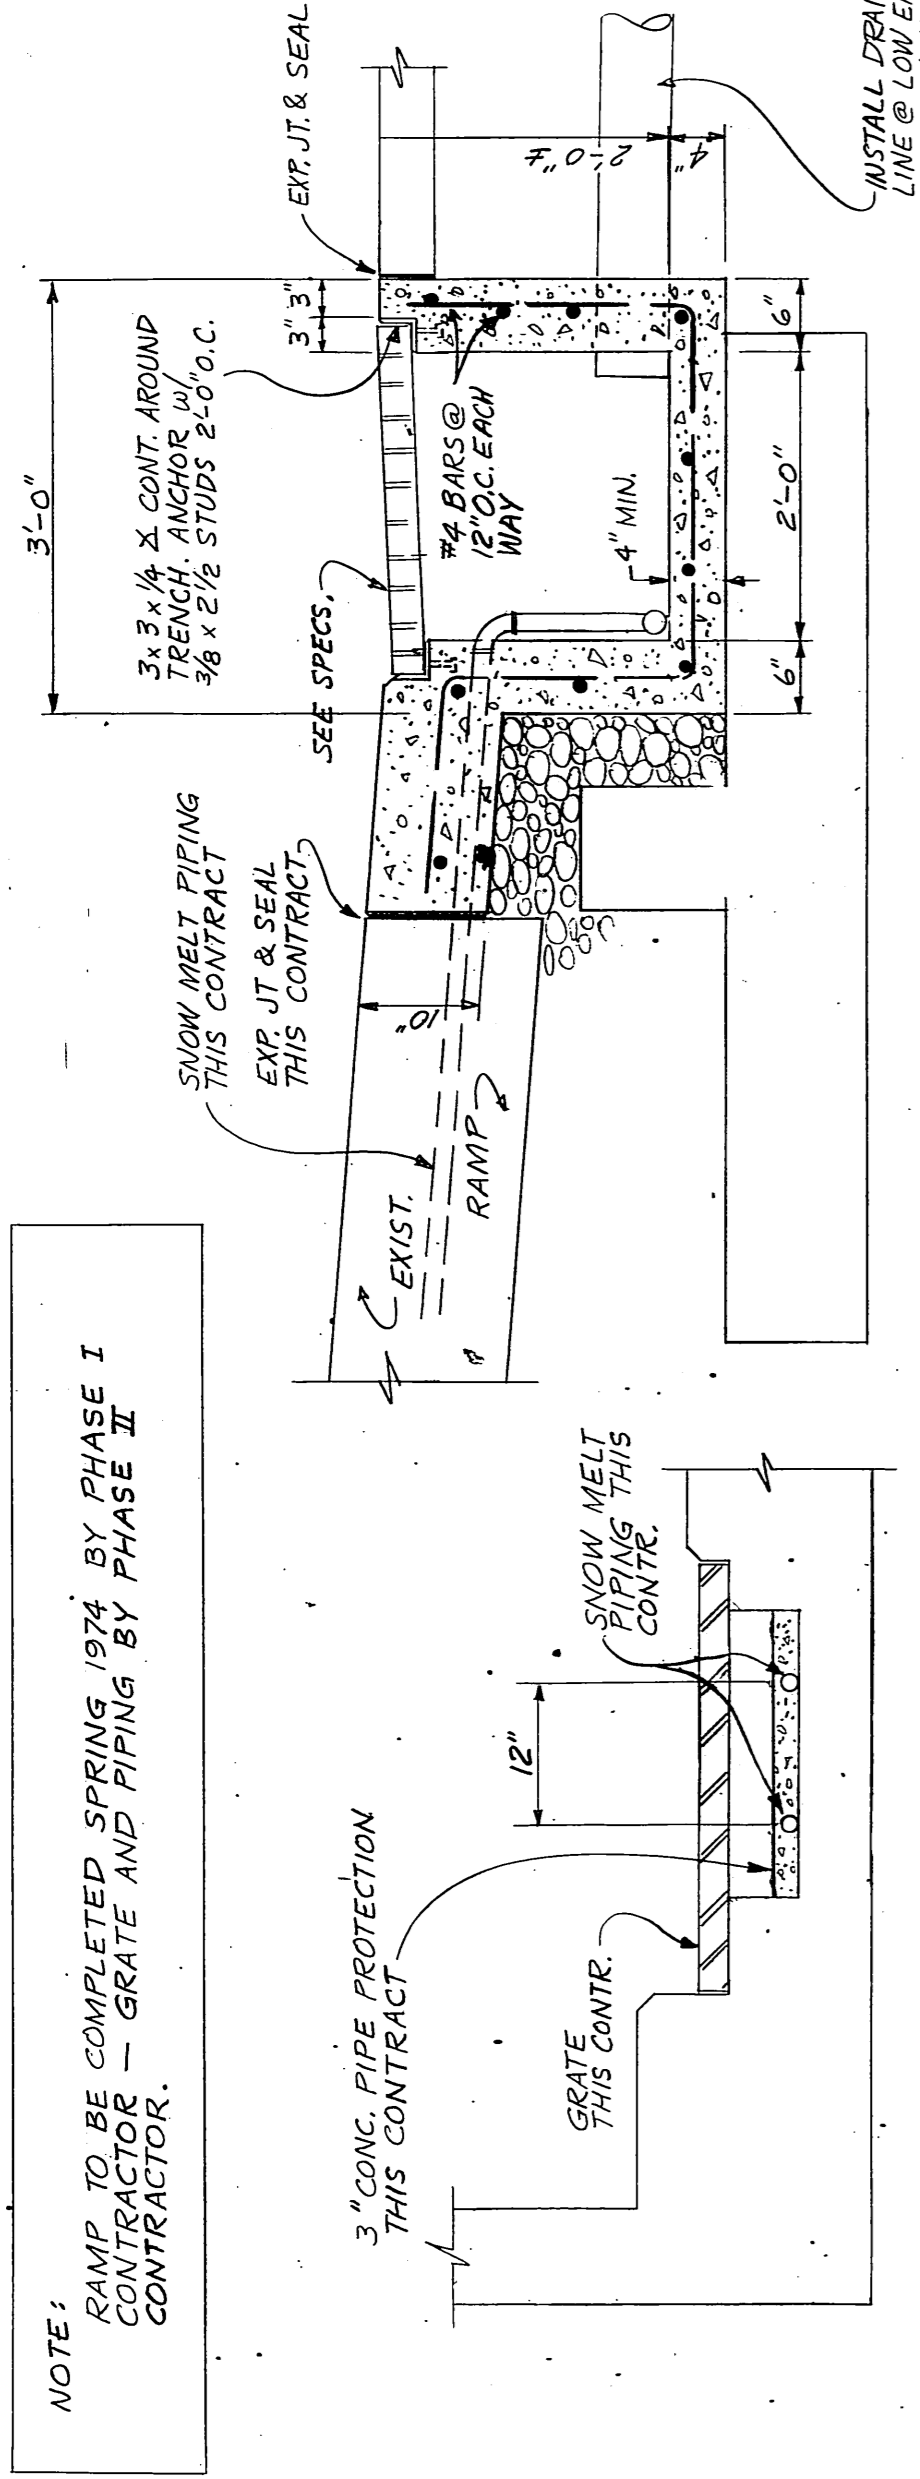


SECTION
SCALE: 3/4" = 1'-0"

SECTION THRU RAMP DRAIN @ INTERSECTION
SCALE: 1/2" = 1'-0"

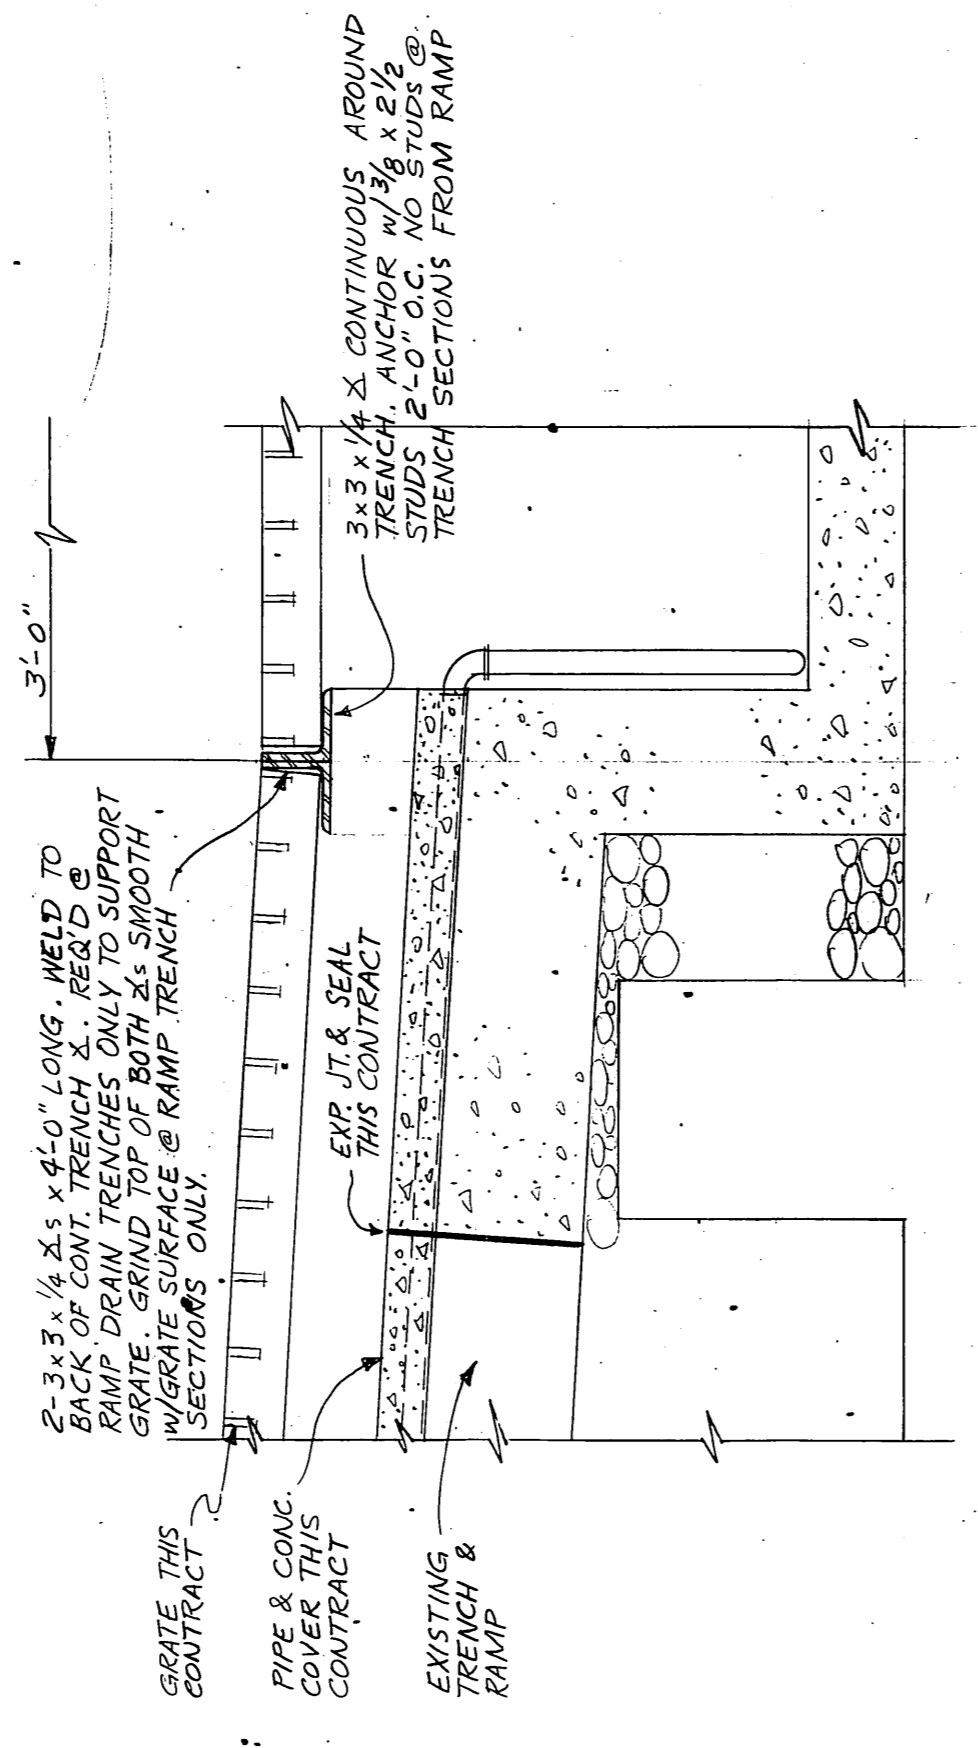


SECTION THRU DRAIN TRENCH @ ENTRANCE RAMP
SCALE: 3/4" = 1'-0" (SIMILAR FOR TRENCH @ EXIT RAMP)


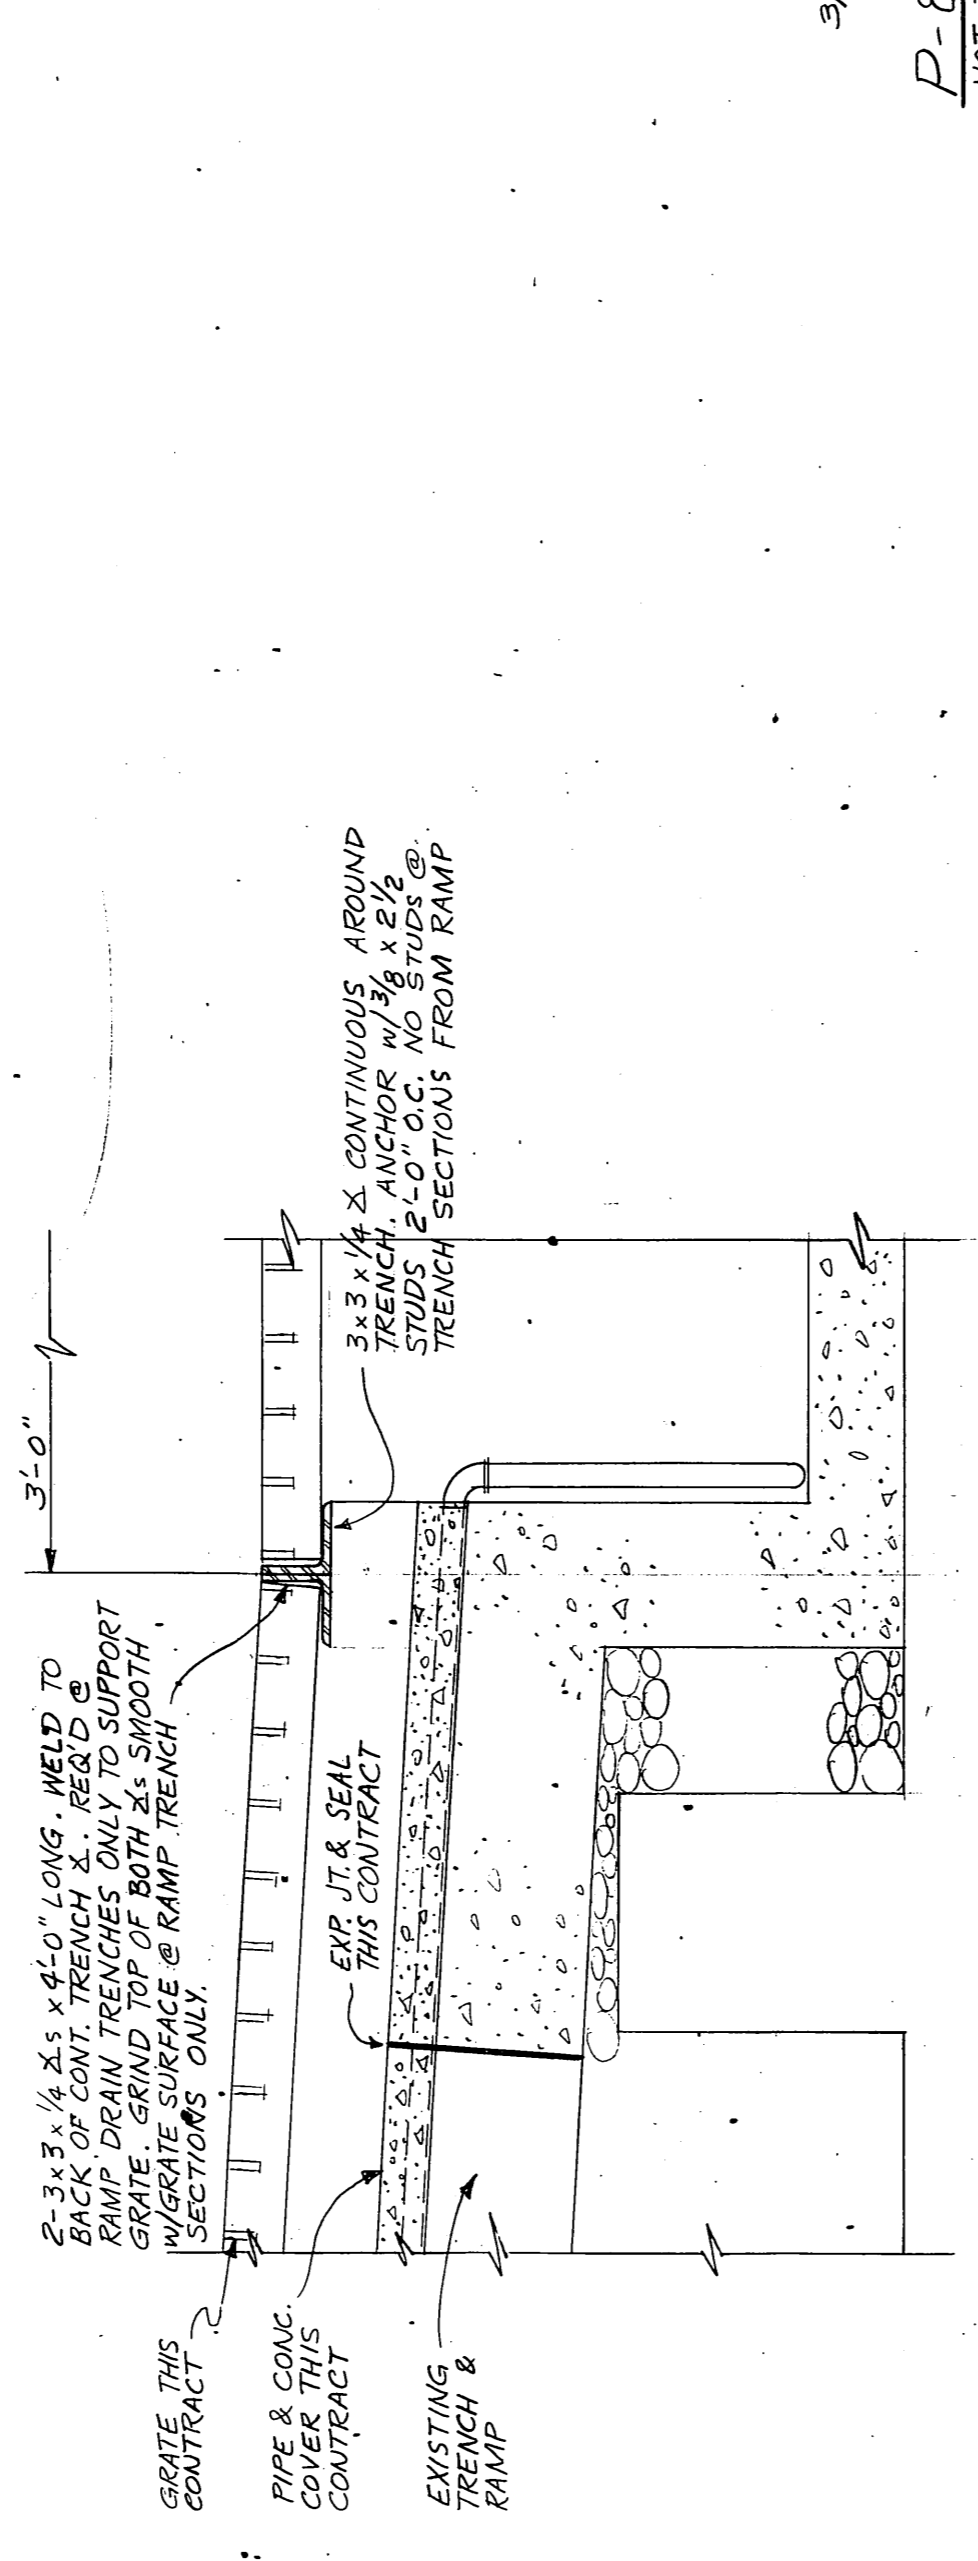


SECTION THRU RAMP DRAIN @ INTERSECTION
SCALE: 1/2" = 1'-0"

P-8 INSTALLATION
NOT TO SCALE

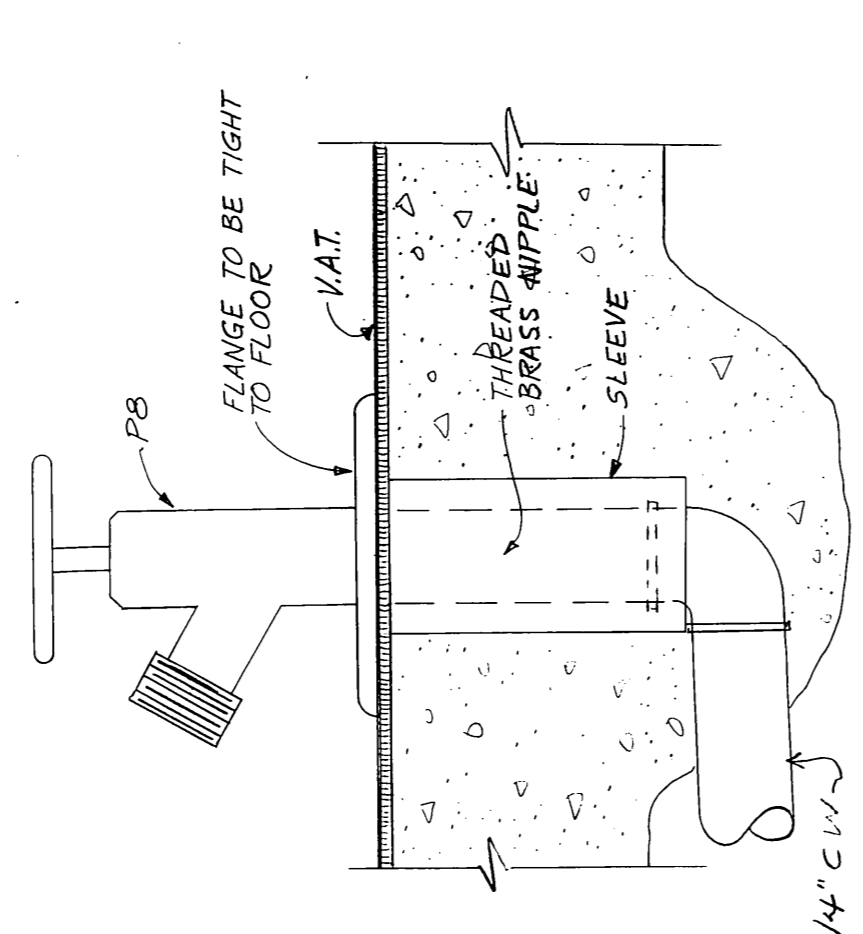

YARD CLEANOUT
NO SCALE

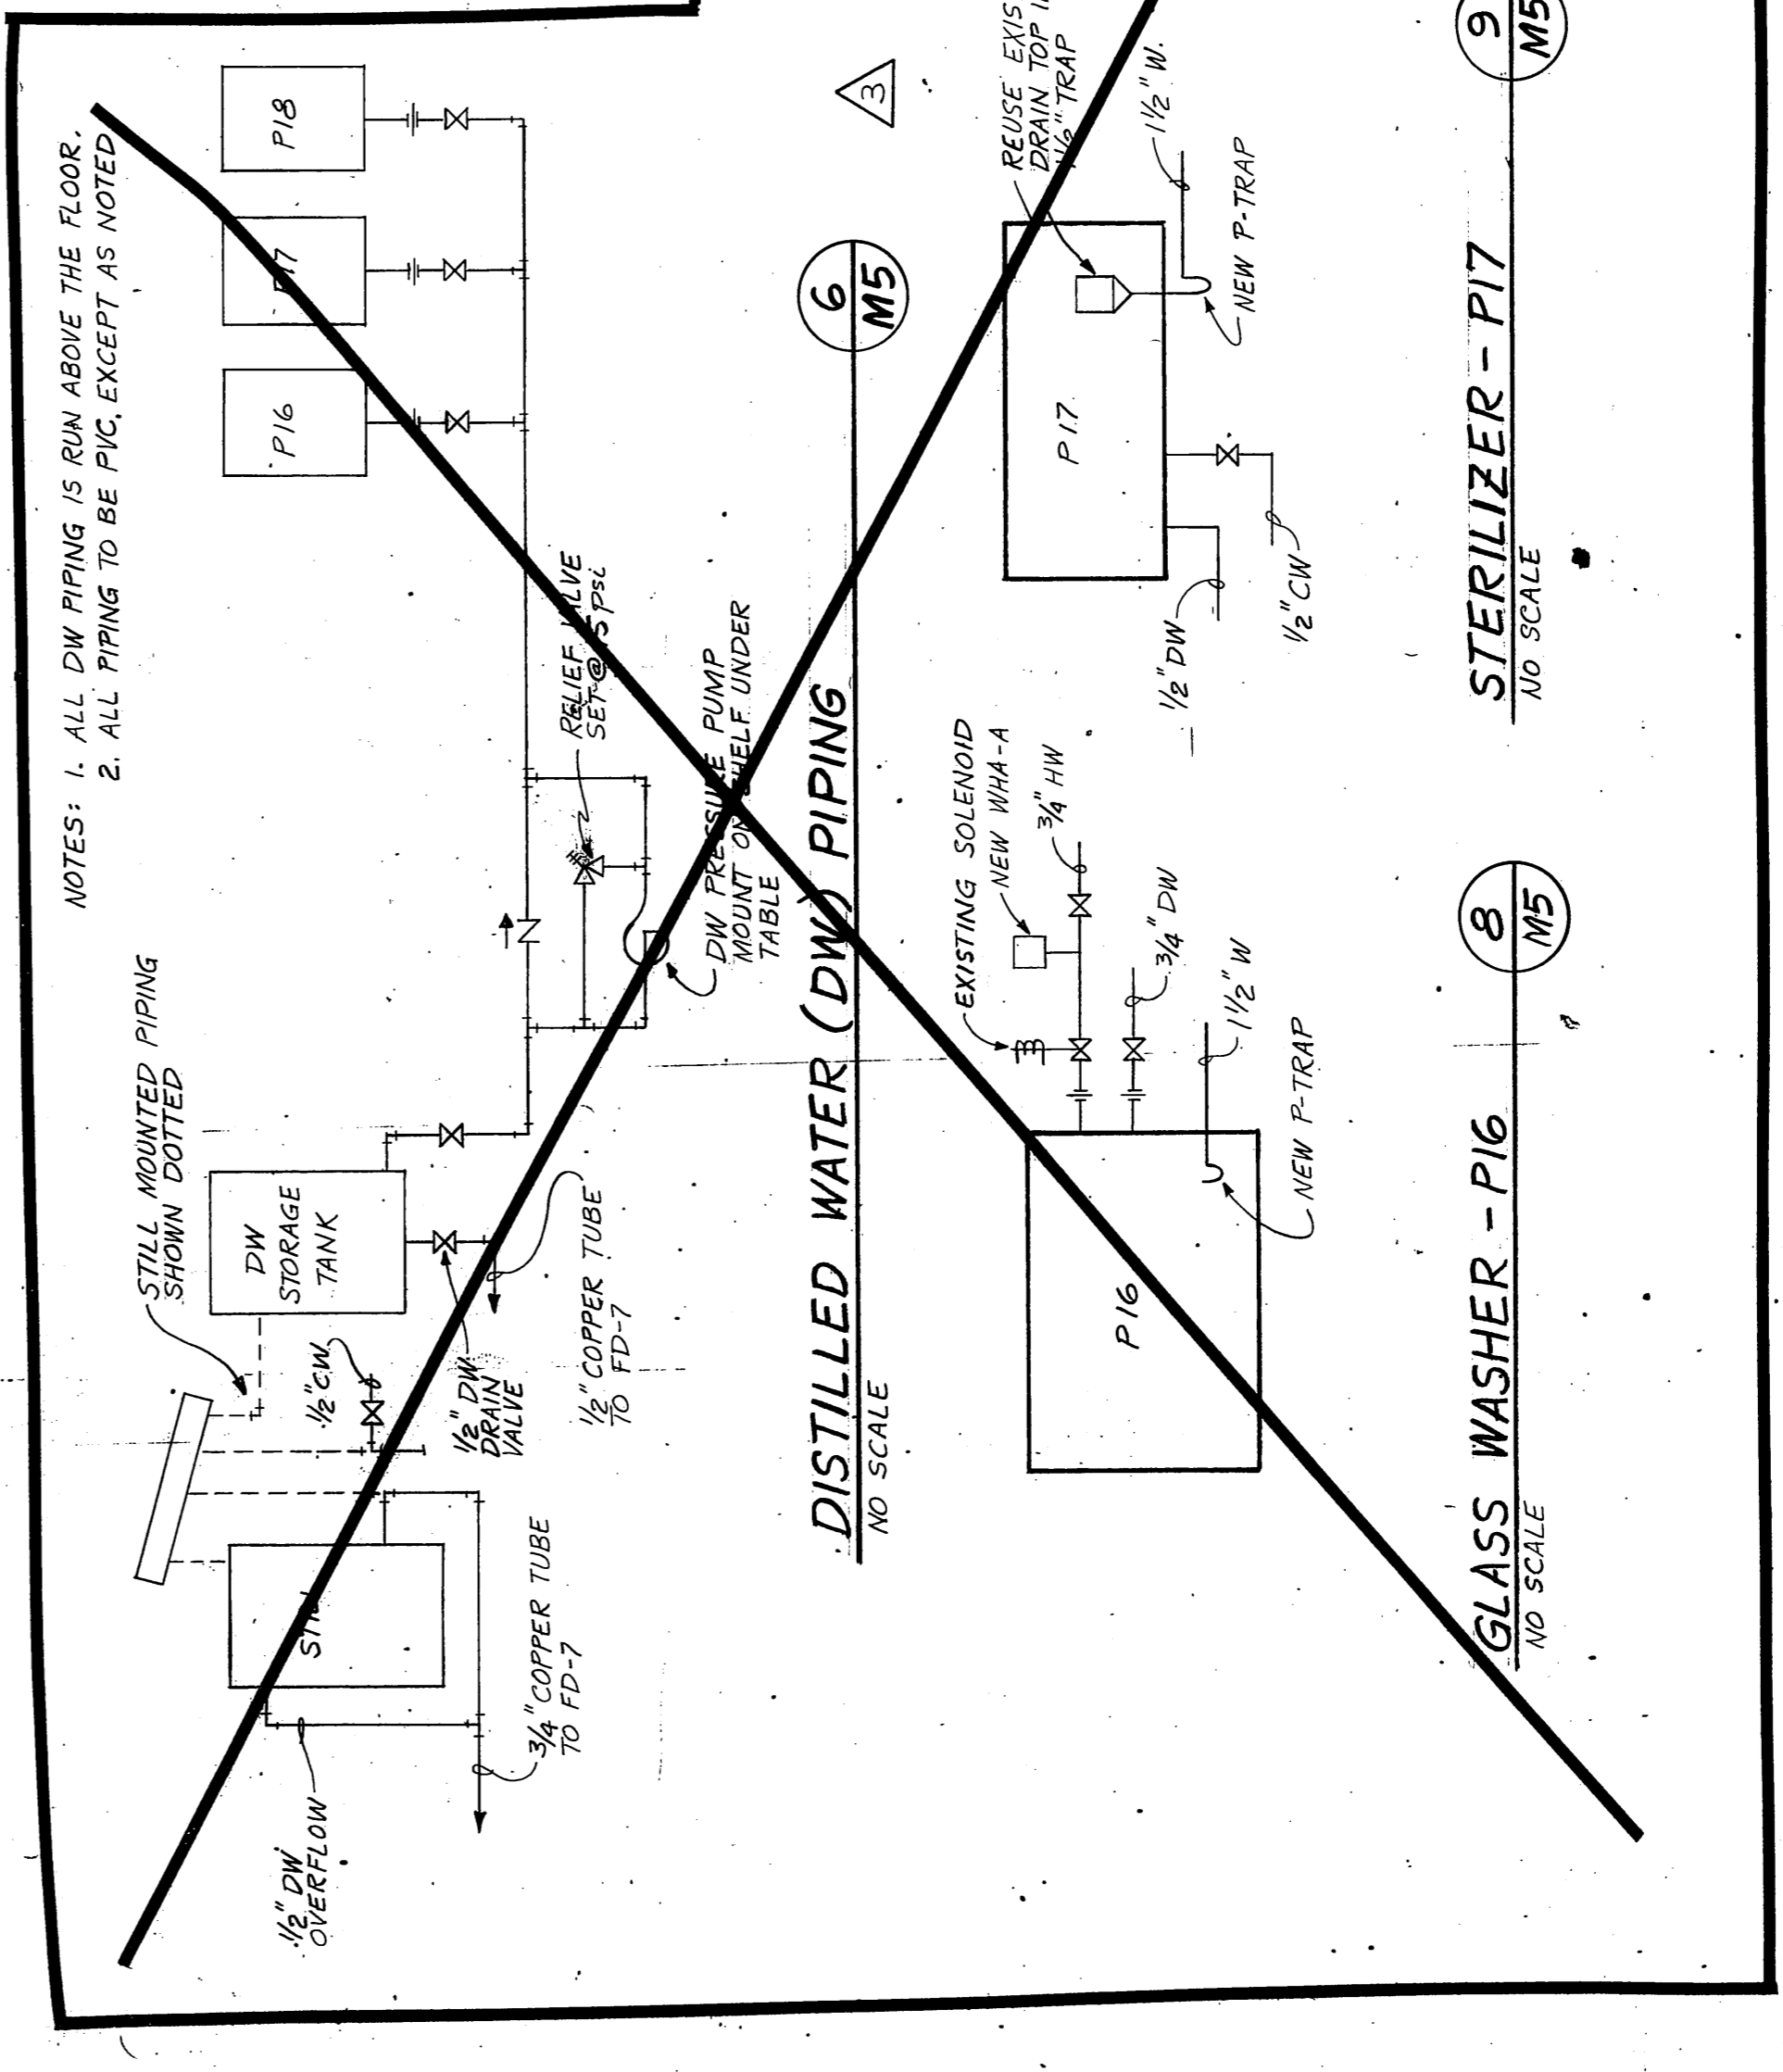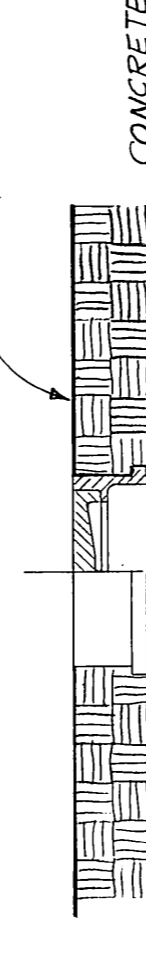

DISTILLED WATER (DW) PIPING
NO SCALE

STERILIZER - P-18
NO SCALE

STERILIZER - P-17
NO SCALE

GLASS WASHER - P-16
NO SCALE

STERILIZER - P-16
NO SCALE

AS BUILTS
PRODUCED IN ACCORDANCE WITH CONTRACTOR
SUBMITTED AS BUILT RECORDS AS APPROVED
BY THE STATE OF ALASKA

JOB NO: 7205-731
DATE: JUN 12 1973

ARCHITECTS - ENGINEERS - SURVEYORS
601 COLLEGE ROAD, FAIRBANKS, ALASKA 99701, PHONE: 452-11241


STATE OF ALASKA
DEPARTMENT OF PUBLIC WORKS
DIVISION OF BUILDINGS

FAIRBANKS REGIONAL
OFFICE BUILDING




M5
SHEET NO. 1 OF 6

AS-BUILT DRAWING 5/4/75
ADDENDA NO. 3
ADDENDA NO. 1
PLUMBING DETAILS

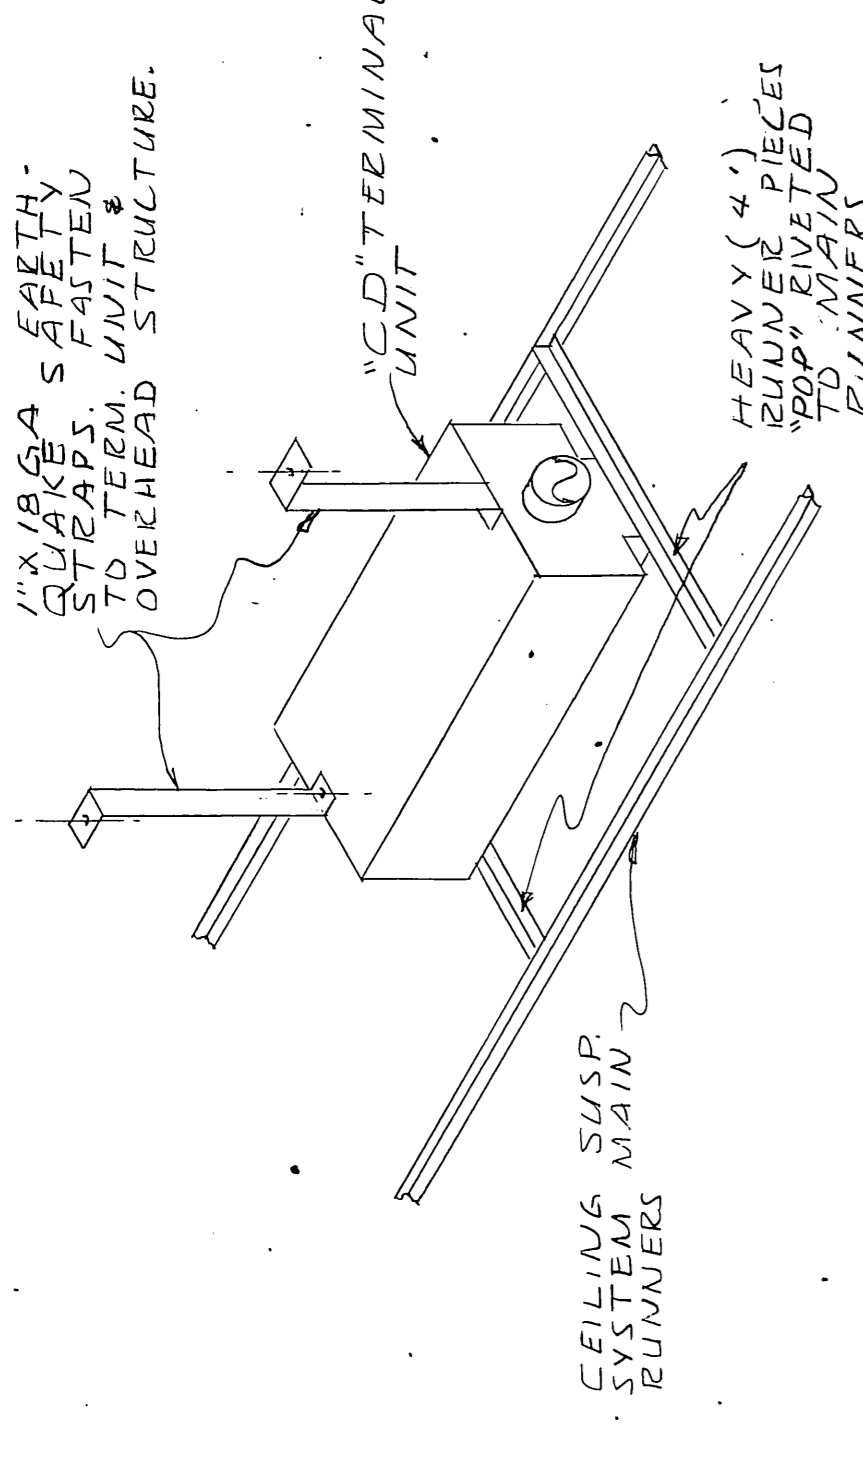

△ AIR TERMINAL UNIT SUSPENSION
NO SCALE

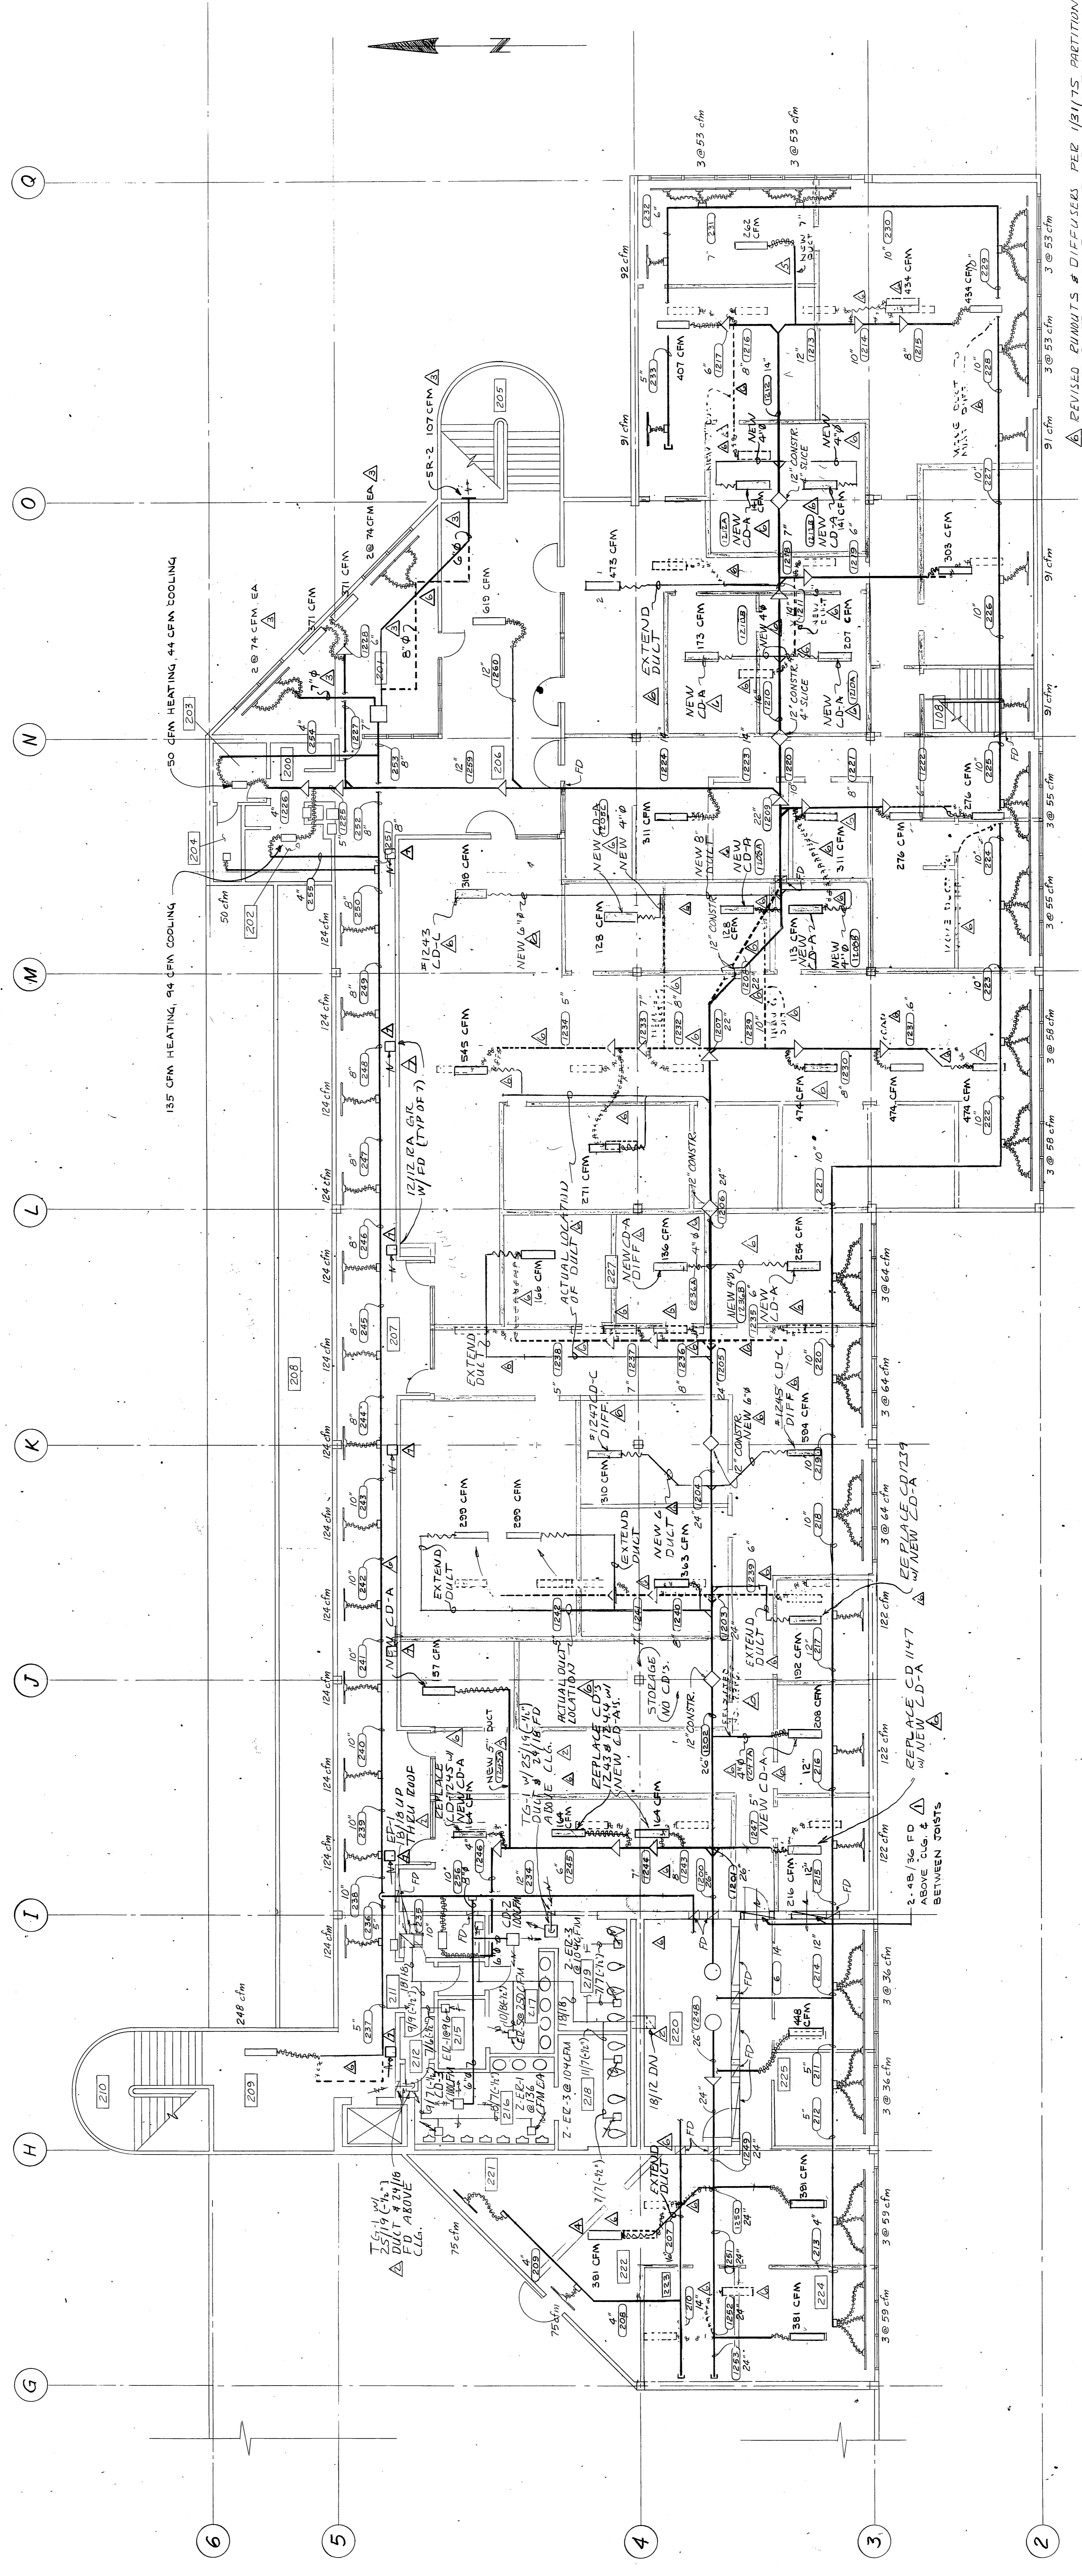

HEATING & VENTILATING - SECOND FLOOR PLAN
SCALE: 1/8" = 1'-0"

AS BUILT
PRODUCED IN ACCORDANCE WITH CONTRACTOR SUBMITTED AS BUILT RECORDS AS APPROVED BY THE STATE OF ALASKA.

- △ EXISTING DIFFUSER LOCATION
- △ REVISED DIFFUSER LOCATION
- △ NEW DIFFUSER
- △ ADD CORRIDOR & A GALLEY AND ADD INTERIOR CLG DIFF REQUIREMENTS 25 MAY 1976

- △ REVISED RUNNERS & DIFFUSERS PER PARTITION LAYOUT. ADD NEW PARTITION LAYOUT. SEE M&P FOR NOTES. FEB 13, 1975
- △ DIFFUSERS CHANGED PER NEW PARTITION LAYOUT. APPENDIX NO. 3 - REMOVE LAB. WALLS. APPENDIX NO. 2 - NOV. 30, 1973
- △ ADD TOILET EXHAUST SYSTEM
- △ ADD FLOOR DAMPERS REVISIONS

ARCHITECTS - ENGINEERS - SURVEYORS
601 COLLEGE ROAD, FAIRBANKS, ALASKA 99701, PHONE: 452-1241

STATE OF ALASKA
DEPARTMENT OF PUBLIC WORKS
DIVISION OF BUILDINGS

FAIRBANKS REGIONAL OFFICE BUILDING
DMA 2-010 - BLOCK 95A - FAIRBANKS, ALASKA

M8
SHEET NO. 1 OF 6

