
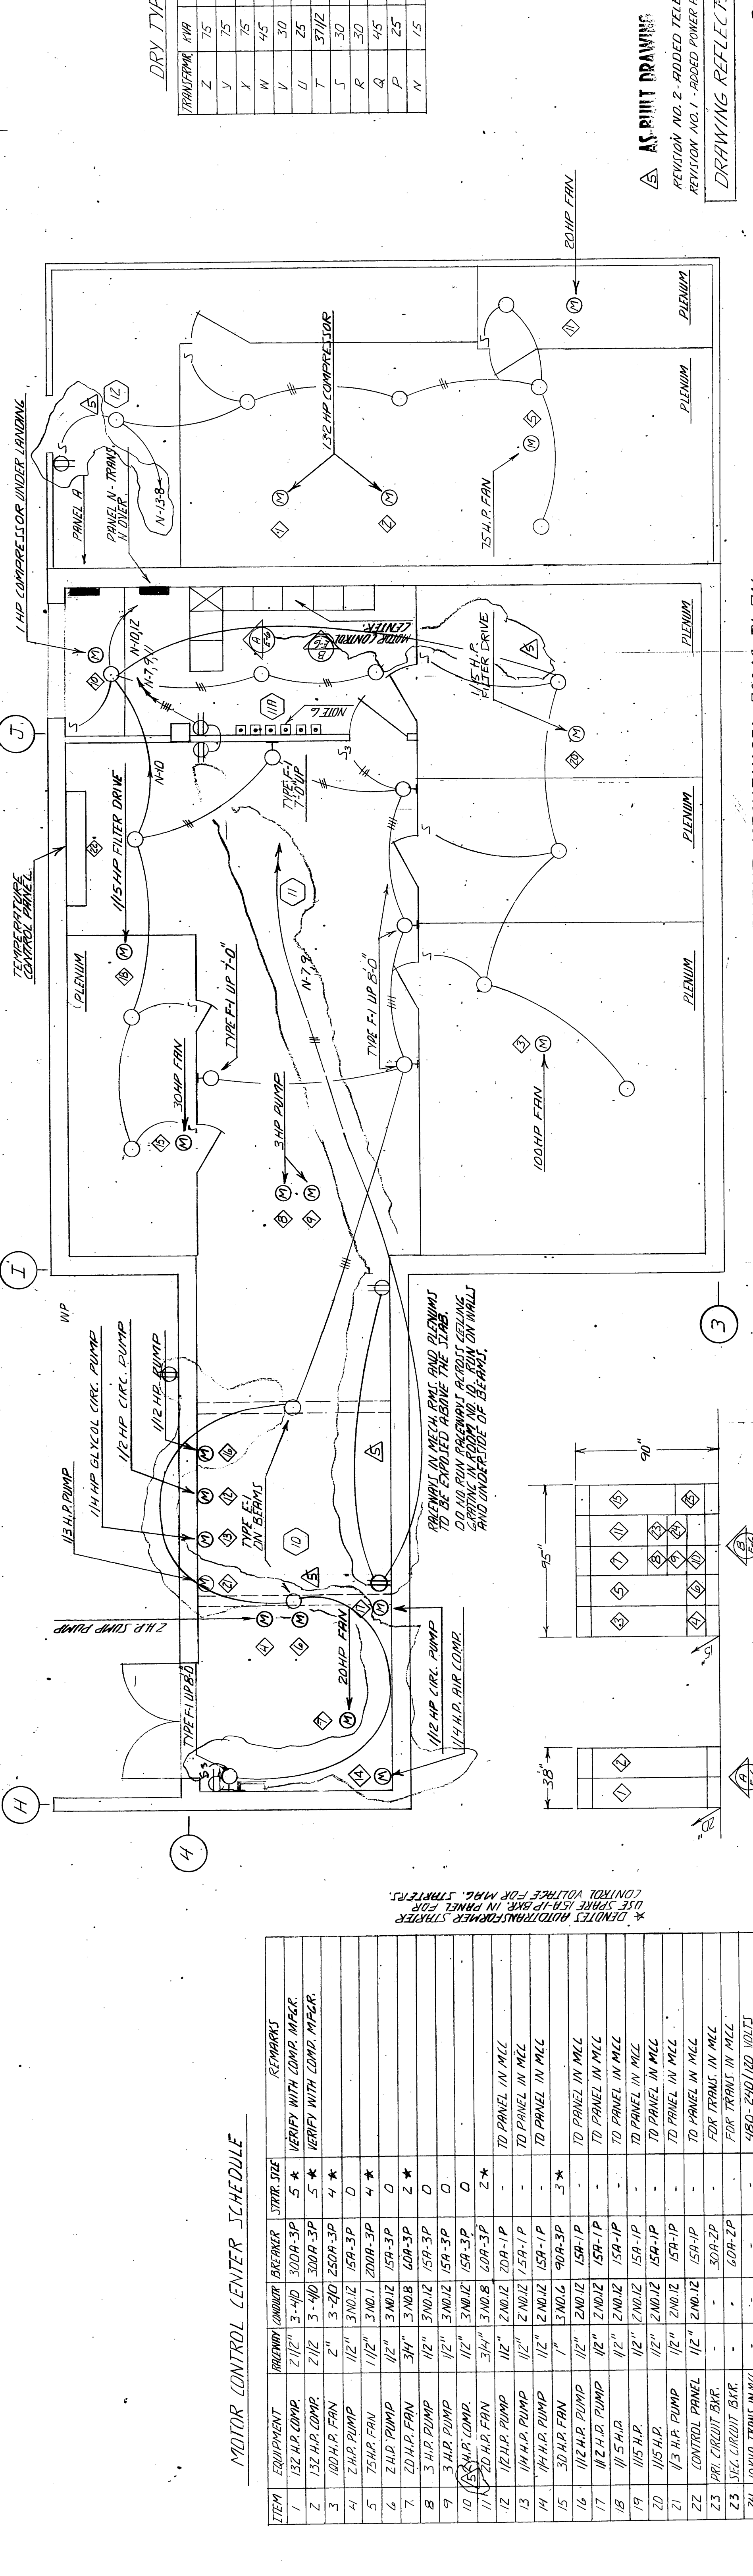


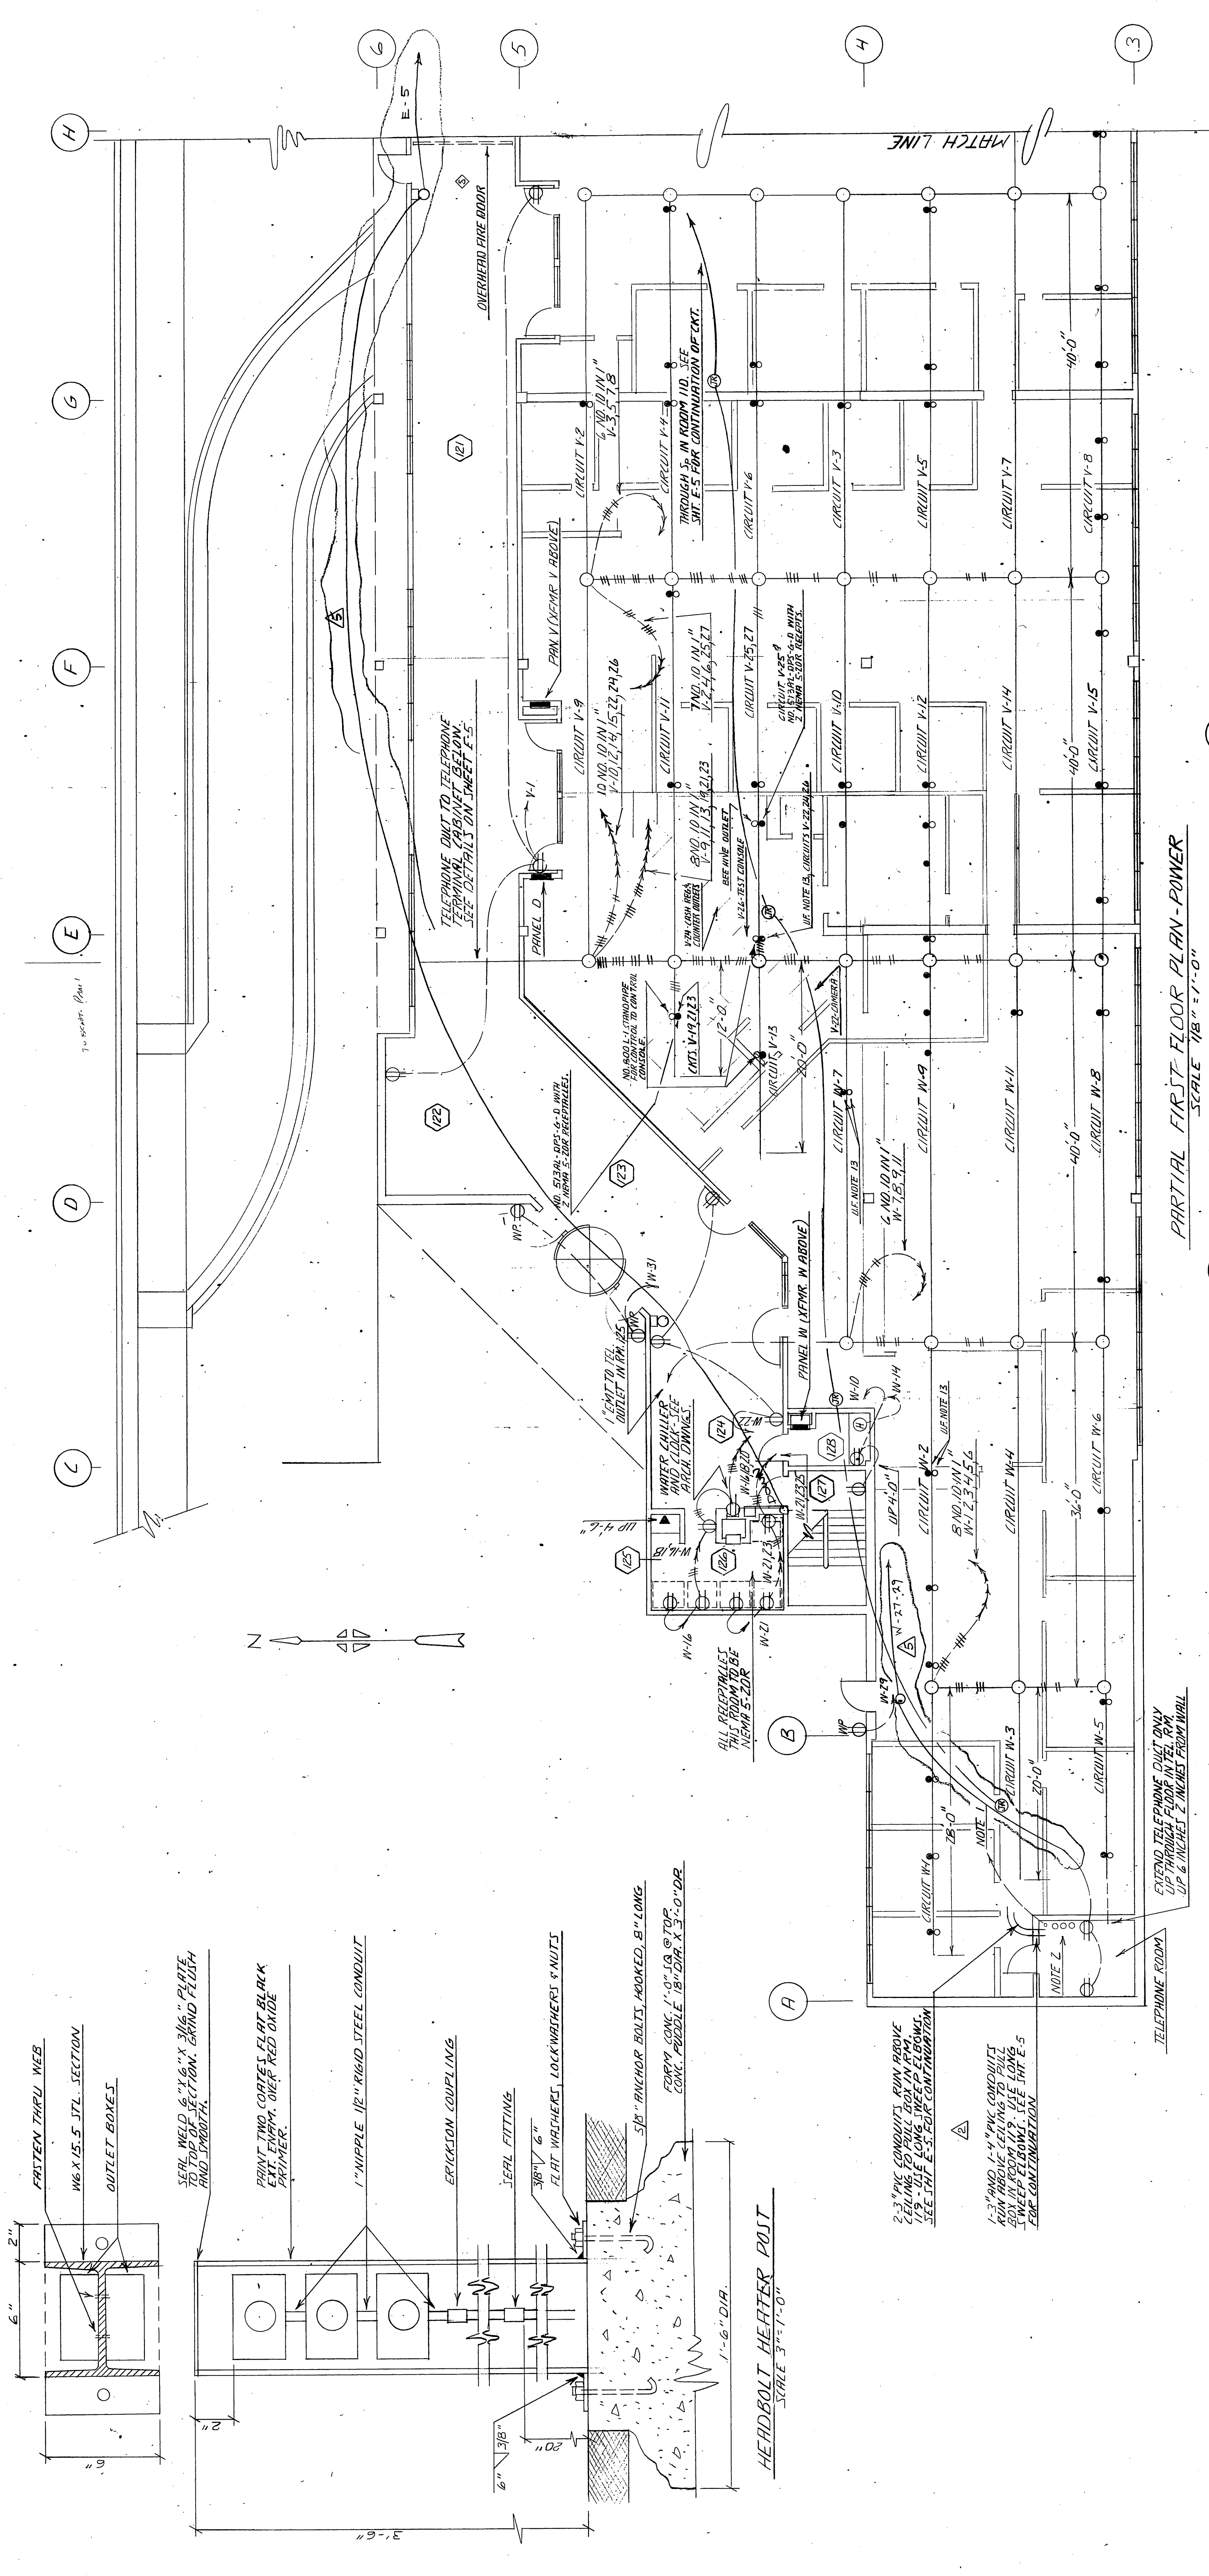


AS BUILT DRAWING 6/12/75
REVISION NO. 2 - ADDED TELEPHONE CONDUIT IN TELEPHONE ROOM 3/28/75
REVISION NO. 1 - ADDED POWER AND TELEPHONE FLOOR OUTLET AND NEW PARTITION LAYOUT 2/15/75
DRAWING REFLECTS CHANGES MADE BY ADDENDUMS 2/25/74

FIRST FLOOR PLAN WEST POWER AND TELEPHONE


DRY TYPE TRANSFORMERS

TRANSFORMER	KVA	PHASE	VOLTS	TYPE	LOCATION
1	75	3	480	DRY	FLOOR
2	75	3	480	DRY	FLOOR
AS BUILT
PRODUCED IN ACCORDANCE WITH CONTRACTOR
SUBMITTED AS BUILT RECORDS AS APPROVED
BY THE STATE OF ALASKA

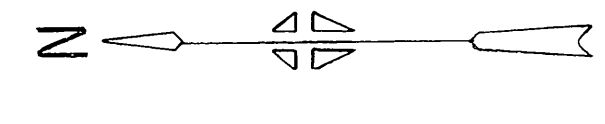

SECOND FLOOR PLAN - LIGHTING

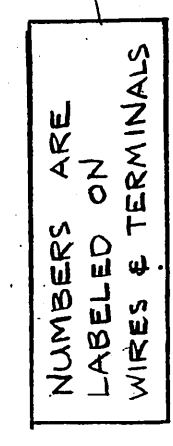

SCHEMATIC - EMERGENCY CORRIDOR LIGHTING - 2ND FLOOR

ROOM	TYPE	MAINTENANCE	LAMP	REMARKS
108	T	RECEIVED	FLUO W	
	S	FEELING	25TIO	EXIT LIGHT - JEE SHEET E-3
	S	WALL	25TIO	EXIT LIGHT - JEE SHEET E-3
200	G	RECEIVED	FLUO W 1/6	JEE SHEET E-3
	V	RECEIVED	100W/25P	
201	F	RECEIVED	FLUO W	
	F	RECEIVED	150W/FL	

* USE ISO PAR 38/2 FLAMPS FOR BIDDING PURPOSES

ROOM	TYPE	PAINTING	LAMP	REMARKS
200	T	CEILING	2570 W	EXIT LIGHT - ICE SHEET E-3
201	S	CEILING	2570 W	EXIT LIGHT - ICE SHEET E-3
202	F	WALL	2570 W	EXIT LIGHT - ICE SHEET E-3
203	V	REFLECTED	2570 W	ICE SHEET E-3
204	G	REFLECTED	2570 W	ICE SHEET E-3
205	J	REFLECTED	2570 W	ICE SHEET E-3
206	F	REFLECTED	2570 W	ICE SHEET E-3
207	M	REFLECTED	2570 W	ICE SHEET E-3
208	O	REFLECTED	2570 W	ICE SHEET E-3
209	J	REFLECTED	2570 W	ICE SHEET E-3
210	S	REFLECTED	2570 W	ICE SHEET E-3
211	S	REFLECTED	2570 W	ICE SHEET E-3
212	S	REFLECTED	2570 W	ICE SHEET E-3
213	S	REFLECTED	2570 W	ICE SHEET E-3
214	S	REFLECTED	2570 W	ICE SHEET E-3
215	S	REFLECTED	2570 W	ICE SHEET E-3
216	S	REFLECTED	2570 W	ICE SHEET E-3
217	S	REFLECTED	2570 W	ICE SHEET E-3

AS BUILTS
PRODUCED IN ACCORDANCE WITH CONTRACTORS
SUBMITTED AS-BUILT RECORDS AS SUBMITTED
BY THE STATE OF ALABAMA

AS-BUILT DRAWING

REVISION NO. A - EMERGENCY CORRIDOR LIGHTING CHANGES - 2/26/75
 REVISION NO. B - EMERGENCY PATHWAY LIGHTING CHANGES - 2/26/75
 REVISION NO. 2 - LIGHTING CHANGED PER NEW PARTITION LAYOUT - 2/14/75
 REVISION NO. 1 - LIGHTING CHANGED PER NEW PARTITION LAYOUT - 10/31/74

DRAWING REFLECTS CHANGES MADE BY ADDENDUMS 2/25/74

SECOND FLOOR PLAN - LIGHTING

ARCHITECTS - ENGINEERS - SURVEYORS
801 COLLEGE ROAD, FAIRBANKS, ALASKA 99701, PHONE: 452-1241


JOB NO.: 7205-731
DATE: NOV. 12, 1973

**STATE OF ALASKA
DEPARTMENT OF PUBLIC WORKS
DIVISION OF BUILDINGS**

**FAIRBANKS REGIONAL
OFFICE BUILDING**
D2A 8-010 • BLOCK 88A • FAIRBANKS, ALASKA

E7

SHEET NO.: OF

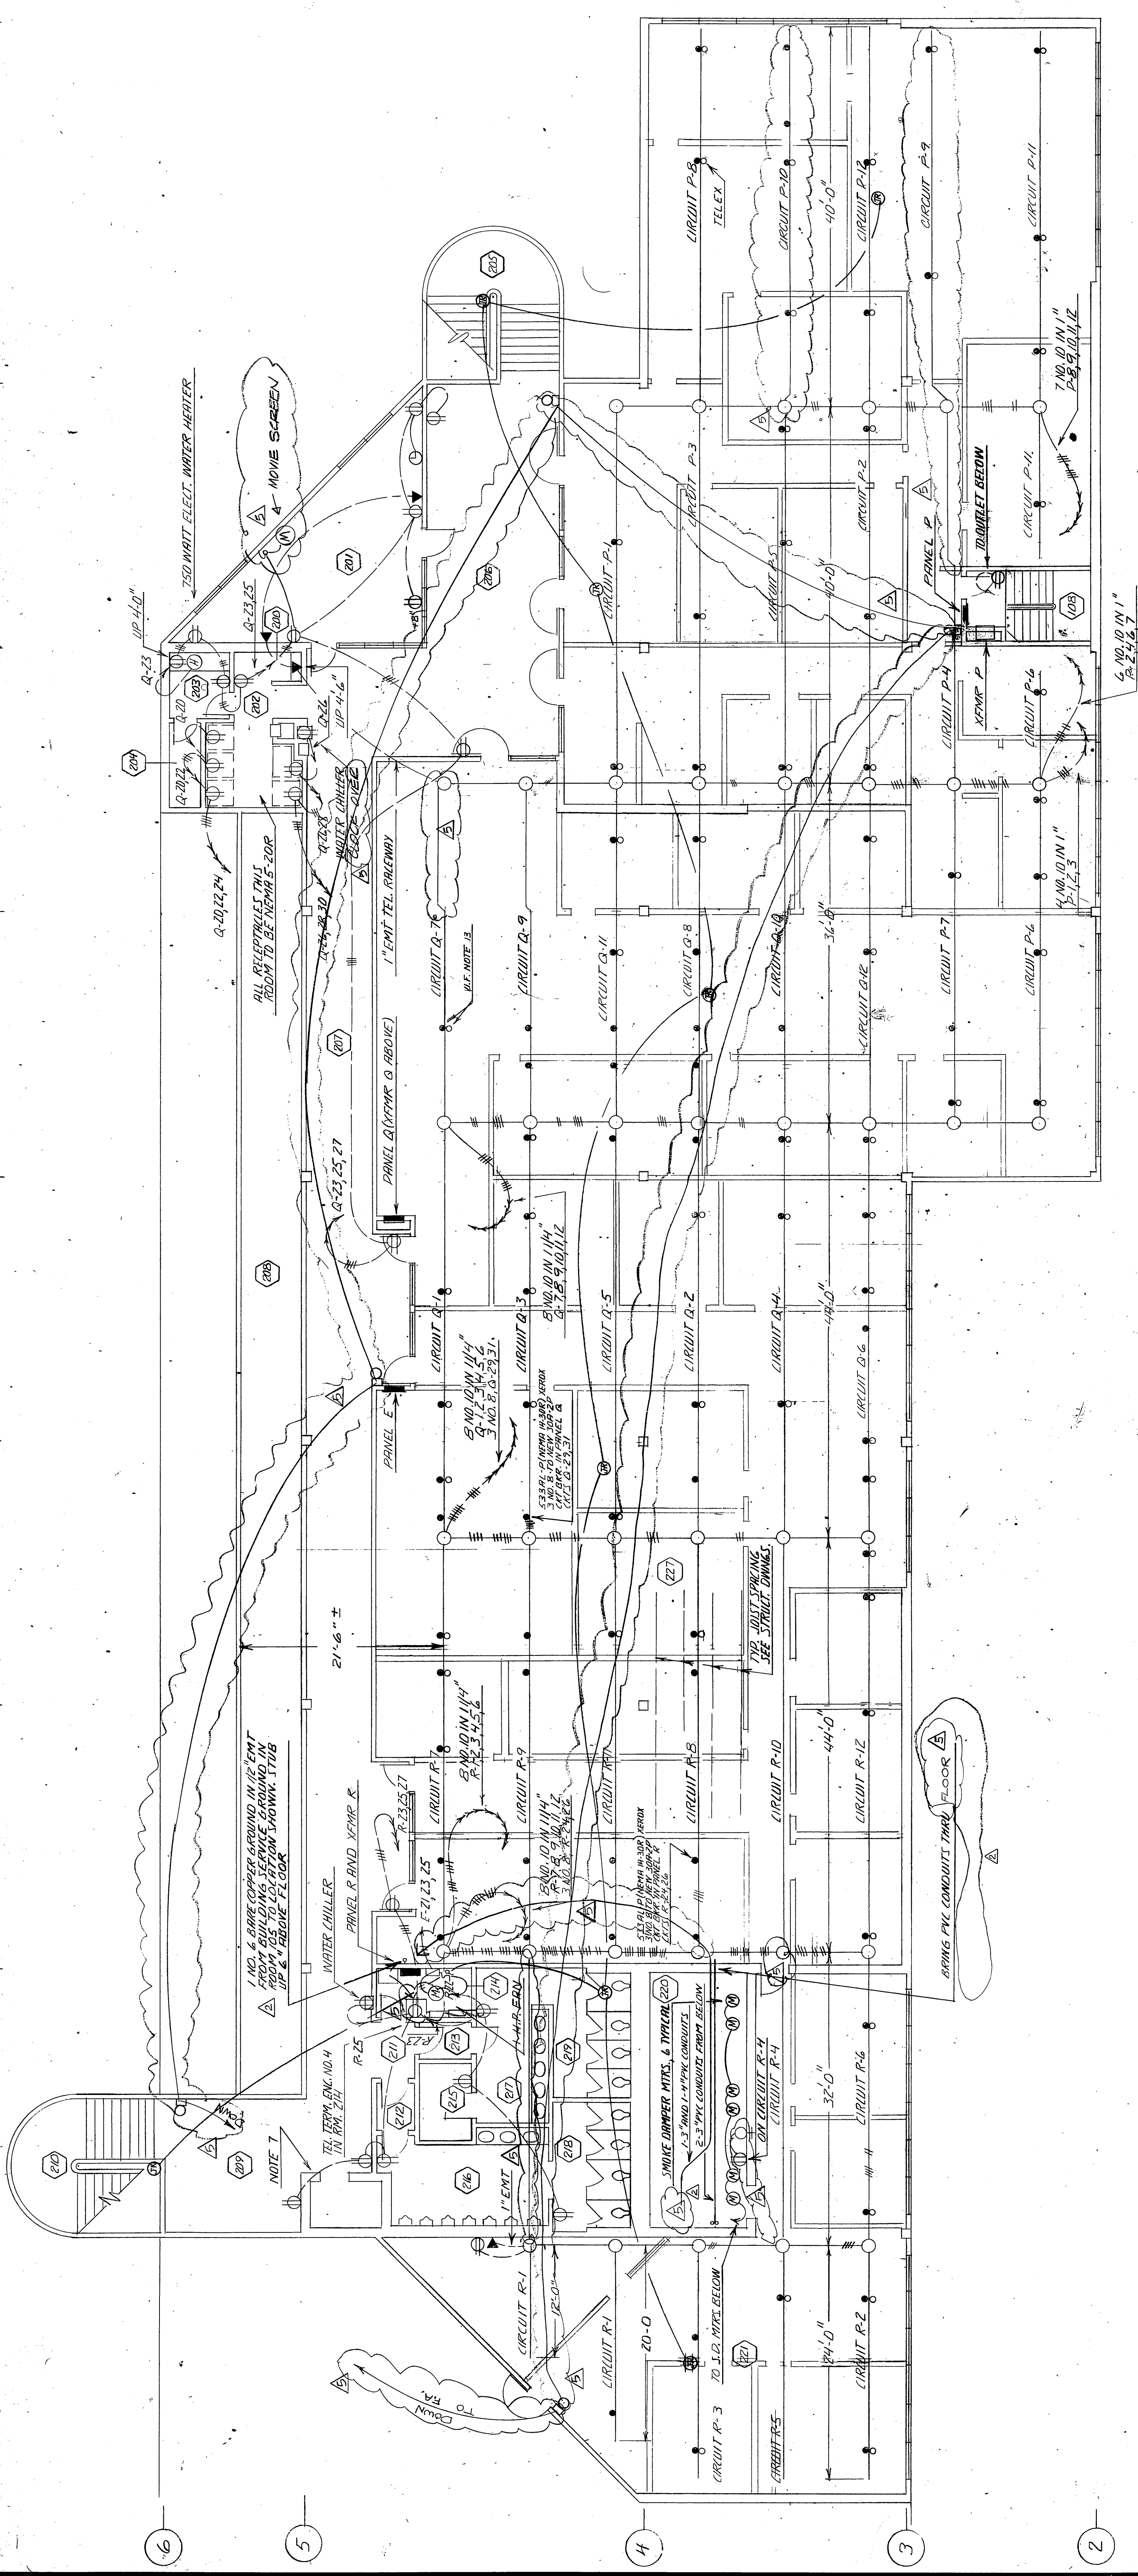

SECOND FLOOR PLAN - POWER
SCALE 1/8" = 1'-0"

AS BUILTS
PRODUCED IN ACCORDANCE WITH CONTRACTOR
SUBMITTED AS BUILT - RECORDS AS APPROVED
BY THE STATE OF ALASKA.

AS-BUILT DRAWING 6-12-78

REVISION NO. 2 - ADDED TELEPHONE CONDUIT AND BUILT FOR IN ROOM 220 AND
312/215
REVISION NO. 1 - ADDED POWER AND TELEPHONE FLOOR OUTLET AND NEW PARTITION LAYOUT 2/25/74

DRAWING REFLECTS CHANGES MADE BY ADDENDUMS 2/25/74

SECOND FLOOR PLAN - POWER AND TELEPHONE

JOB NO. 7-74-1, 7-31
DATE: NOV. 12, 1973









ARCHITECTS - ENGINEERS - SURVEYORS
601 COLLEGE ROAD, FAIRBANKS, ALASKA 99701, PHONE: 452-1241







STATE OF ALASKA
DEPARTMENT OF PUBLIC WORKS
DIVISION OF BUILDINGS
PHASE TWO

FAIRBANKS REGIONAL
OFFICE
BUILDING
DEA 2-010 1-BLOCK 25A, FAIRBANKS, ALASKA






8
SHEET NO. 1 OF 2

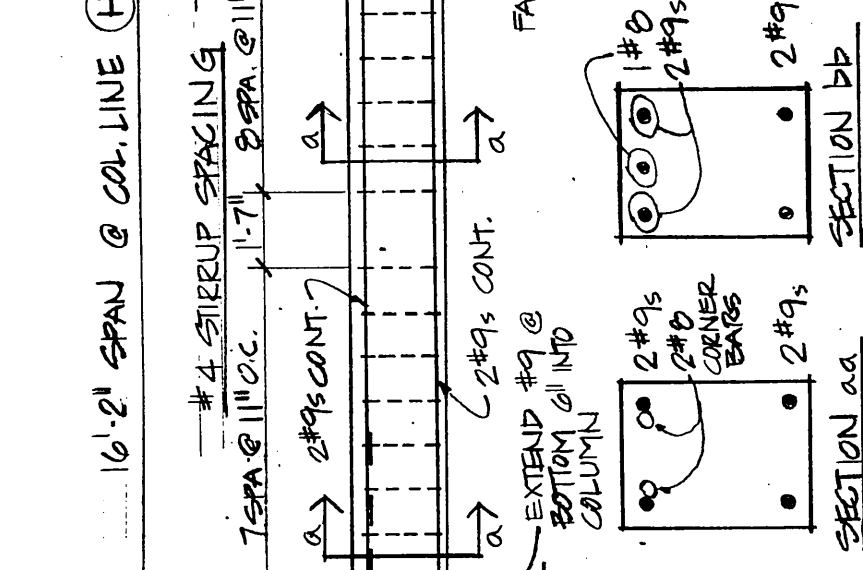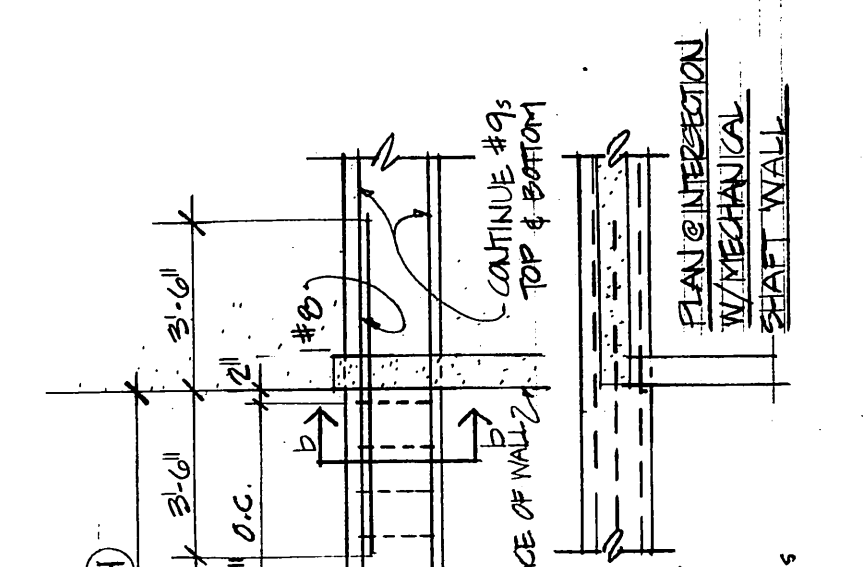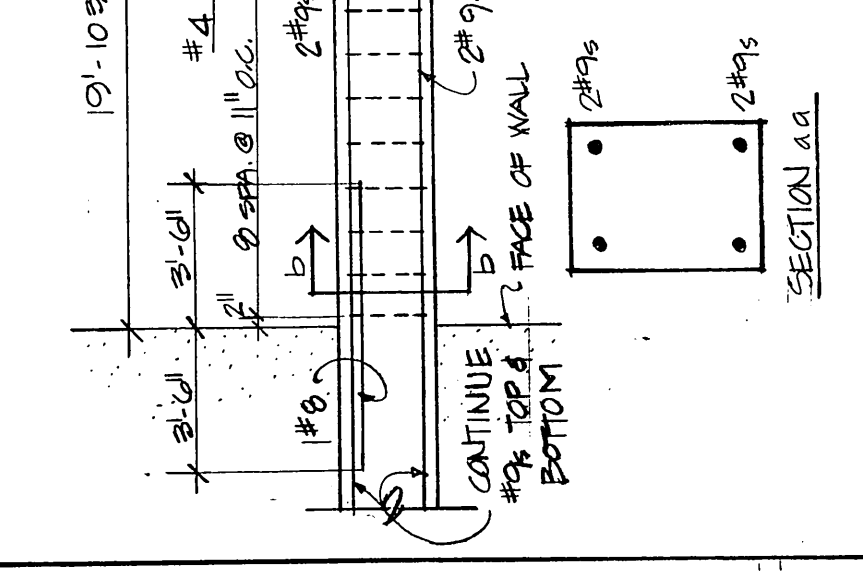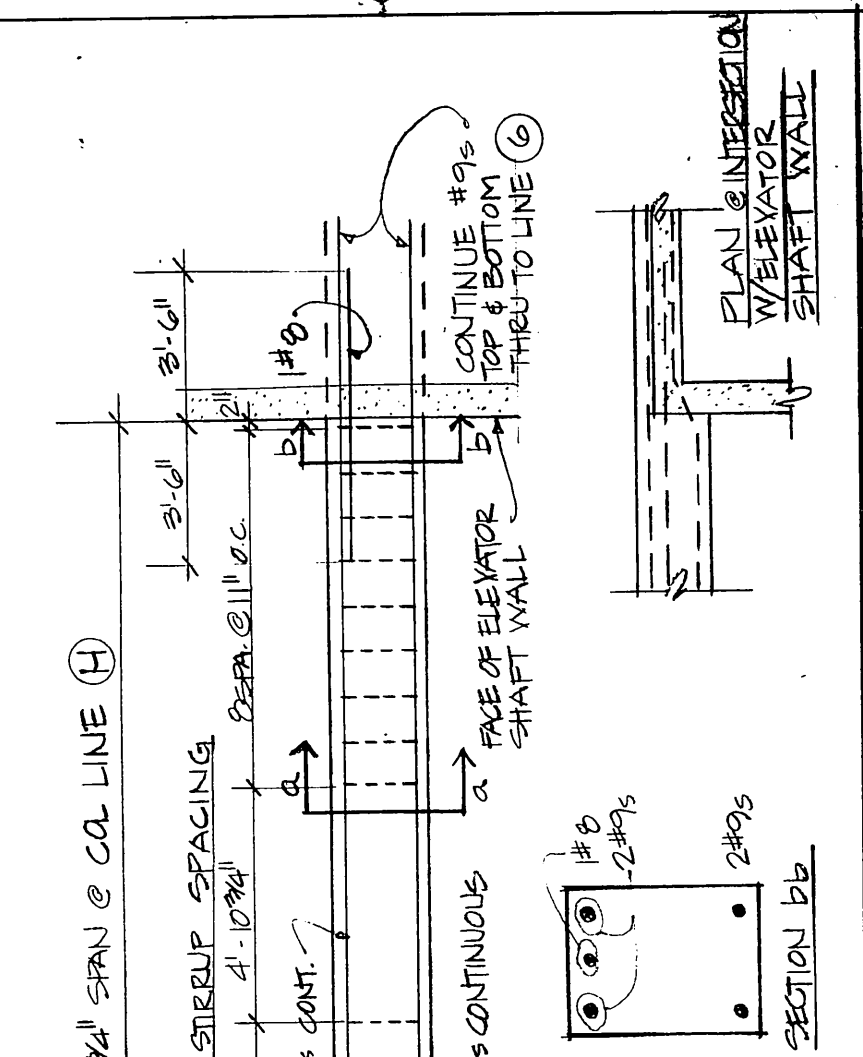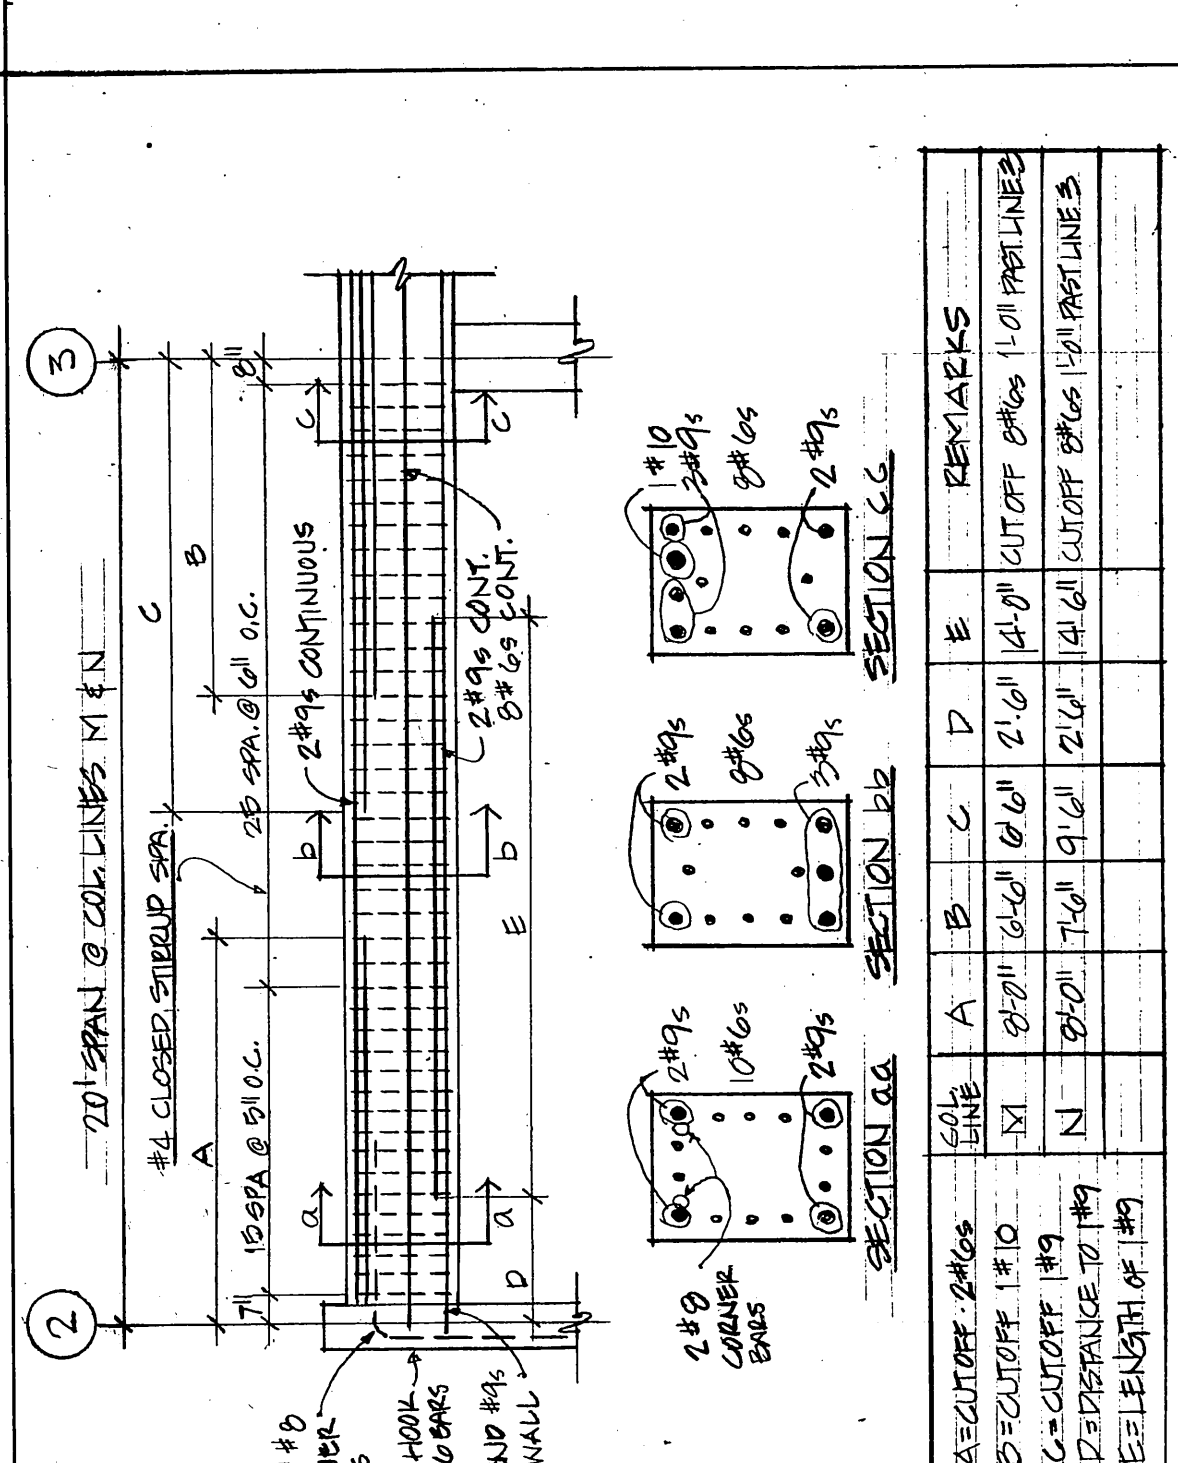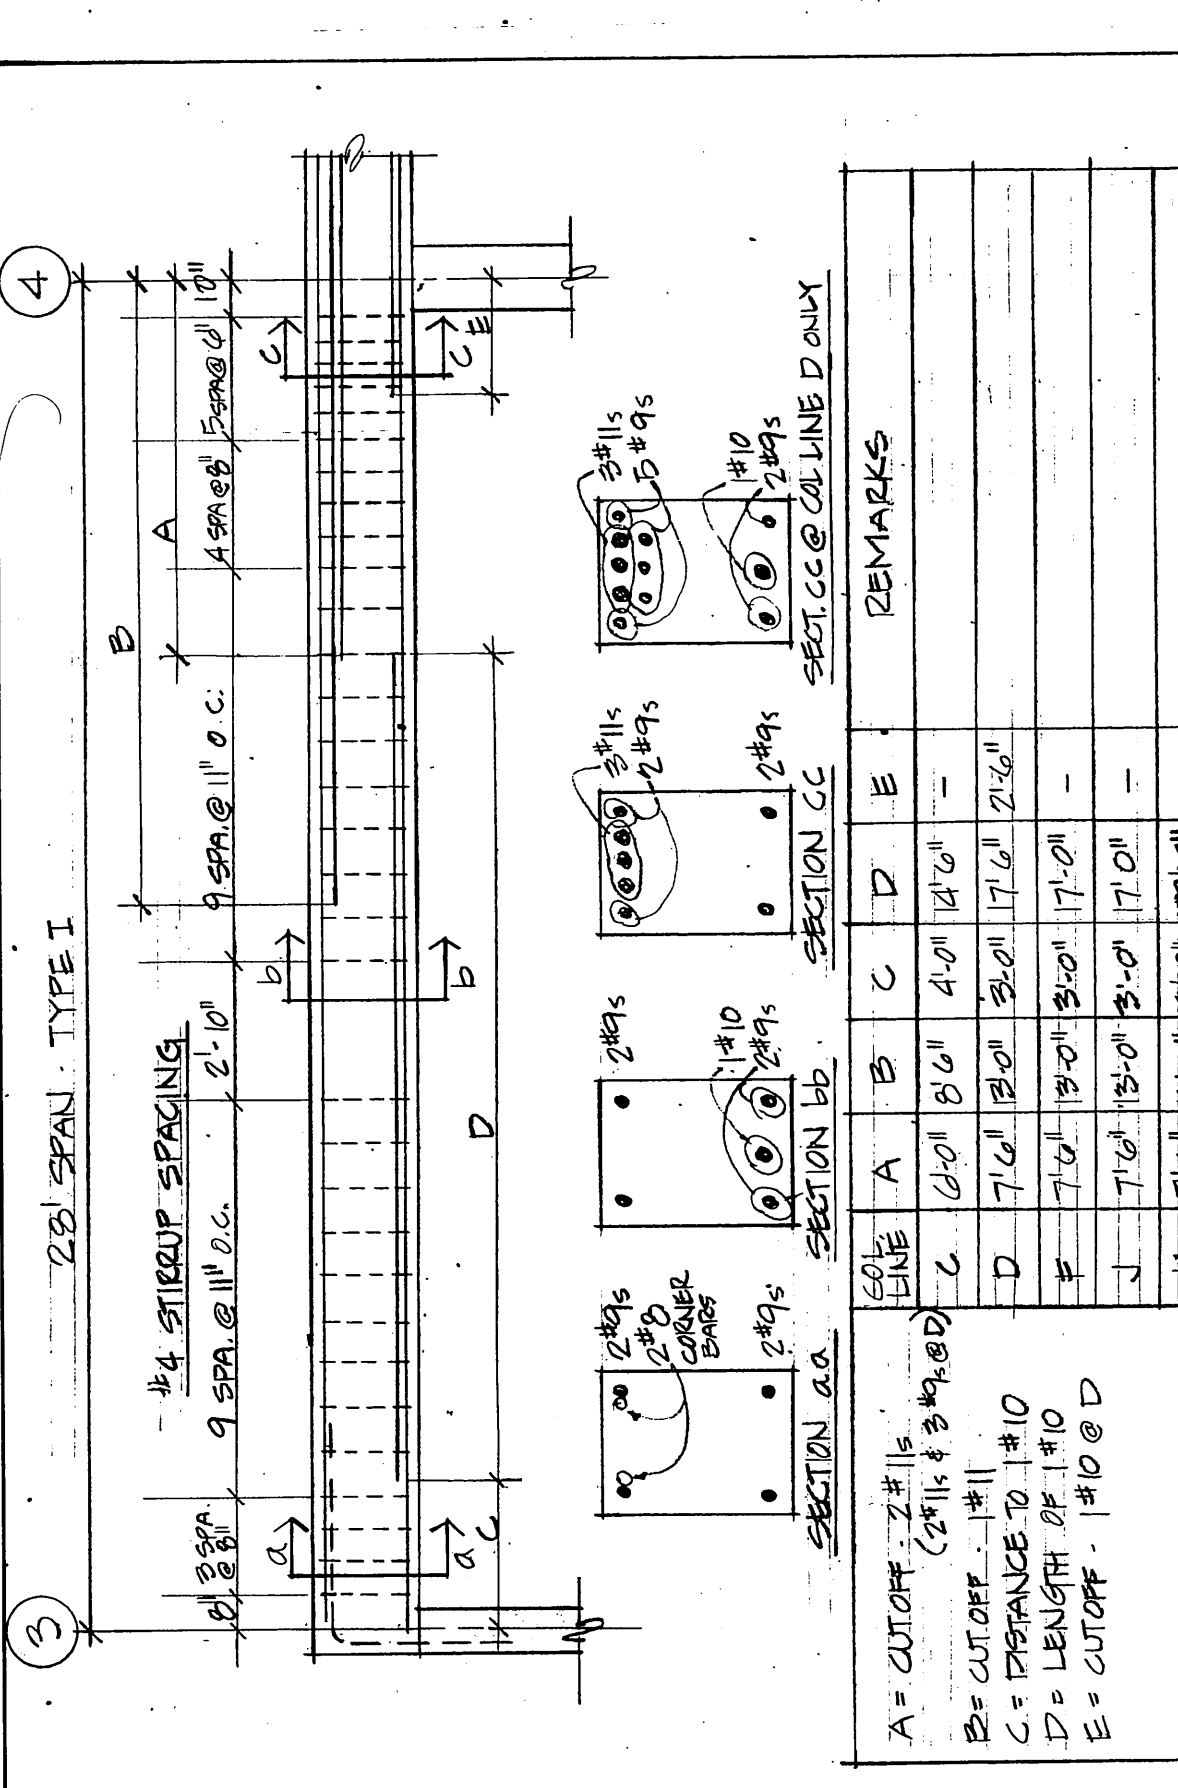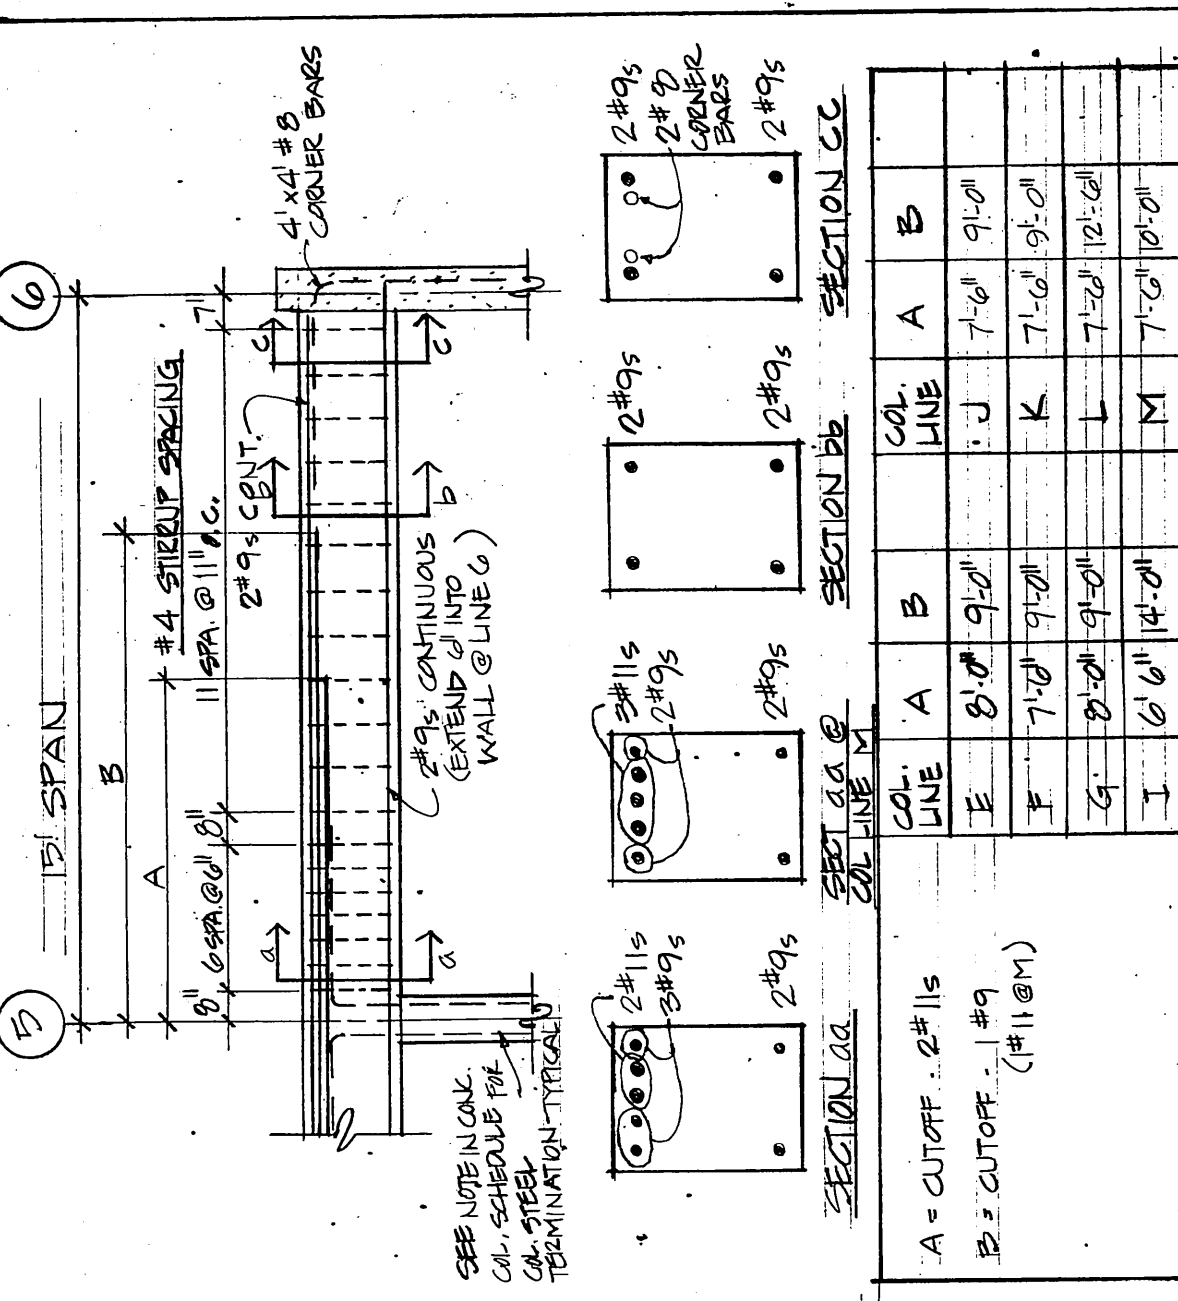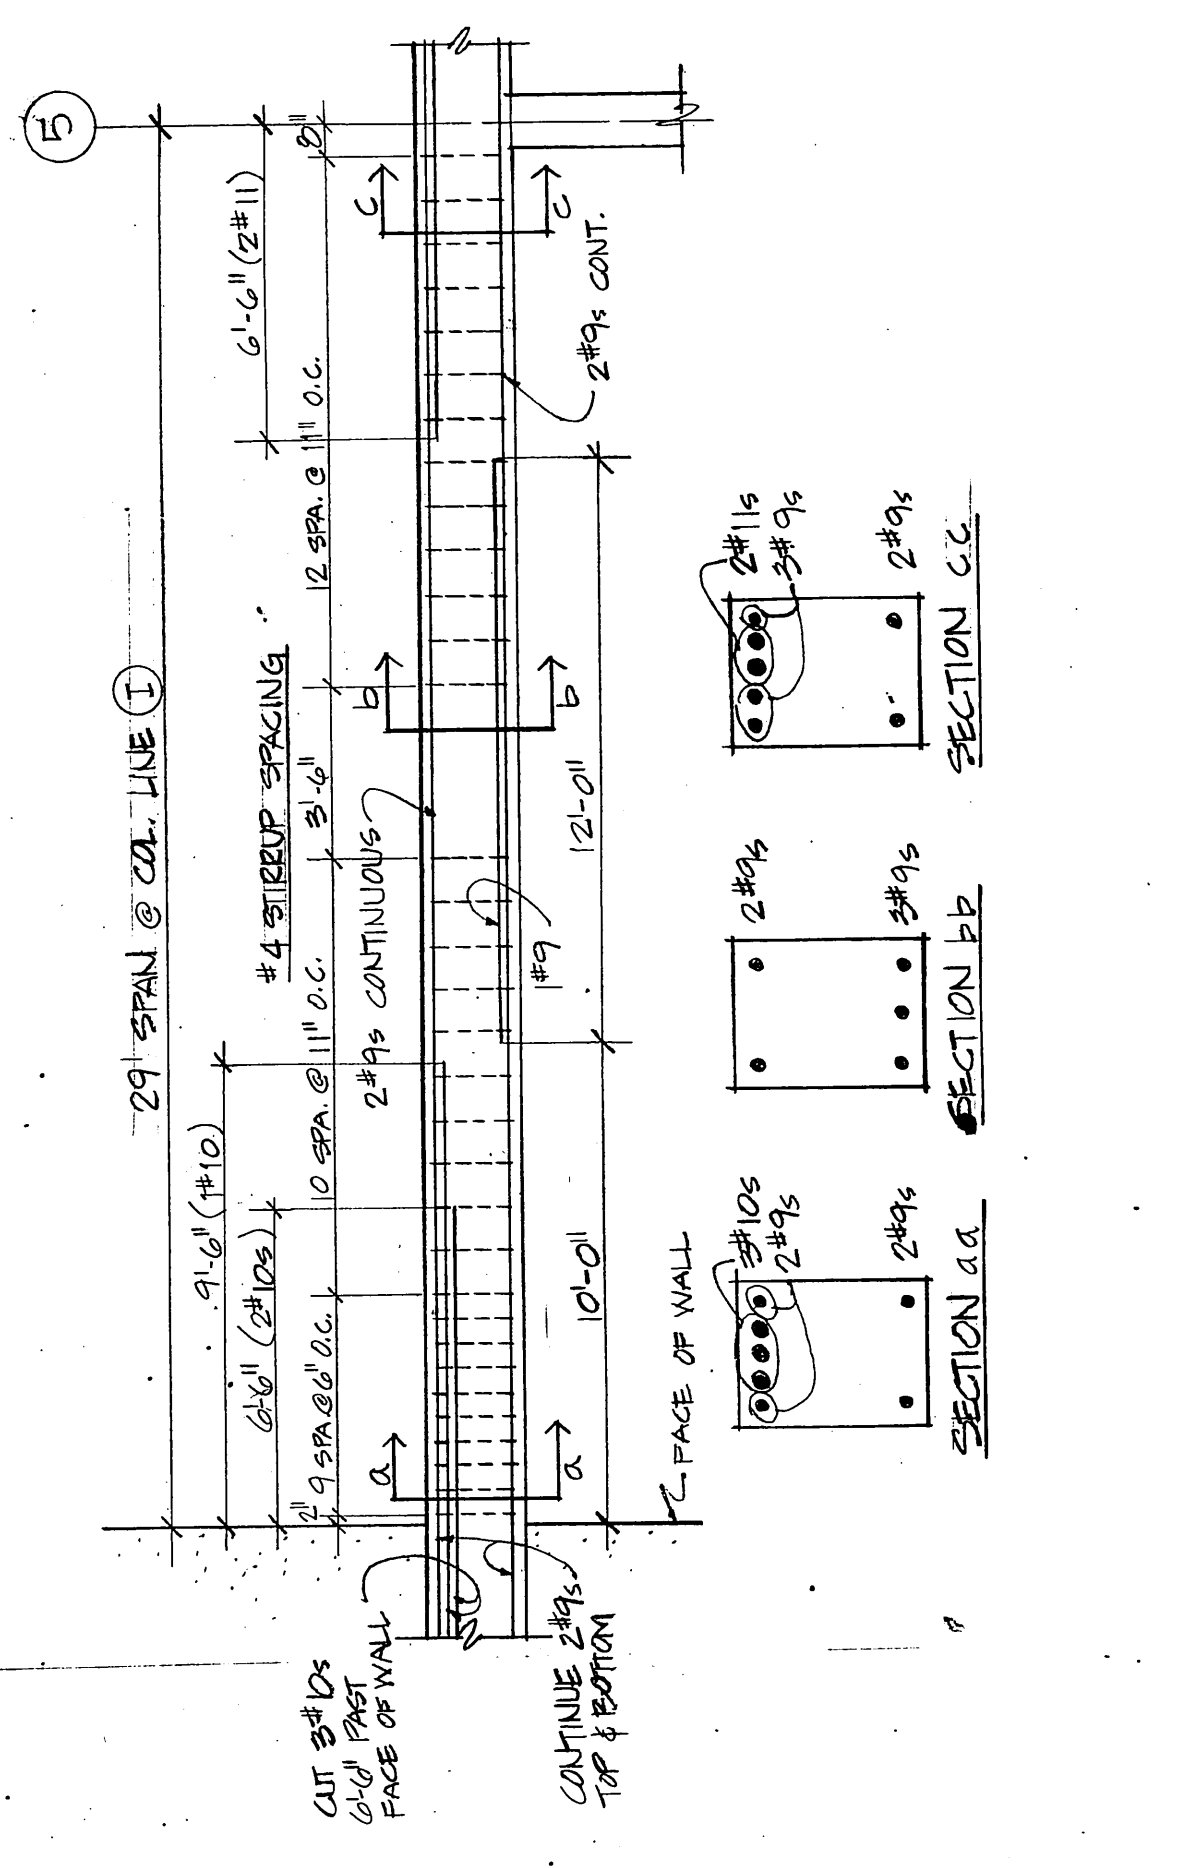

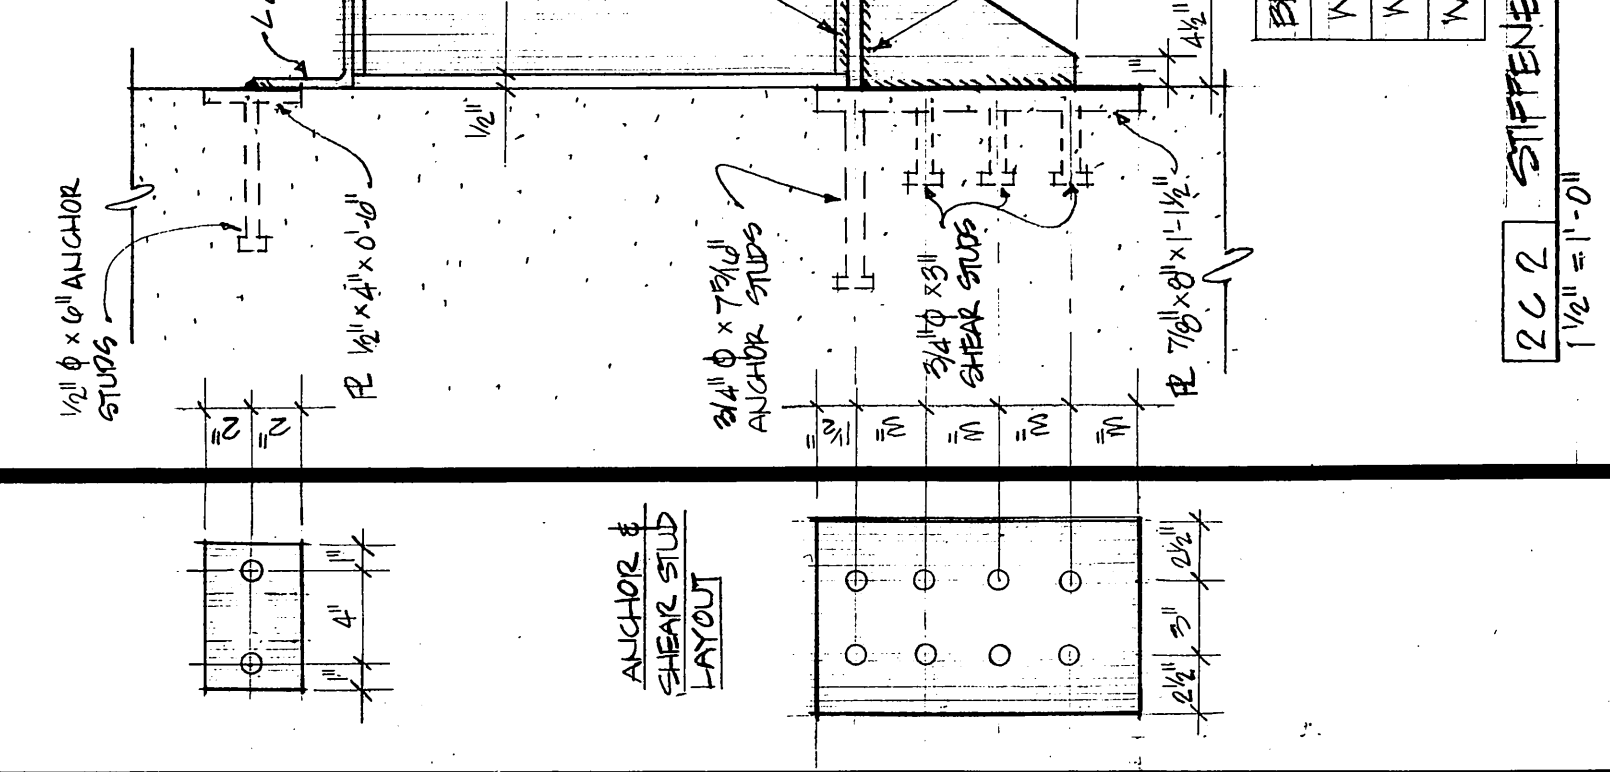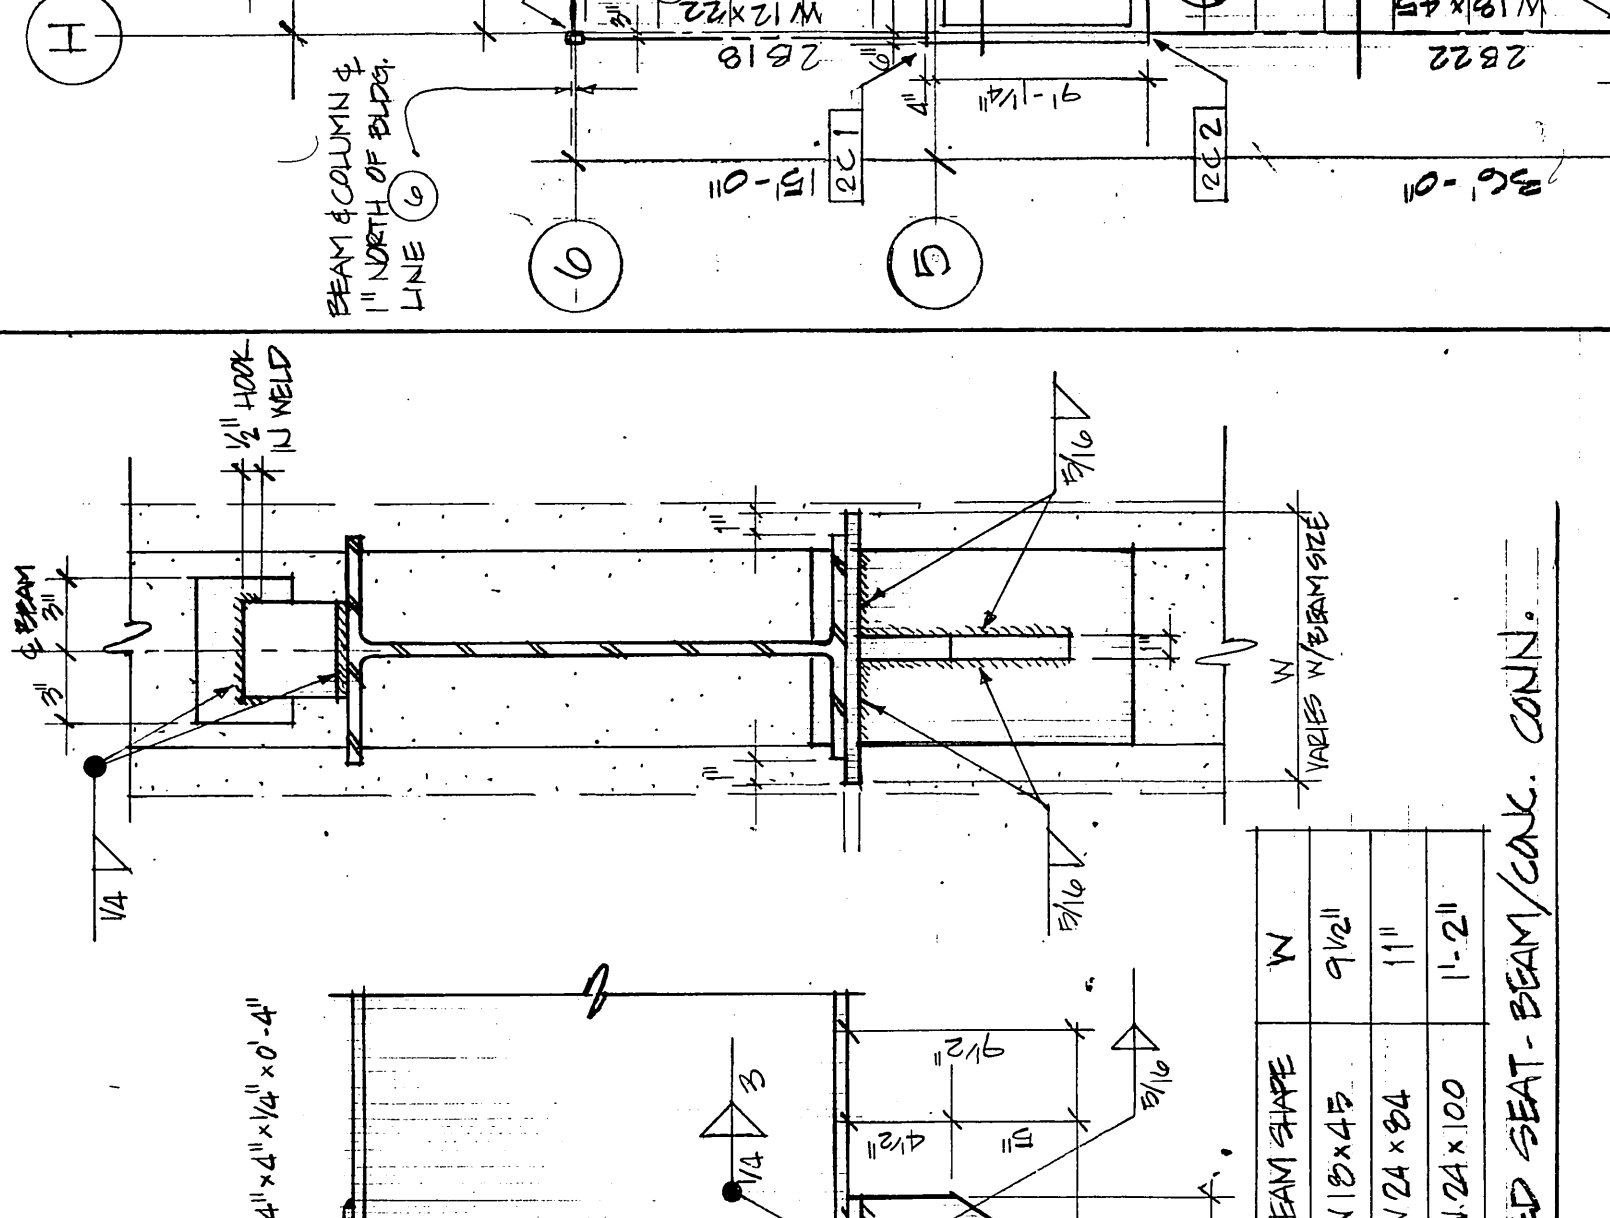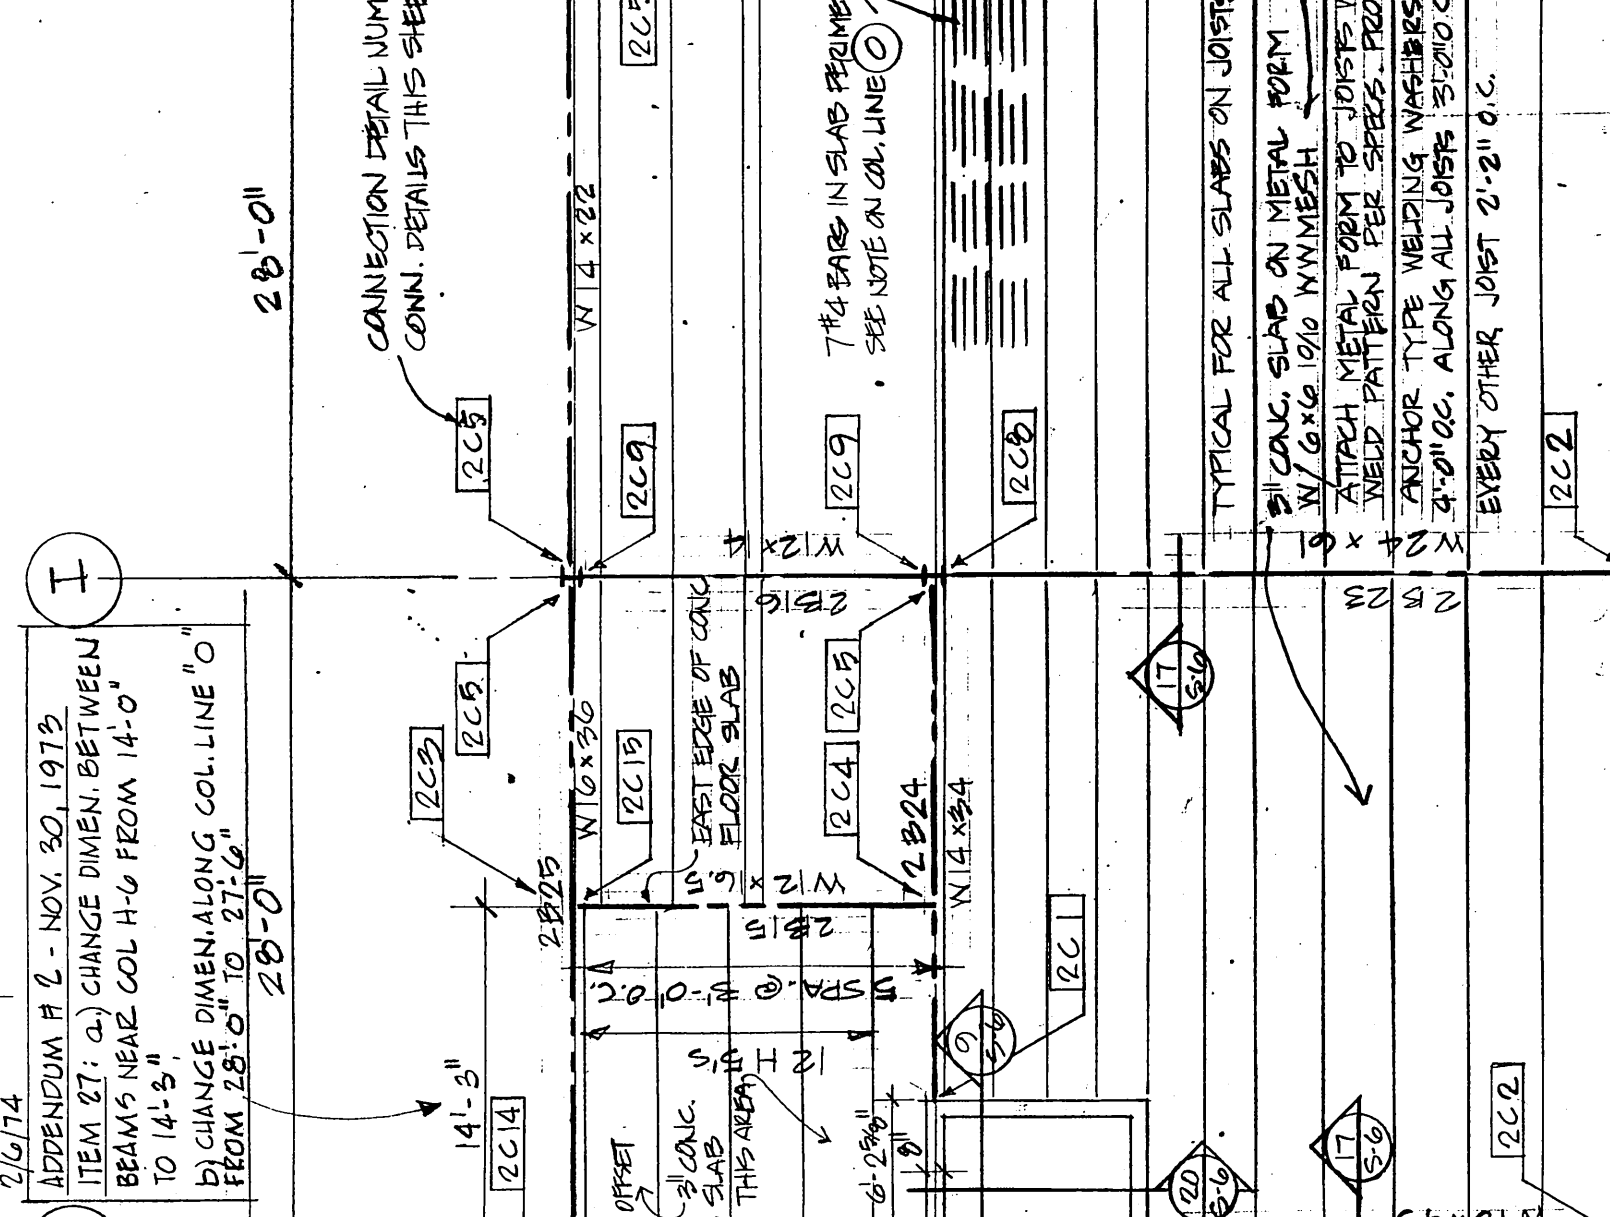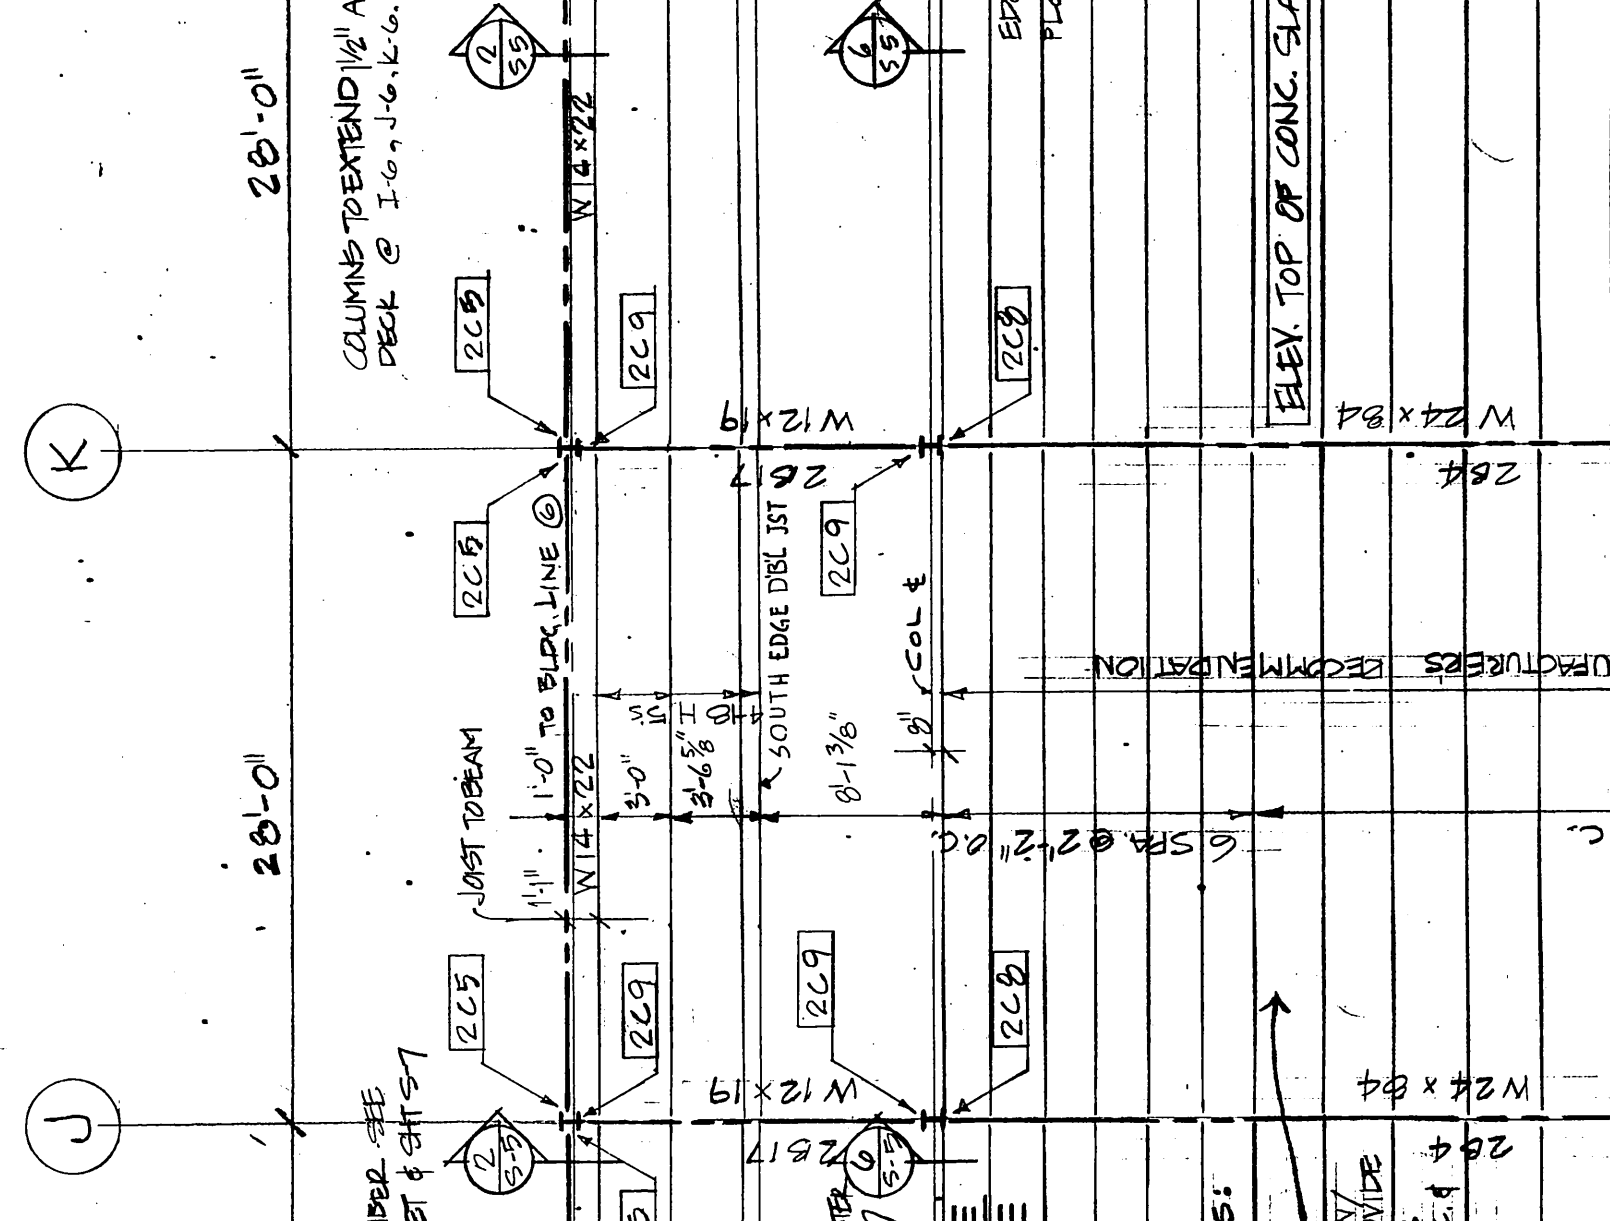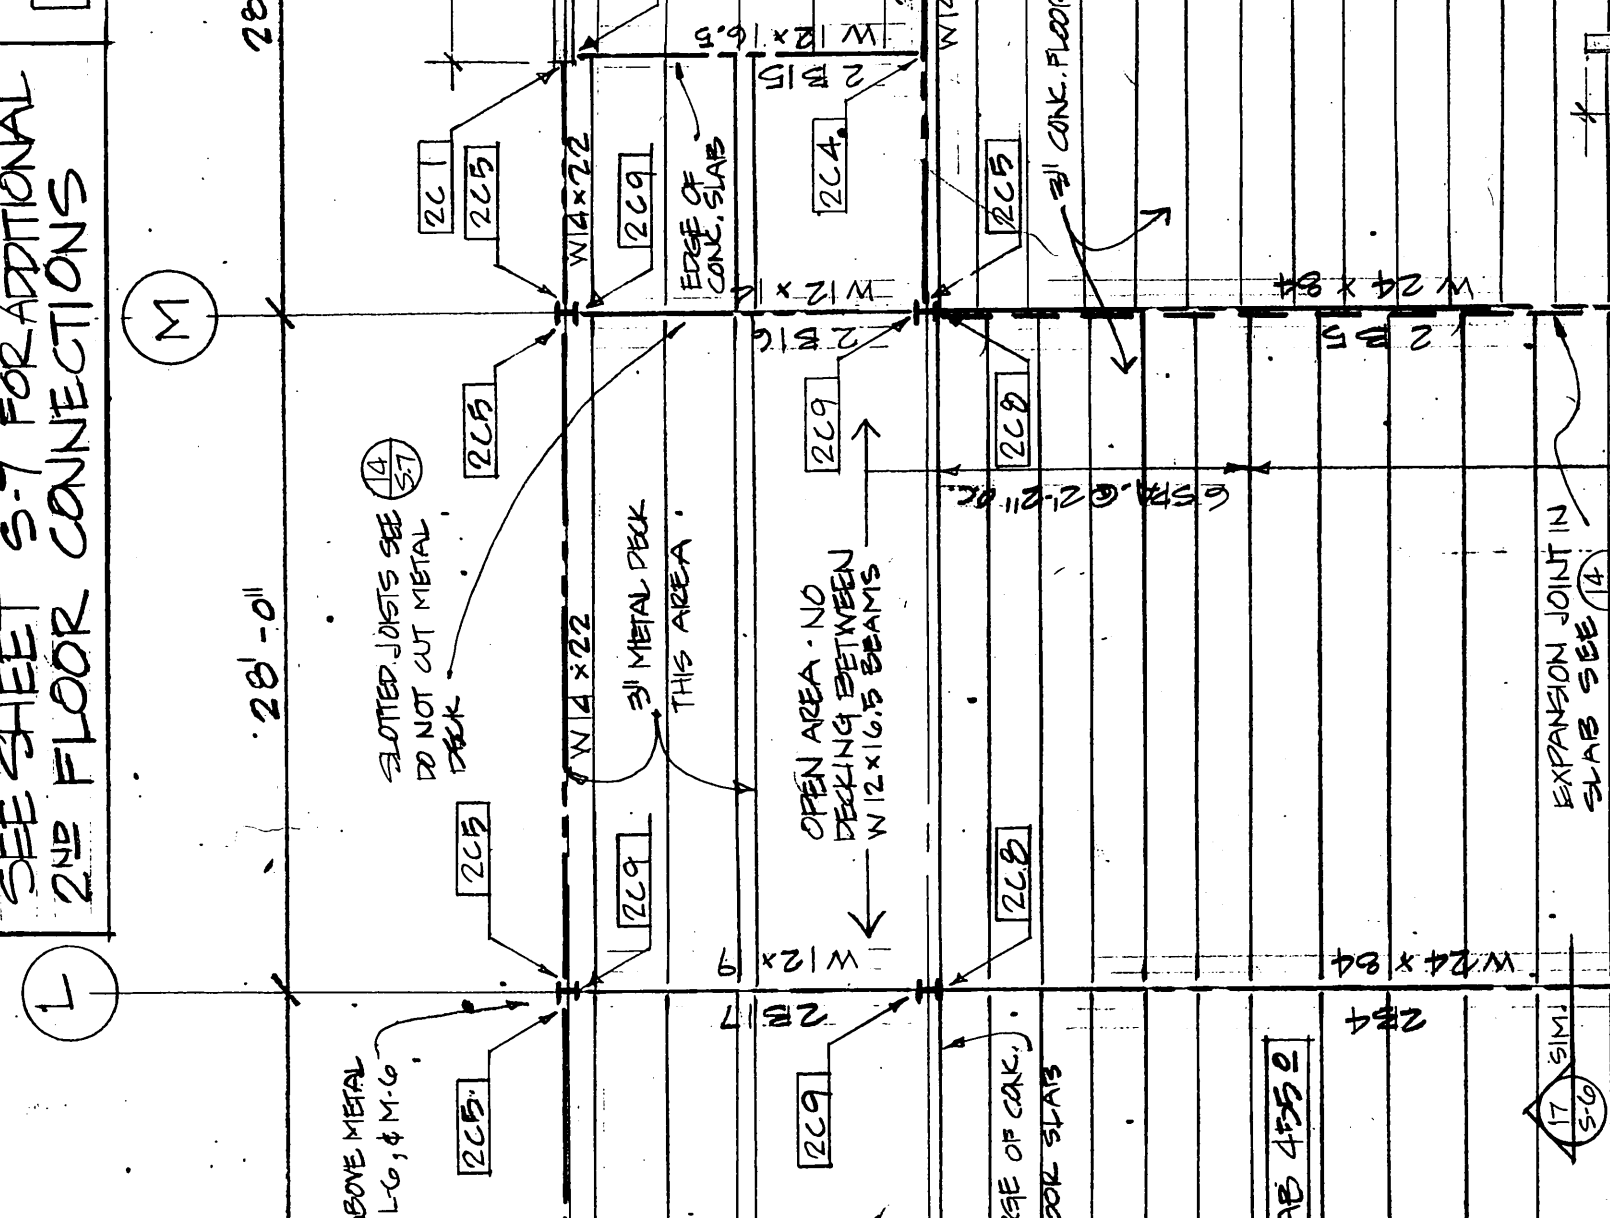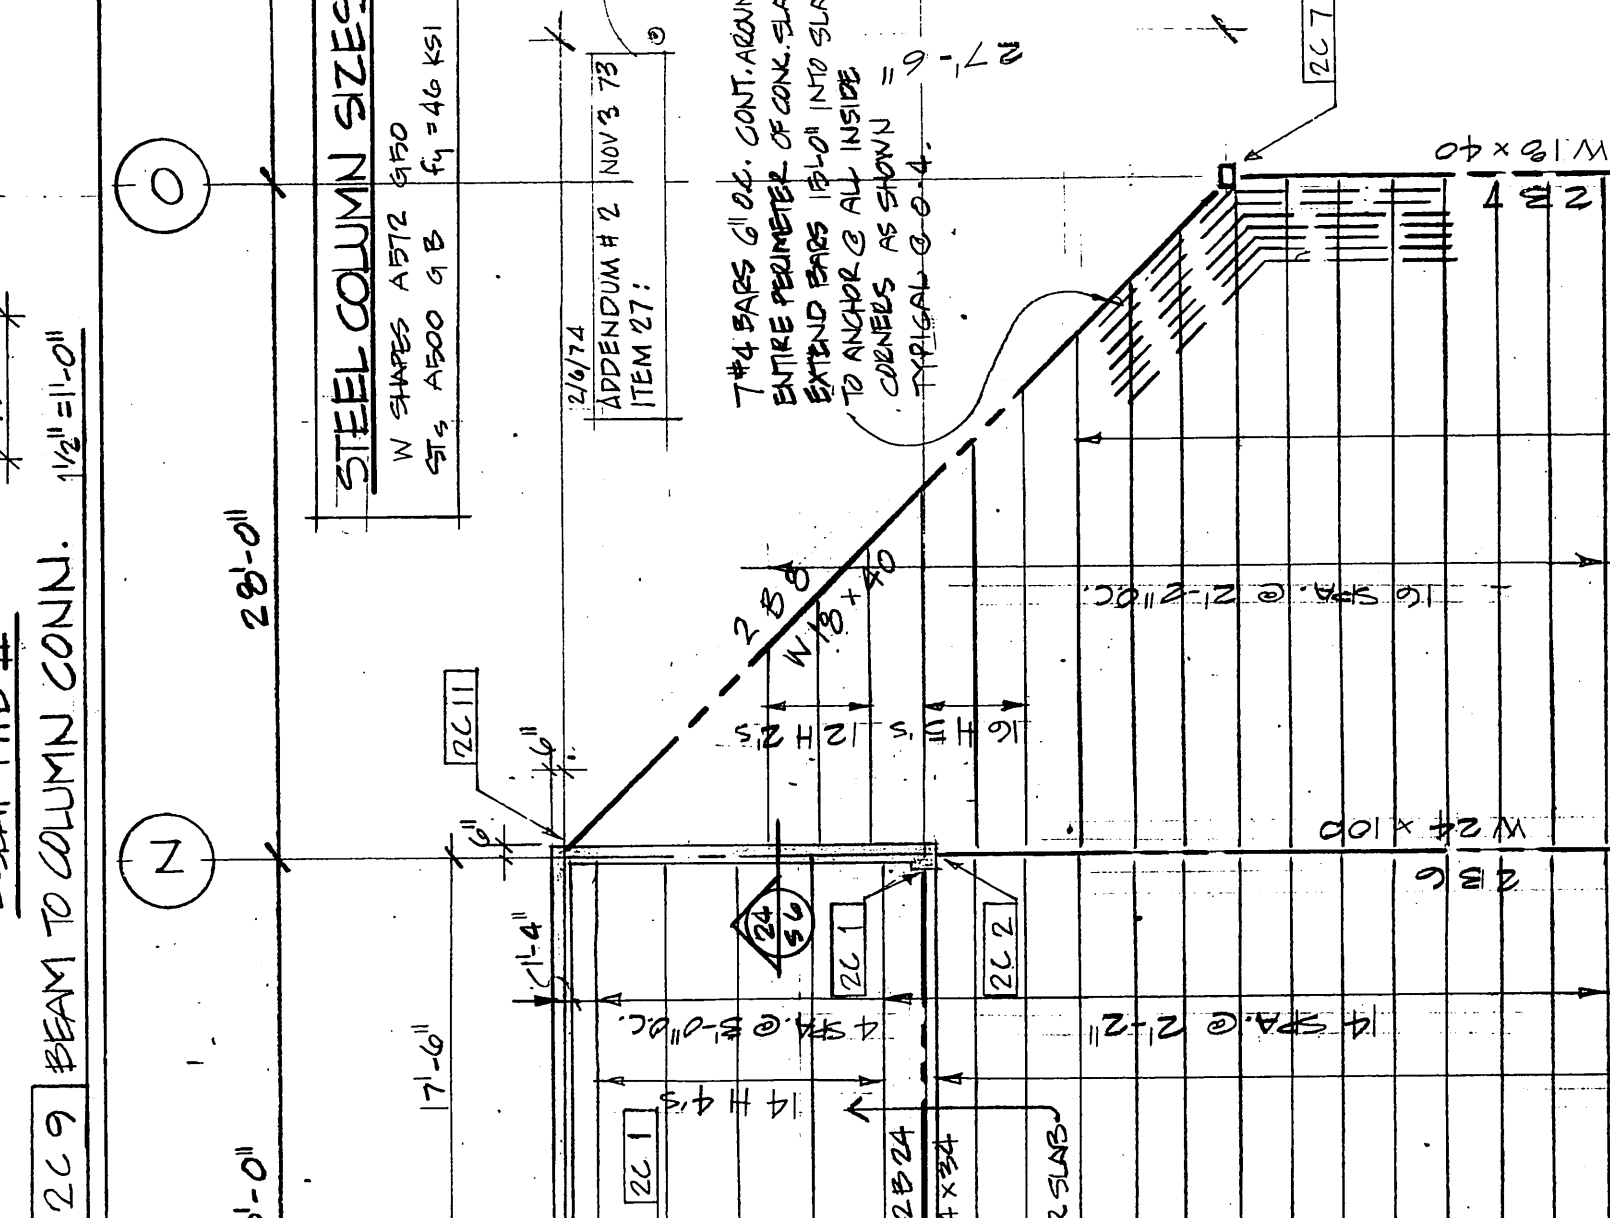


Hand-drawn structural drawing of a floor level. The drawing shows a rectangular area with dimensions 22' x 14' 6" N (width) and 15' 0" (depth). A north arrow is located in the top right corner. The drawing includes several beams and columns. Beams are labeled with sizes like 22' x 14' 6" and 22' x 14' 6". Columns are marked with 'C' and 'D'. A note at the bottom right states '22' x 14' 6" N'. The drawing is a technical sketch of a floor plan, likely for a building or structure.

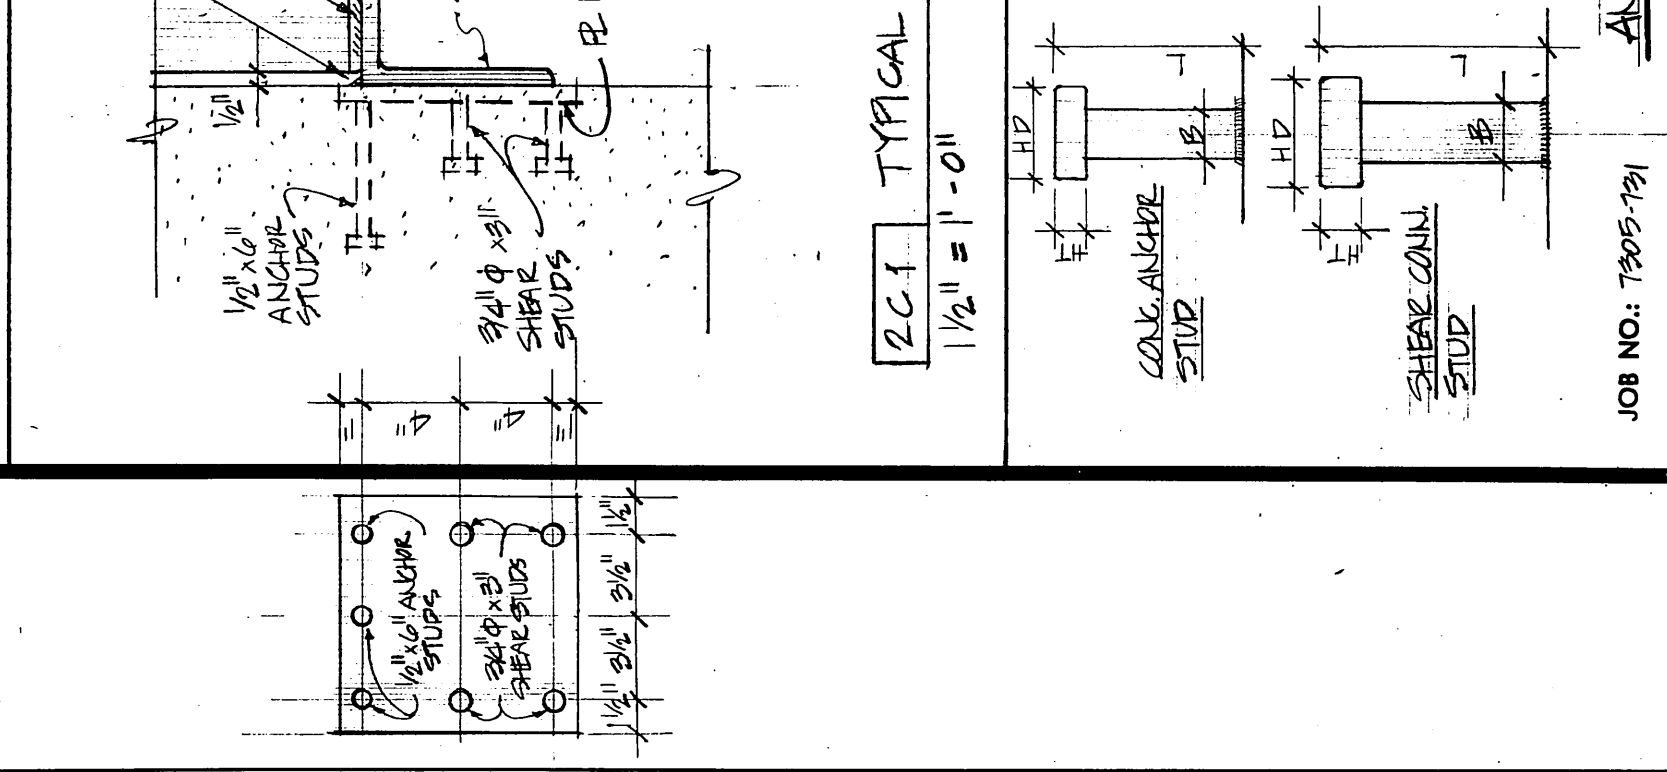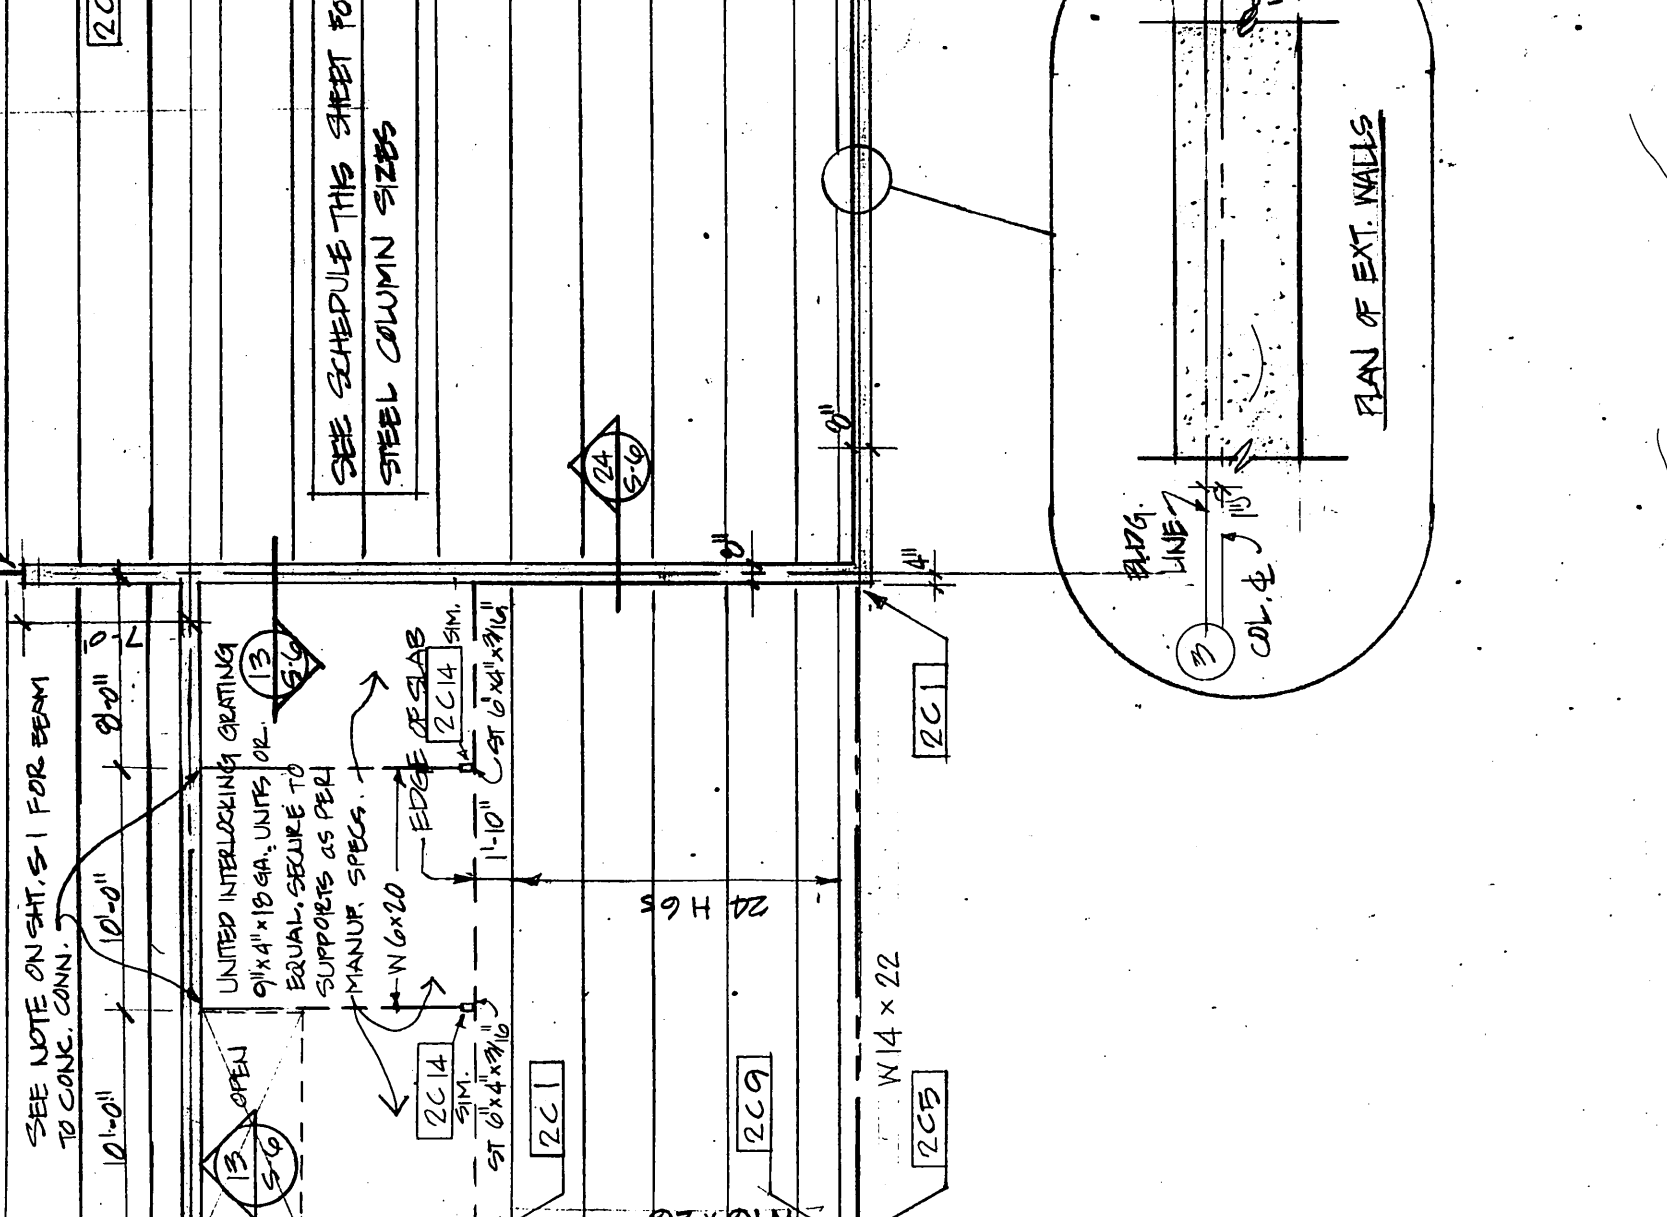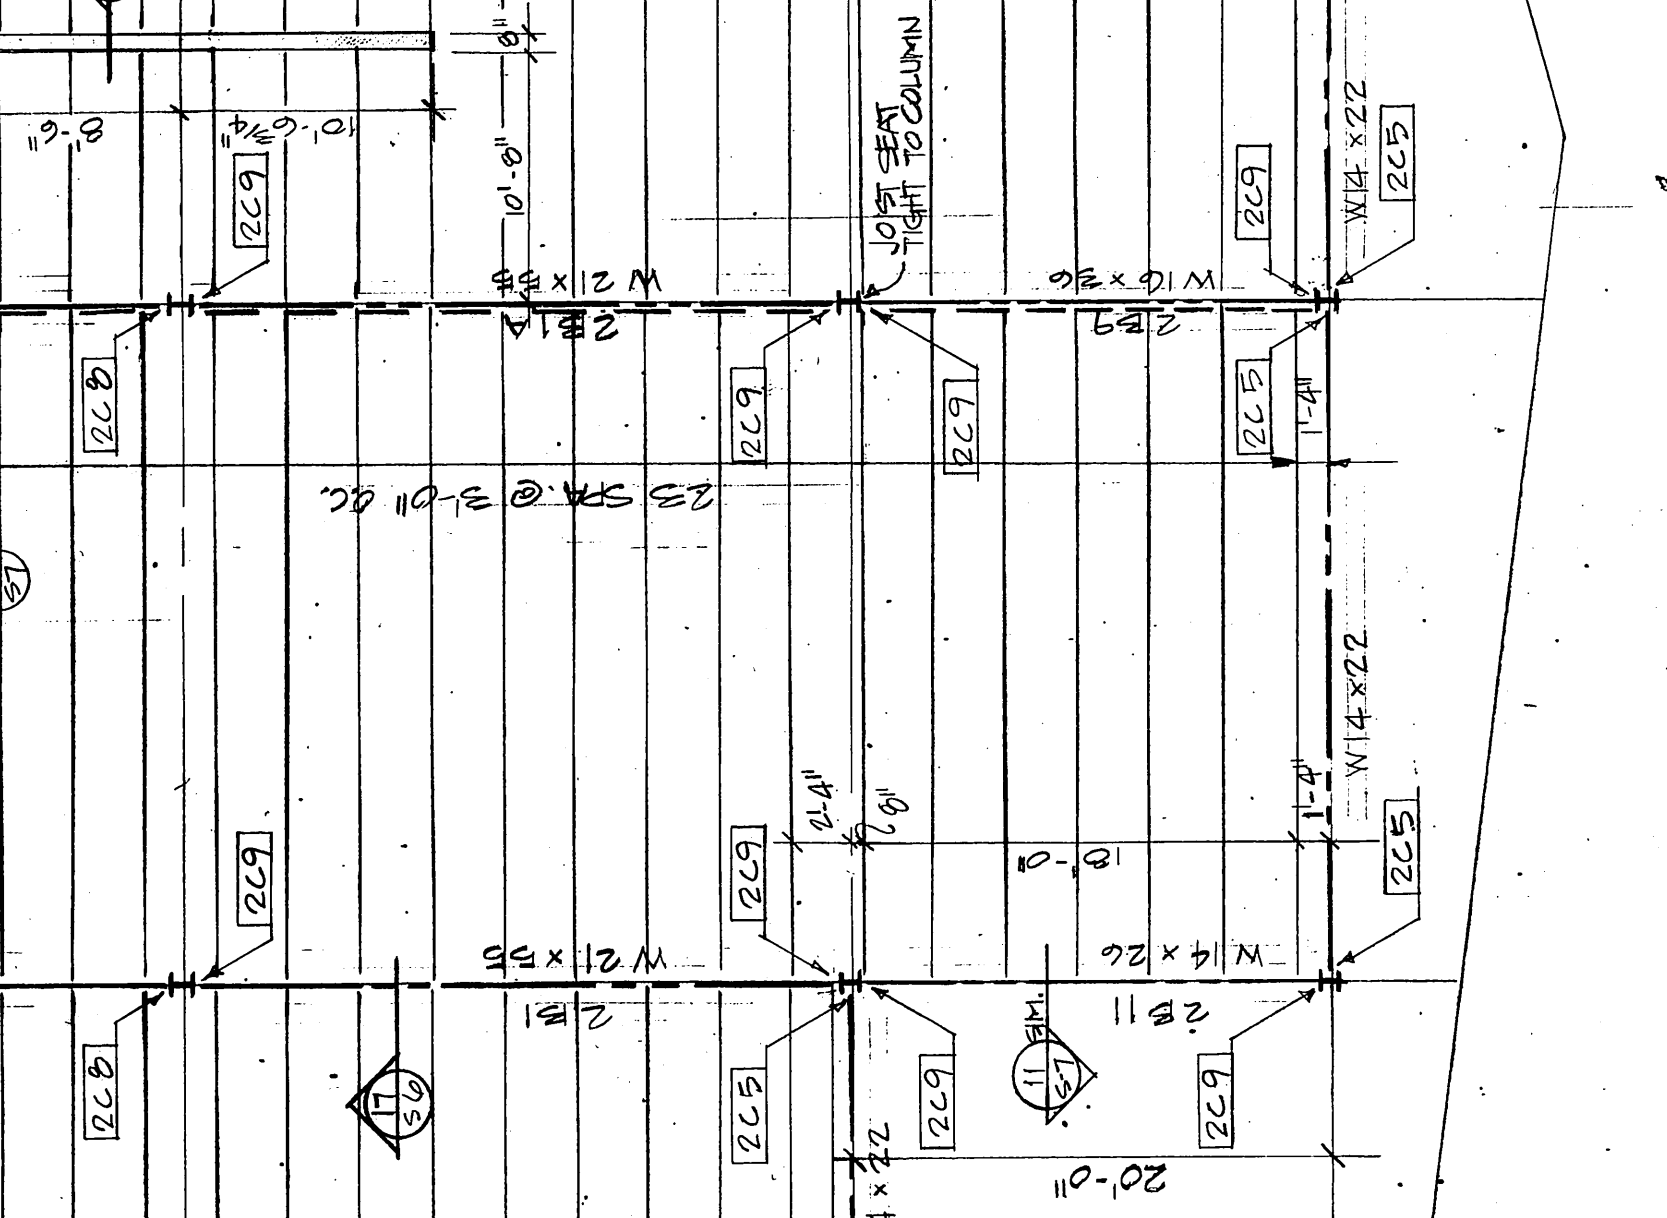

JOB NO.: 7305-131

GRAY ROGERS & TYERS INC.

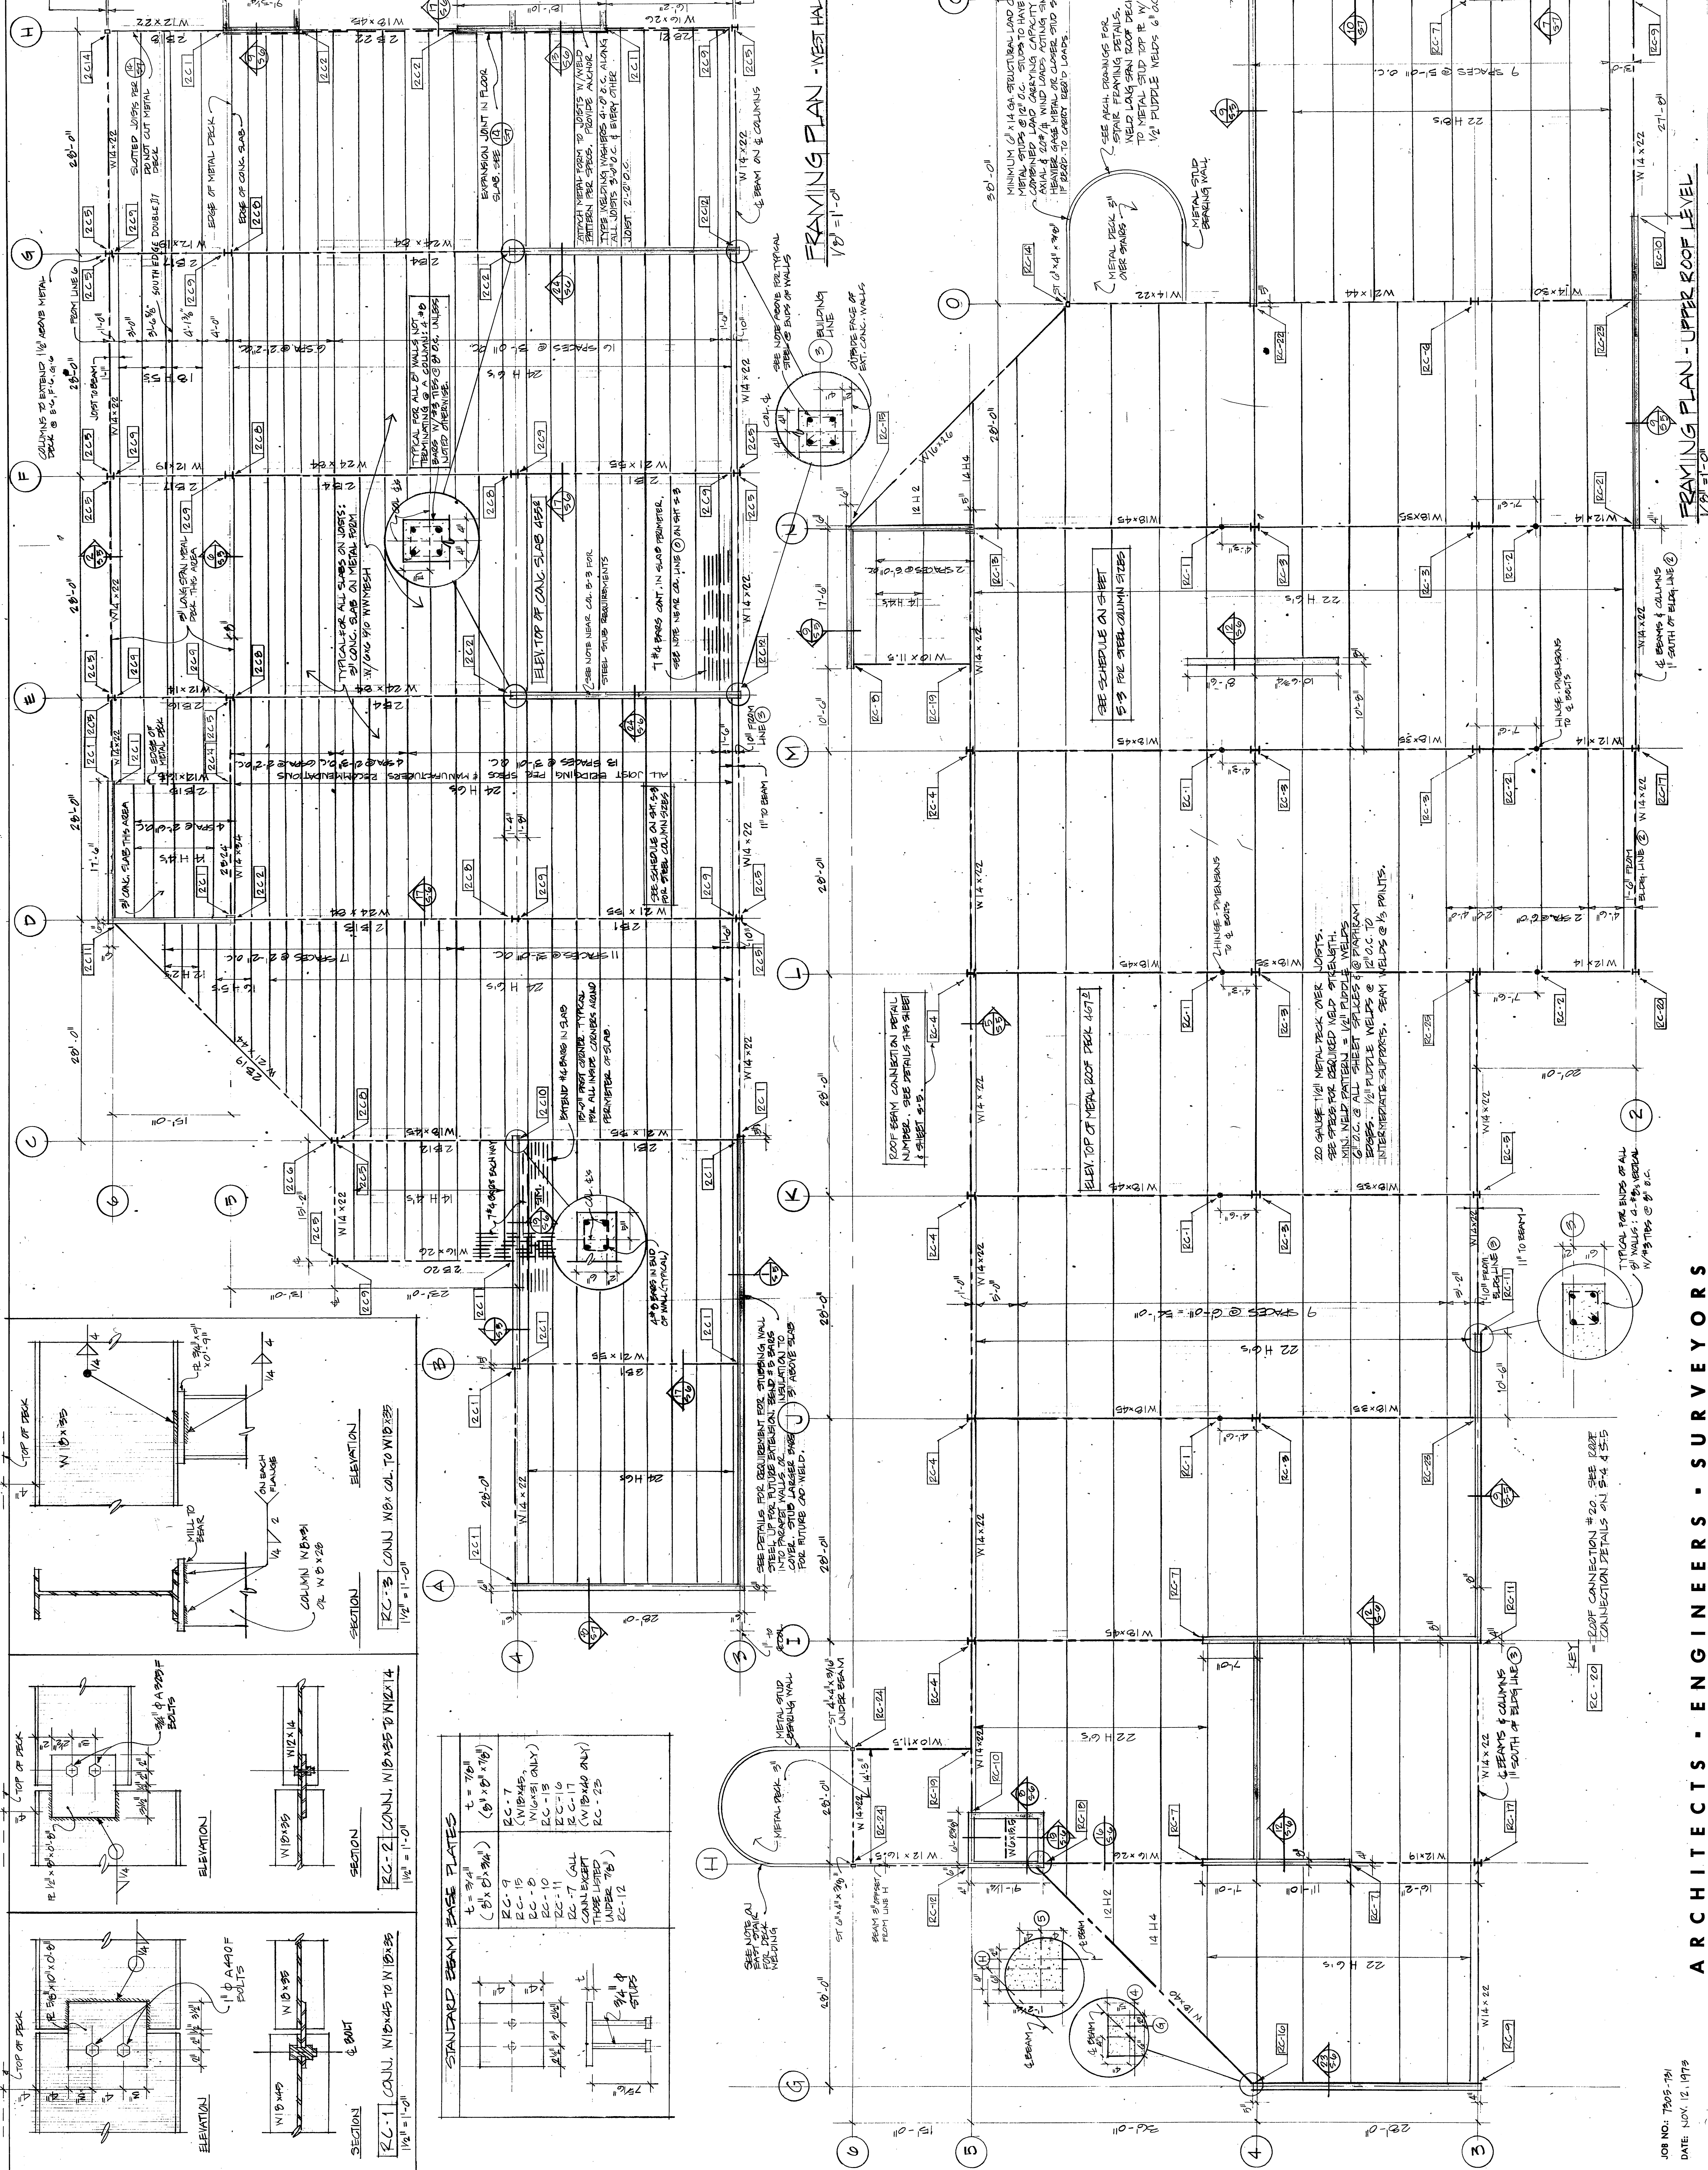

ARCHITECTS - ENGINEERS - SURVEYORS
601 COLLEGE ROAD, FAIRBANKS, ALASKA 99701, PHONE: 452-1241

STATE OF ALASKA
DIVISION OF PUBLIC WORKS
DIVISION OF BUILDINGS

FAIRBANKS REGIONAL
OFFICE BUILDING
PHASE TWO

AS BUILT'S
PRODUCED IN ACCORDANCE WITH THE REQUIREMENTS OF THE ALASKA BUILDING CODE, AS AMENDED, AND THE REQUIREMENTS OF THE STATE OF ALASKA.

DATE: NOV. 12, 1975

AS BUILT'S
PRODUCED IN ACCORDANCE WITH THE REQUIREMENTS OF THE ALASKA BUILDING CODE, AS AMENDED, AND THE REQUIREMENTS OF THE STATE OF ALASKA.





















































































DATE: NOV. 12, 1975

ARCHITECTS - ENGINEERS - SURVEYORS
601 COLLEGE ROAD, FAIRBANKS, ALASKA 99701, PHONE: 452-1241

STATE OF ALASKA
DIVISION OF PUBLIC WORKS
DIVISION OF BUILDINGS

FAIRBANKS REGIONAL
OFFICE BUILDING
PHASE TWO

S-4
SHEET NO.: OF 61

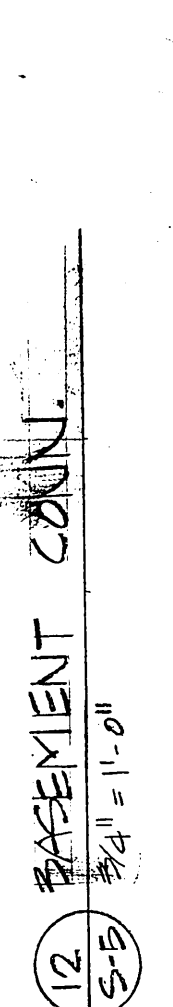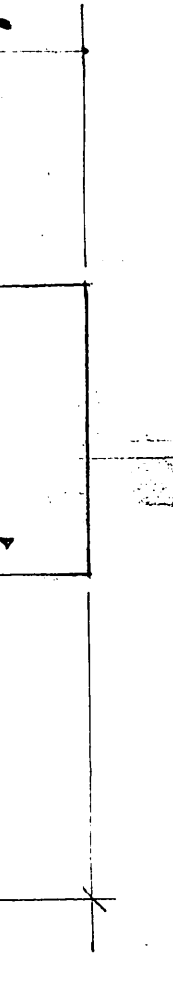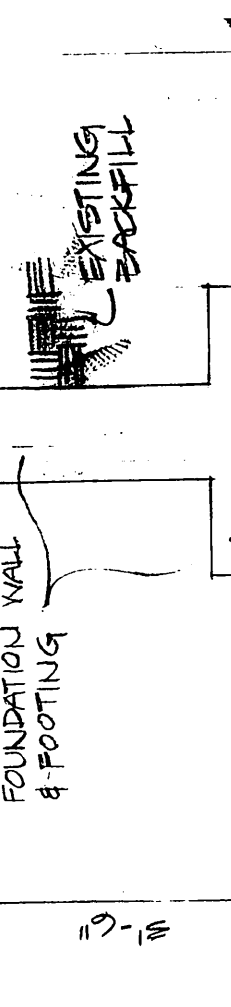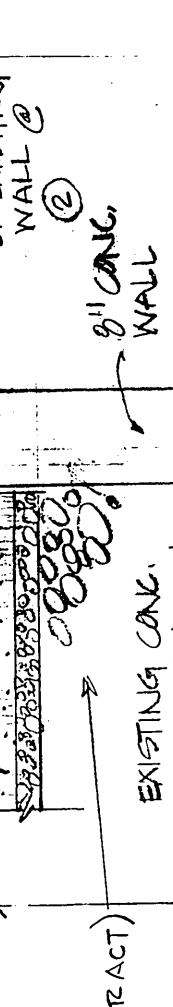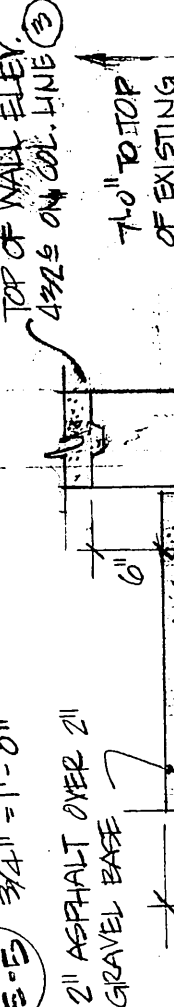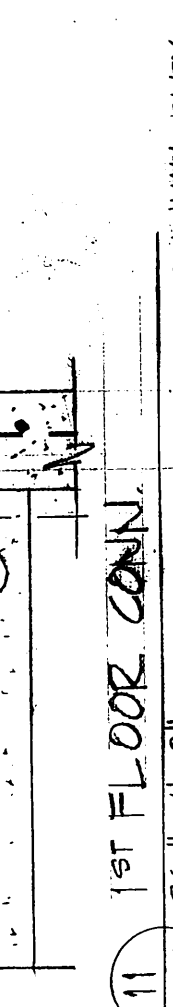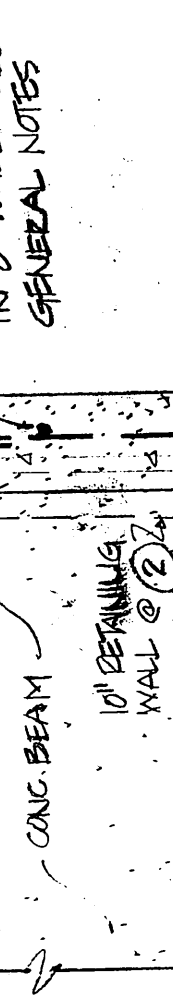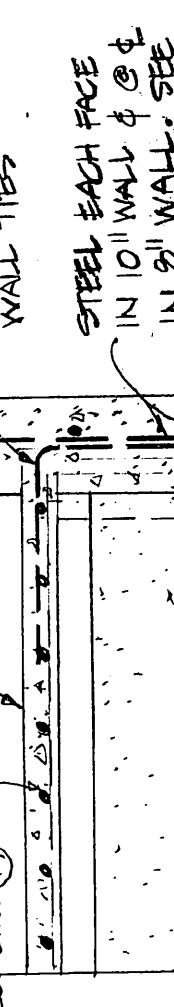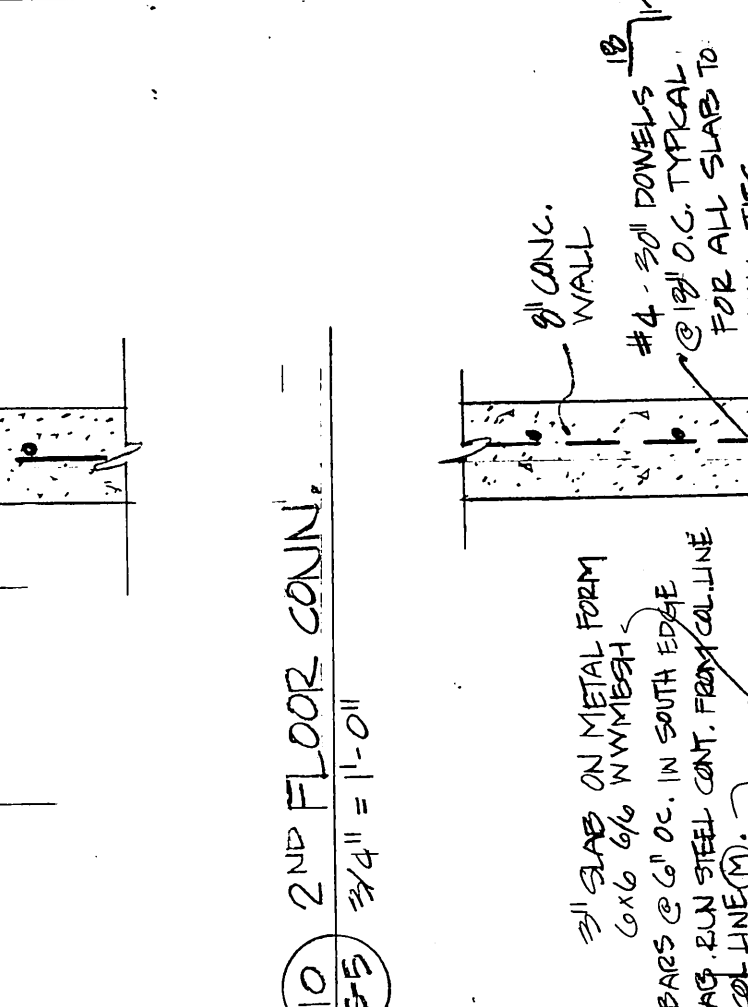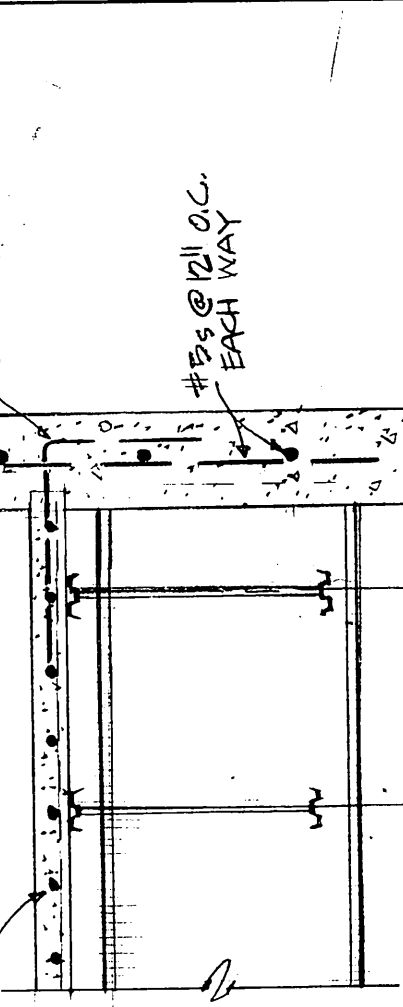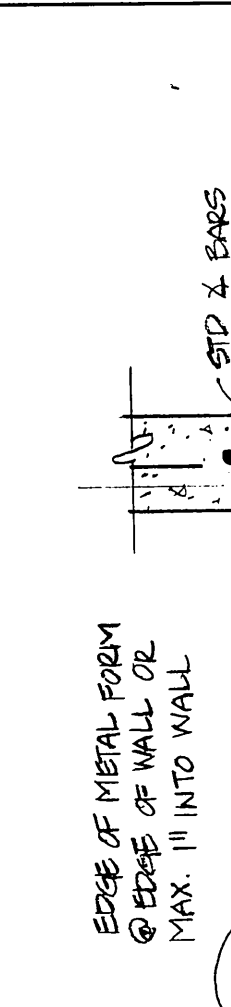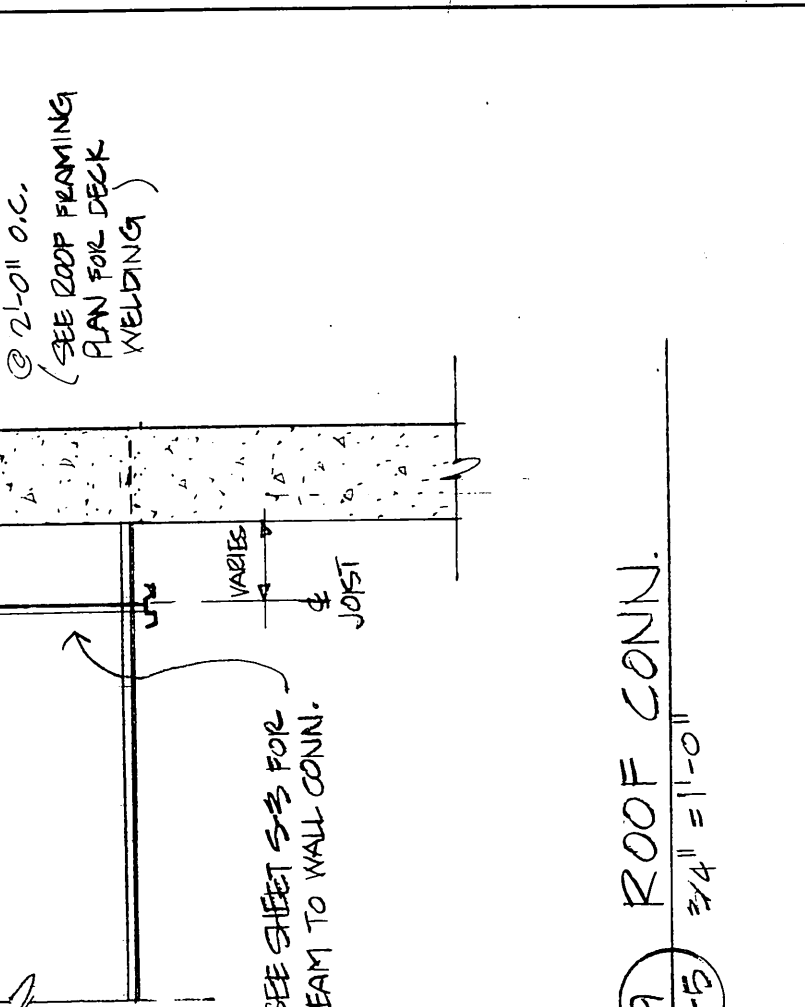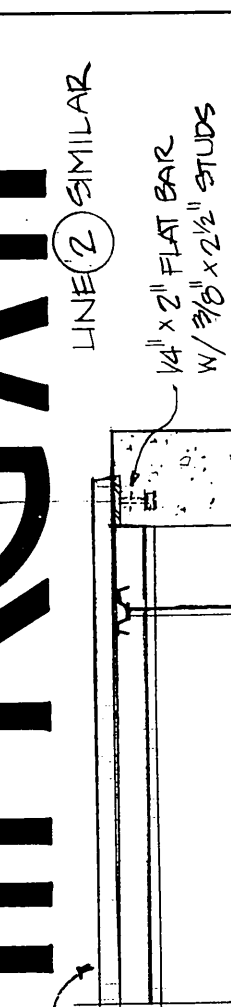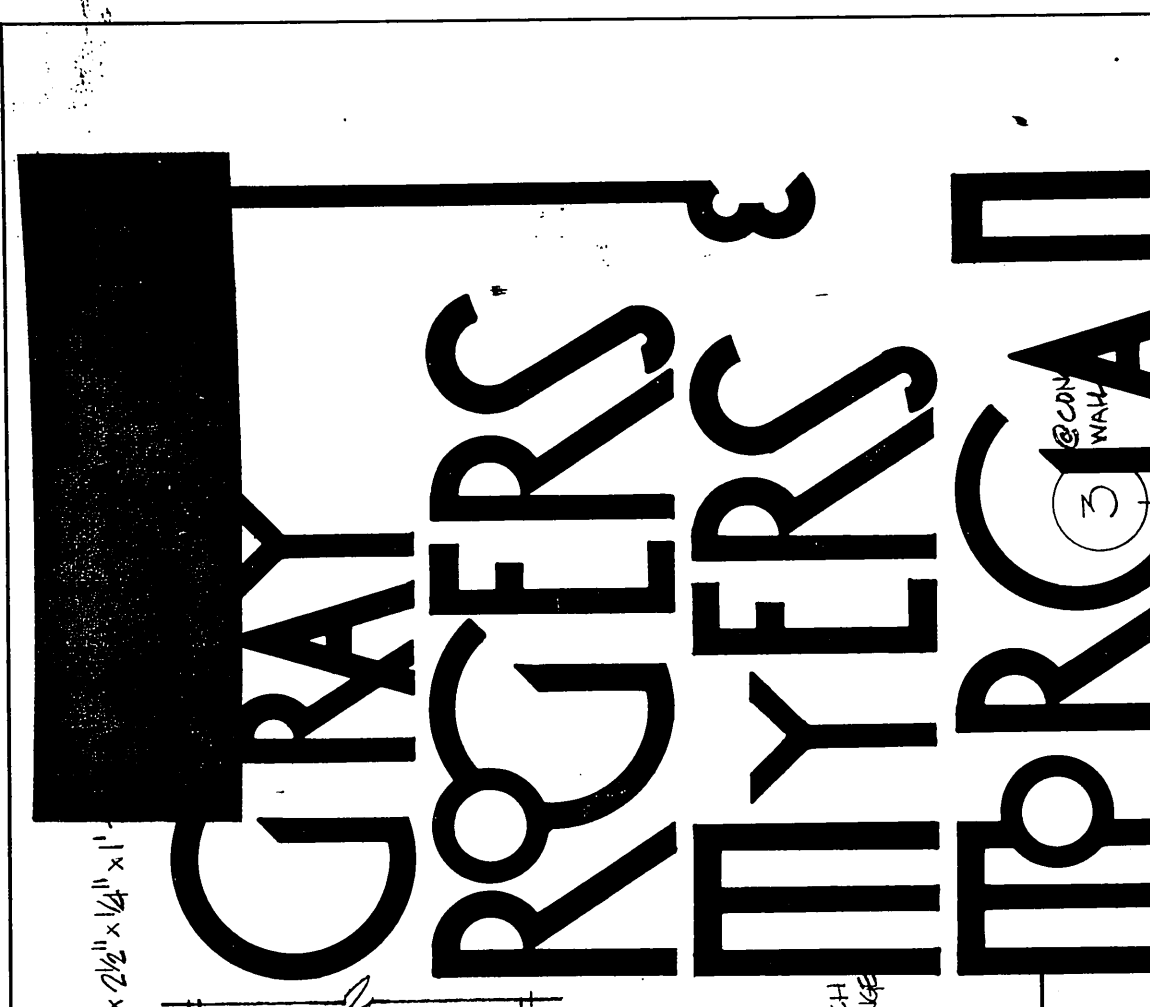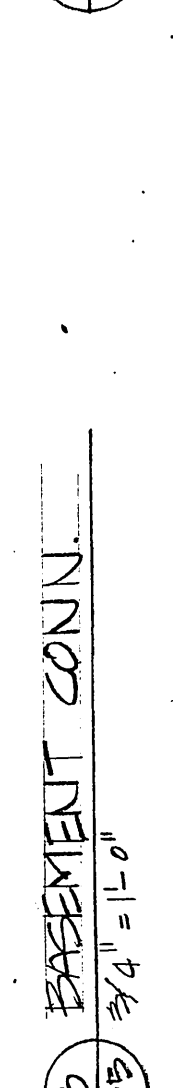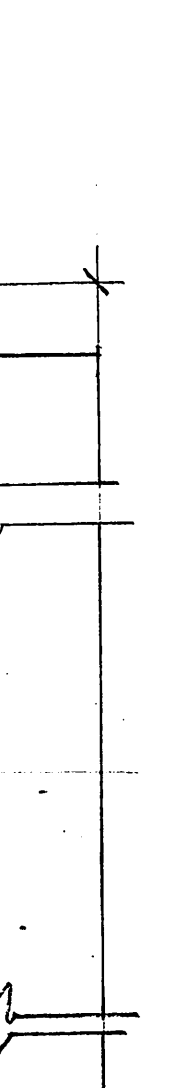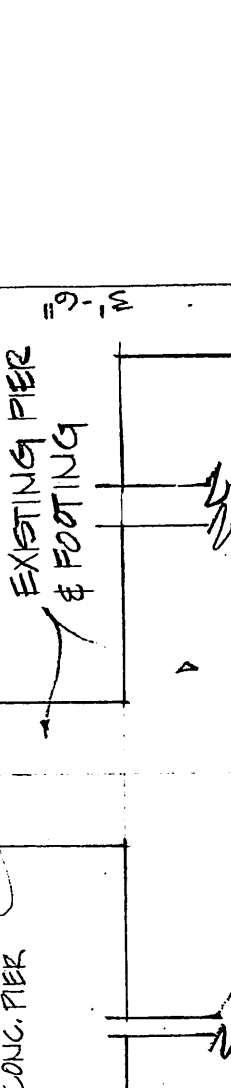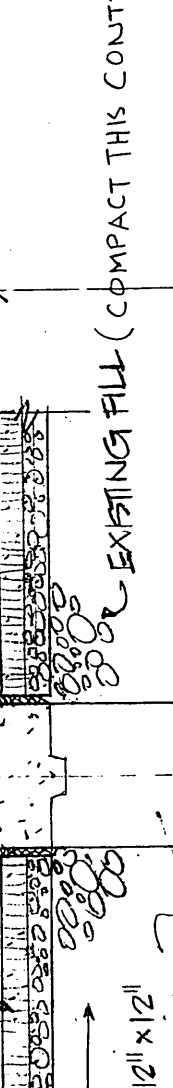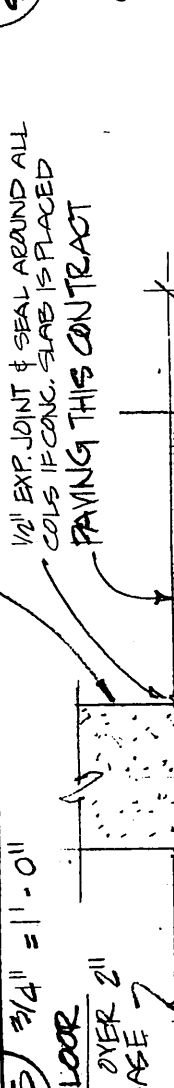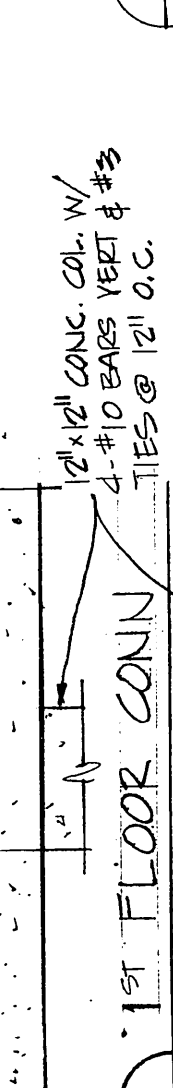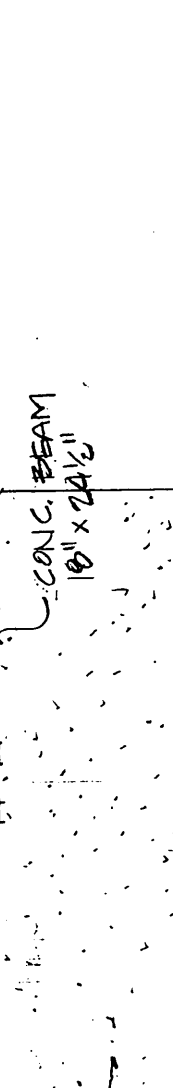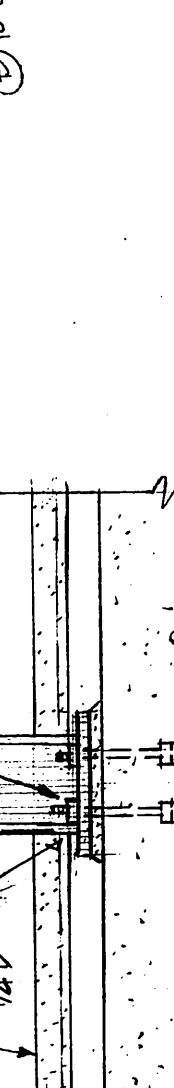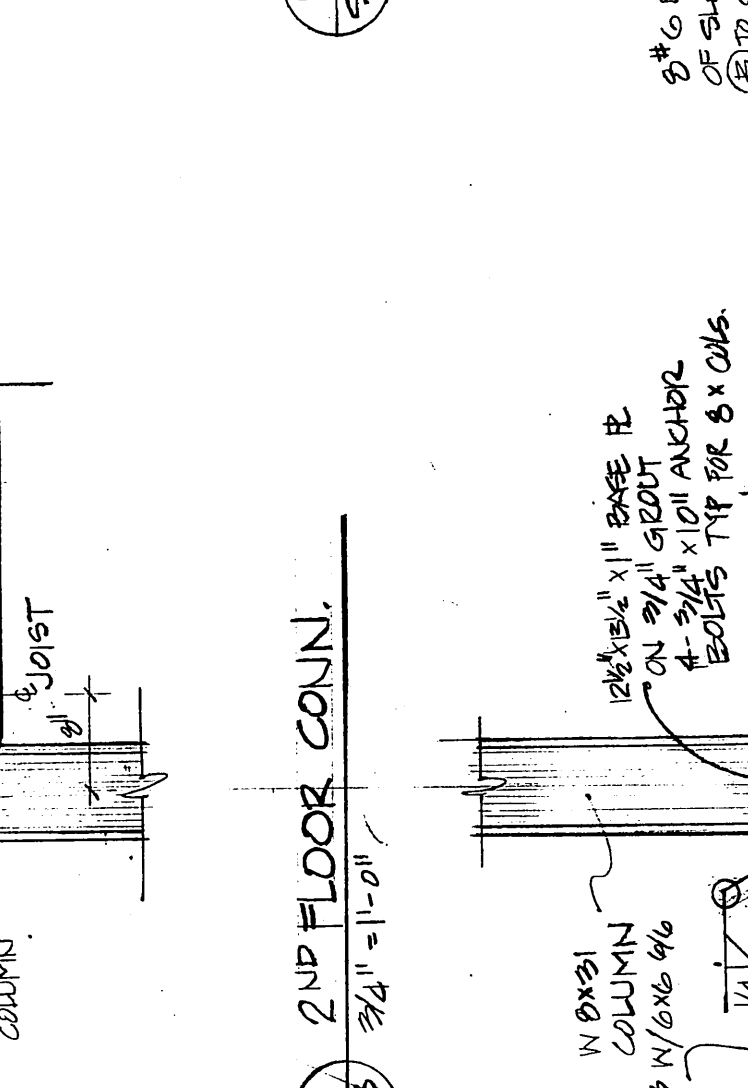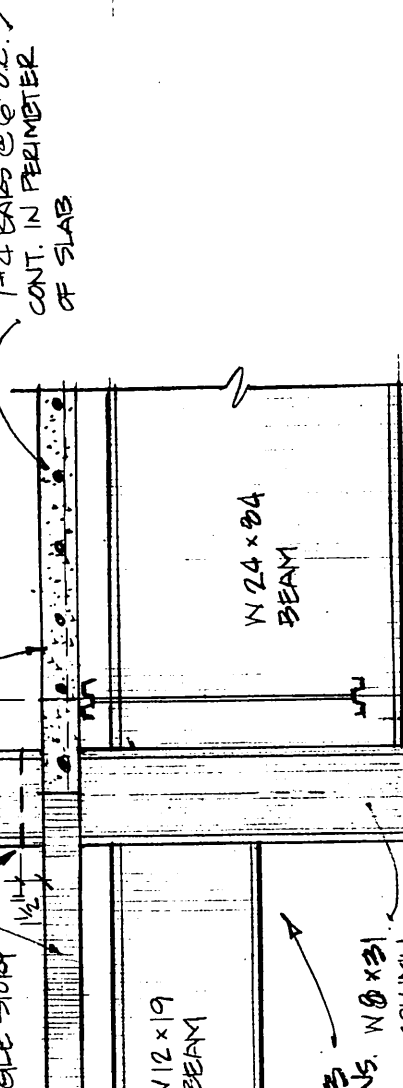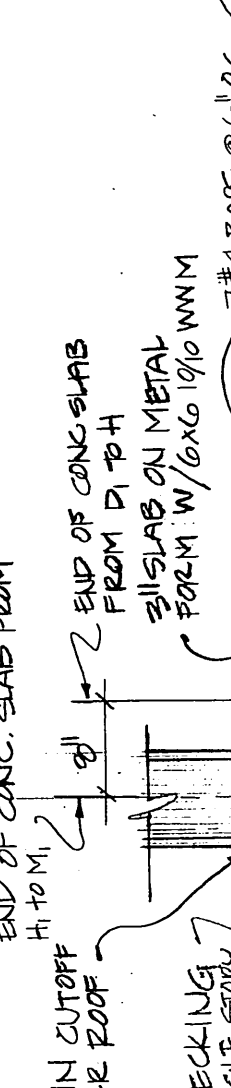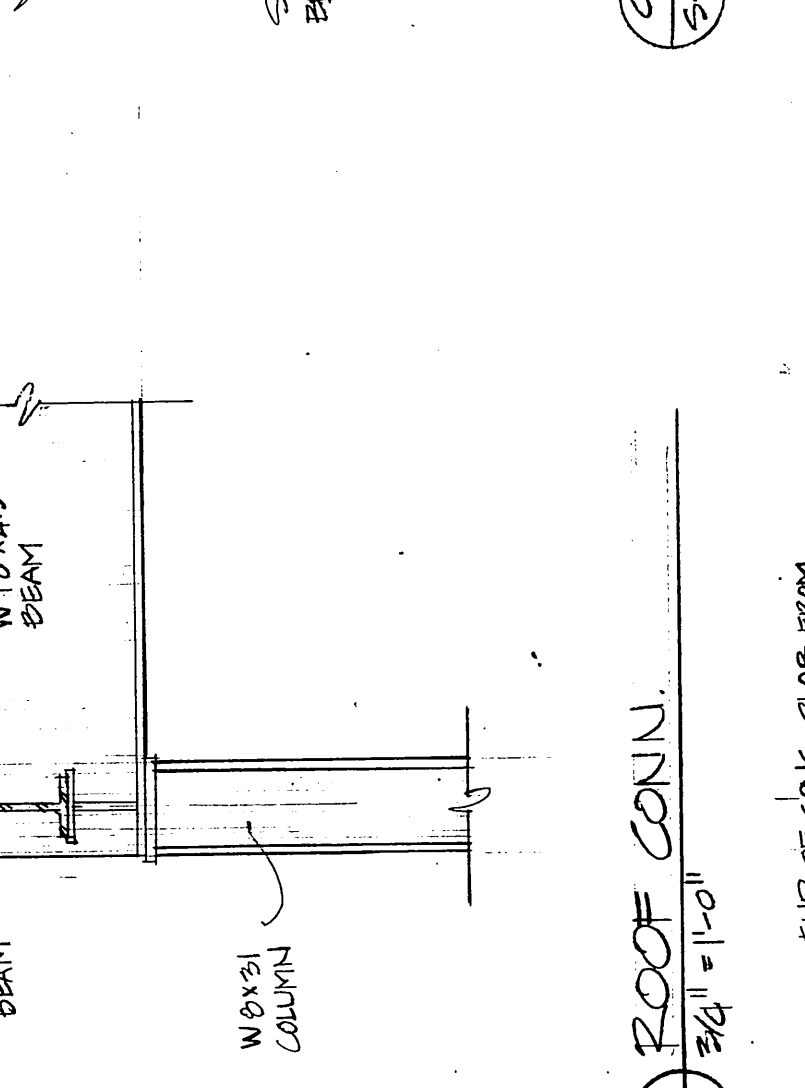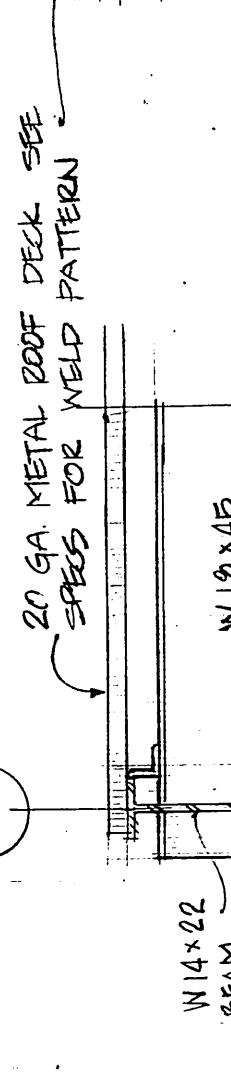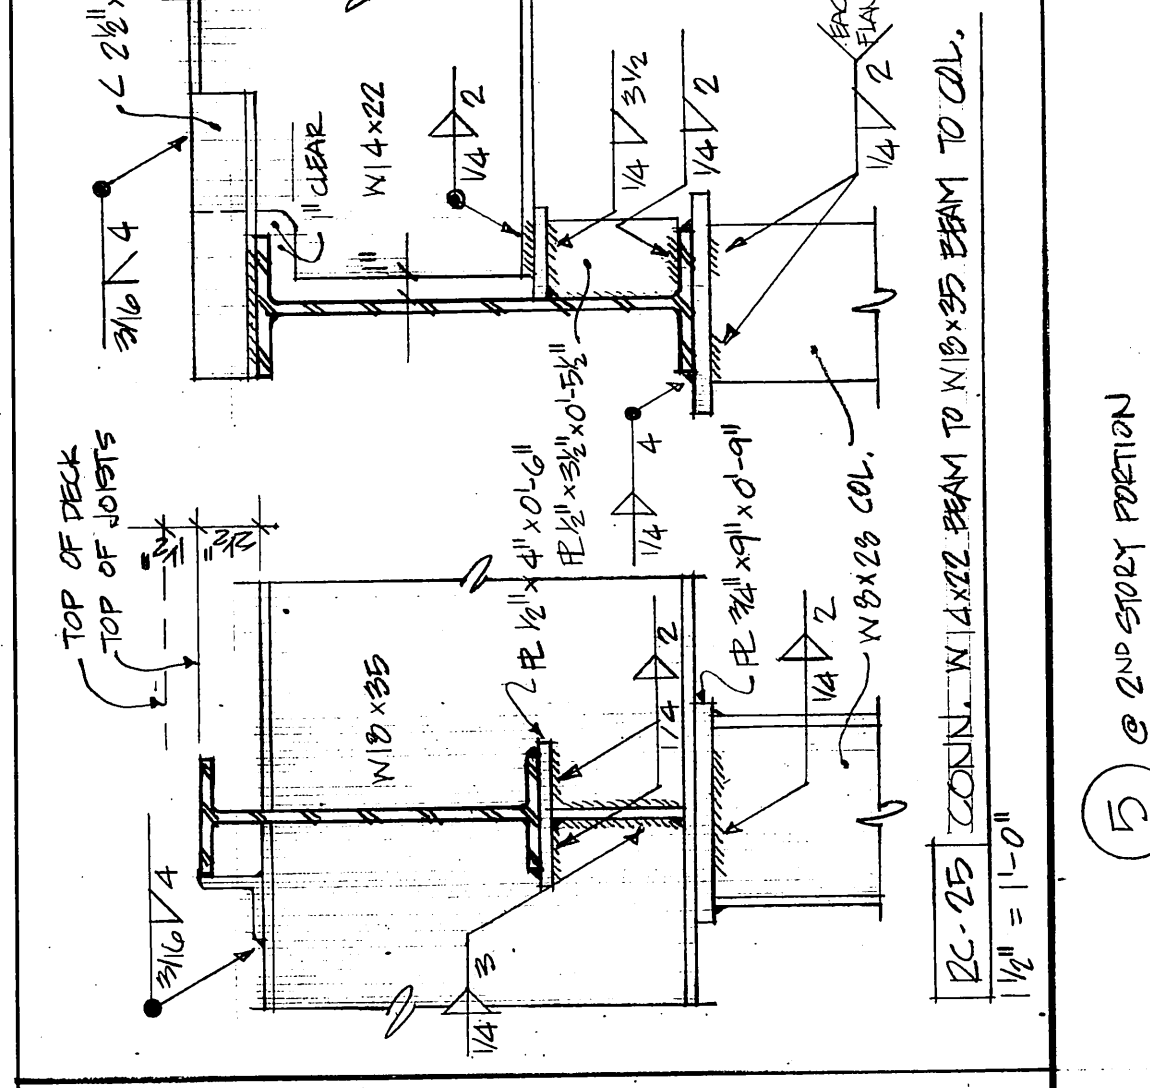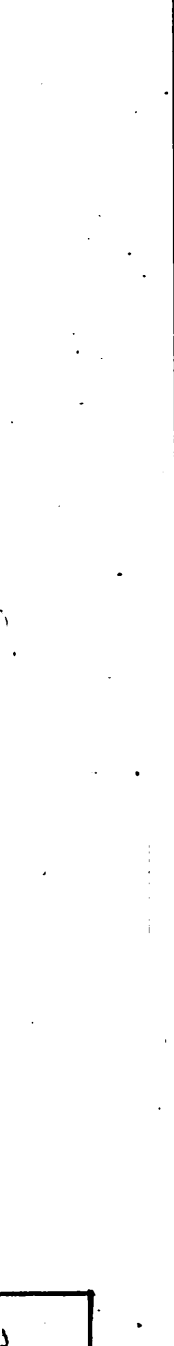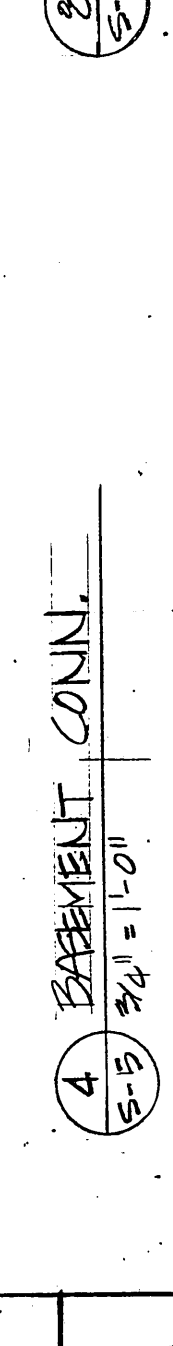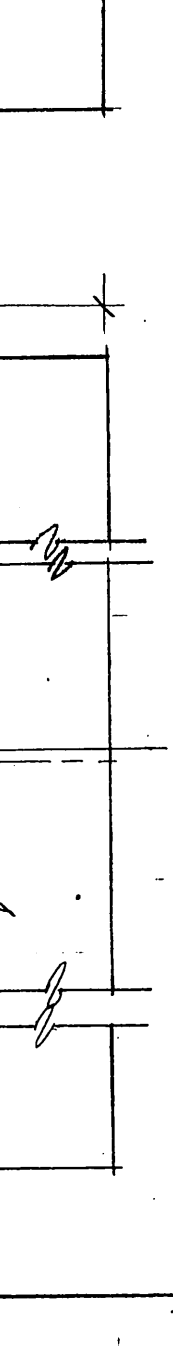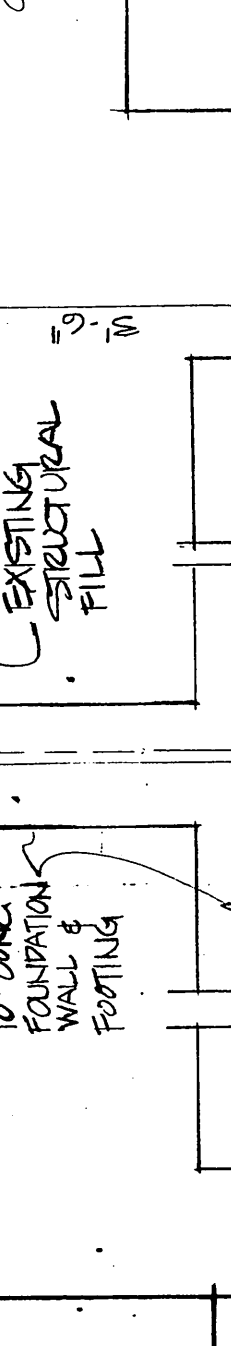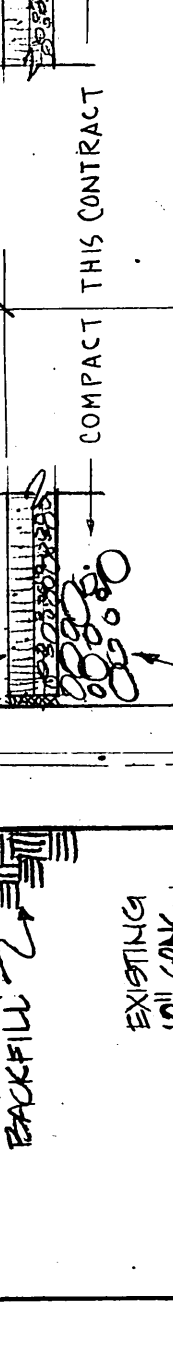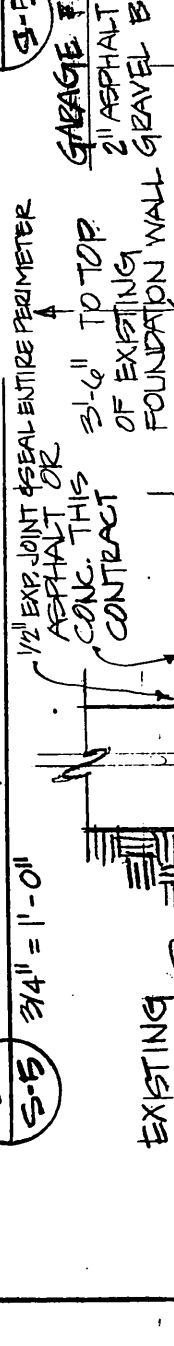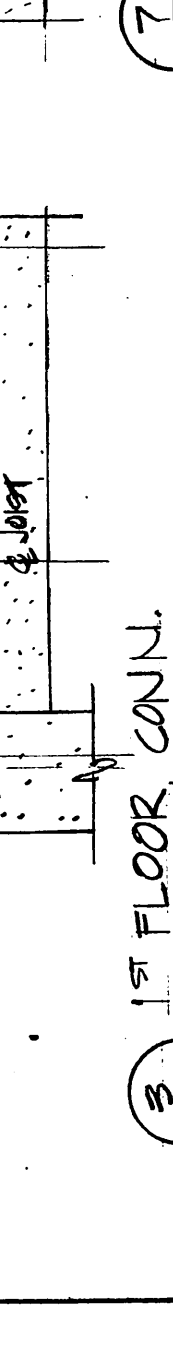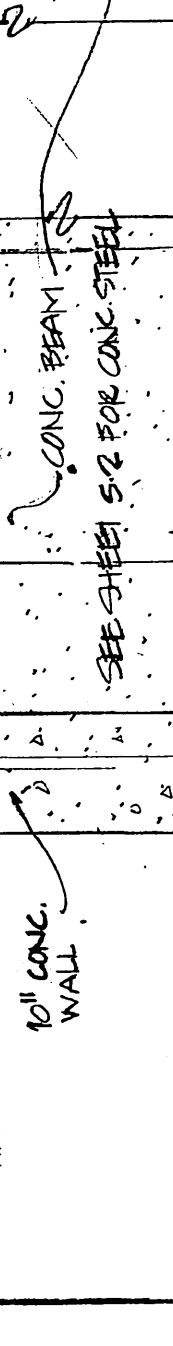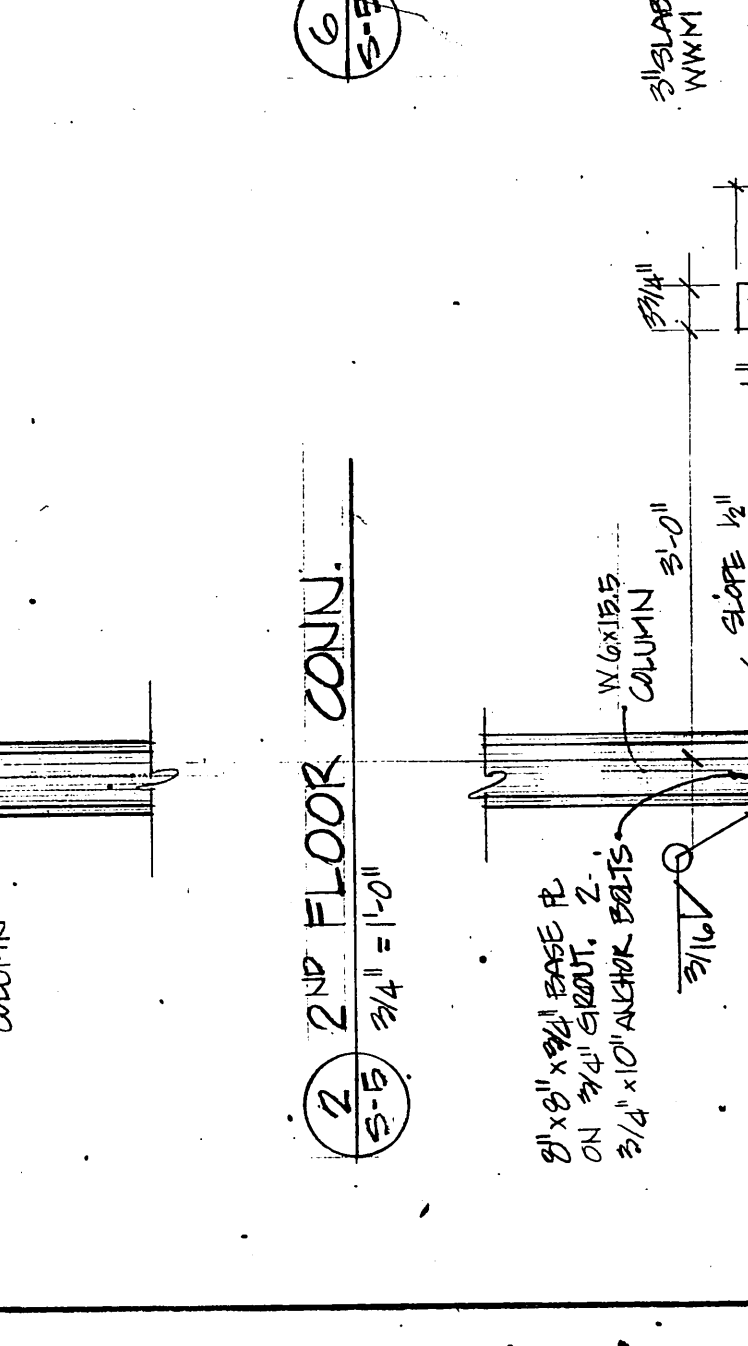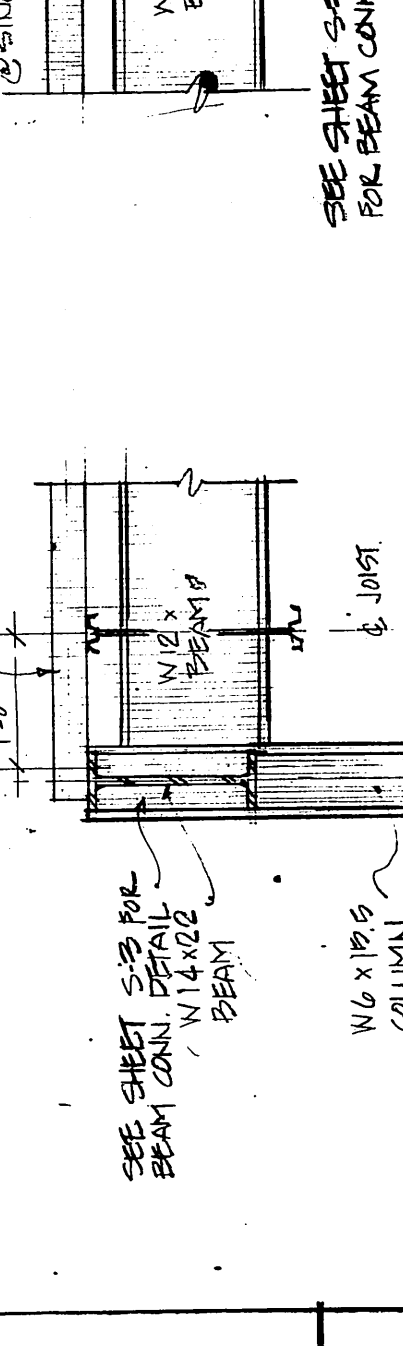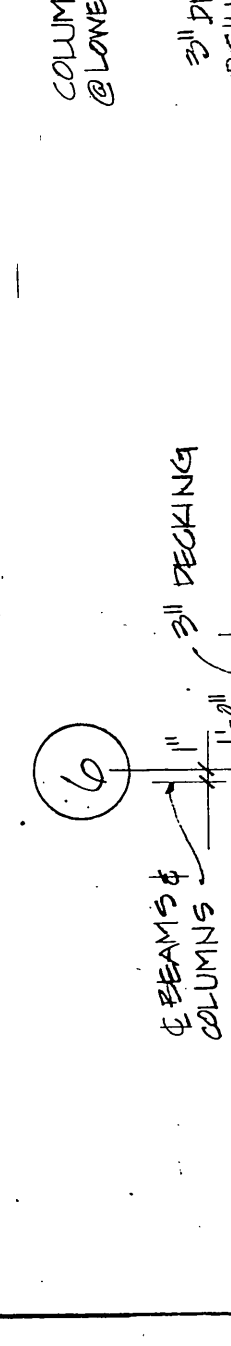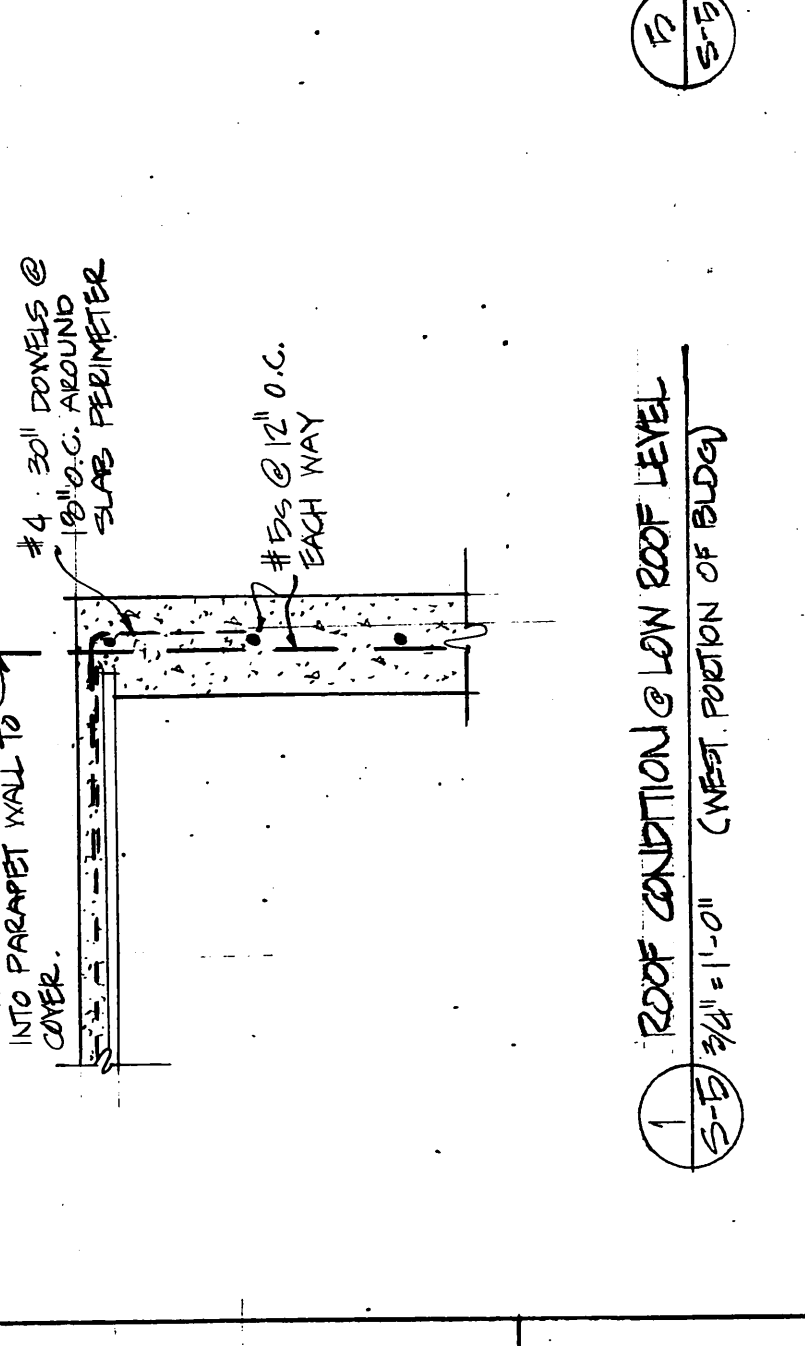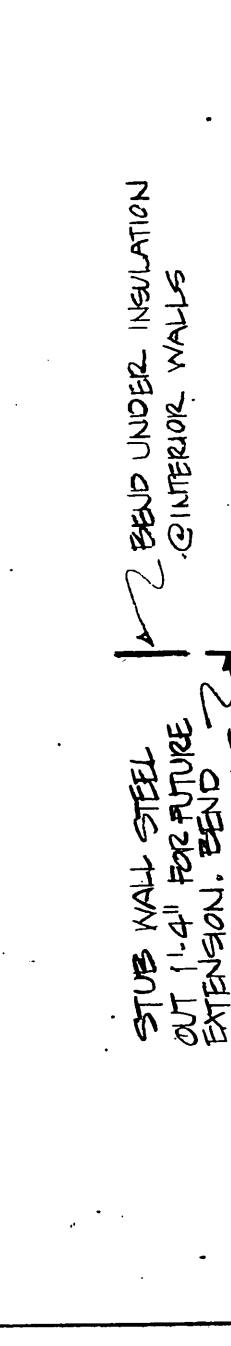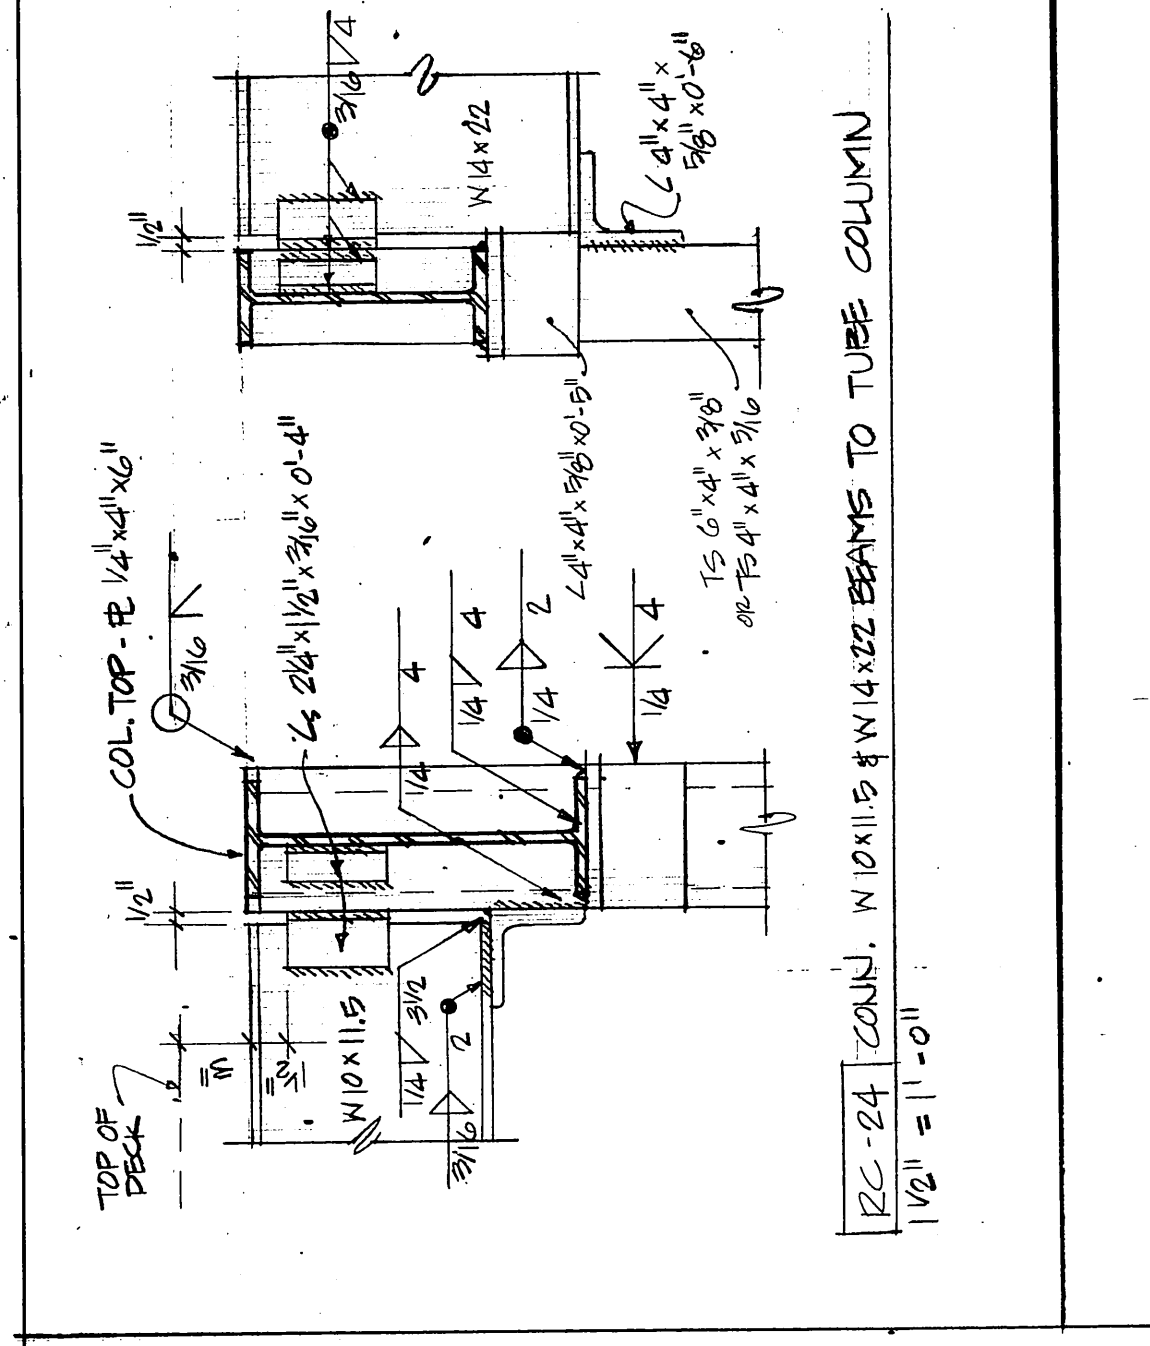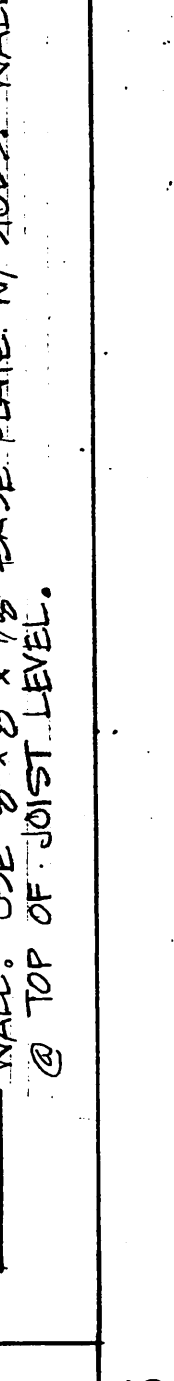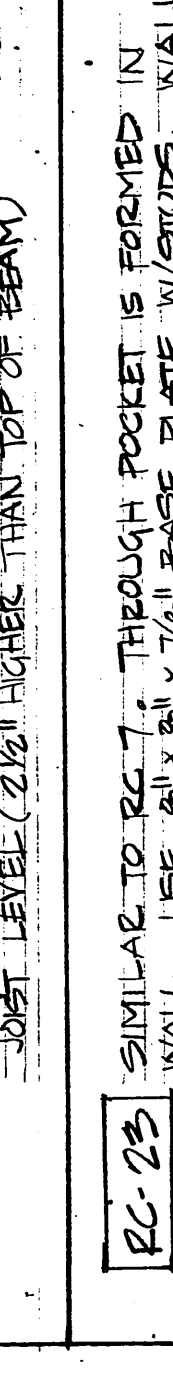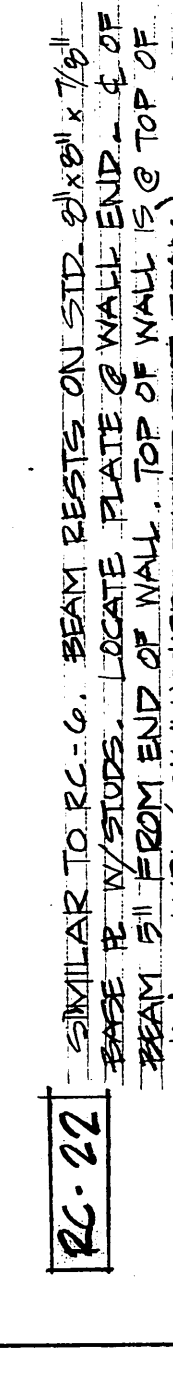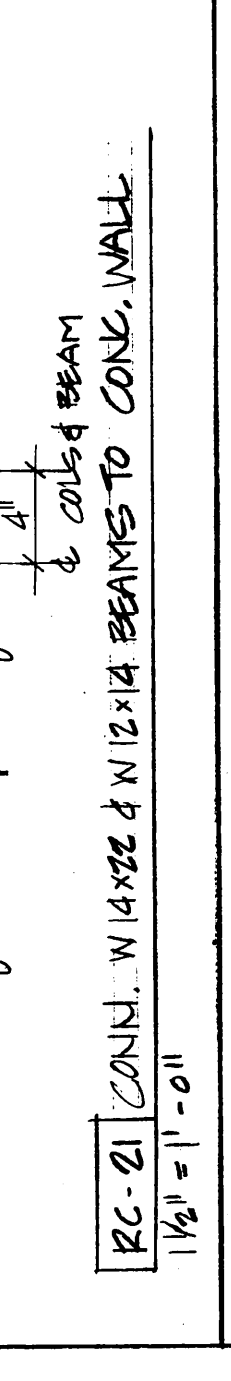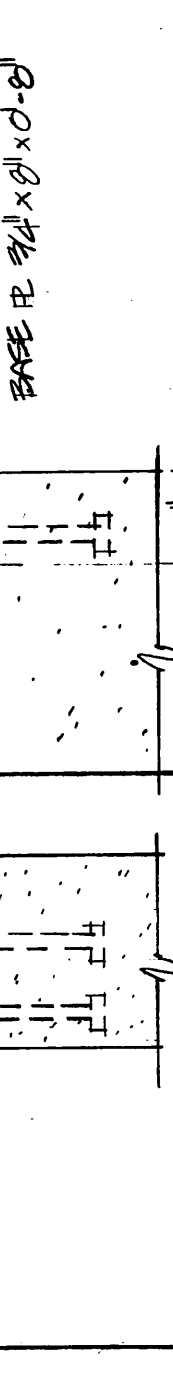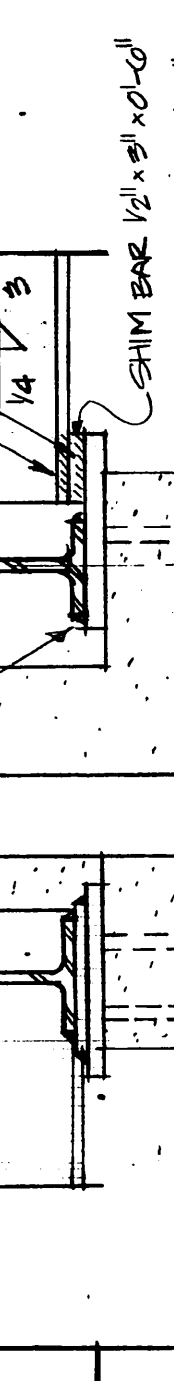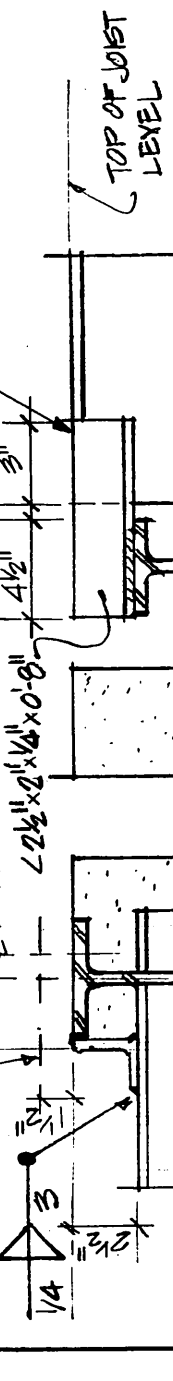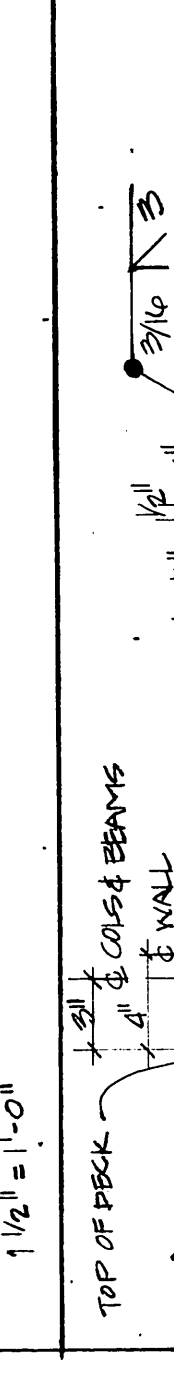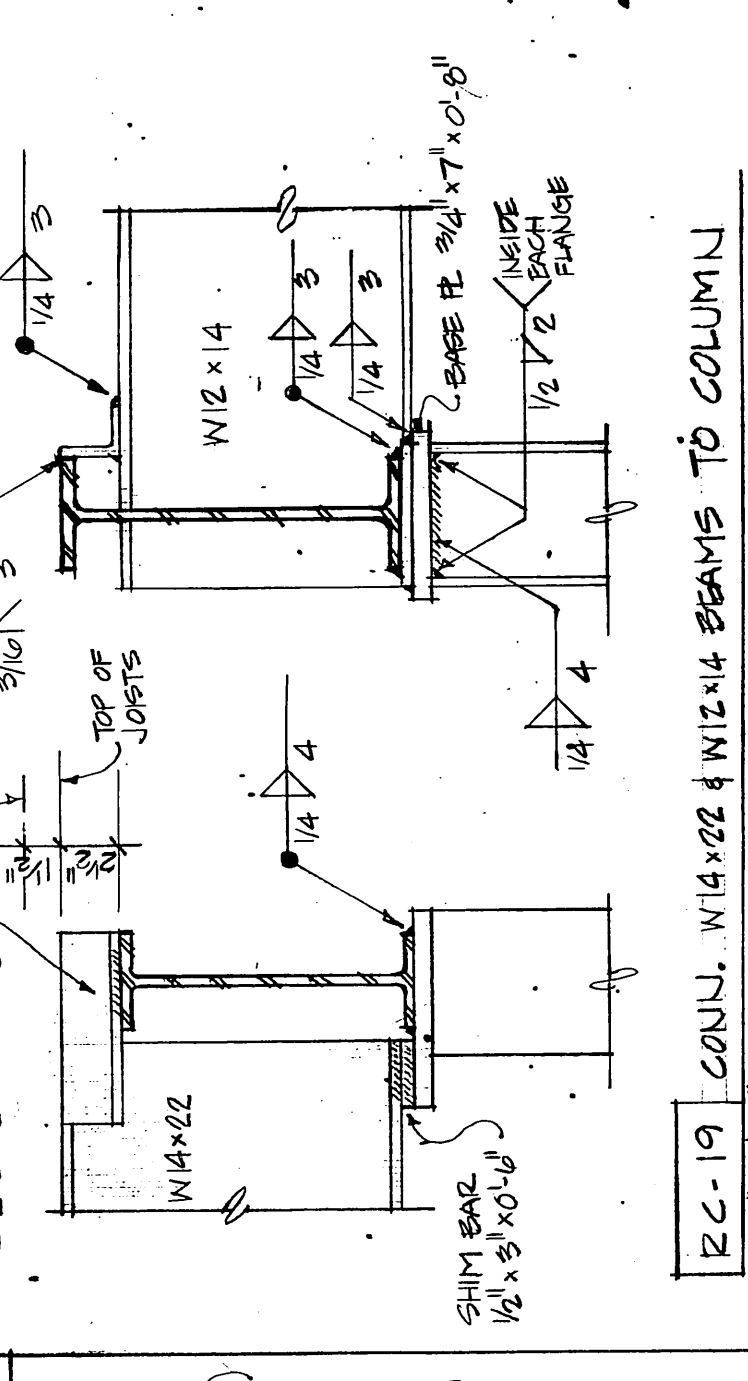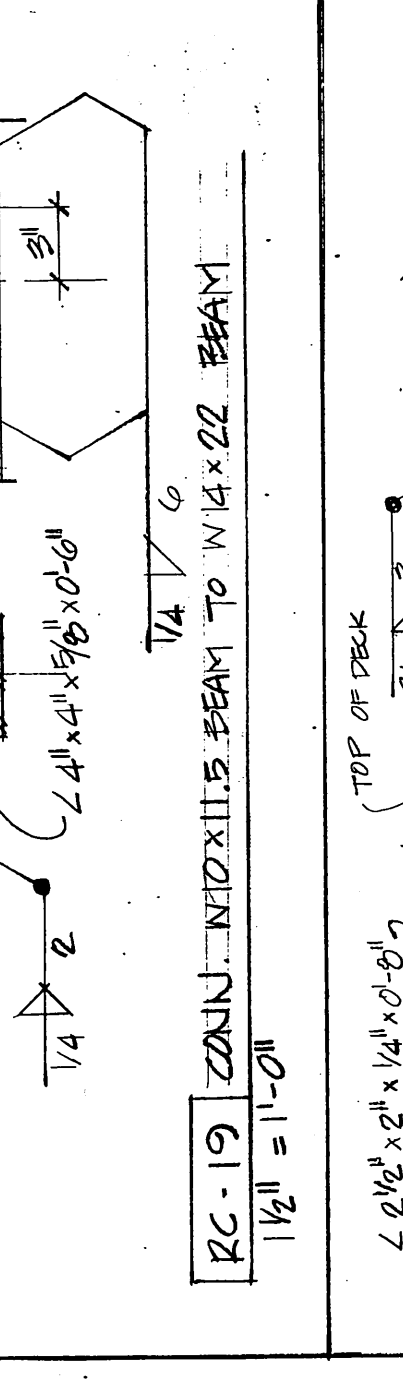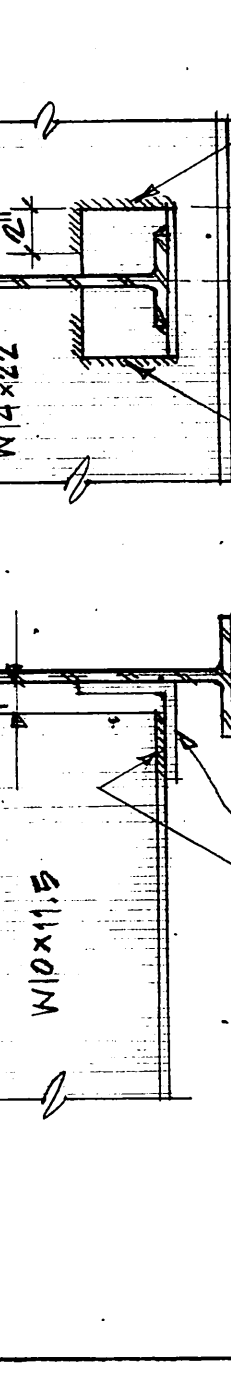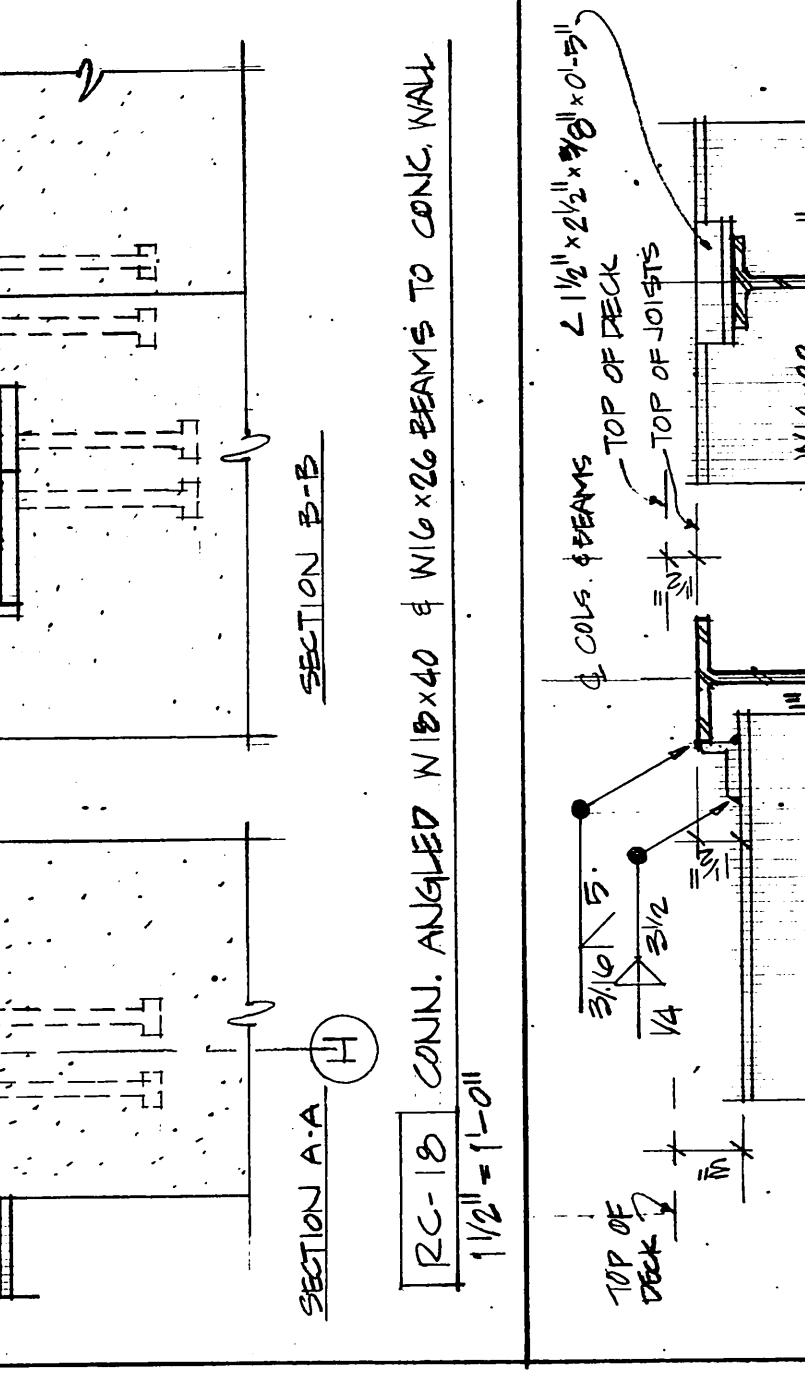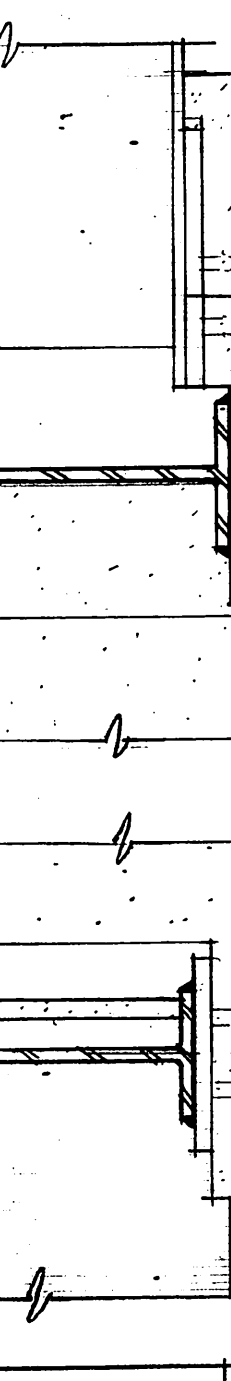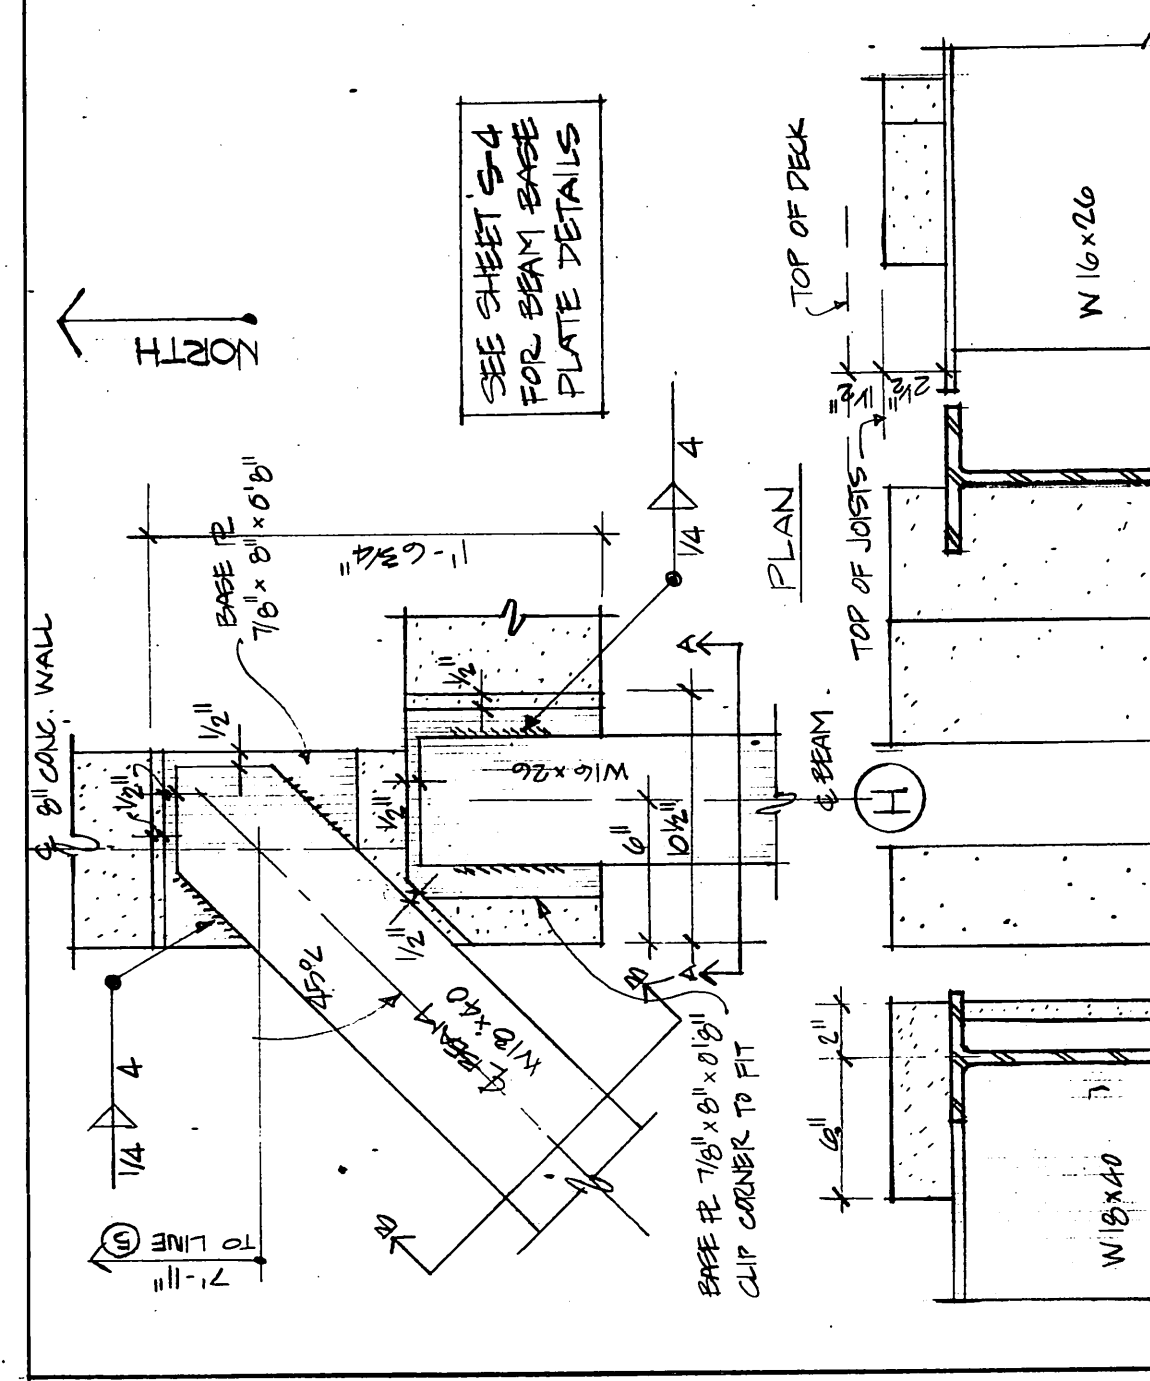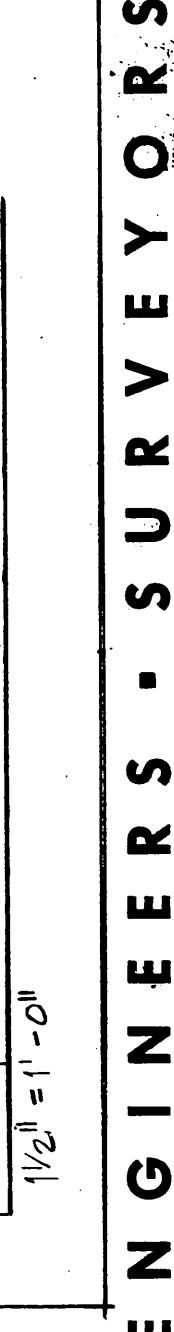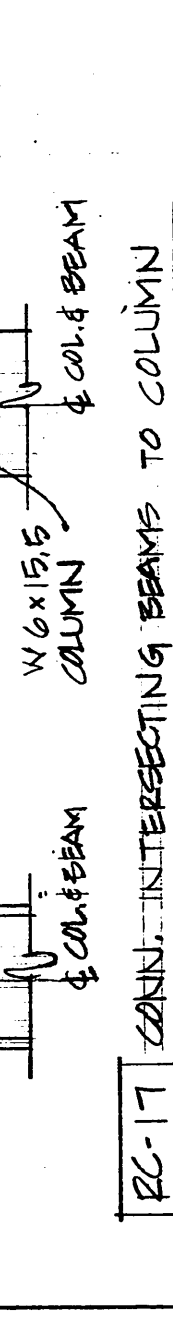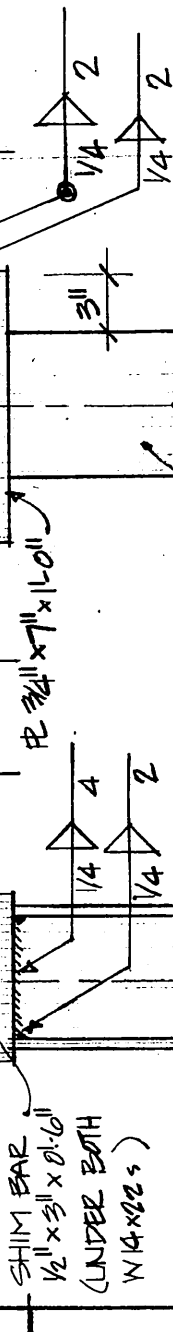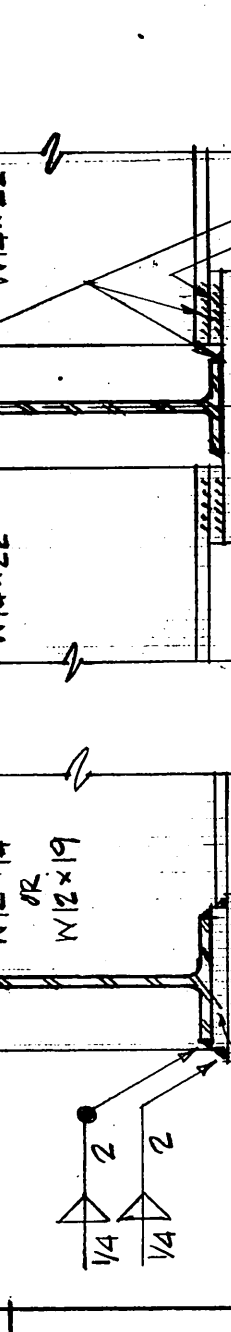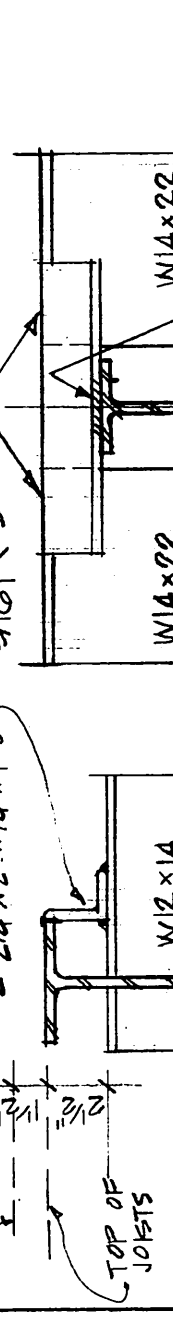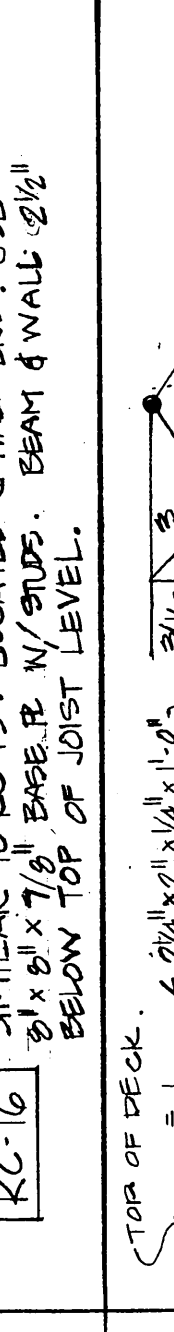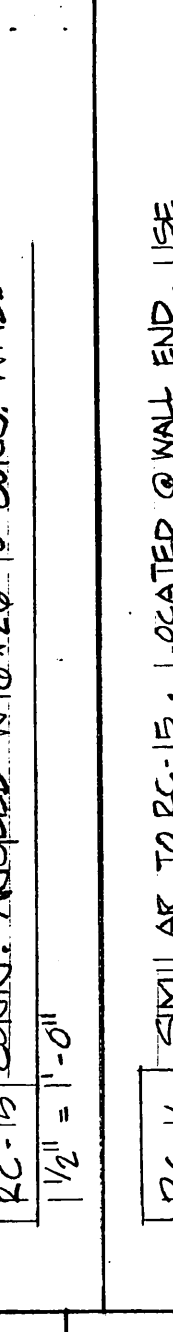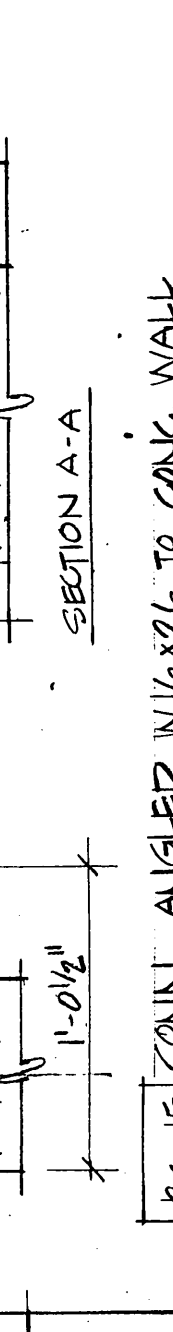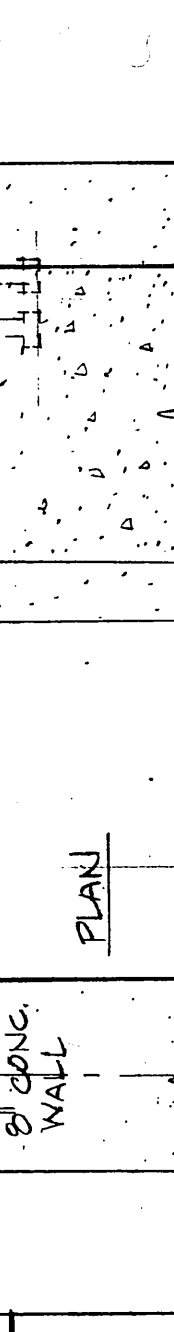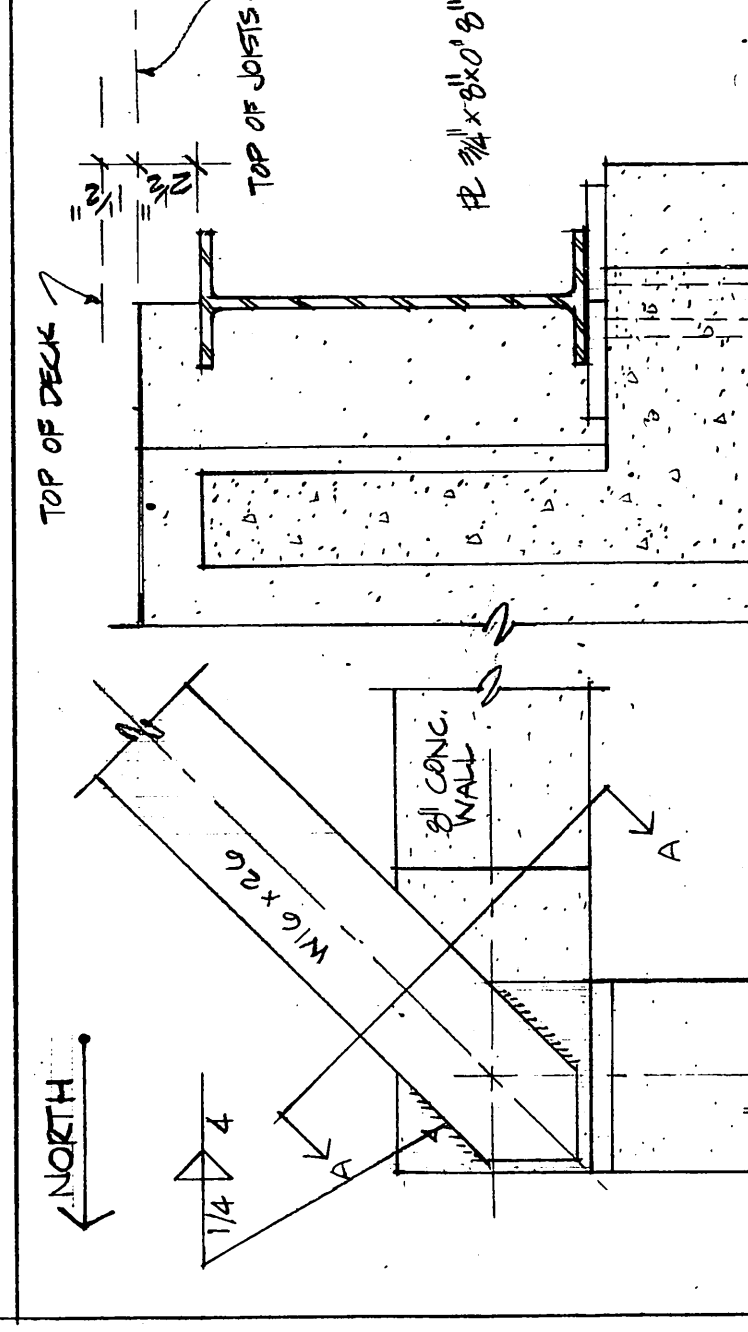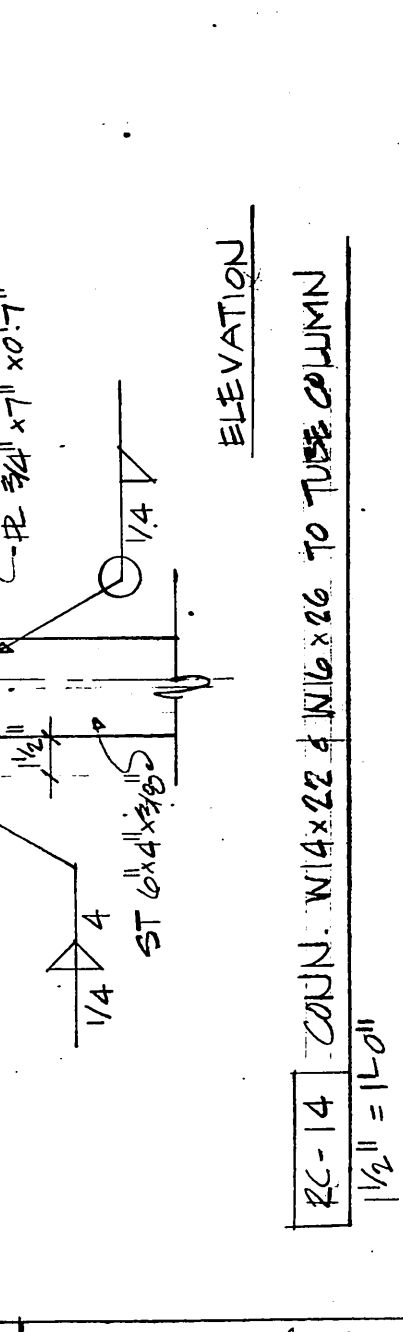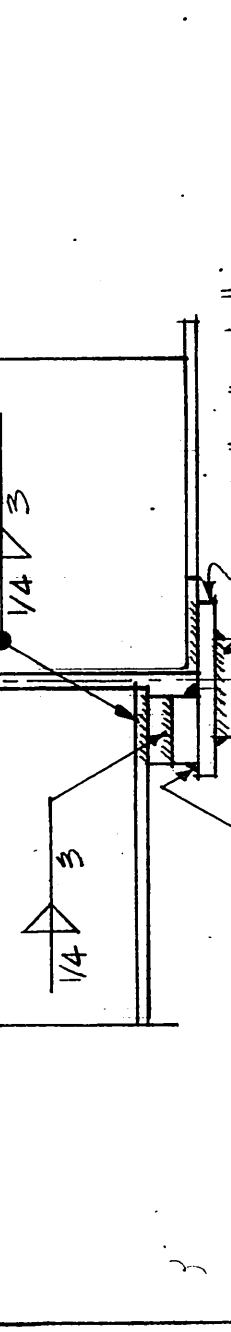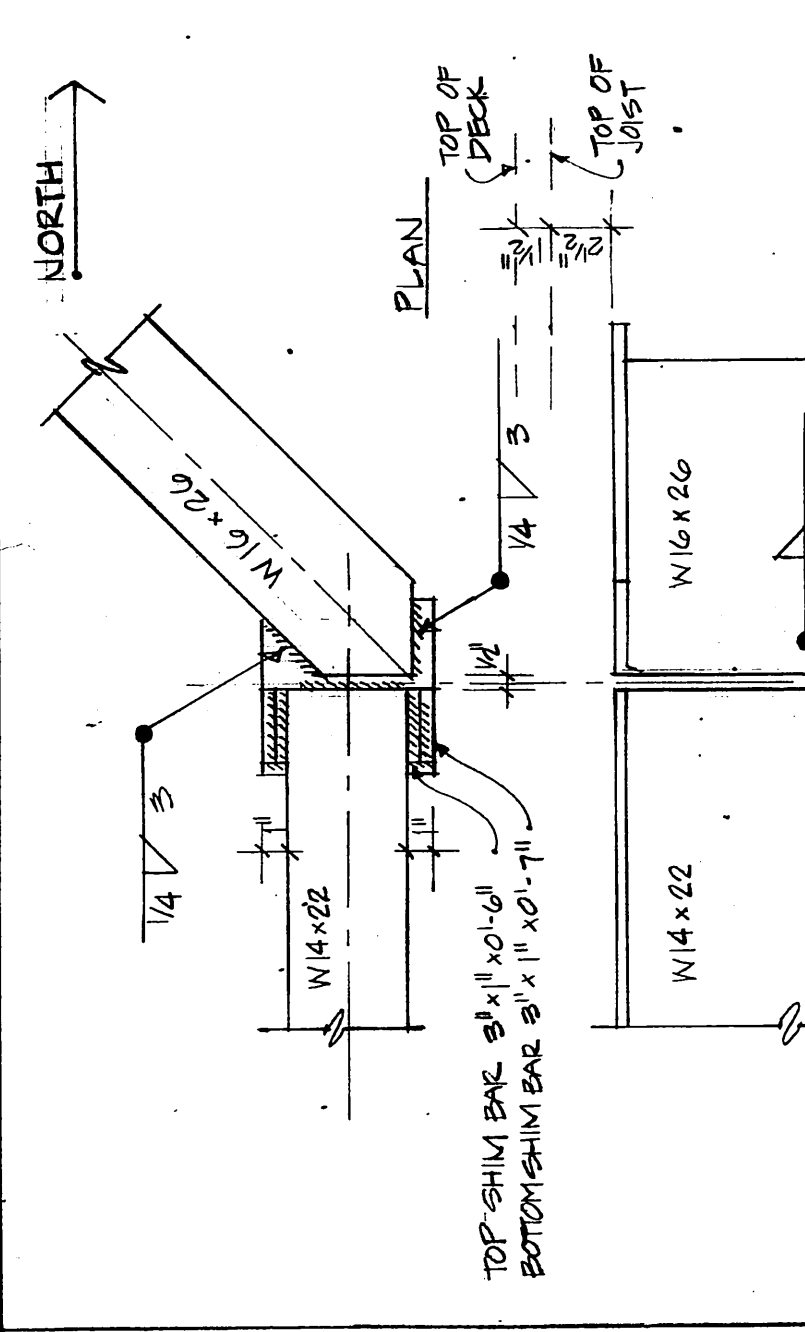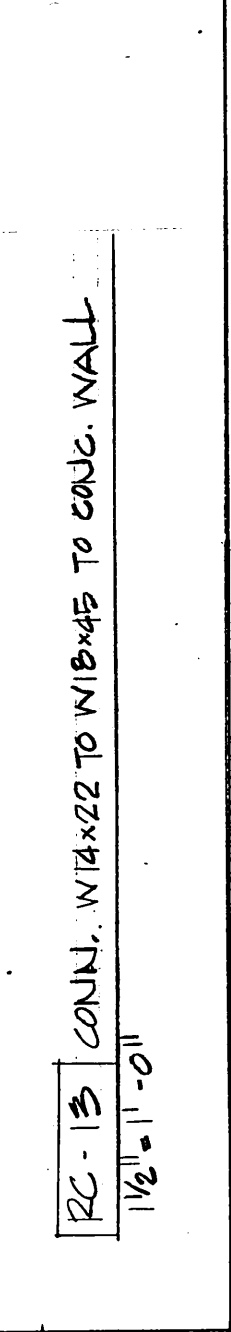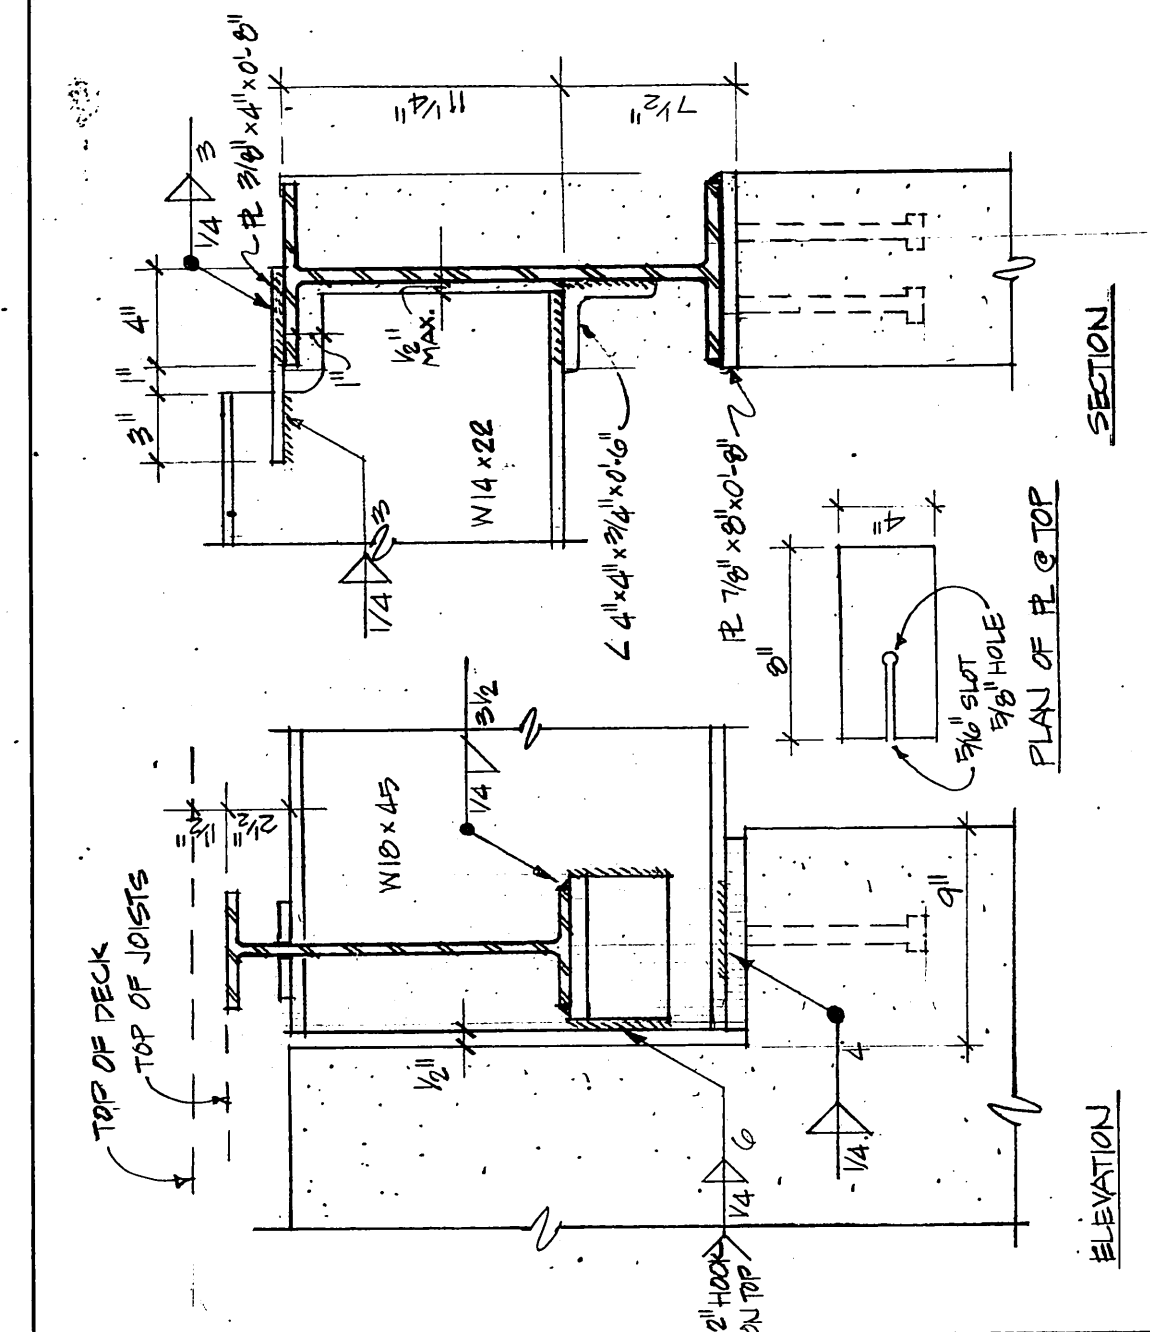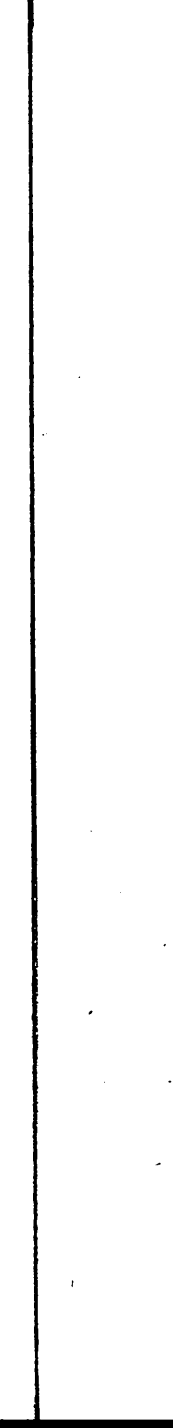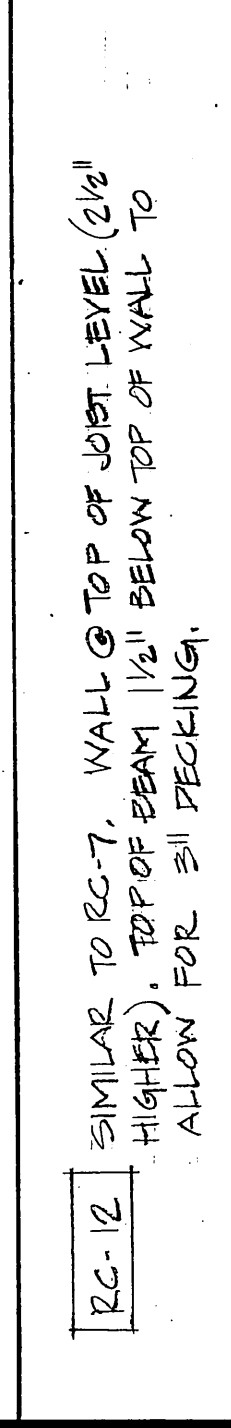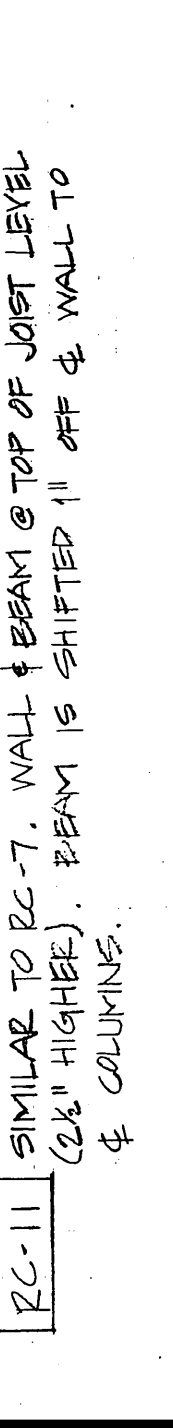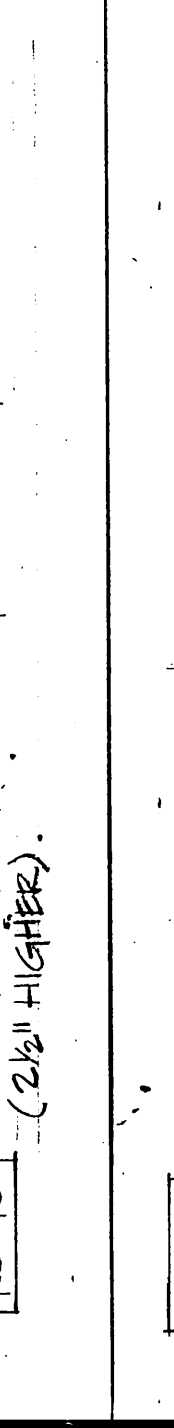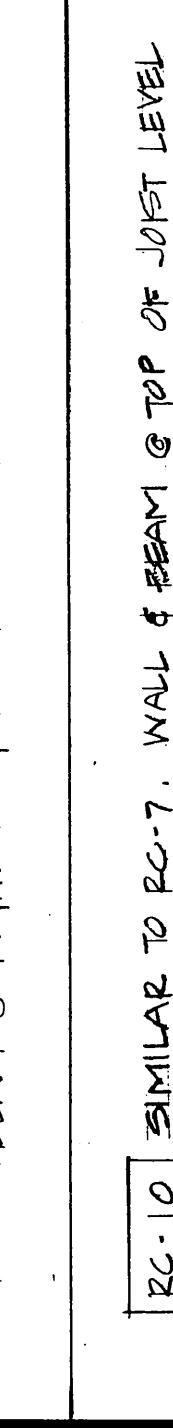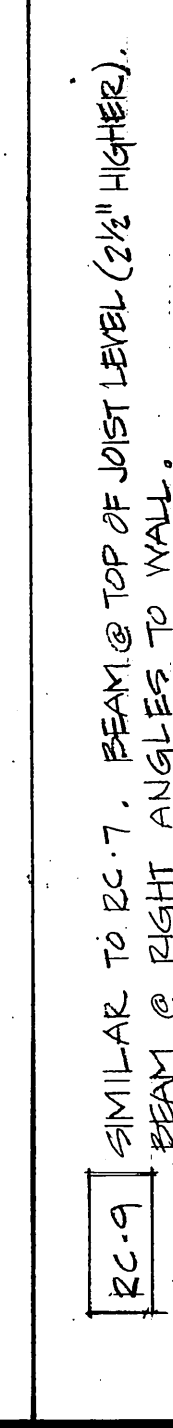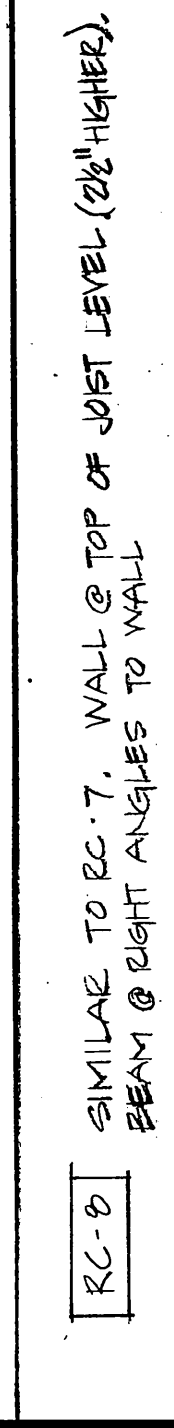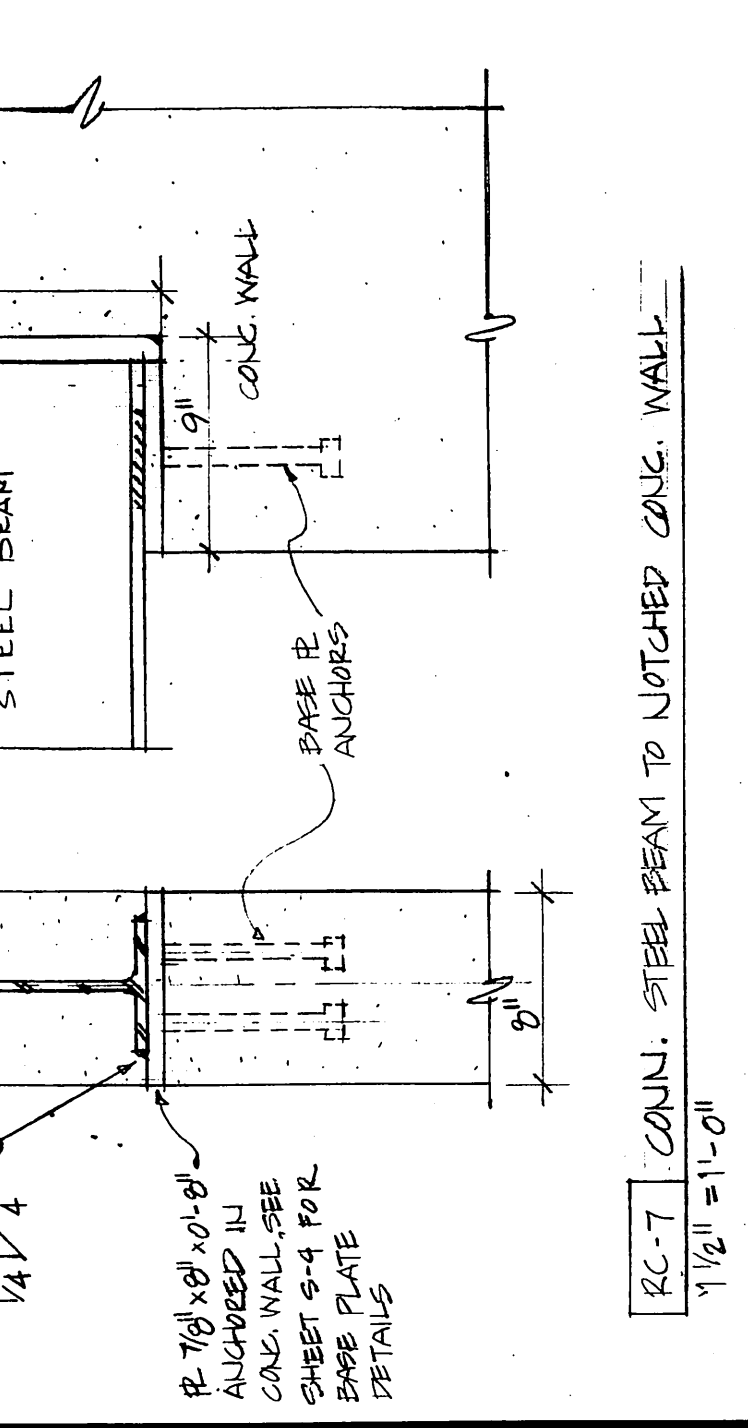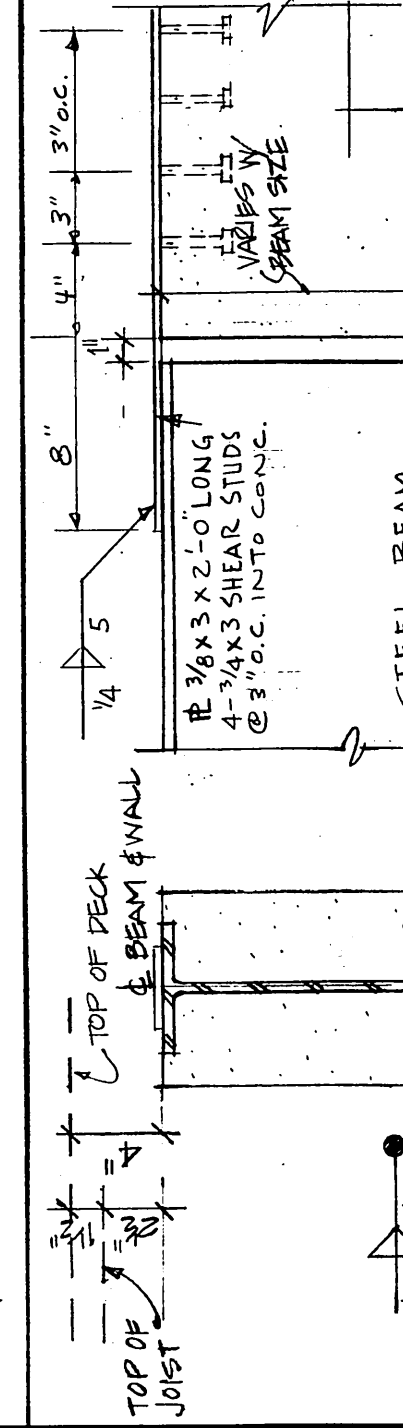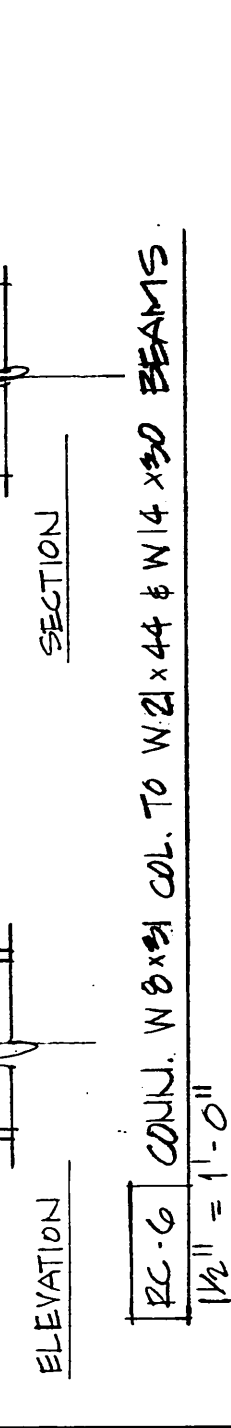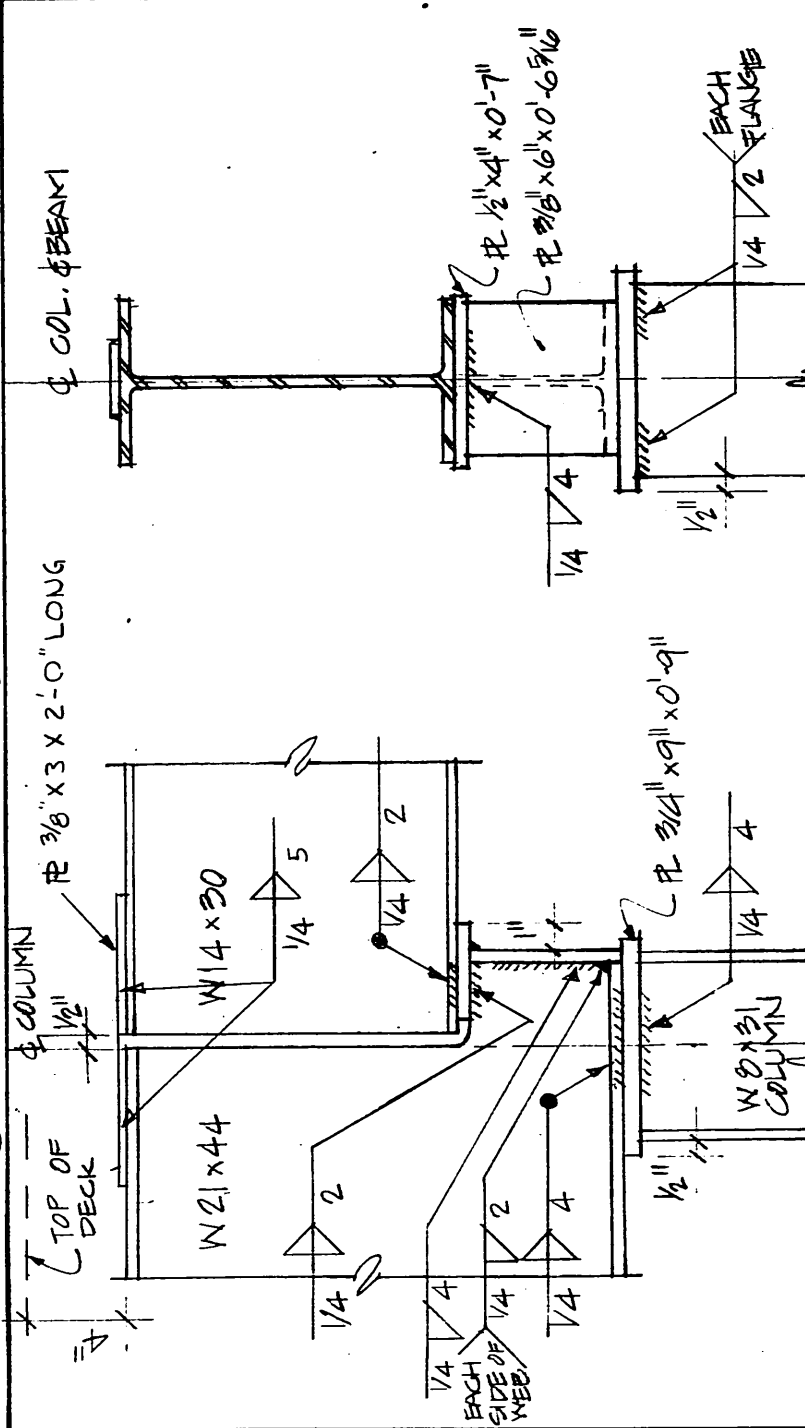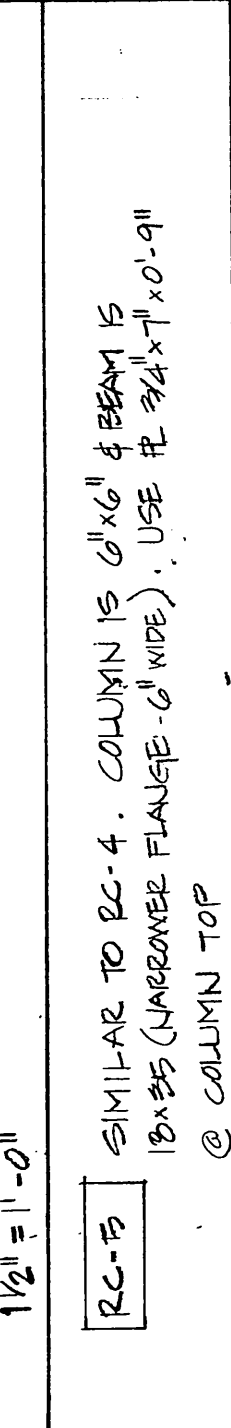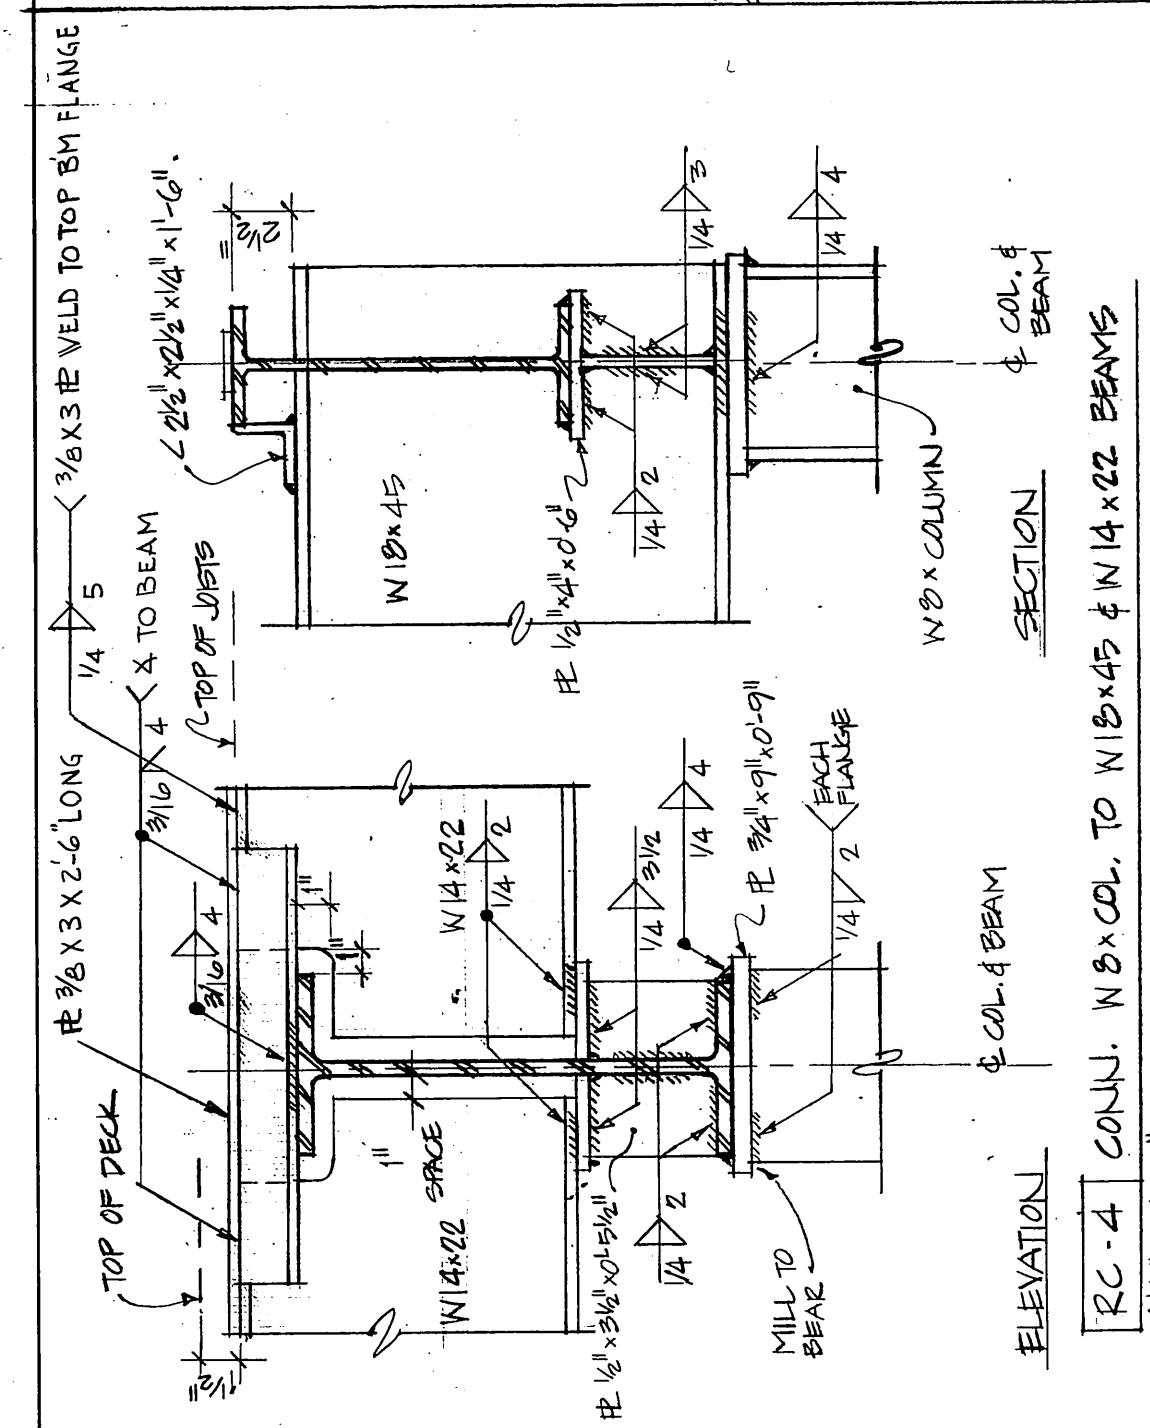

JOB NO: 75005-754

DATE: NOV. 12, 1973


ARCHITECTS - ENGINEERS - SURVEYORS
601 COLLEGE ROAD, FAIRBANKS, ALASKA 99701, PHONE: 452-1111

AS BUILT
PRODUCED IN ACCORDANCE WITH CONTRACTOR
SUBMITTED AS BUILT RECORDS AS APPROVED
BY THE STATE OF ALASKA.

STATE OF ALASKA
DIVISION OF BUILDINGS

PHASE
TWO
















FAIRBANKS REGIONAL
OFFICE BUILDING

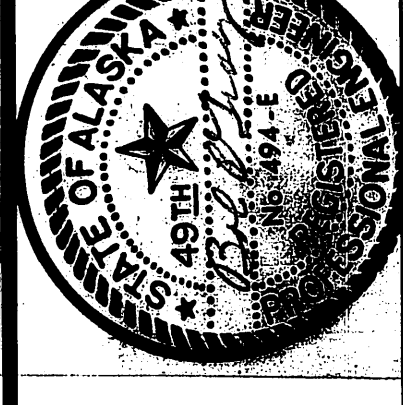

S-5
SHEET NO. 5 OF 6

STEEL COL. BASE SIZES @ 1 ST FLOOR	BASE SIZE	BASE SIZE
W 6 x 15.5	12 1/2" x 17 1/4"	
W 6 x 25	12 3/8" x 19 1/4" x 9 1/2"	
W 8 x 28	12 7/8" x 10 1/2" x 12 1/4"	
W 8 x 31	12 11/16" x 12 1/2" x 12 1/4"	
W 8 x 35	12 1 1/8" x 12 1/2" x 13 3/4"	
W 8 x 40	12 13/16" x 13 1/8" x 16 1/2"	
5 TH FLOOR	12 5/8" x 8 1/2" x 10 1/4"	
W 8 x 39	12 1 1/4" x 12 1/2" x 13 3/4"	

* $\frac{1}{16}$ BASE PL @ M-3, N-3, I-5, J-5, K-5, L-5, M-5
 $\frac{1}{16}$ BASE PL @ O-3, J-4, K-4, L-4, M-4, N-4

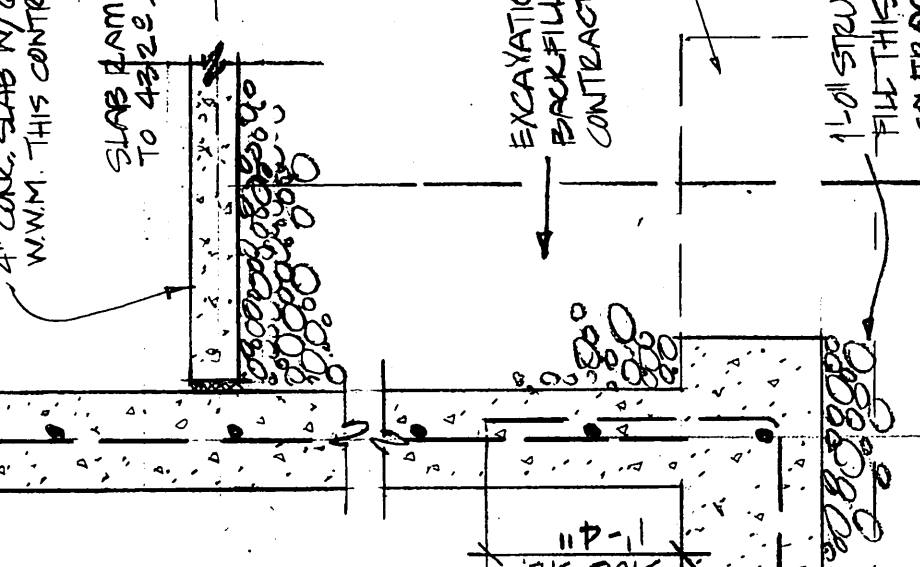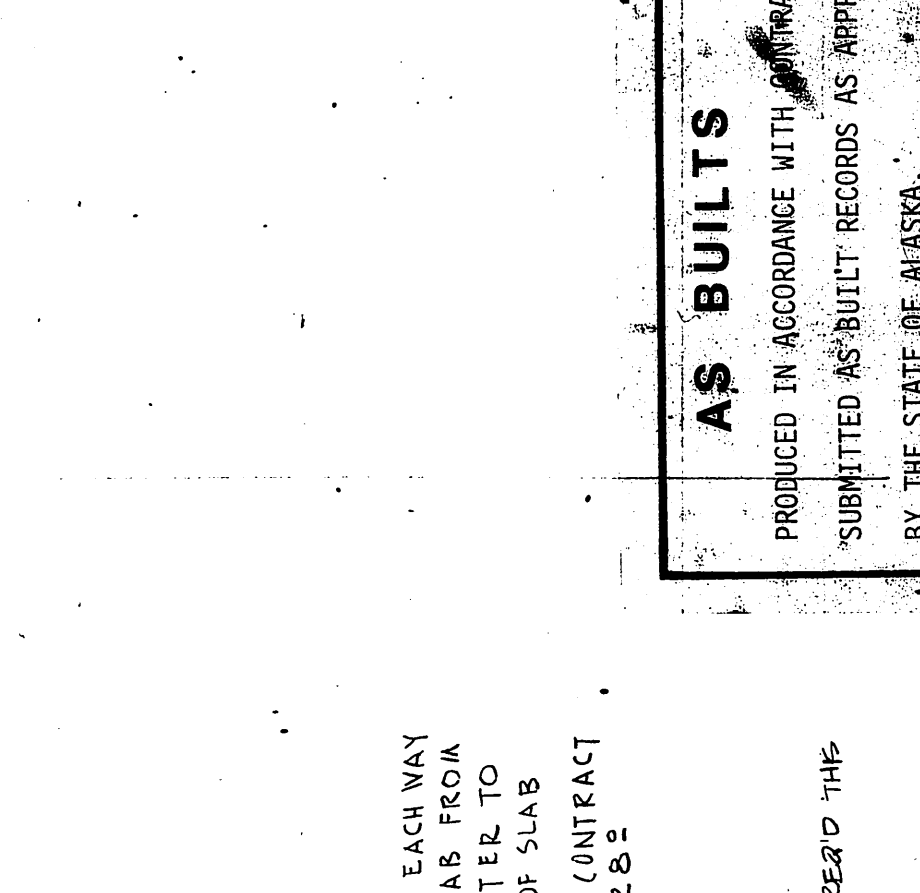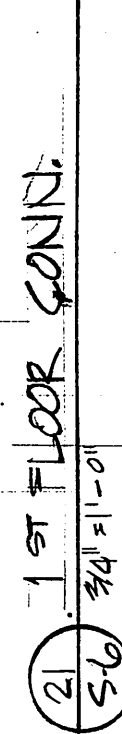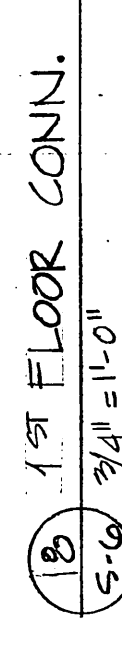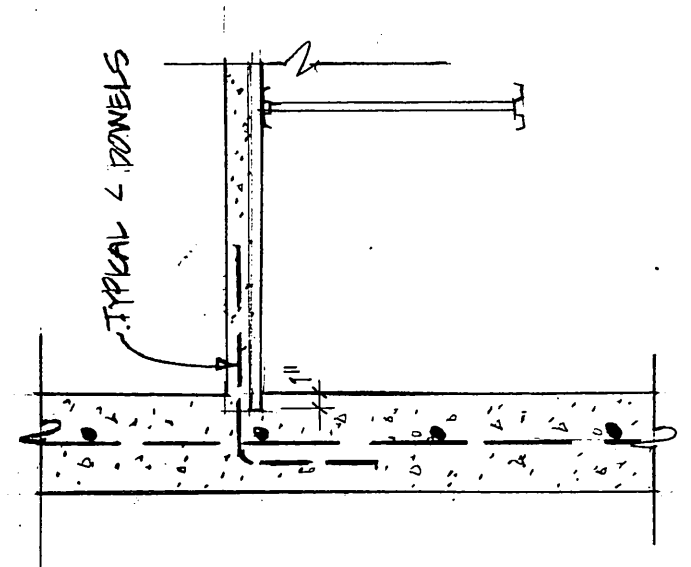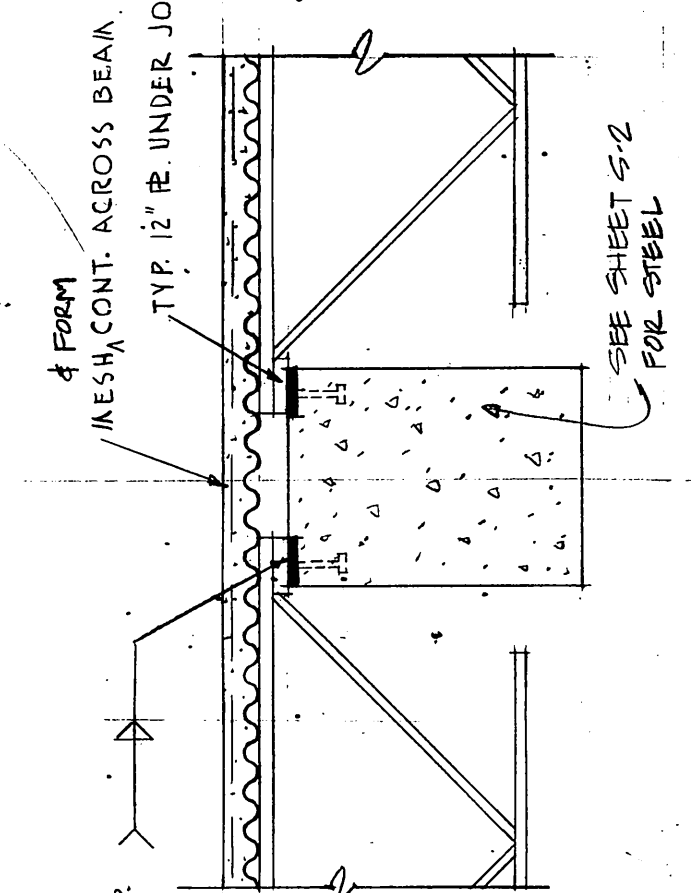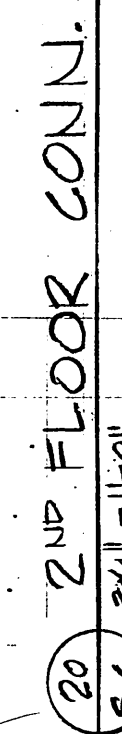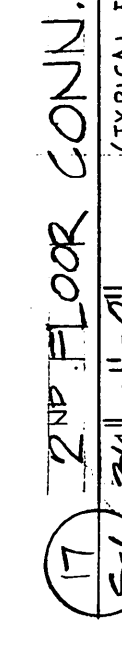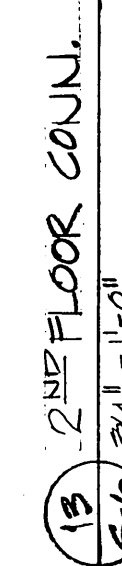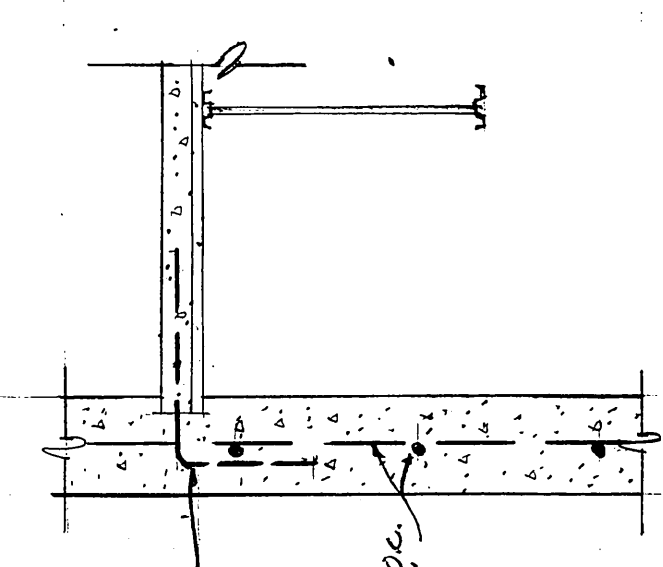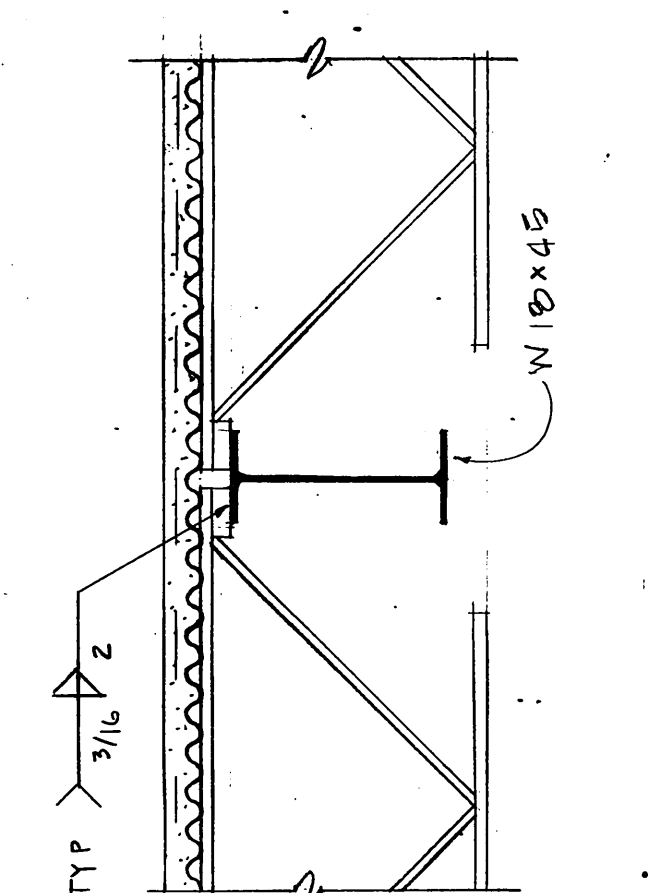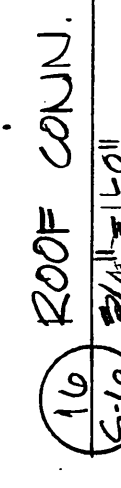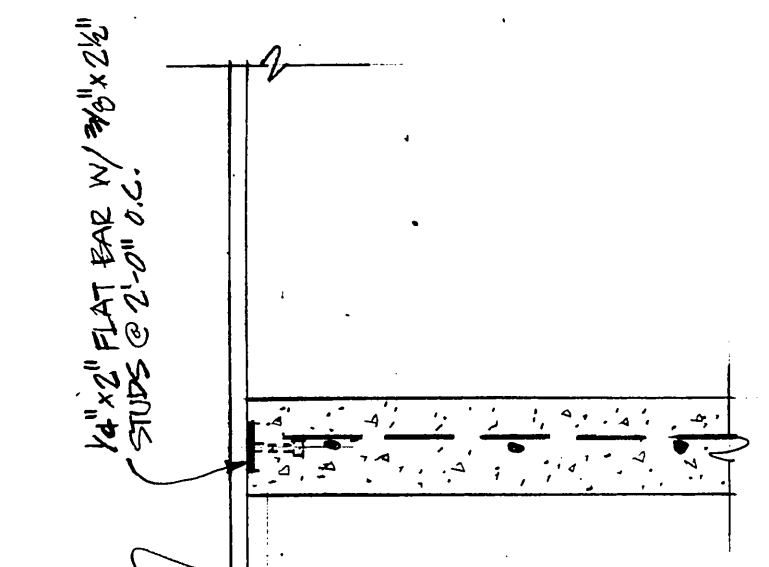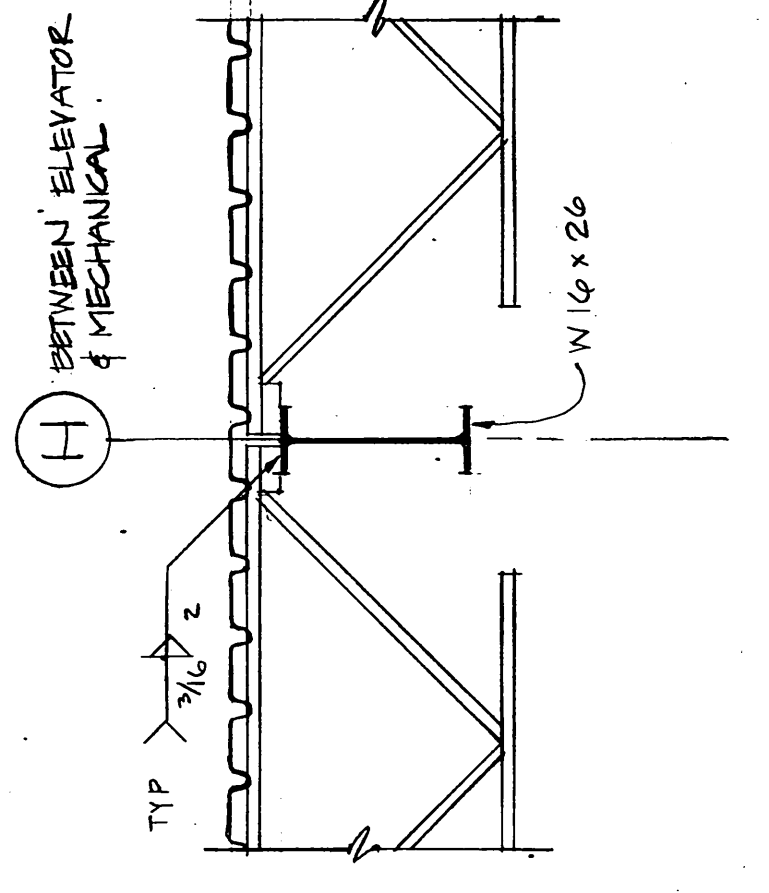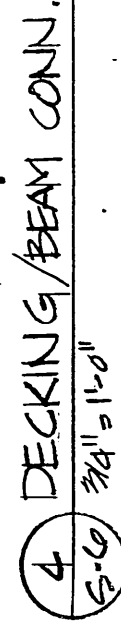

AS BUILTS
PRODUCED IN ACCORDANCE WITH CONTRACTOR
SUBMITTED AS 'BUILT' RECORDS AS APPROVED
BY THE STATE OF ALASKA.

JOE NO. 11-12-13-14-1043-10

FOOTING DETAIL
OOC
DETAIL
17 DETAIL
3/8" x 1/2"
ARCHITECTS - ENGINEERS - SURVEYORS
601 COLLEGE ROAD, FAIRBANKS, ALASKA 99701, PHONE: 452-1241

SUBMITTED AS BUILT RECORDS AS APPROVED
BY THE STATE OF ALASKA

22 BASEMENT/FOOTING DETAIL

26/5-6


MENT DETAIL



**FAIRBANKS REGIONAL
OFFICE BUILDING**


STATE OF ALASKA
DEPARTMENT OF PUBLIC WORKS
DIVISION OF BUILDINGS

S-6
SHEET NO.: OF 61

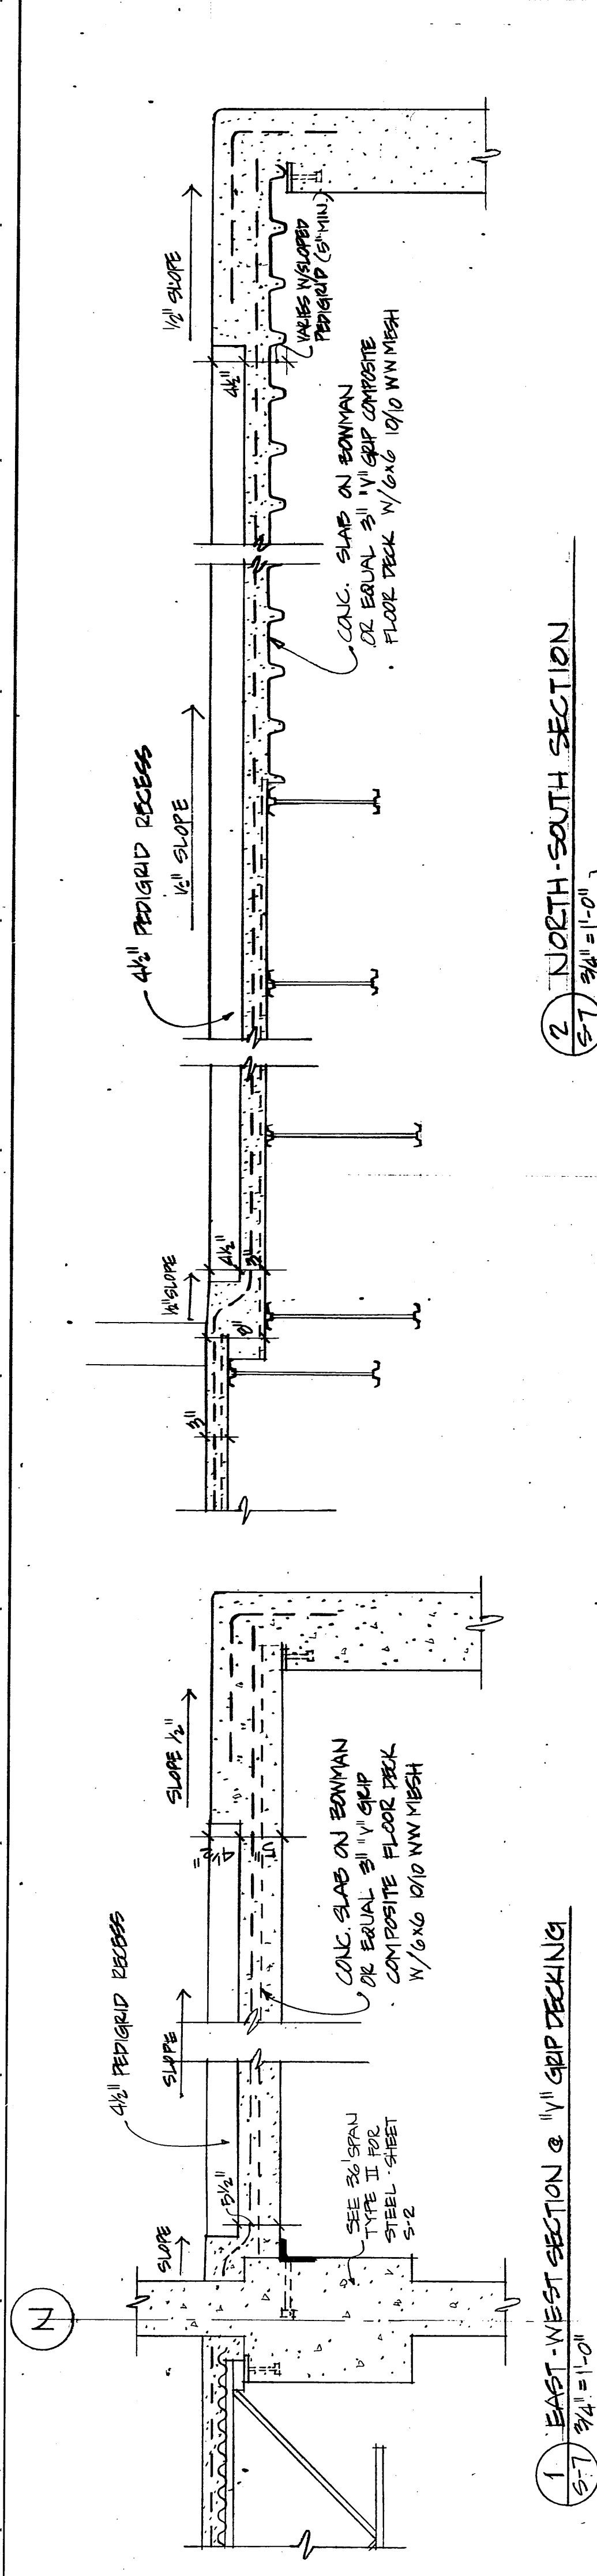


1 EAST-WEST SECTION @ 1/2" GRIP PECKING
S-7 3/4" = 1'-0"

MAIN ENTRY SECTIONS

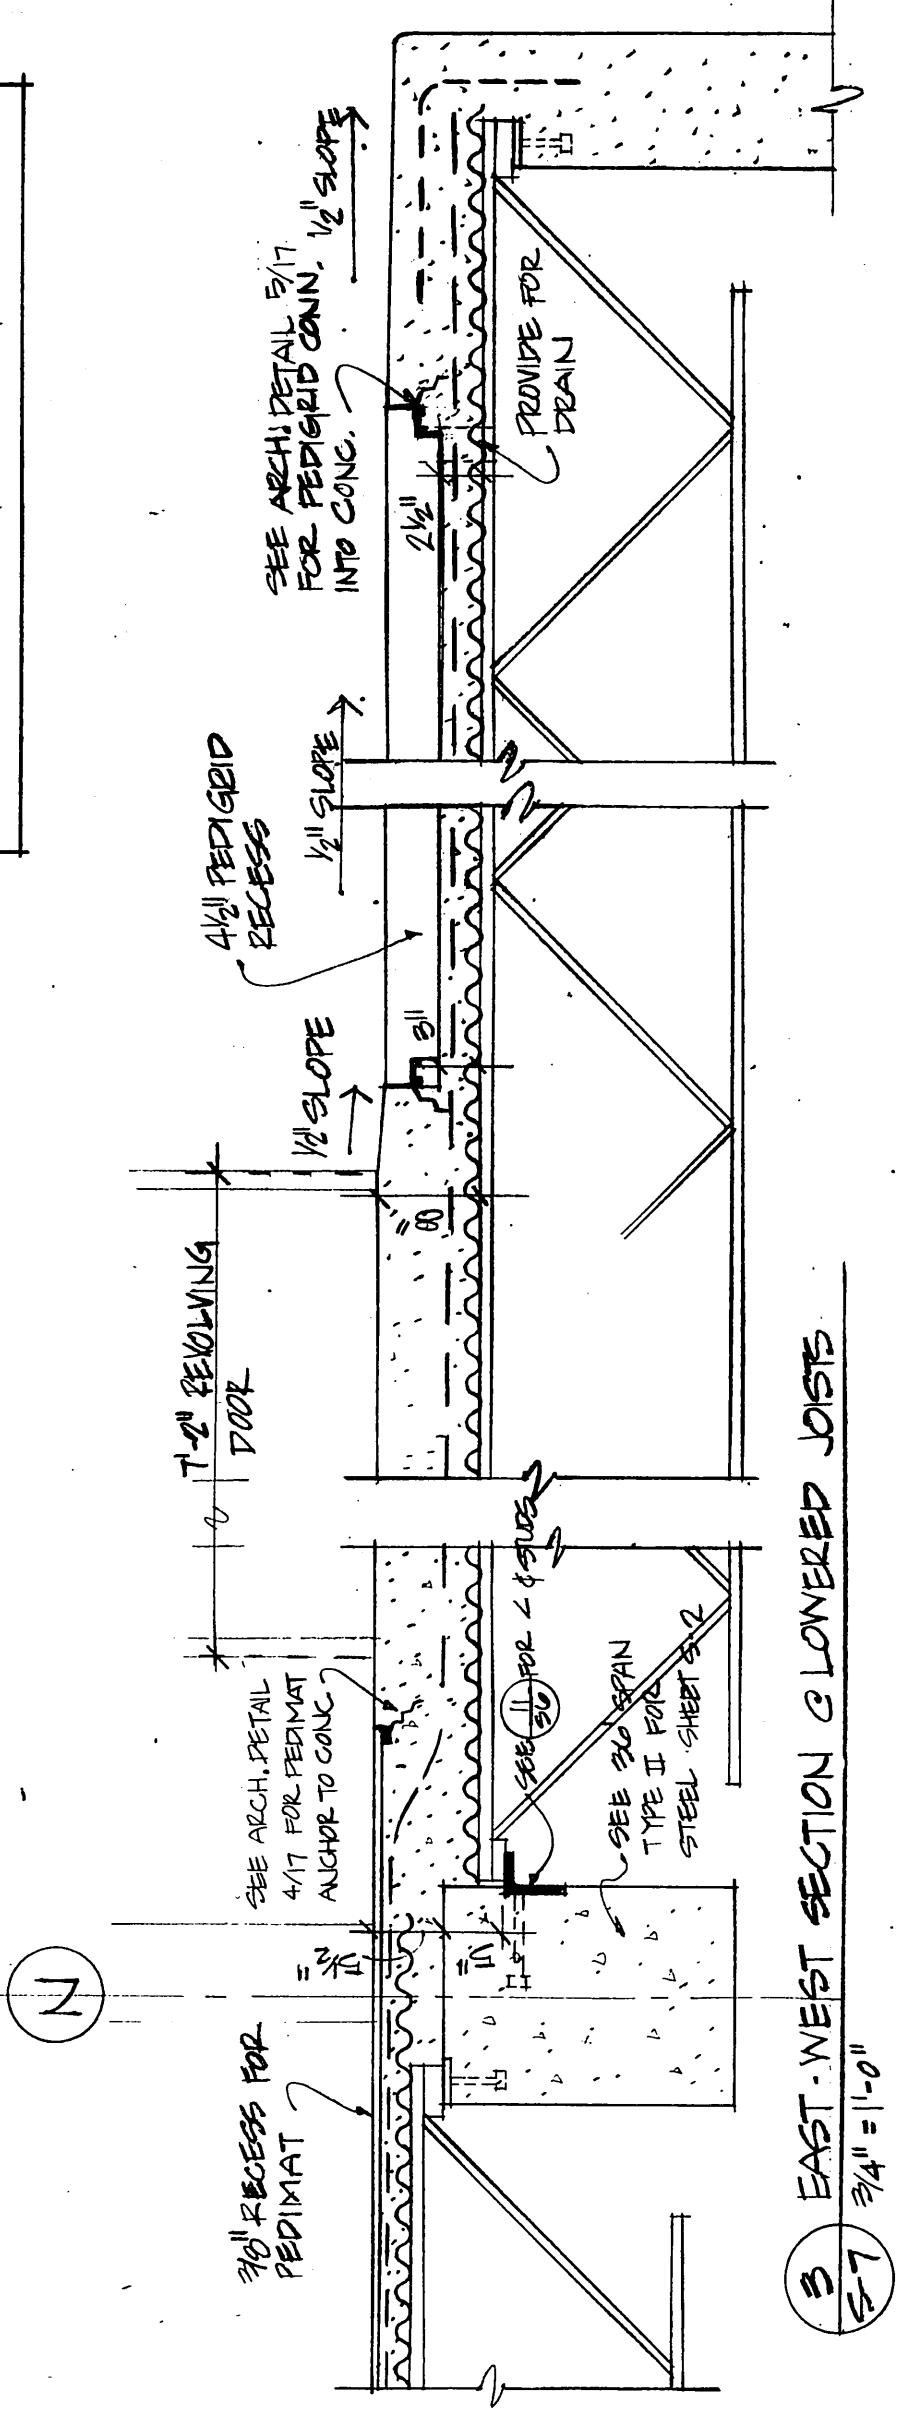


3 EAST-WEST SECTION @ LOWERED JOIST
S-7 3/4" = 1'-0"

2 NORTH-SOUTH SECTION
S-7 3/4" = 1'-0"

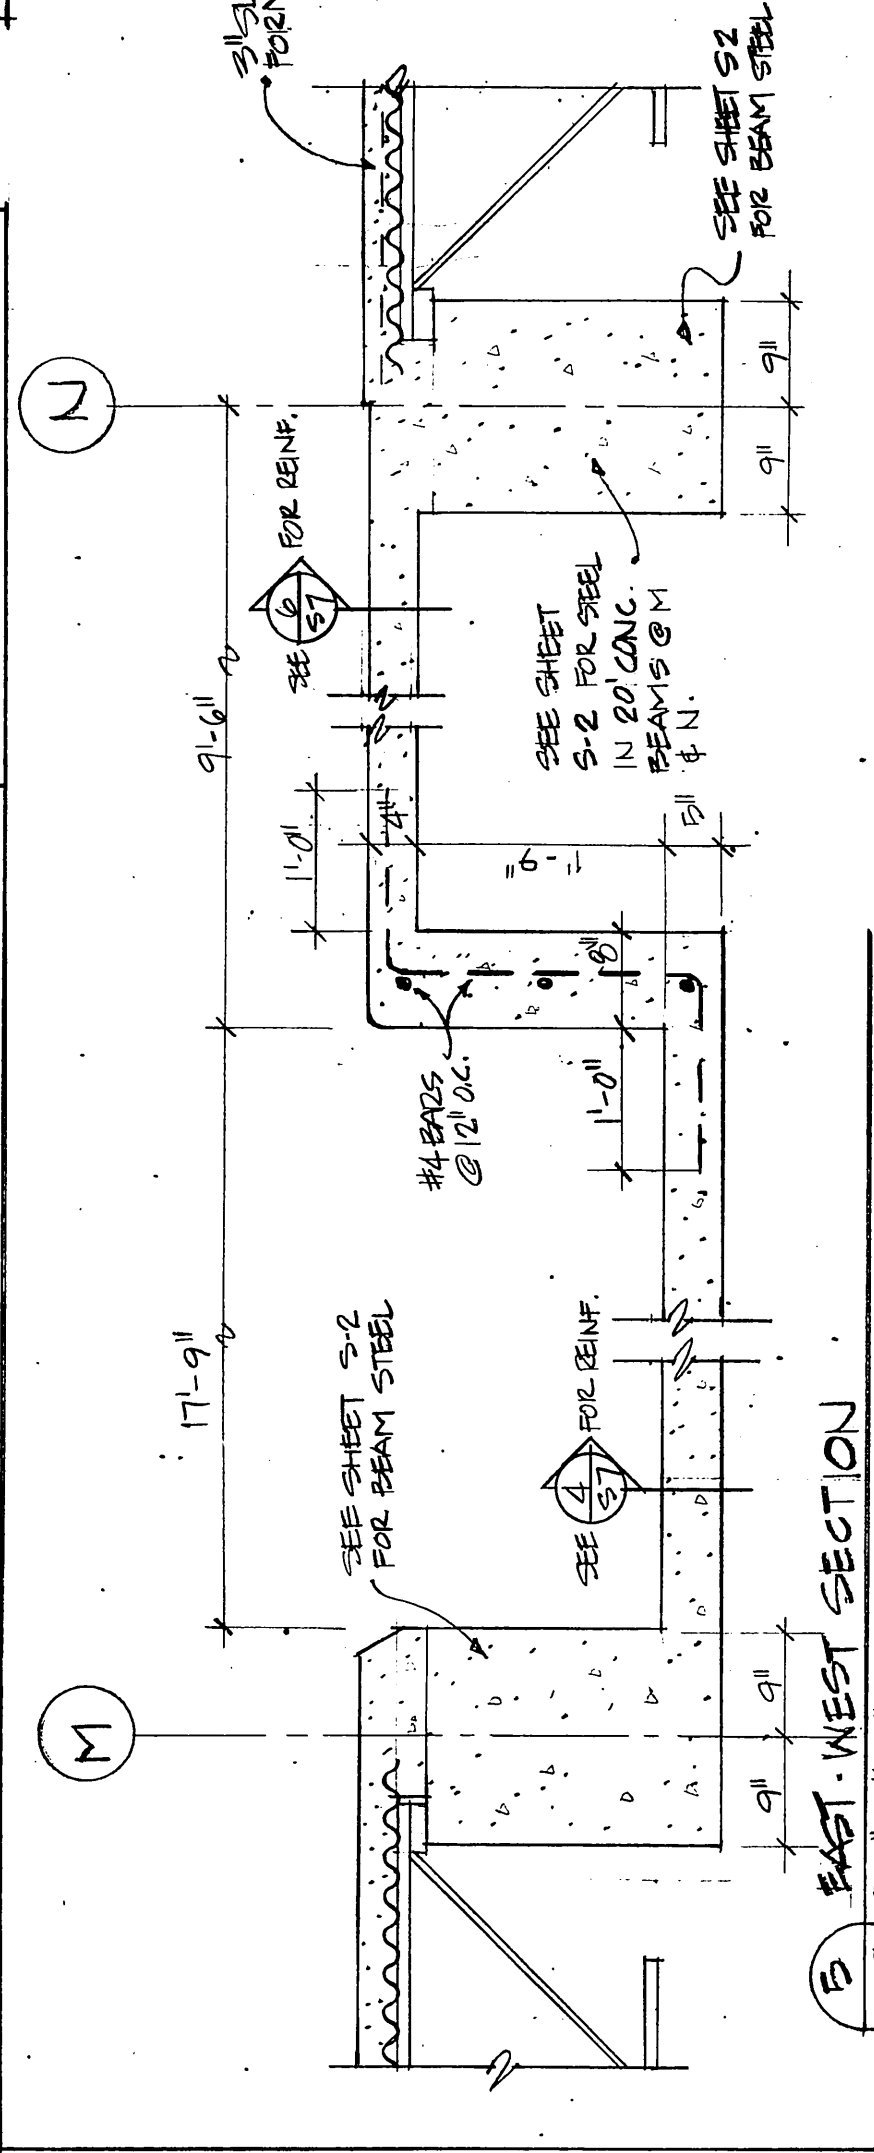


5 EAST-WEST SECTION
S-7 3/4" = 1'-0"


LOADING DOCK SECTIONS

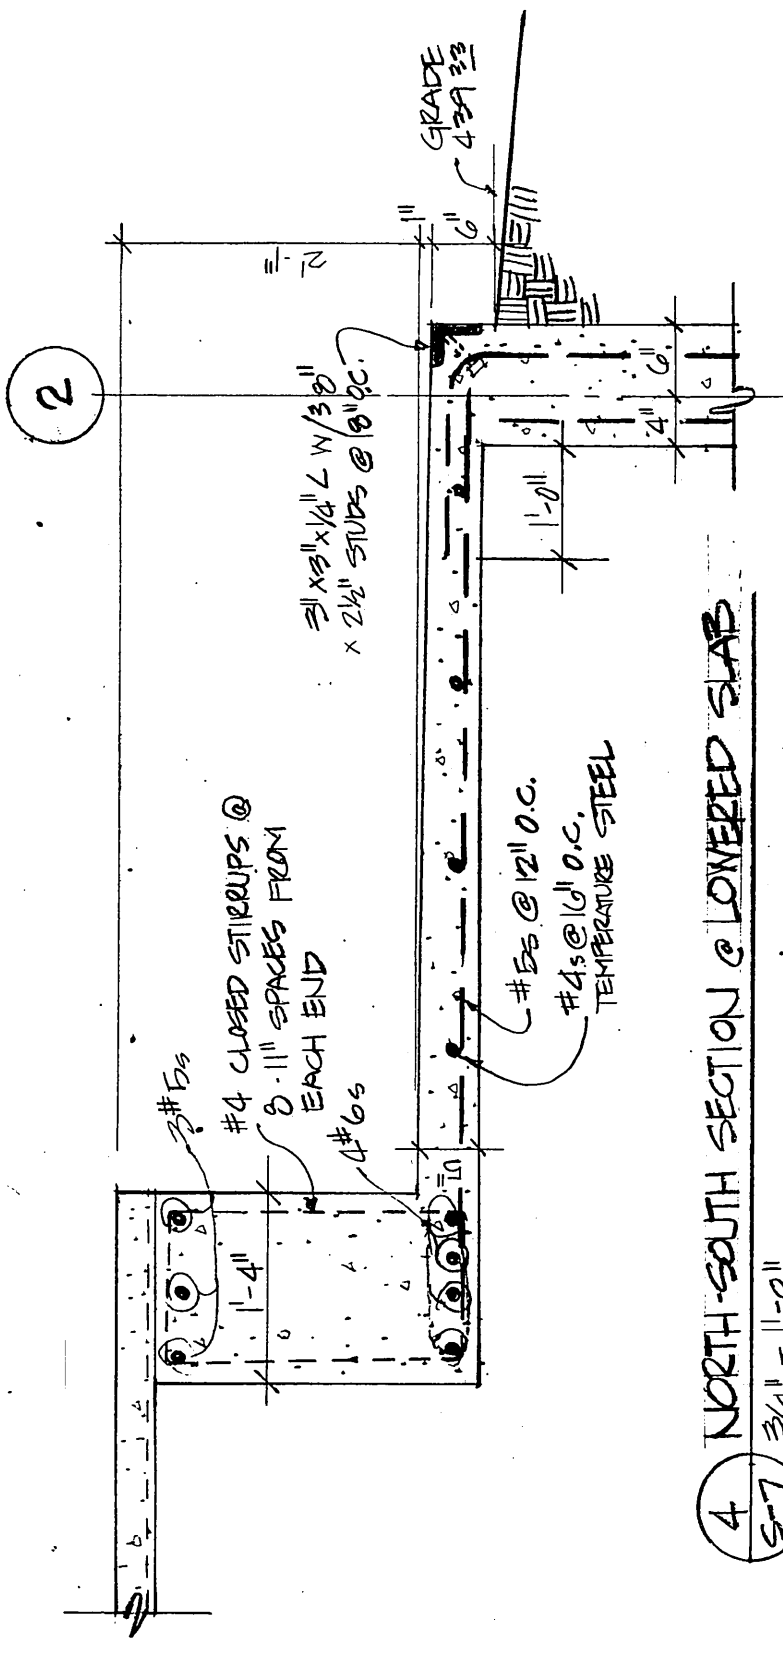

4 NORTH-SOUTH SECTION @ LOWERED SLAB
S-7 3/4" = 1'-0"

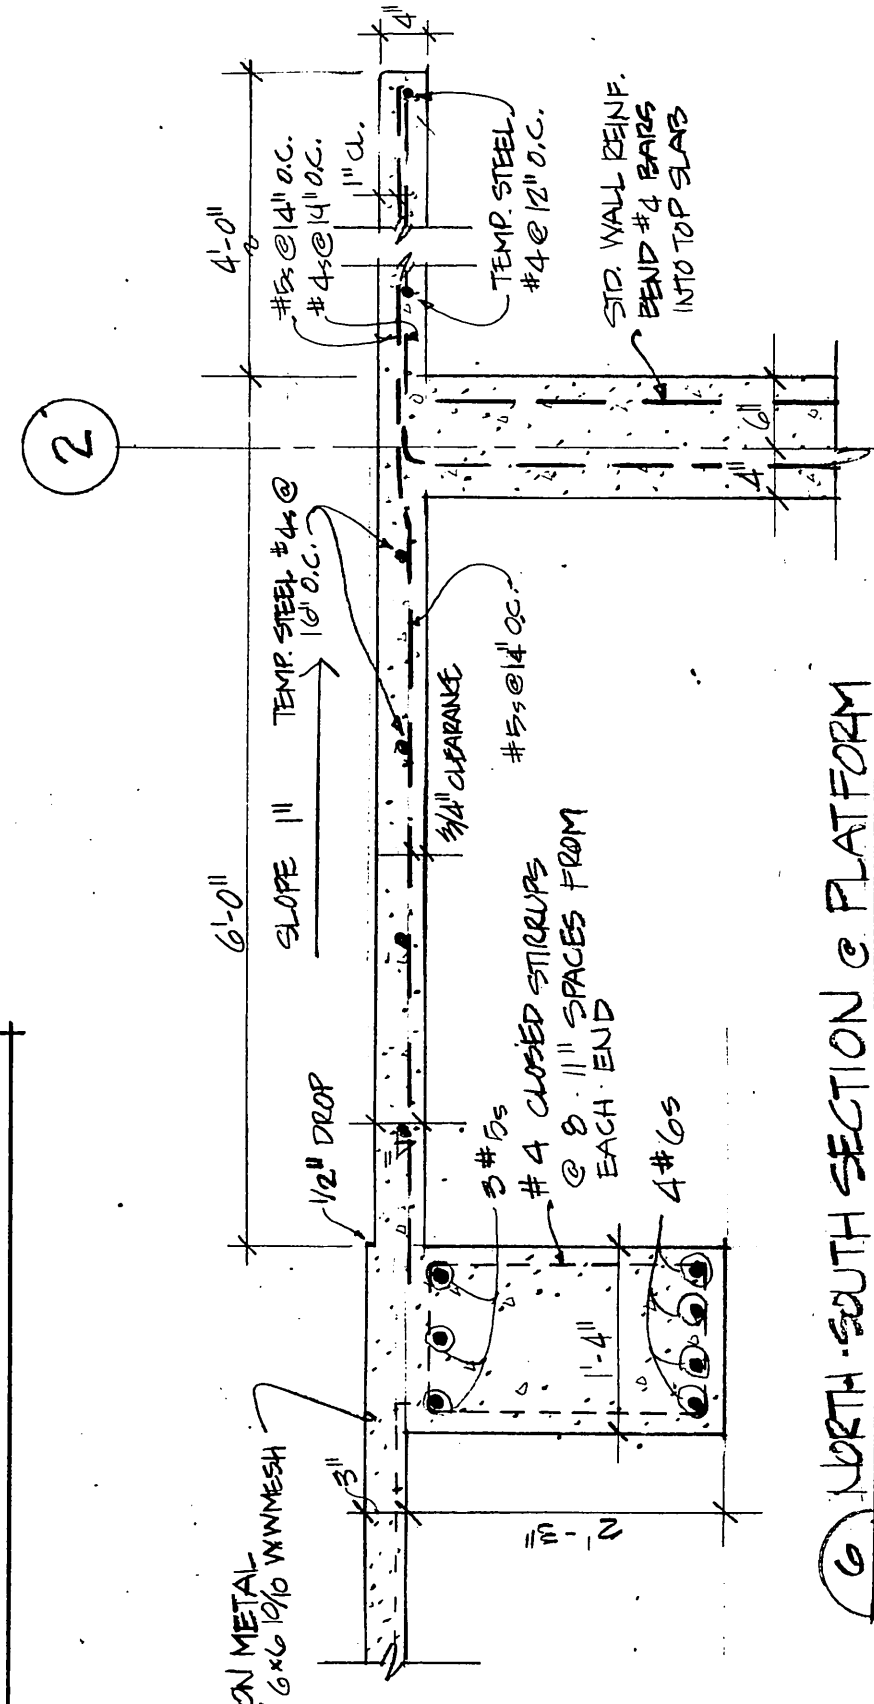


6 NORTH-SOUTH SECTION @ PLATFORM
S-7 3/4" = 1'-0"

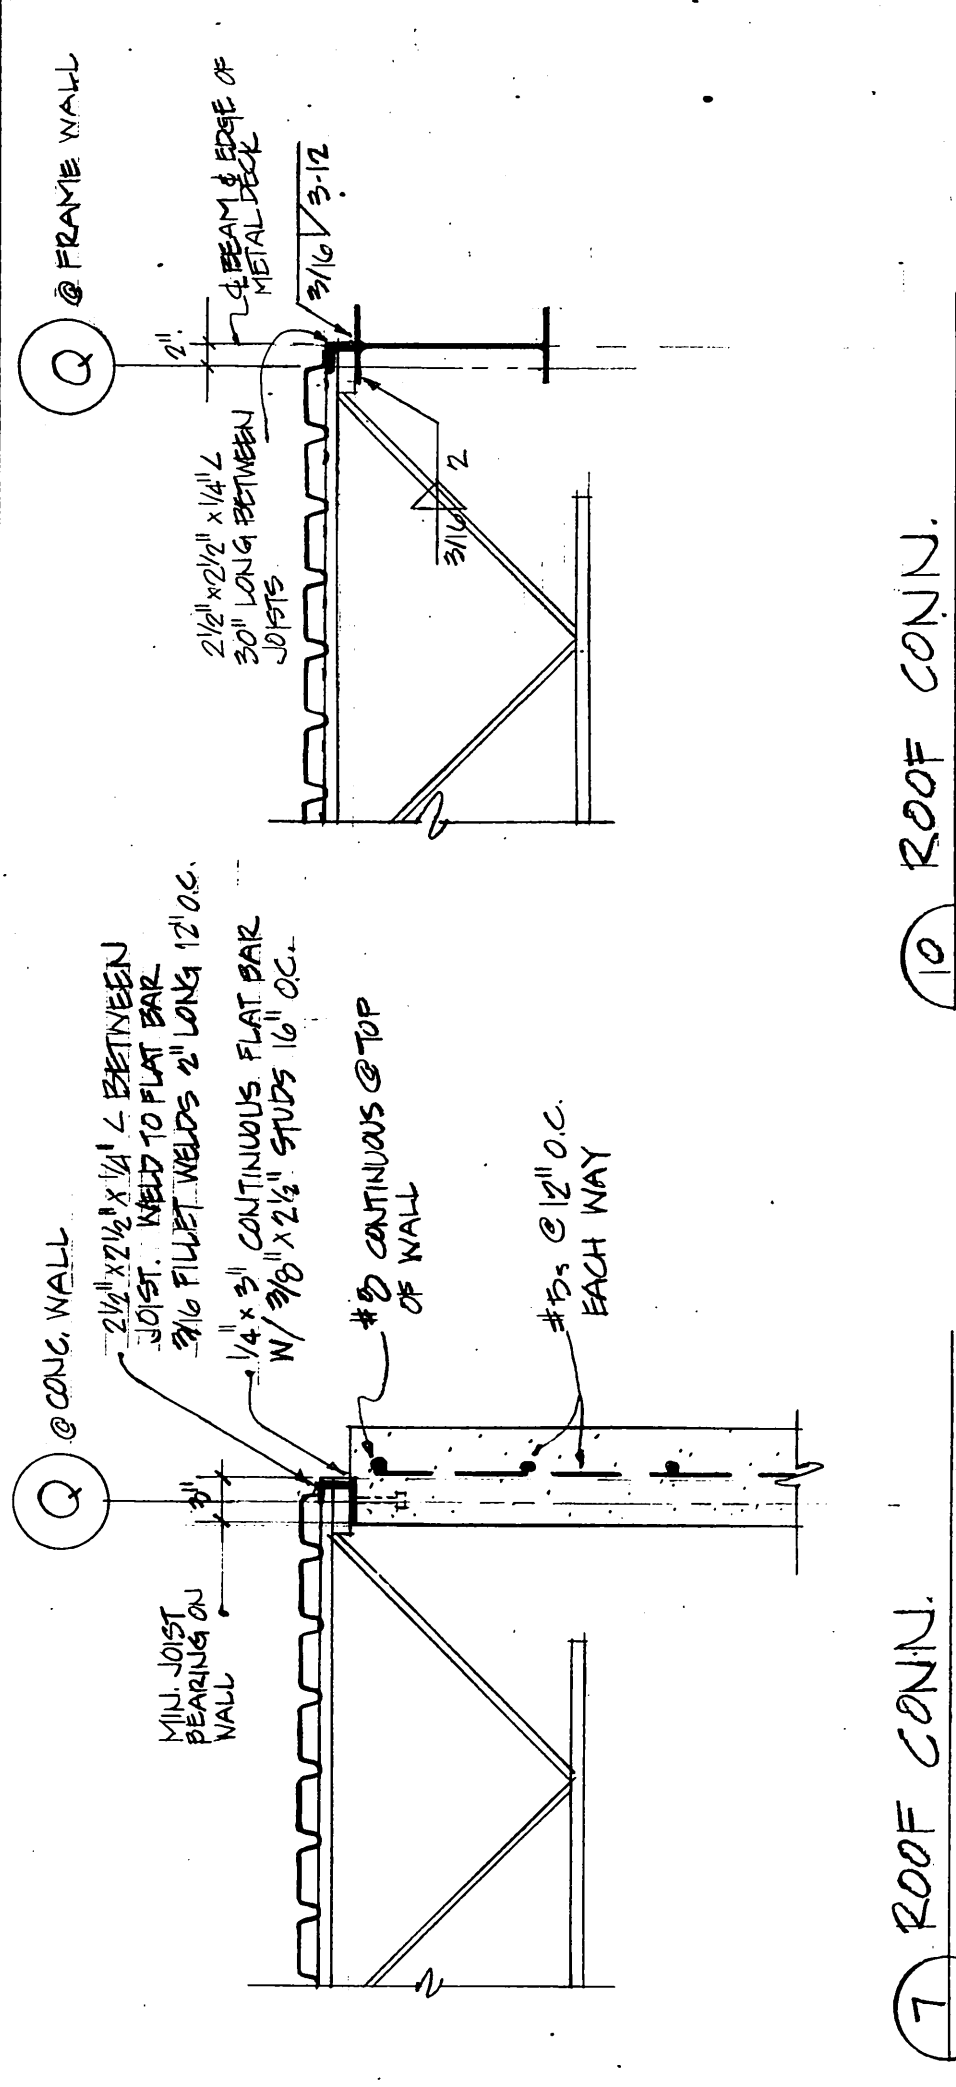


7 ROOF CONN.
S-7 3/4" = 1'-0"

10 ROOF CONN.
S-7 3/4" = 1'-0"

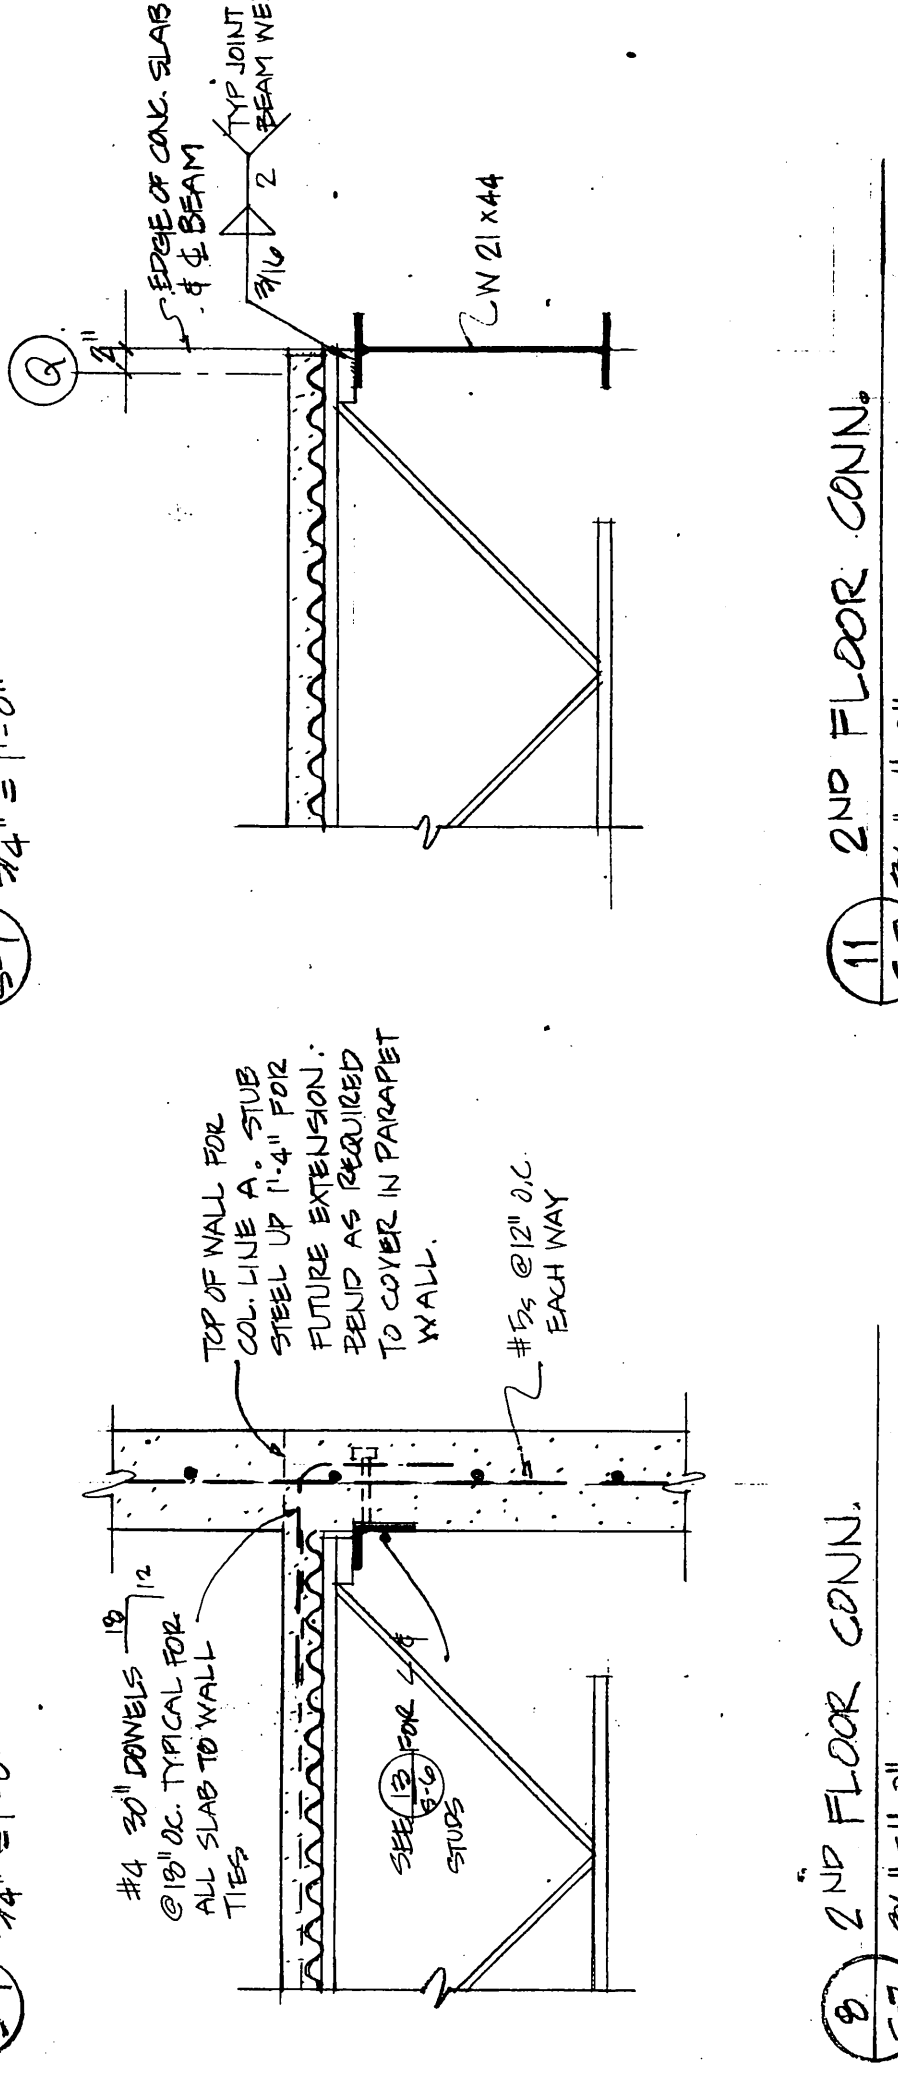


8 2ND FLOOR CONN.
S-7 3/4" = 1'-0"

11 2ND FLOOR CONN.
S-7 3/4" = 1'-0"

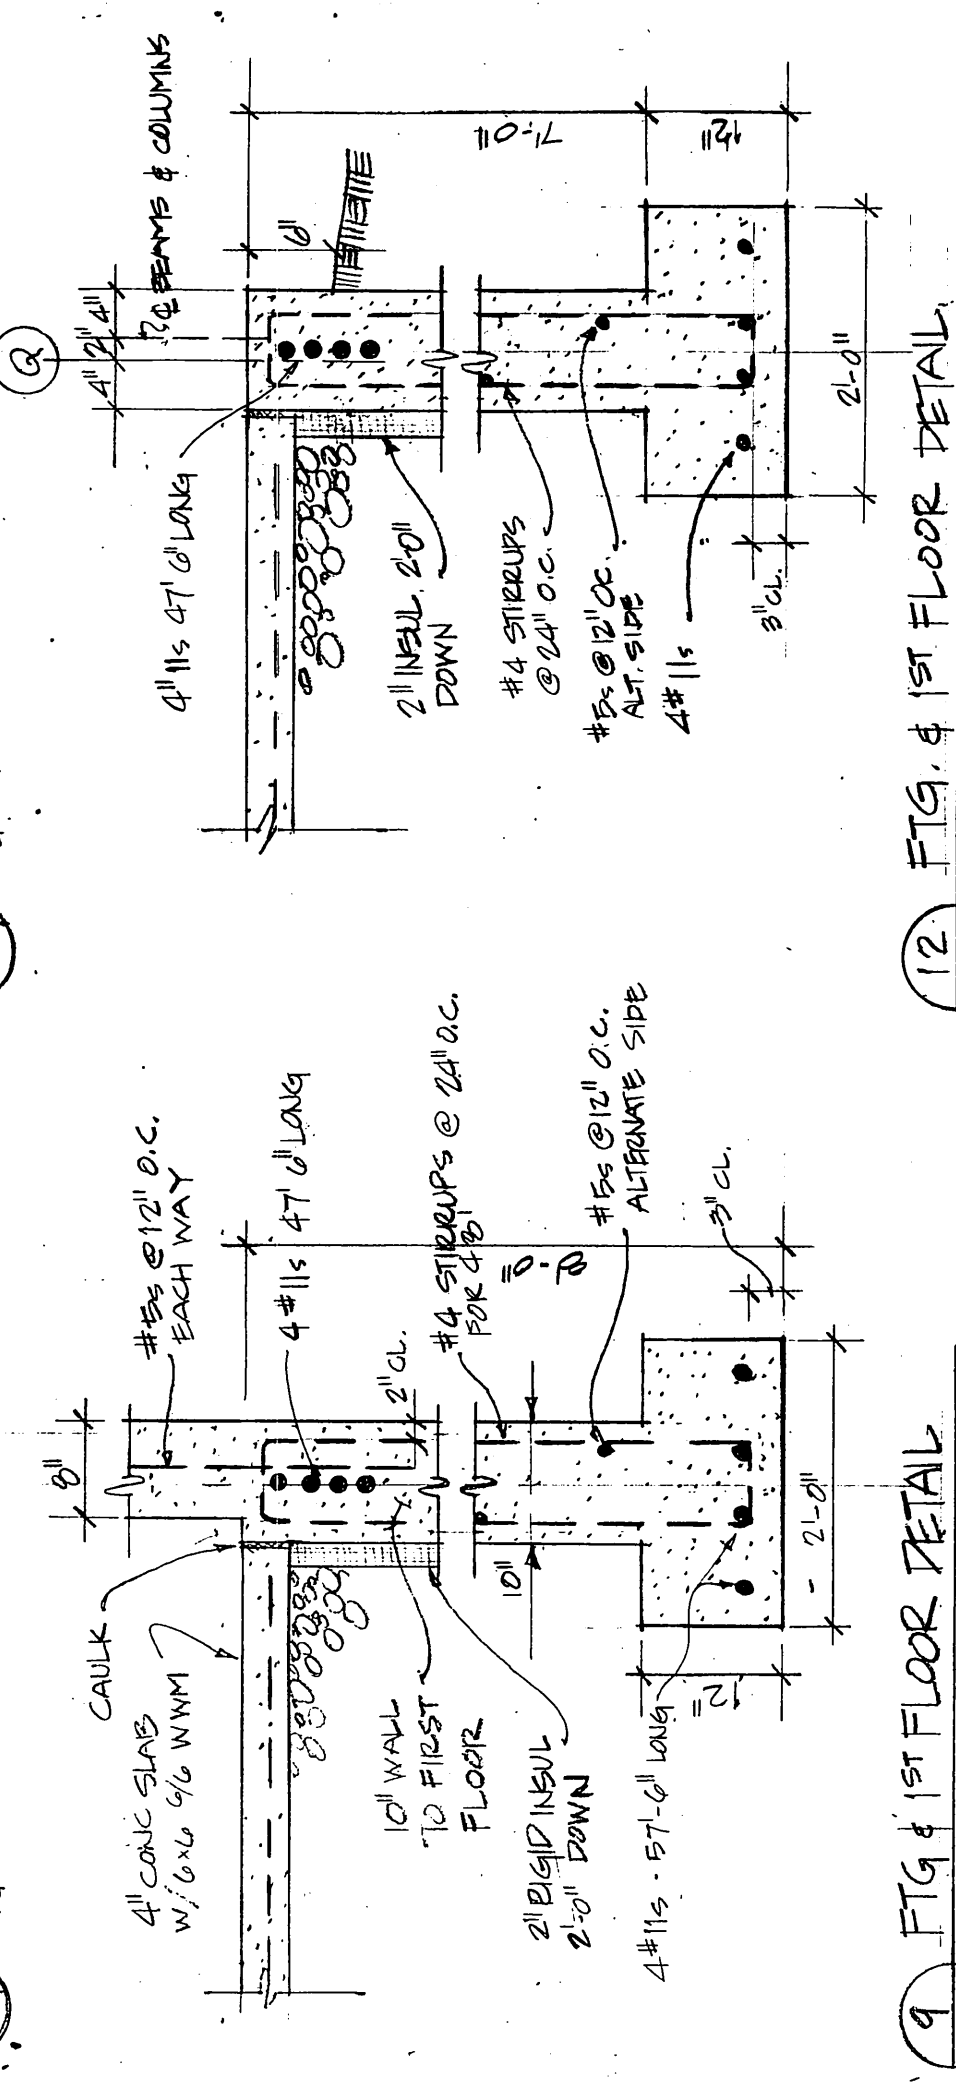


9 FIG. 1ST FLOOR DETAIL
S-7 3/4" = 1'-0"

12 FIG. 1ST FLOOR DETAIL
S-7 3/4" = 1'-0"

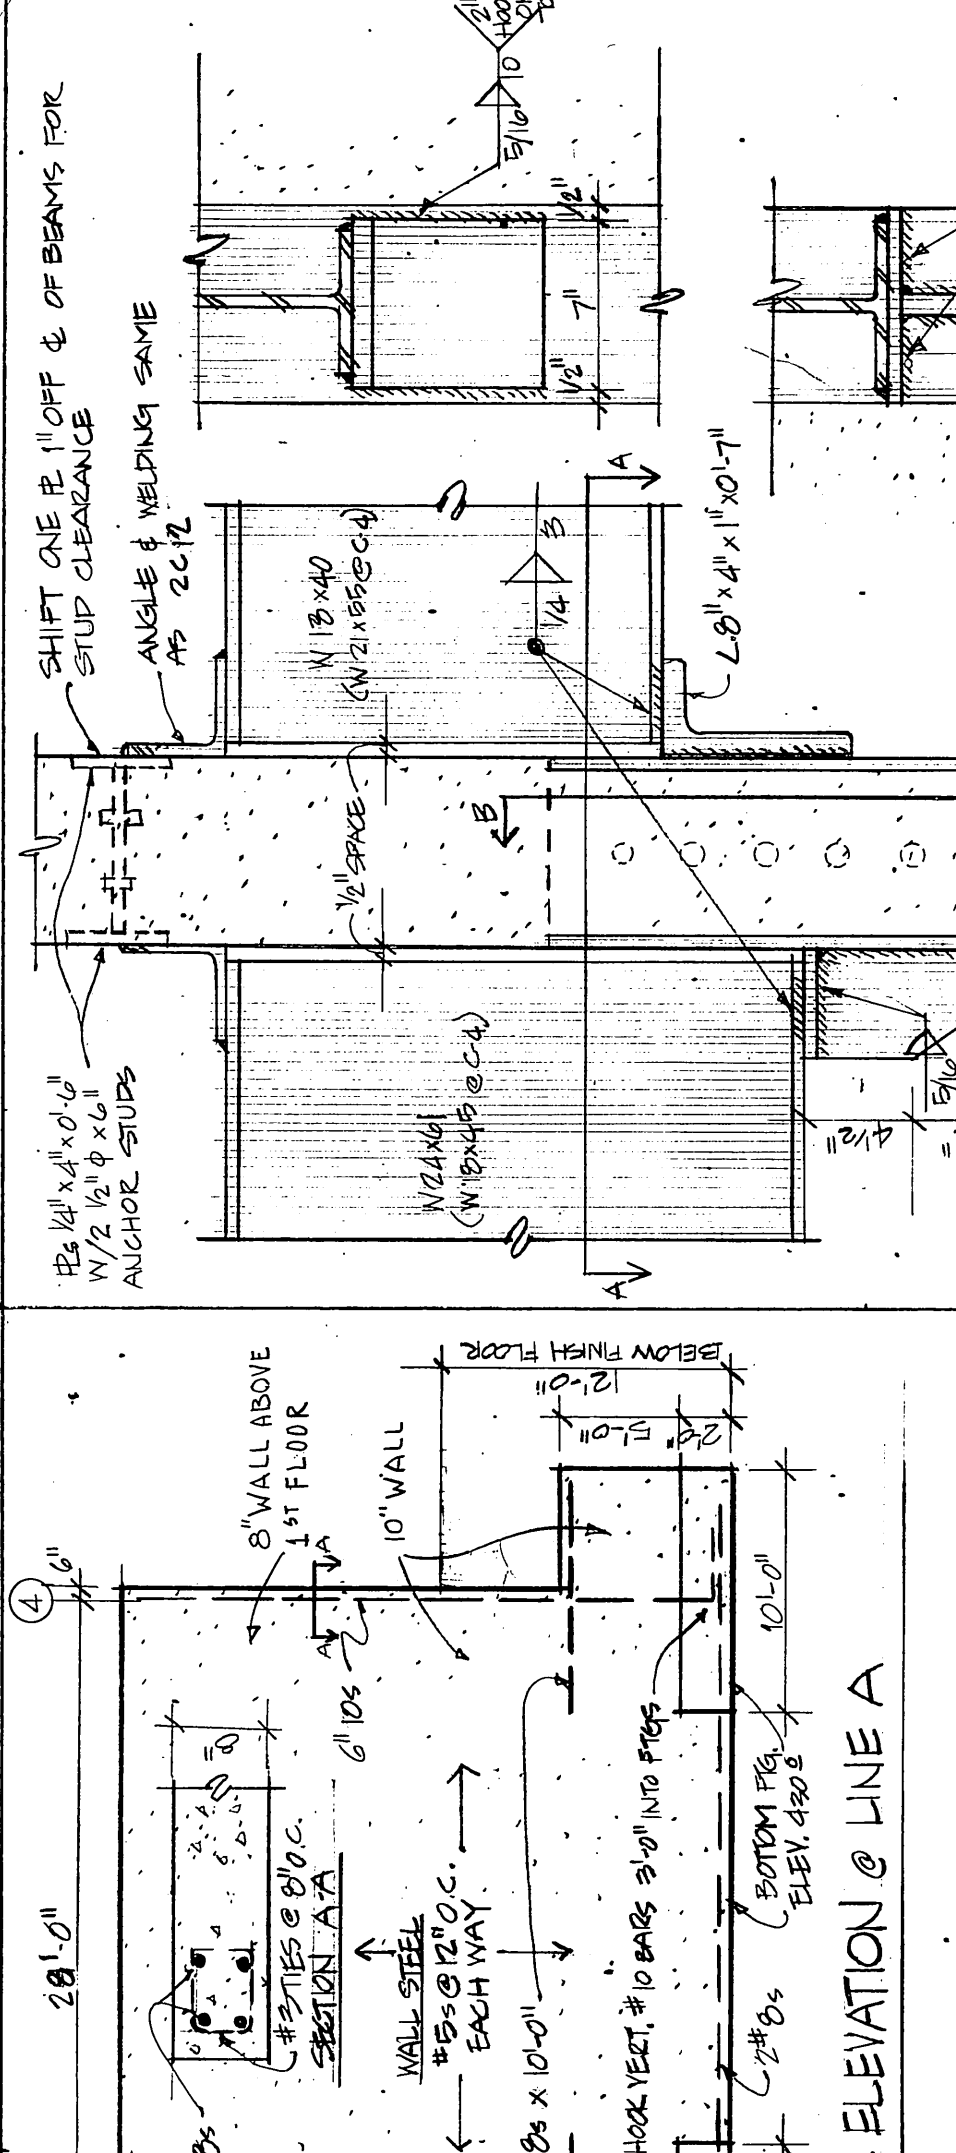


13 WALL ELEVATION @ LINE A
S-7 3/4" = 1'-0"

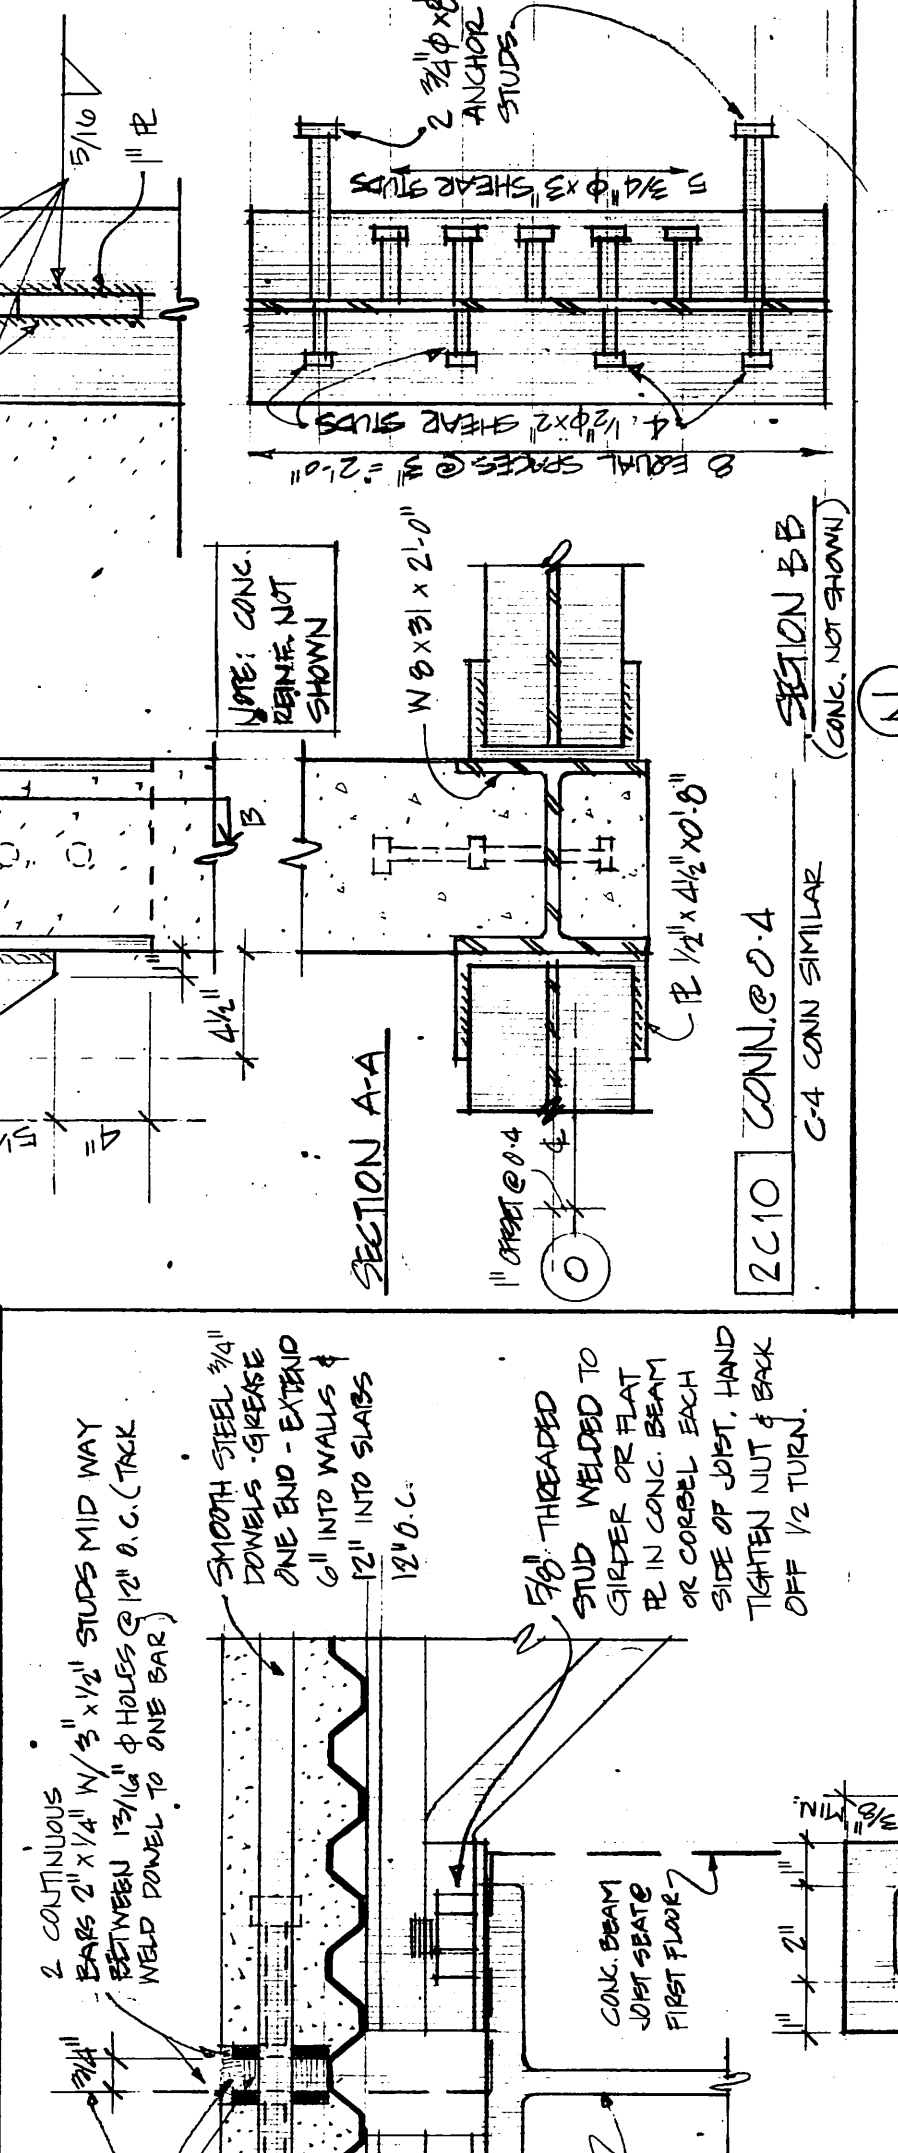


2C10 CONN. @ 4
S-7 3/4" = 1'-0"

2C12 WALL TO WALL CONN. @ E3.4.9.3
S-7 3/4" = 1'-0"

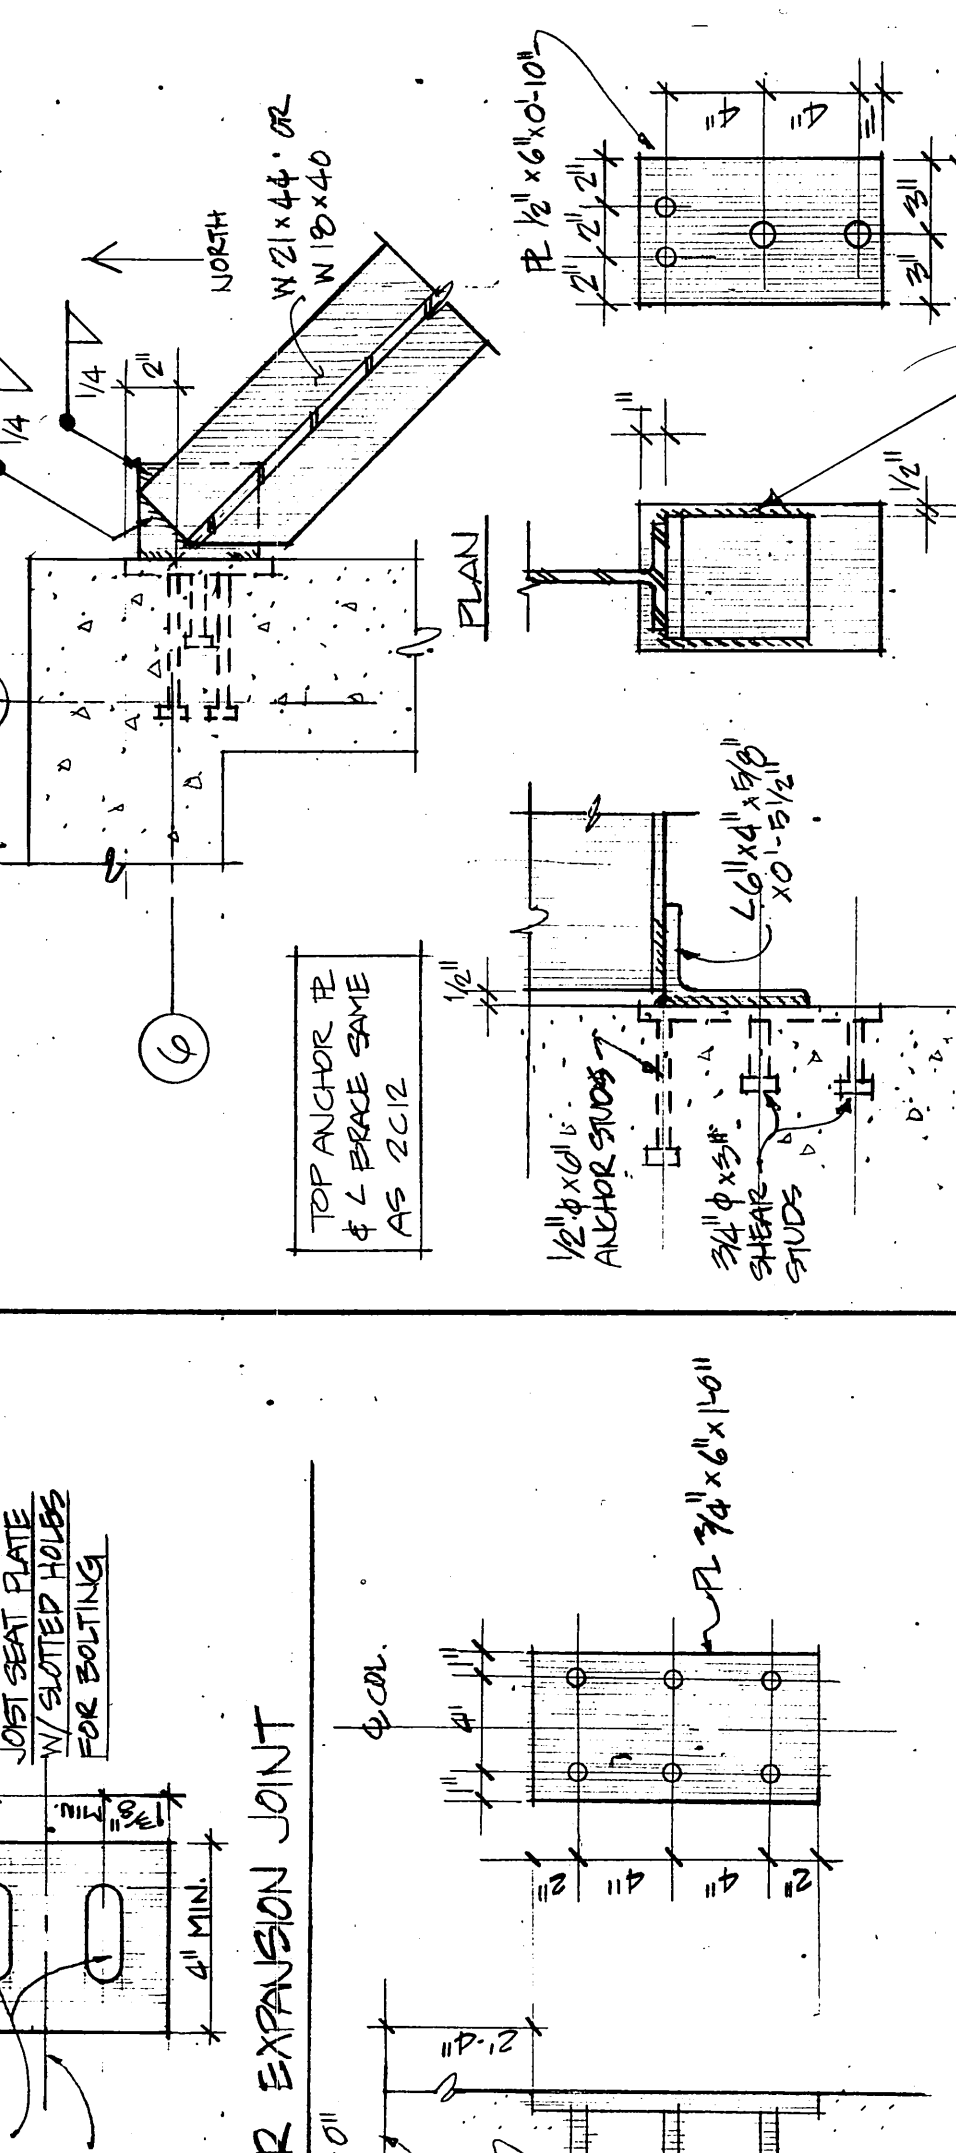


2C11 ANGLED BEAM CONN. TO COL. WALL @ N10.
S-7 3/4" = 1'-0"

2C13 BEAMS TO CONN. WALL CONN. @ N12
S-7 3/4" = 1'-0"

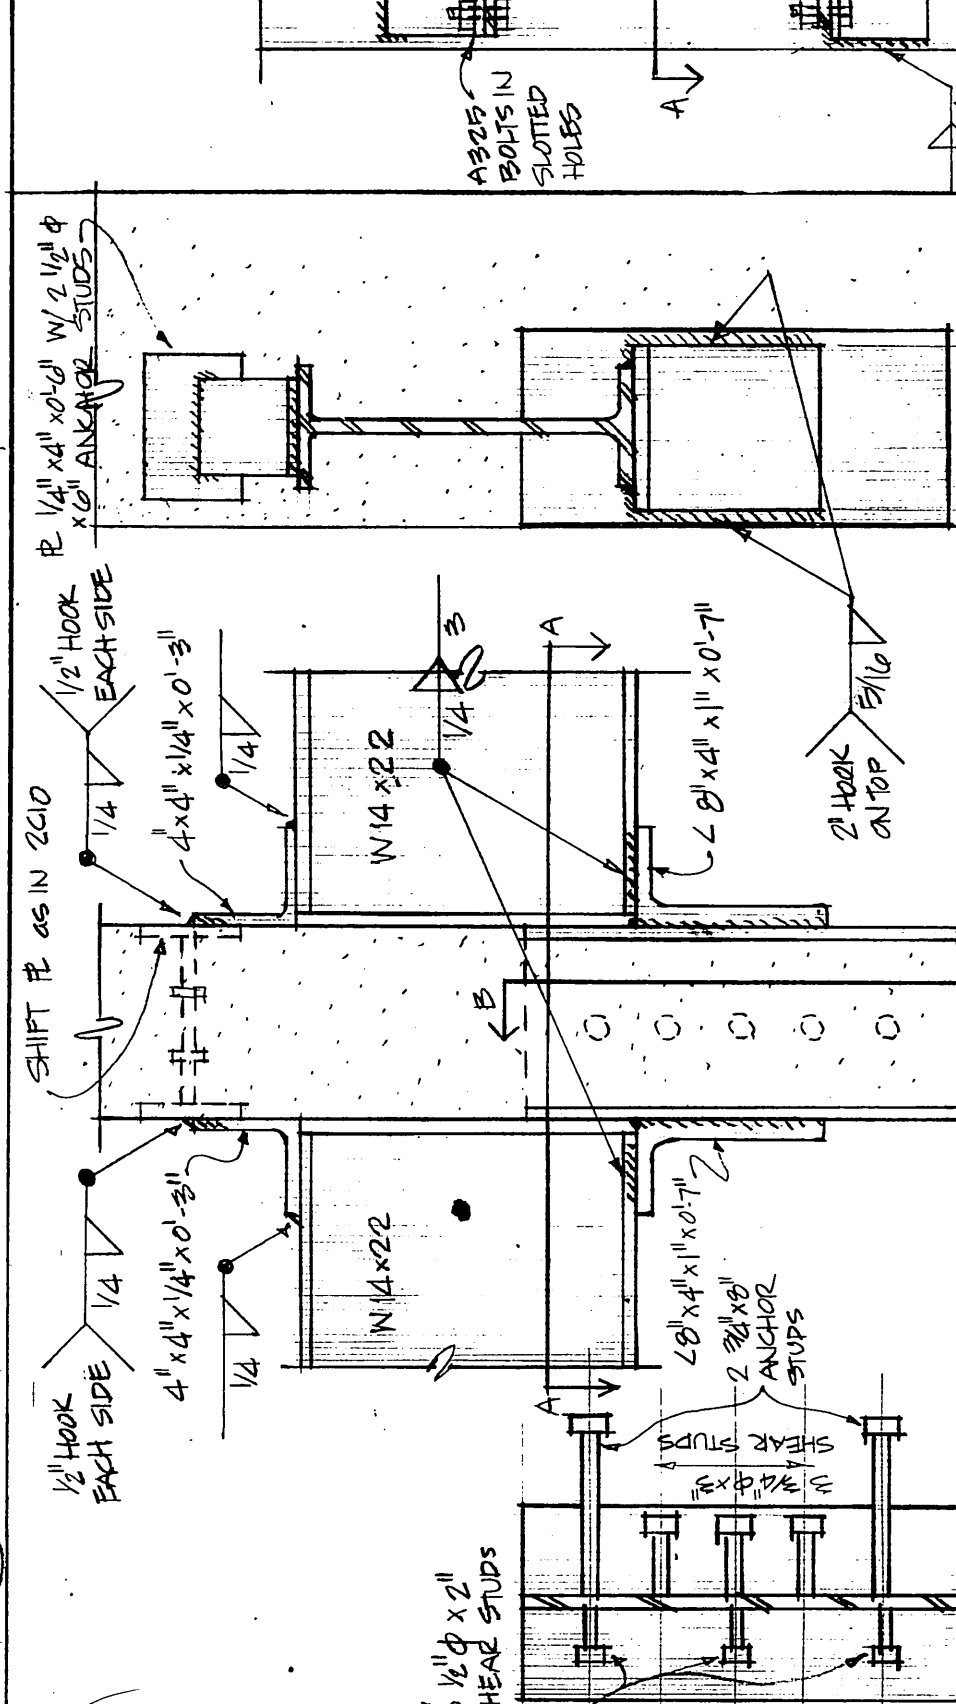

SECTION A-A

2C14 CONN. TO ST. CH. @ H.6
S-7 3/4" = 1'-0"

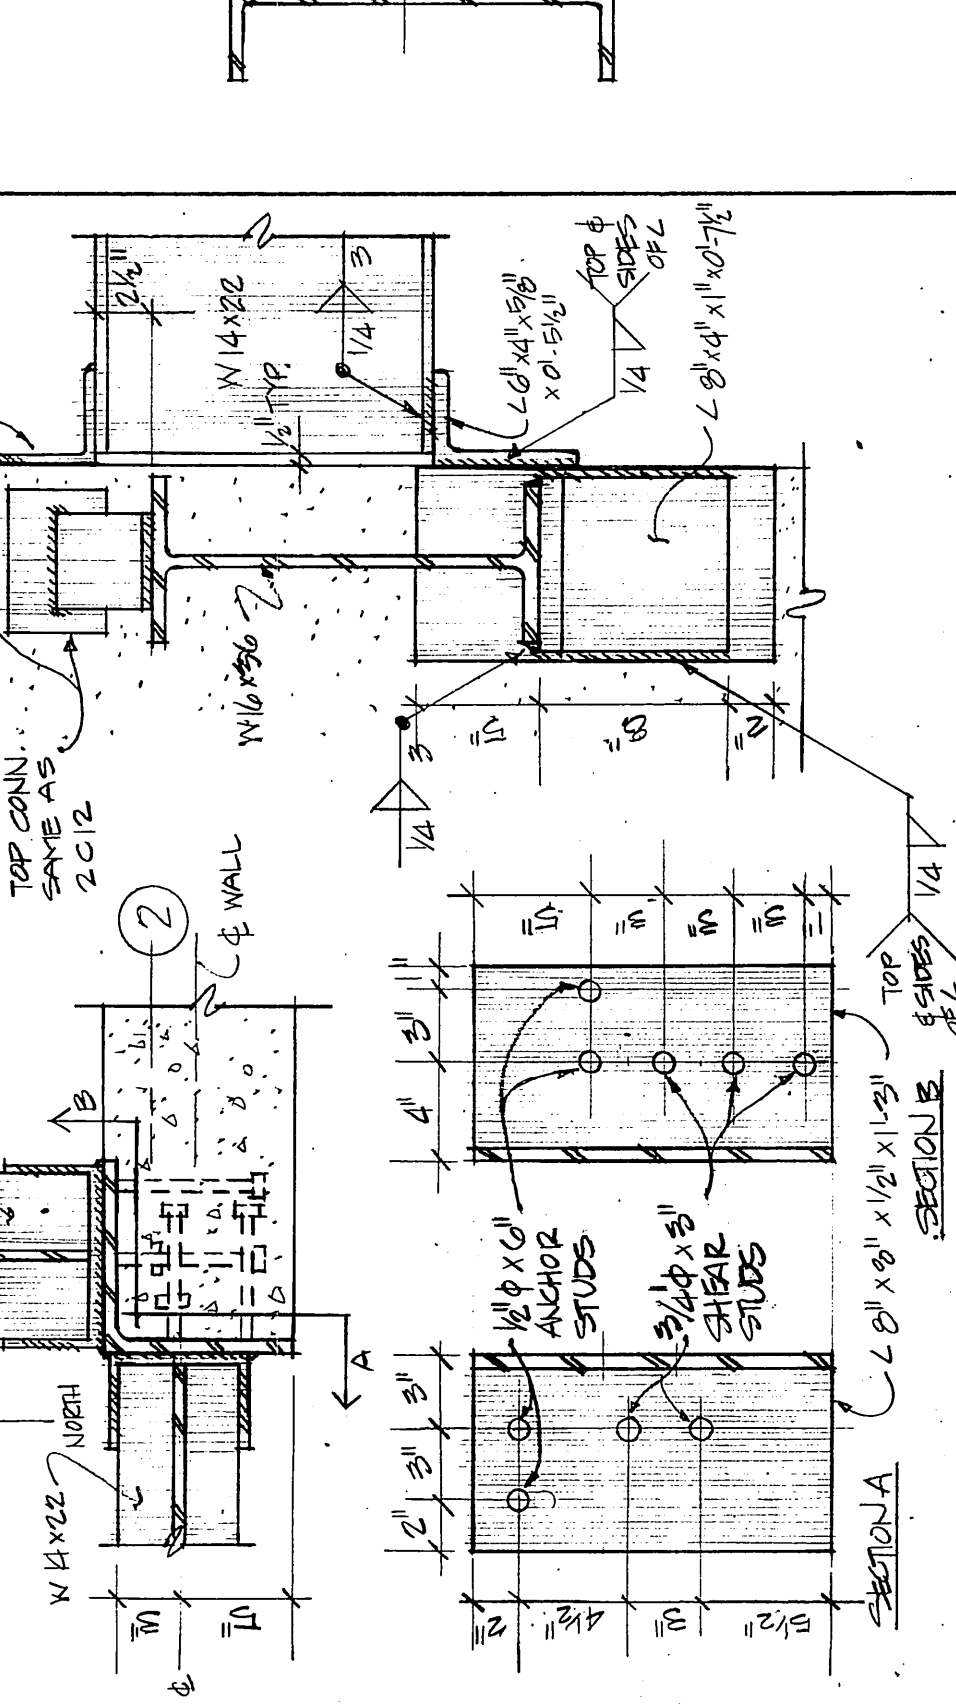

2C15 JOIST SUPPORTING BEAM TO DECK SUPPORT CONN.
S-7 3/4" = 1'-0"

ARCHITECTS - ENGINEERS - SURVEYORS
601 COLLEGE ROAD, FAIRBANKS, ALASKA 99701, PHONE: 452-1124

STATE OF ALASKA
DIVISION OF BUILDINGS

AS BUILTS
PRODUCED IN ACCORDANCE WITH CONSTRUCTION
SUBMITTED AS BUILT RECORDS AS APPROVED
BY THE STATE OF ALASKA.

FAIRBANKS
OFFICE

REGIONAL
BUILDING

DETAILED 2-0110 - BLOCK 22A - FAIRBANKS, ALASKA

STATE OF ALASKA
DIVISION OF BUILDINGS

REGISTERED
PROFESSIONAL
ENGINEER

NO. 147-0007

SHEET NO. 7 OF 9

S-7