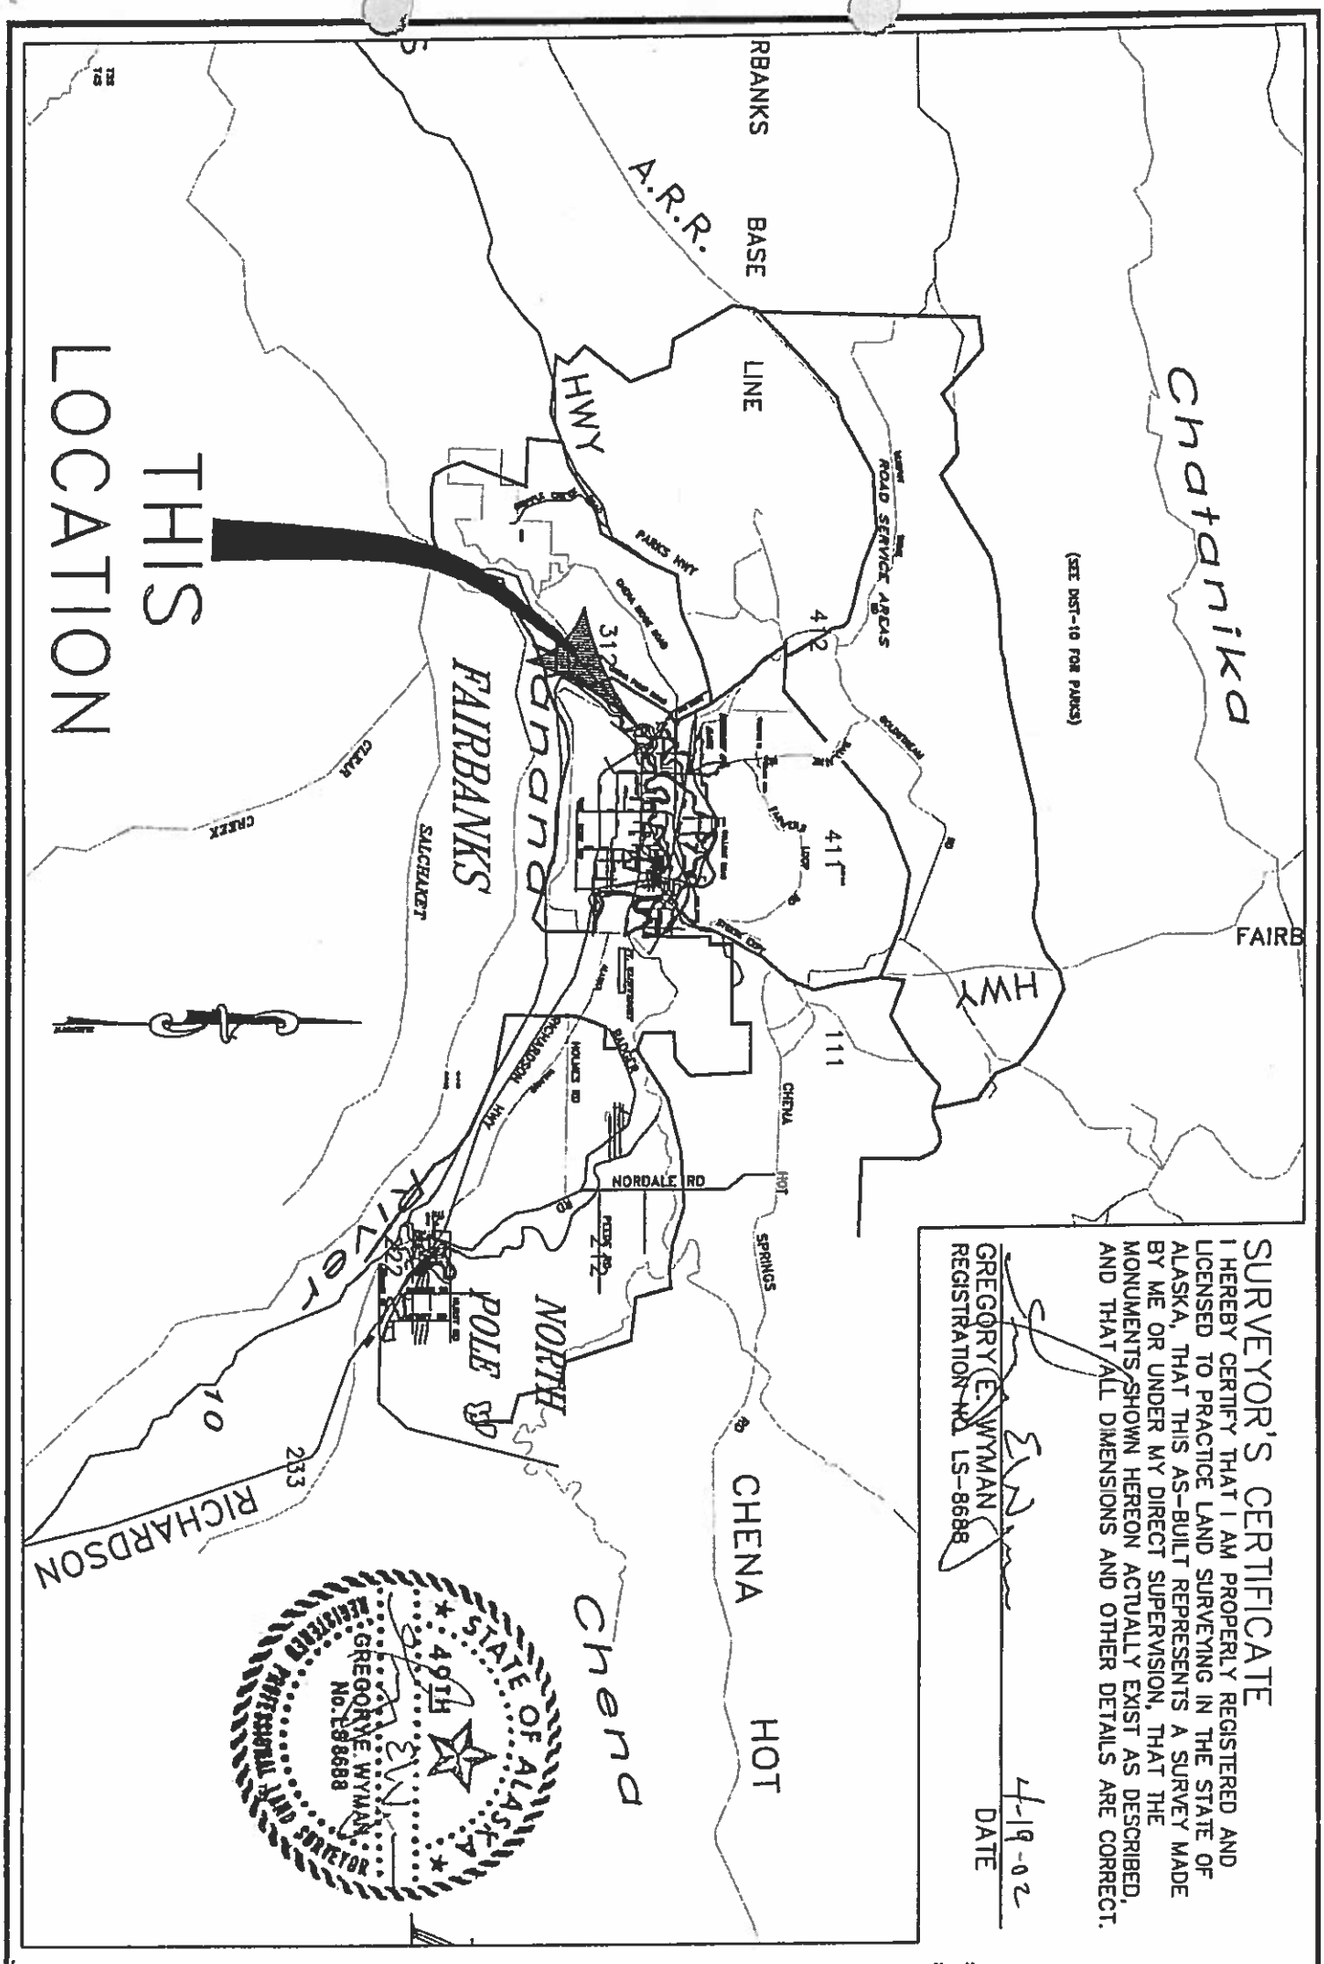


SURVEYOR'S CERTIFICATE

I HEREBY CERTIFY THAT I AM PROPERLY REGISTERED AND LICENSED TO PRACTICE LAND SURVEYING IN THE STATE OF ALASKA, THAT THIS AS-BUILT REPRESENTS A SURVEY MADE BY ME OR UNDER MY DIRECT SUPERVISION, THAT THE MONUMENTS SHOWN HEREON ACTUALLY EXIST AS DESCRIBED, AND THAT ALL DIMENSIONS AND OTHER DETAILS ARE CORRECT.

GREGORY E. WYMAN
REGISTRATION NO. LS-8688

4-19-02
DATE

STATE OF ALASKA
49TH
REGISTERED LAND SURVEYOR
GREGORY E. WYMAN
No. LS 8688

EXHIBIT "A"


PREPARED BY:	SURVEY DATE:	PREPARED FOR:	LEGAL DESCRIPTION:
G.V.E.A. P.O. BOX 71249 FAIRBANKS, AK. 99707	Beginning–10/23/96 Ending–2/13/97	STATE OF ALASKA DEPT. OF NATURAL RESOURCES DIVISION OF MINING, LAND AND WATER	SECTION 7 & 12 T. 1S R. 1W FAIRBANKS MERIDIAN AK.

100 0 50 100 200
1 inch = 100 ft.

SHEET NO:	ADL NUMBER:
1 of 2	415875

1st Original Sent to NRO

approved 5/28/02

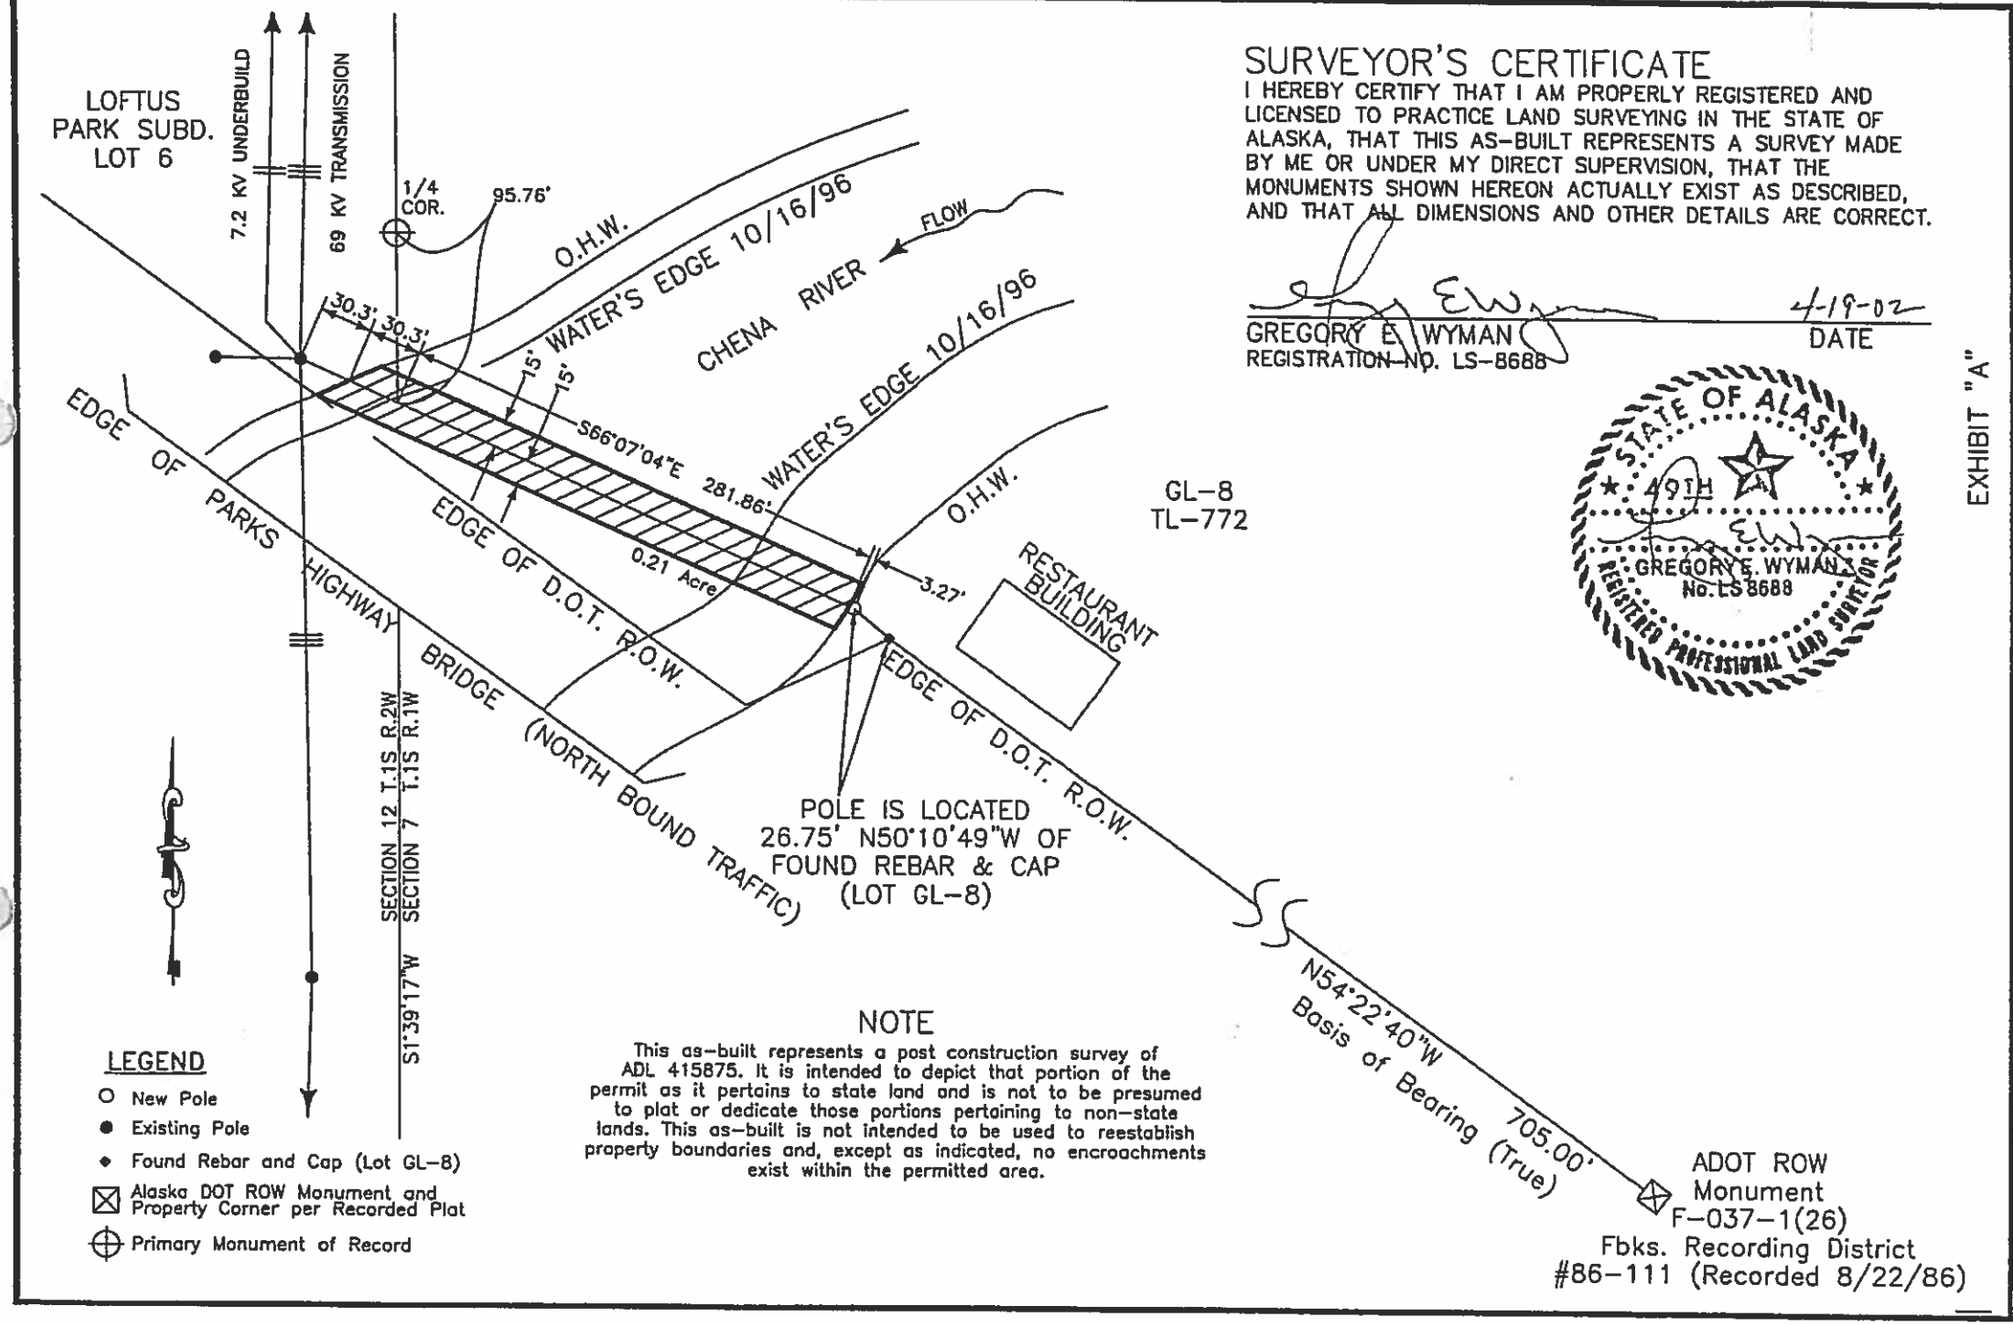

SURVEYOR'S CERTIFICATE

I HEREBY CERTIFY THAT I AM PROPERLY REGISTERED AND LICENSED TO PRACTICE LAND SURVEYING IN THE STATE OF ALASKA, THAT THIS AS-BUILT REPRESENTS A SURVEY MADE BY ME OR UNDER MY DIRECT SUPERVISION, THAT THE MONUMENTS SHOWN HEREON ACTUALLY EXIST AS DESCRIBED, AND THAT ALL DIMENSIONS AND OTHER DETAILS ARE CORRECT.

GREGORY E. WYMAN
REGISTRATION NO. LS-8688

4-19-02
DATE

STATE OF ALASKA
49TH
GREGORY E. WYMAN
No. LS 8688
REGISTERED PROFESSIONAL LAND SURVEYOR

EXHIBIT "A"

NOTE

This as-built represents a post construction survey of ADL 415875. It is intended to depict that portion of the permit as it pertains to state land and is not to be presumed to plat or dedicate those portions pertaining to non-state lands. This as-built is not intended to be used to reestablish property boundaries and, except as indicated, no encroachments exist within the permitted area.

PREPARED BY:
G.V.E.A.
P.O. BOX 71249
FAIRBANKS,AK. 99707

SURVEY DATE:
Beginning-10/23/96
Ending-2/13/97

PREPARED FOR:
STATE OF ALASKA
DEPT. OF NATURAL RESOURCES
DIVISION OF MINING, LAND AND WATER

LEGAL DESCRIPTION:
SECTION 7 & 12
T. 1S R. 1W
FAIRBANKS MERIDIAN AK.

SHEET NO: 2 of 2

ADL NUMBER: 415875

200 100 50 0 100
1 inch = 100 ft.