




6/S1 **SECTION**
SCALE: 1"=1'-0"

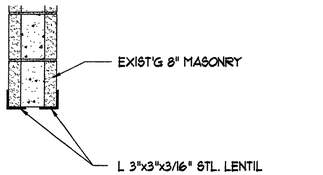


5/S1 **SECTION**
SCALE: 1"=1'-0"

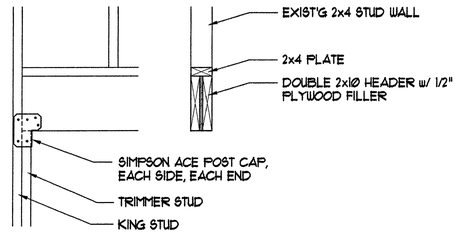


4/S1 **HEADER DETAIL**
SCALE: 1"=1'-0"

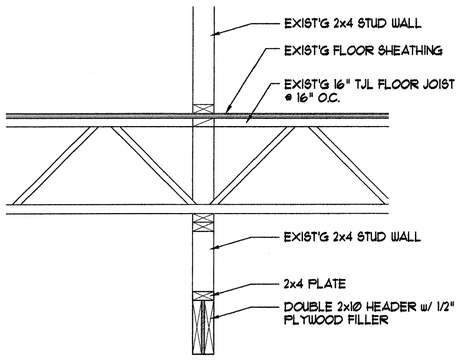

3/S1 **SECTION**
SCALE: 1"=1'-0"

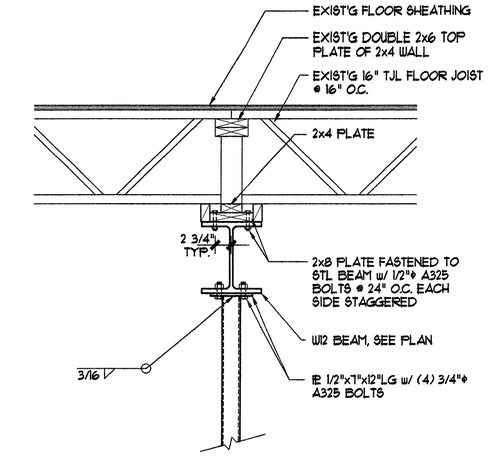

2/S1 **SECTION**
SCALE: 1"=1'-0"

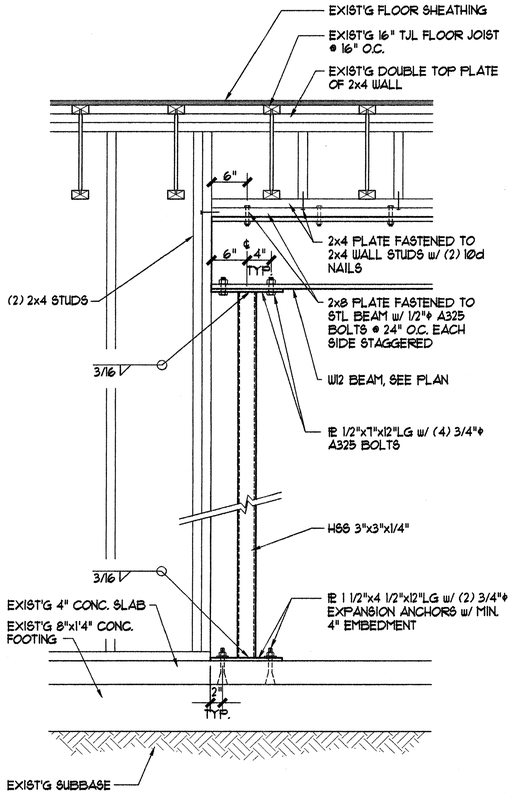

1/S1 **SECTION**
SCALE: 1"=1'-0"

GENERAL STRUCTURAL NOTES:

ALL MATERIALS AND CONSTRUCTION SHALL CONFORM TO THE REQUIREMENTS OF THE UNIFORM BUILDING CODE (UBC), 1997 EDITION, AS AMENDED BY ANY LOCAL CODES AND ORDINANCES. WHERE EXPLICIT DETAILS ARE NOT SHOWN OR DESCRIBED, THE MINIMUM REQUIREMENTS OF THE ABOVE CODE SHALL APPLY.

ALL REFERENCES TO ASTM, AISC, ACI, AWS, AISI, AITC, ECT., DESIGNATIONS REFER TO THE LATEST EDITIONS OF SAID SPECIFICATIONS. CONTACT THE OWNERS REPRESENTIVE IF INTERPRETATION OF THE DOCUMENTS IS NECESSARY.

WHERE ANY DEVIATION MAY BE NECESSARY FROM THE STRUCTURAL DRAWINGS, THE OWNERS REPRESENTATIVE SHALL BE NOTIFIED AND HIS WRITTEN APPROVAL SHALL BE OBTAINED PRIOR TO PROCEEDING WITH THE WORK.

SAWN LUMBER AND TIMBER
ALL STRUCTURAL LUMBER AND TIMBER SHALL BE HEM-FIR AS FOLLOWS:

PLATTES & LEDGERS	NO. 2
STUDS (2X6)	NO. 2 OR BETTER
STUDS (2X4)	STANDARD OR BETTER
JOISTS	NO. 2 OR BETTER
POSTS & TIMBERS	NO. 1 DENSE

BOLT HEADS AND NUTS BEARING AGAINST WOOD SHALL BE PROVIDED WITH WASHERS.

UNLESS OTHERWISE NOTED, CONFORM TO TABLE 23-II-B-1 (NAILING SCHEDULE) OF THE 97 UBC FOR MINIMUM NAILING REQUIREMENTS. ALL NAILS SHALL BE COMMON OR GALVANIZED BOX.

ASCG INCORPORATED
ENGINEERS • ARCHITECTS • SURVEYORS • INSPECTION SERVICES
301 ARCTIC SLOPE AVENUE • ANCHORAGE, AK 99518
PHONE (907) 349-3148 • FAX (907) 349-4213

ALASKA COURT SYSTEM
820 WEST 4TH AVENUE
ANCHORAGE, AK 99501-2005

COMBINED FACILITIES
KODIAK, ALASKA
DETAILS

REVISIONS	
NUMBER:	DATE:
AD 1	MAY 2, 2001
AD 2	MAY 11, 2001
CONF. DWG	JUL 10, 2001

JOB NO.:	4257
DATE:	MAR 30, 2001
DRAWN BY:	CPW
CHECKED BY:	RTB
DRAWING NO.:	S1
SHEET	OF

J:\1130\4257\ACAD14\4257-s01.dwg Tue Jul 10 16:22:59 2001

PLUMBING FIXTURE CONNECTION SCHEDULE

SYMBOL	FIXTURE	SOIL	WASTE	VENT	H.W.	C.W.	REMARKS
P-1	WATER CLOSET	3"	--	2"		1/2"	WALL MOUNT, TANK TYPE, BARRIER FREE.
P-2	LAVATORY	--	1 1/2"	1 1/2"	1/2"	1/2"	WALL HUNG, VITREOUS CHINA, BARRIER FREE.

FAN SCHEDULE

SYMBOL	LOCATION	CFM	S.P. TOT	S.P. EXT	RPM	O.V. FPM	TYPE FAN	TYPE WHL	USE	MOTOR HP/VOLTS/PH	DESIGN BASIS PRODUCT
EF-1	TOILET&215T 202AT, 202T	75	--	.25"	950	--	FC		E/A	49W/115V/1Ø	GREENHECK SP-210 WITH RCC-1 ROOF CAP. SWITCH ON W/LIGHTS.
SF-1	STORAGE 214	850	1.15	.40	1901	1932	FC		S/A	.75/230/1Ø	PACE MODEL SCF-8A

AIR OUTLET SCHEDULE

SYMBOL	UNIT SIZE	SCFM	FINISH	USE	DESIGN BASIS PRODUCT
(A)	18" x 6"	425	STEEL	SA	TITUS MODEL 30FRL, DOUBLE DEFLECTION, 3/4" BLADE SPACING
(B)	18" x 10"	550	STEEL	RA	TITUS MODEL 350RL, 3/4" BLADE SPACING, 35 DEG. FIXED DEFLECTION
(C)	16" x 16"	750	STEEL	EA	TITUS MODEL 50R, 1/2"X1/2"X1/2" ALUMINUM CORE

HEATING COIL SCHEDULE


SYMBOL	LOCATION	MBH	CFM	VEL FPM	GPM	AIR TEMP IN	AIR TEMP OUT	GLYCOL (%)	FLUID TEMP. IN	FLUID TEMP. OUT	PRESS. DROP AIR	PRESS. DROP FLUID	VALVE TYPE	RELATED SYSTEM
HC-1	ROOM 214	38.3	850	544	4.2	44	88	Ø	180	160	Ø.13	Ø.1	3-WAY	SF-1

PUMP SCHEDULE


SYMBOL	LOCATION	SERVICE	FLUID TYPE	FLUID TEMP.	GPM	HEAD FT.	RPM	MOTOR HP/VOLTS/PH	DESIGN BASIS PRODUCT
PMP-1	BOILER RM.	HEATING	WATER	180	42	26	3250	1/1HP/115V/1Ø	TACO MODEL ØØ11

HEATING UNIT SCHEDULE


SYMBOL	TYPE	GLYCOL (%)	FLUID IN	FLUID OUT	MBH	GPM	CFM	RPM	MOTOR HP/VOLTS/PH	DESIGN BASIS PRODUCT
BB-1	FINNED TUBE	WATER	180	160	.72	SEE PLAN	--	--	--	STERLING C34, 3-1/4" X 3-1/4" FINS, 40 FPF, 1" COPPER TUBE, INSTALL IN EXISTING ENCLOSURE.

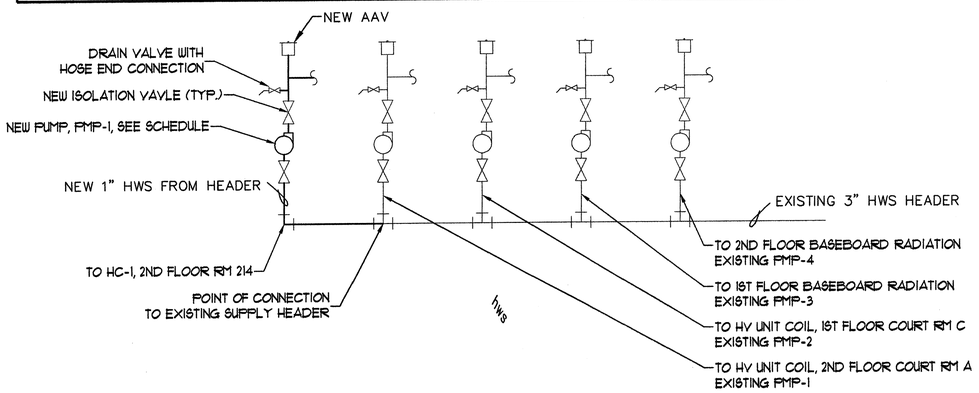

A / M-1 BOILER SUPPLY HEADER DETAIL
NO SCALE

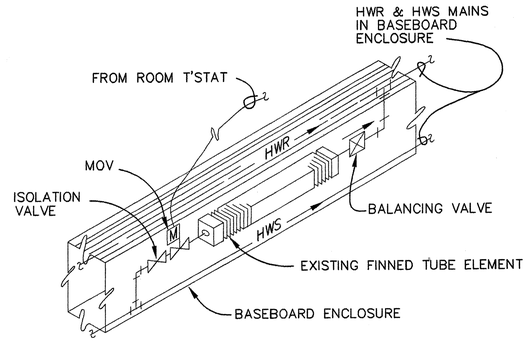

B / M-1 BASEBOARD PIPING DETAIL
NO SCALE

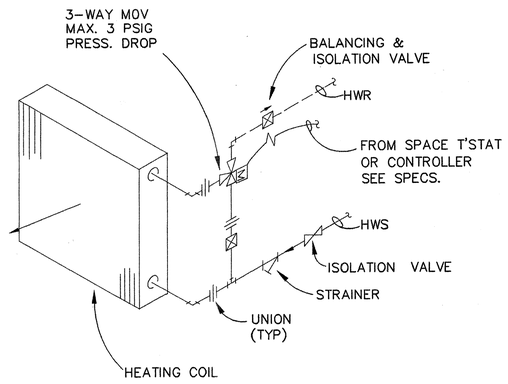

C / M-1 3-WAY VALVE COIL DETAIL
NO SCALE

LEGEND

ABBR.	EXPLANATION	SYMBOL
NIC	NOT IN CONTRACT	
	IN GENERAL CONSTRUCTION	
MOV	2-WAY MOTOR OPERATED VALVE	
MOV	3-WAY MOTOR OPERATED VALVE	
PRV	PRESSURE RELIEF VALVE	
RV	RELIEF VALVE	
CV	CHECK VALVE	
	BALL VALVE	
	GLOBE VALVE	
	BALANCING/ISOLATION VALVE	
	SQUARE HEAD COCK	
	UNION	
	PIPE ANCHOR	
	PIPE GUIDE	
	EXPANSION COMPENSATOR	
	FLOW CONTROL VALVE	
	STRAINER WITH DRAIN VALVE	
	PRESSURE GAGE	
	THERMOMETER	
S/W	SANITARY SOIL/WASTE	
PS	PUMPED SANITARY SOIL/WASTE	PS
V	VENT	V
VTR	VENT THRU ROOF	
CO	CLEANOUT	
WCO	WALL CLEANOUT	
FCO	FLOOR CLEANOUT	
CW	COLD WATER	
HW	HOT WATER	
HWC	HOT WATER CIRCULATION	
T	TEMPERED WATER	T
RL	RAIN LEADER	RL
RD	ROOF DRAIN	
SD	STORM DRAIN	SD
FD	FLOOR DRAIN	
HB	HOSE BIBB	
WH	WALL HYDRANT	
A	COMPRESSED AIR	A
SP	SPRINKLER	SP
FDC	FIRE DEPARTMENT CONNECTION	
F	FIRE	F
CWS	CHILLED WATER SUPPLY	CWS
CWR	CHILLED WATER RETURN	CWR
GS	GLYCOL SUPPLY	GS
GR	GLYCOL RETURN	GR
HWS	HEATING WATER SUPPLY	HWS
HWR	HEATING WATER RETURN	HWR
FOS	FUEL OIL SUPPLY	FOS
FOR	FUEL OIL RETURN	FOR
G	GAS	G
T'STAT	THERMOSTAT	T
T'STAT	RETURN AIR THERMOSTAT	
AAV	AUTOMATIC AIR VENT	
S/A	SUPPLY AIR	
R/A	RETURN AIR	
O/A	OUTSIDE AIR	
E/A	EXHAUST AIR	
BD	BALANCING DAMPER	
FD	FIRE DAMPER	
MOD	MOTOR OPERATED DAMPER	
	FLEXIBLE CONNECTION	
	AIR EXTRACTOR	
	AIR FOIL TURNING VANES	
	FLEXIBLE DUCT	
	SUPPLY AIR SLOT W/FLEX DUCT	
	RETURN AIR SLOT	
	DUCT IDENTIFICATION SYMBOL	21
	SUPPLY AIR REG. GRILLE, OR DIFFUSER	
	RETURN/EXHAUST AIR REG. OR GRILLE	
SL	ACOUSTICALLY LINED DUCT	
	THERMALLY INSULATED DUCT OR PIPE	
HC	HEATING COIL	
CC	COOLING COIL	
DD	DUCT DETECTOR	DD
	AIR FLOW MEASURING DEVICE	
	STATIC PRESSURE SENSOR	SP

THIS IS A STANDARD LEGEND, SOME SYMBOLS SHOWN ON LEGEND ARE NOT NECESSARILY ON THE DRAWING.

CONFORMANCE DRAWING

ASCG INCORPORATED
ENGINEERS • ARCHITECTS • SURVEYORS • INSPECTION SERVICES
301 ARCTIC SLOPE AVENUE • ANCHORAGE, AK 99518
PHONE (907) 349-5148 • FAX (907) 349-4213

ALASKA COURT SYSTEM
820 WEST 4TH AVENUE
ANCHORAGE, AK 99501-2005

COMBINED FACILITIES
KODIAK, ALASKA
LEGEND, SCHEDULES, AND DETAILS


REVISIONS

NUMBER:	DATE:
AD 1	MAY 2, 2001
AD 2	MAY 11, 2001
CONF. DWG	JUL 10, 2001

JOB NO.: 4257
DATE: JUNE 21, 2001
DRAWN BY: JBM/SCH
CHECKED BY: BSS
DRAWING NO.: M-1
SHEET 1 OF 4

Plot Time: 10:19:31
Plot Date: 06/21/01
DWG Name: JASON:A107_M-1.dwg

J:\1130\4257\ACAD14\elec\A107_M-1.dwg Tue Jul 10 14:39:15 2001

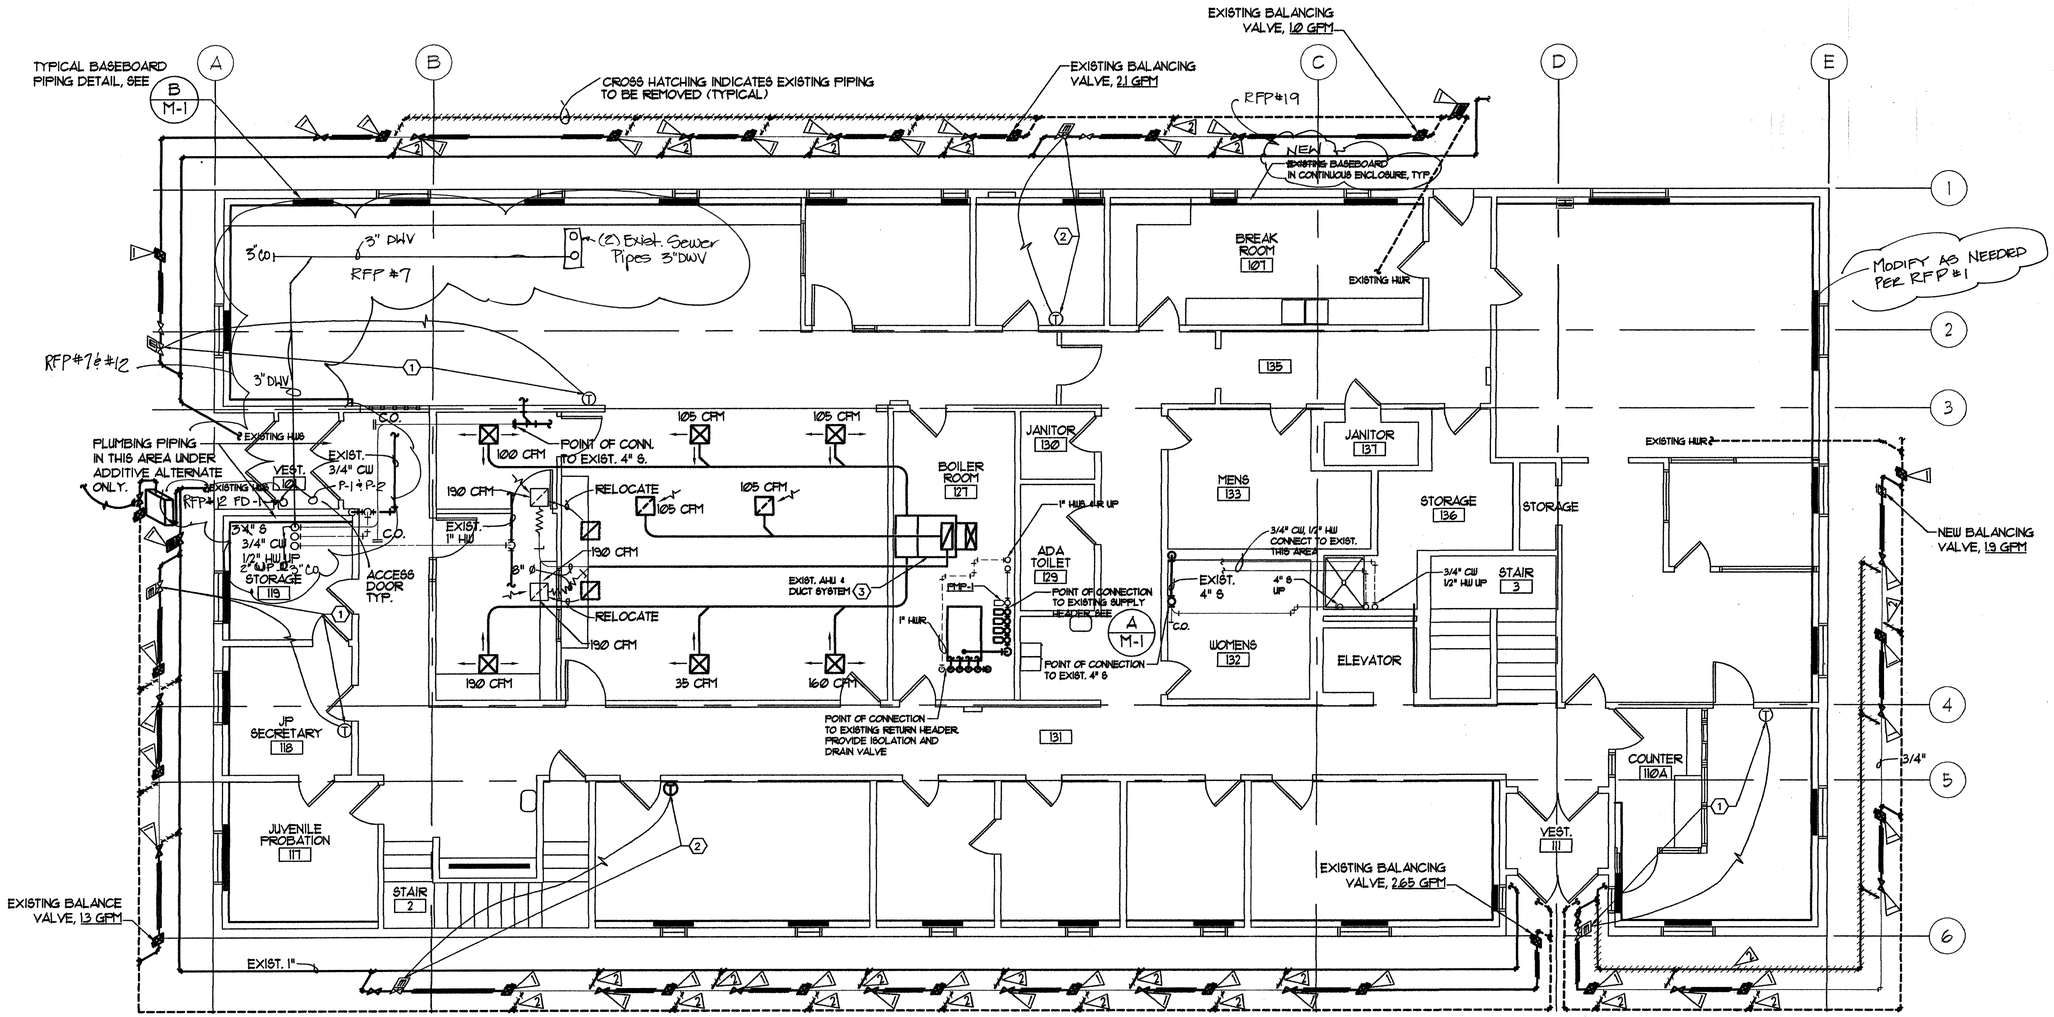

A M-2 FIRST FLOOR MECHANICAL PLAN

SCALE: 3/16" = 1'-0"

DEMOLITION NOTES:

1. REMOVE BALANCING VALVE, ISOLATION VALVE, TEE, OR OTHER.
2. REMOVE CONNECTION TO HWR OR HWS, CAP TEE

1. PROVIDE NEW PNEUMATIC THERMOSTAT AND 2-WAY CONTROL VALVE FOR ROOM ZONE CONTROL.
2. PROVIDE NEW 2-WAY CONTROL VALVE CONTROLLED BY EXISTING PNEUMATIC THERMOSTAT. CALIBRATE THERMOSTAT.
3. EXISTING VENTILATION SYSTEM TO REMAIN. RELOCATE RETURN GRILLES AS SHOWN. CLEAN ENTIRE SYSTEM INCLUDING FAN, COIL, DUCT, GRILLES, ETC.

CONFORMANCE DRAWING

ASCG INCORPORATED
ENGINEERS • ARCHITECTS • SURVEYORS • INSPECTION SERVICES
301 ARCTIC SLOPE AVENUE • ANCHORAGE, AK 99518
PHONE (907) 348-5146 • FAX (907) 348-4213

ALASKA COURT SYSTEM
820 WEST 4TH AVENUE
ANCHORAGE, AK 99501-2005

COMBINED FACILITIES
KODIAK, ALASKA


FIRST FLOOR MECHANICAL PLAN

REVISIONS	
NUMBER:	DATE:
AD 1	MAY 2, 2001
AD 2	MAY 11, 2001
CONF. DWG	JUL 10, 2001

JOB NO.:	4257
DATE:	JUNE 21, 2001
DRAWN BY:	JBM
CHECKED BY:	BSS

DRAWING NO.: M-2
SHEET 2 OF 4

J:\1130\4257\ACAD14\elec\A107_M-2.dwg Tue Jul 10 14:38:21 2001
Plot Time: 10:20:38
Plot Date: 06/21/01
DWG Name: JASON::A107_M-2.dwg

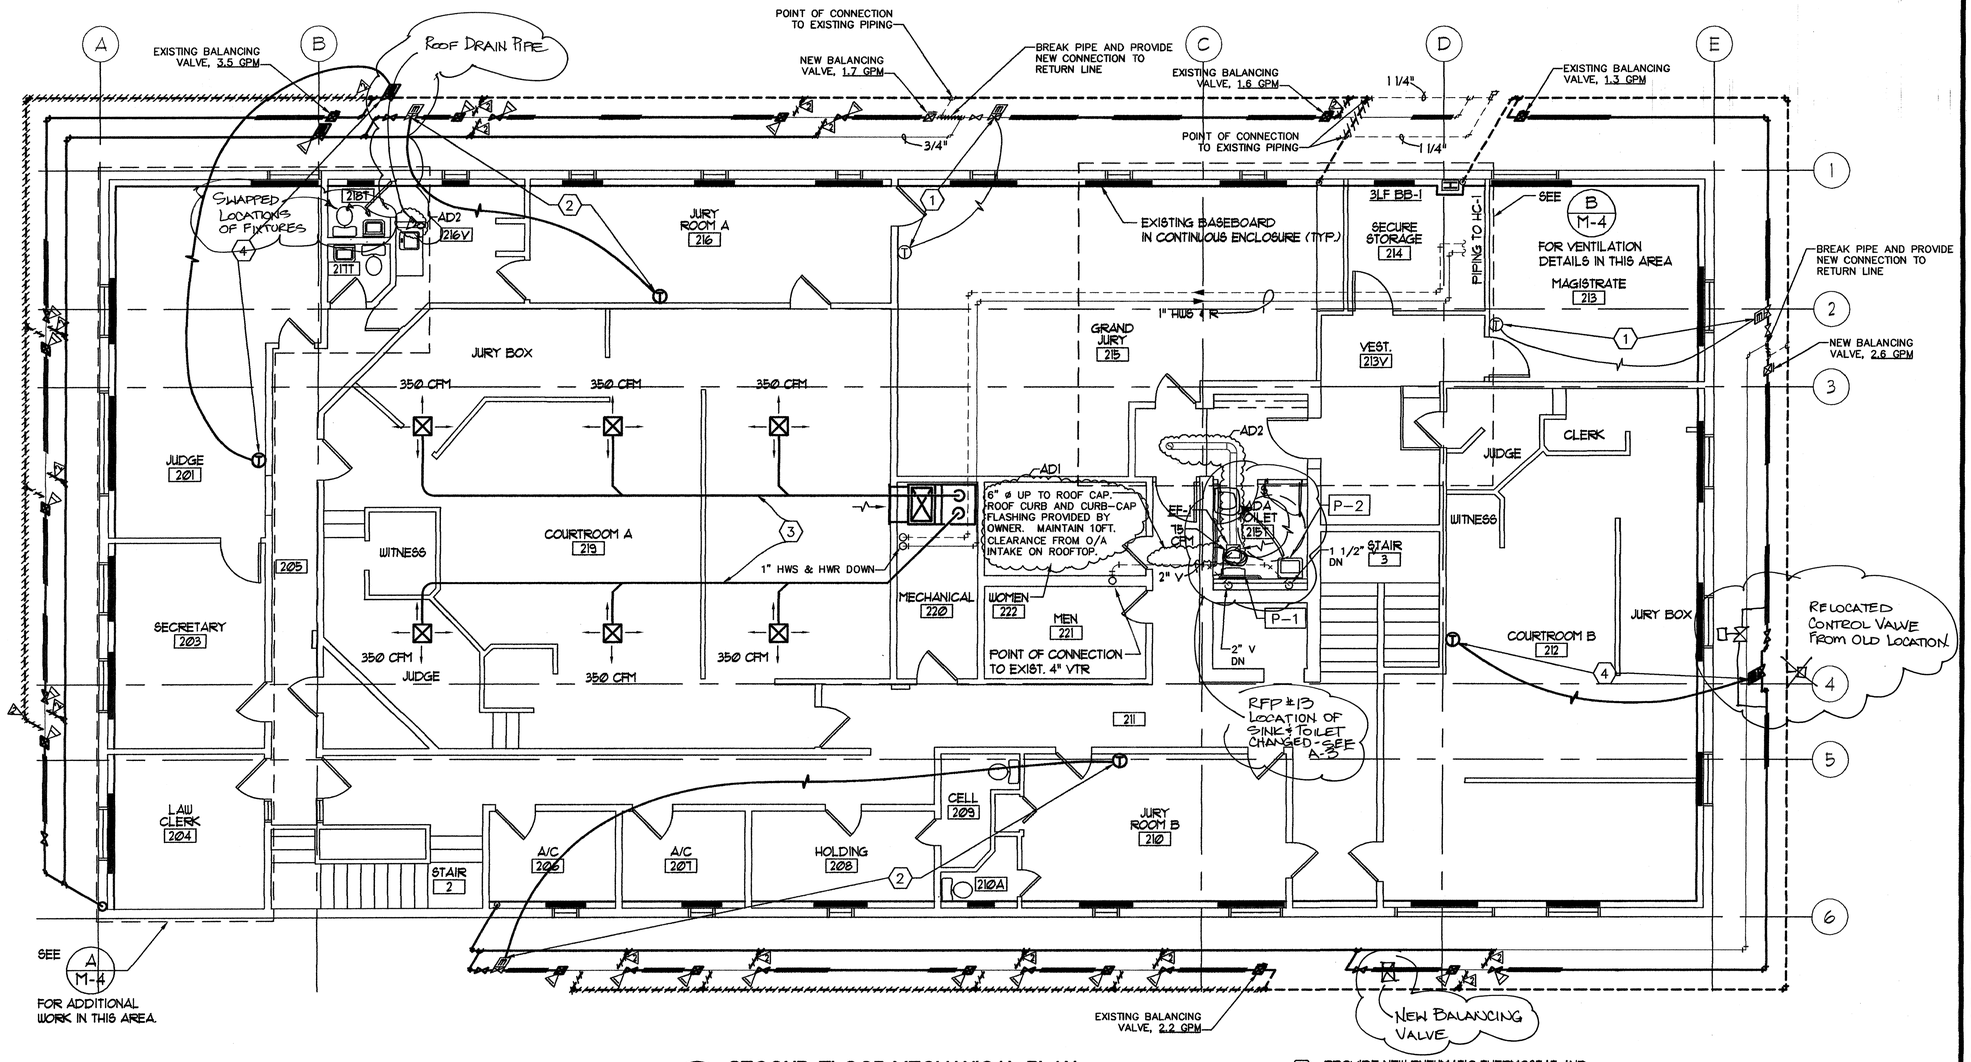

A M-3 SECOND FLOOR MECHANICAL PLAN

SCALE: 3/16" = 1'-0"

DEMOLITION NOTES:

1. REMOVE BALANCING VALVE, ISOLATION VALVE, TEE, OR OTHER.
2. REMOVE CONNECTION TO RETURN OR SUPPLY, CAP TEE.
3. UNDER ADDITIVE ALTERNATE, REMOVE SINK IN ROOM 216V; CAP HOT AND COLD WATER, VENT AND WASTE IN WALL. (AD2)

1. PROVIDE NEW PNEUMATIC THERMOSTAT AND 2-WAY CONTROL VALVE FOR ROOM ZONE CONTROL.
2. PROVIDE NEW 2-WAY CONTROL VALVE CONTROLLED BY EXISTING PNEUMATIC THERMOSTAT. CALIBRATE THERMOSTAT.
3. EXISTING VENTILATION SYSTEM TO REMAIN. CLEAN ENTIRE SYSTEM INCLUDING FAN, COIL, DUCT, GRILLES, ETC.
4. EXISTING THERMOSTAT AND CONTROL VALVE TO REMAIN. CALIBRATE THERMOSTAT.

CONFORMANCE DRAWING

ASCG INCORPORATED
ENGINEERS • ARCHITECTS • SURVEYORS • INSPECTION SERVICES
301 ARCTIC SLOPE AVENUE • ANCHORAGE, AK 99518
PHONE (907) 349-5148 • FAX (907) 349-4213

ALASKA COURT SYSTEM
820 WEST 4TH AVENUE
ANCHORAGE, AK 99501-2005


COMBINED FACILITIES
KODIAK, ALASKA

SECOND FLOOR MECHANICAL PLAN


REVISIONS	
NUMBER:	DATE:
AD 1	MAY 2, 2001
AD 2	MAY 11, 2001
CONF. DWG	JUL 10, 2001

JOB NO.:	4257
DATE:	JUNE 21, 2001
DRAWN BY:	JBM
CHECKED BY:	BSS
DRAWING NO.:	M-3
SHEET	3 OF 4


J:\1130\4257\ACAD14\elec\A107_M-3.dwg Tue Jul 10 14:36:53 2001
Plot Time: 10:20:04
Plot Date: 06/21/01
DWG Name: JASON::A107_M-3.dwg

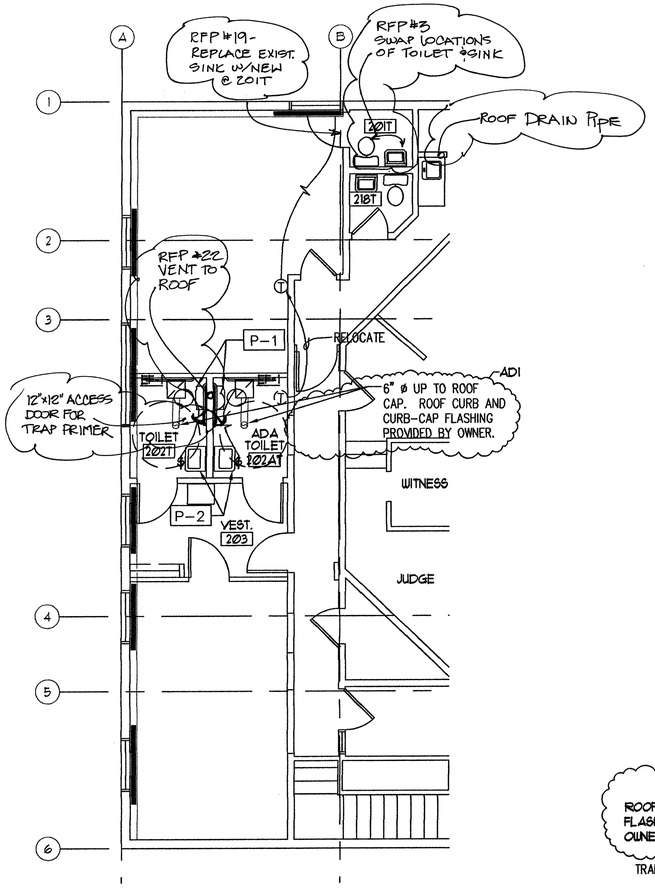


A M-4 **SECOND FLOOR MECHANICAL PLAN**
SCALE: 3/16" = 1'-Ø"

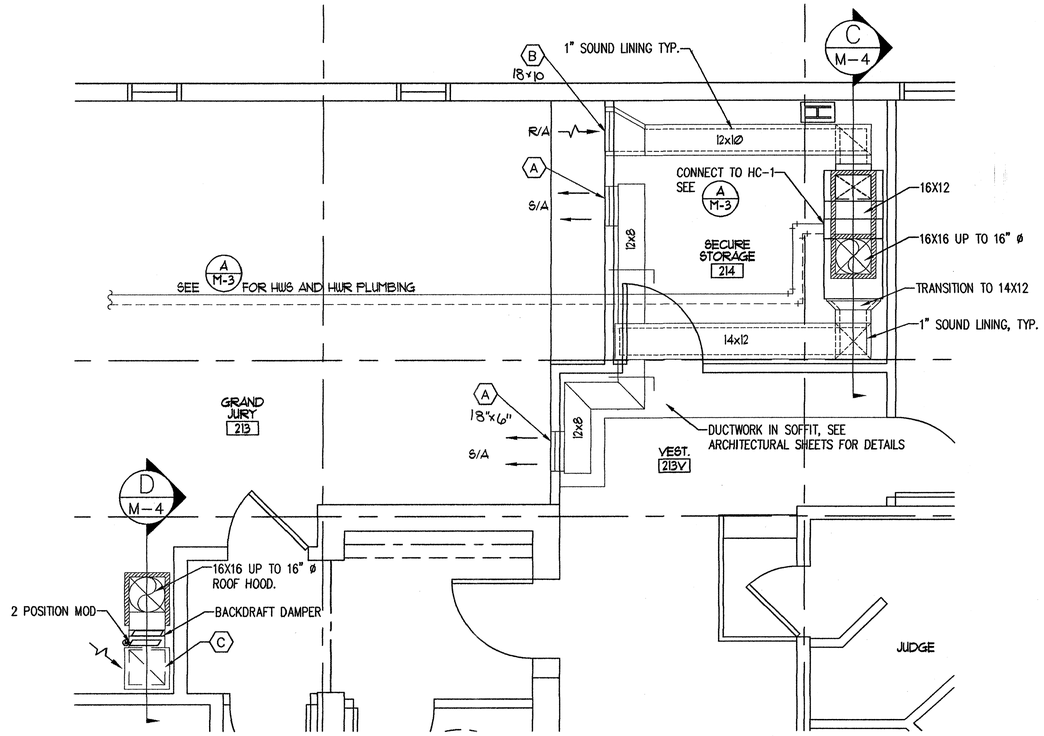

B M-4 **ENLARGED PLAN VIEW, SF-1**
SCALE: 3/8" = 1'-Ø"

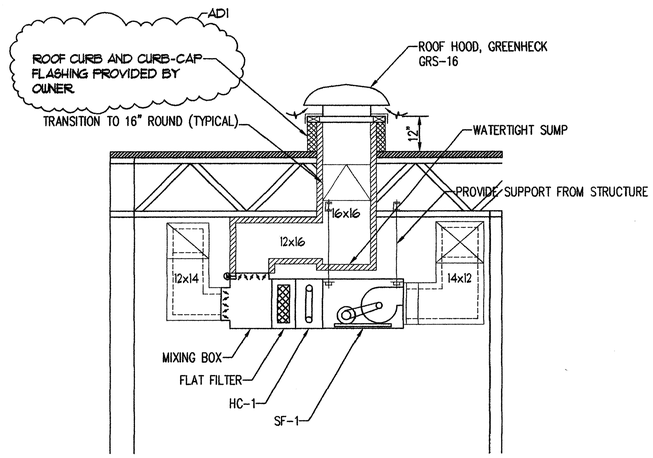

C M-4 **SF-1 SECTION**
SCALE: 1/2" - 1'-Ø"

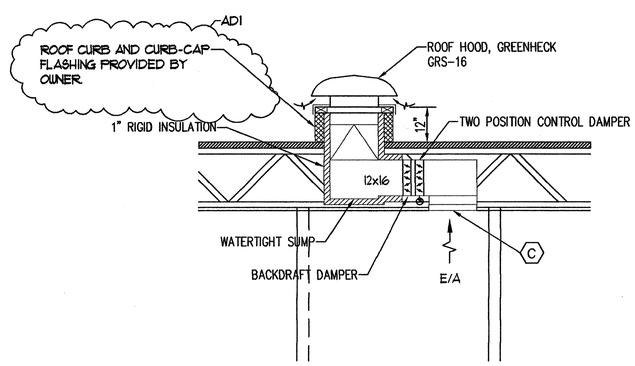

D M-4 **RELIEF HOOD SECTION**
SCALE: 1/2" = 1'-Ø"

CONFORMANCE DRAWING

ASCG INCORPORATED
ENGINEERS • ARCHITECTS • SURVEYORS • INSPECTION SERVICES
301 ARCTIC SLOPE AVENUE • ANCHORAGE, AK 99518
PHONE (907) 349-5145 • FAX (907) 349-4213

ALASKA COURT SYSTEM
820 WEST 4TH AVENUE
ANCHORAGE, AK 99501-2005

COMBINED FACILITIES
KODIAK, ALASKA

SECOND FLOOR MECHANICAL PLAN

REVISIONS	
NUMBER:	DATE:
AD 1	MAY 2, 2001
AD 2	MAY 11, 2001
CONF. DWG	JUL 10, 2001

JOB NO:	4257
DATE:	JUNE 21, 2001
DRAWN BY:	JBM/SCH
CHECKED BY:	BSS
DRAWING NO:	M-4
SHEET	4 OF 4

J:\1130\4257\ACAD14\elec\A107_M-4.dwg Tue Jul 10 14:35:31 2001
Plot Time: 10:20:6
Plot Date: 06/21/01
DWG Name: JASON:A107_M-4.dwg

PANEL: R

PROJECT: KODIAK COMBINED FACILITIES

LUGS ■ CB □ | SURF ■ FLSH □ | THRUFEED LGS □ SHNT TRP □ SBFD LGS □ | SUBFEED BKR □ ISO GRND BAR □ SOLID NEUTRAL ■

120/208 VOLTS | 3 PH | 4 WIRE | 225 AMP | 10000 AIC

CIRCUIT DESCRIPTION	KVA	AMP	CKT	CKT	AMP	KVA	CIRCUIT DESCRIPTION
~~LIGHTS~~-ROOM #120 - LIGHTS	0.8	20/1	1	2	20/1	1.0	RECEPTACLES-~~CLERKS~~ OFFICES 122-124
~~LIGHTS~~-ROOM #120 - RECPT.	0.9	20/1	3	4	20/1	0.9	~~RECEPTACLES-COUNTER 121, MICROFILM 122~~
LIGHTS-ROOM ~~#123~~, 122-124	0.5	20/1	5	6	20/1	0.4	RECEPTACLES-TELEPHONE ROOM
~~SPARE~~ RECPT. - ROOM 126		20/1	7	8	20/1	0.6	RECEPTACLES-~~CLERKS~~, OFFICES~~125~~, 120-126
~~SPARE~~ RECPT - ROOM 120		20/1	9	10	20/1	0.8	~~RECEPTACLES-GRAND JURY 225~~, HT. PUMP-200
~~SPARE~~ RECPT - ROOM 120		20/1	11	12	20/1	1.0	RECEPTACLES-~~GRAND JURY 225, WMOS. 213~~ 205
~~SPACE~~ ROOF TOP			13	14	20/1	1.2	RECEPTACLES-~~TOILET 223, STORAGE 224~~ 207-B
~~SPACE~~ MAKE-UP			15	16	15		RECPT - ROOM 191
~~SPACE~~ UNIT			17	18	/	1.3	~~3/4 HP FAN-STORAGE 224~~ RECPT- 126
~~SPACE~~ RECPT. ROOM 325			19	20	3		RECPT - ROOM 208
~~SPACE~~ RECPT. ROOM 224			21	22	20/1	0.8	~~RECEPTACLES-JURY 204, JUDGE 201~~ *PUMPS-
~~SPACE~~ RECPT. ROOMS 226-228			23	24	20/1	0.8	RECEPTACLES-~~VEST 203, TOILETS 202, 202A~~* 208
SPACE			25	26	20/1	1.0	RECEPTACLES-RM ~~215~~ * 215
SPACE			27	28	20/1	1.4	RECEPTACLES-~~LAW CLERK 214~~ *222
SPACE			29	30	15/1	0.5	~~1/2 HP PUMP-BOILER RM 127~~ RECPT - 223
SPACE			31	32			SPACE
SPACE			33	34			SPACE
SPACE			35	36			SPACE
SPACE			37	38			SPACE
SPACE			39	40			SPACE
SPACE			41	42			SPACE

CONNECTED LOAD:	13.9	KVA	39	A	REMARKS:
DEMAND LOAD:	13.9	KVA	39	A	*=ADDITIVE ALTERNATE, PROVIDE SPARE UNDER BASE BID.
DEMAND + CONT.	17.4	KVA	48	A	
DATE: 3/20/2001					
REV:					

DOOR LOCK ROOM 122

118

LIGHTING FIXTURE SCHEDULE

KEY	LAMPS NO.	LAMPS TYPE	MTG. HT.	DESCRIPTION	MANUFACTURERS NO.
A/150	4	F32T8 3500K	SURFACE CEILING	SURFACE ACRYLIC WRAPAROUND DIFFUSER STYLE. ELECTRONIC BALLAST.	LITHONIA AW432
B/75	2	F32T8 3500K	SURFACE CEILING	MATCH TYPE A EXCEPT 2-LAMP.	LITHONIA 2AW232
E/25	FURNISHED WITH FIXTURE		ON WALL AT CLG	BATTERY POWERED EMERGENCY LIGHT, 6 VOLT, 16 WATT, CONNECT TO UNSWITCHED LIGHTING CIRCUIT IN AREA SERVED.	LITHONIA #6 ELM2
⊗	–	–	CEILING OR WALL AT CEILING	SELF POWERED EXIT SIGN, SINGLE OR DOUBLE FACE, CEILING OR WALL MOUNT AS INDICATED ON PLAN. RED FACEPLATE, WHITE HOUSING, 15 YEAR LIFE.	EVENLITE SL SERIES
ER **IN BASIC BID	VARIES	F32T8 3500K	----	RELAMP EXISTING & RELOCATED FIXTURES WITH NEW LAMPS	
ER **IN ADD. ALT. BID #2	VARIES	PARA-LITE, SPECTRA 5000-F40-T12MB	----	RELAMP EXISTING & RELOCATED FIXTURES WITH NEW FULL SPECTRUM LAMPS	

AD2

ELECTRICAL EQUIPMENT LIST

EQUIP. SYMBOL	DESCRIPTION	MANUFACTURER'S NUMBER
◇1	2 PIECE SURFACE STEEL RACEWAY, TWO COMPARTMENT, NOMINAL CHANNEL SIZE 1 3/4" X 4 3/4", IVORY COLOR, CAT 5 RADIUS FITTINGS. PROVIDE DUPLEX RECEPTACLES WHERE INDICATED. PROVIDE SINGLE-GANG DEVICE BRACKETS AND BLANK COVERS FOR COMM/DATA MICROPHONE AND TV OUTLETS WHERE INDICATED. PROVIDE CABLE RETAINING CLIPS 4 FEET OC, BOTH COMPARTMENTS.	WIREMOLD 4000 SERIES
◇2	SAME AS ITEM 1 EXCEPT COLOR TO MATCH MOUNTING SURFACE	WIREMOLD 4000 SERIES

LEGEND

ABBR.	EXPLANATION	SYMBOL
XFMR	TRANSFORMER	T
NIC	NOT IN CONTRACT	
CKT	CIRCUIT – NUMBER AS NOTED (TYP.)	CKT–XX
UON	UNLESS OTHERWISE NOTED	
A/100	LIGHTING FIXTURE DESIGNATION – SEE SCHEDULE	
ETR	EXISTING TO REMAIN	
N.L.	NIGHT LIGHT	
WP	WEATHERPROOF	
E	EMERGENCY LIGHT, CIRCUIT, PANEL	
C	CONDUIT, CONCEALED. SIZE AS NOTED (TYP.)	
	CONDUIT, UNDERGROUND OR UNDERFLOOR	
	CONDUIT, EXPOSED	
FLEX	CONDUIT, FLEXIBLE	
	MULTI-OUTLET ASSEMBLY–RECEPTACLES AS INDICATED	–M–
	HOMERUN TO PANEL/CIRCUITS AS NOTED	
#X	WIRE COUNT OF # 12 UON/SPECIFIED	
UP	CONDUIT UP	
DN	CONDUIT DOWN	
PNL	PANELBOARD – SEE SCHEDULES	
	REFER TO INDICATED NOTE	(1)
RECPT	TELEPHONE RECEPTACLE	
	TELEPHONE RECEPTACLE IN FLOOR BOX	
	DUPLEX RECEPTACLE – NEMA 5–20R	
	QUADRUPLEX RECEPTACLE – NEMA 5–20R	
	DUPLEX RECEPTACLE – NEMA 5–20R GFCI TYPE	
	ISOLATED GRD DUPLEX RECEPTACLE – NEMA 5–20R	IG
	DUPLEX RECEPTACLE – NEMA 5–20R SPLIT WIRED	
	DUPLEX RECEPTACLE IN FLOOR BOX	
	RECEPTACLE – NEMA CONFIGURATION AS NOTED	
	TELEVISION RECEPTACLE	TV
J–BOX	JUNCTION BOX	J
	SINGLE PHASE MOTOR – SIZE AS INDICATED	
	THREE PHASE MOTOR – SIZE AS INDICATED	
	MOTOR CONTROLLER	
	MOTOR DISCONNECT	
	COMBINATION STARTER/DISCONNECT	
SW	SWITCH – SINGLE POLE	$
	SWITCH – TWO POLE	$2
	SWITCH – THREE WAY	$3
	SWITCH – FOUR WAY	$4
	SWITCH – DIMMING TYPE	$D
	SWITCH – WITH PILOT LIGHT	$P
	SWITCH – THERMAL OVERLOAD	$T
	SWITCH – LOW VOLTAGE	$L
	CALL–IN SWITCH	$X
	SWITCH – WITH TIMER	$S
FS	SPRINKLER FLOW SWITCH	FS
TS	SPRINKLER TAMPER SWITCH	TS
	PHOTOELECTRIC TYPE SMOKE DETECTOR	P
	IONIZATION TYPE SMOKE DETECTOR	I
	HEAT DETECTOR– F INDICATES FIXED TEMP ONLY C INDICATES ABOVE CEILING	H F135 C
	RESIDENTIAL TYPE SMOKE DETECTOR	R
	DUCT MOUNTED SMOKE DETECTOR	DD
	FIRE ALARM HORN/STROBE	H
	FIRE ALARM STROBE	S
	WEATHERPROOF FIRE ALARM HORN	H
	FIRE ALARM MANUAL STATION	F
FACP	FIRE ALARM CONTROL PANEL	FACP
FANN	FIRE ALARM REMOTE ANNUNCIATOR	FANN
T'STAT	THERMOSTAT	T
	MICROPHONE OUTLET	M
	PUSHBUTTON SWITCH	*
TTB/C	TELEPHONE TERMINAL BOARD/CABINET	TTB
STBY	STANDBY CIRCUIT	
PC	PHOTOCELL	PC
TC	TIMECLOCK	
	CLOCK	
	COMBINATION CLOCK/SPEAKER	
	MAGNETIC DOOR SWITCH	MS
	SECURITY ALARM PANEL	SA
	SOUND/CLOCK CONSOLE	SCC
SPKR	SPEAKER ASSEMBLY – CEILING MOUNTED	S
	WALL MOUNTED SPEAKER ASSEMBLY	S
	BELL	B
	COMBINATION SPEAKER/CALL–IN SWITCH	SW
CCTV	CLOSED–CIRCUIT TELEVISION CAMERA	CCTV
	EXIT SIGN – SELF POWERED	
	BATTERY–POWERED EMERGENCY LIGHT	
	LIGHTING FIXTURES – VARIOUS TYPES AS NOTED	
	SHADING INDICATES EMERGENCY LIGHTING FIXTURE	
	DIAGONAL LINE INDICATES STANDBY FIXTURE	

THIS IS A STANDARD LEGEND, ALL SYMBOLS SHOWN ON LEGEND ARE NOT NECESSARILY ON THE DRAWING(S).

CONFORMANCE DRAWING

MBA Consulting Engineers, Inc.
3612 Spenard Road, Suite 203 • Anchorage, AK 99517
(907) 274-2822 • FAX (907) 274-0914
Email: mbaconsulting@alaska.com

ASCG INCORPORATED
ENGINEERS • ARCHITECTS • SURVEYORS • INSPECTION SERVICES
301 ARCTIC SLOPE AVENUE • ANCHORAGE, AK 99518
PHONE (907) 349-3148 • FAX (907) 349-4213

ALASKA COURT SYSTEM
820 WEST 4TH AVENUE
ANCHORAGE, AK 99501-2005

COMBINED FACILITIES
KODIAK, ALASKA


EQUIPMENT LIST
SCHEDULES

REVISIONS

NUMBER:	DATE:
AD 1	MAY 2, 2001
AD 2	MAY 11, 2001
CONF. DWG	JUL 10, 2001

JOB NO.: 4257
DATE: JUNE 21, 2001
DRAWN BY: SNS
CHECKED BY: MJL
DRAWING NO.: E1
SHEET OF

J:\1130\4257\ACAD14\elec\A107_E1.dwg Tue Jul 10 14:33:24 2001
Plot Time: 10:54:26
Plot Date: 07/10/01
DWG Name: SAM S::A107_E1.dwg

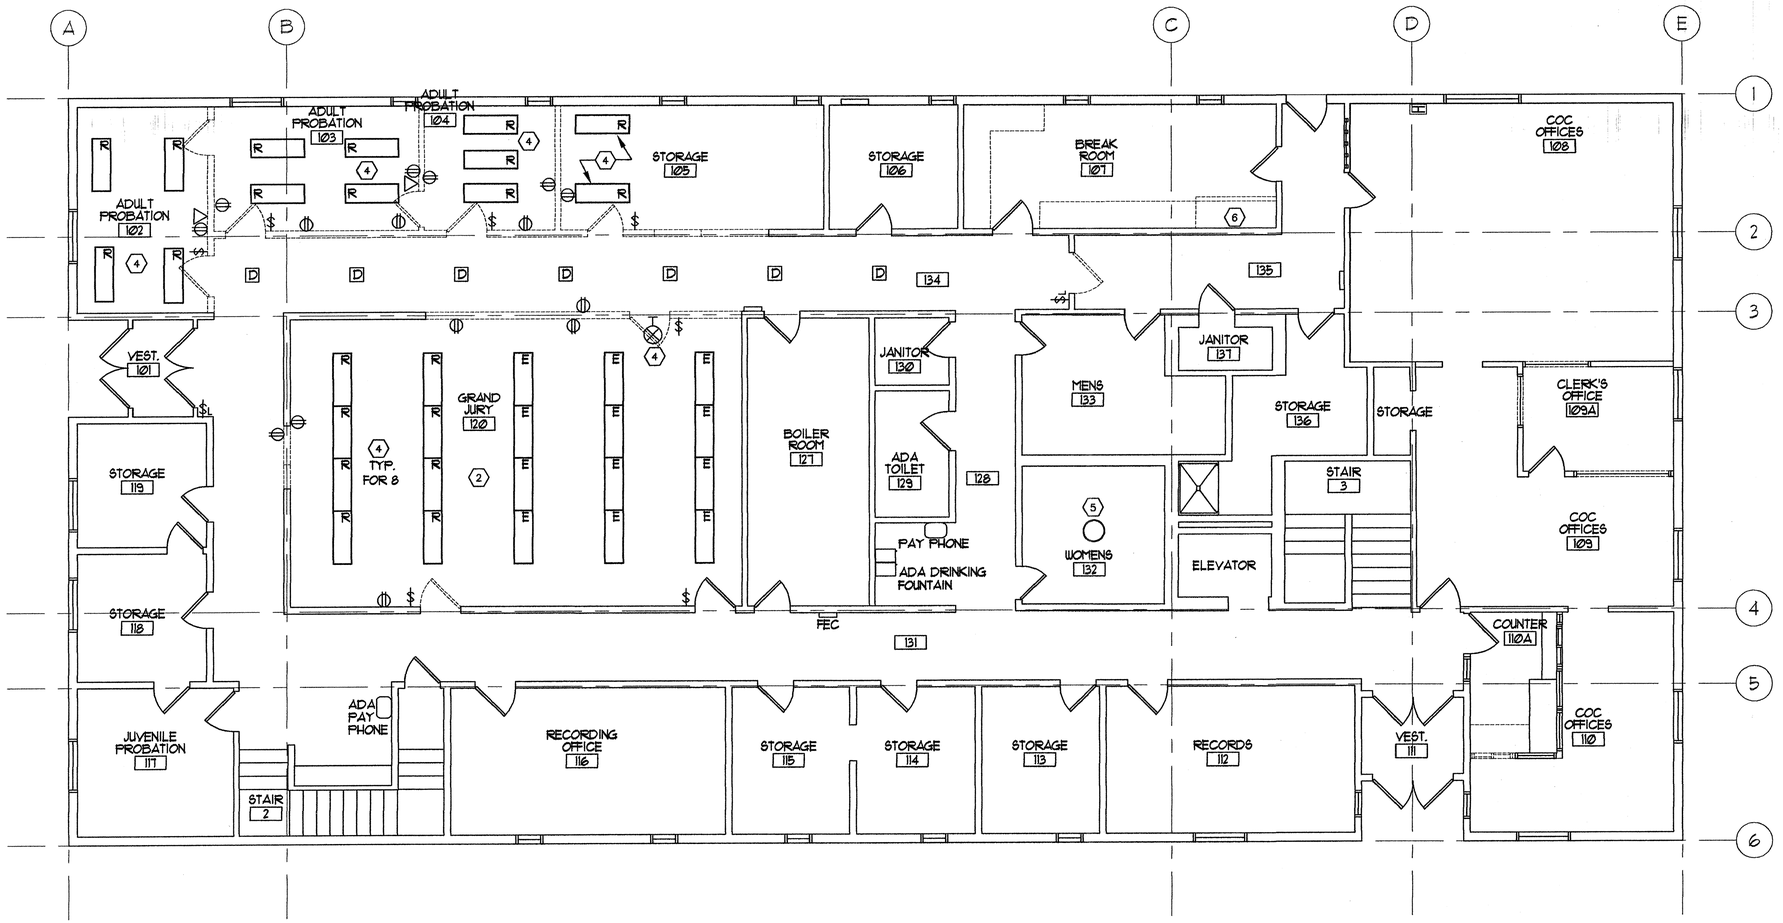

1/E2 FIRST FLOOR ELECTRICAL DEMOLITION PLAN

SCALE: 3/16" = 1'-0"

NOTES:

1. REMOVE RECEPTACLES AND OUTLETS FROM NEW DOOR OPENINGS AND FROM WALLS SCHEDULED FOR DEMOLITION. ASTERISK INDICATES ADDITIVE ALTERNATE #1.
2. REMOVE AUDIO AND VIDEO SYSTEMS OUTLETS AND UNUSED SURFACE MOUNTED RACEWAYS IN GRAND JURY ROOM. REMOVE AUDIO/RECORDING AND VIDEO EQUIPMENT AND TURN OVER TO OWNER.
3. REMOVE EXISTING LIGHTING FIXTURES AND SWITCHES THAT ARE SHOWN. EXISTING EQUIPMENT NOT SHOWN ON THIS PLAN REMAINS IN PLACE.
4. RELOCATE EXISTING FIXTURES TO CLERKS OFFICE #110
5. REMOVE EXISTING FIXTURES. REINSTALL AFTER CEILING WORK IS COMPLETE.
6. DISCONNECT EXISTING COOKTOP. REMOVE CONDUCTORS, PROVIDE BLANK COVER PLATE.

D=DEMOLISH FIXTURE
R=RELOCATE FIXTURE
E=EXISTING FIXTURE TO REMAIN

CONFORMANCE DRAWING

MBA Consulting Engineers, Inc.
3812 Spenard Road, Suite 200 • Anchorage, AK 99517
(907) 274-2822 • FAX (907) 274-0914
Email: mbaconsult@mbaconsult.com

ASCG INCORPORATED
ENGINEERS • ARCHITECTS • SURVEYORS • INSPECTION SERVICES
301 ARCTIC SLOPE AVENUE • ANCHORAGE, AK 99518
PHONE (907) 344-3144 • FAX (907) 344-2214

ALASKA COURT SYSTEM
820 WEST 4TH AVENUE
ANCHORAGE, AK 99501-2005

COMBINED FACILITIES
KODIAK, ALASKA

FIRST FLOOR ELECTRICAL DEMOLITION PLAN AND NOTES

REVISIONS

NUMBER:	DATE:
AD 1	MAY 2, 2001
AD 2	MAY 11, 2001
CONF. DWG	JUL 10, 2001

JOB NO.: 4257
DATE: JUNE 21, 2001
DRAWN BY: SNS
CHECKED BY: MJL
DRAWING NO.: E2
SHEET OF

J: \1130\4257\ACAD14\elec\A107_E2.dwg Tue Jul 10 14:32:37 2001
Plot Time: 10:56:11
Plot Date: 07/10/01
DWG Name: SAM S:\A107_E2.dwg