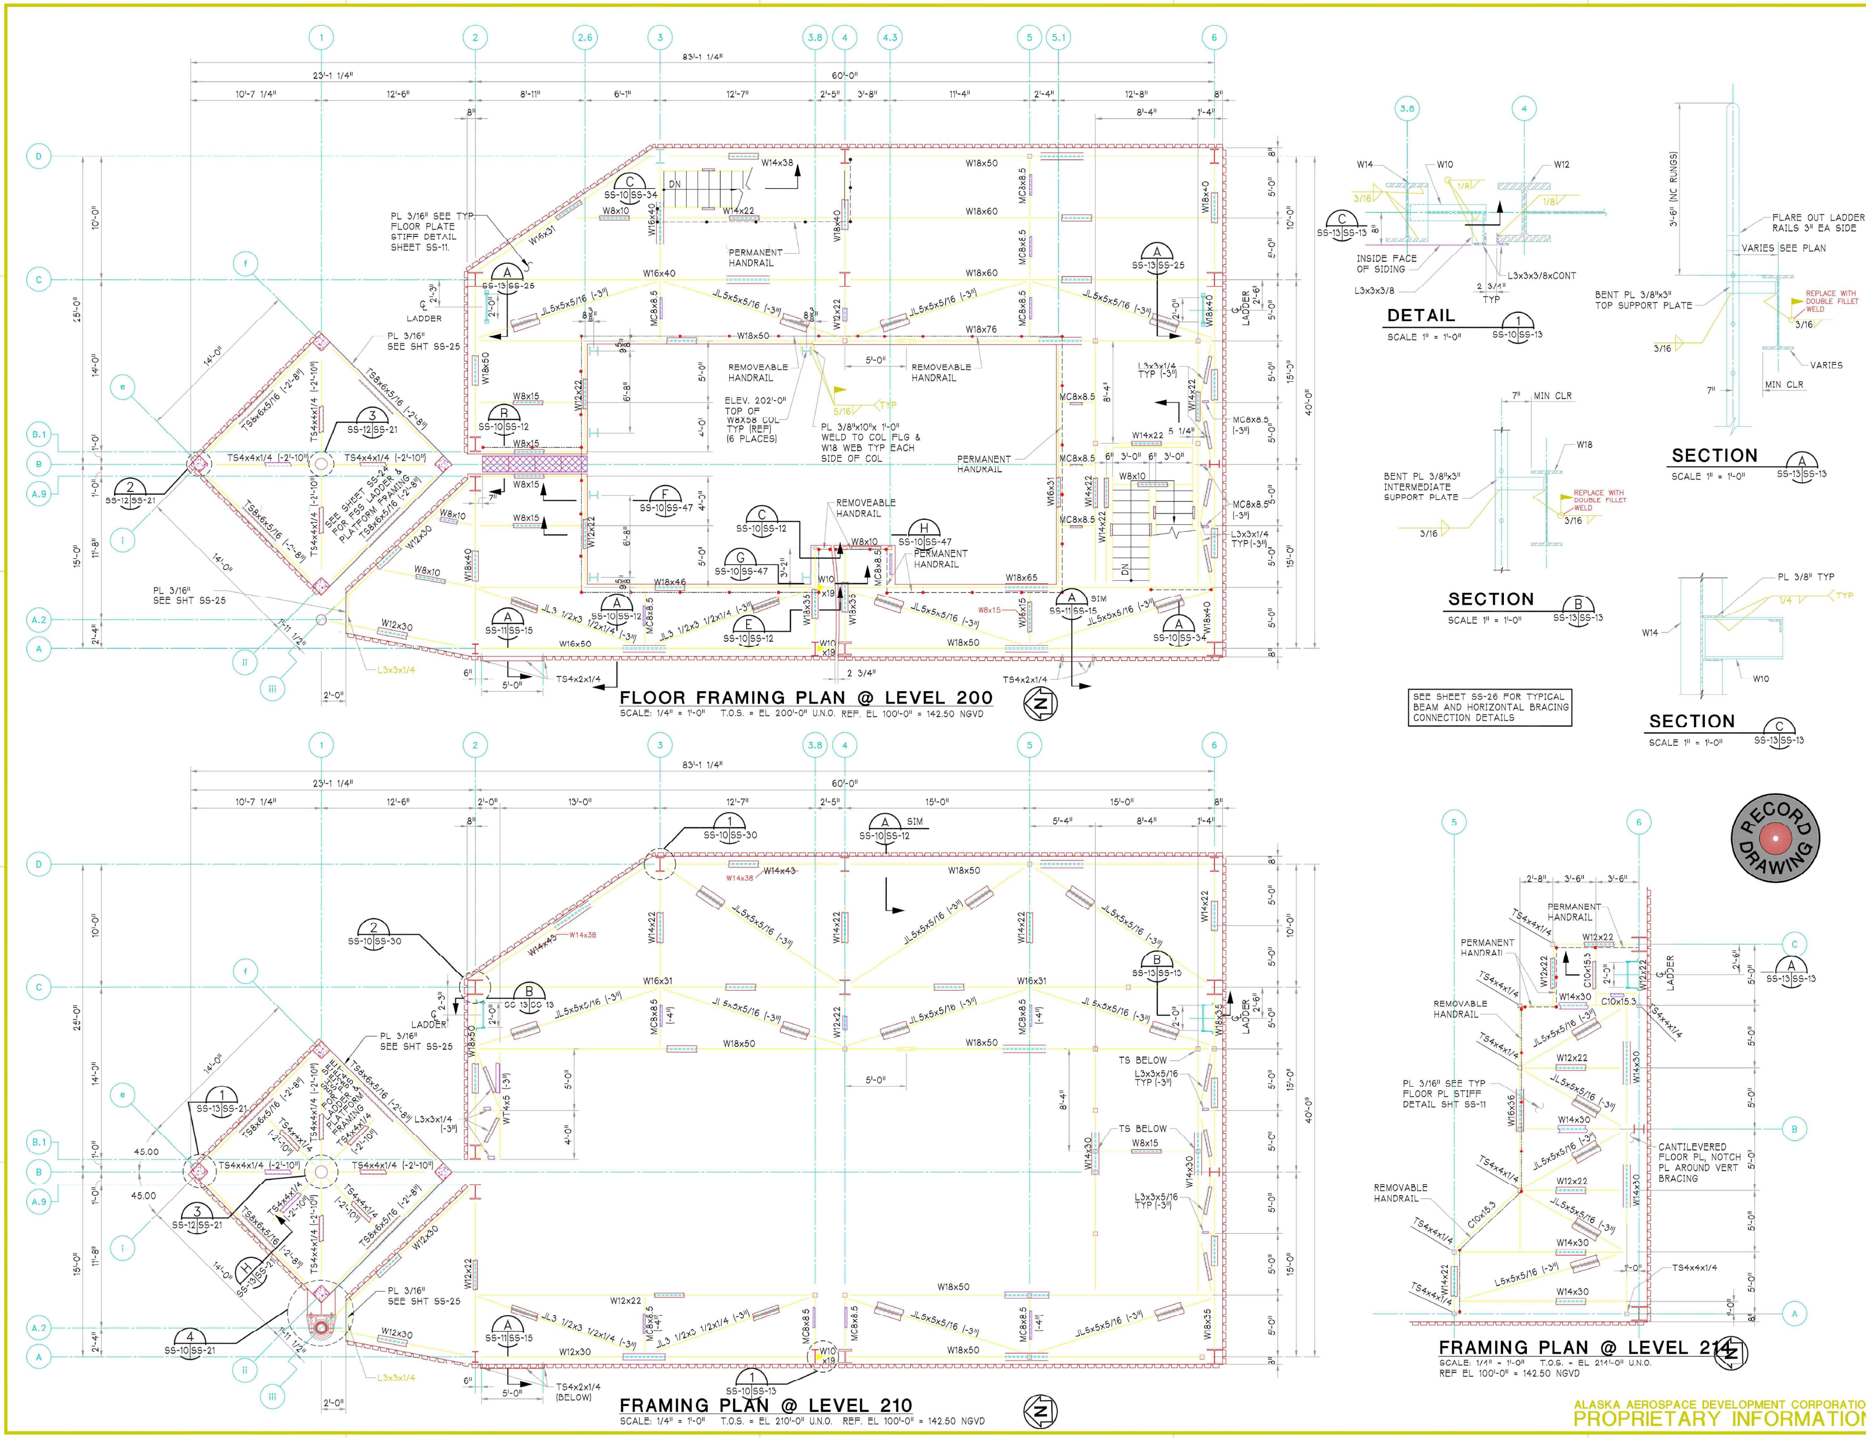


	DATE	REVISION	BY	CHK
0	07/1/98	ISSUED FOR BID	DKH	
11	08/30/02	RECORD DRAWINGS	GAB	AHM

BRPH ARCHITECTS · ENGINEERS, INC.
MELBOURNE / TALLAHASSEE, FLORIDA
3275 SUNTREE BOULEVARD
MELBOURNE, FLORIDA 32940

KODIAK LAUNCH COMPLEX
NARROW CAPE, KODIAK ISLAND, ALASKA
LAUNCH STRUCTURE PHASE 3

FLR FRMG PLAN @ LVL 200 & 210

ALASKA AEROSPACE DEVELOPMENT CORPORATION

DATE 7-1-98
DESIGNED BY ELLIFRITT
DRAWN BY VANDERLAAK
CHECKED BY WAITE
CAD CODE 3597.27\SS-13
PROJECT NO. 3597.27
DRAWING NO. SS-13

ALASKA AEROSPACE DEVELOPMENT CORPORATION
PROPRIETARY INFORMATION