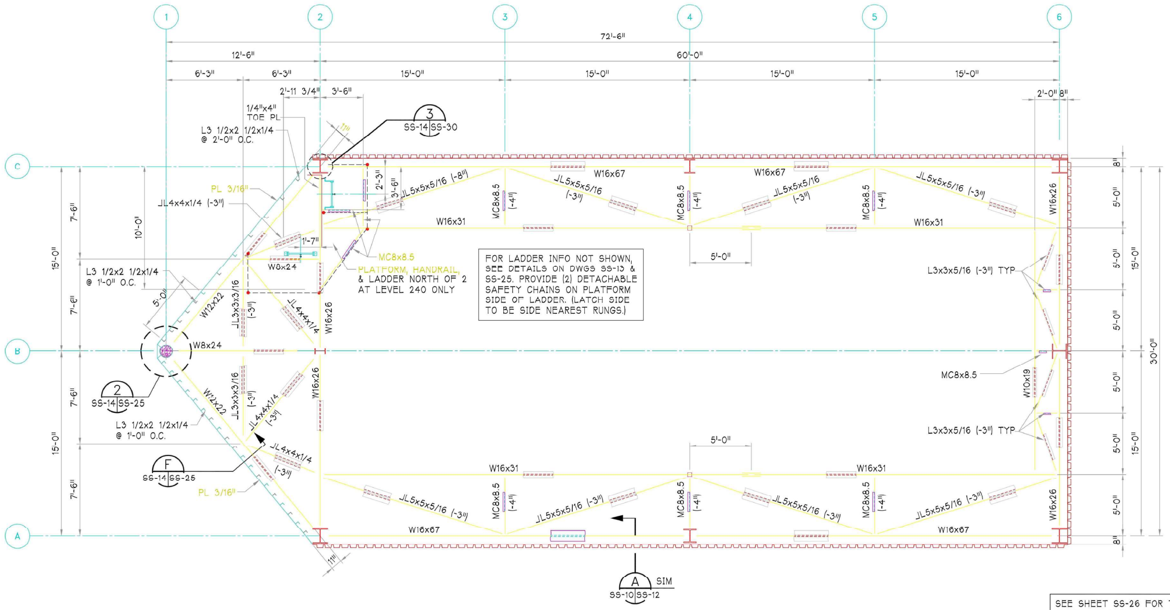

FOR LADDER INFO NOT SHOWN, SEE DETAILS ON DWGS SS-13 & SS-25. PROVIDE (2) DETACHABLE SAFETY CHAINS ON PLATFORM SIDE OF LADDER. (LATCH SIDE TO BE SIDE NEAREST RUNGS.)

SEE SHEET SS-26 FOR TYPICAL BEAM AND HORIZONTAL BRACING CONNECTION DETAILS

## FRAMING PLAN @ LEVEL 230, 240

SCALE: 1/4" = 1'-0"
TOS = EL. 230'-0" OR 240'-0" UNO
REF. EL. 100'-0" = 142.50 NGVD

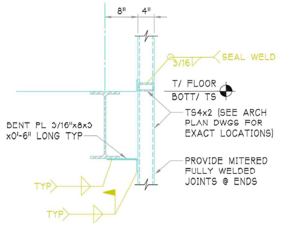
8"
4"
3/16
SEAL WELD
T/ FLOOR
BOTT/ TS
TS4x2 (SEE ARCH PLAN DWGS FOR EXACT LOCATIONS)
BENT PL 3/16"x8x0 x0'-6" LONG TYP
PROVIDE MITERED FULLY WELDED JOINTS @ ENDS
TYP
TYP

## SECTION A

1" = 1'-0"
SS-11 SS-15

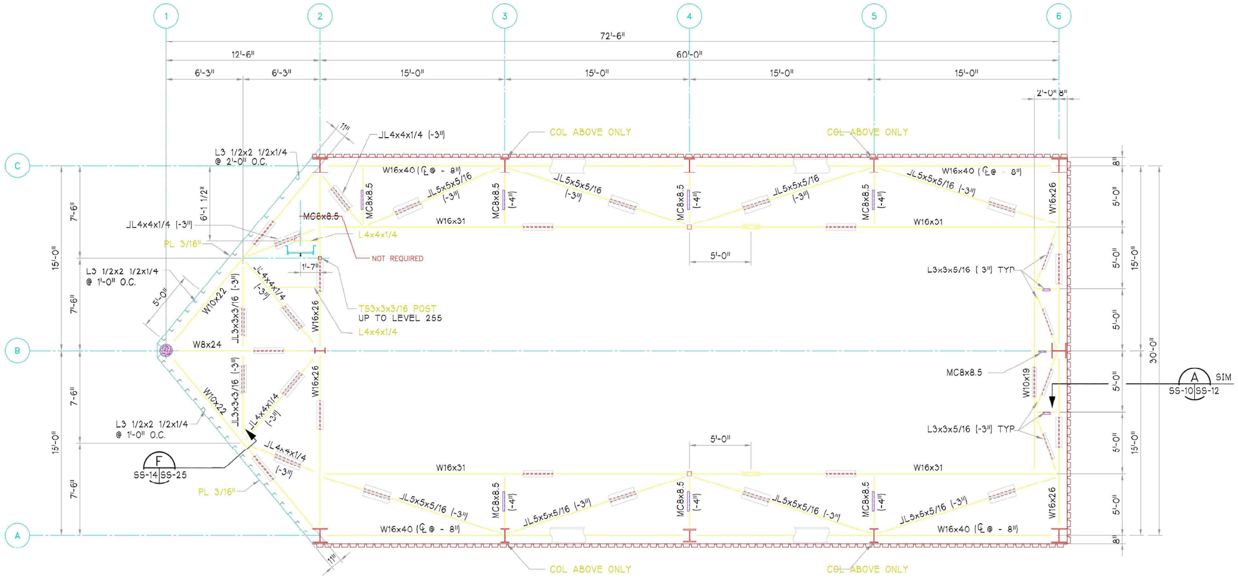

## FRAMING PLAN @ LEVEL 250

SCALE: 1/4" = 1'-0"
TOS = EL. 250'-0" UNO
REF. EL. 100'-0" = 142.50 NGVD

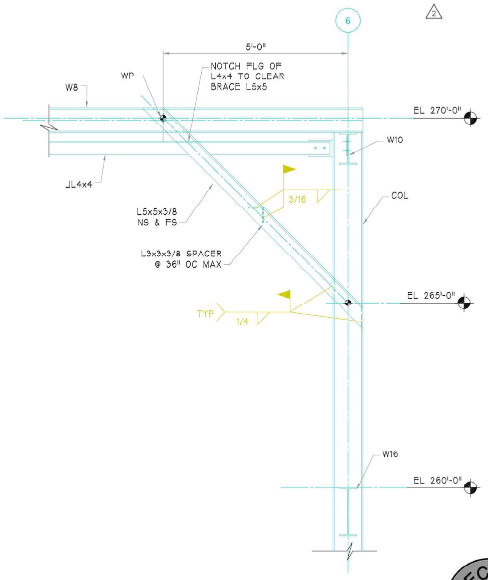

## SECTION B

3/4" = 1'-0"
SS-16 SS-15

RECORD DRAWING

ALASKA AEROSPACE DEVELOPMENT CORPORATION
PROPRIETARY INFORMATION

| △ | DATE | REVISION | BY | CHK |
|---|---|---|---|---|
| 2 | 11-30-99 | ADDED ROOF BRACE DETAIL | HVL | |
| 11 | 08-30-02 | RECORD DRAWINGS | GAB | AHN |

BRPH ARCHITECTS · ENGINEERS, INC.
MELBOURNE / TALLAHASSEE, FLORIDA
3275 SUNTREE BOULEVARD
MELBOURNE, FLORIDA 32940
License No. AA C000149

Copyright © 1998
These plans are protected by Federal Copyright protection. Unauthorized use may result in an infringement action.

KODIAK LAUNCH COMPLEX
NARROW CAPE, KODIAK ISLAND, ALASKA
LAUNCH STRUCTURE PHASE 3

FRAMING PLAN @ LVL 230, 240 & 250

ALASKA AEROSPACE DEVELOPMENT CORPORATION

DATE 7-1-98
DESIGNED BY ELLIFRITT
DRAWN BY VANDERLAAK
CHECKED BY WAITE
CAD CODE 3597.22\LP1\SS-15
PROJECT NO. 3597.27
DRAWING NO. SS-15
SHEET OF

J:\3597.22\CURRENT\SS-15.DWG 12-19-99 09:25 HVL