REV. MK.	DESCRIPTION	BY	DATE	APPVD.
1	REVISED TO AS BUILT	PJT	1-10-83	

42 CIRCUIT PANEL NO. 5 LOCATED IN PILOT HOUSE

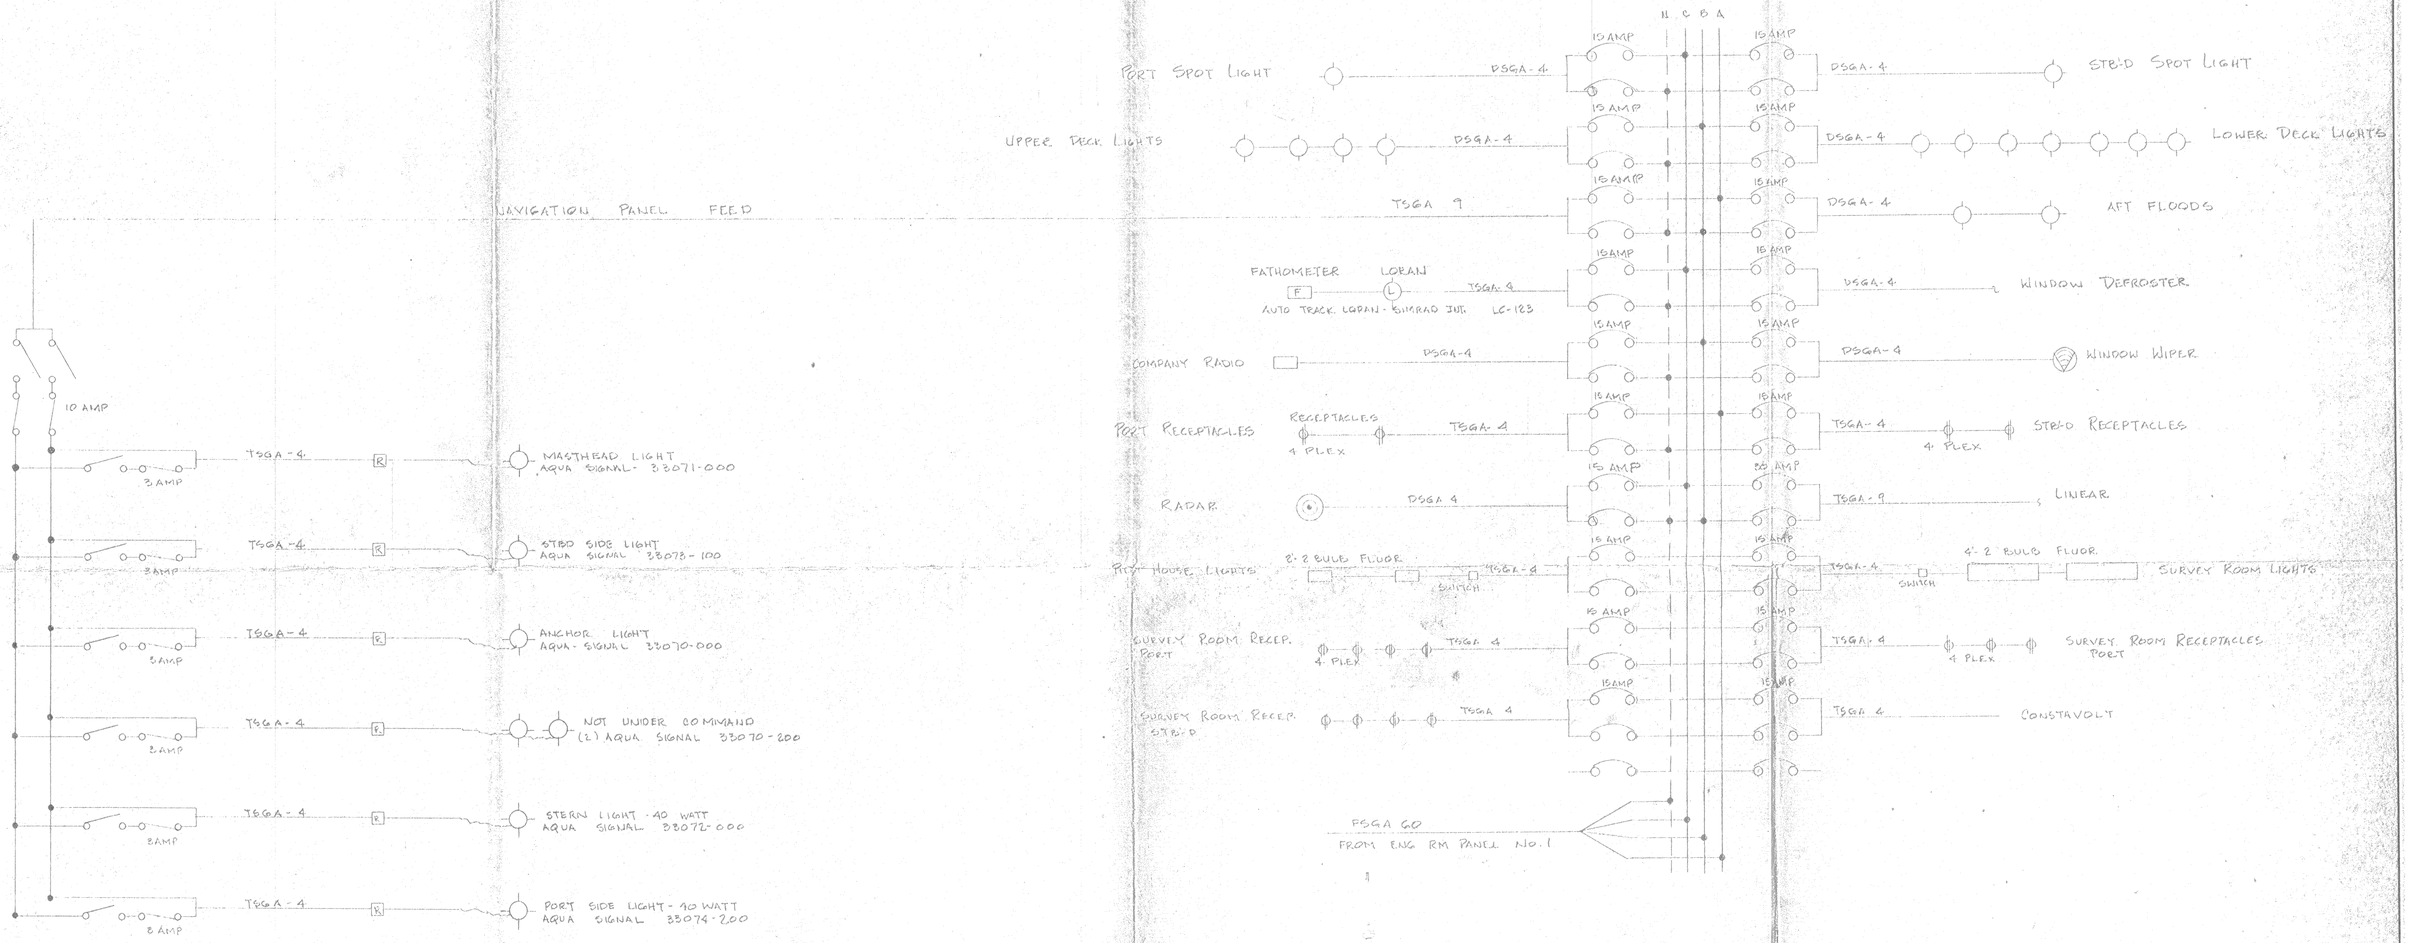

UNIVERSAL IRON WORKS INC.
UNIVERSAL CONSTRUCTION UNICO & LABOR CREWS
P.O. BOX 9056
301 PROSPECT ST.
HOUMA, LA. 70361
PHONE
504-868-2575

110'-9" x 26'-0" x 12'-0"
SMALL PASSENGER VESSEL
ELECTRICAL PANEL

DR. PJT	DATE 1-10-83	DWG. NO. 11392-E3	REV. 1
CK.	SCALE NONE		

DRAWING 40-22 31348-6